


00P000Cto/lieprieino/mqin/1P4 00/1/8

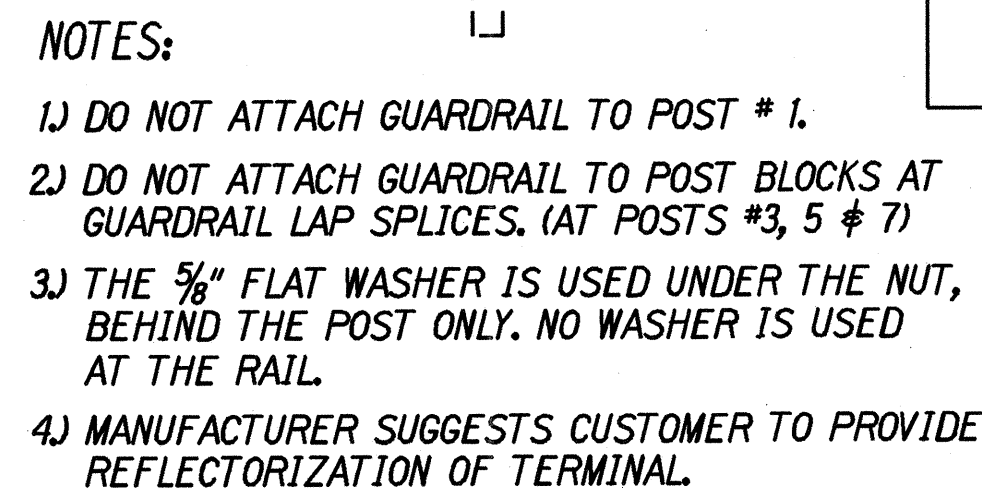

SEE NOTE BELOW

5/8" dia. x 10" LG H.G.P. BOLT
W/ HEX NUT & WASHER
(SEE NOTE 3)

PC 33872A POST (UPPER)
W6 x 8.5

SEE DETAIL "D"

RECYCLED PLASTIC
BLOCKOUT OR
OFFSET BLOCK


3'-7 1/2"

PC 33874A POST (LOWER)
W6 x 8.5

PC 33872A POST
(UPPER) W6 x 8.5

SEE DETAIL "H"

5'-11 1/2"

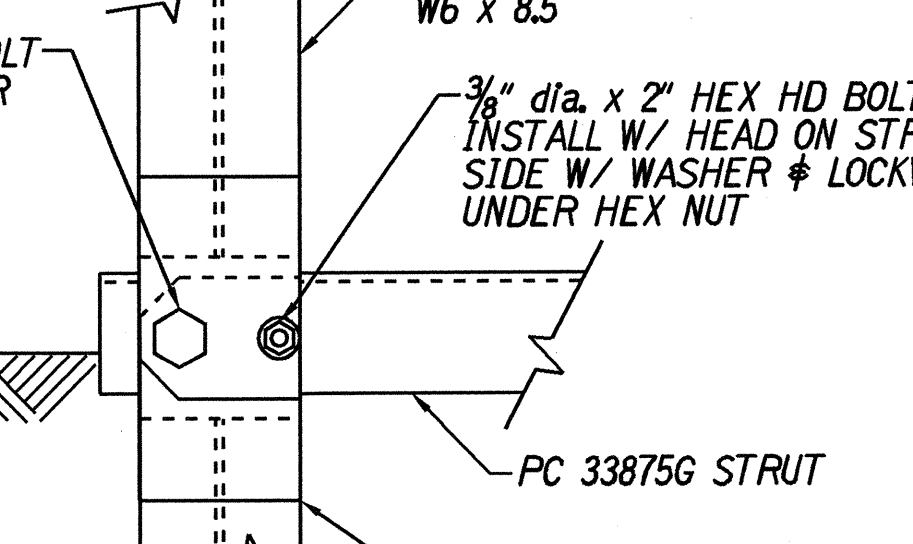

HD BOLT WASHER

PC 33872A POST (UPPER)
W6 x 8.5

3/4" dia. x 2" HEX HD BOLT
INSTALL W/ HEAD ON STRUT
SIDE W/ WASHER & LOCKWASHER
UNDER HEX NUT

PC 33875G STRUT

PC 33873A POST (LOWER)
W6 x 8.5

STATE OF HAWAII
DEPARTMENT OF TRANSPORTATION
HIGHWAYS DIVISION

ET-2000 PLUS

KAMEHMEHA V HIGHWAY RESURFACING

Kamalo to Pukoo

Project No. 450B-01-02M

Scale: As Shown Date: October, 2001

SHEET No. 1 OF 1 SHEETS