
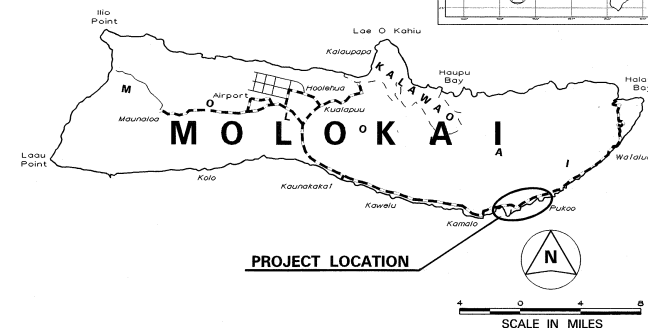
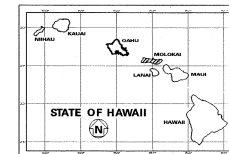


Sheet No. ①OS-1 is a supplementary sheet to this project. Total Sheet count after "A5-BUILT" posting 41 shts.

DISTRICT OF MOLOKAI
ISLAND OF MOLOKAIDISTRICT OF MOLOKAI
ISLAND OF MOLOKAI

----- FEDERAL AID PROJECTS PREVIOUSLY CONSTRUCTED
OR UNDER CONSTRUCTION

MILE POST 11.30 TO MILE POST 16.50

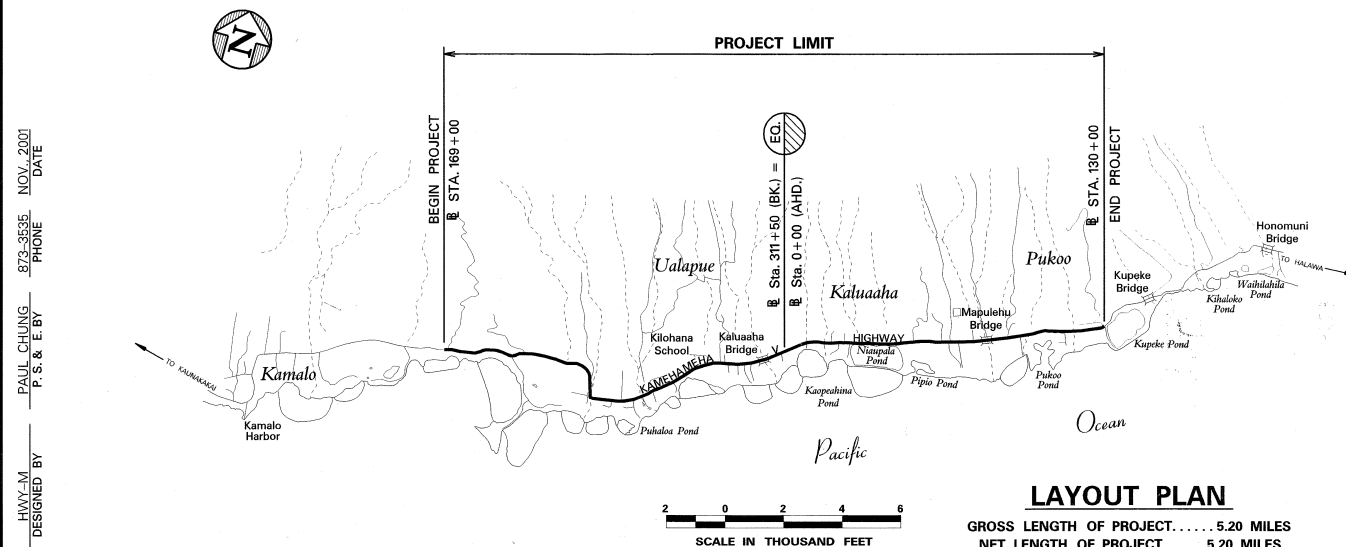

LAYOUT PLAN

GROSS LENGTH OF PROJECT.....5.20 MILES
NET LENGTH OF PROJECT.....5.20 MILES

DEPARTMENT OF TRANSPORTATION
STATE OF HAWAII

APPROVED:

Dennis M. Jami 11-16-0
DIR. OF TRANSPORTATION DATE