



FED. ROAD DIST. NO.	STATE	PROJ. NO.	FISCAL YEAR	SHEET NO.	TOTAL SHEETS
HAWAII	HAW.	450B-01-02M	2002	ADD.8	40

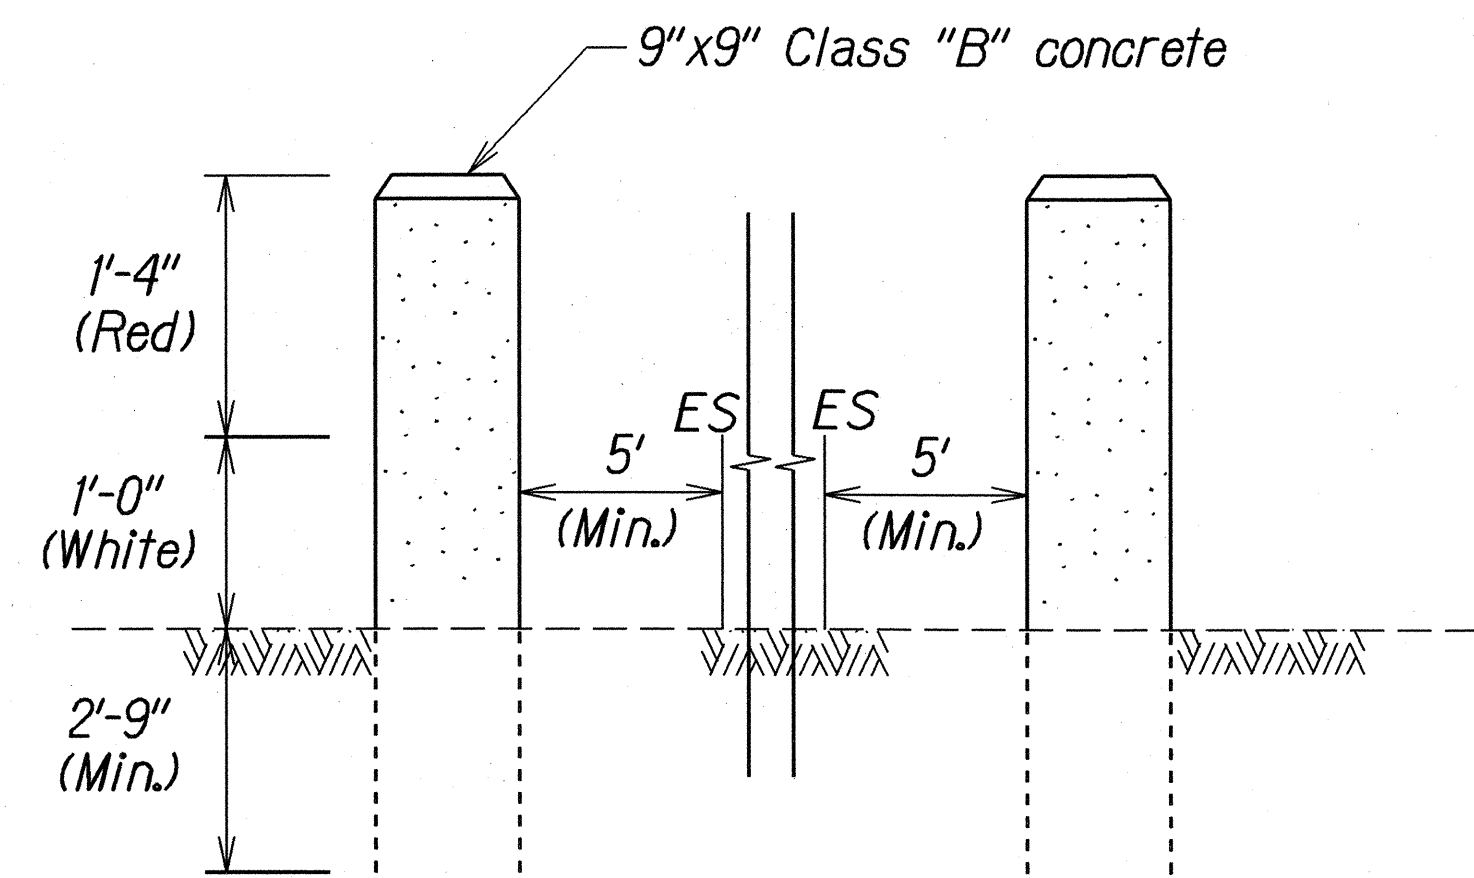


NOTE: Guide post shall be painted as shown and spaced 30'-0" o.c.


GUIDE POST DETAIL
(CLASS "B" CONCRETE)
Scale: 1" = 1'-0"

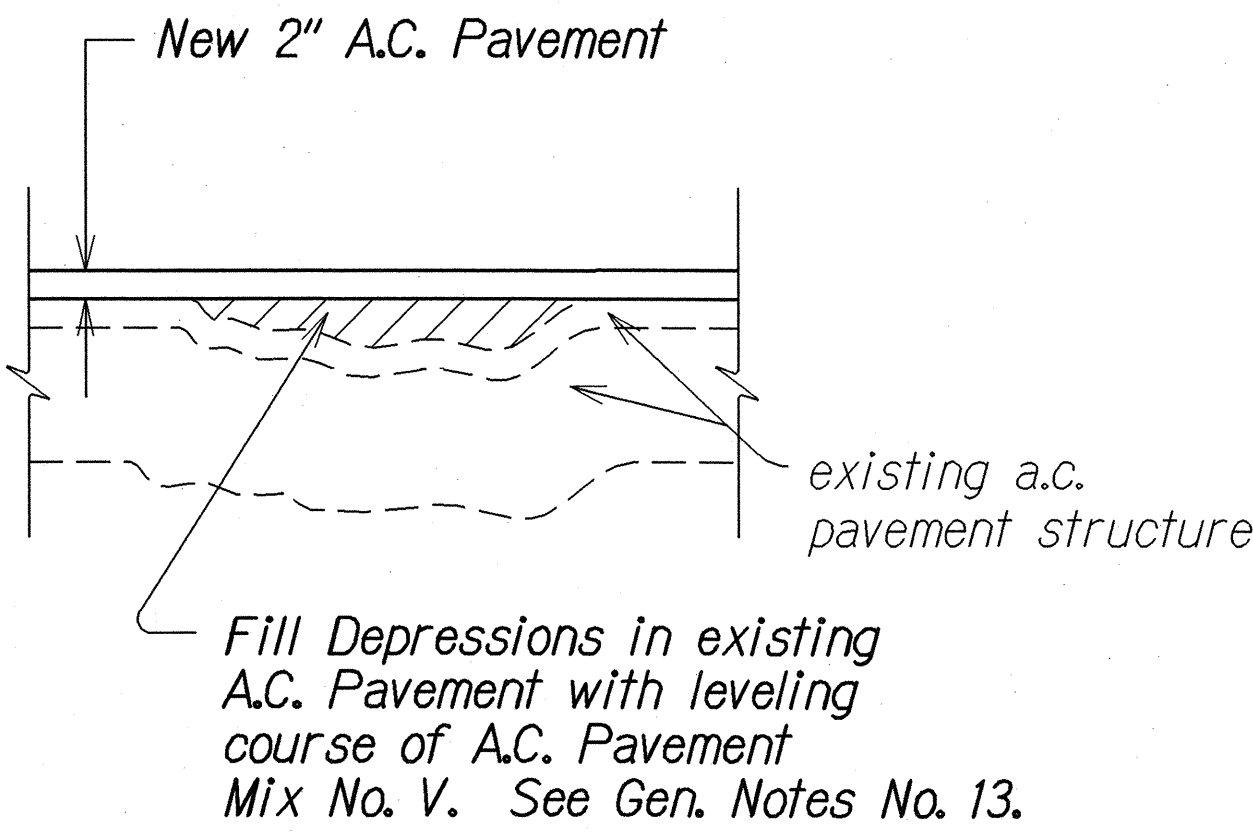

LEVELING COURSE DETAIL
Not To Scale

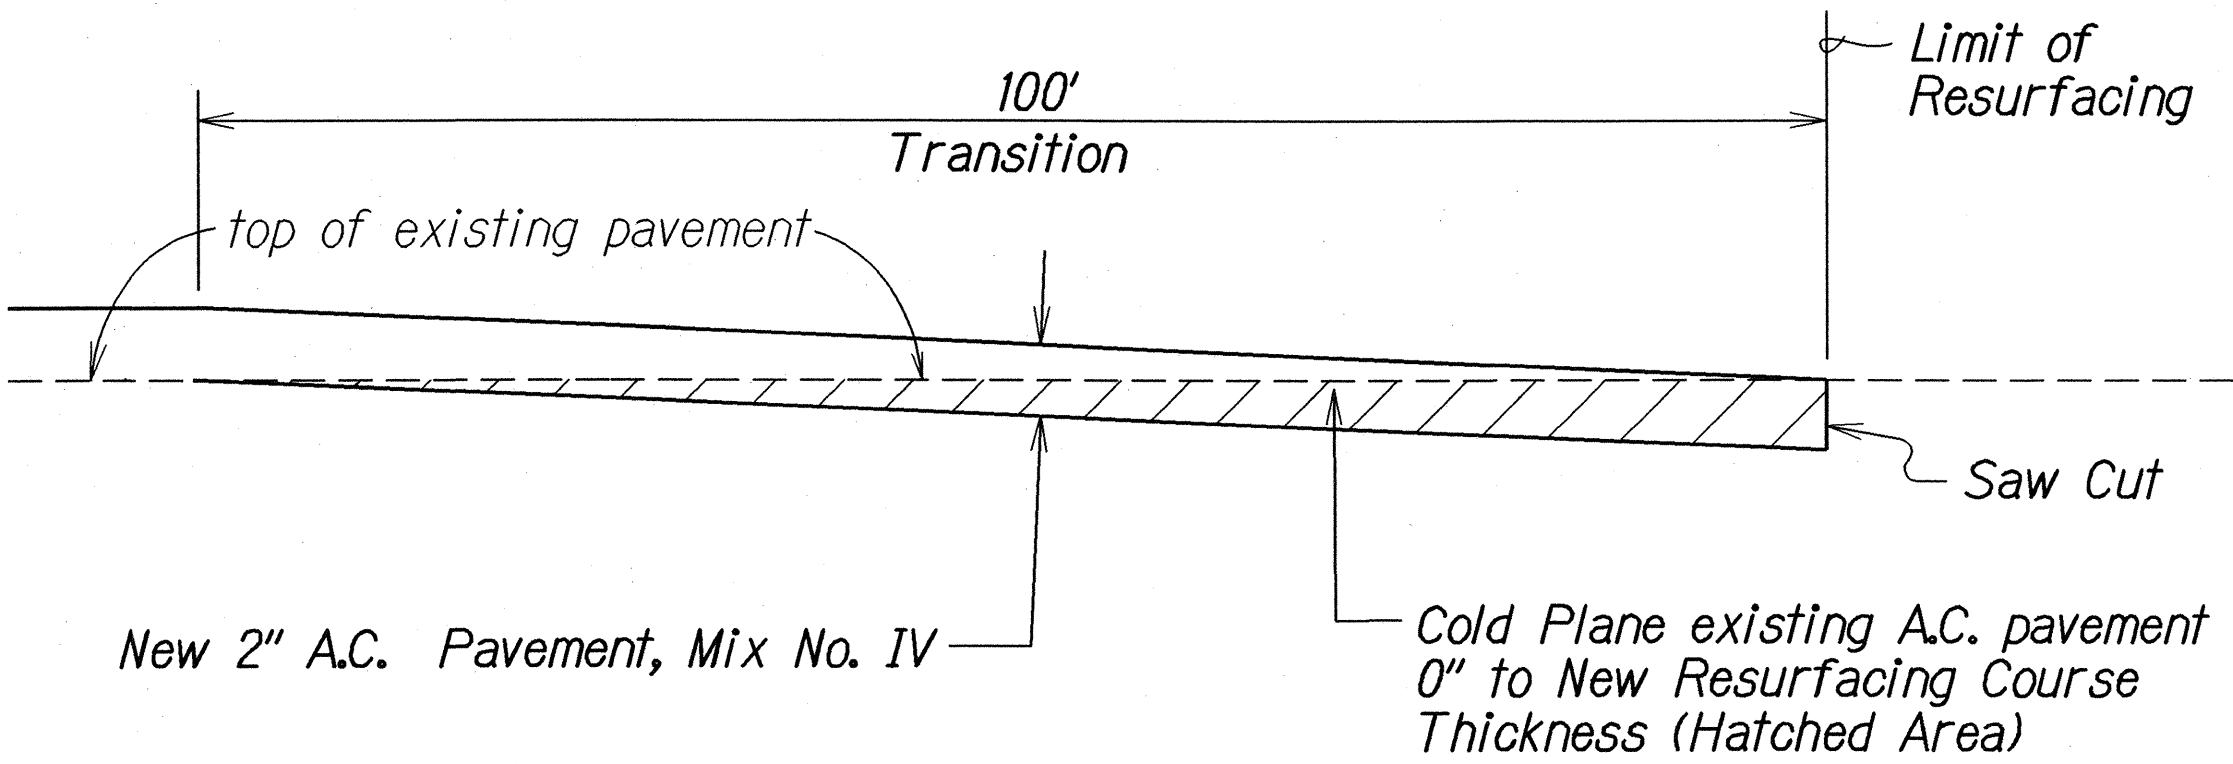

COLD PLANED TRANSITION
TO EXISTING A.C. PAVEMENT
Not To Scale

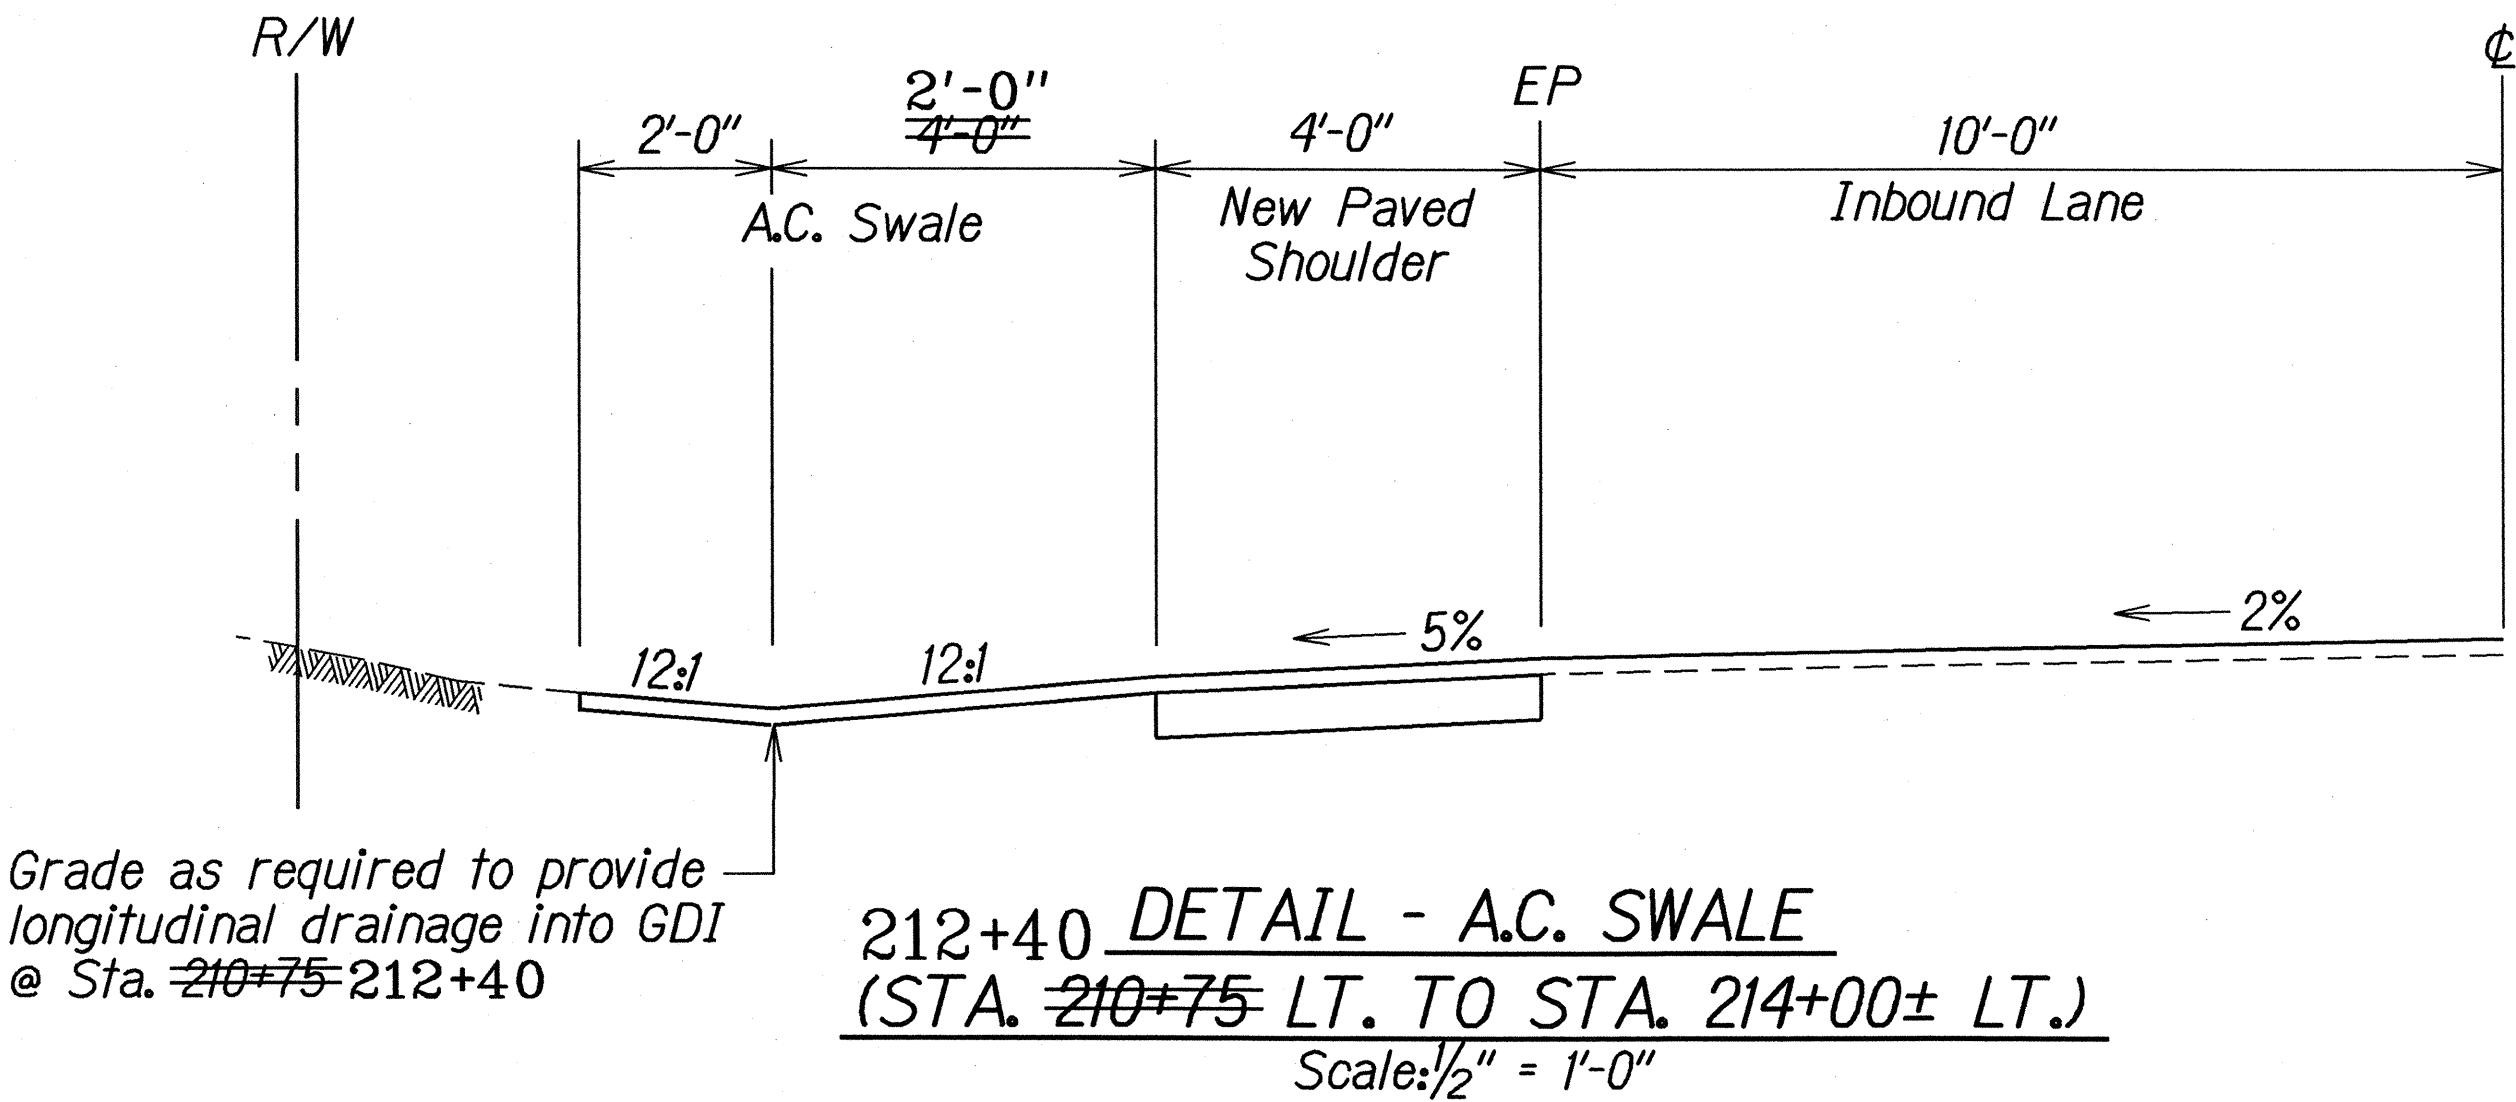

LEGEND FOR AS-BUILT POSTINGS	
	Squiggly line for as-built deletion
	Double line for as-built deletion
Roadway	Text for as-built posting



1/18/02	Deleted Pavement Transition Detail at Obstruction.
DATE	REVISION
STATE OF HAWAII DEPARTMENT OF TRANSPORTATION HIGHWAYS DIVISION TYPICAL SECTIONS & DETAILS KAMEHAMEHA V HIGHWAY RESURFACING Kamalo to Pukoo Project No. 450B-01-02M Scale: As Shown Date: August, 2001	
SHEET No. 1 OF 2 SHEETS	

ORIGINAL PLAN	SURVEY PLOTTED BY	DATE
NOTE BOOK	DRAWN BY	10/18/02
QUANTITIES BY	CHECKED BY	
DATE	BY	

"AS-BUILT"



ADD.8

FED. ROAD DIST. NO.	STATE	PROJ. NO.	FISCAL YEAR	SHEET NO.	TOTAL SHEETS
HAWAII	HAW.	450B-01-02M	2002	9	40

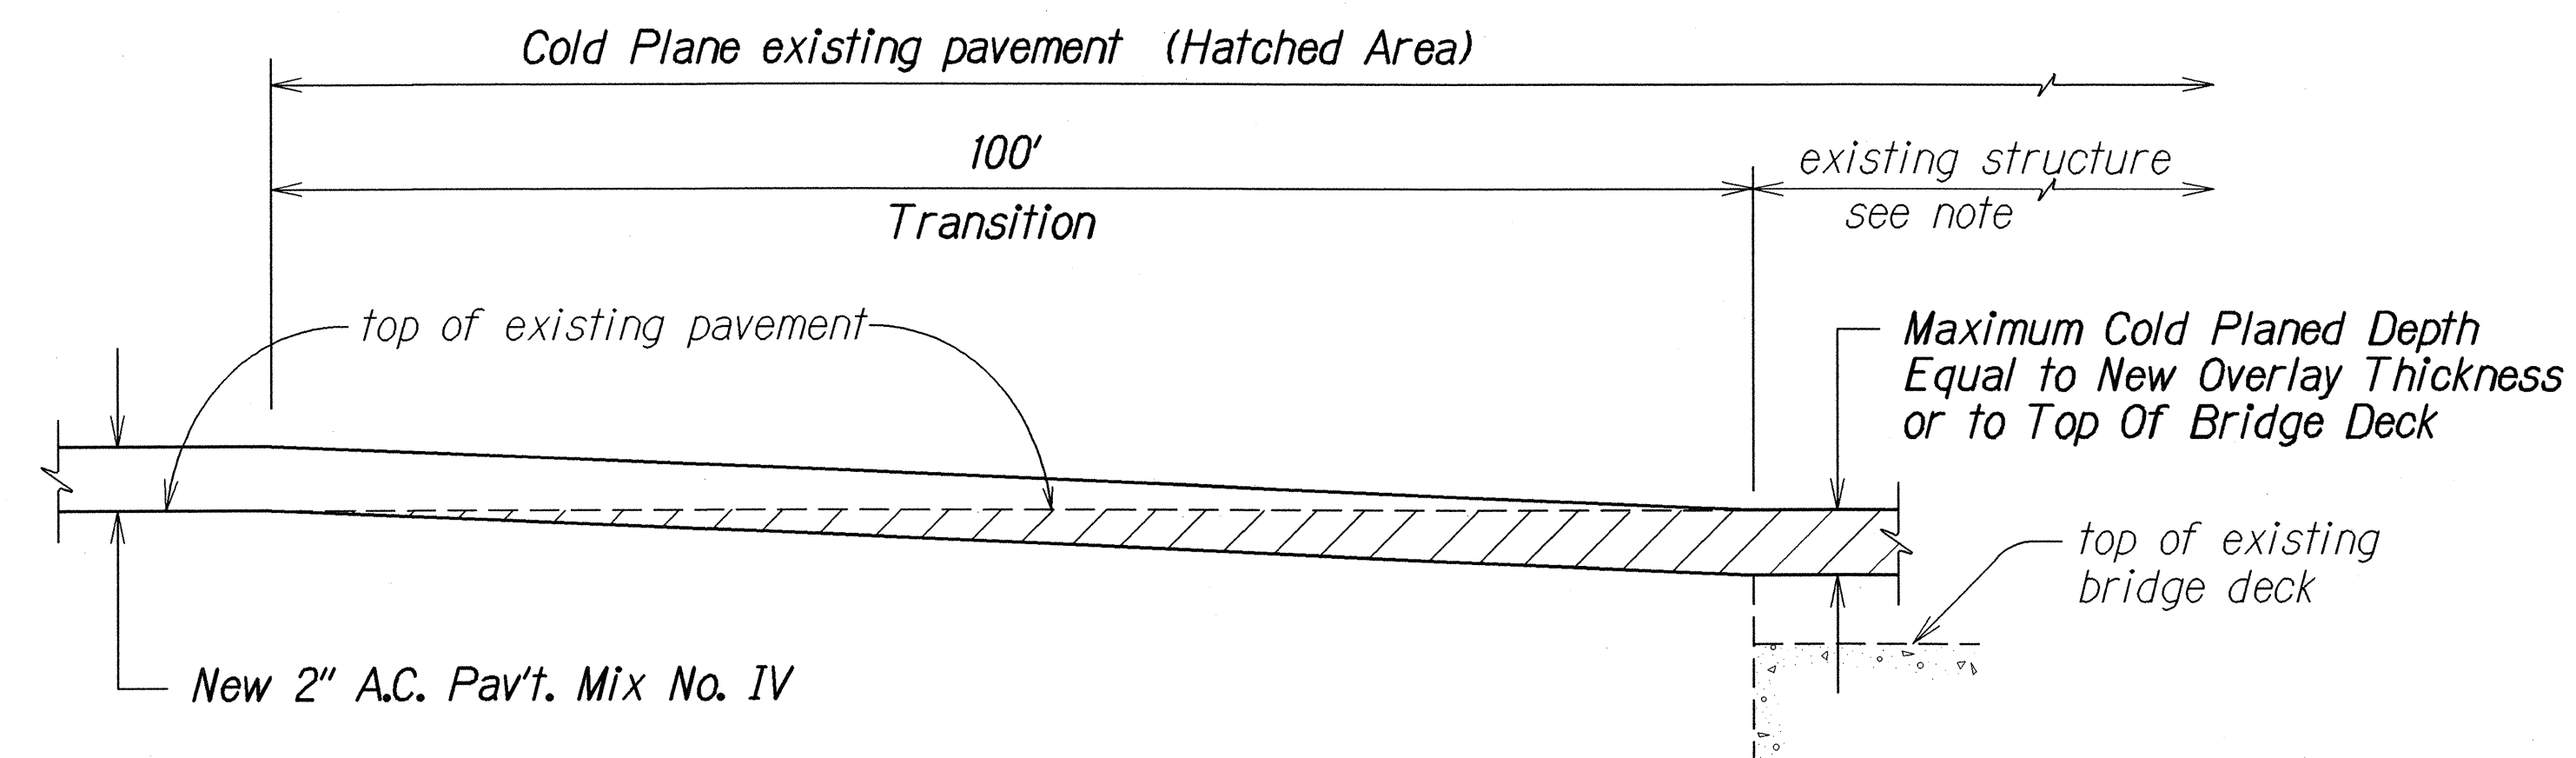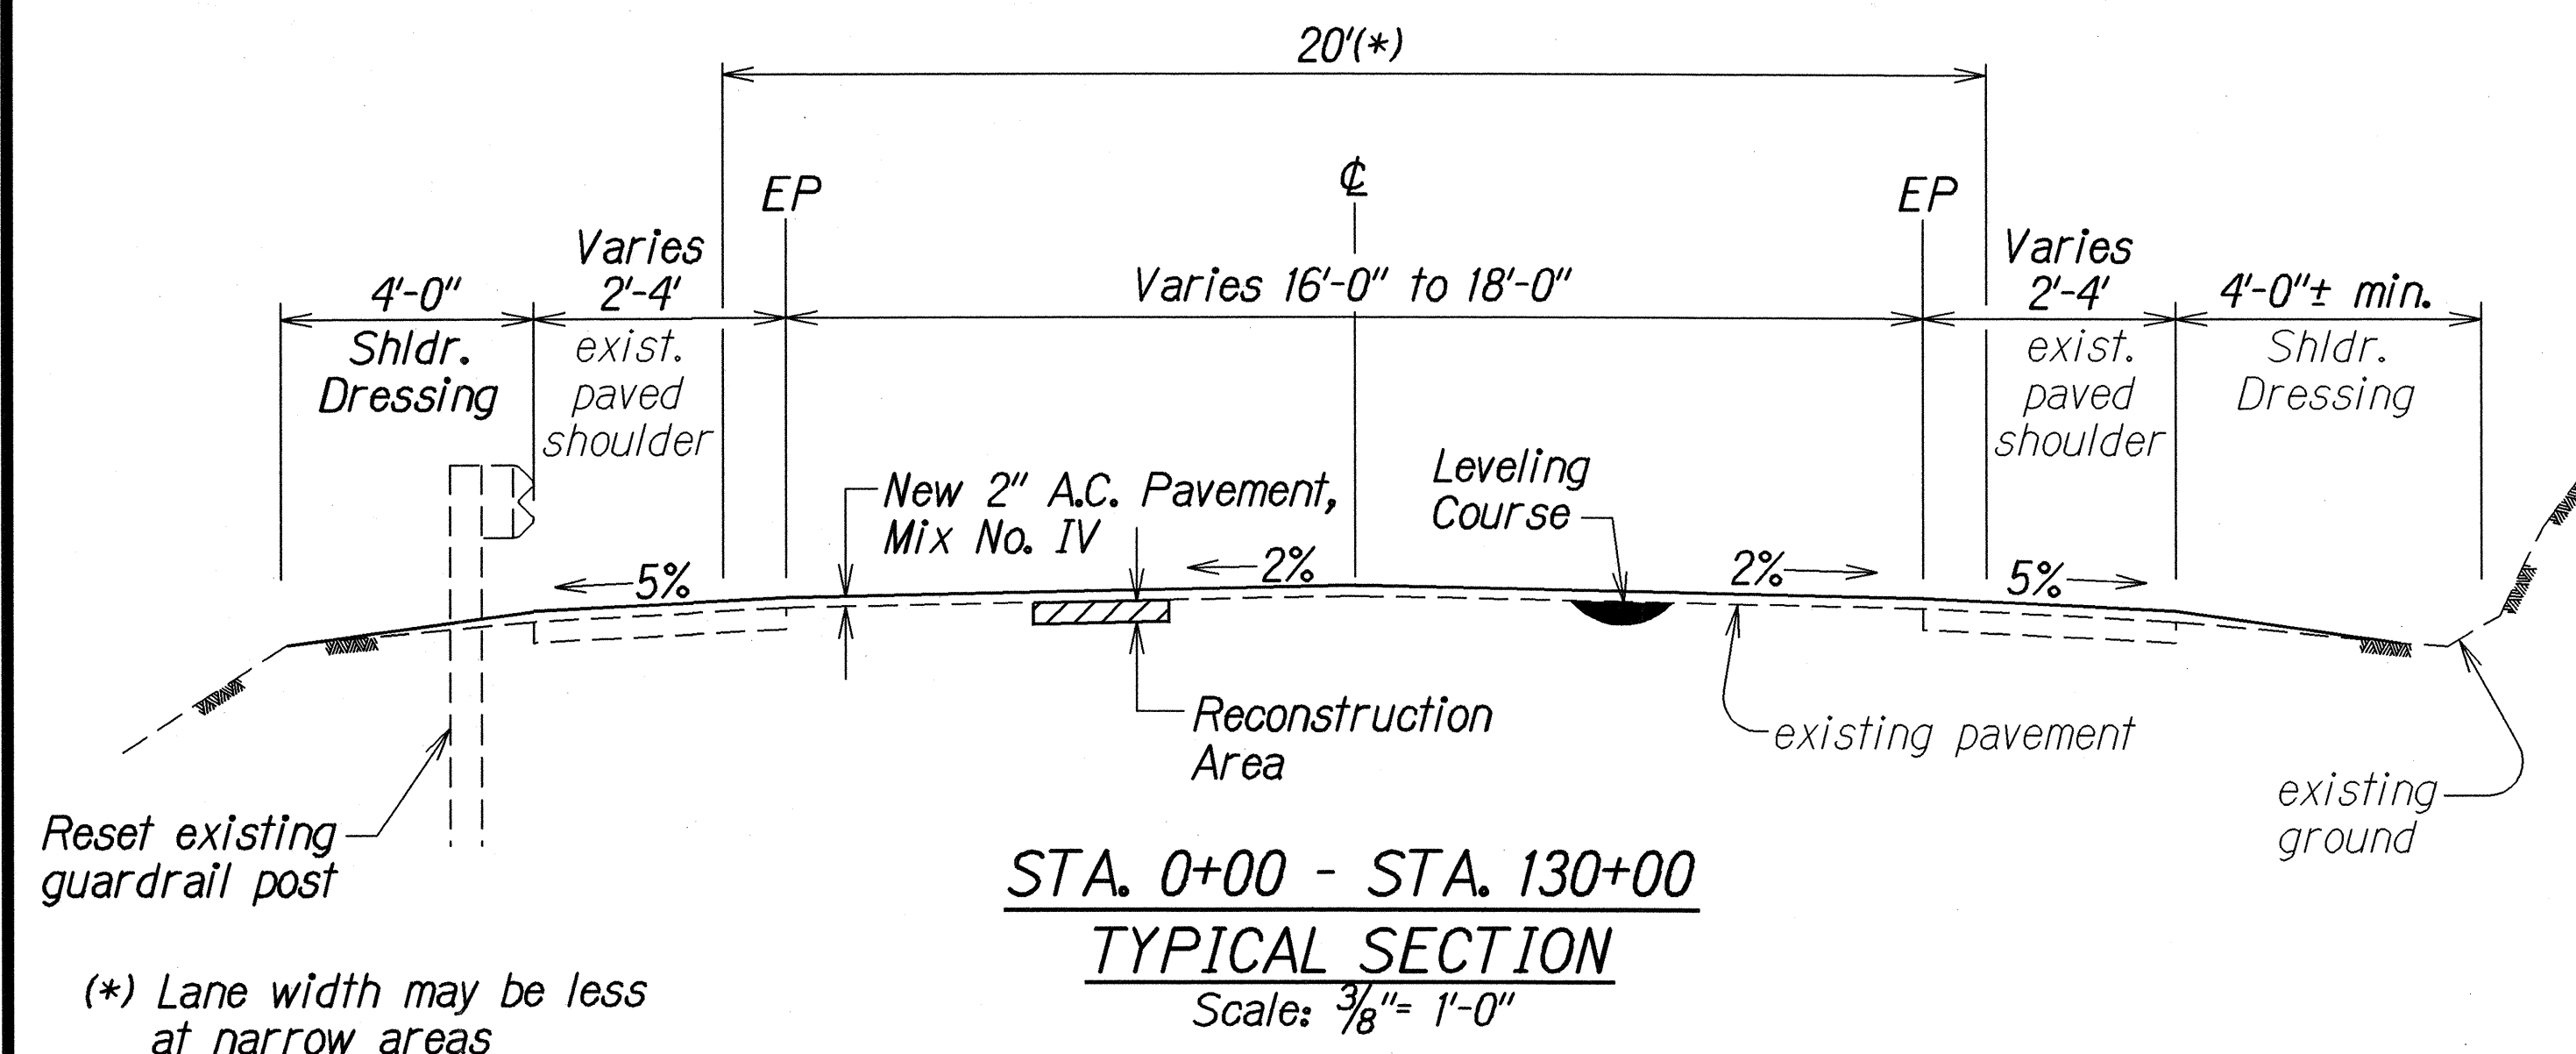


OHIA AND KALUAAHA BRIDGE
COLD PLANED TRANSITION AND RESURFACING
OVER EXISTING STRUCTURE

Not to Scale

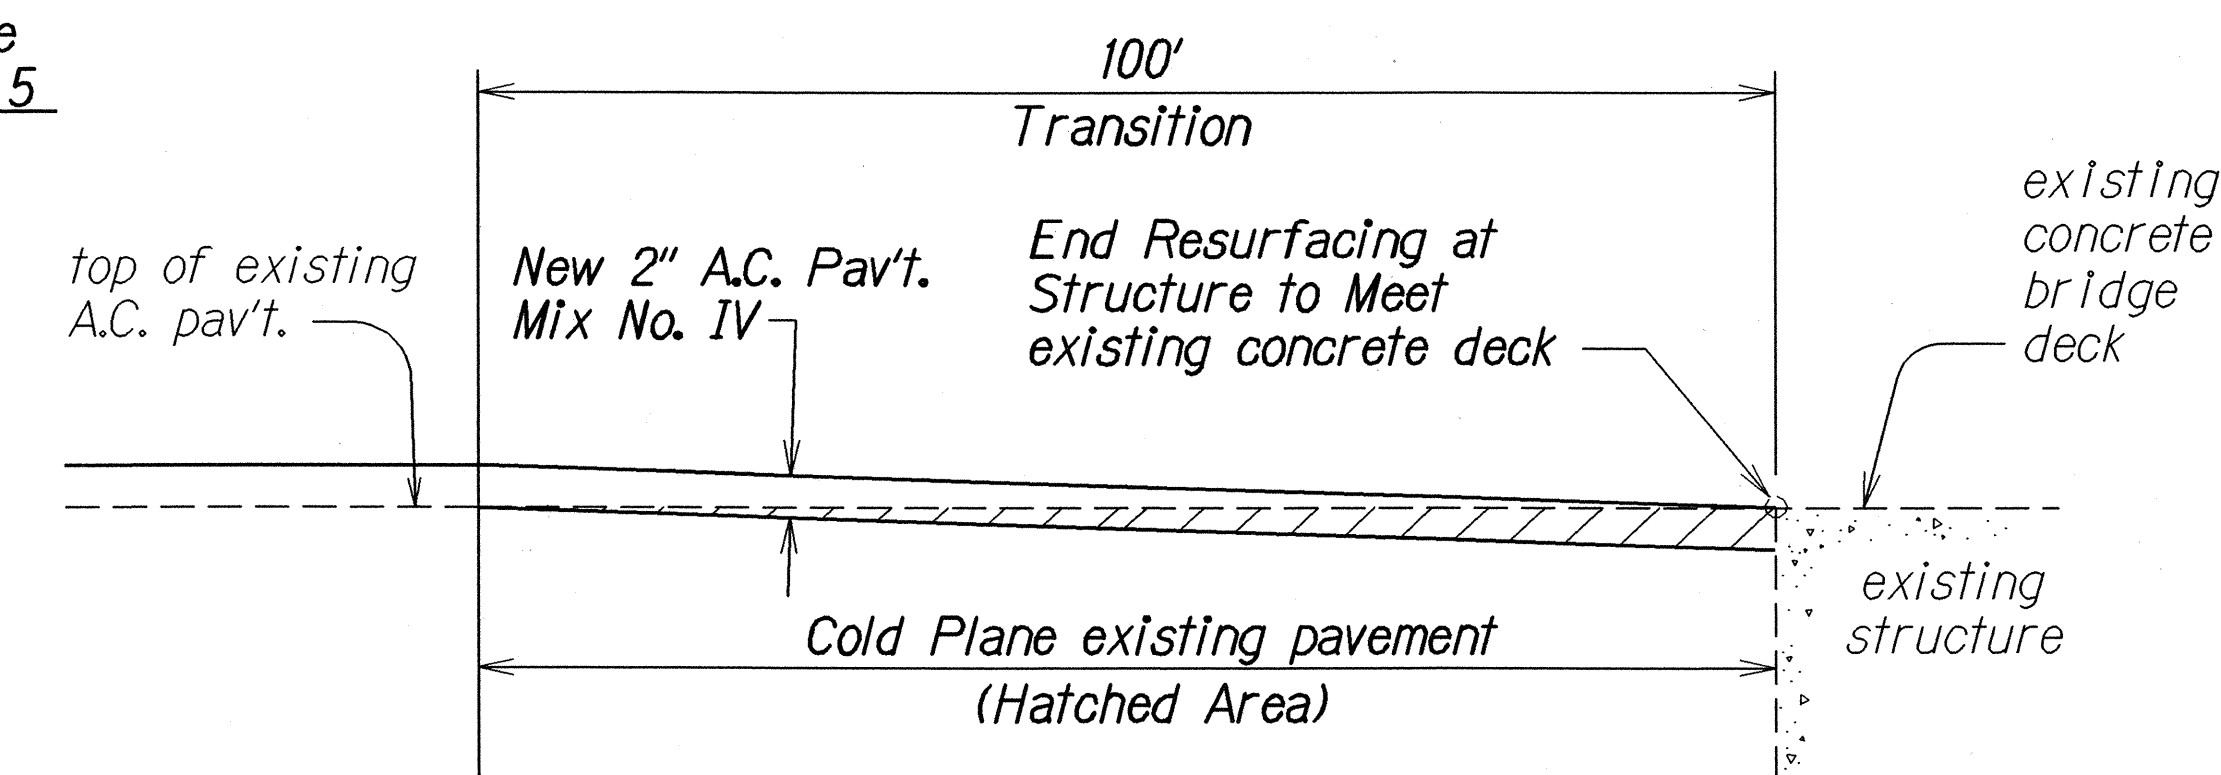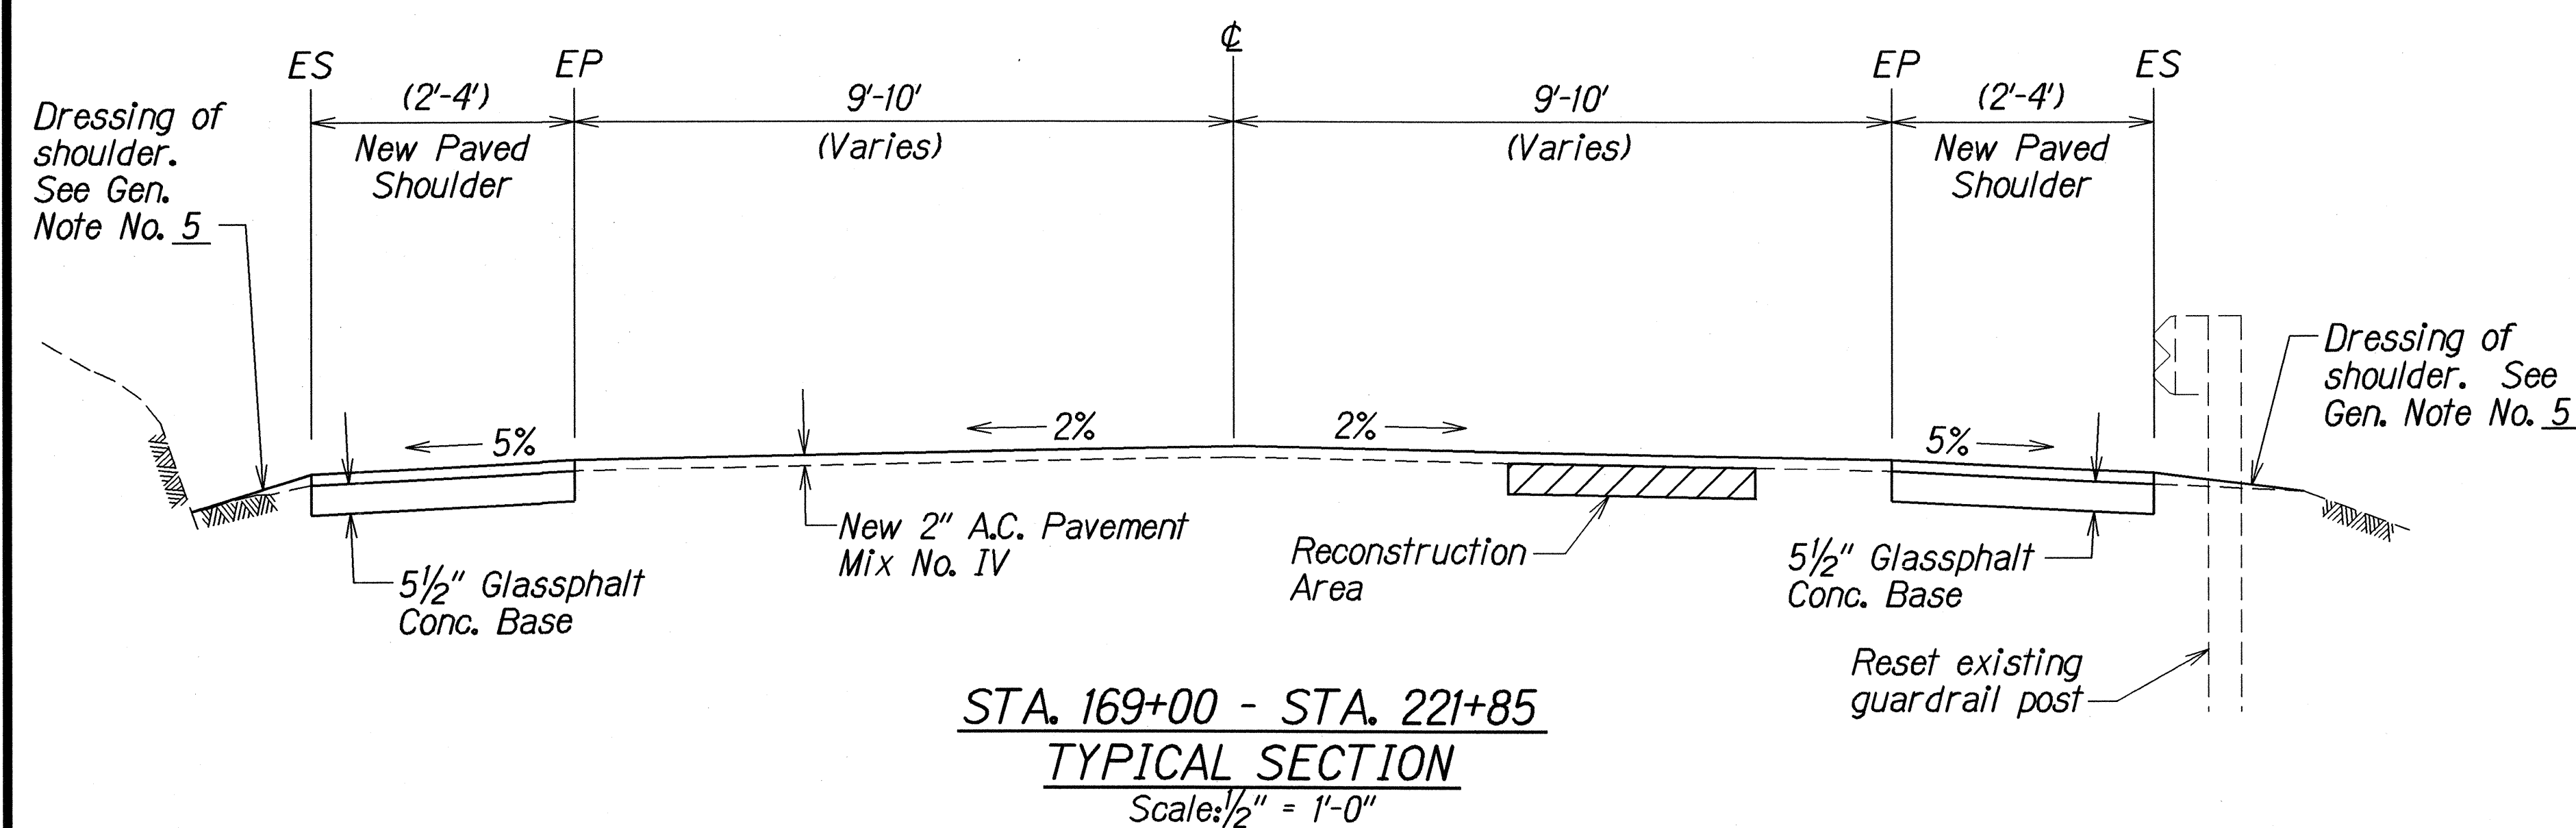

MAPULEHU BRIDGE
COLD PLANED TRANSITION AT STRUCTURE

Not to Scale

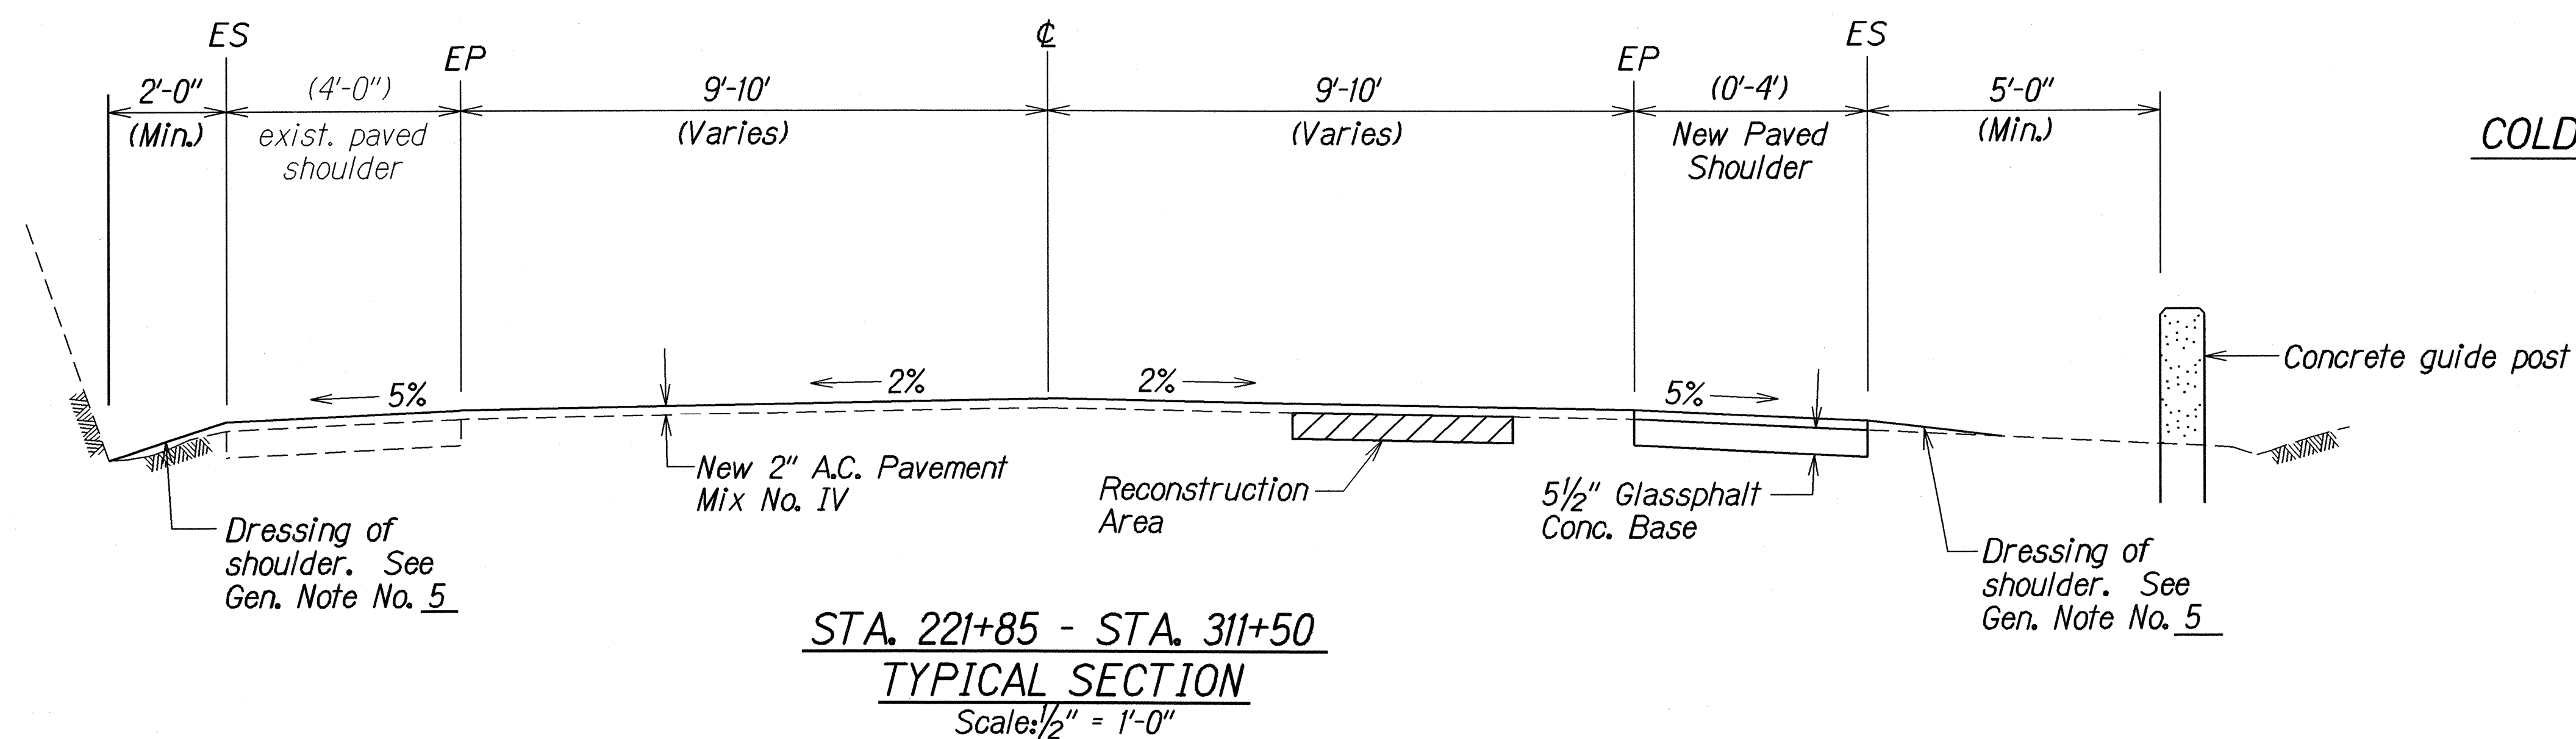

SURVEY PLOTTED BY	DATE	2001
DESIGNED BY		
NOTED BY		
QUANTITIES BY		
CHECKED BY		

STATE OF HAWAII DEPARTMENT OF TRANSPORTATION HIGHWAYS DIVISION
TYPICAL SECTIONS & DETAILS
KAMEHAMEHA V HIGHWAY RESURFACING
Kamalo to Pukoo
Project No. 450B-01-02M
Scale: As Shown Date: September, 2001
SHEET No. 2 OF 2 SHEETS