

STATE OF HAWAII

DEPARTMENT OF TRANSPORTATION

HIGHWAYS DIVISION

HONOLULU, HAWAII

"AS-BUILT"

PLANS FOR

KAMEHAMEHA V HIGHWAY,



GUARDRAIL AND SHOULDER IMPROVEMENTS,

KAPUOKOOLAU TO KAMALO

FEDERAL-AID PROJECT NO. STP-0450(9)


DISTRICT OF MOLOKAI

ISLAND OF MOLOKAI

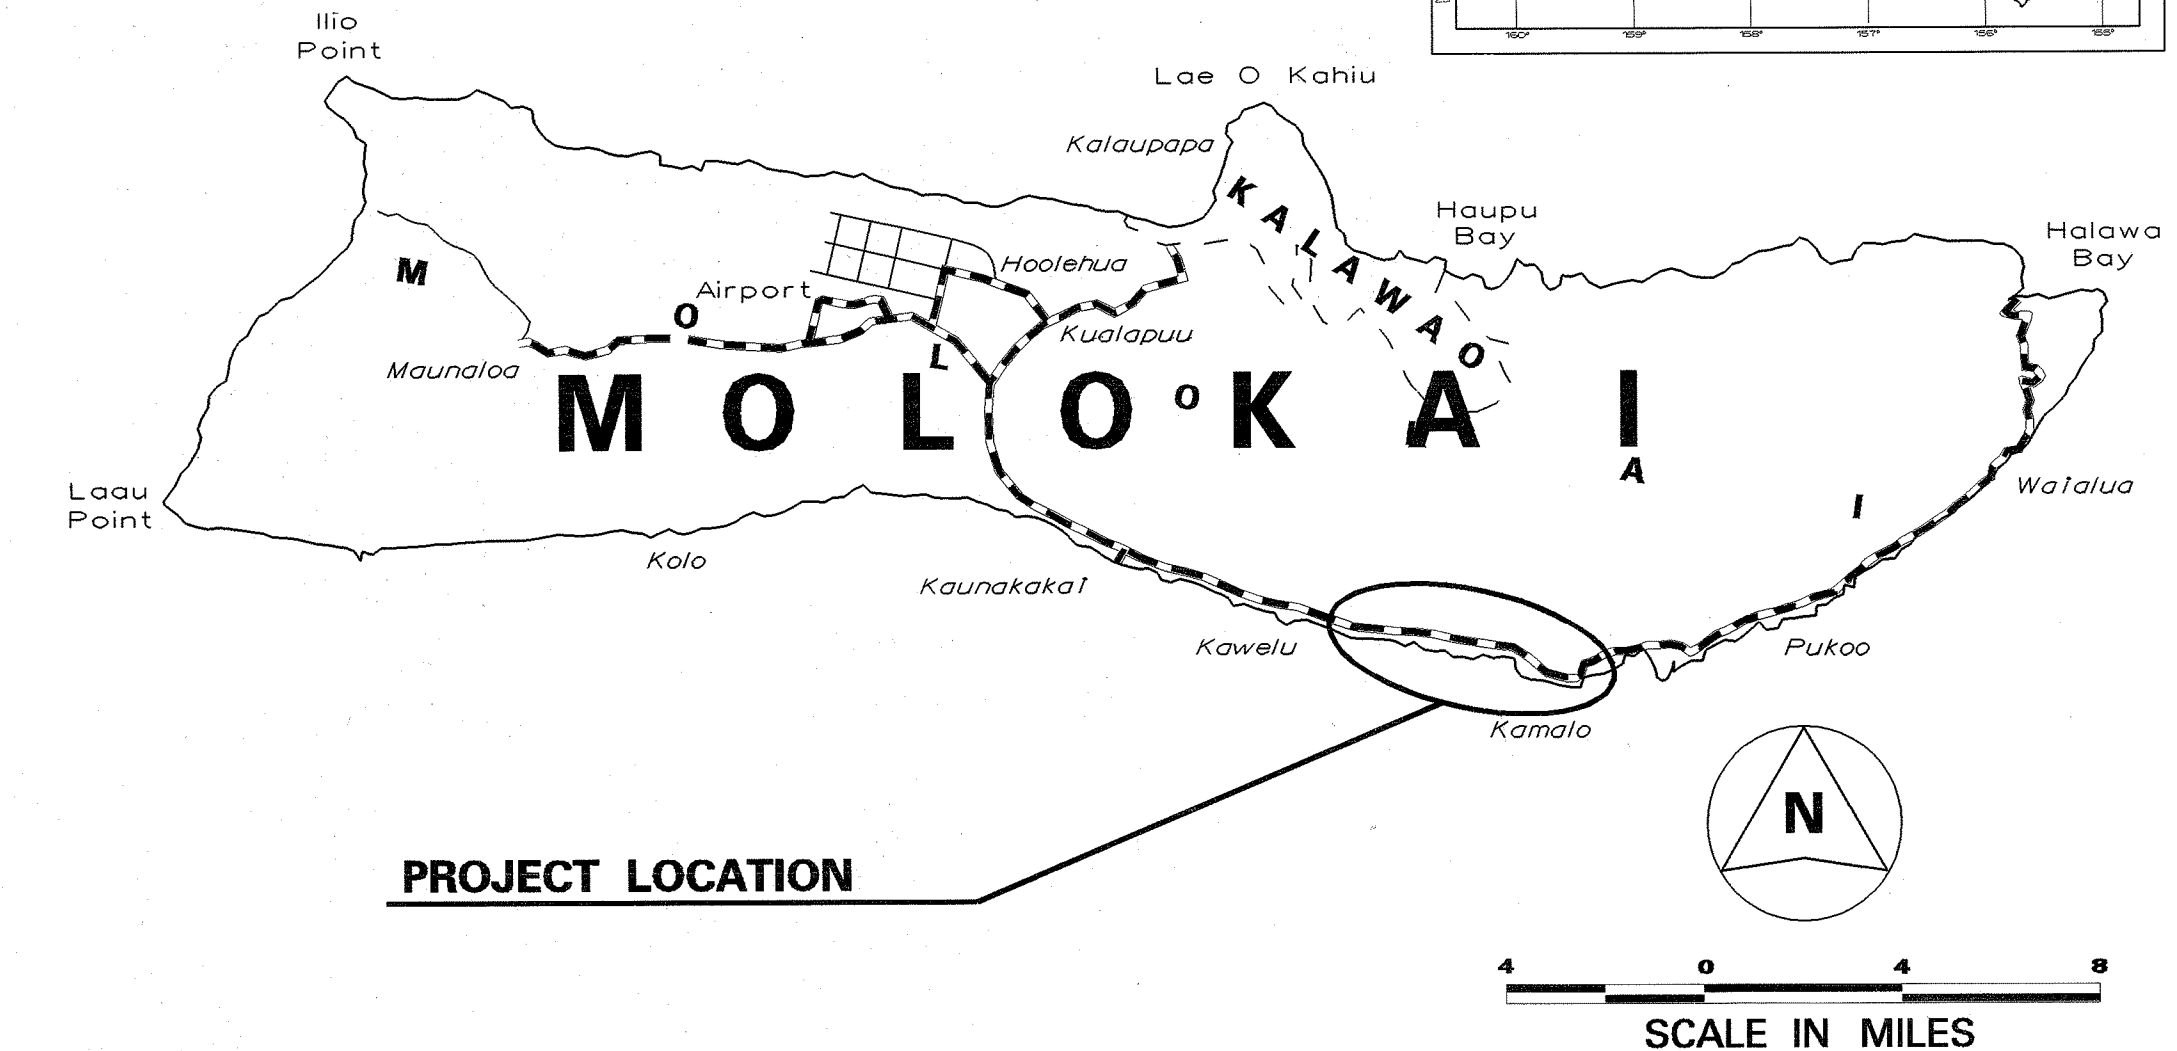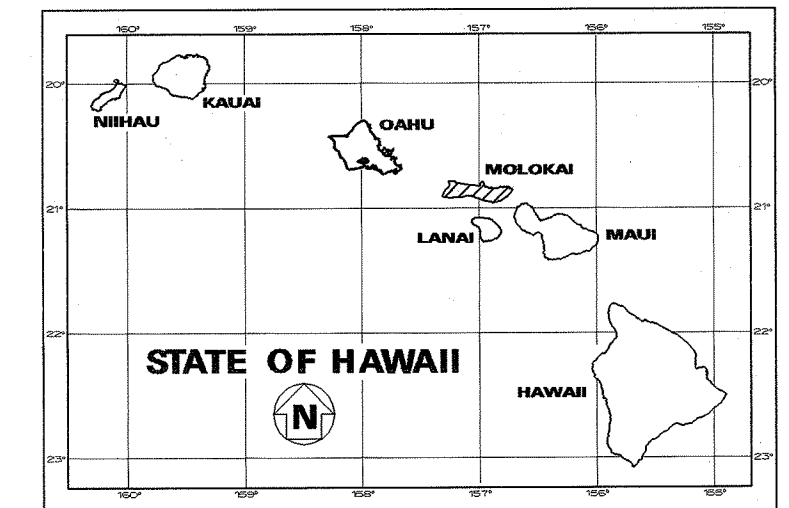

— FEDERALLY AIDED PROJECTS PREVIOUSLY CONSTRUCTED OR UNDER CONSTRUCTION

MILE POST 7.90 TO MILE POST 11.30

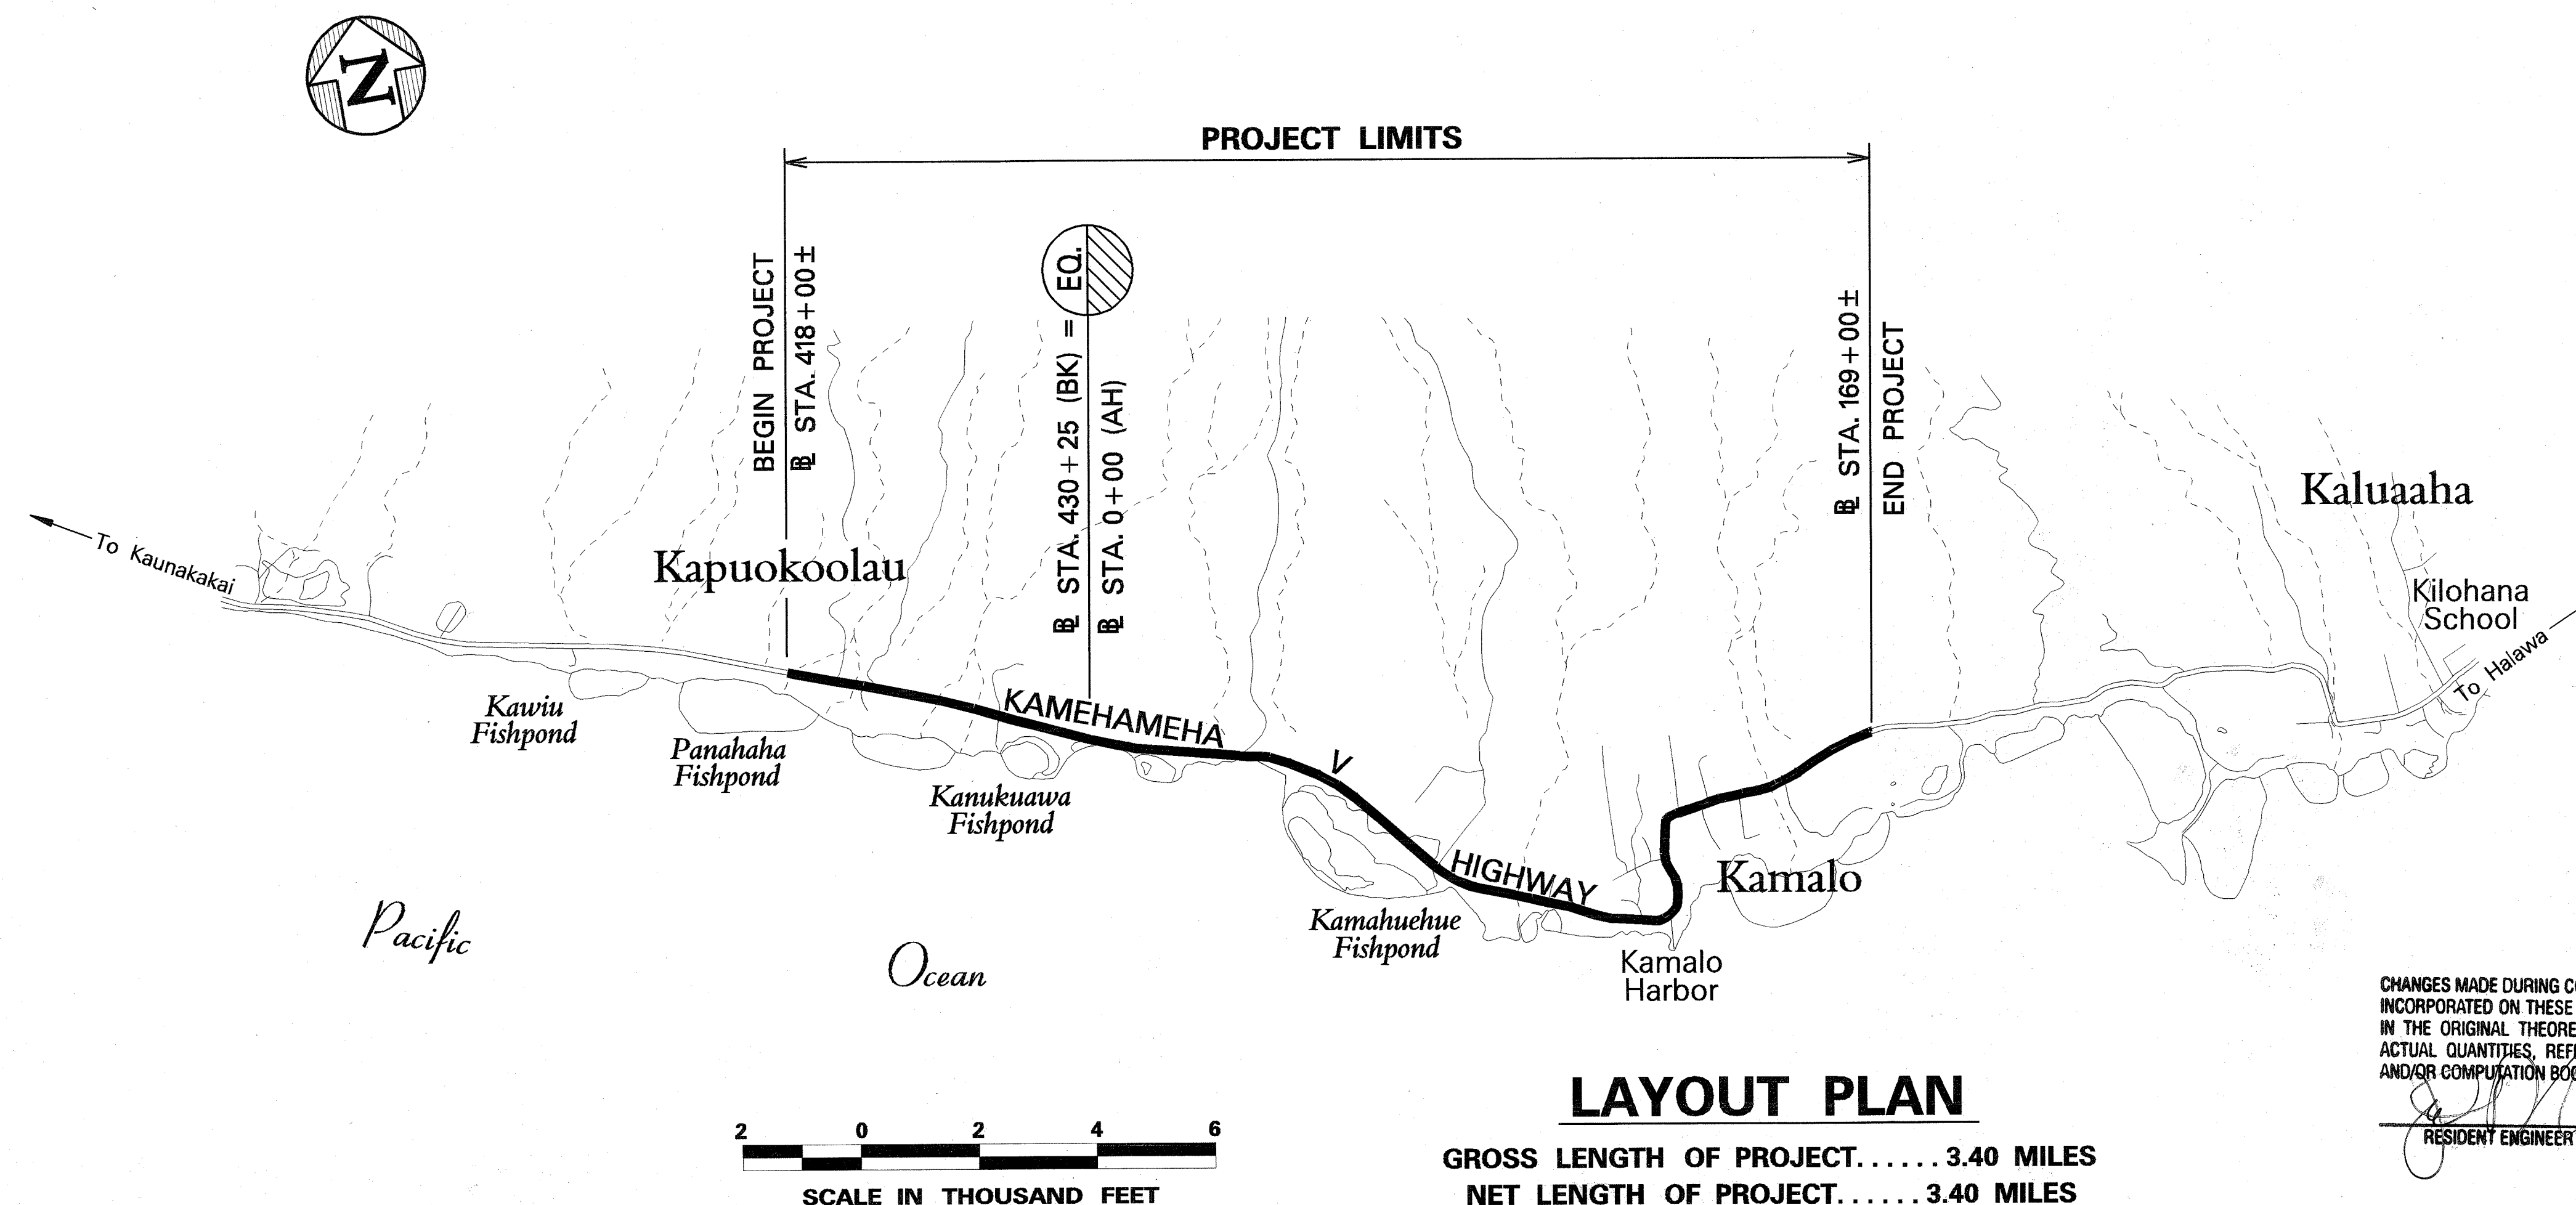

<u>DESIGN</u>	<u>DESIGNATION</u>
ADT (2006).....	1,760
ADT (2016).....	2,040
DHV	190 VPH
D	65/35
T (DESIGN)	7.5%
T ₂₄	4.0%

CHANGES MADE DURING CONSTRUCTION HAVE BEEN INCORPORATED ON THESE PLANS EXCEPT CHANGES IN THE ORIGINAL THEORETICAL QUANTITIES. FOR ACTUAL QUANTITIES, REFER TO PROJECT LEDGER AND/OR COMPUTATION BOOK.

RESIDENT ENGINEER 3-15-12
DATE

DEPARTMENT OF TRANSPORTATION STATE OF HAWAII

APPROVED: For Dinesh M. Gami 4-6-06
DIR. OF TRANSPORTATION DATE