



FED. ROAD DIST. NO.	STATE	FED. AID PROJ. NO.	FISCAL YEAR	SHEET NO.	TOTAL SHEETS
HAWAII	HAW.	BR-0450(8)	2011	11	93

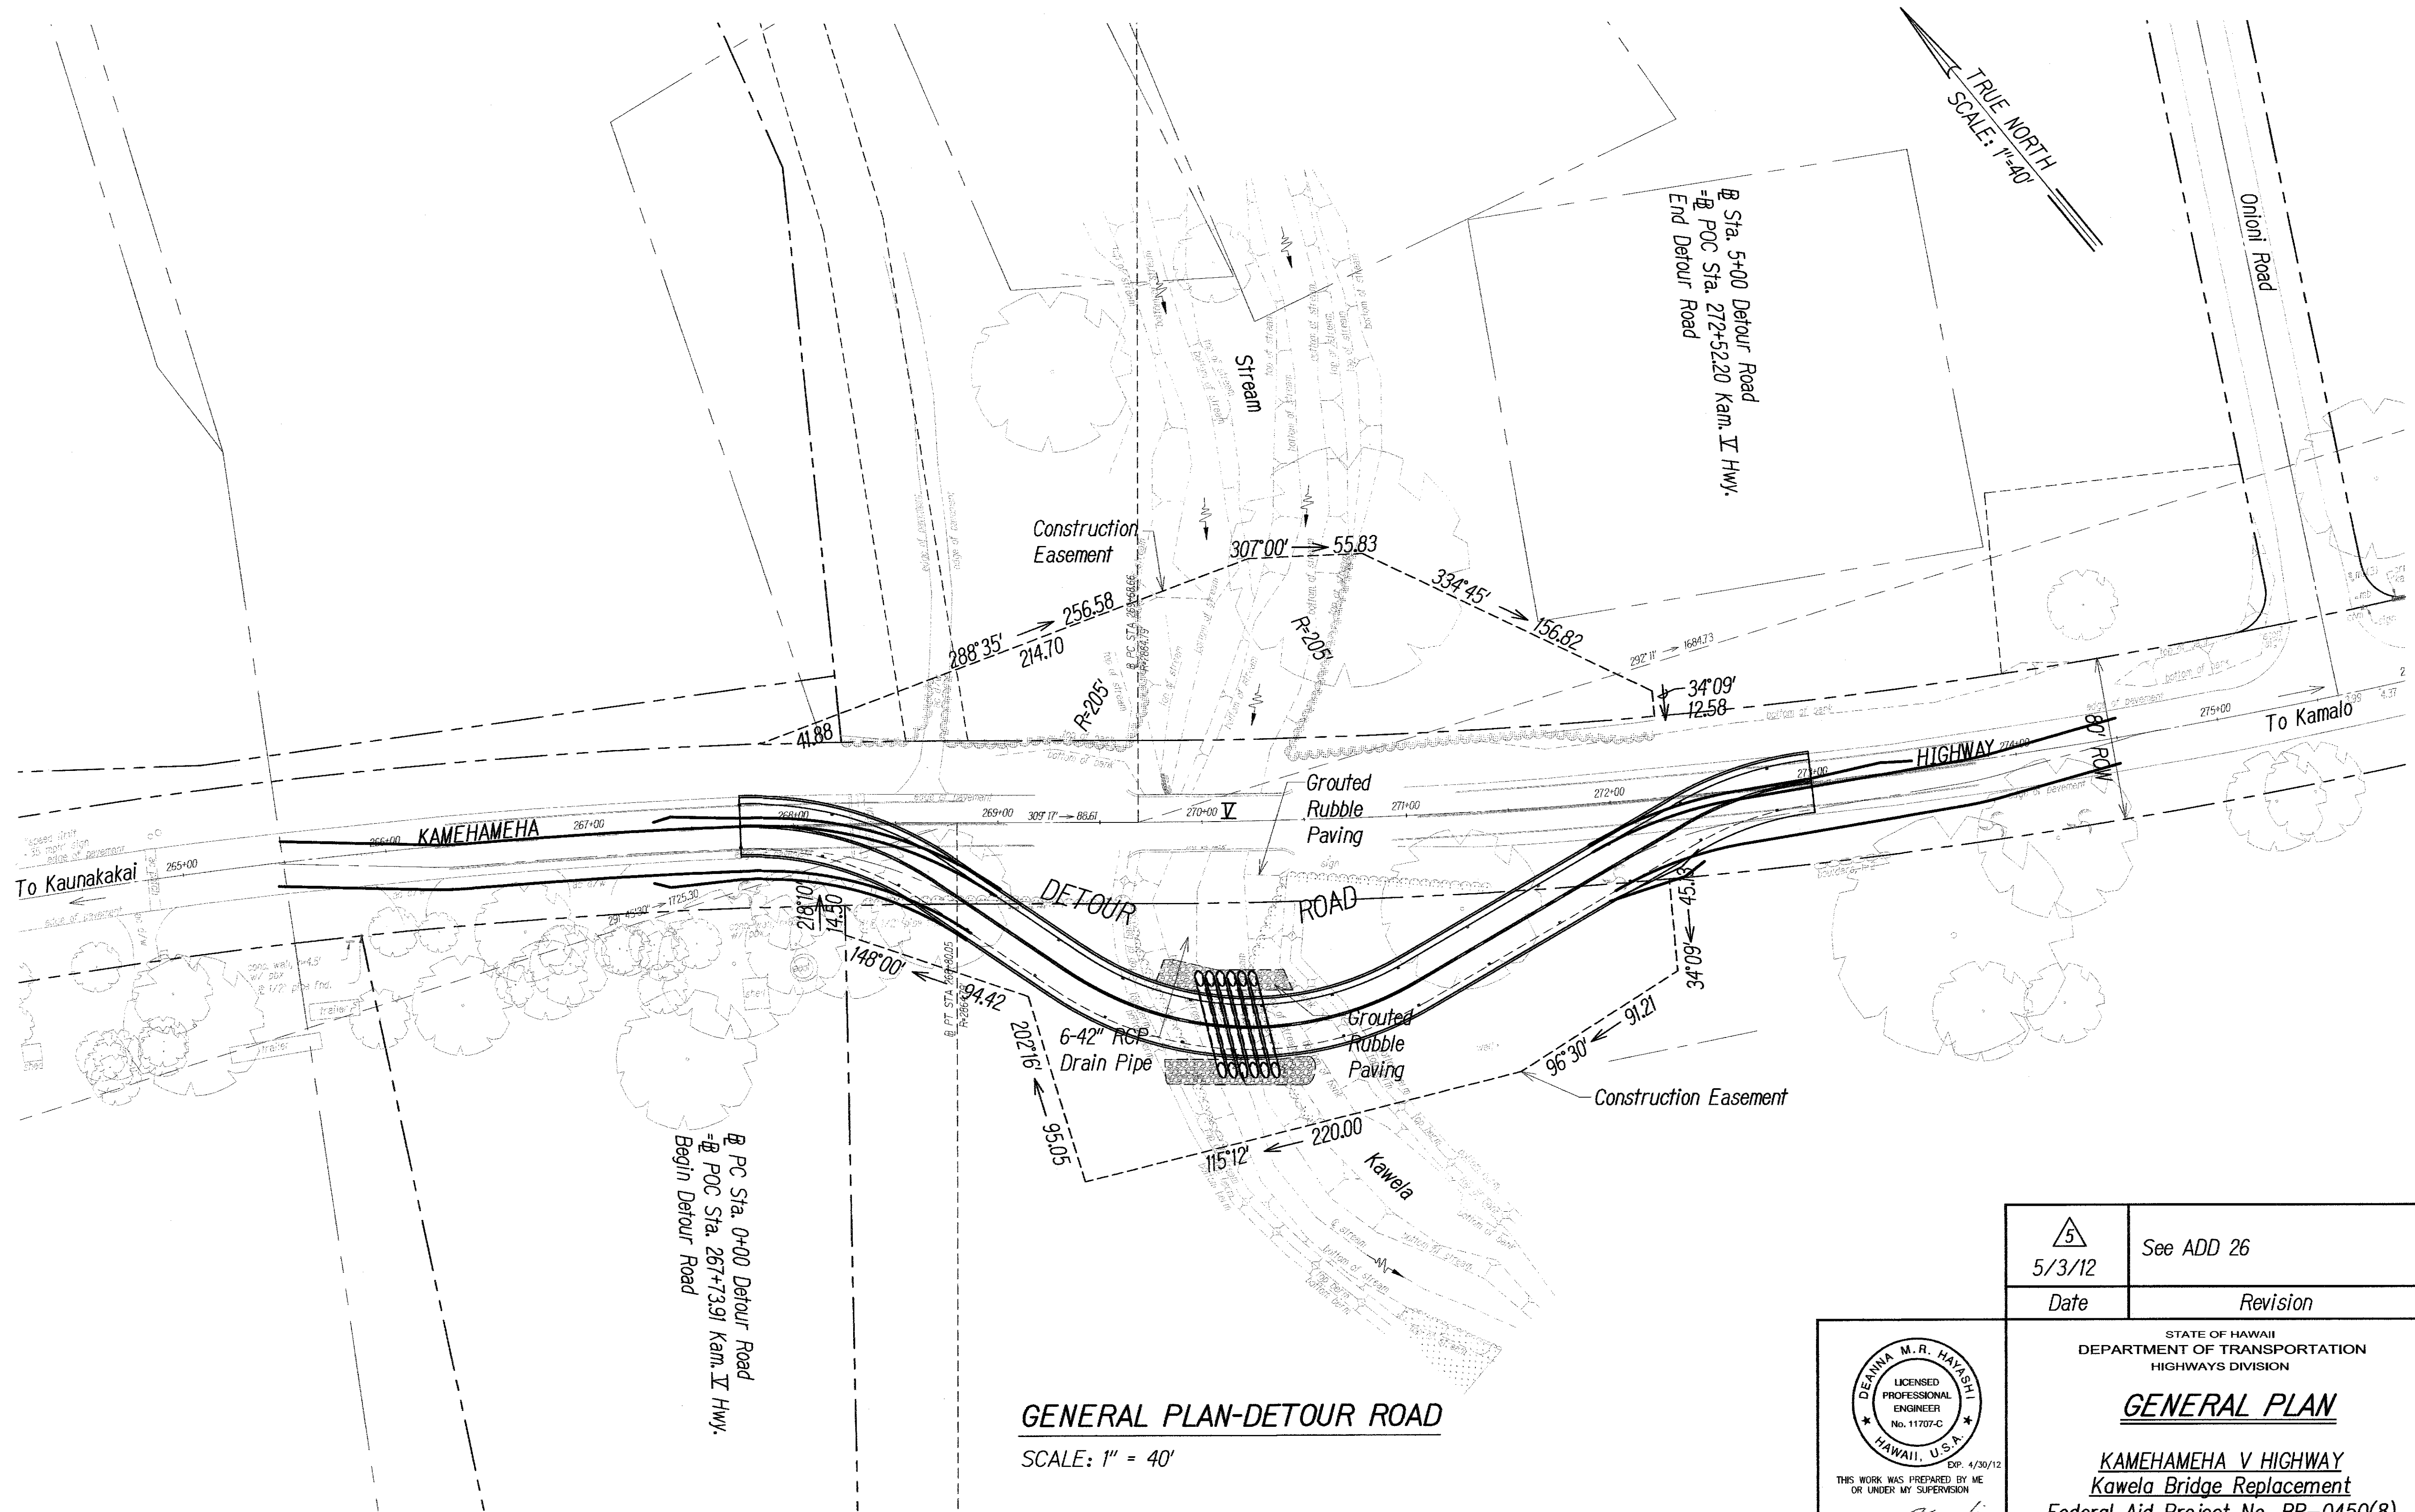


5/3/12	See ADD 26
Date	Revision

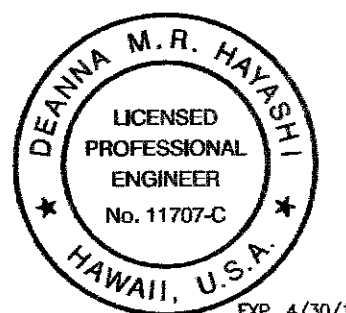

STATE OF HAWAII
 DEPARTMENT OF TRANSPORTATION
 HIGHWAYS DIVISION
GENERAL PLAN
 KAMEHAMEHA V HIGHWAY
 Kawela Bridge Replacement
 Federal Aid Project No. BR-0450(8)
 Scale: AS NOTED Date: Oct. 2010

FED. ROAD DIST. NO.	STATE	FED. AID PROJ. NO.	FISCAL YEAR	SHEET NO.	TOTAL SHEETS
HAWAII	HAW.	BR-0450(8)	2011	C.O. 12	93

CURVE DATA						
NO.	Δ	Δ/2	R	T	Ch	Lc
①	35°03'00"	17°31'30"	2,864.79'	904.64'	1725.30'	1752.50'
②	34°12'00"	17°06'00"	2,864.79'	881.32'	1684.73'	1710.00'

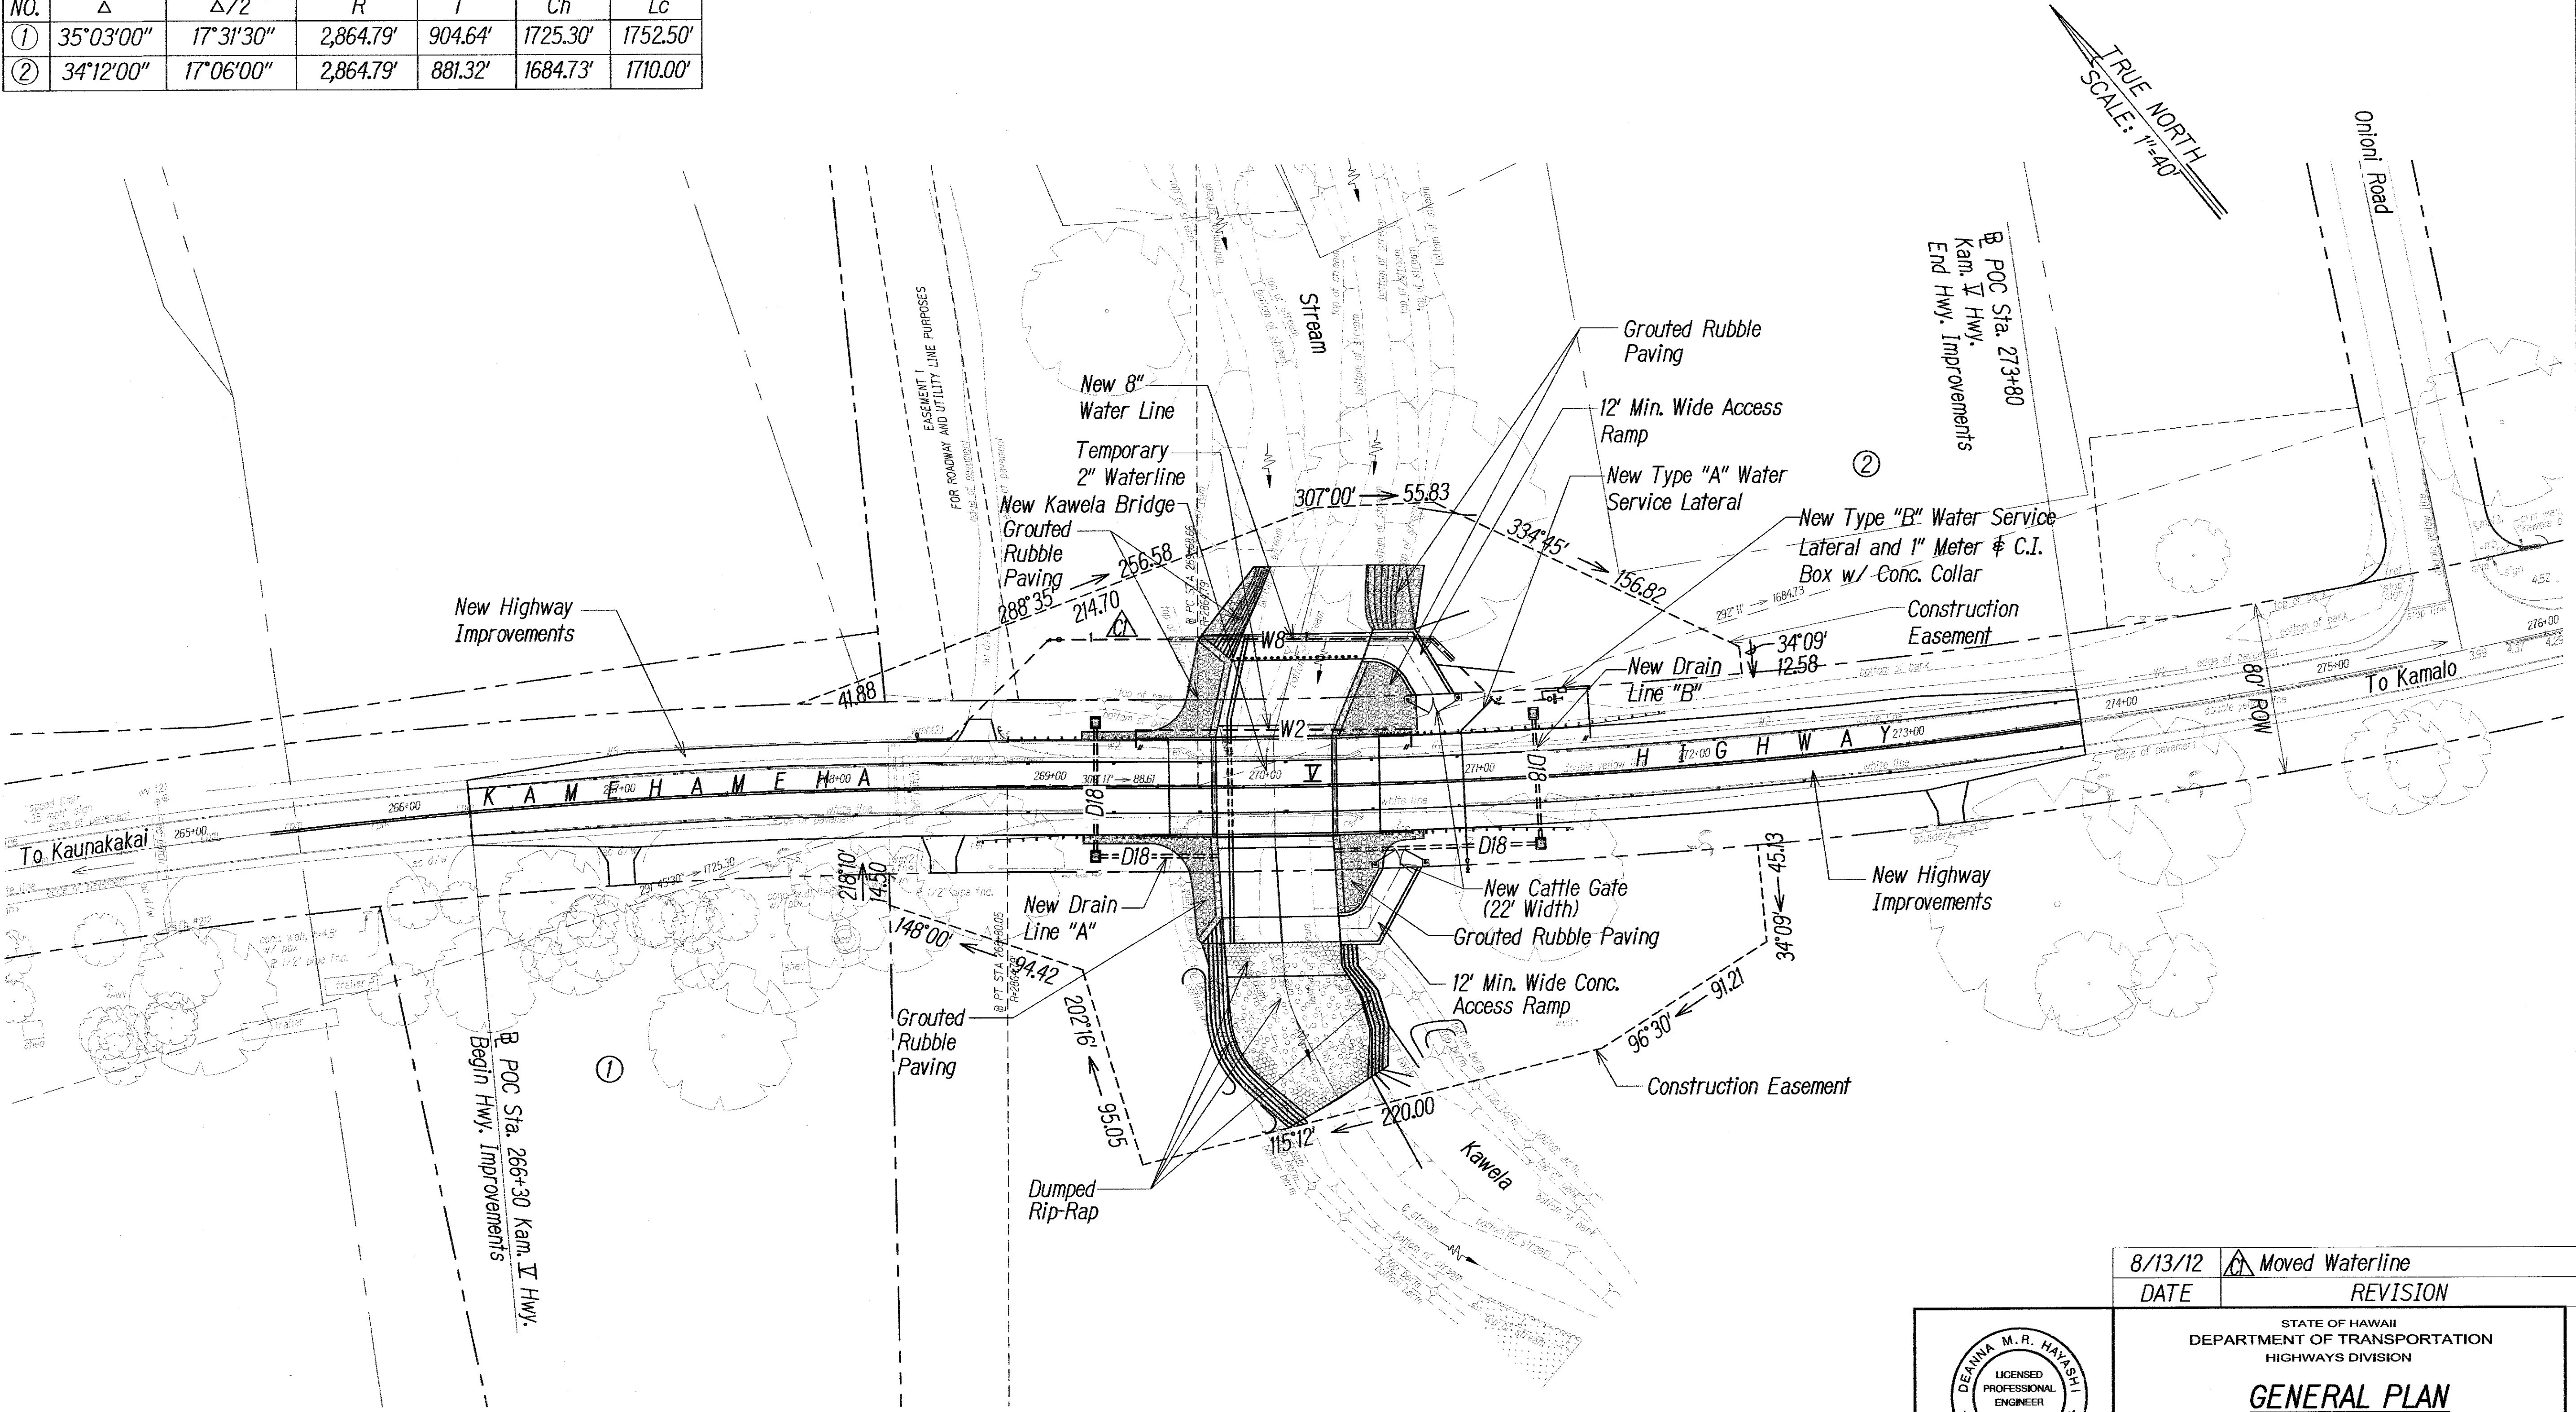

GENERAL PLAN-KAM. V HWY.
SCALE: 1" = 40'

8/13/12

DATE

Moved Waterline

REVISION

STATE OF HAWAII

DEPARTMENT OF TRANSPORTATION

HIGHWAYS DIVISION

GENERAL PLAN

KAMEHAMEHA V HIGHWAY

Kawela Bridge Replacement

Federal Aid Project No. BR-0450(8)

Scale: AS NOTED




Date: Oct. 2010

SHEET No. C/11 OF 93 SHEETS


C.O. 12

"AS-BUILT"

FED. ROAD DIST. NO.	STATE	FED. AID PROJ. NO.	FISCAL YEAR	SHEET NO.	TOTAL SHEETS
HAWAII	HAW.	BR-0450(8)	2011	ADD.13	93

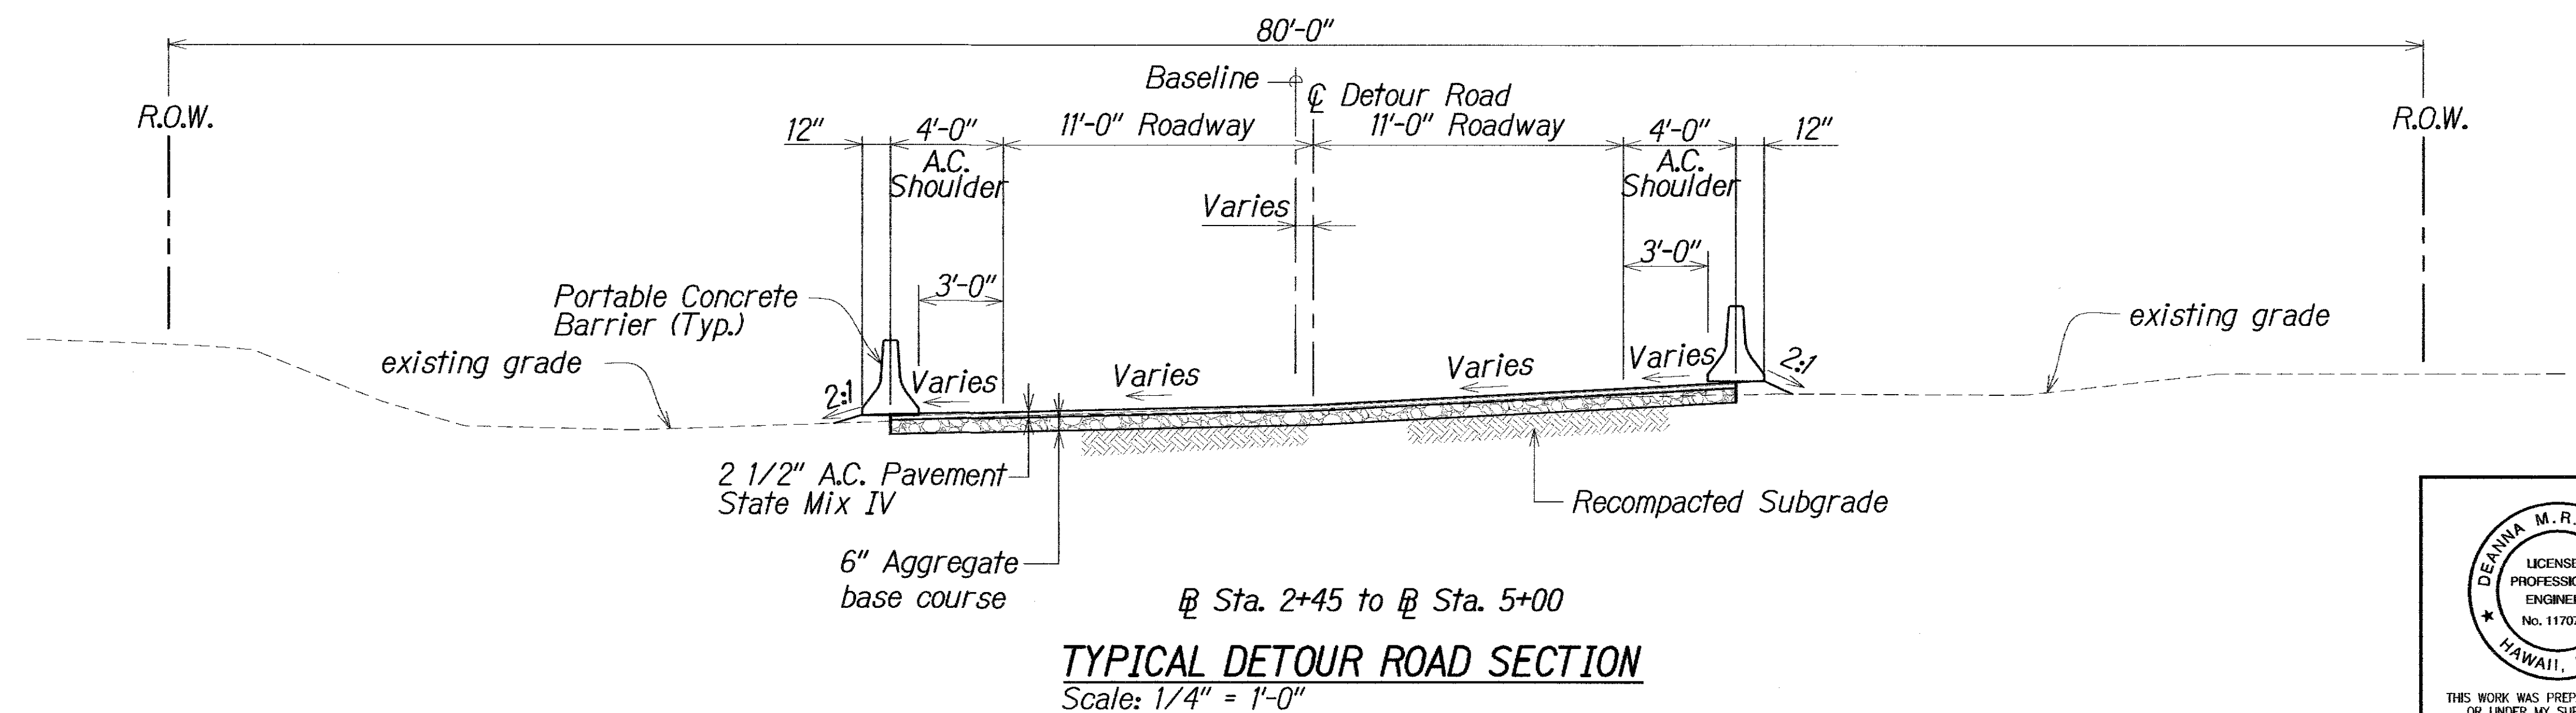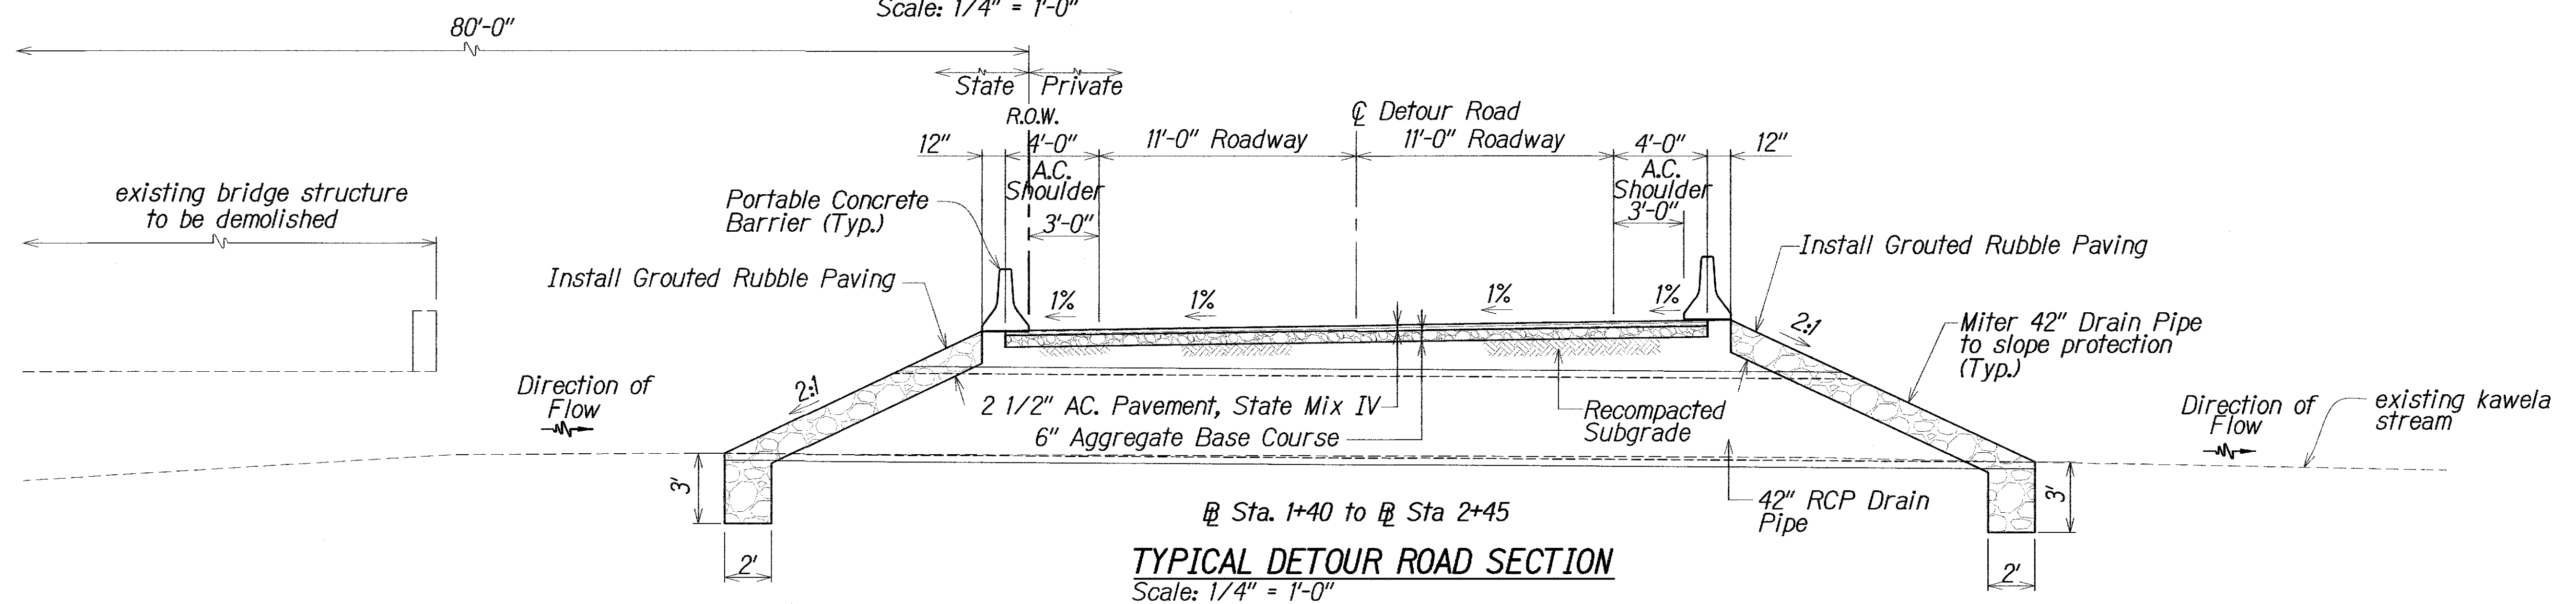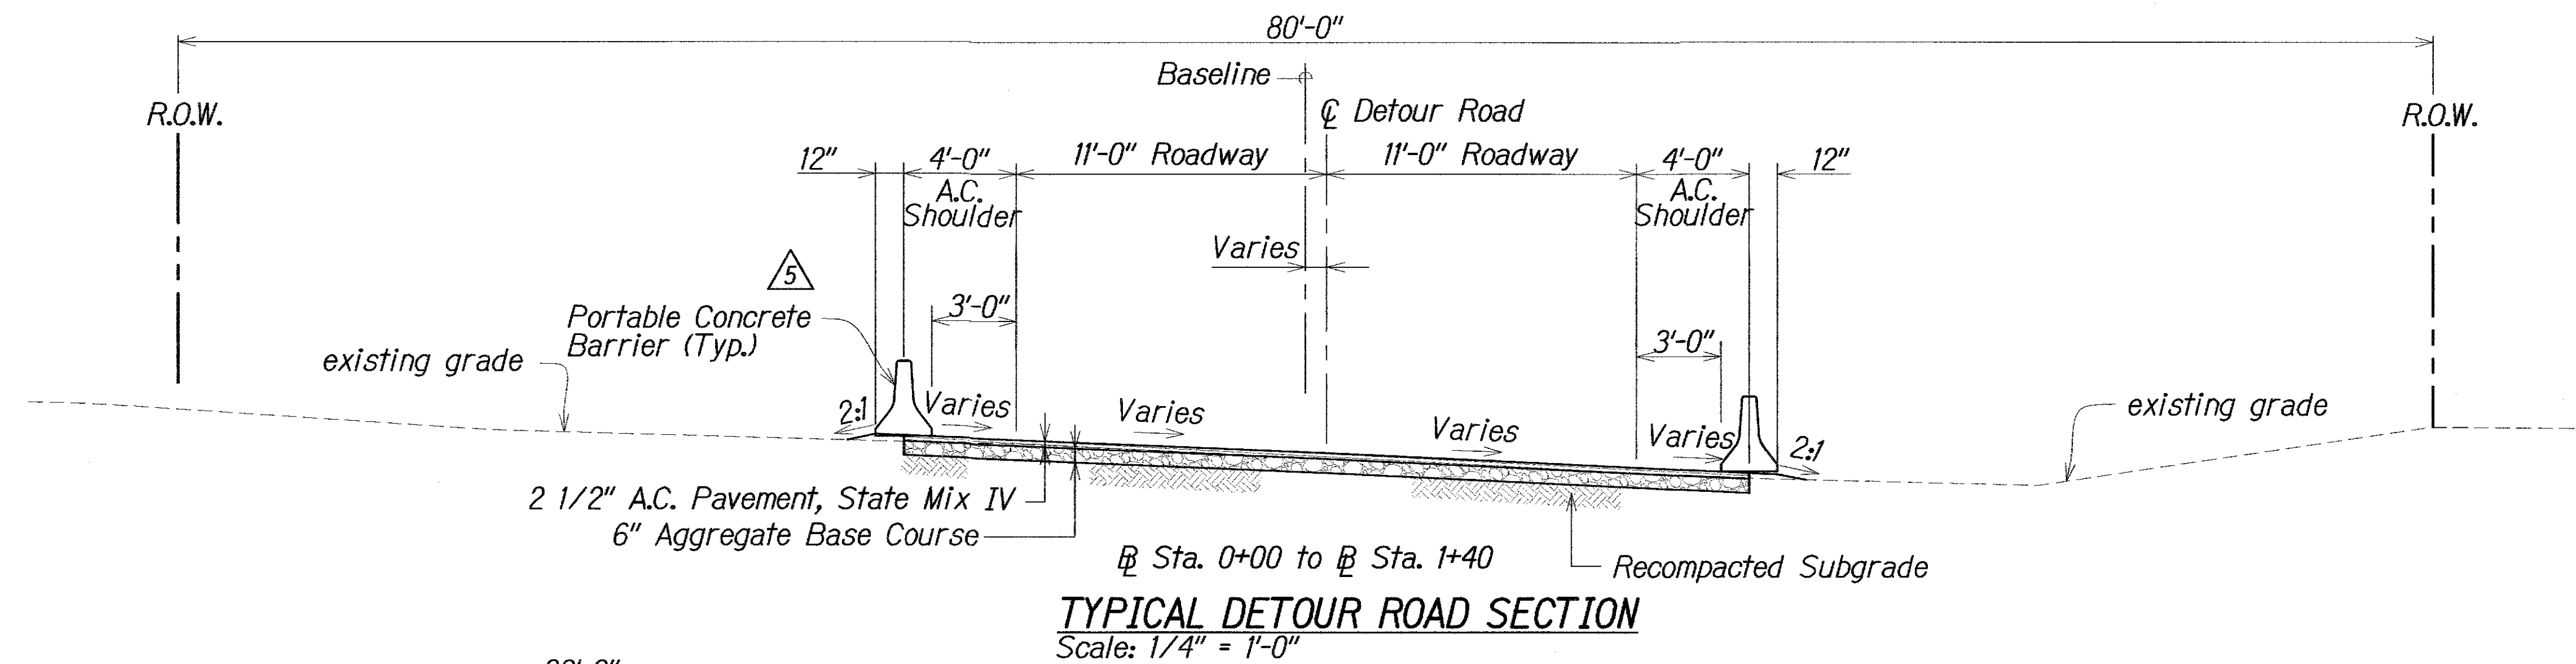

5/3/12	Added Portable Concrete Barrier to section
Date	Revision

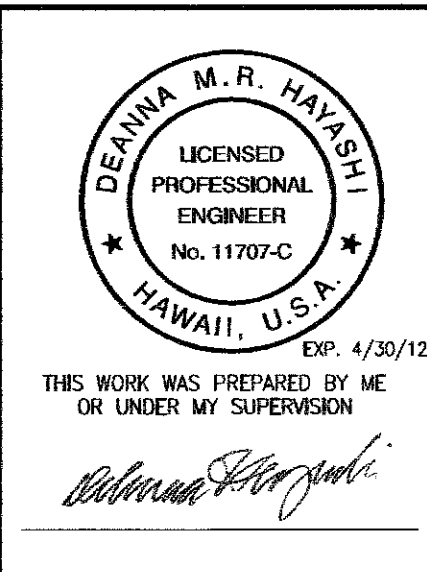

STATE OF HAWAII
DEPARTMENT OF TRANSPORTATION
HIGHWAYS DIVISION

TYPICAL ROAD SECTIONS

KAMEHAMEHA V HIGHWAY
Kawela Bridge Replacement
Federal Aid Project No. BR-0450(8)


Scale: AS NOTED Date: Oct. 2010

SHEET No. C112 OF 93 SHEETS


"AS-BUILT"

ADD. 13


FED. ROAD DIST. NO.	STATE	FED. AID PROJ. NO.	FISCAL YEAR	SHEET NO.	TOTAL SHEETS
HAWAII	HAW.	BR-0450(8)	2011	14	93

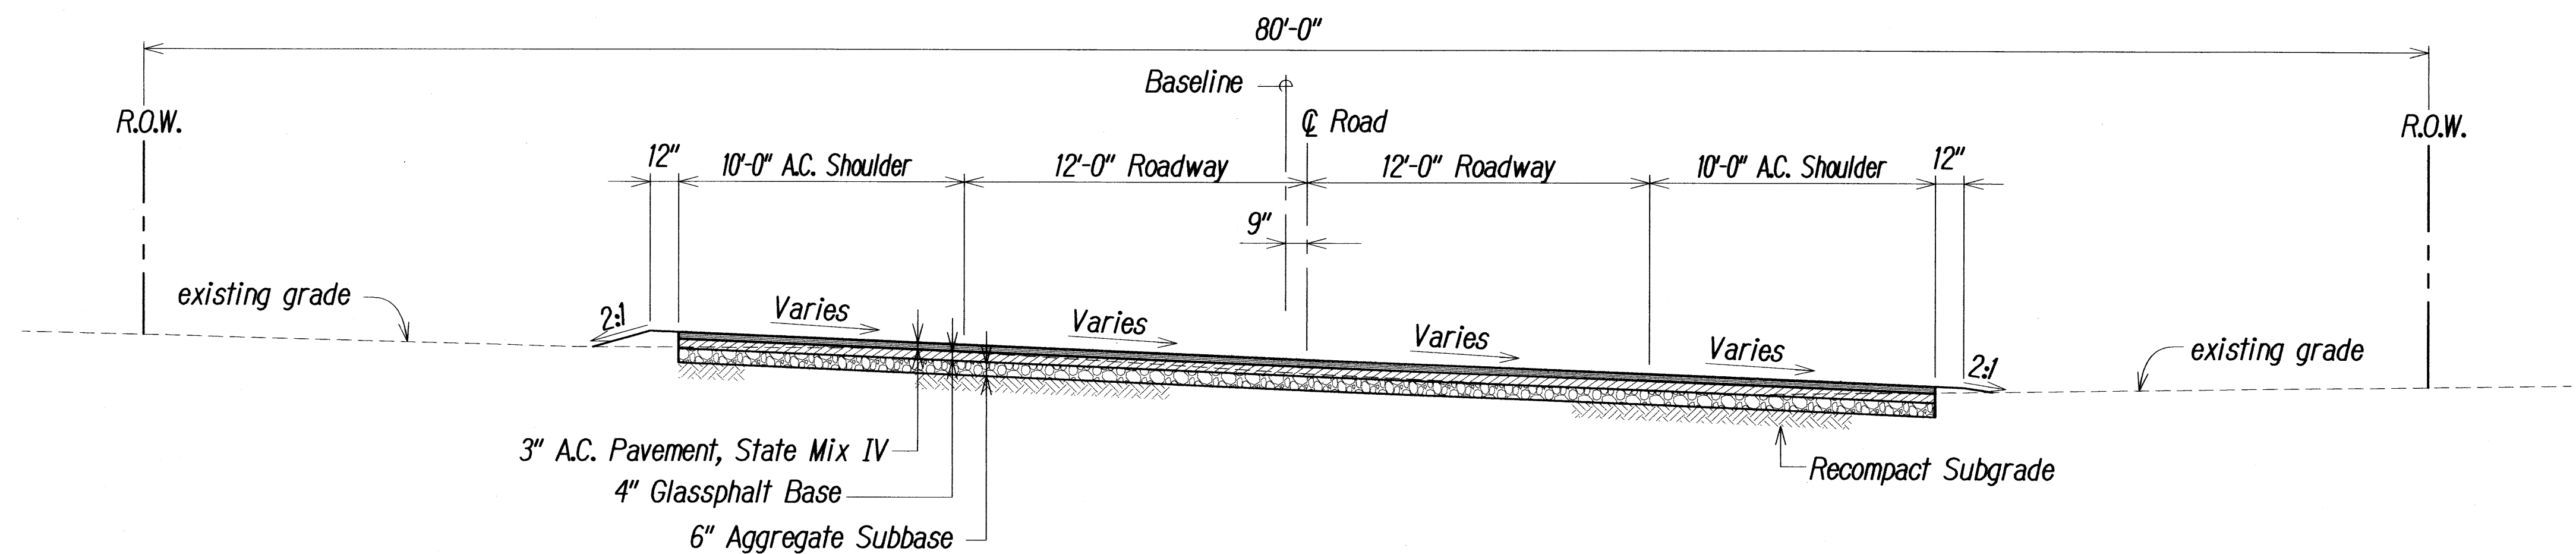

Sta. 266+30 to Sta. 268+60
TYPICAL ROAD SECTION
 Scale: 1/4" = 1'-0"

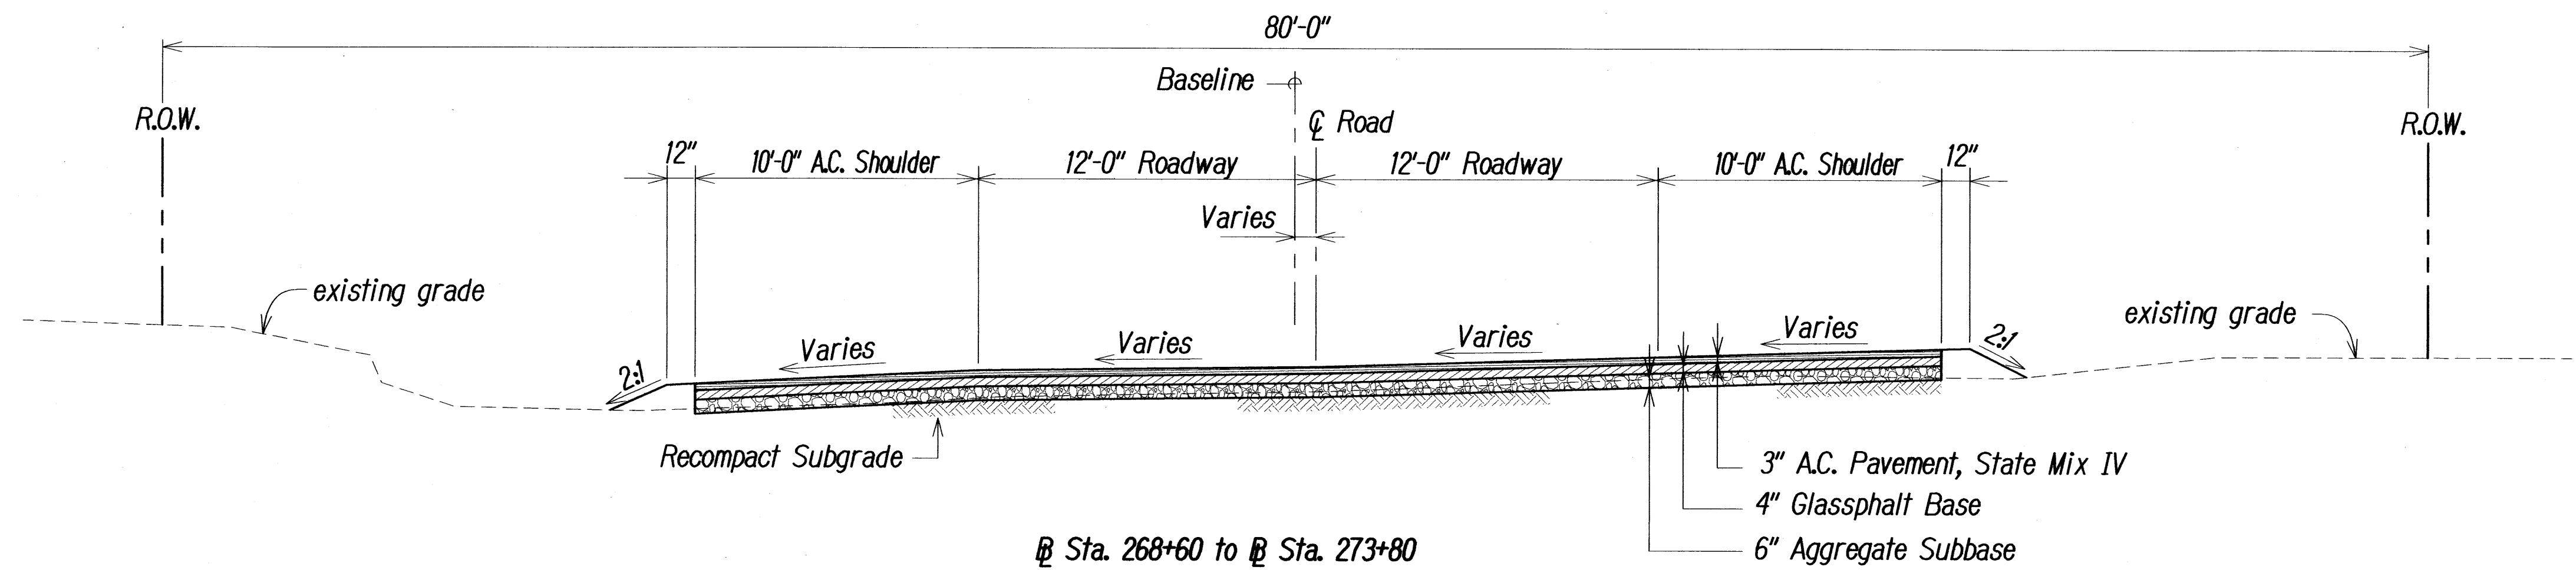

Sta. 268+60 to Sta. 273+80
TYPICAL ROAD SECTION
 Scale: 1/4" = 1'-0"

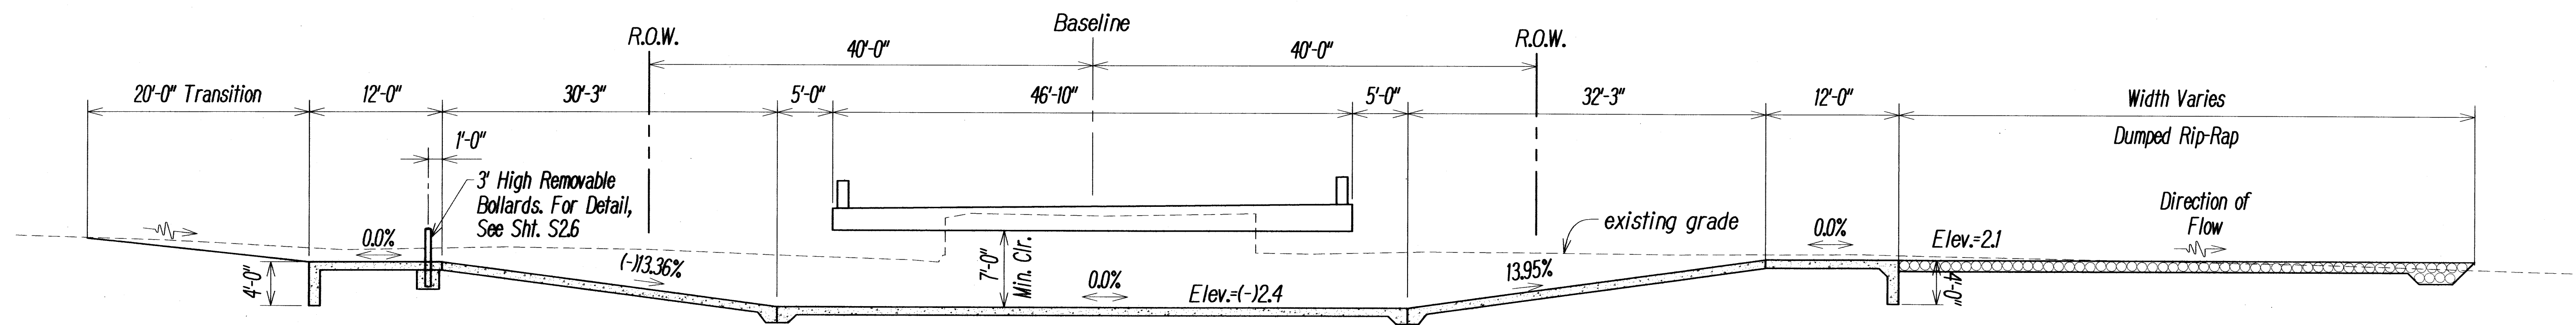

TYPICAL BRIDGE SECTION
 Scale: 1/8" = 1'-0"

DEANNA M.R. HAYASHI
 LICENSED PROFESSIONAL ENGINEER
 No. 11707-C
 HAWAII, U.S.A.

STATE OF HAWAII
 DEPARTMENT OF TRANSPORTATION
 HIGHWAYS DIVISION

TYPICAL ROAD SECTIONS

KAMEHAMEHA V HIGHWAY
 Kawela Bridge Replacement
 Federal Aid Project No. BR-0450(8)

Scale: AS NOTED Date: Oct. 2010