



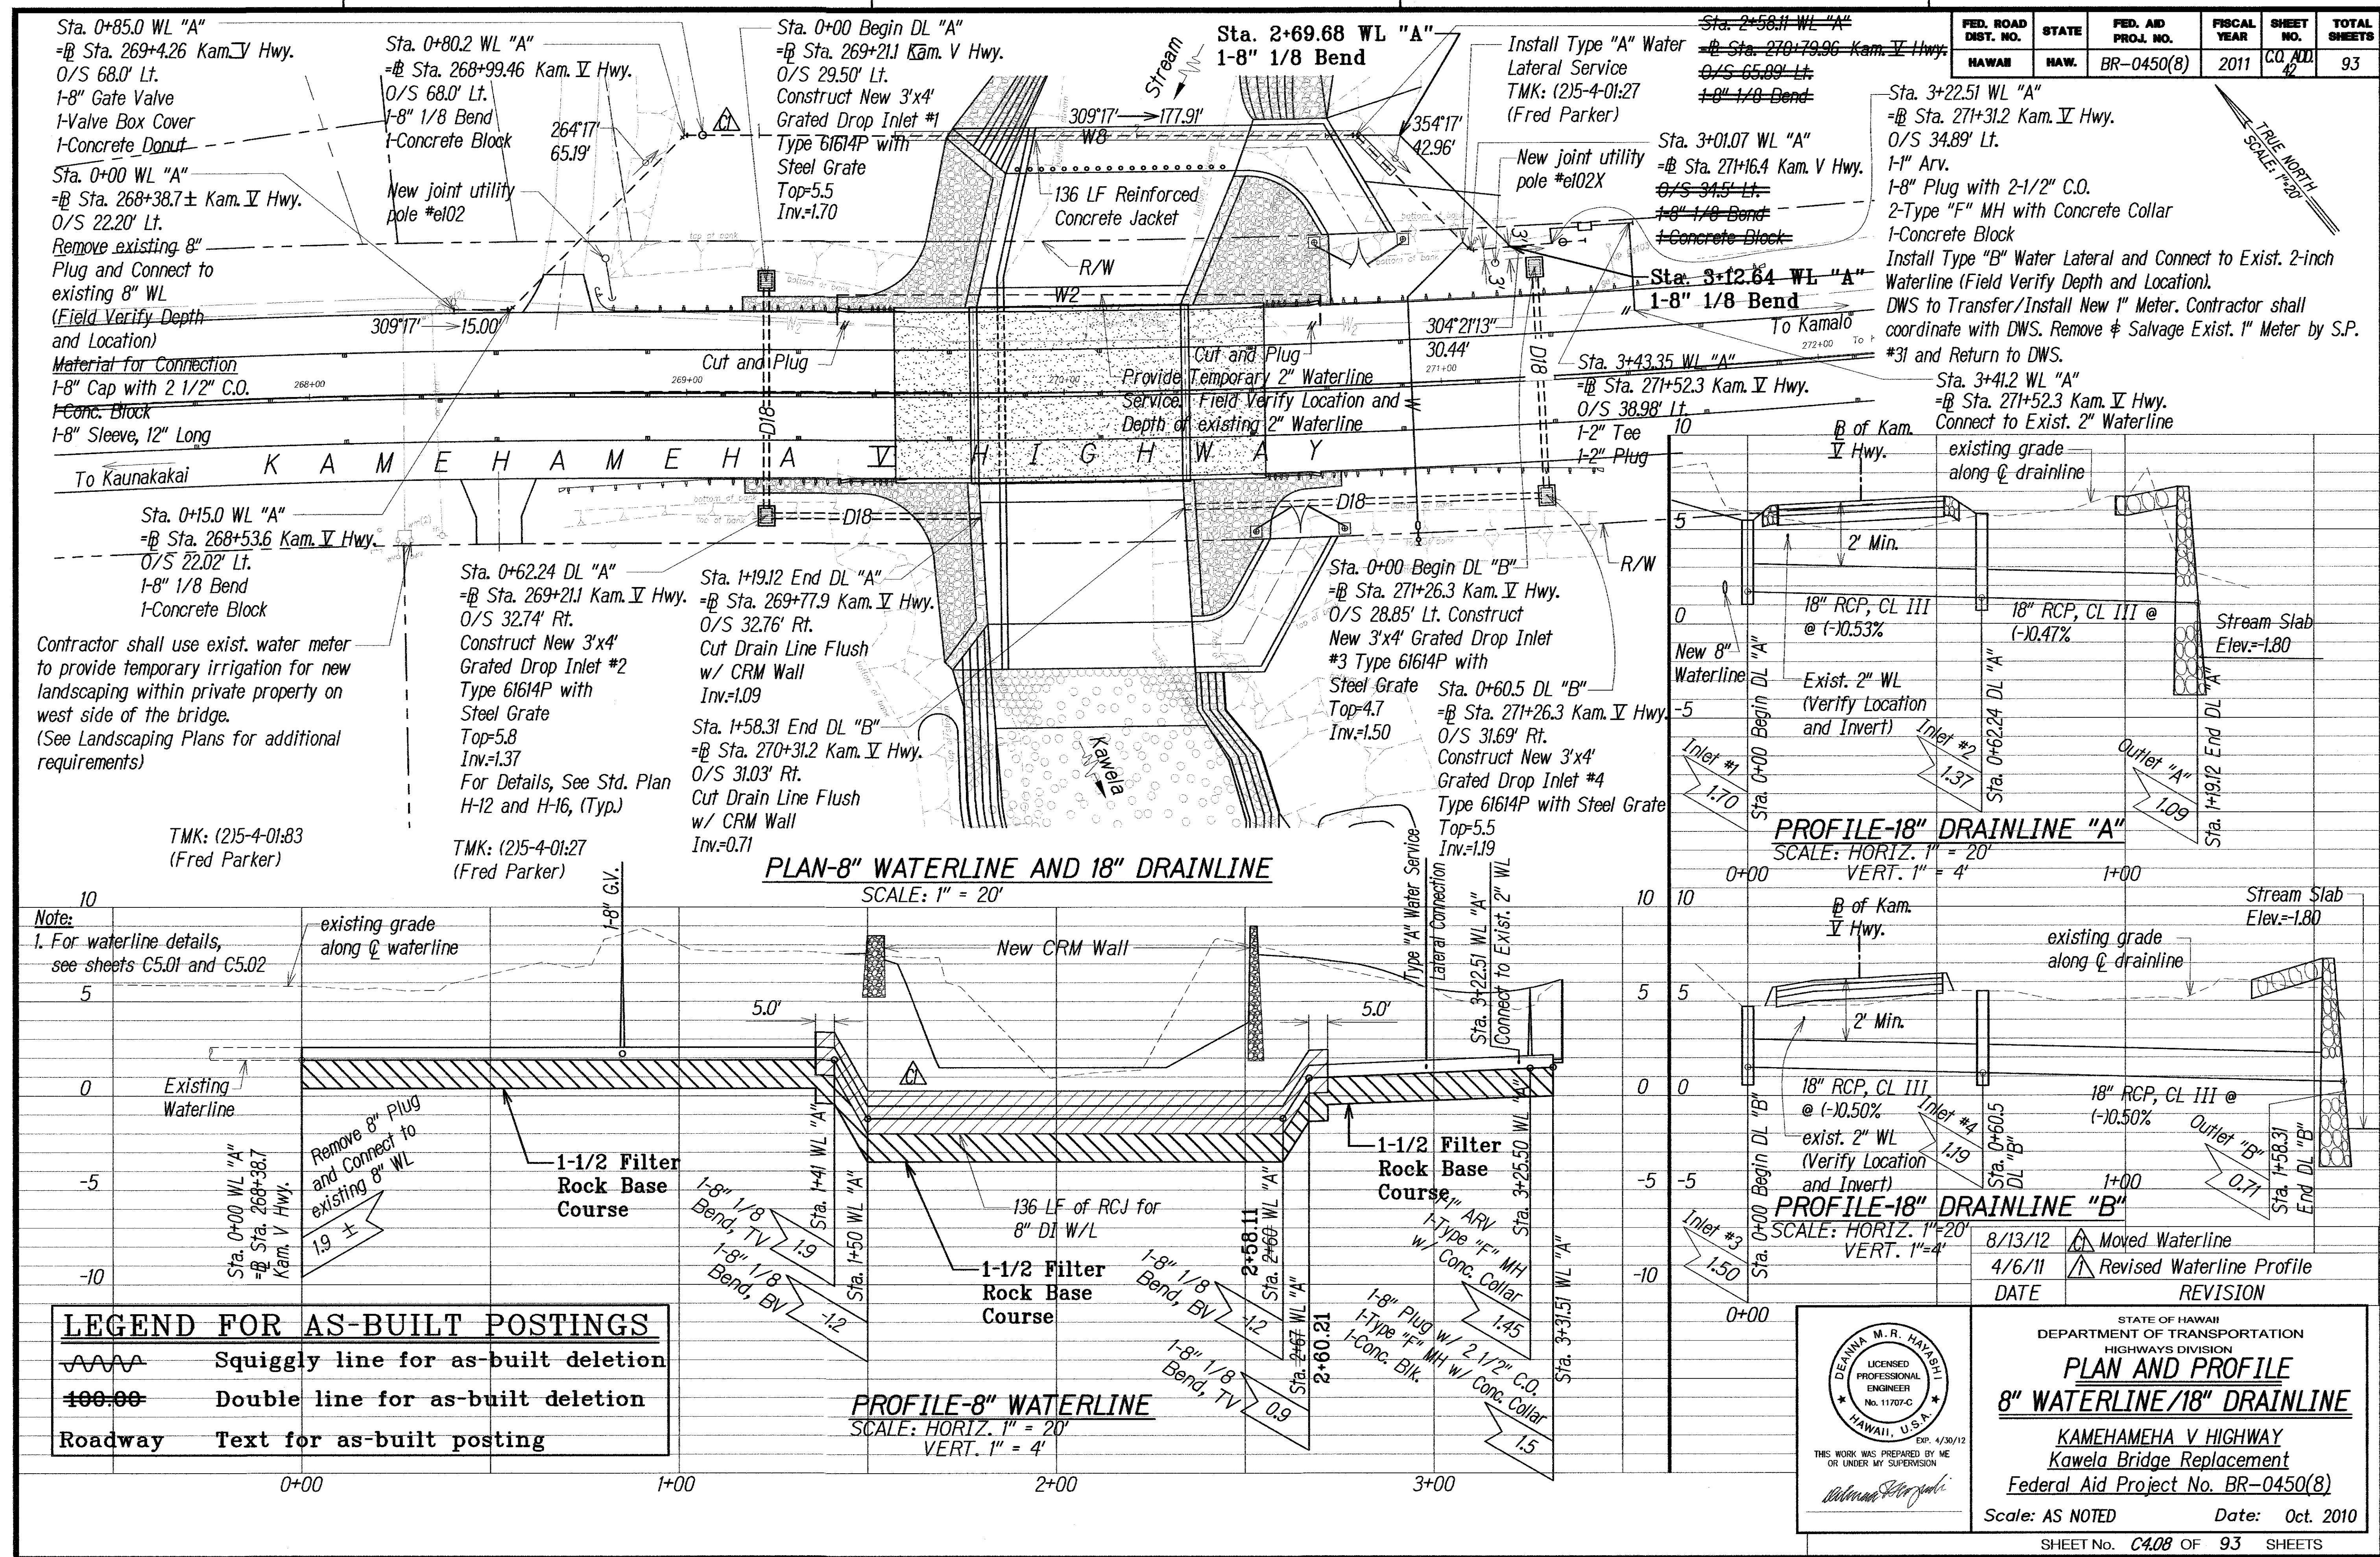

FED. ROAD DIST. NO.	STATE	FED. AID PROJ. NO.	FISCAL YEAR	SHEET NO.	TOTAL SHEETS
HAWAII	HAW.	BR-0450(8)	2011	C.O. ADD. 42	93

LEGEND FOR AS-BUILT POSTINGS	
	Squiggly line for as-built deletion
	Double line for as-built deletion
	Roadway Text for as-built posting

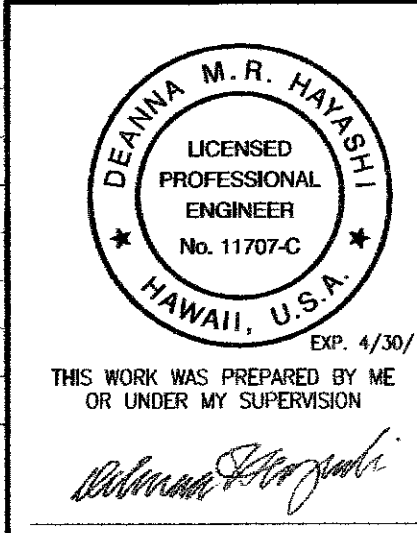

STATE OF HAWAII
DEPARTMENT OF TRANSPORTATION
HIGHWAYS DIVISION

PLAN AND PROFILE
8" WATERLINE/18" DRAINLINE

KAMEHAMEHA V HIGHWAY
Kawela Bridge Replacement
Federal Aid Project No. BR-0450(8)

Scale: AS NOTED Date: Oct. 2010

SHEET No. C408 OF 93 SHEETS