

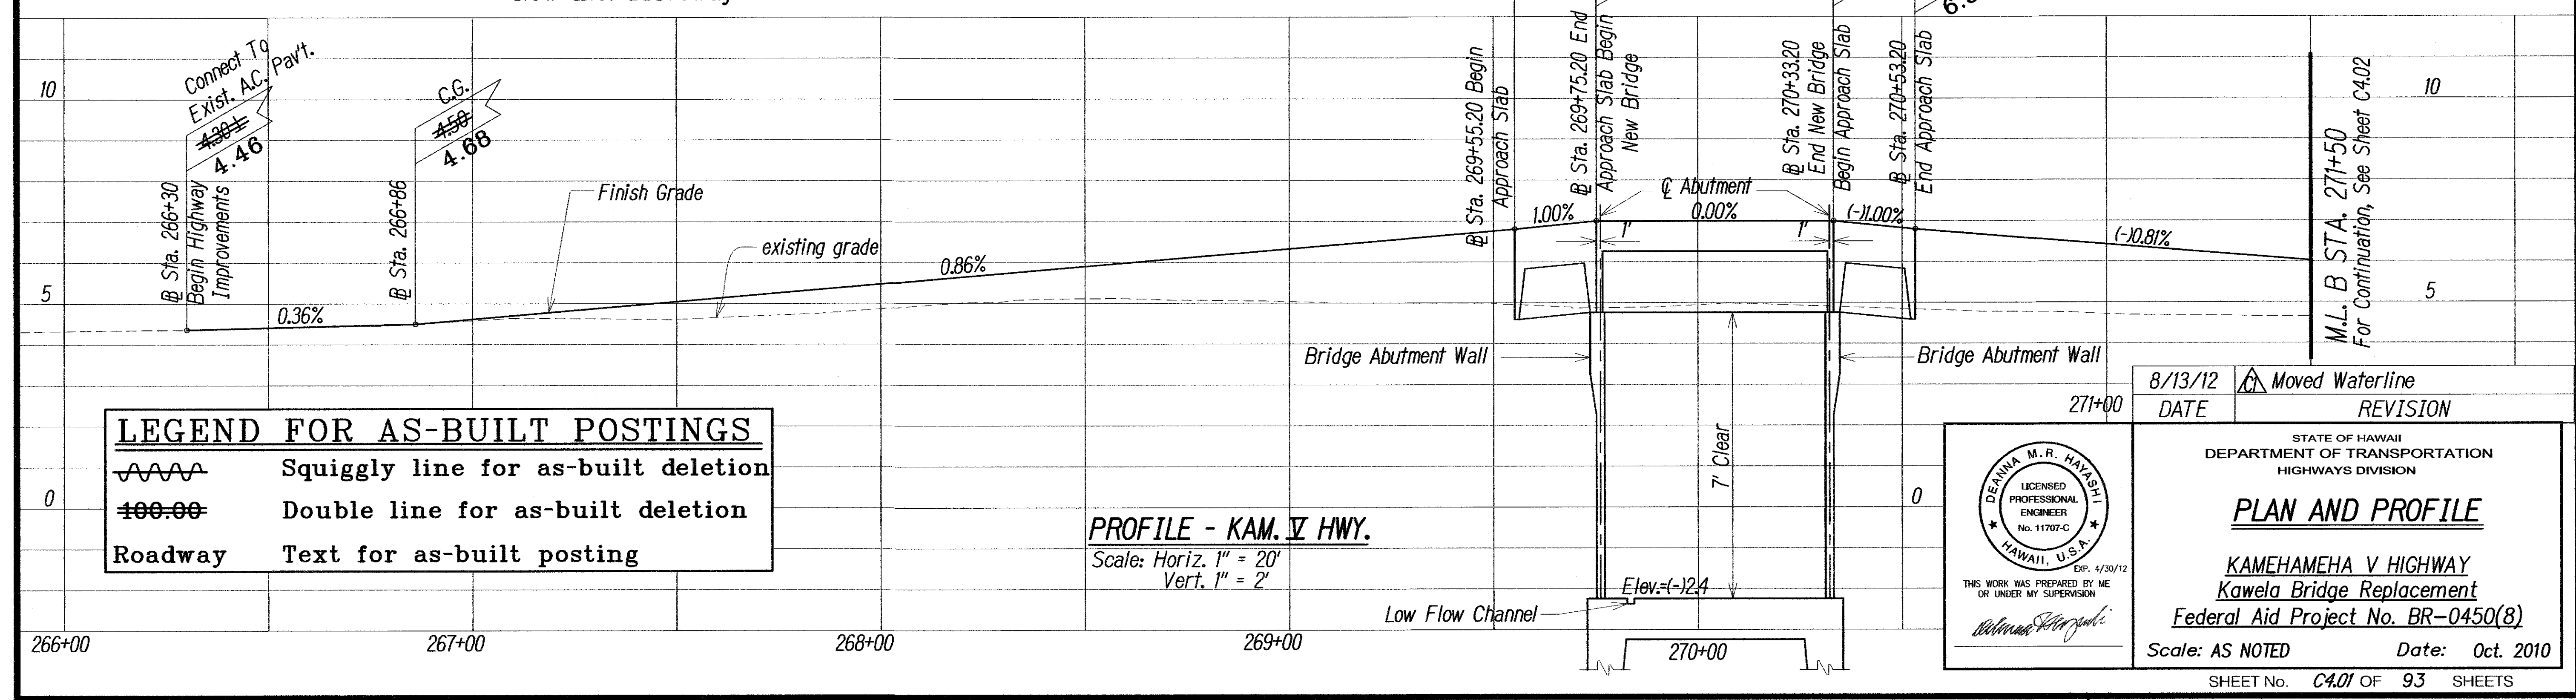


FED. ROAD DIST. NO.	STATE	FED. AID PROJ. NO.	FISCAL YEAR	SHEET NO.	TOTAL SHEETS
HAWAII	HAW.	BR-0450(8)	2011	C.O. 35	93

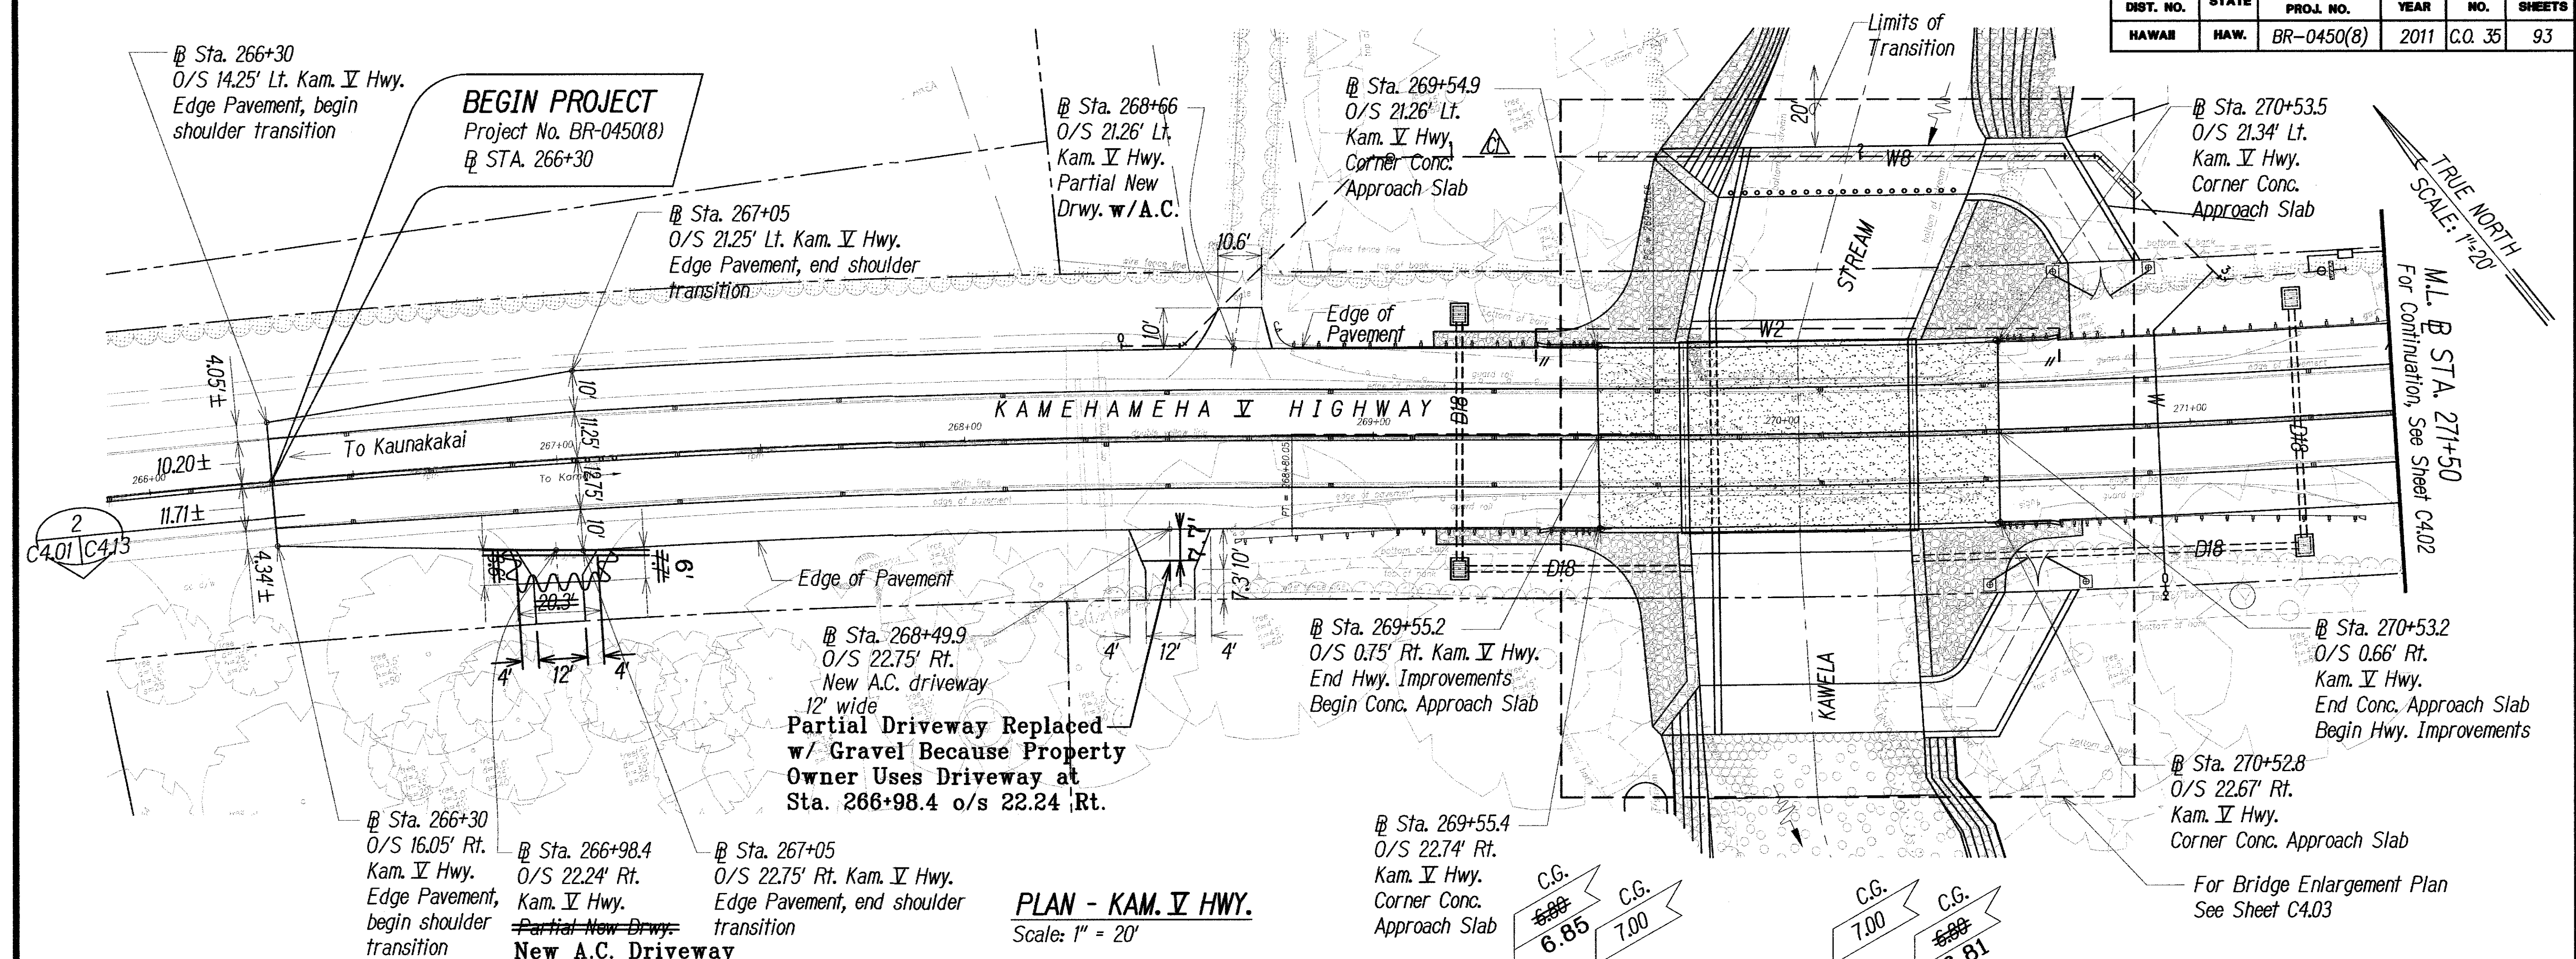


FED. ROAD DIST. NO.	STATE	FED. AID PROJ. NO.	FISCAL YEAR	SHEET NO.	TOTAL SHEETS
HAWAII	HAW.	BR-0450(8)	2011	36	93

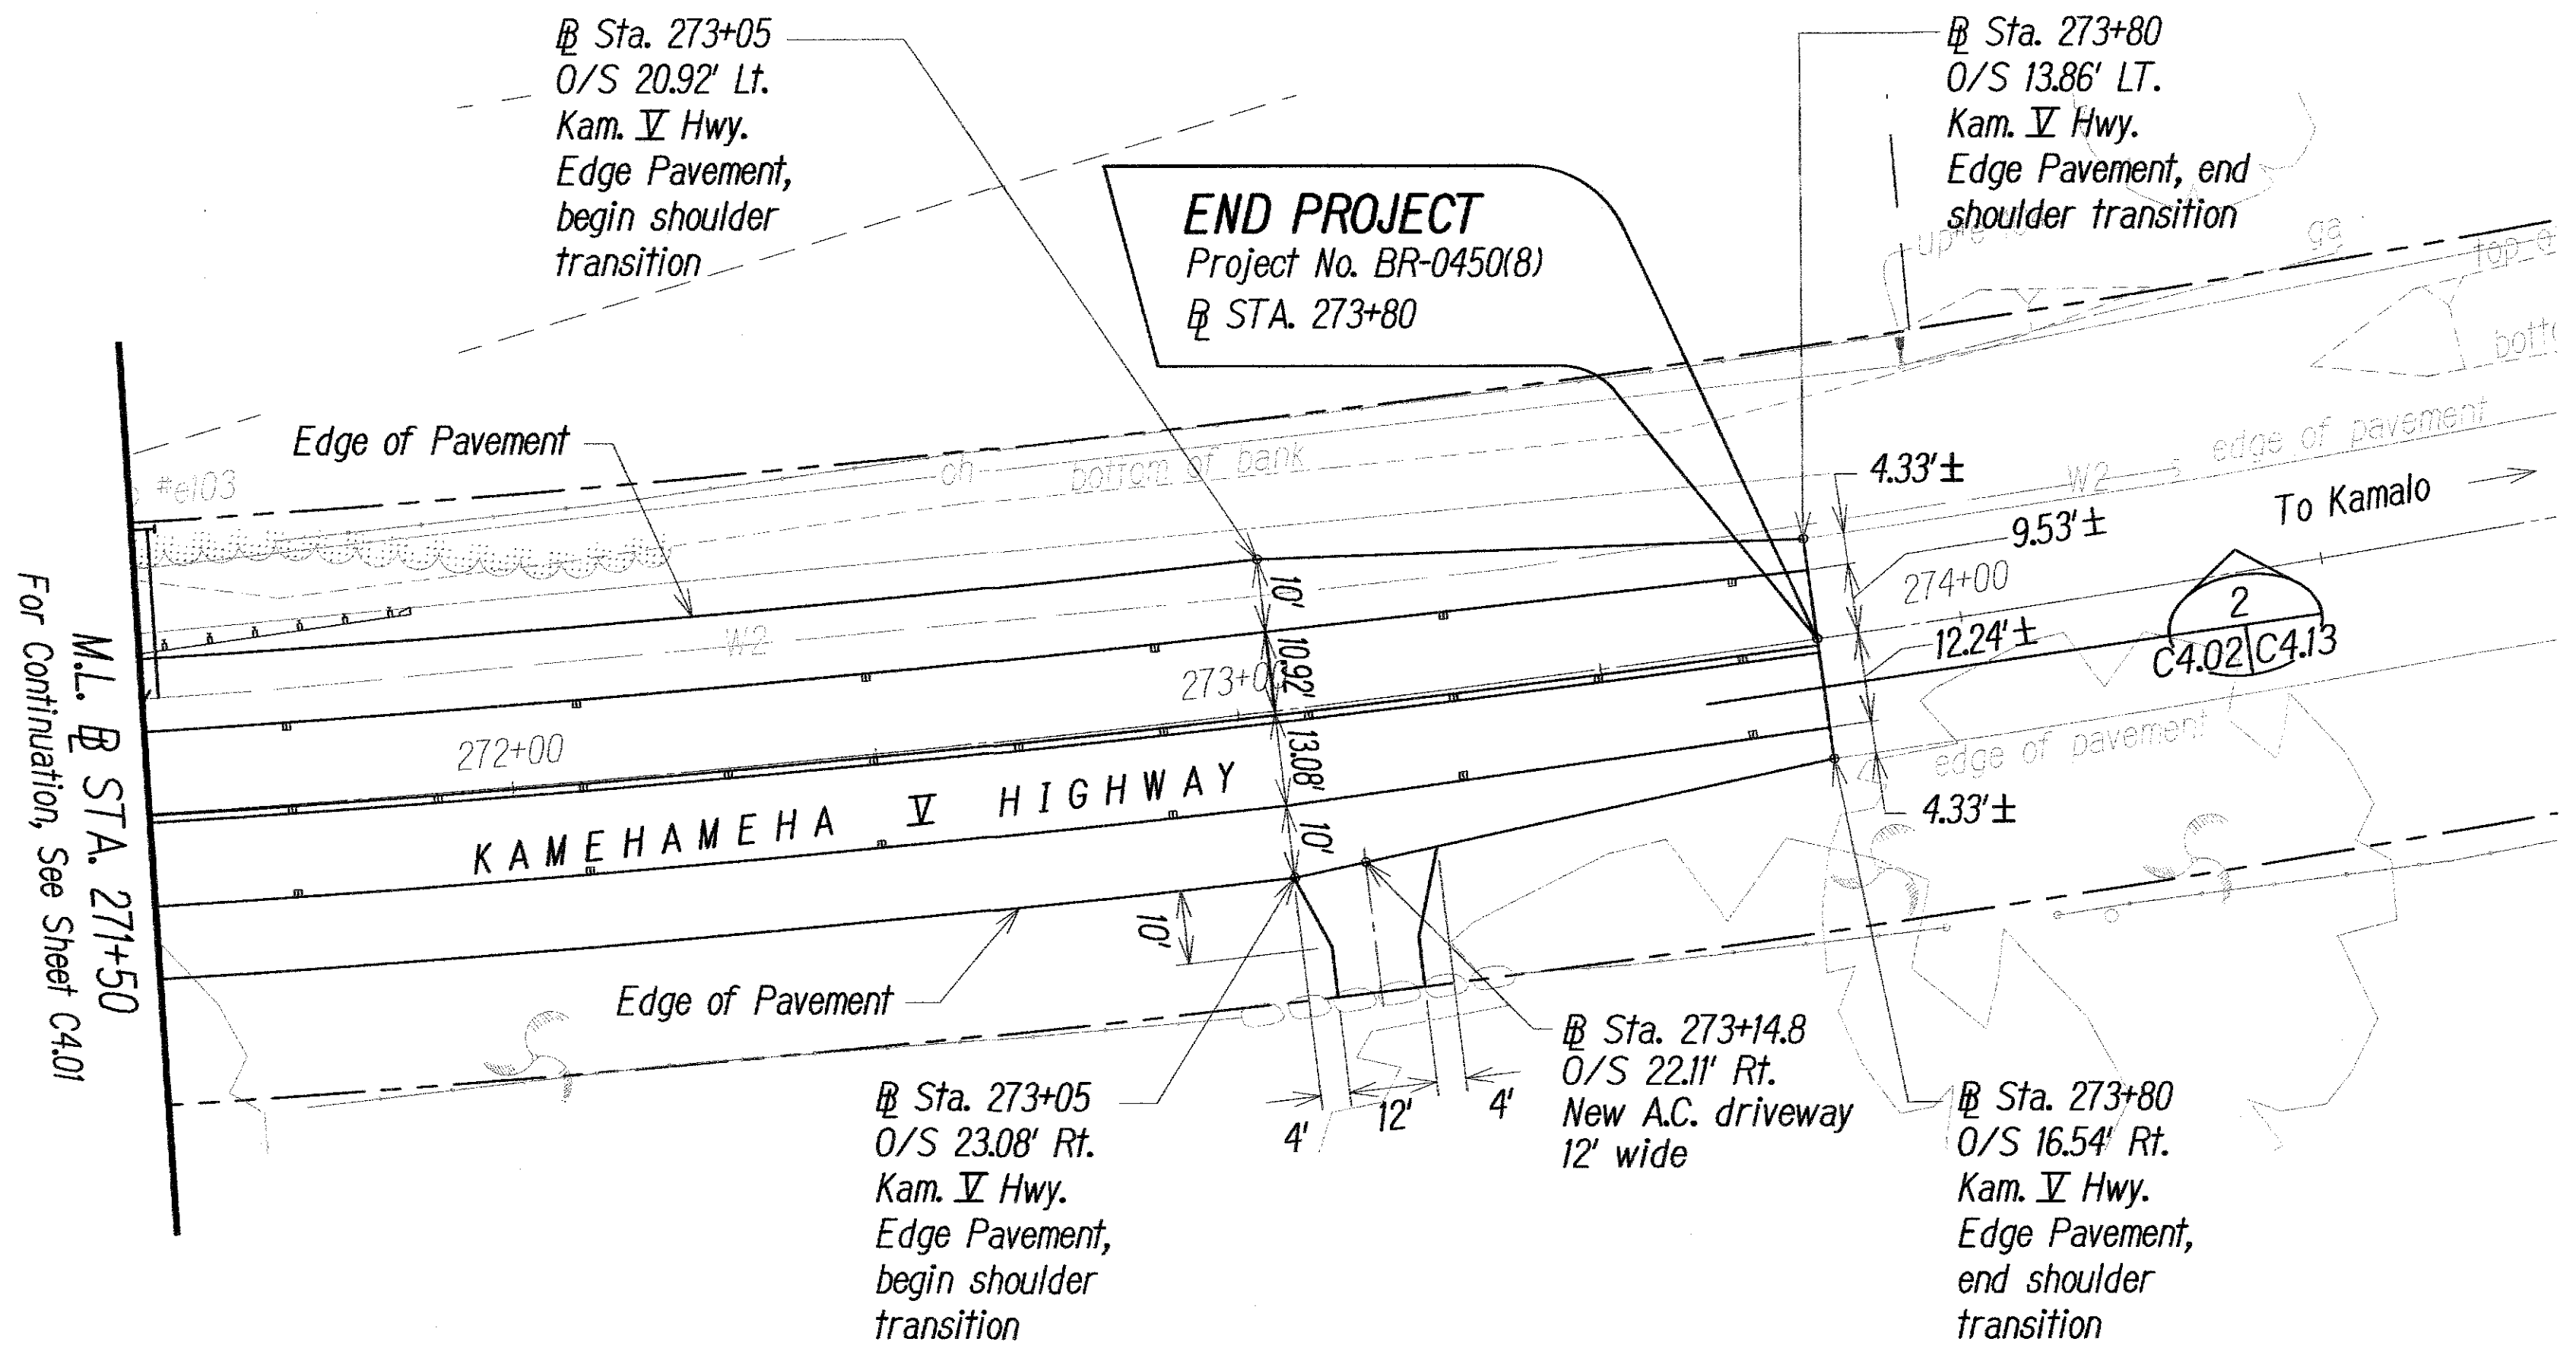

PLAN - KAM. V HWY.
Scale: 1" = 20'

LEGEND FOR AS-BUILT POSTINGS	
	Squiggly line for as-built deletion
	Double line for as-built deletion
Roadway	Text for as-built posting

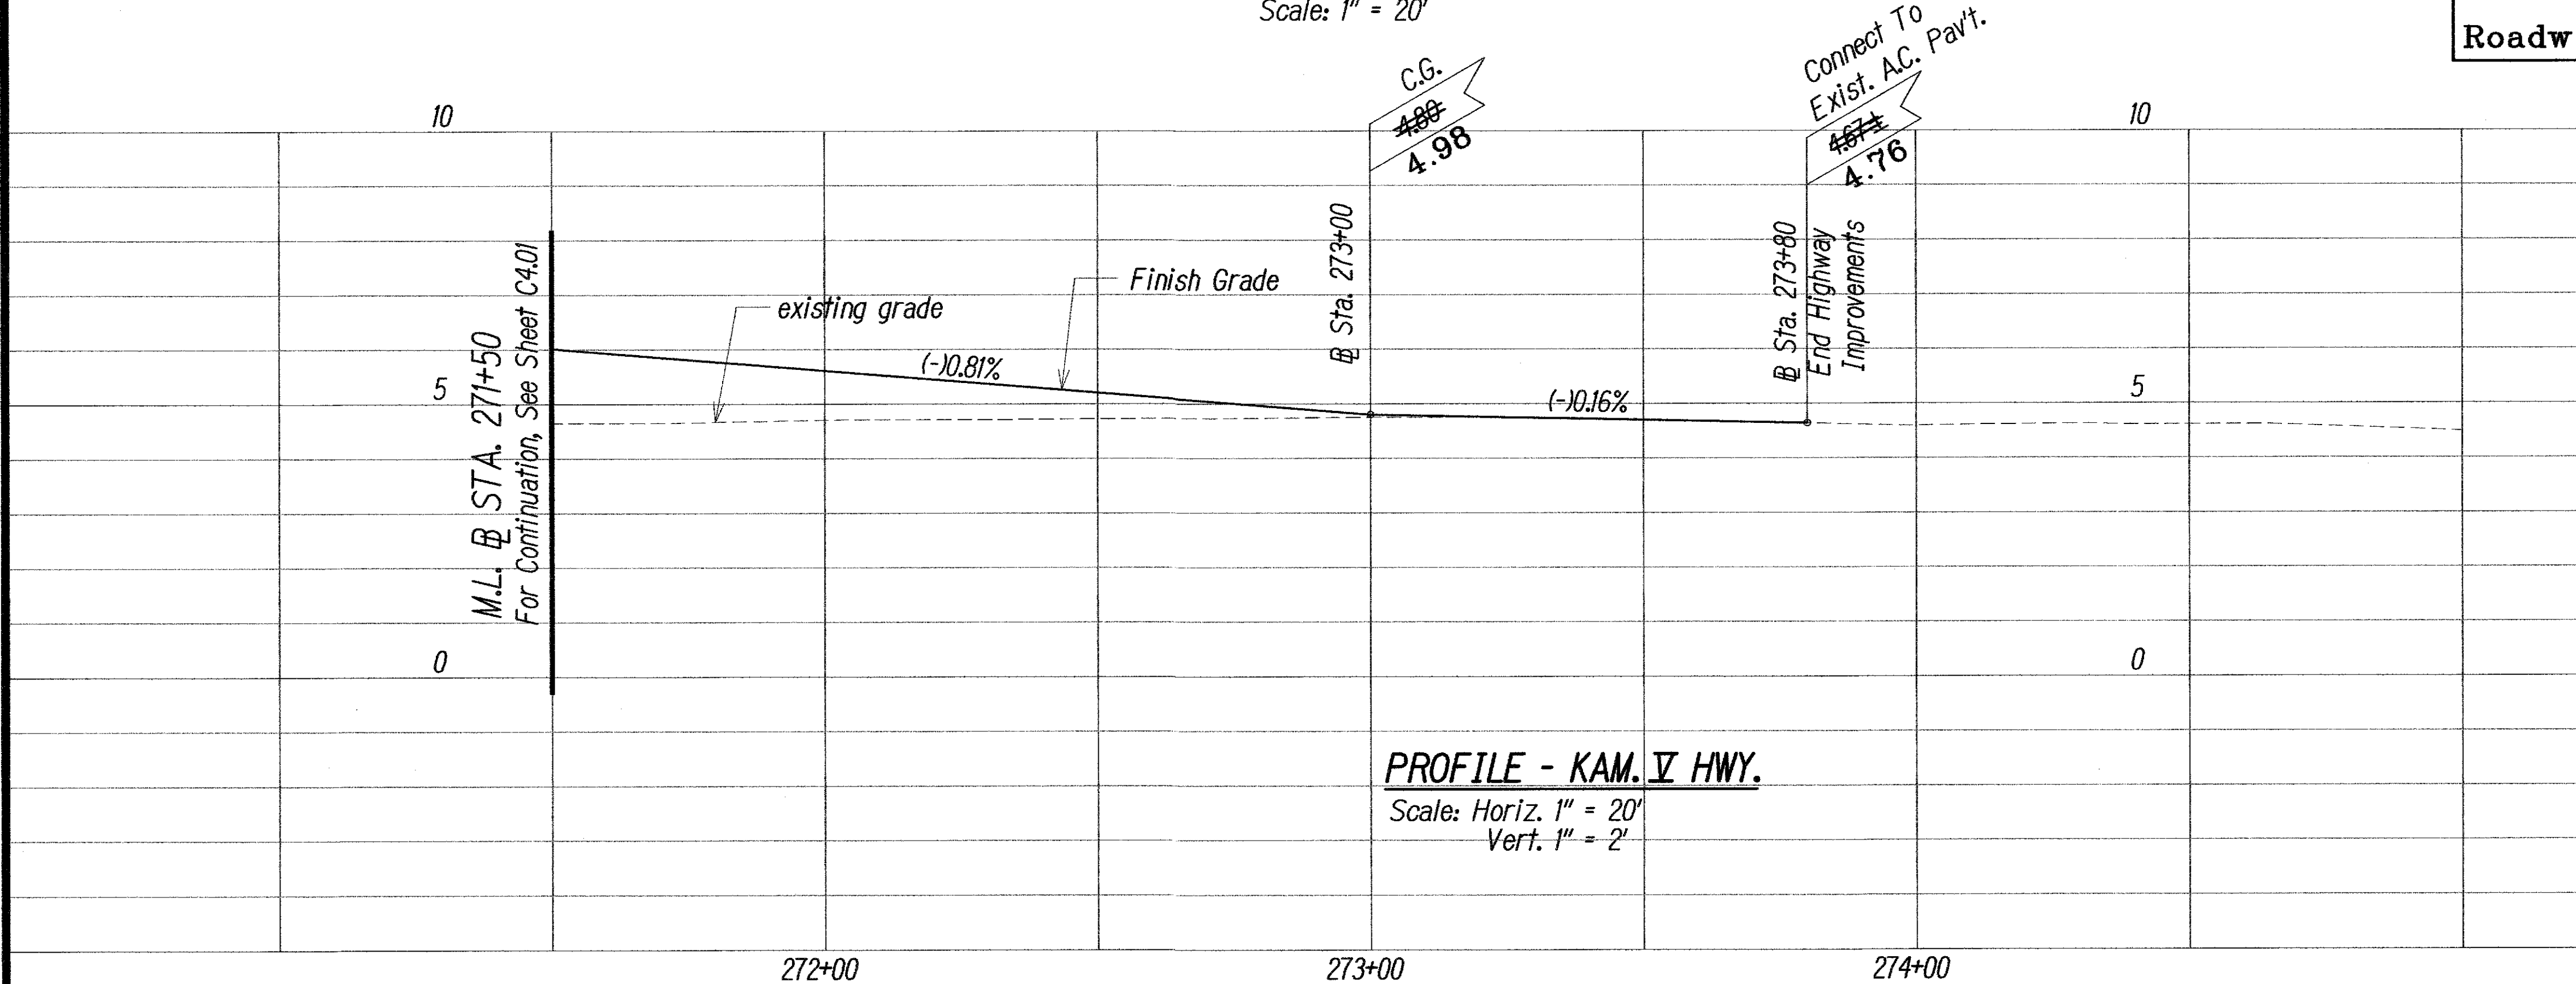

PROFILE - KAM. V HWY.
Scale: Horiz. 1" = 20'
Vert. 1" = 2'

STATE OF HAWAII
DEPARTMENT OF TRANSPORTATION
HIGHWAYS DIVISION

PLAN AND PROFILE

KAMEHAMEHA V HIGHWAY
Kawela Bridge Replacement
Federal Aid Project No. BR-0450(8)

Scale: AS NOTED Date: Oct. 2010