



FED. ROAD DIST. NO.	STATE	FED. AID PROJ. NO.	FISCAL YEAR	SHEET NO.	TOTAL SHEETS
HAWAII	HAW.	BR-0450(8)	2011	C.O. ADD. 46	93

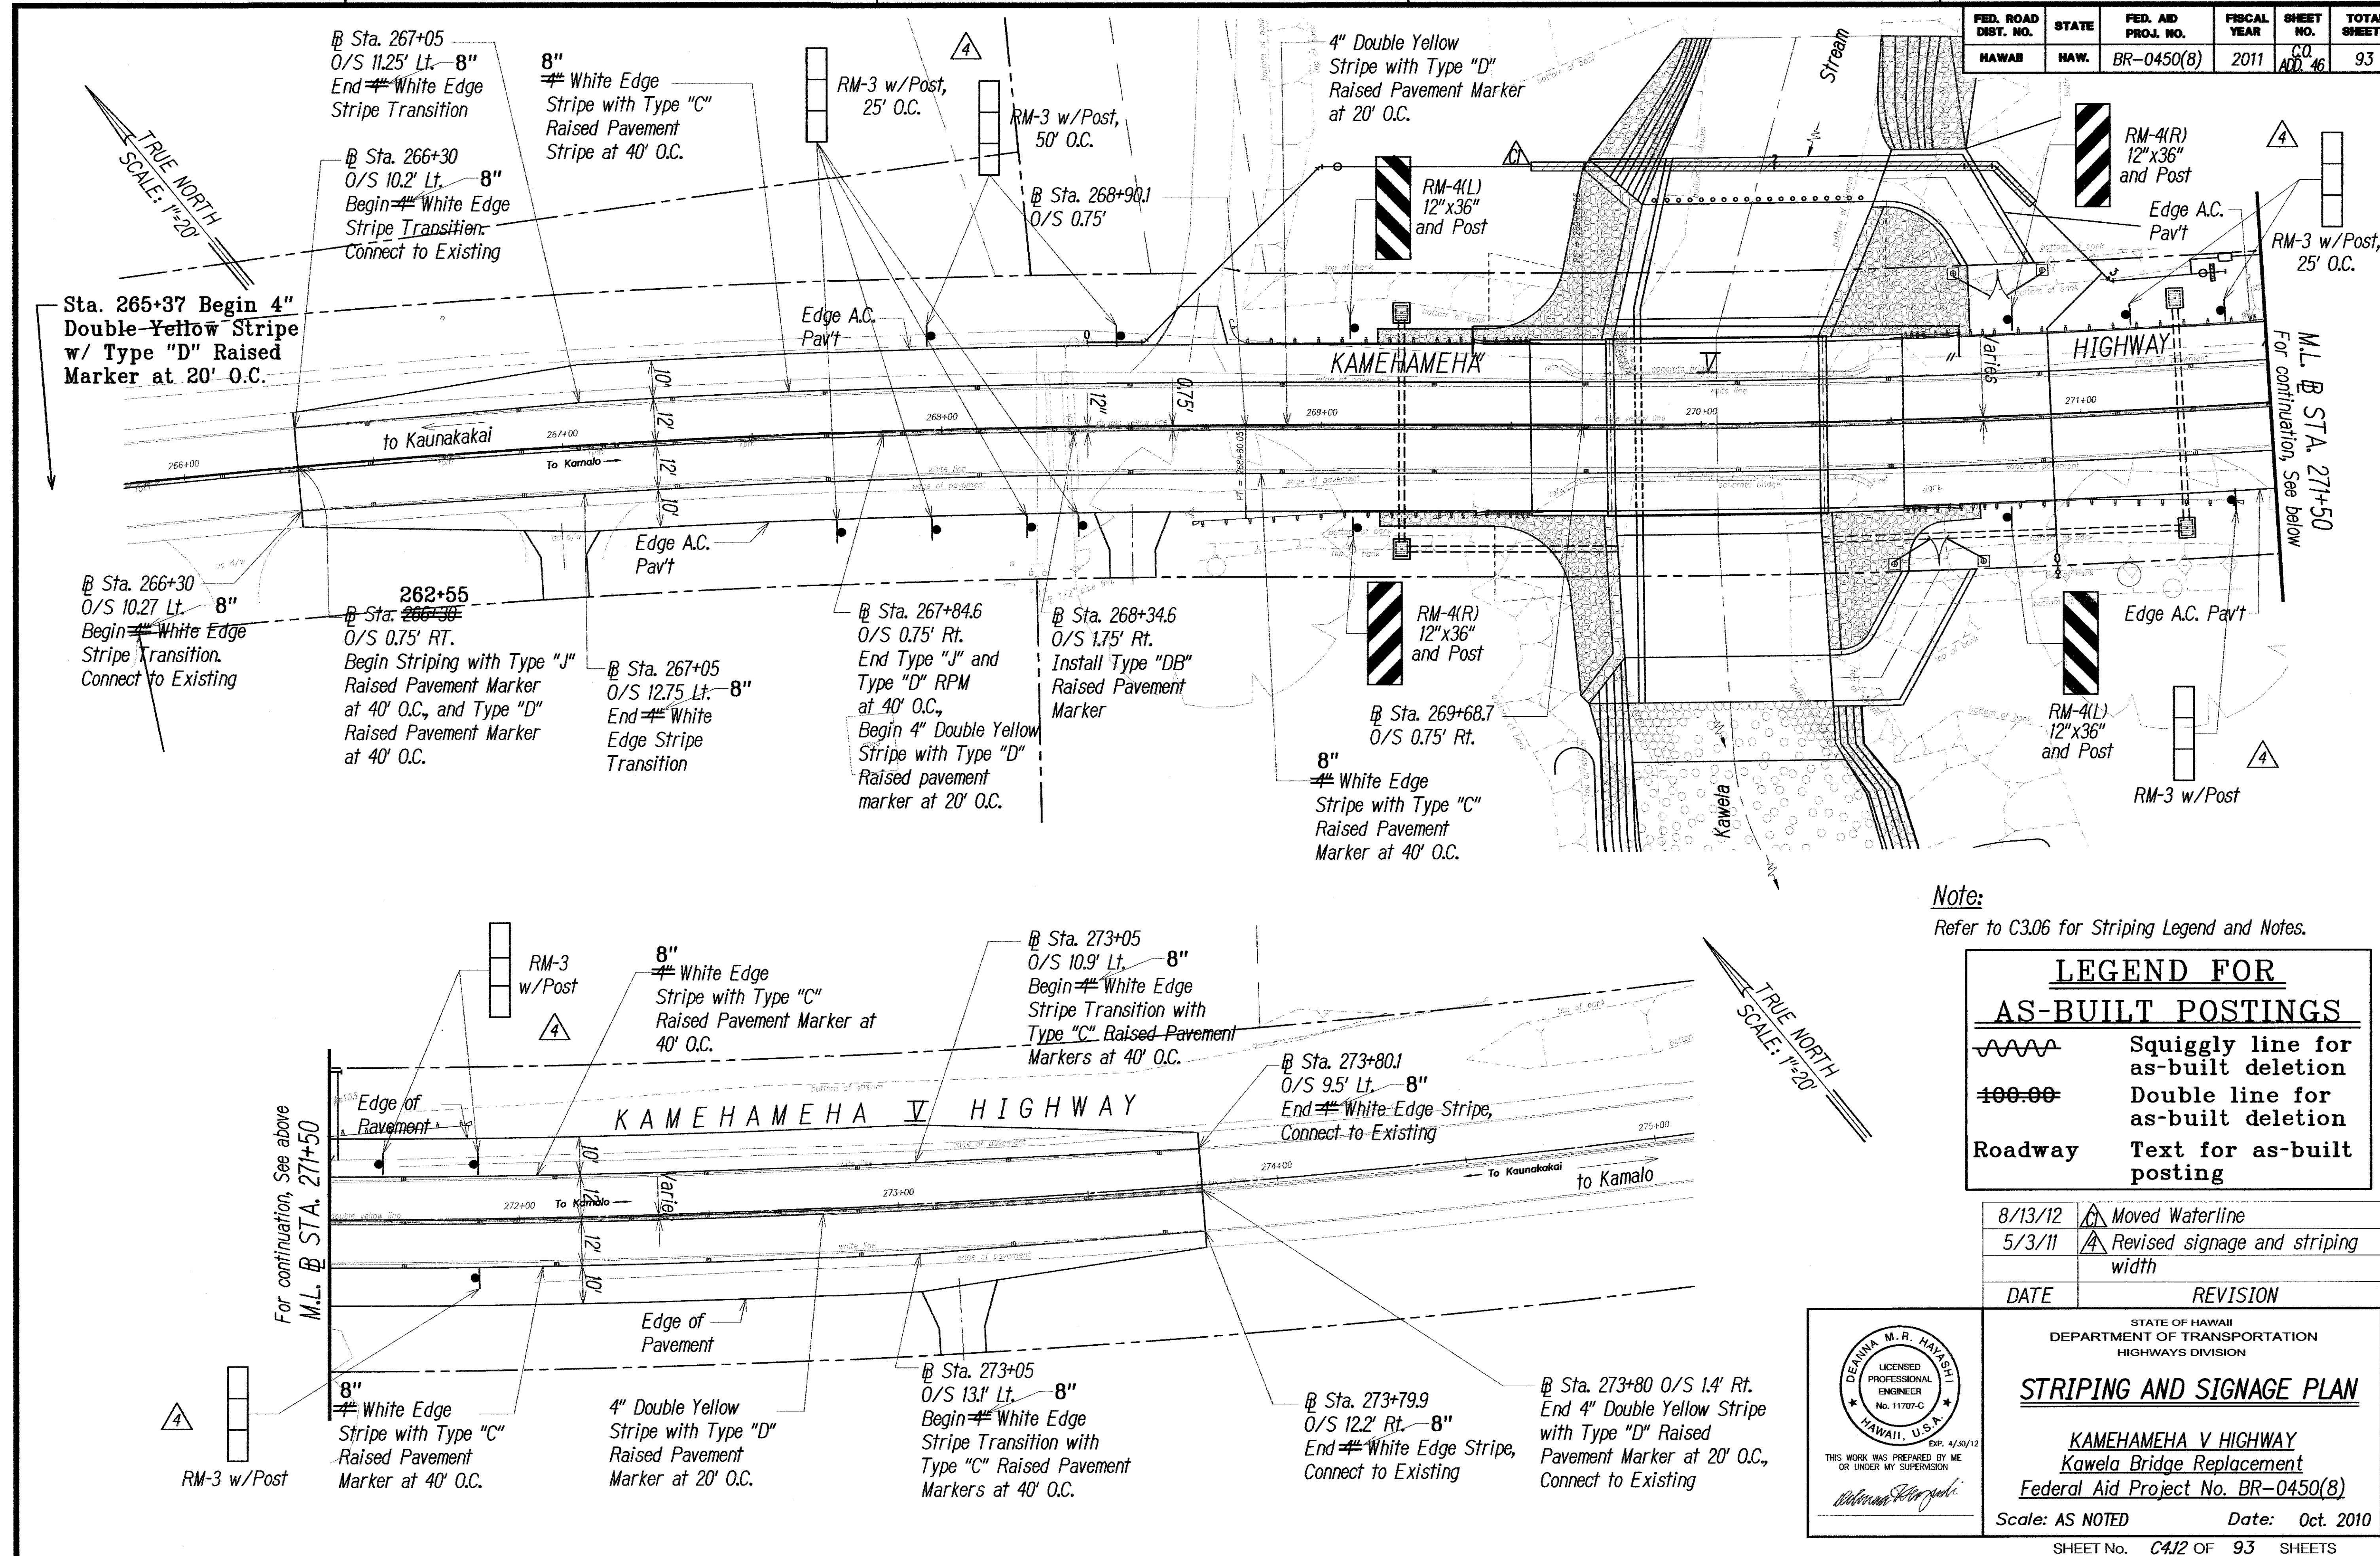

Note:
Refer to C3.06 for Striping Legend and Notes.

LEGEND FOR AS-BUILT POSTINGS	
	Squiggly line for as-built deletion
	Double line for as-built deletion
Roadway	Text for as-built posting

DATE	REVISION
8/13/12	Moved Waterline
5/3/11	Revised signage and striping width

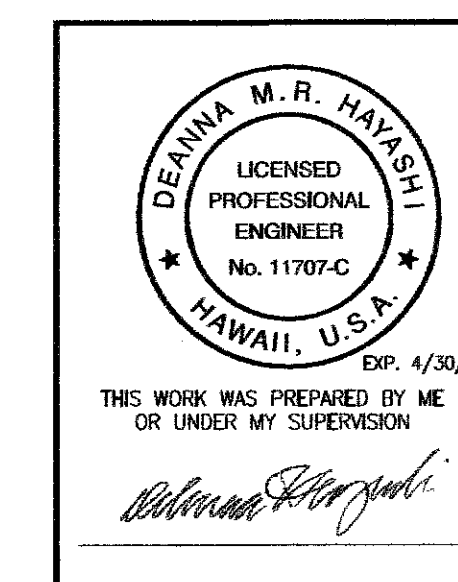

STATE OF HAWAII
DEPARTMENT OF TRANSPORTATION
HIGHWAYS DIVISION

STRIPING AND SIGNAGE PLAN

KAMEHAMEHA V HIGHWAY
Kawela Bridge Replacement
Federal Aid Project No. BR-0450(8)

Scale: AS NOTED Date: Oct. 2010

SHEET NO. C412 OF 93 SHEETS

"AS-BUILT"

C.O. ADD. 46