





FED. ROAD DIST. NO.	STATE	FED. AID PROJ. NO.	FISCAL YEAR	SHEET NO.	TOTAL SHEETS
HAWAII	HAW.	BR-0450(8)	2011	59	93


Painting Notes:

- Contractor shall shop coat all members. Field coating shall consist of touch up only.
- The touch up paint shall consist of the following:
  - prepare surface per SSPC-SP1, solvent cleaning.
  - apply first and second coat according to paint schedule
- Color for top coat shall be an earthtone light brown or green, as proposed by the contractor and approved by the Engineer. Intermediate coat shall have contrasting light color. Finish for top coat shall not be gloss or high gloss.
- Multiple coats may be required to obtain minimum dry film thickness (DFT).
- All hot-dip galvanized coating that is damaged shall be repaired. The repairs shall consist of the following:
  - Prepare surface per SSPC-SP1, solvent cleaning.
  - Apply (2) coats of cold applied, galvanizing compound containing 95% metallic zinc content by weight in dry film and 52% solids content by volume.
  - Application rate shall be 1.5 mils dry film thickness per coat.
  - Rust scale shall be cleaned per SSPC-SP3.
  - The coating shall be applied at sufficient wet film thickness to achieve a minimum dry film.
  - The coating shall be well stirred before use so that it is completely homogeneous during application.
  - Minimum dry film build is 3 mils, using manufacturer's recoat time directions.
  - Apply paint system according to paint schedule.
- Painting of galvanized steel shall be in accordance with ASTM D6386, "Standard Practice for Preparation of Zinc (Hot-Dipped Galvanized) Coated Iron and Steel Product and Hardware Surfaces for Painting."
- Cost of painting is incidental to metal railings.

PAINT SCHEDULE				
SPECIAL COATING SCHEDULE FOR ZINC COATED METAL BRIDGE RAILING				
	OPTION 1	OPTION 2	OPTION 3	OPTION 4
PREPARATION:	Carboline thinner #2 or surface cleaner #3, per SSPC-SP1, Apply Rustbond Penetrating Sealer.	Solvent clean per SSPC-1, and as recommended by the manufacturer	Solvent clean per SSPC-SP1, and as recommended by the manufacturer	Solvent clean per SSPC- SP1. Apply Galvanized Zinc Treatment (Acid Etching)
1ST COAT:	Carboline Carboguard 890 epoxy DFT 5 mil (min) WFT 7 mil (min)	Tnemec High-Build Epoxoline II Series N69 DFT 5 mil (min) WFT 7 mil (min)	Sherwin Williams Tile Clad High Solids B62 Series DFT 4 mil (min) WFT 7 mil (min)	Ameron Amercoat 385 epoxy DFT 5 mil (min) WFT 8 mil (min)
RECOATING TIME:	8 HRS (min) 2 Days (max)	10 HRS (min) 2 Days (max)	8 HRS (min) 14 Days (max)	8 HRS (min) 2 Days (max)
TOP COAT:	Carboline Carbothane 133HB Alyphatic polyurethane DFT 5 mil (min) WFT 7 mil (max)	Tnemec Endura-Shield Series 75 DFT 4 mil (min) WFT 7 mil (min)	Sherwin Williams Corothane II B65 W200 Series/B60V2 DFT 4 mil (min) WFT 7 mil (min)	Ameron Amercoat 450 SA Polyurethane DFT 4 mil WFT 7 mil
TOP COAT COLOR:	Medium Shade Green, submit color chips for approval.			

ABBREVIATIONS

B	Baseline	Galv	Galvanized
Bot	Bottom	Horiz	Horizontal
Btwn	Between	HSB	High Strength Bolt
CL	Centerline	I.D.	Inside Diameter
CJ	Construction Joint	Max	Maximum
Clr	Clear	Mech	Mechanical
Conc	Concrete	Min	Minimum
Cont	Continuous	Misc	Miscellaneous
Dbl	Double	No. or #	Number
Dia	Diameter	N.T.S.	Not to Scale
Dwg	Drawing	O.C.	On center
Ea	Each	O.D.	Outside Diameter
E.F.	Each Face	Opng	Opening
Elev	Elevation	Opp	Opposite
Eq	Equal	PL or P	Plate
E.W.	Each Way	Prefab	Prefabricated
Exist or (E)	Existing	Ref	Reference
Ext	Exterior	Reinf	Reinforced or Reinforcing
Fin	Finish	Sim	Similar
Ft	Foot or Feet	Sp	Spaces or Spacing
Ftg	Footing	ss	Stainless Steel

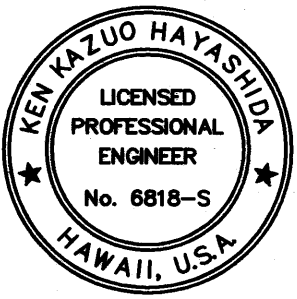

EXPIRATION DATE OF THE LICENSE 4/30/2012  
THIS WORK WAS PREPARED BY  
ME OR UNDER MY SUPERVISION

STATE OF HAWAII  
DEPARTMENT OF TRANSPORTATION  
HIGHWAYS DIVISION

STRUCTURAL  
GENERAL NOTES  
KAMEHAMEHA V HIGHWAY  
Kawela Bridge Replacement  
Federal Aid Project No. BR-0450(8)

Scale: AS NOTED      Date: June, 2010

SHEET No. 50.2 OF 93 SHEETS

FED. ROAD DIST. NO.	STATE	FED. AID PROJ. NO.	FISCAL YEAR	SHEET NO.	TOTAL SHEETS
HAWAII	HAW.	BR-0450(8)	2011	60	93

MINIMUM SPLICE & EMBEDMENT LENGTHS					
CONCRETE STRENGTH = 4,000 PSI					
LAP SPLICE		EMBEDMENT			
BAR SIZE	OTHER BARS	TOP BAR	STRAIGHT		WITH STANDARD 90° HOOK
			OTHER BARS	TOP BAR	
#3, #4	21"	29"	12"	17"	7"
#5	26"	36"	15"	21"	9"
#6	31"	43"	18"	26"	10"
#7	39"	54"	23"	32"	12"
#8	51"	71"	30"	42"	14"
#9	64"	90"	38"	53"	15"
#10	81"	114"	48"	67"	17"
#11	100"	140"	59"	82"	19"


- Notes:
- "Top Bars" are horizontal bars with 12" or more of concrete cast below.
  - Splice lengths may be reduced by multiplying the tabulated values by 0.765 if the centerline of splice of adjacent bars are staggered 6'-0" o.c. for #9 bar and smaller and 9'-0" o.c. for #10 bar and larger.
  - Embedment lengths for straight bars may be reduced by multiplying the tabulated values by 0.80 if the bars are spaced laterally not less than 6" center-to-center, with not less than 3" clear cover measured in the direction of the spacing.
  - Embedment lengths for bars with 90° hook are bars with side cover, normal to plane of hook, of not less than 2½" and cover on bar extension beyond hook not less than 2". Increase embedment length by 43% for bars not meeting these requirements.

TYPICAL REBAR SPLICE AND EMBEDMENT LENGTH SCHEDULE

1

S0.3S0.3

Not to Scale

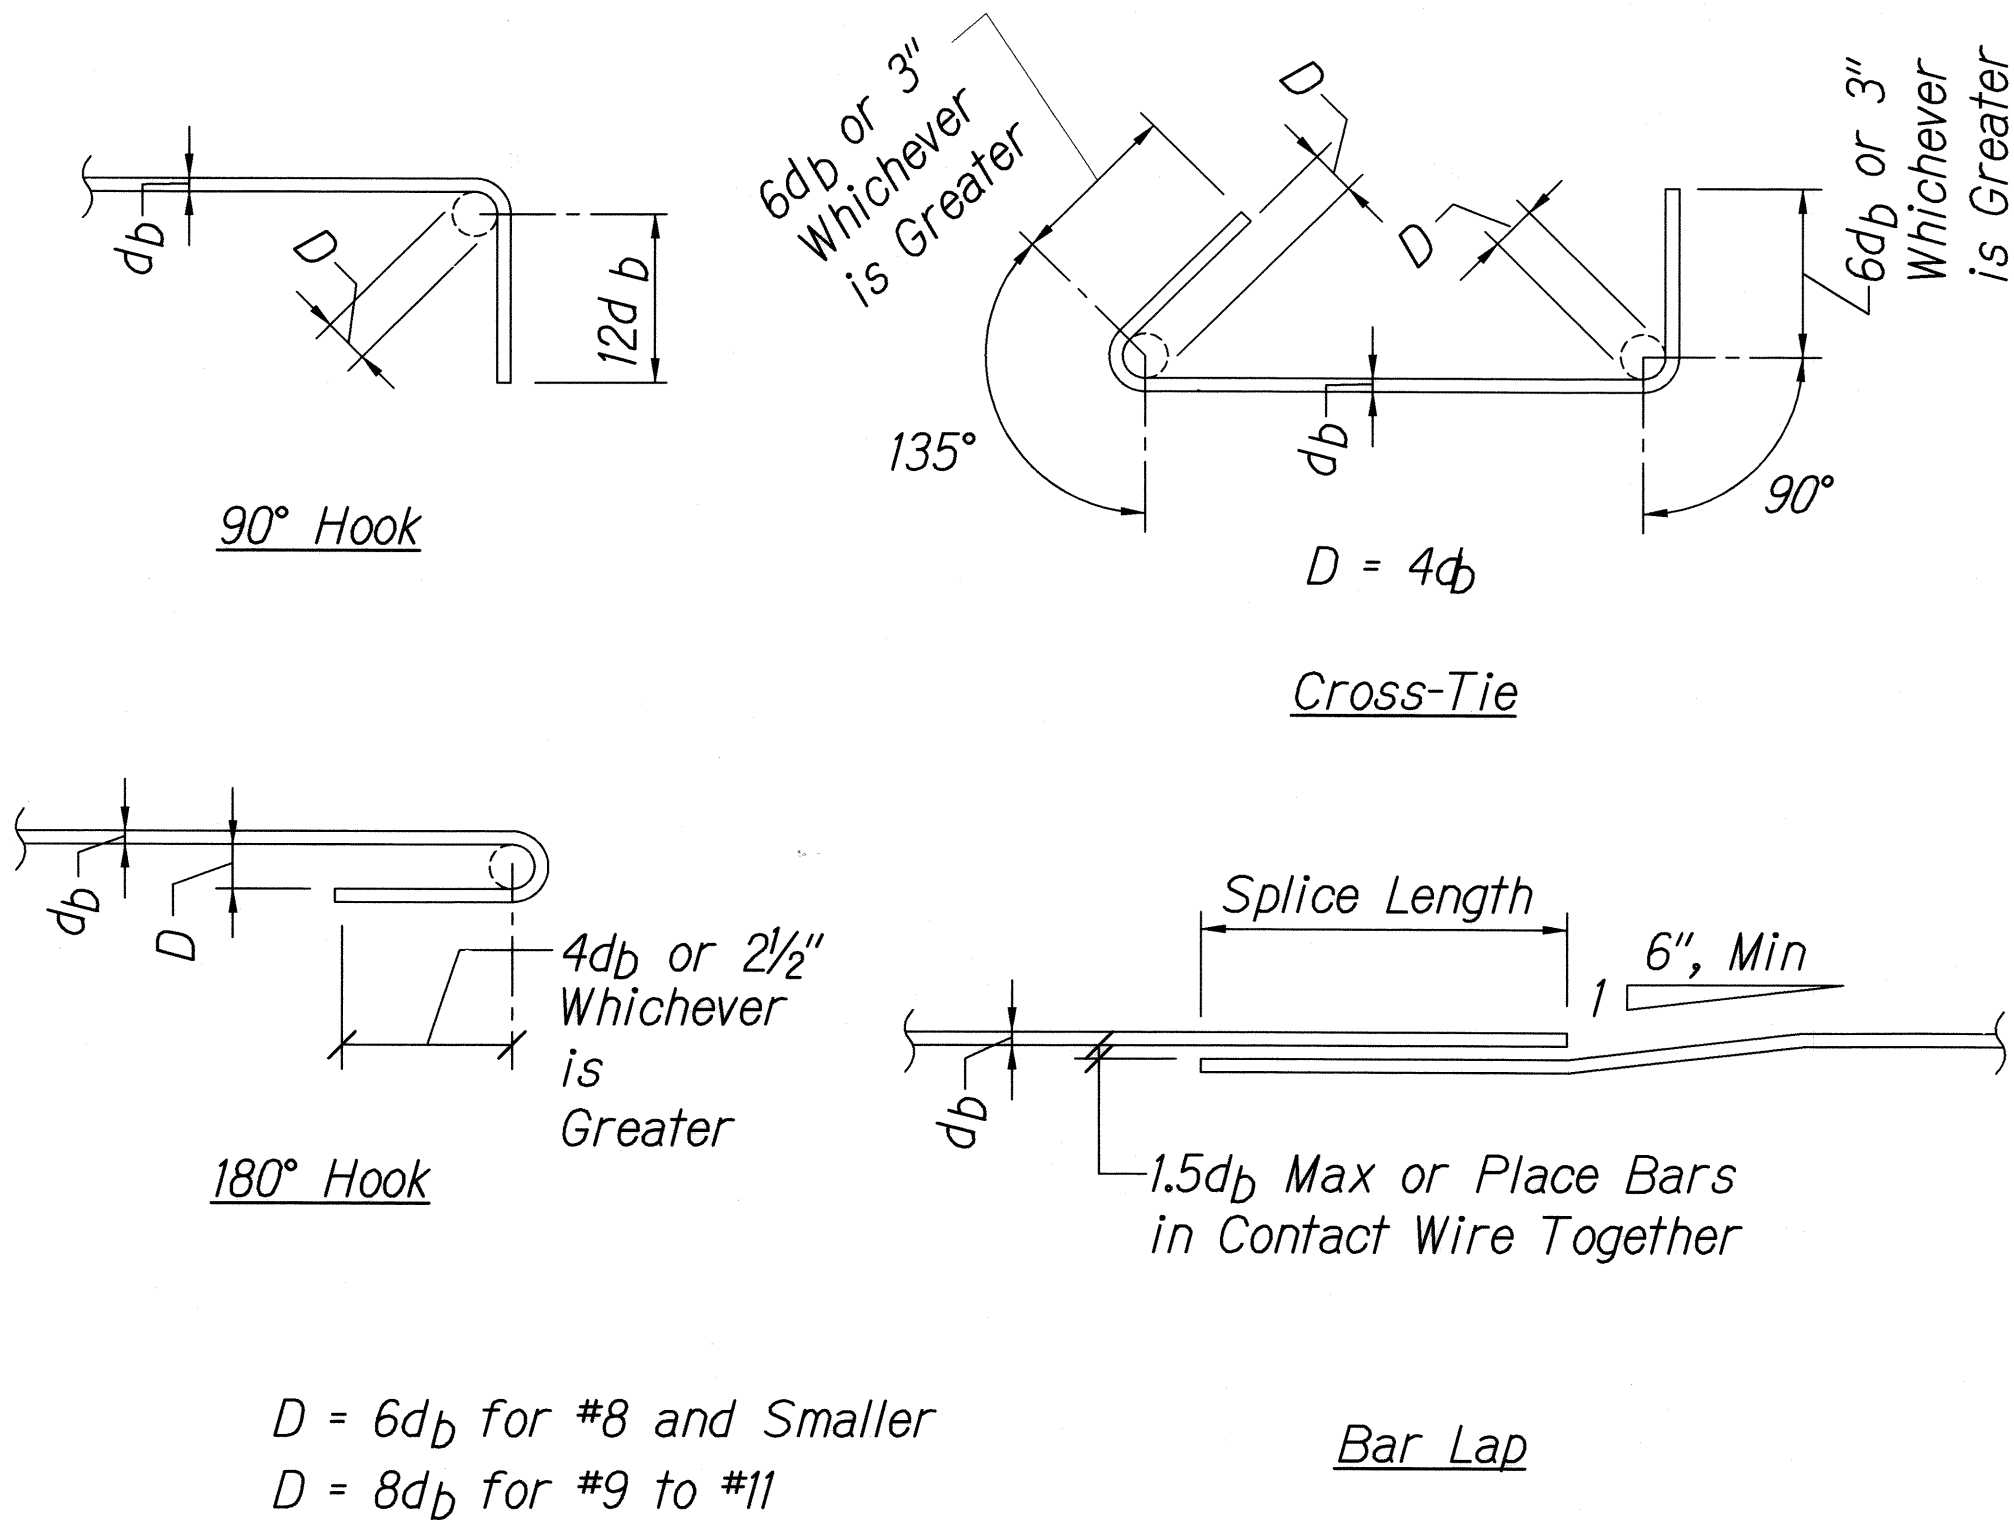


STANDARD HOOKS AND CROSS-TIE DETAIL

Not to Scale

2

S0.3S0.3

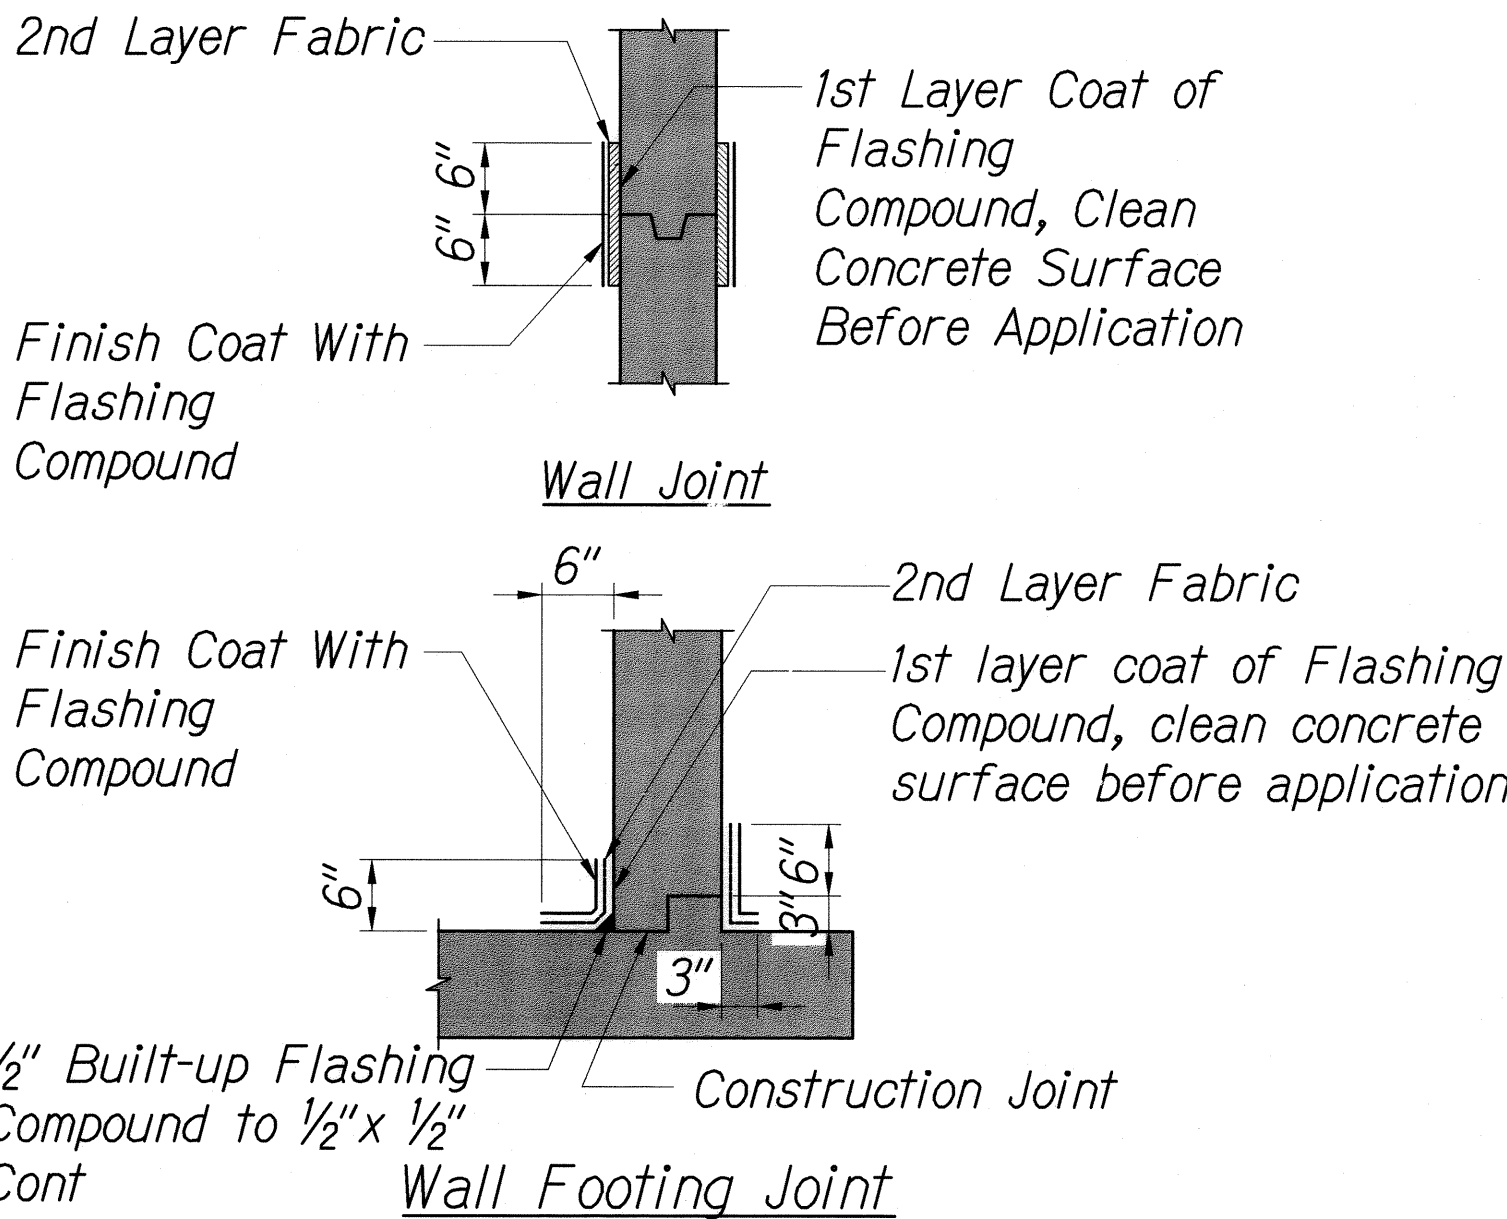


TYPICAL WATERPROOFING DETAIL

Not to Scale

3

S0.3S0.3

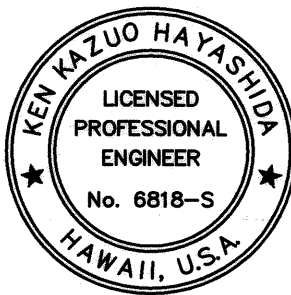

EXPIRATION DATE OF THE LICENSE 4/30/2012  
THIS WORK WAS PREPARED BY  
ME OR UNDER MY SUPERVISION

STATE OF HAWAII  
DEPARTMENT OF TRANSPORTATION  
HIGHWAYS DIVISION

TYPICAL DETAILS


KAMEHAMEHA V HIGHWAY  
Kawela Bridge Replacement  
Federal Aid Project No. BR-0450(8)

Scale: AS NOTED Date: June, 2010

SHEET No. S0.3 OF 93 SHEETS




FED. ROAD DIST. NO.	STATE	FED. AID PROJ. NO.	FISCAL YEAR	SHEET NO.	TOTAL SHEETS
HAWAII	HAW.	BR-0450(8)	2011	C.O. 61	93

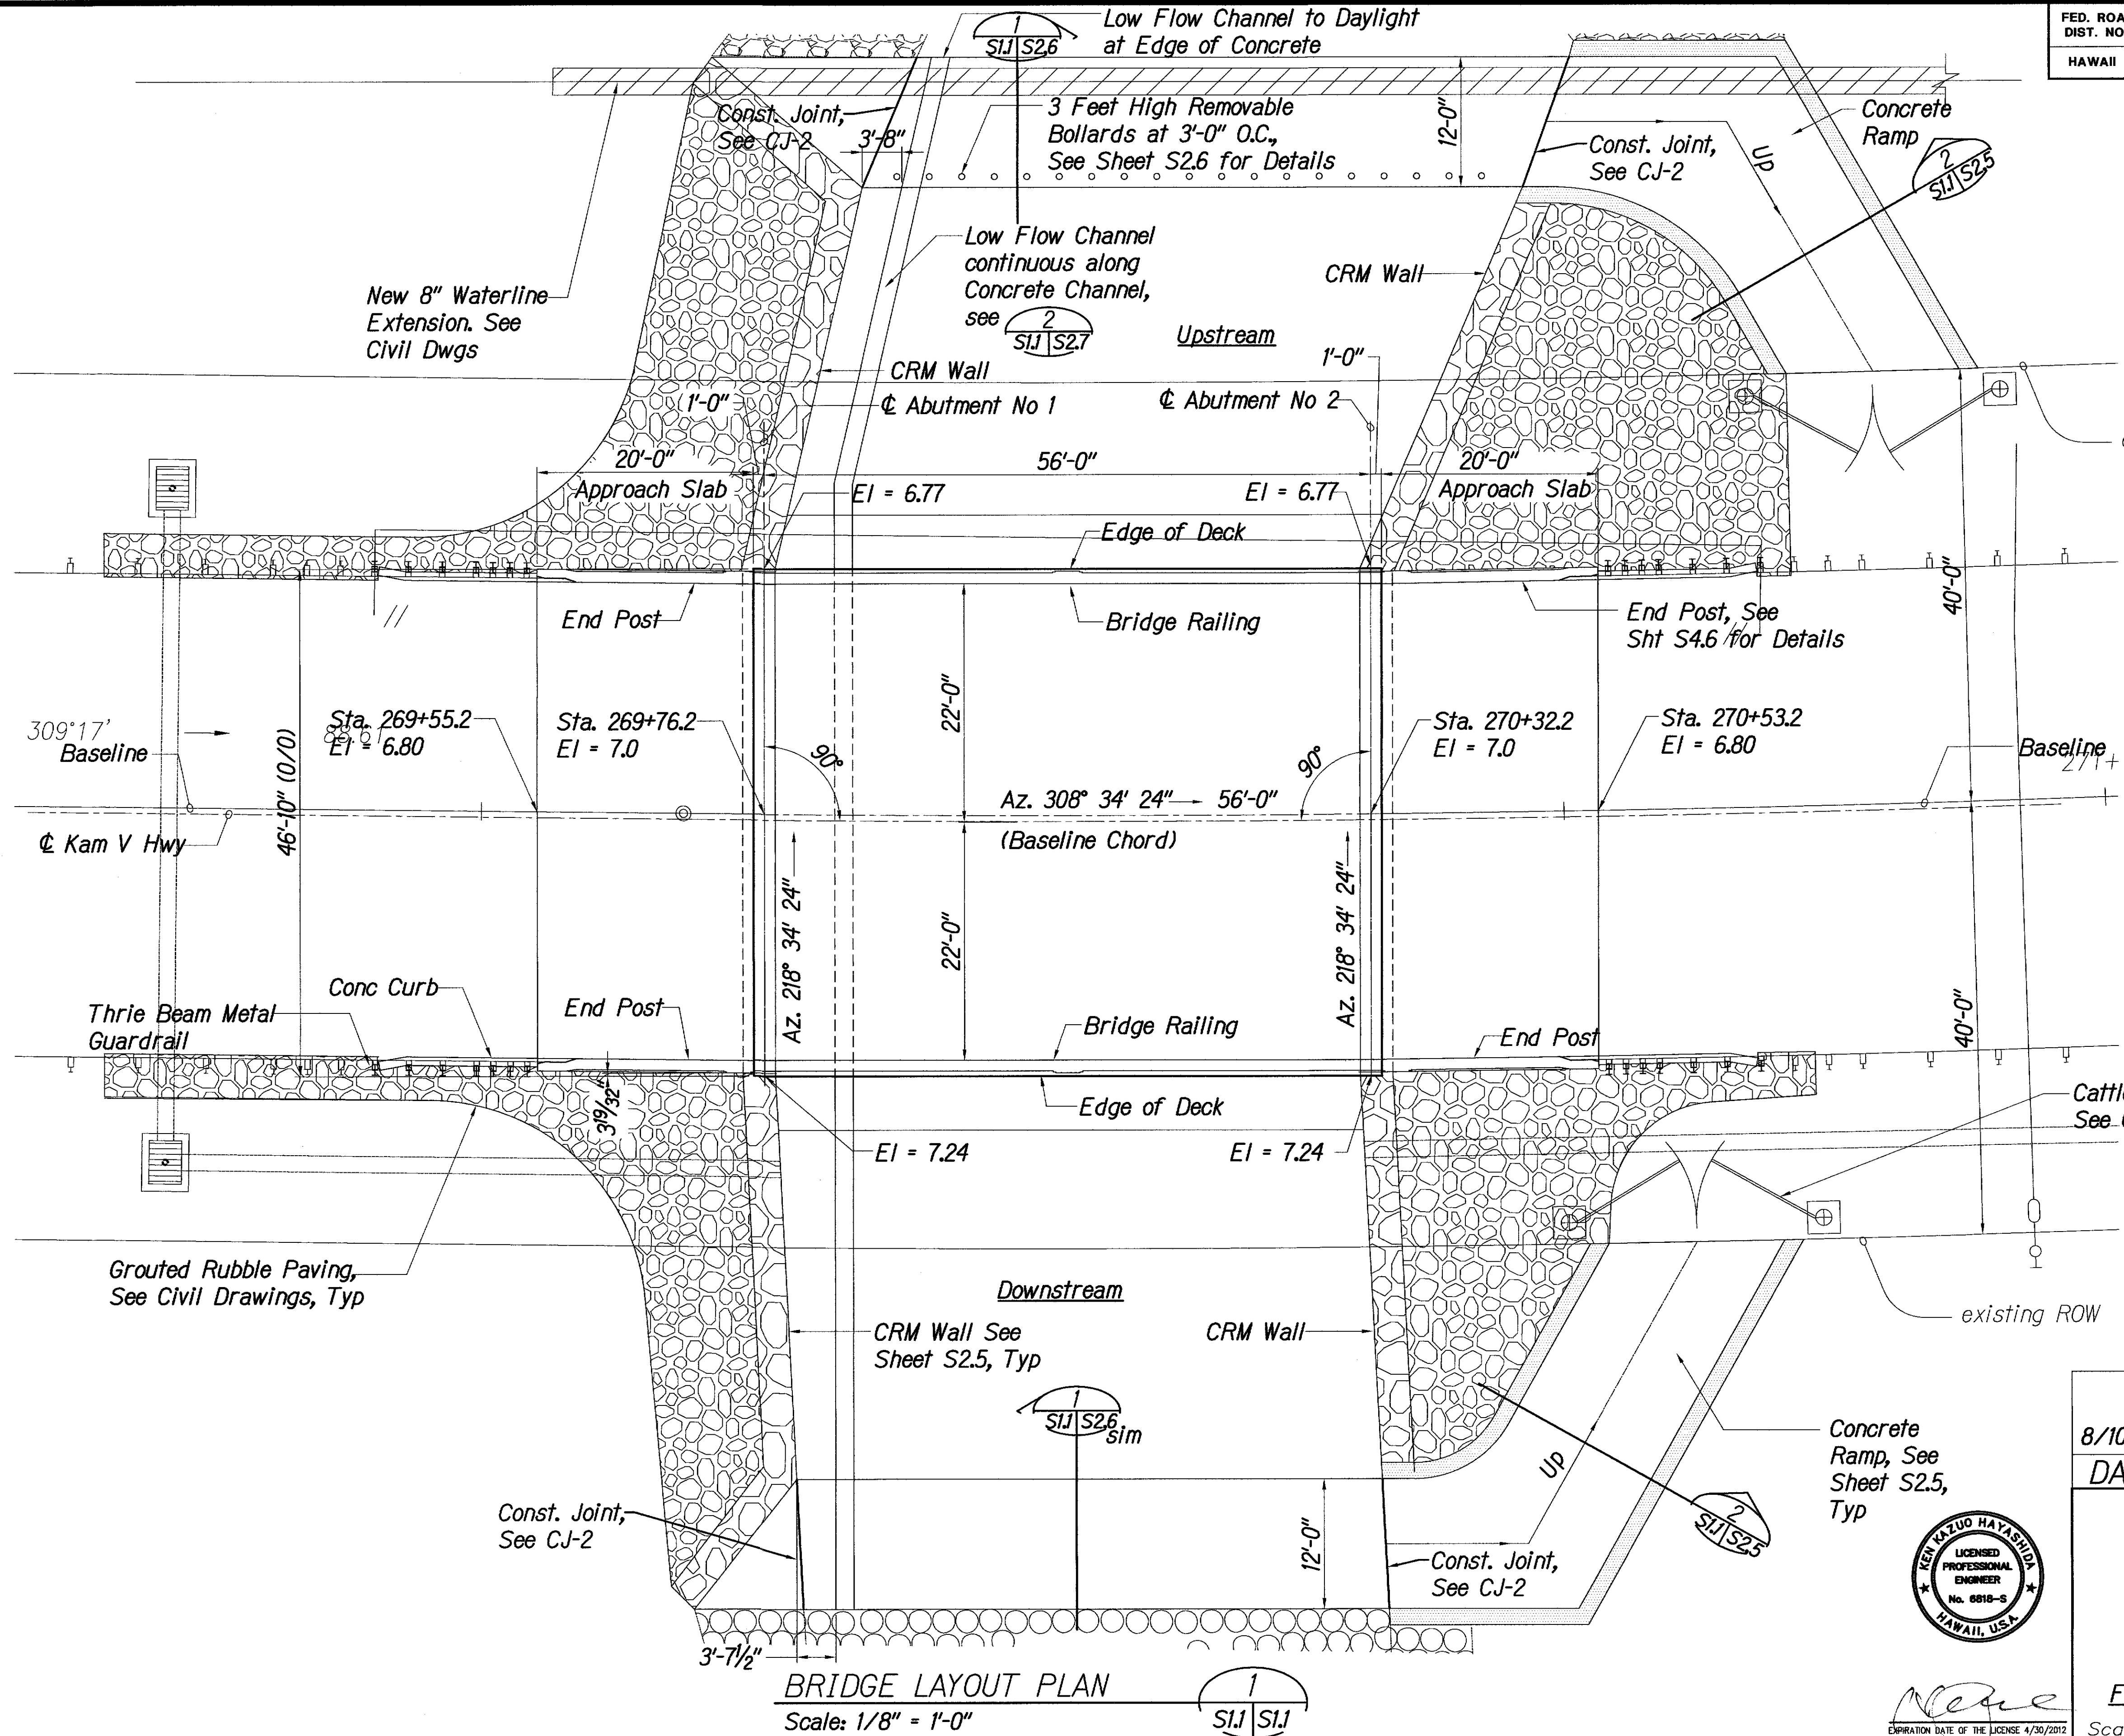

LEGEND FOR AS-BUILT POSTINGS	
	Squiggly line for as-built deletion
	Double line for as-built deletion
	Text for as-built posting

8/10/12	Revised Layout of New 8" Waterline
DATE	REVISION
STATE OF HAWAII DEPARTMENT OF TRANSPORTATION HIGHWAYS DIVISION	
BRIDGE LAYOUT PLAN	
KAMEHAMEHA V. HIGHWAY Kawela Bridge Replacement Federal Aid Project No. BR-0450(8)	
Scale: AS NOTED	Date: June, 2010
SHEET No. <i>SIJ</i> OF 93 SHEETS	

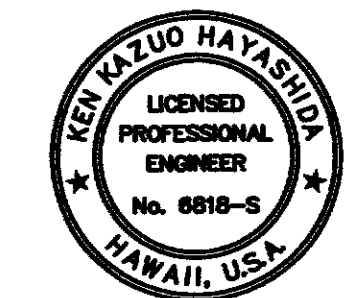


EXPIRATION DATE OF THE LICENSE 4/30/2012  
THIS WORK WAS PREPARED BY ME OR UNDER MY SUPERVISION

BRIDGE LAYOUT PLAN  
Scale: 1/8" = 1'-0"

2016-09-13 1528-01 Kawela Bridge AS BUILT S-1-1.dwg, 9/13/2016 2:45:06 PM, tamana




FED. ROAD DIST. NO.	STATE	FED. AID PROJ. NO.	FISCAL YEAR	SHEET NO.	TOTAL SHEETS
HAWAII	HAW.	BR-0450(8)	2011	62	93

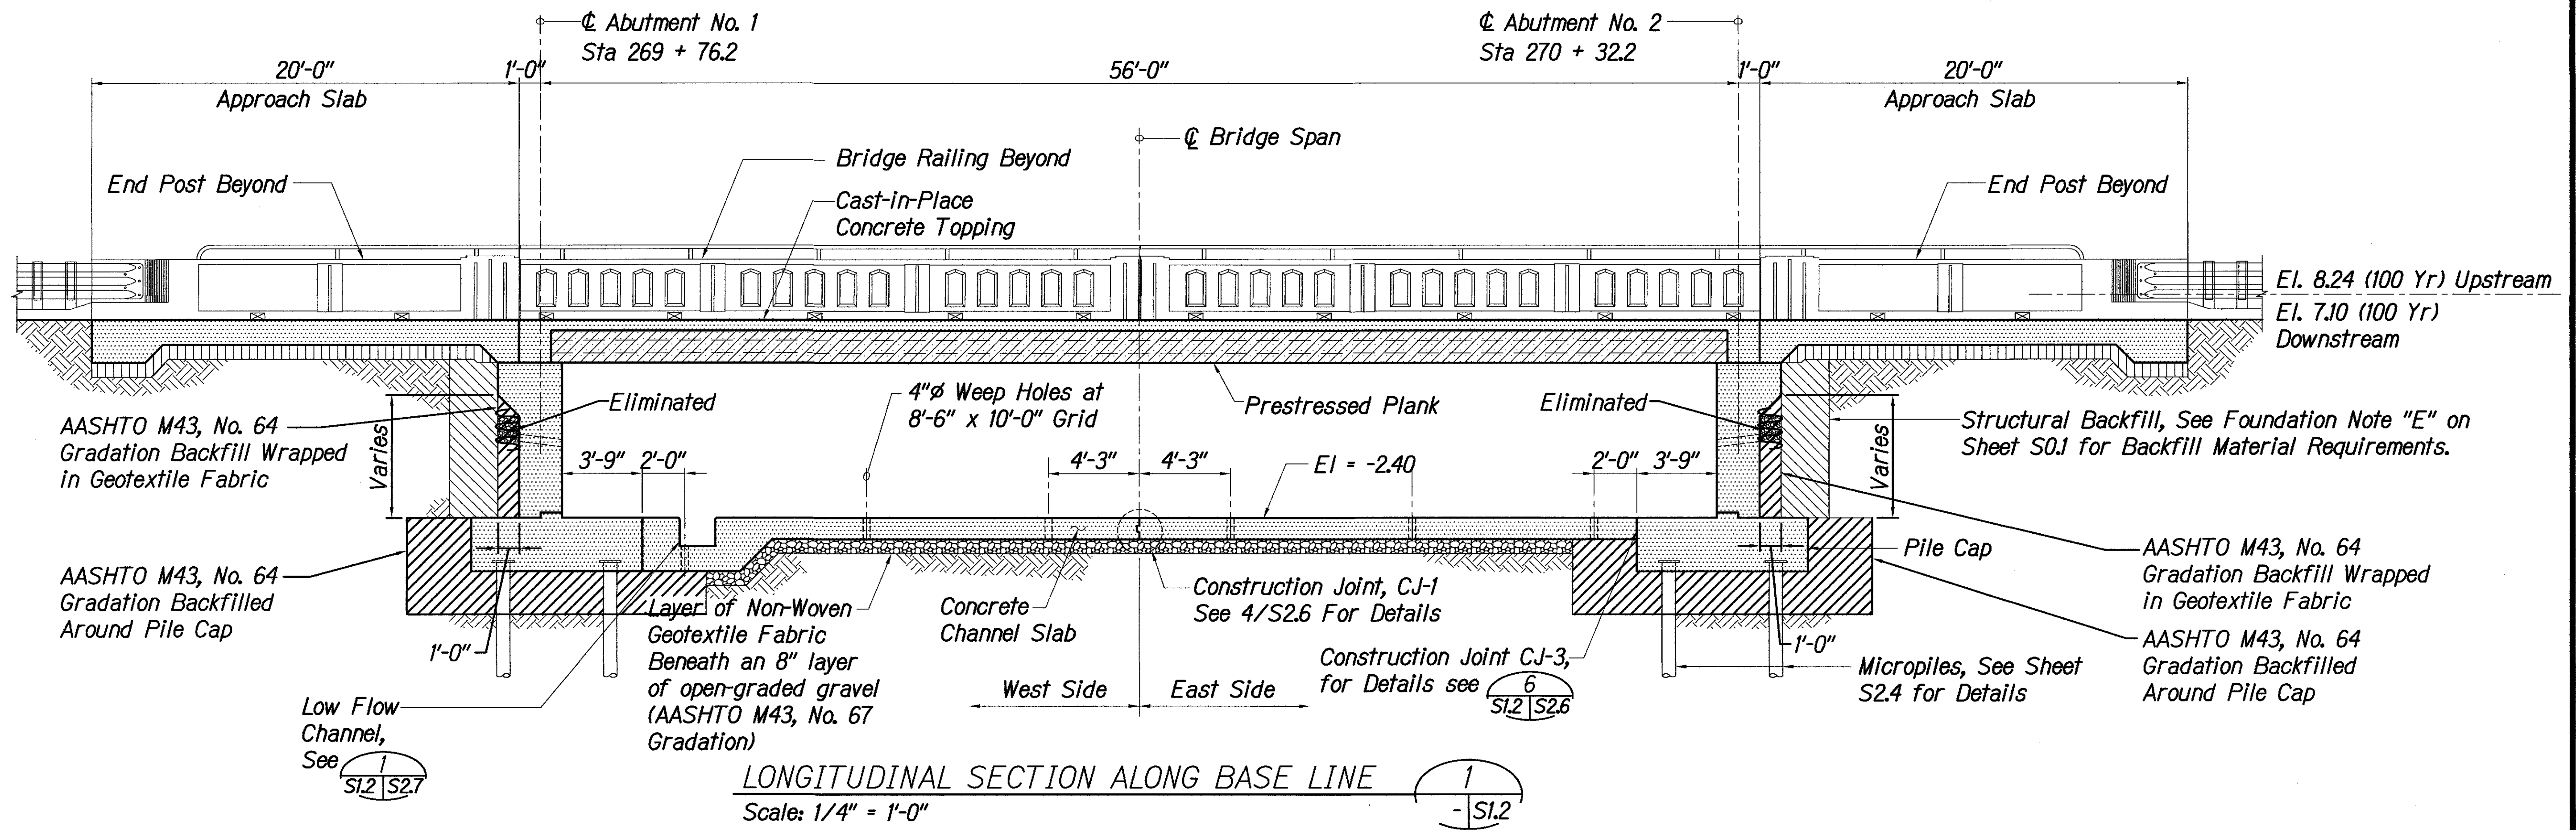

**Notes:**

- The sequence of construction is the responsibility of the contractor. The contractor shall conduct their construction activities such that the micropiles are not subjected to lateral loads, such as backfilling behind abutments, until after the channel slab beneath the bridge is in place and has sufficiently cured. The following construction sequence shall be followed to avoid imposing lateral loads on the micropiles during construction:
  - Excavate for and construct abutments and channel slab according to Phasing Plan, Sheets C2.01 and C2.02.
  - The abutments shall not be backfilled until after the channel slab is in place and has cured for at least 7 days.
- Placement and repositioning of BMP's that will be used for channelizing stream flow during the various phases of the work shall be the responsibility of the contractor. Refer to BMP Notes, Sheets C2.01 and C2.02.
- Channel slab subgrade shall be prepared by proof-rolling the soil subgrade to a firm condition.

LEGEND FOR AS-BUILT POSTINGS	
	Squiggly line for as-built deletion
	Double line for as-built deletion
	Text for as-built posting

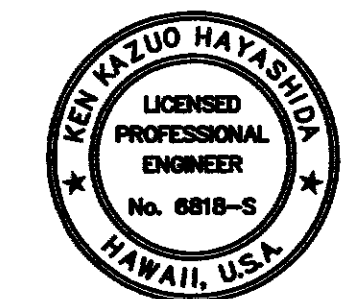


STATE OF HAWAII  
DEPARTMENT OF TRANSPORTATION  
HIGHWAYS DIVISION  
  
**BRIDGE LONGITUDINAL SECTION**  
**KAMEHAMEHA V HIGHWAY**  
**Kawela Bridge Replacement**  
**Federal Aid Project No. BR-0450(8)**  
  
Scale: AS NOTED      Date: June, 2010  
SHEET No. **51.2** OF **93** SHEETS


EXPIRATION DATE OF THE LICENSE 4/30/2012  
THIS WORK WAS PREPARED BY ME OR UNDER MY SUPERVISION

2016-09-13 15:28-01 Kawela Bridge AS BUILT S1528 S-1-2.dwg, 9/13/2016 3:04:14 PM, tamahata

FED. ROAD DIST. NO.	STATE	FED. AID PROJ. NO.	FISCAL YEAR	SHEET NO.	TOTAL SHEETS
HAWAII	HAW.	BR-0450(8)	2011	63	93

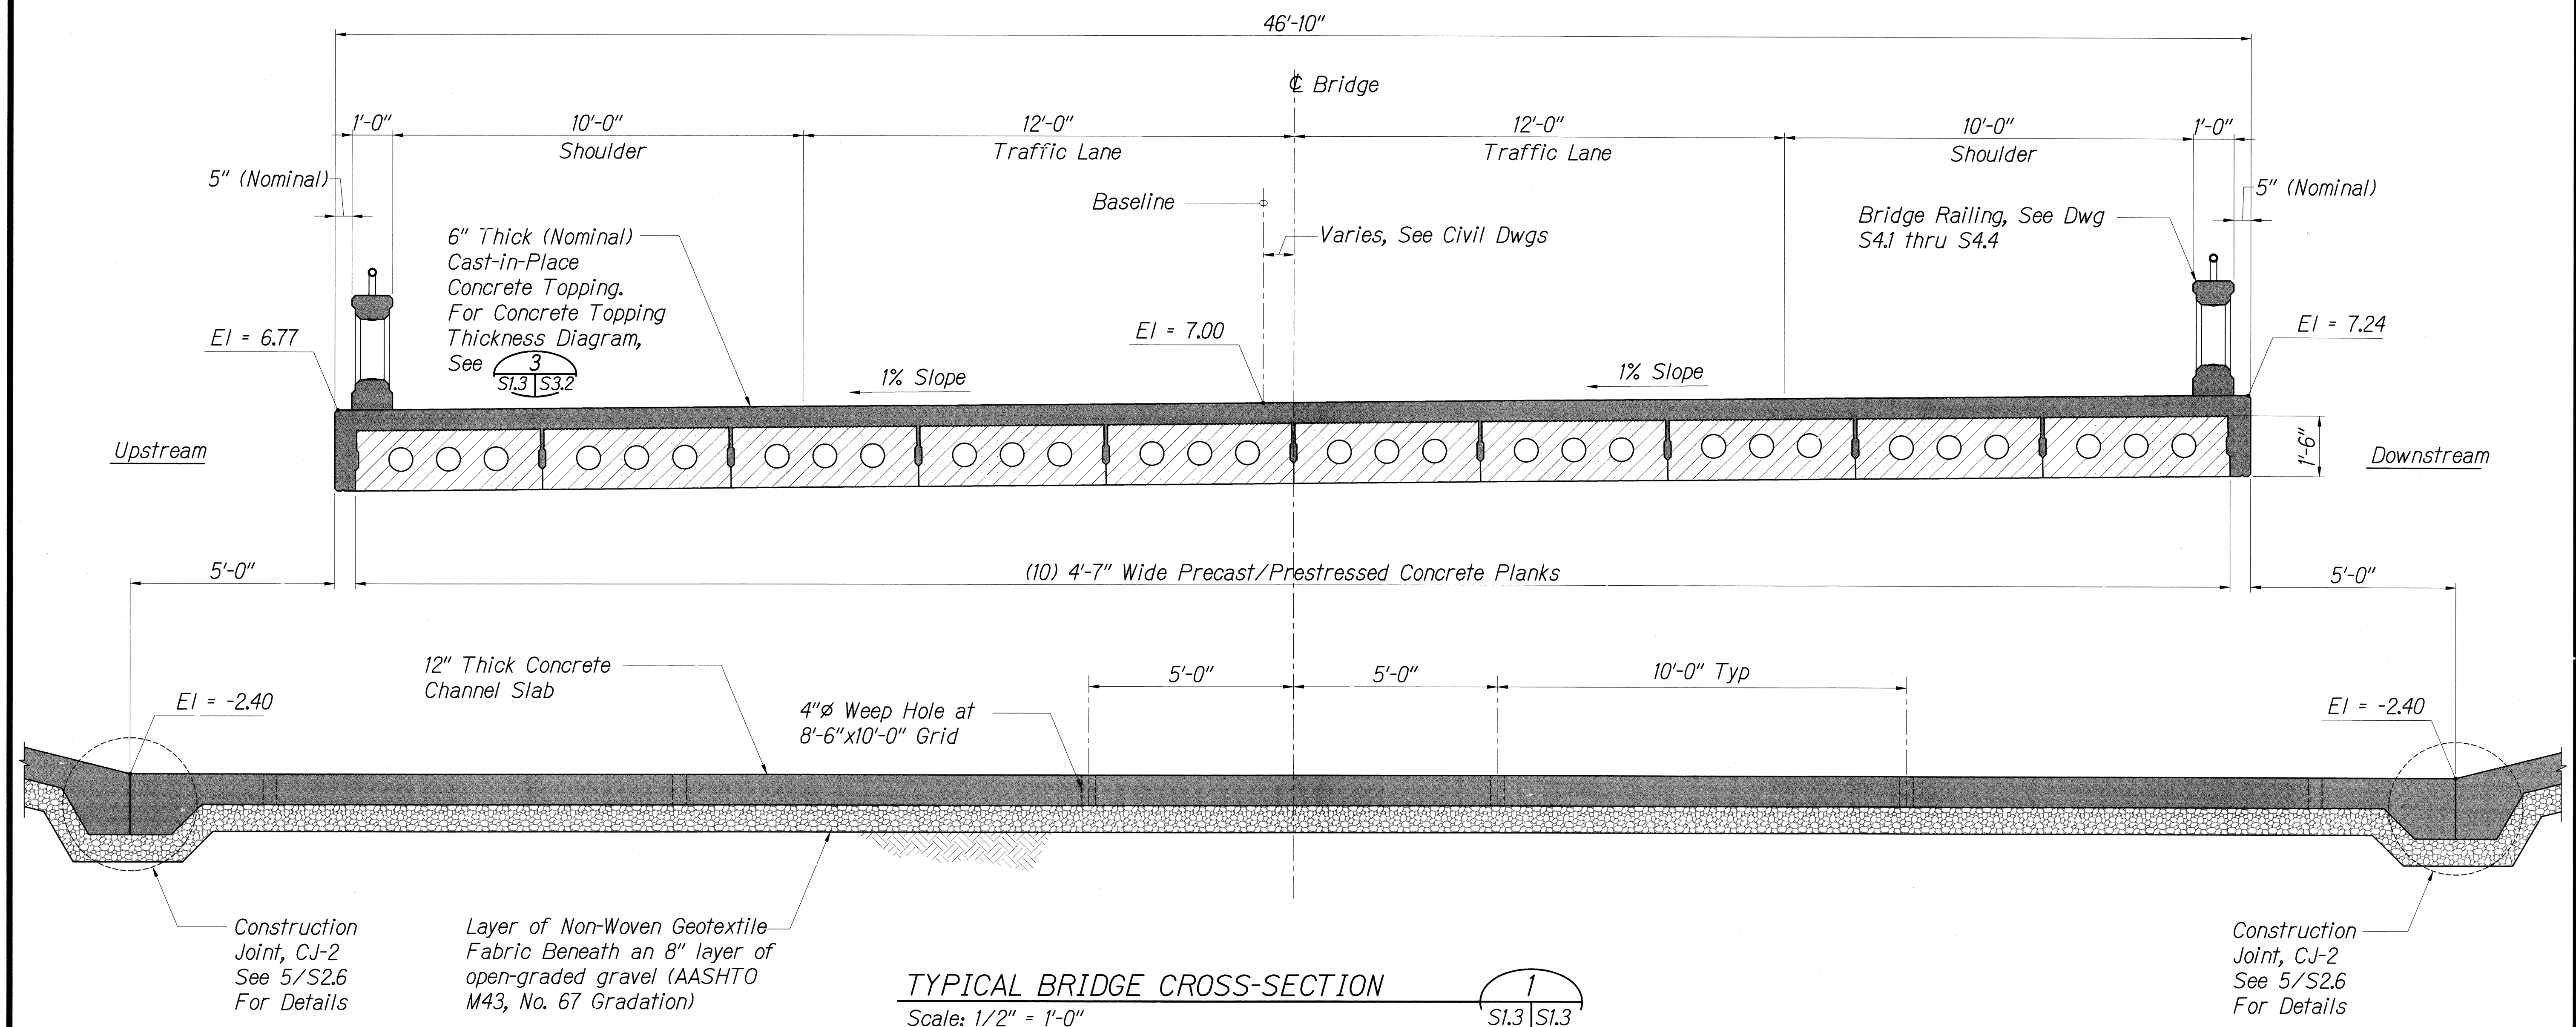

**Note:**  
Channel slab subgrade shall be prepared by proof-rolling the soil subgrade to a firm condition.

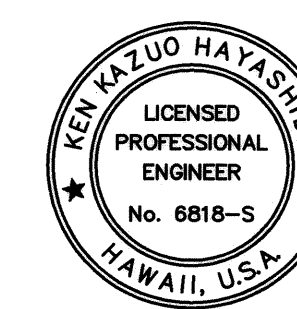

EXPIRATION DATE OF THE LICENSE 4/30/2012  
THIS WORK WAS PREPARED BY ME OR UNDER MY SUPERVISION

STATE OF HAWAII  
DEPARTMENT OF TRANSPORTATION  
HIGHWAYS DIVISION


**TYPICAL BRIDGE CROSS SECTION**  
KAMEHAMEHA V HIGHWAY  
Kawela Bridge Replacement  
Federal Aid Project No. BR-0450(8)

Scale: AS NOTED Date: June, 2010

SHEET No. S1.3 OF 93 SHEETS



FED. ROAD DIST. NO.	STATE	FED. AID PROJ. NO.	FISCAL YEAR	SHEET NO.	TOTAL SHEETS
HAWAII	HAW.	BR-0450(8)	2011	64	93

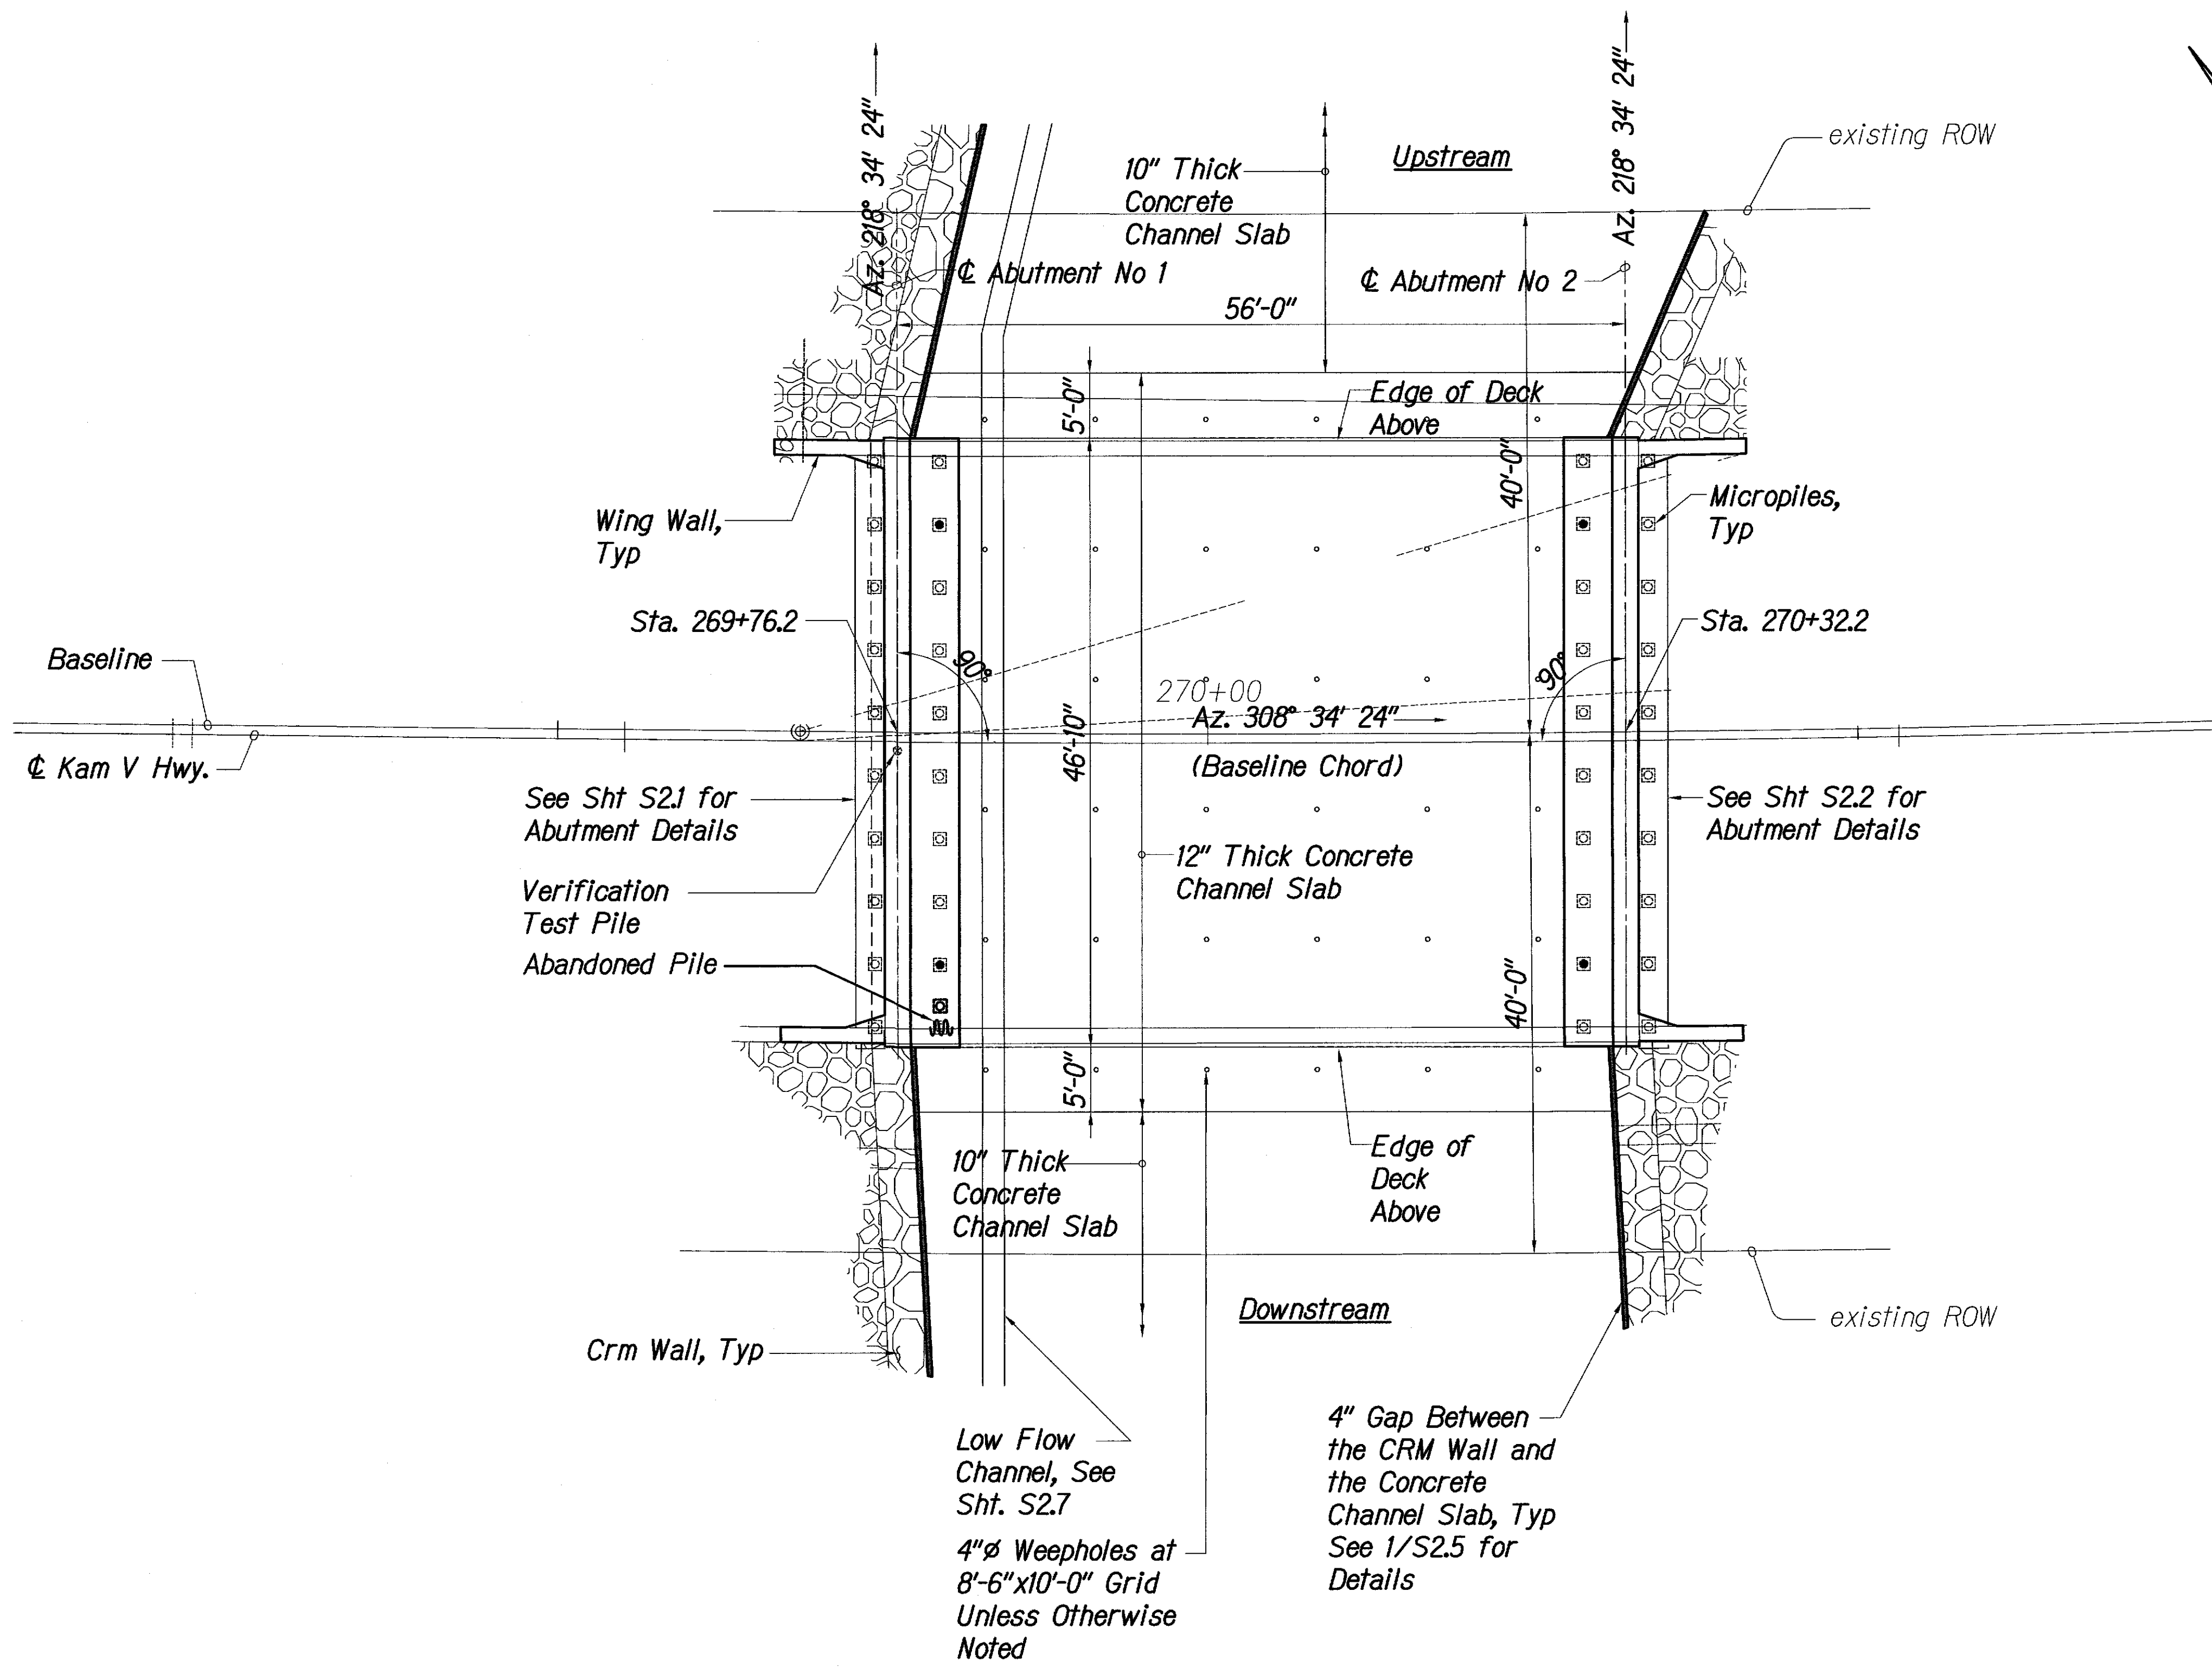


TRUE NORTH  
SCALE: 1/8" = 1'-0"

- Legend:**
- Proof Test Piles, Qty. 4
  - \* Verification Test Pile, Qty. 1

**Note:**  
Locations of proof test piles are subject to change based upon construction observations of the micropile installation.

LEGEND FOR AS-BUILT POSTINGS	
~~~~~	Squiggly line for as-built deletion
==	Double line for as-built deletion
Roadway	Text for as-built posting

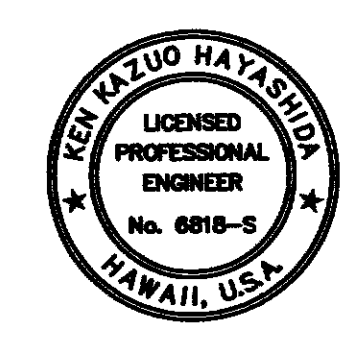

STATE OF HAWAII  
DEPARTMENT OF TRANSPORTATION  
HIGHWAYS DIVISION


**FOUNDATION LAYOUT PLAN**

**KAMEHAMEHA V HIGHWAY**  
**Kawela Bridge Replacement**  
**Federal Aid Project No. BR-0450(8)**

Scale: AS NOTED Date: June, 2010

SHEET No. **64** OF 93 SHEETS


FOUNDATION LAYOUT PLAN  
Scale: 1/8" = 1'-0"

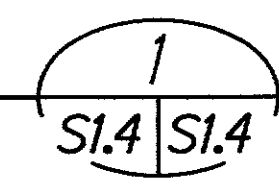

"AS-BUILT"

2016-09-13 15:28:01 Kawela Bridge AS BUILT S-1-4.dwg, 9/13/2016 3:03:18 PM, tamaraha

FED. ROAD DIST. NO.	STATE	FED. AID PROJ. NO.	FISCAL YEAR	SHEET NO.	TOTAL SHEETS
HAWAII	HAW.	BR-0450(8)	2011	65	93

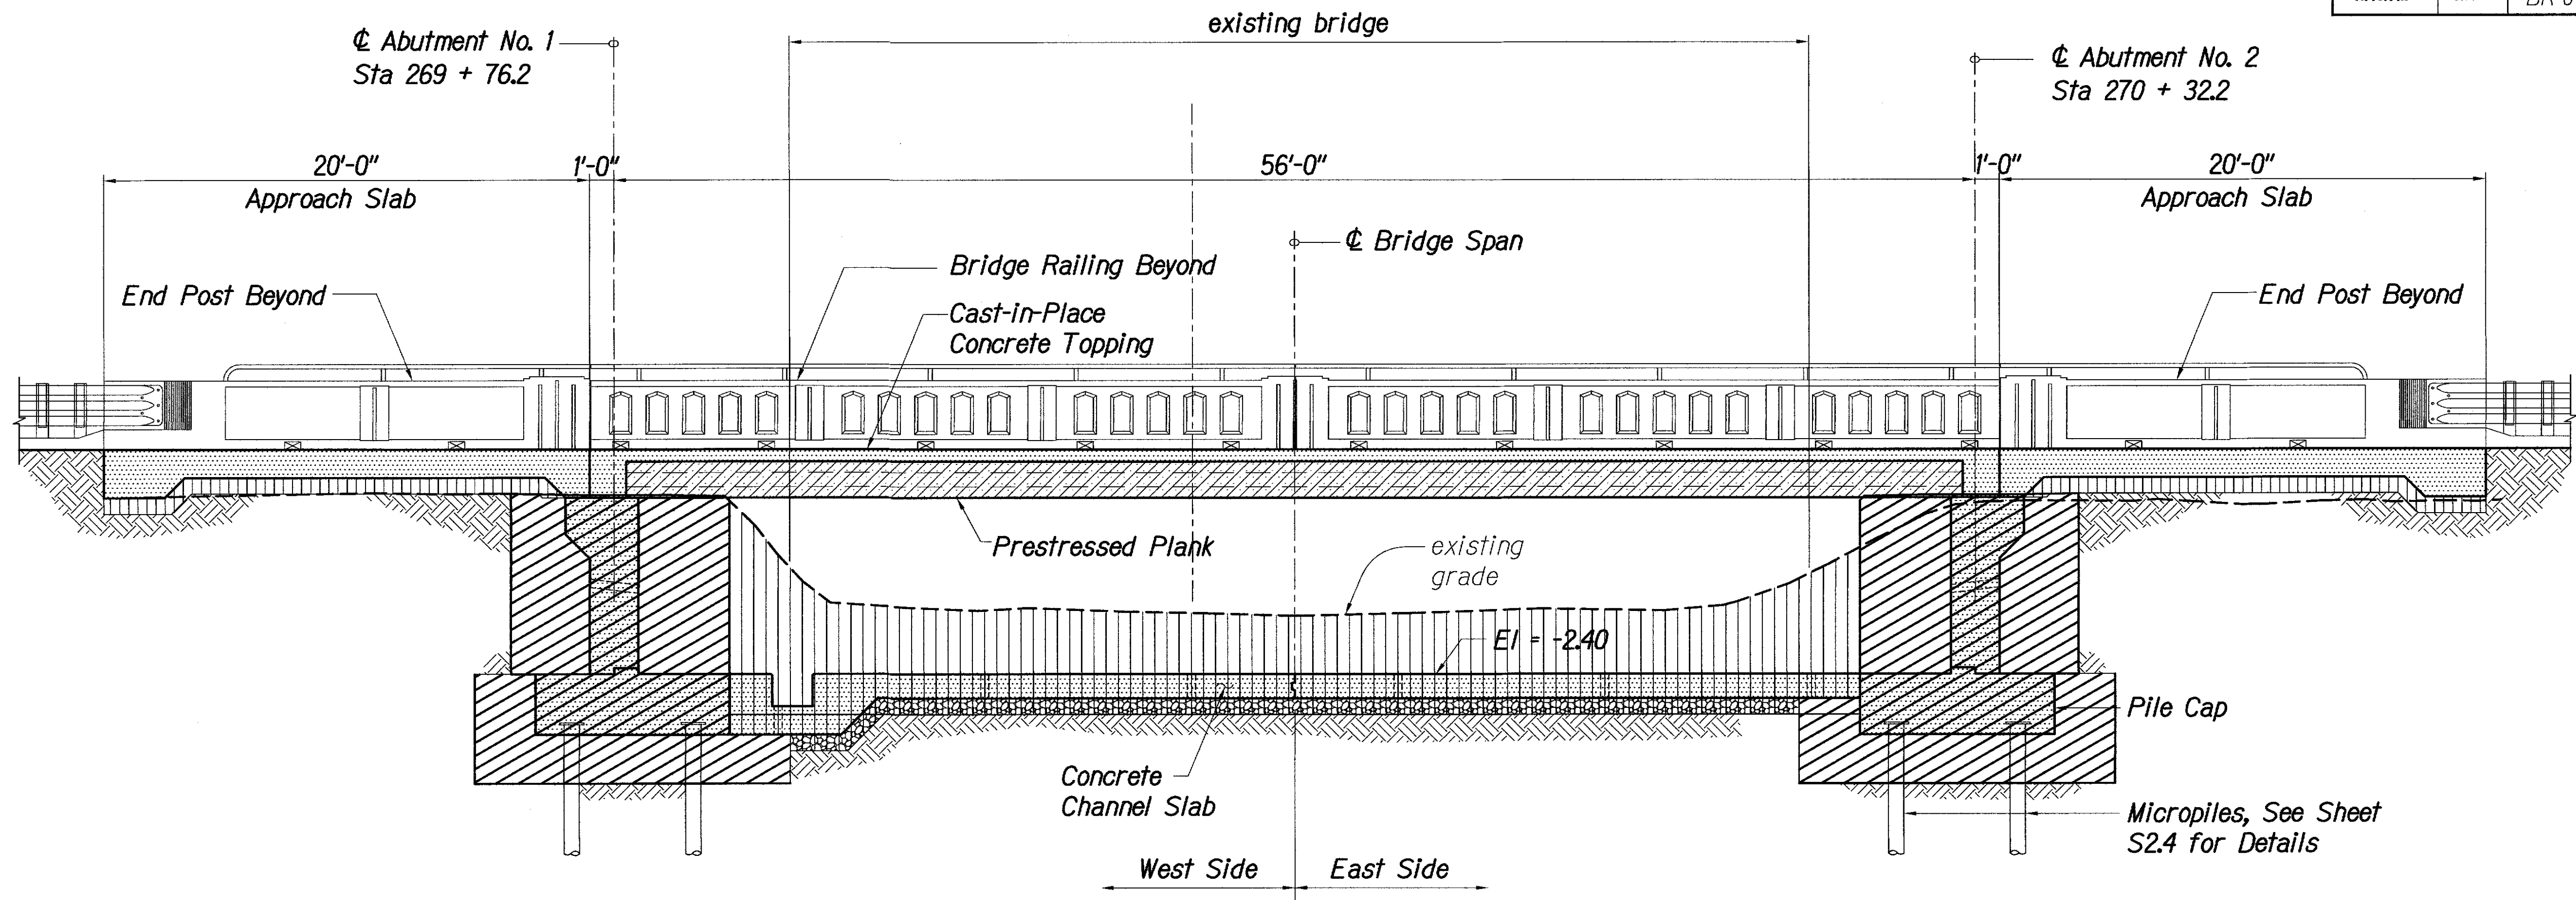


LONGITUDINAL SECTION ALONG BASE LINE  
Scale: 1/4" = 1'-0"

**Note:**  
Excavation for wingwall not shown  
and shall be considered incidental  
to excavation for abutment.

- Legend:**
- Structure Excavation for Abutment
  - Structure Excavation for Channel

LEGEND FOR AS-BUILT POSTINGS	
	Squiggly line for as-built deletion
	Double line for as-built deletion
Roadway	Text for as-built posting

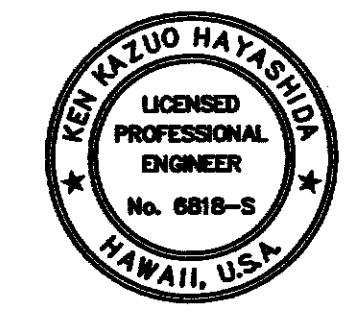

STATE OF HAWAII  
DEPARTMENT OF TRANSPORTATION  
HIGHWAYS DIVISION

**PAY LIMITS**

KAMEHAMEHA V HIGHWAY  
Kawela Bridge Replacement  
Federal Aid Project No. BR-0450(8)

Scale: AS NOTED Date: June, 2010


SHEET No. 65 OF 93 SHEETS

"AS-BUILT"

2016-09-13 15:28-01 Kawela Bridge AS BUILT S-1-5.dwg, 9/13/2016 3:03:38 PM, tamaraha




J:\2016-09-13\_1528-01 Kawela Bridge AS BUILTS\1528\_S-2-1.dwg, 9/14/2016 2:46:37 PM, tamanaha

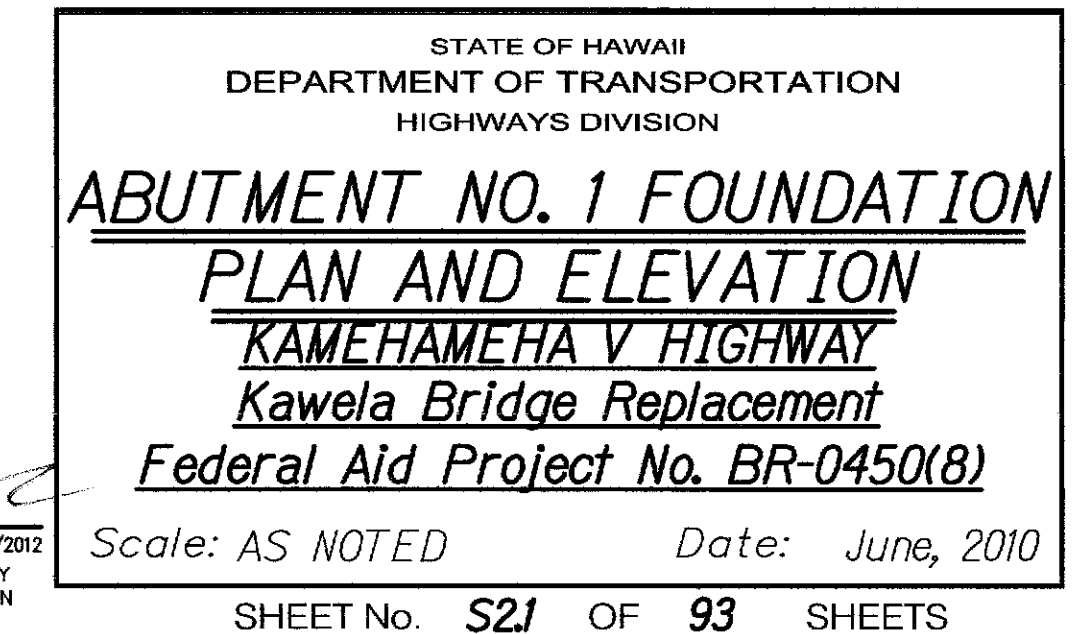


S2.1, S2.2		S2.
------------	--	-----

ADD. 66

FED. ROAD DIST. NO.	STATE	FED. AID PROJ. NO.	FISCAL YEAR	SHEET NO.	TOTAL SHEETS
HAWAII	HAW.	BR-0450(8)	2011	ADD. 67	93

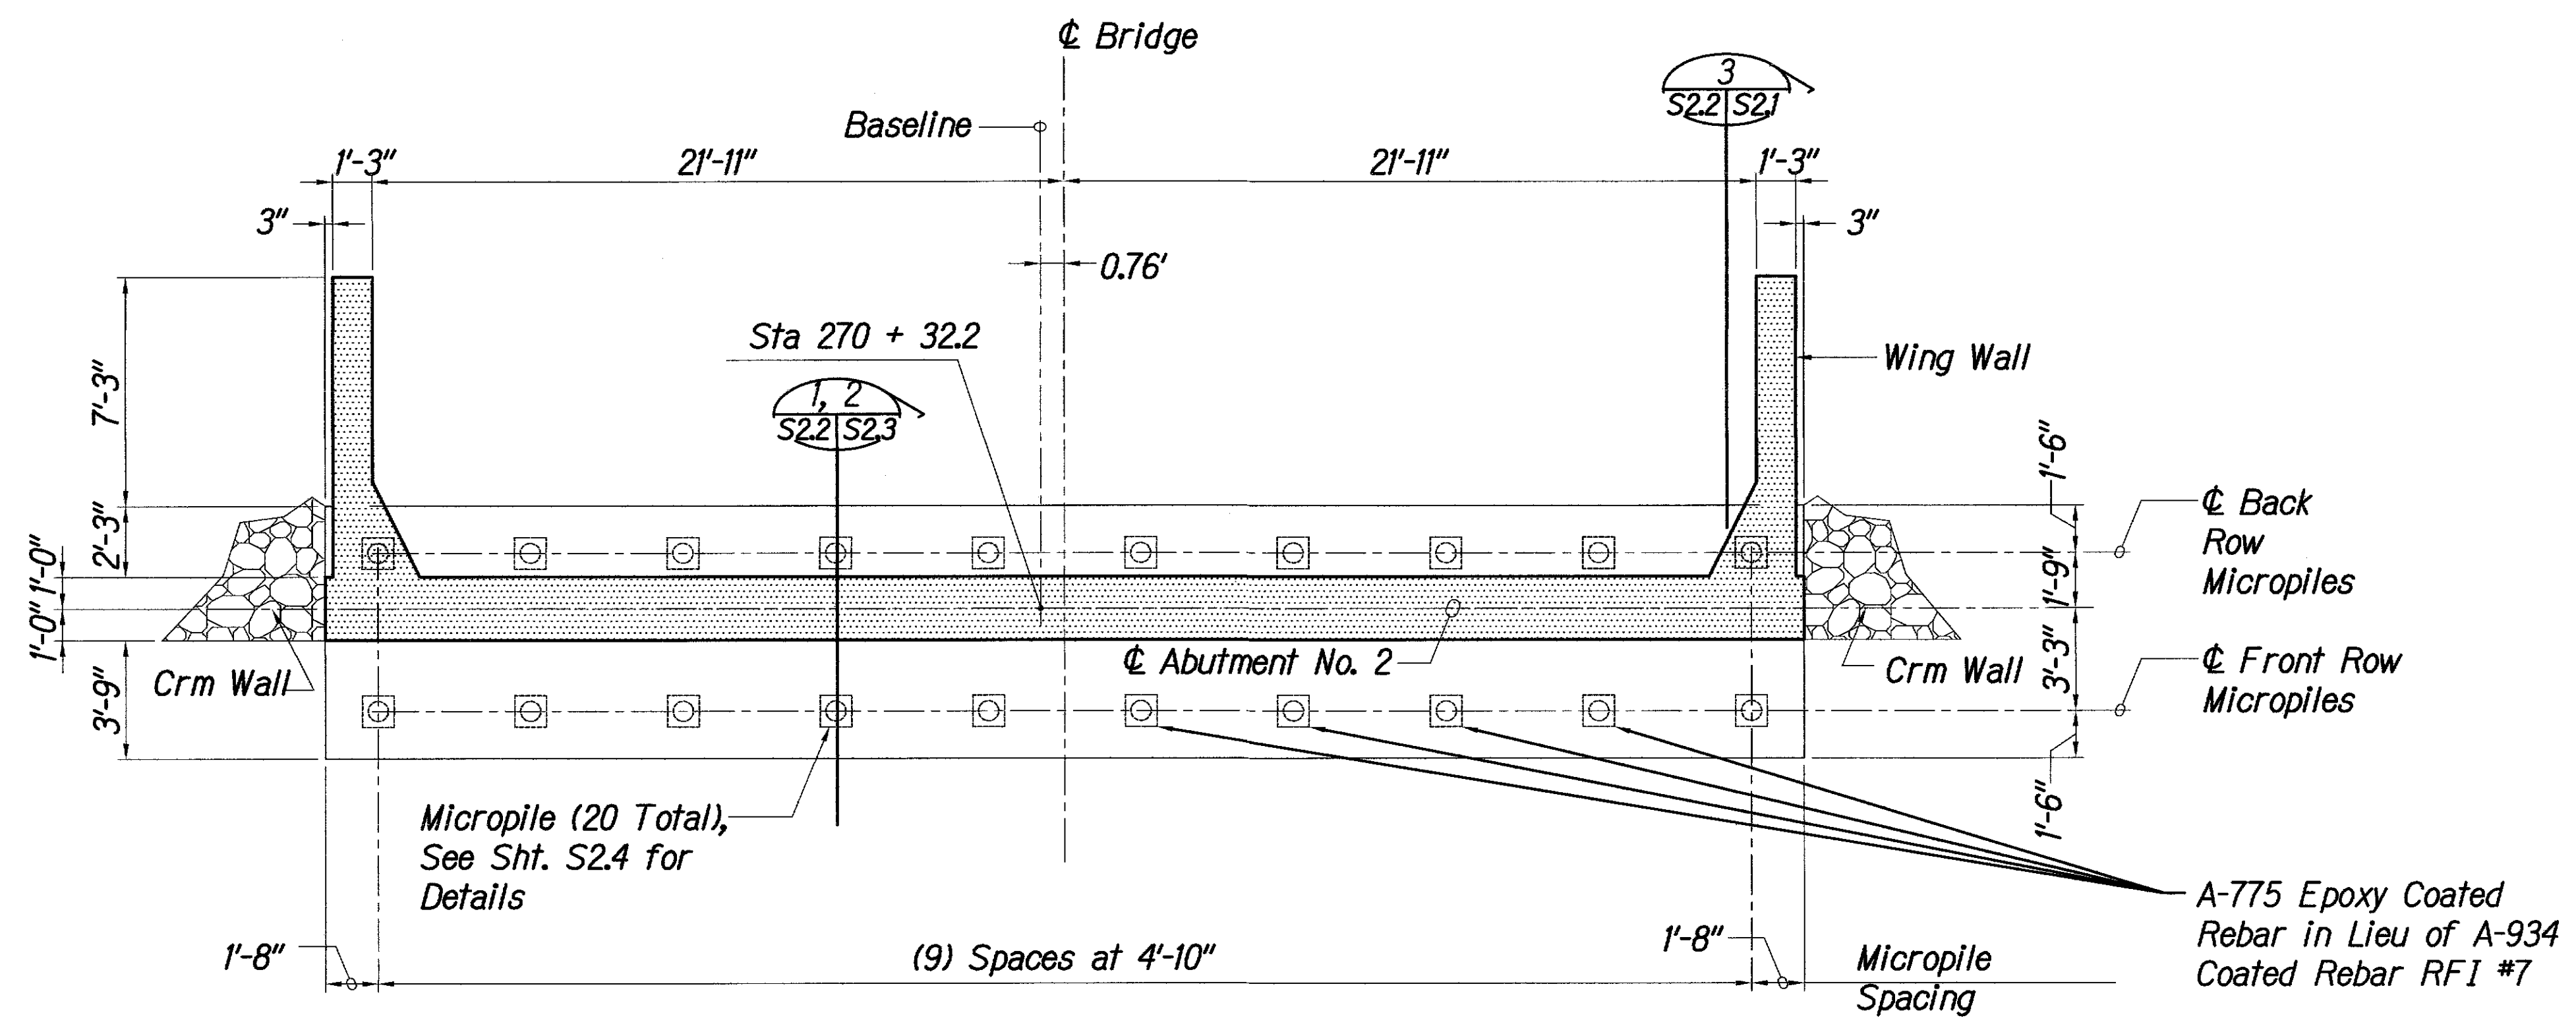

ABUTMENT NO. 2 - FOUNDATION PLAN  
Scale: 1/4" = 1'-0"

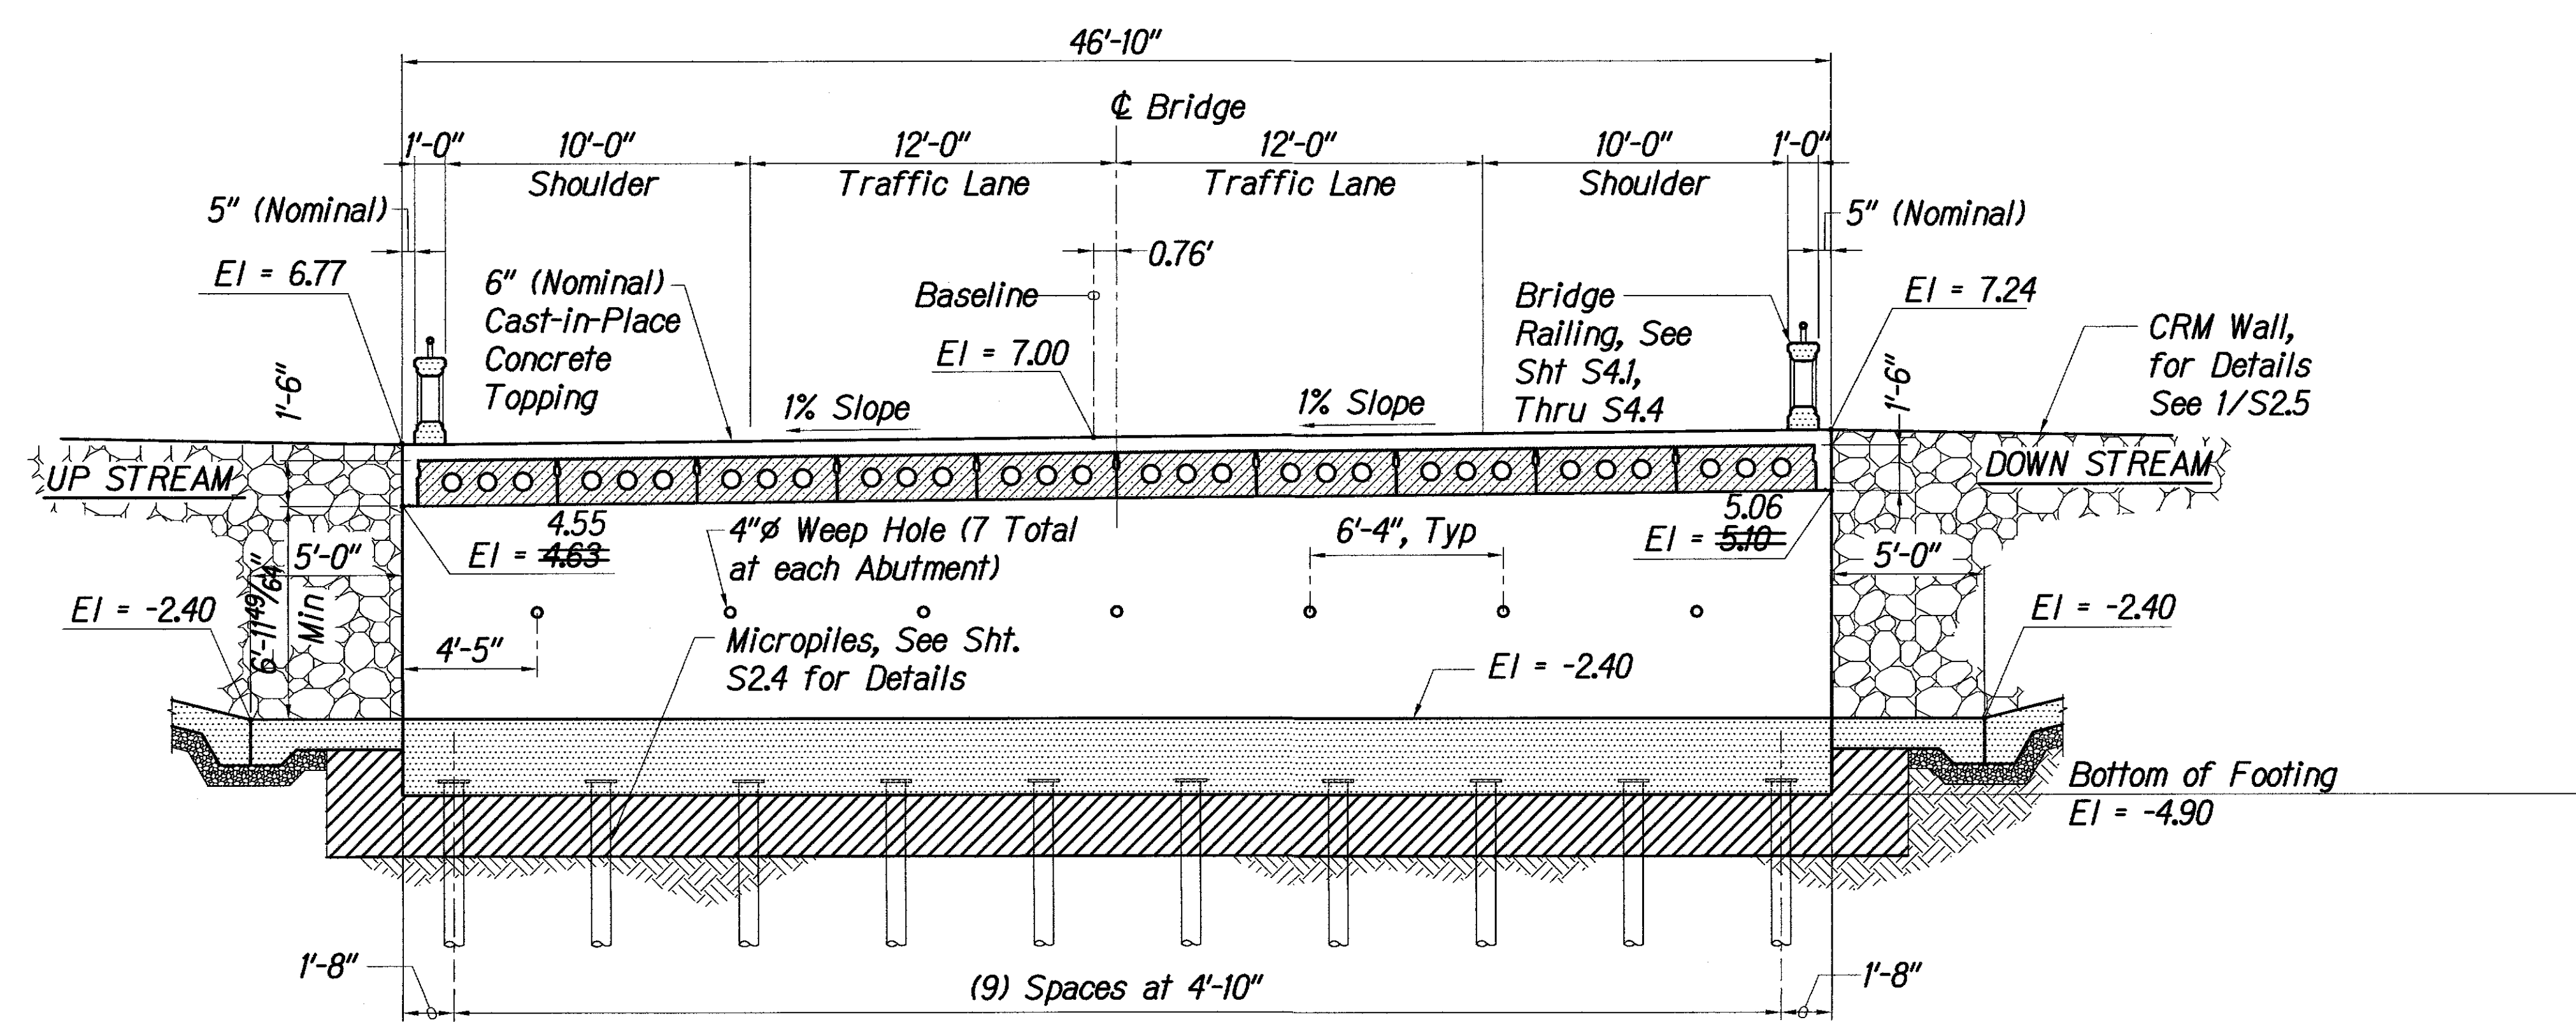

ABUTMENT NO. 2 - ELEVATION  
Scale: 1/4" = 1'-0"

LEGEND FOR AS-BUILT POSTINGS	
~~~~~	Squiggly line for as-built deletion
==	Double line for as-built deletion
Roadway	Text for as-built posting






4/14/11	Revised length and width of wingwalls, and associated dimensions
Date	Revision
STATE OF HAWAII DEPARTMENT OF TRANSPORTATION HIGHWAYS DIVISION	
ABUTMENT NO. 2 FOUNDATION PLAN AND ELEVATION KAMEHAMEHA V HIGHWAY Kawela Bridge Replacement Federal Aid Project No. BR-0450(8)	
Scale: AS NOTED	Date: June, 2010
SHEET No. S22 OF 93 SHEETS	



EXPIRATION DATE OF THE LICENSE 4/30/2012  
THIS WORK WAS PREPARED BY ME OR UNDER MY SUPERVISION



FED. ROAD DIST. NO.	STATE	FED. AID PROJ. NO.	FISCAL YEAR	SHEET NO.	TOTAL SHEETS
HAWAII	HAW.	BR-0450(8)	2011	ADD. 68	93

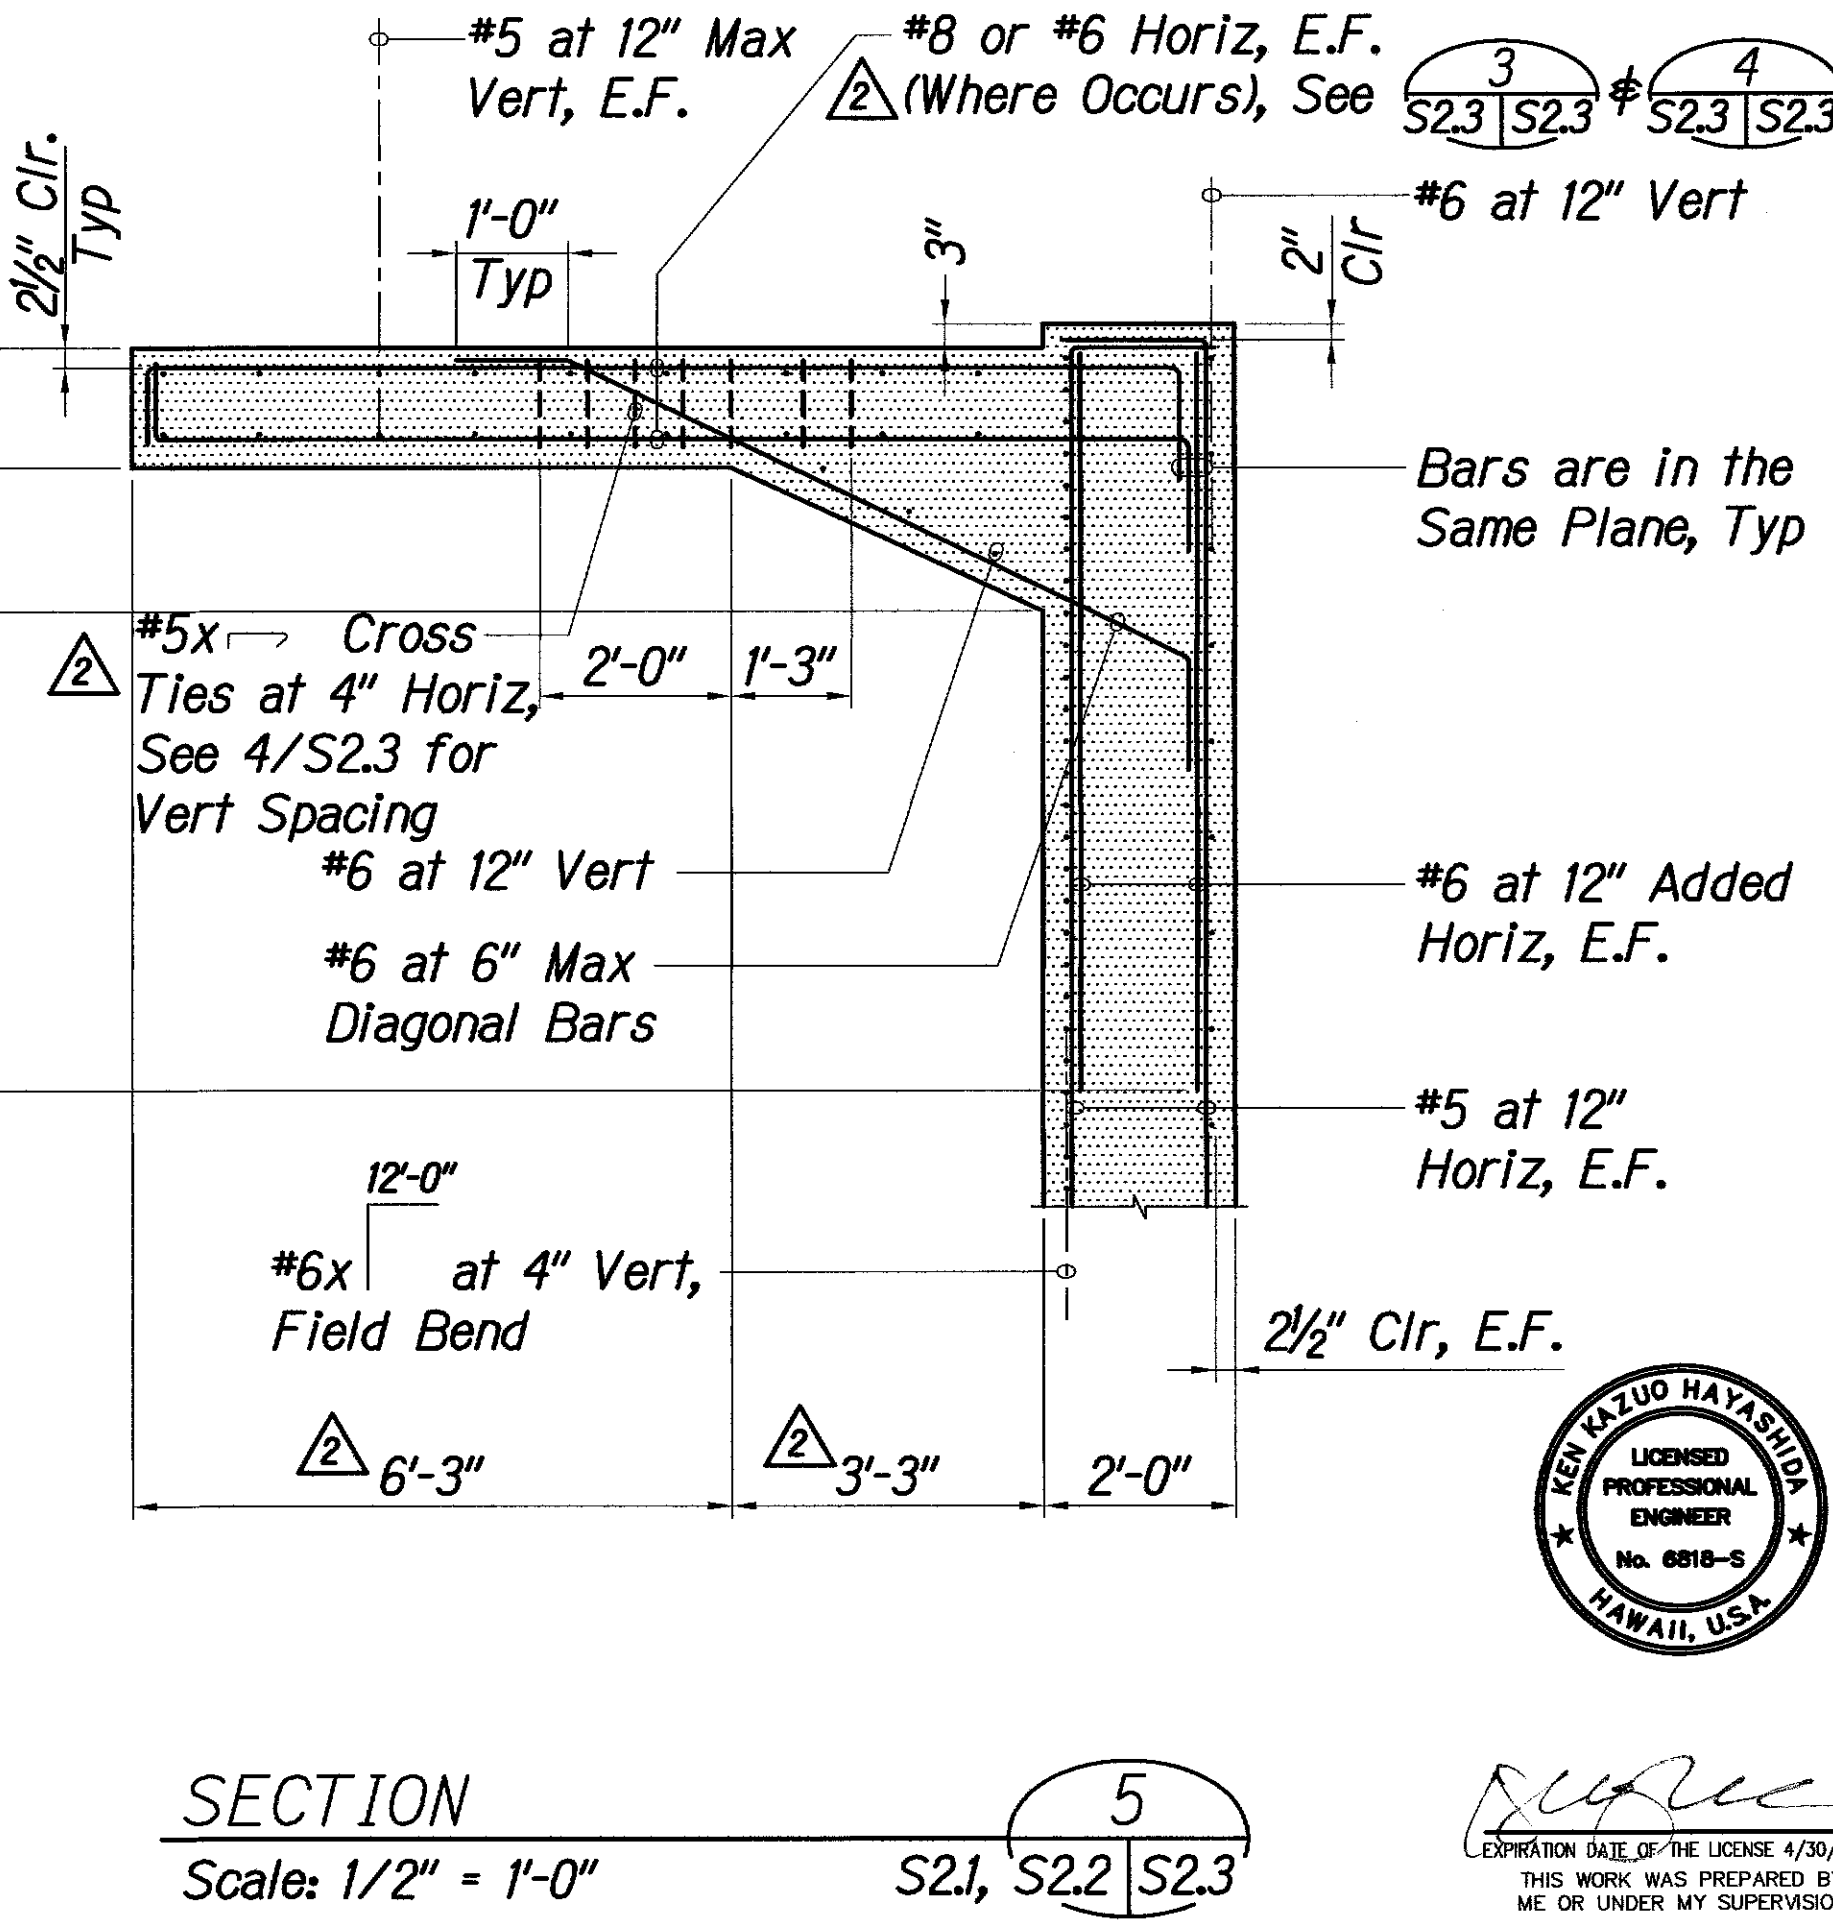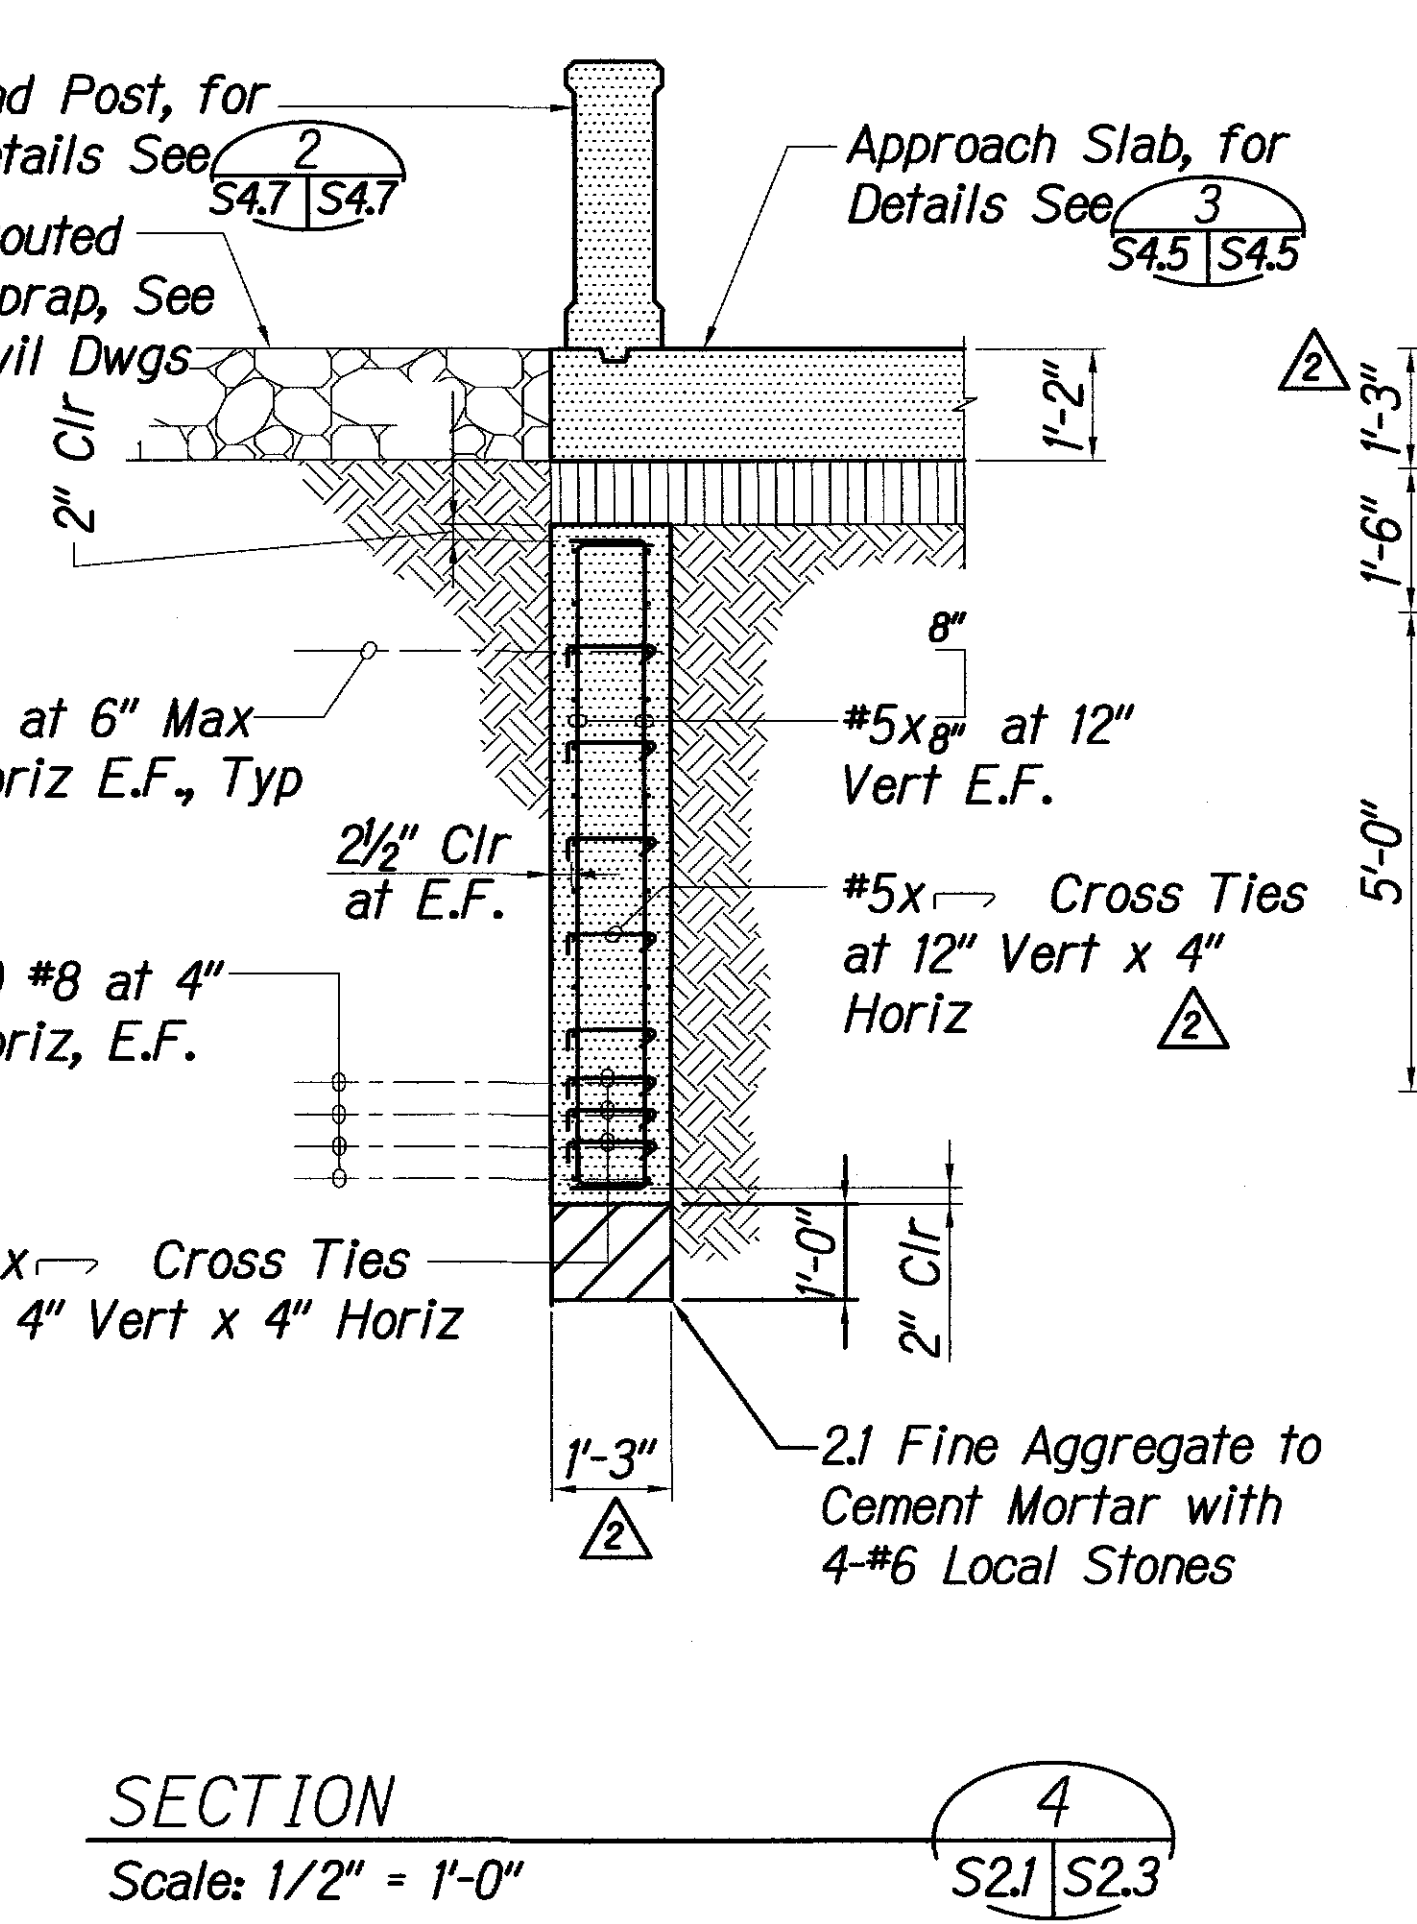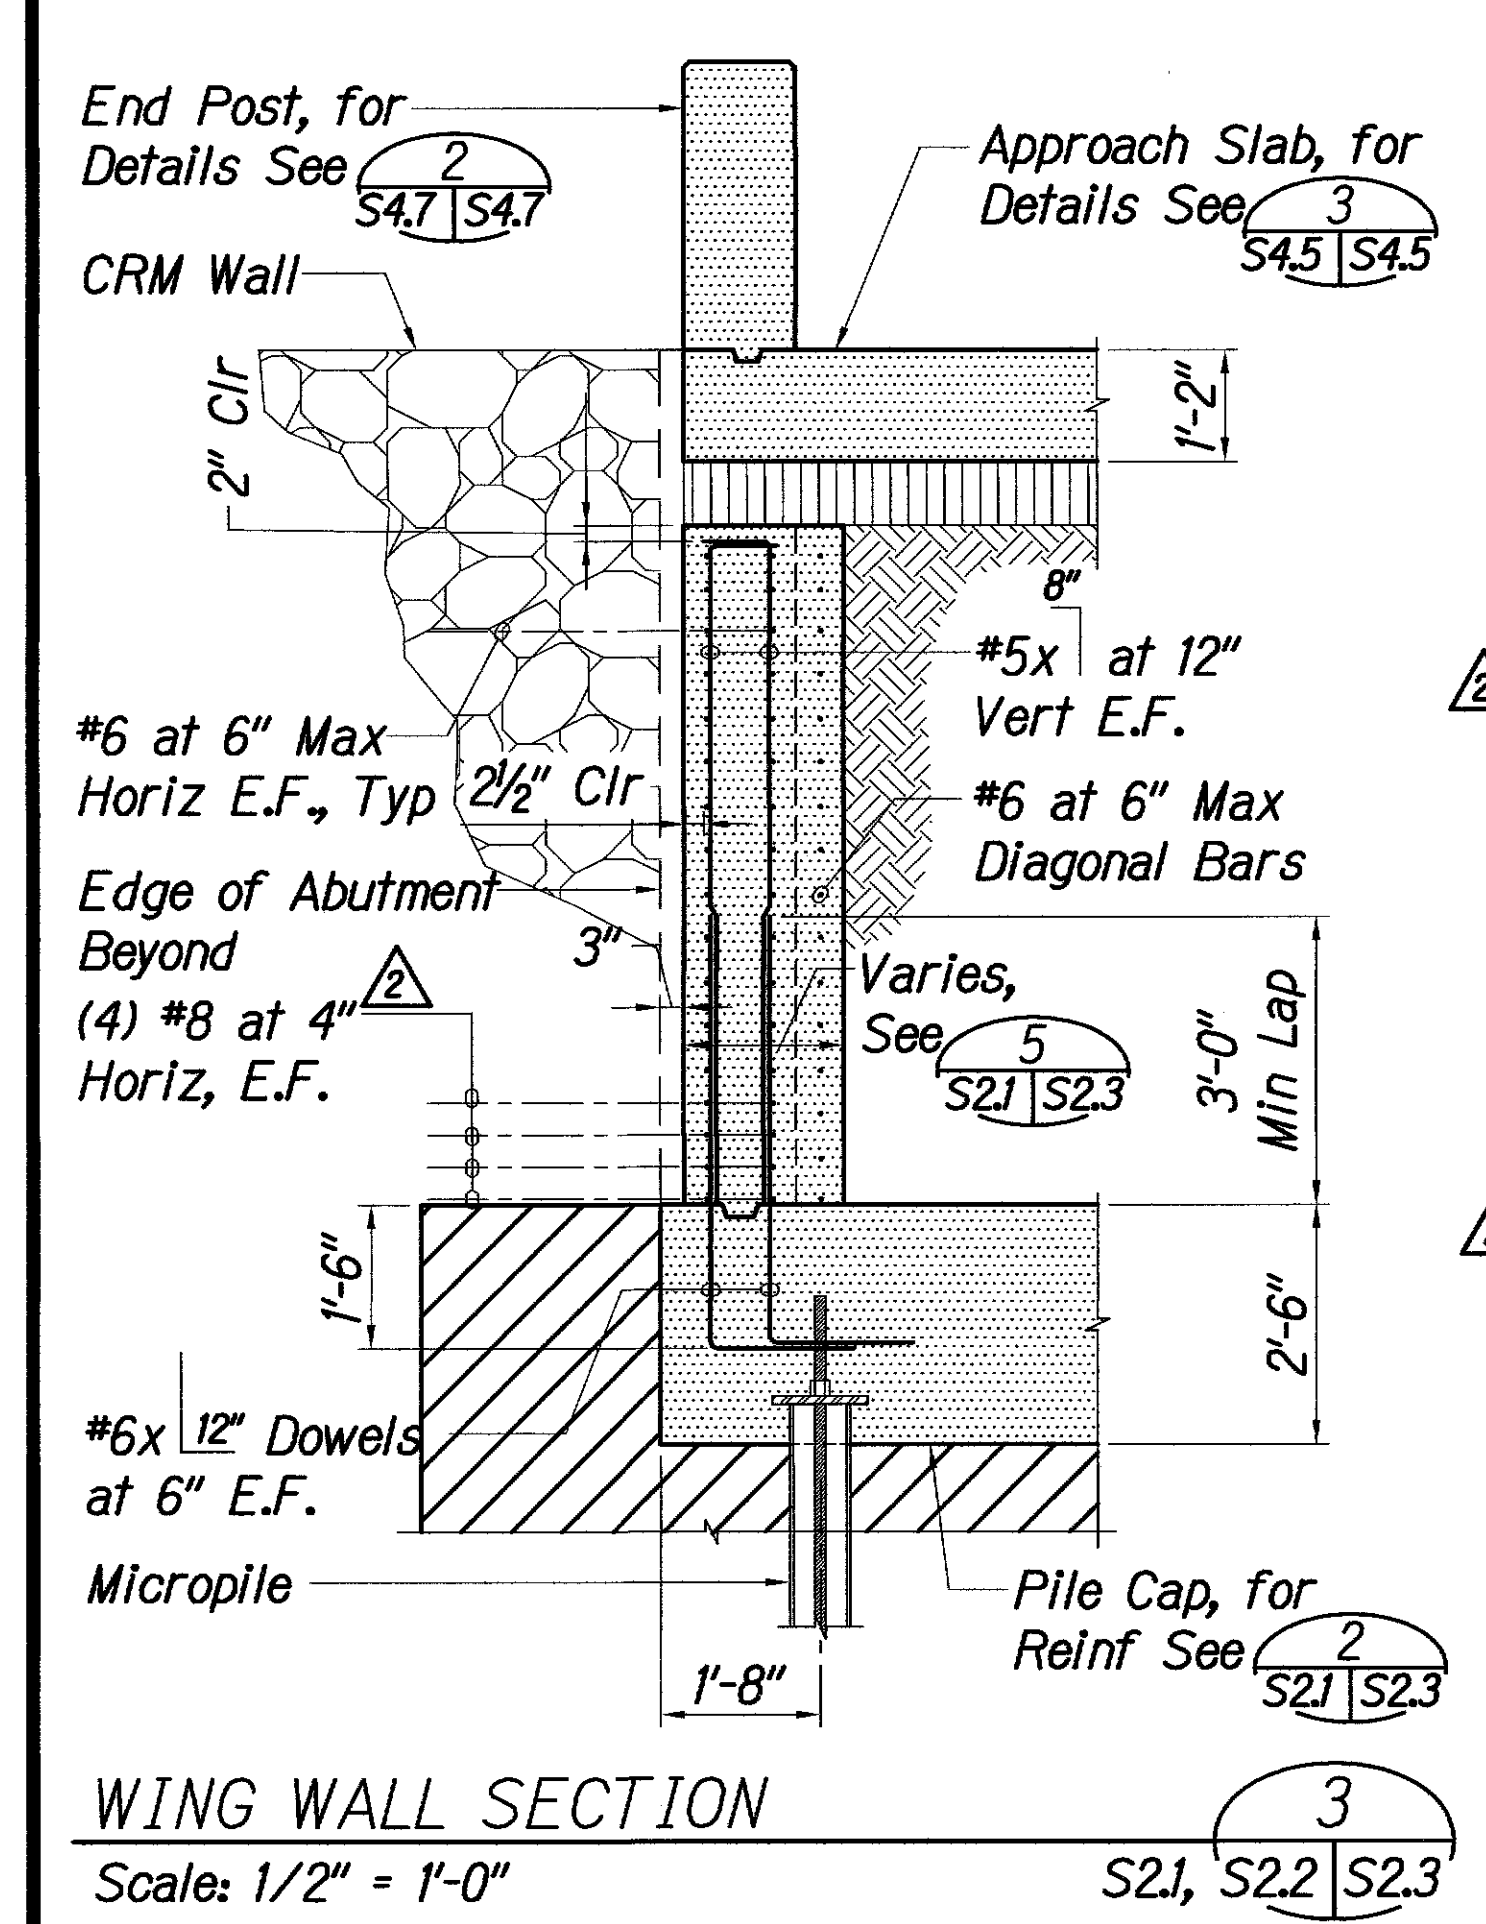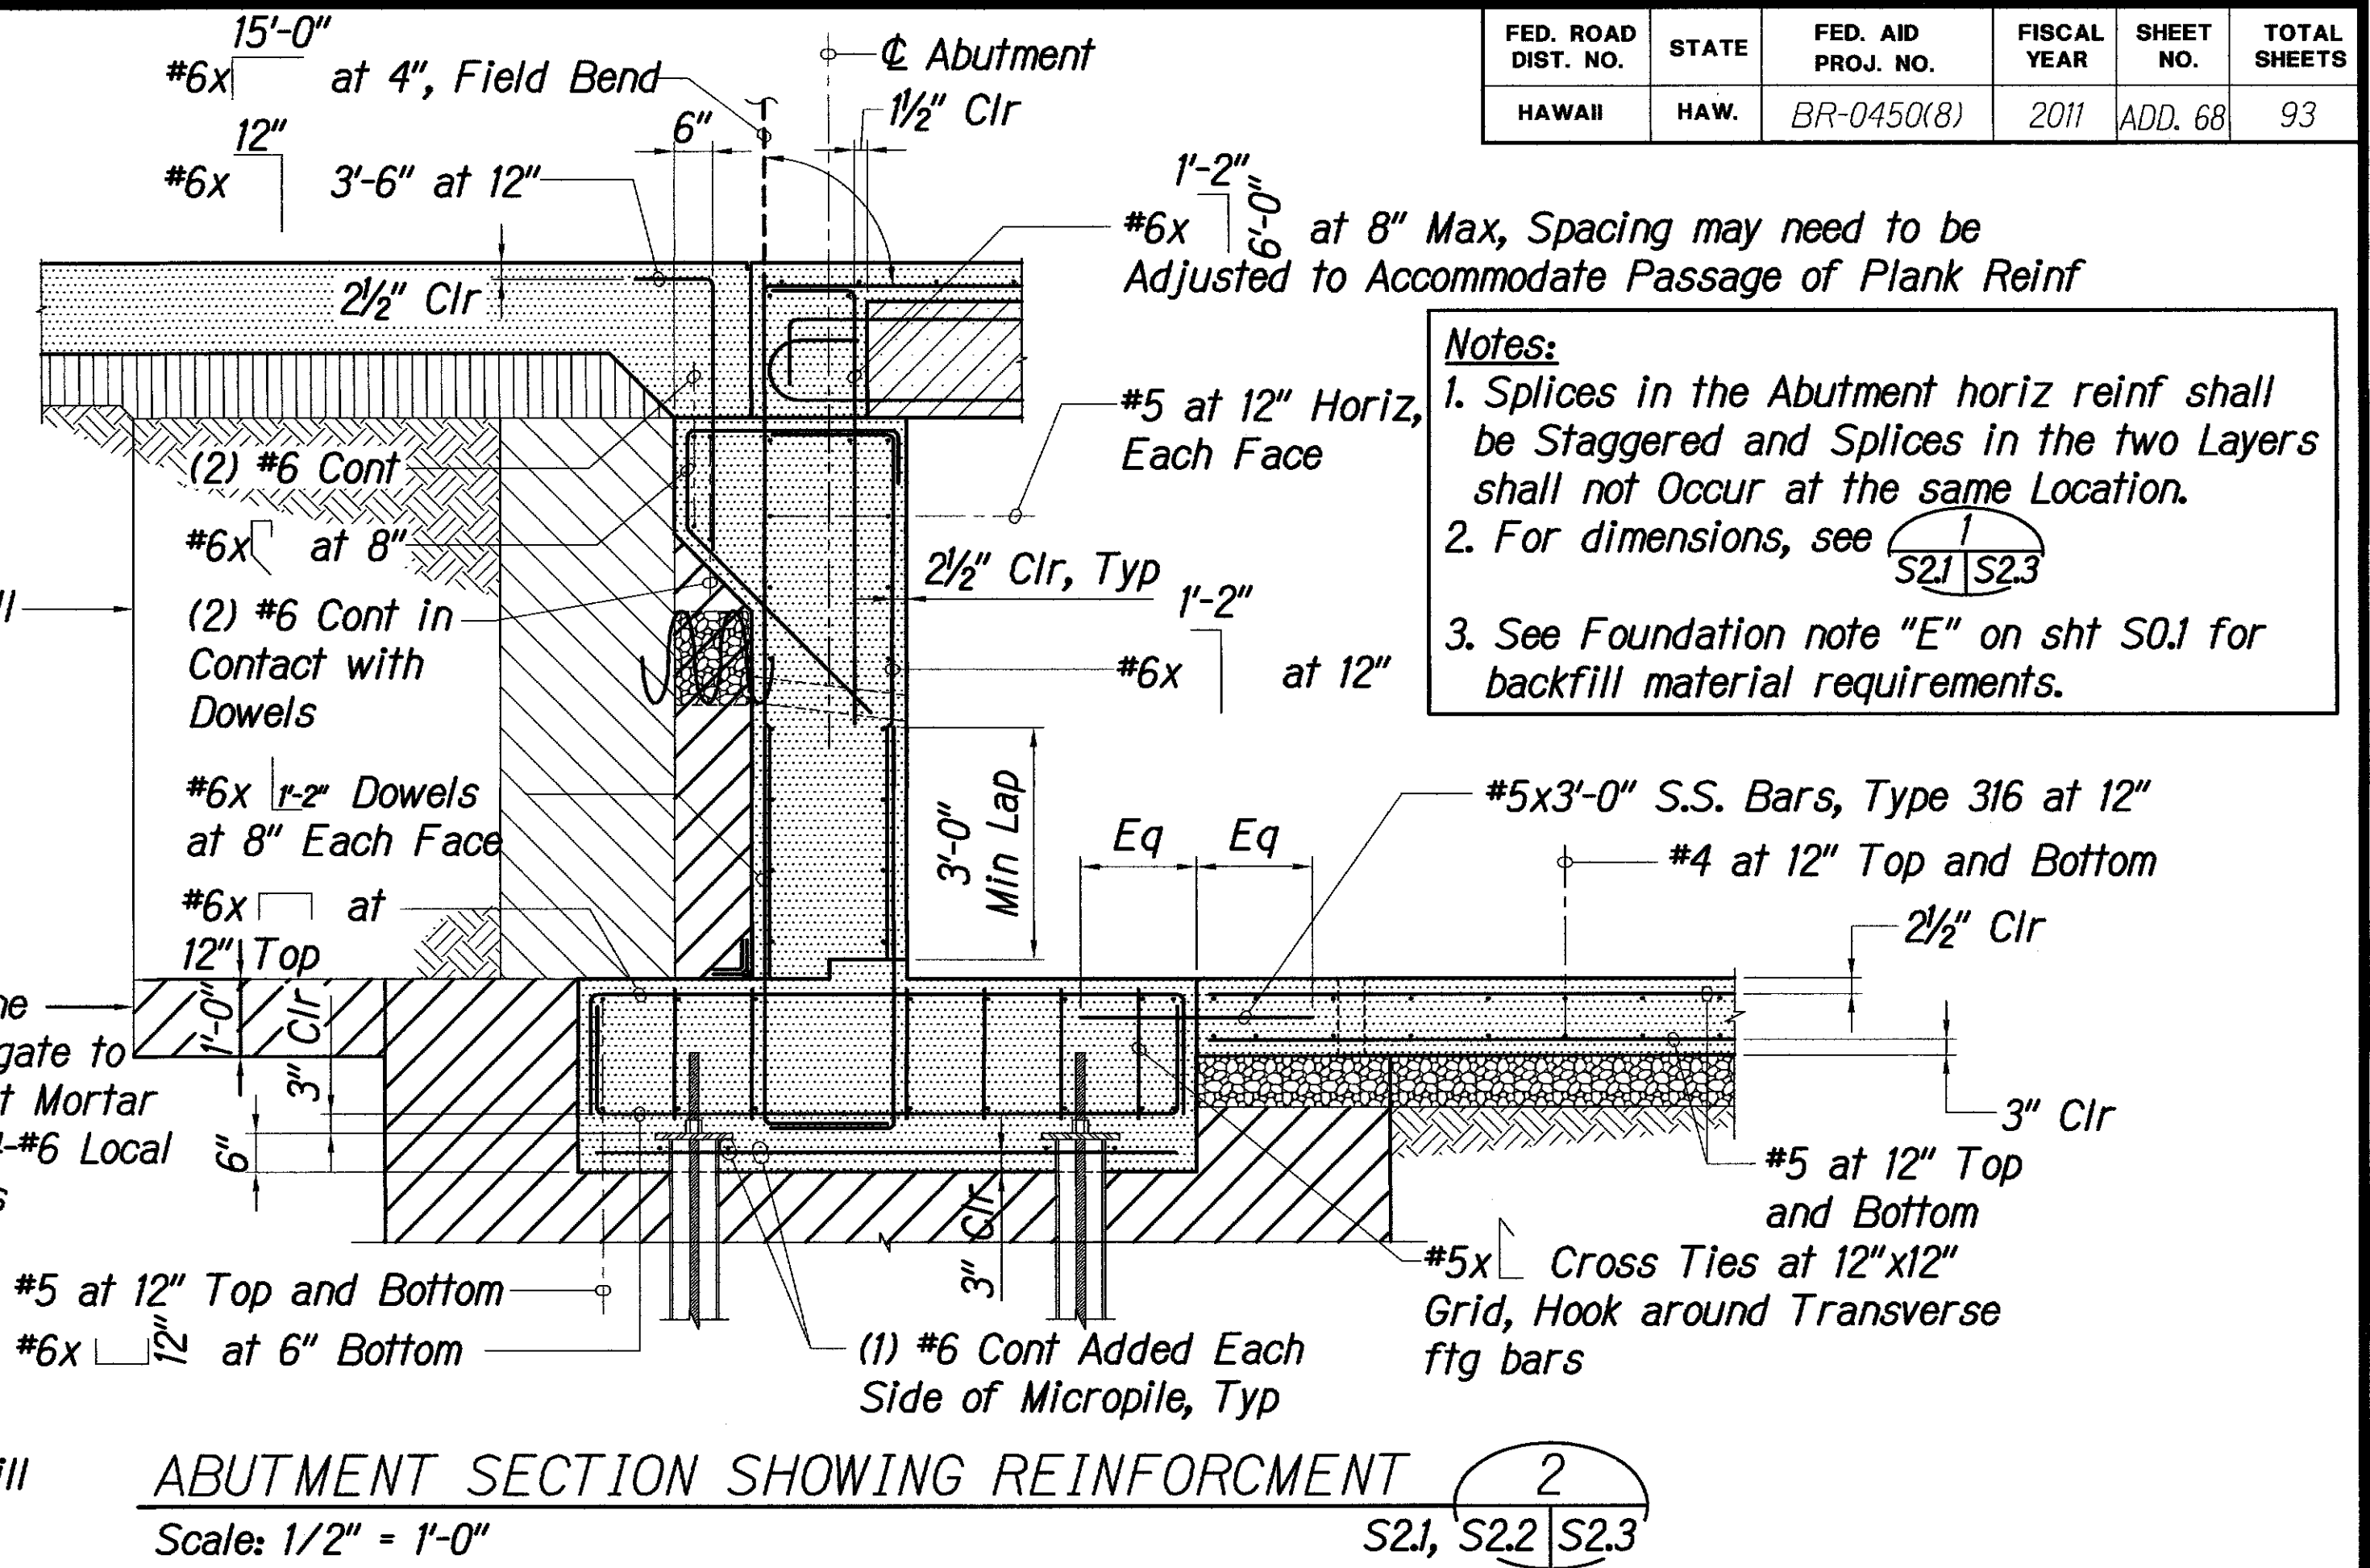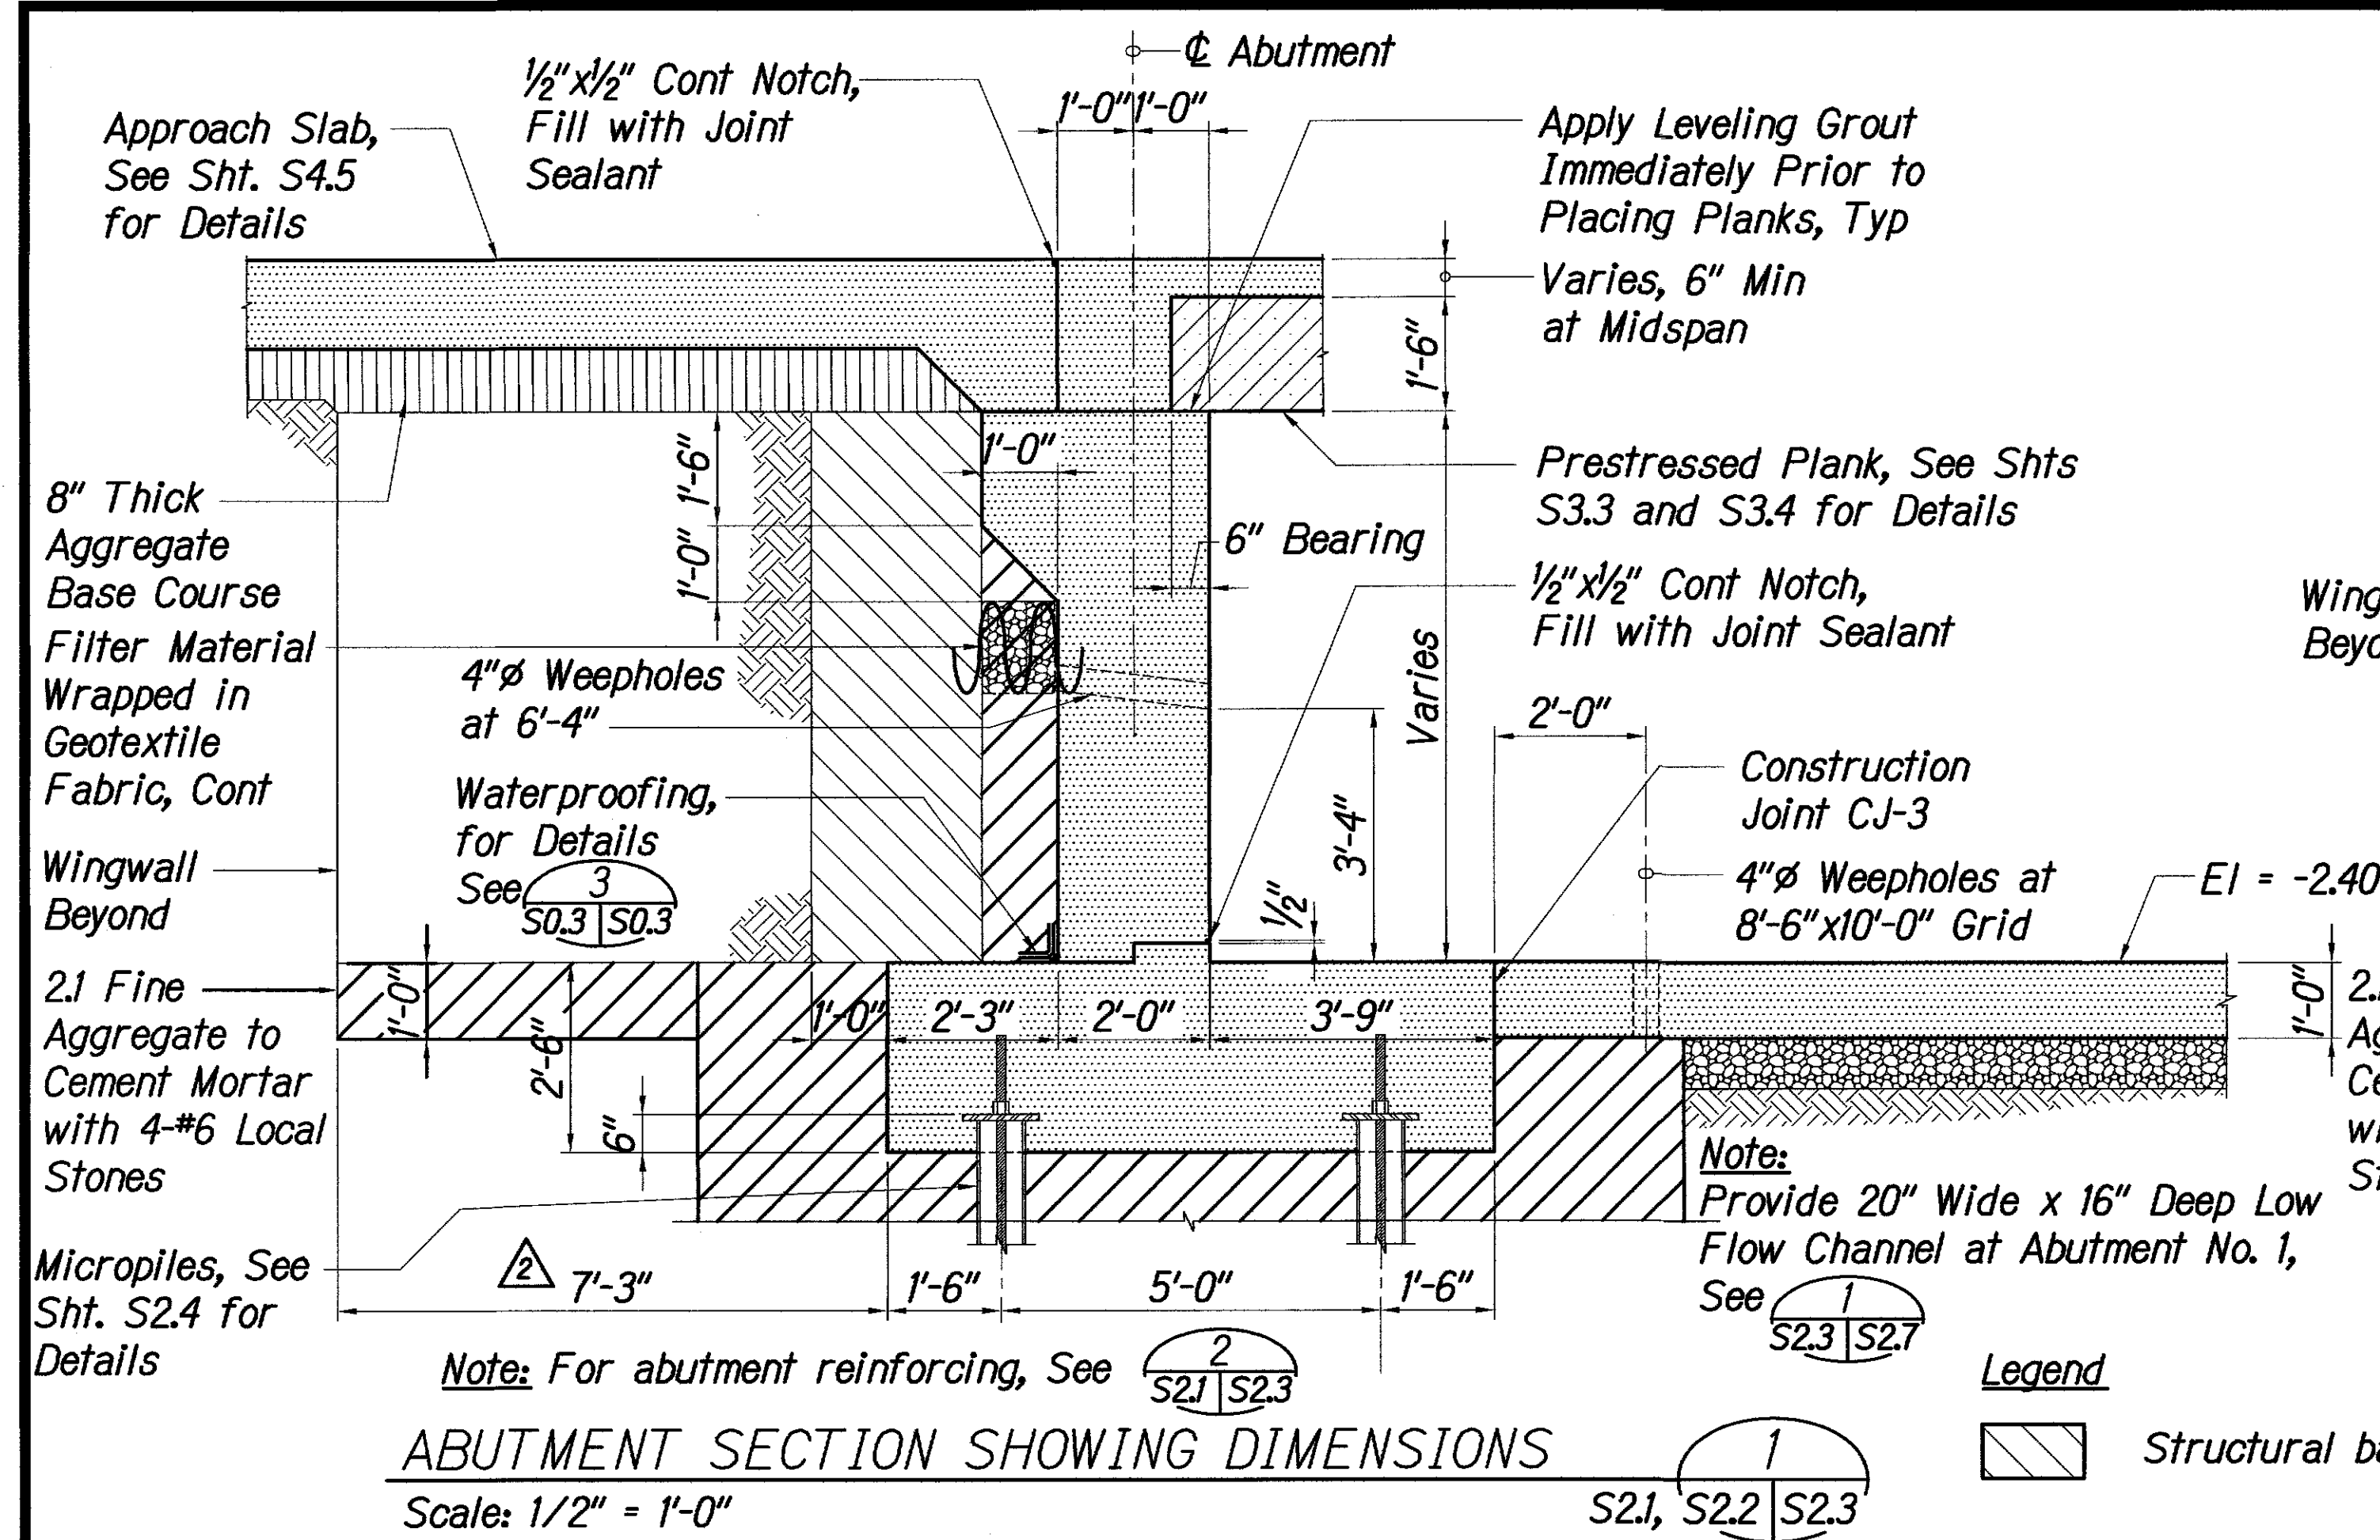

**LEGEND FOR AS-BUILT POSTINGS**

~~~~~	Squiggly line for as-built deletion
==	Double line for as-built deletion
Roadway	Text for as-built posting

Revised length and width of wingwalls, and associated dimensions

4/14/11

Date Revision

STATE OF HAWAII  
DEPARTMENT OF TRANSPORTATION  
HIGHWAYS DIVISION

**ABUTMENT SECTIONS AND DETAILS**

**KAMEHAMEHA V HIGHWAY**

**Kawela Bridge Replacement**

**Federal Aid Project No. BR-0450(8)**

Scale: AS NOTED Date: June, 2010


SHEET No. S23 OF 93 SHEETS






FED. ROAD DIST. NO.	STATE	FED. AID PROJ. NO.	FISCAL YEAR	SHEET NO.	TOTAL SHEETS
HAWAII	HAW.	BR-0450(8)	2011	70	93

- Cement Rubble Masonry (CRM):**
- A. Stones shall be clean, hard, sound, and durable. Each stone, except stones for filling or pinning interstices, shall have a thickness of not less than 6 inches and a width of not less than one and one half times the thickness or 12 inches, whichever is greater.
  - B. Mortar shall be type "S" conforming to ASTM C270 and have a minimum compressive strength of 1,800 psi at 28 days.
  - C. Cement rubble masonry shall be constructed by experienced workmen.
  - D. Selected stones shall be roughly squared and pitched to lines at angles and ends of walls.
  - E. Stones shall be wet thoroughly before laying.
  - F. Stone joints shall overlap at least 6 inches and form a firm bond.
  - G. Stones for bottom course shall be large, flat and fully bedded in mortar.
  - H. Horizontal joints in the face of the wall shall not exceed 1 inch in thickness and vertical joints shall not exceed 2 inches in width.
  - I. CRM Wall subgrade shall be over-excavated by a minimum of 2 feet below the bottom of the wall and replace with open-graded gravel, such as AASHTO M43, No. 67 gradation wrapped on all sides with non-woven geotextile fabric.

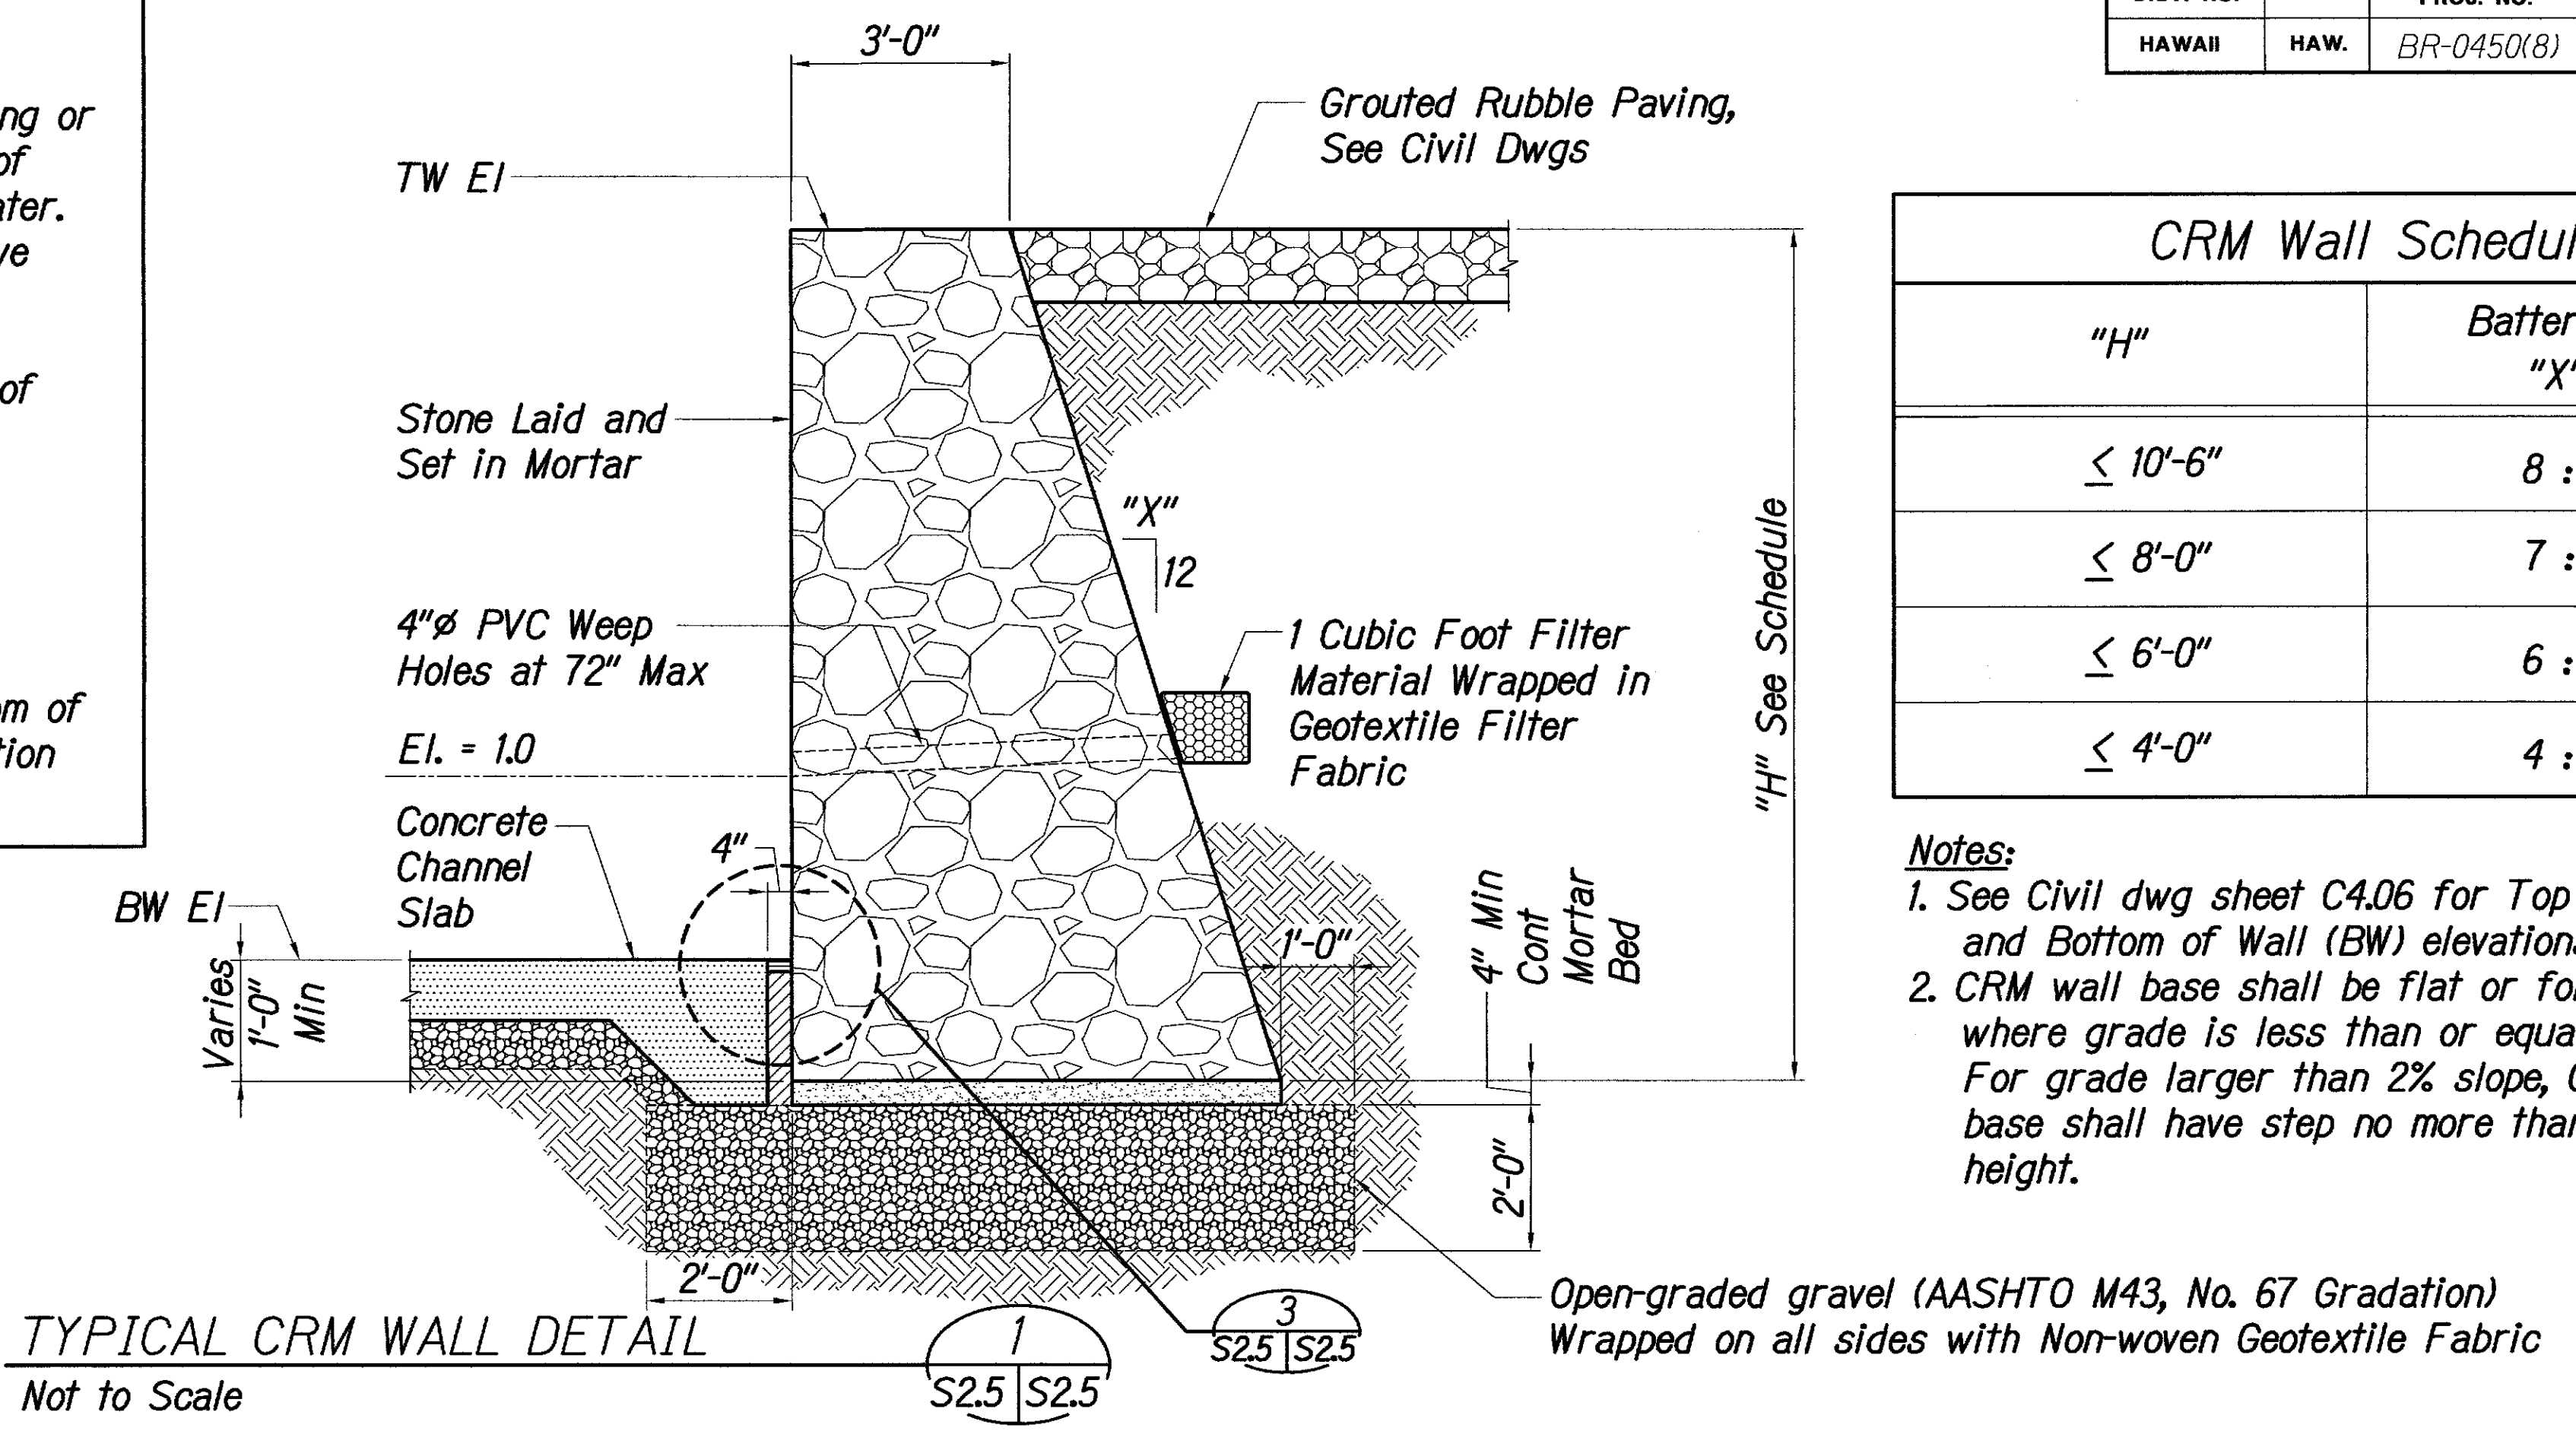


CRM Wall Schedule	
"H"	Batter on Back "X" : 12
≤ 10'-6"	8 : 12
≤ 8'-0"	7 : 12
≤ 6'-0"	6 : 12
≤ 4'-0"	4 : 12

- Notes:**
- 1. See civil dwg sheet C4.06 for Top of Wall (TW) and Bottom of Wall (BW) elevations.
  - 2. CRM wall base shall be flat or follow grade where grade is less than or equal to 2% slope. For grade larger than 2% slope, CRM wall base shall have step no more than 2'-0" in height.

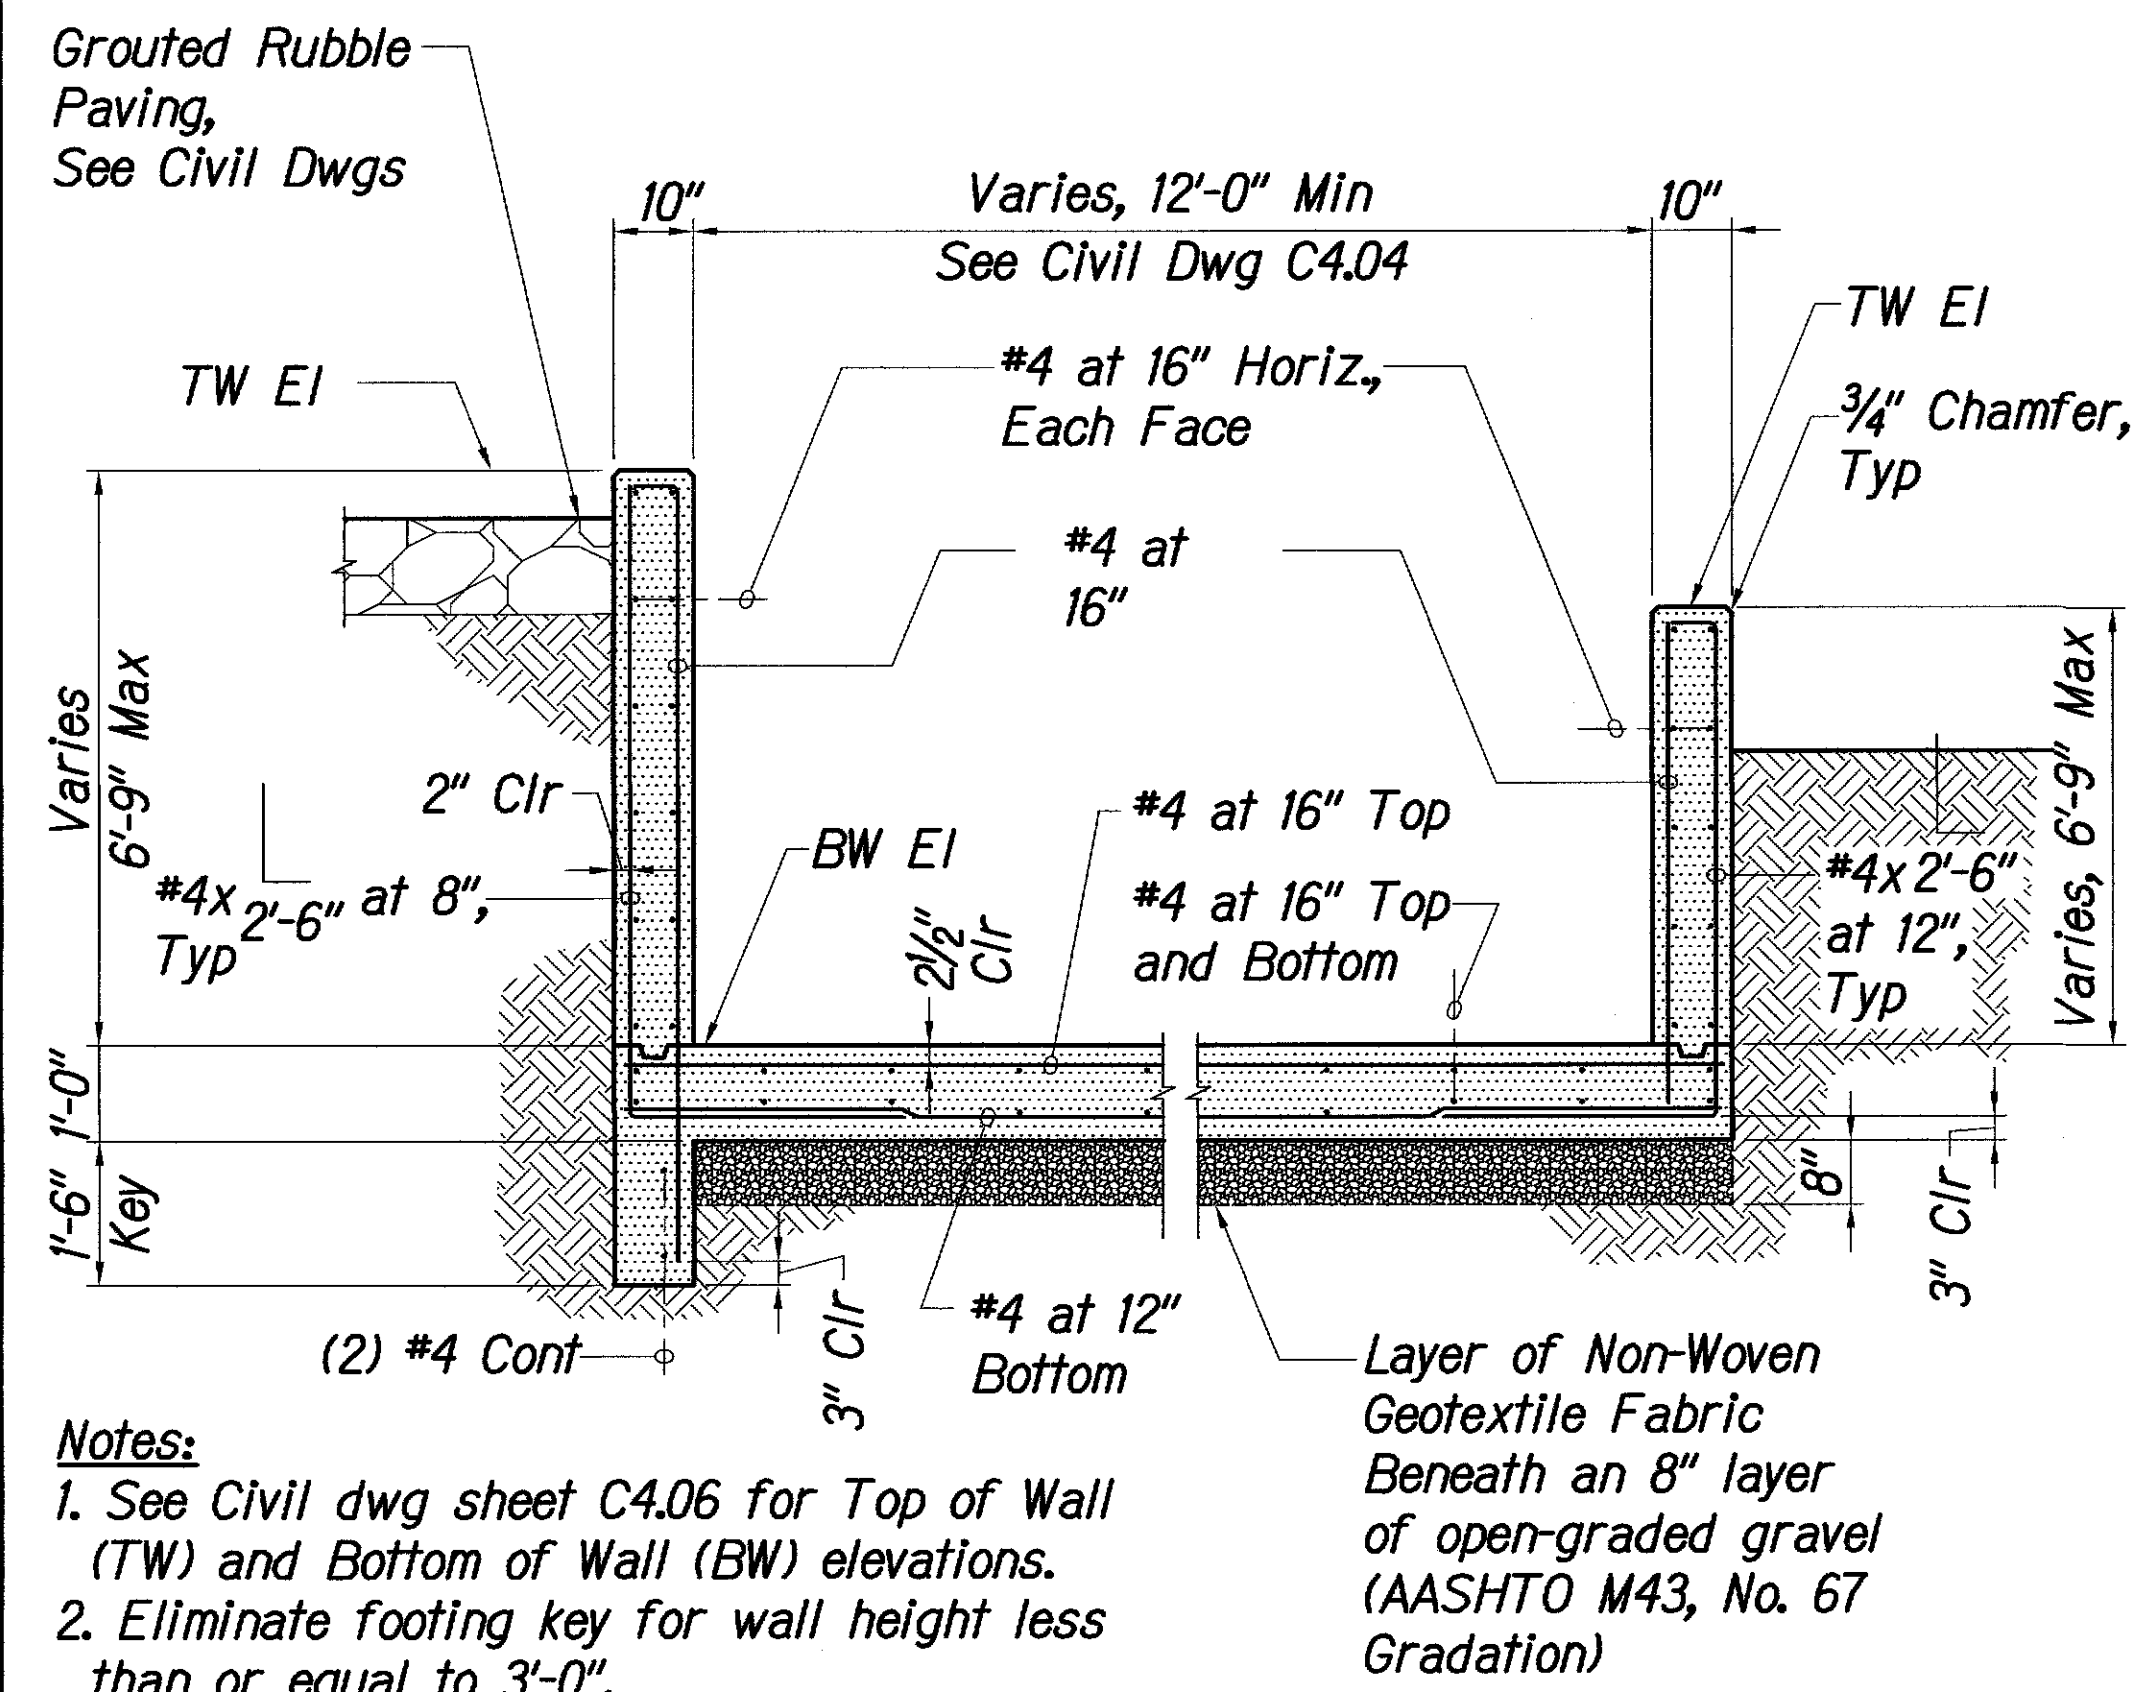


- Notes:**
- 1. See Civil dwg sheet C4.06 for Top of Wall (TW) and Bottom of Wall (BW) elevations.
  - 2. Eliminate footing key for wall height less than or equal to 3'-0".

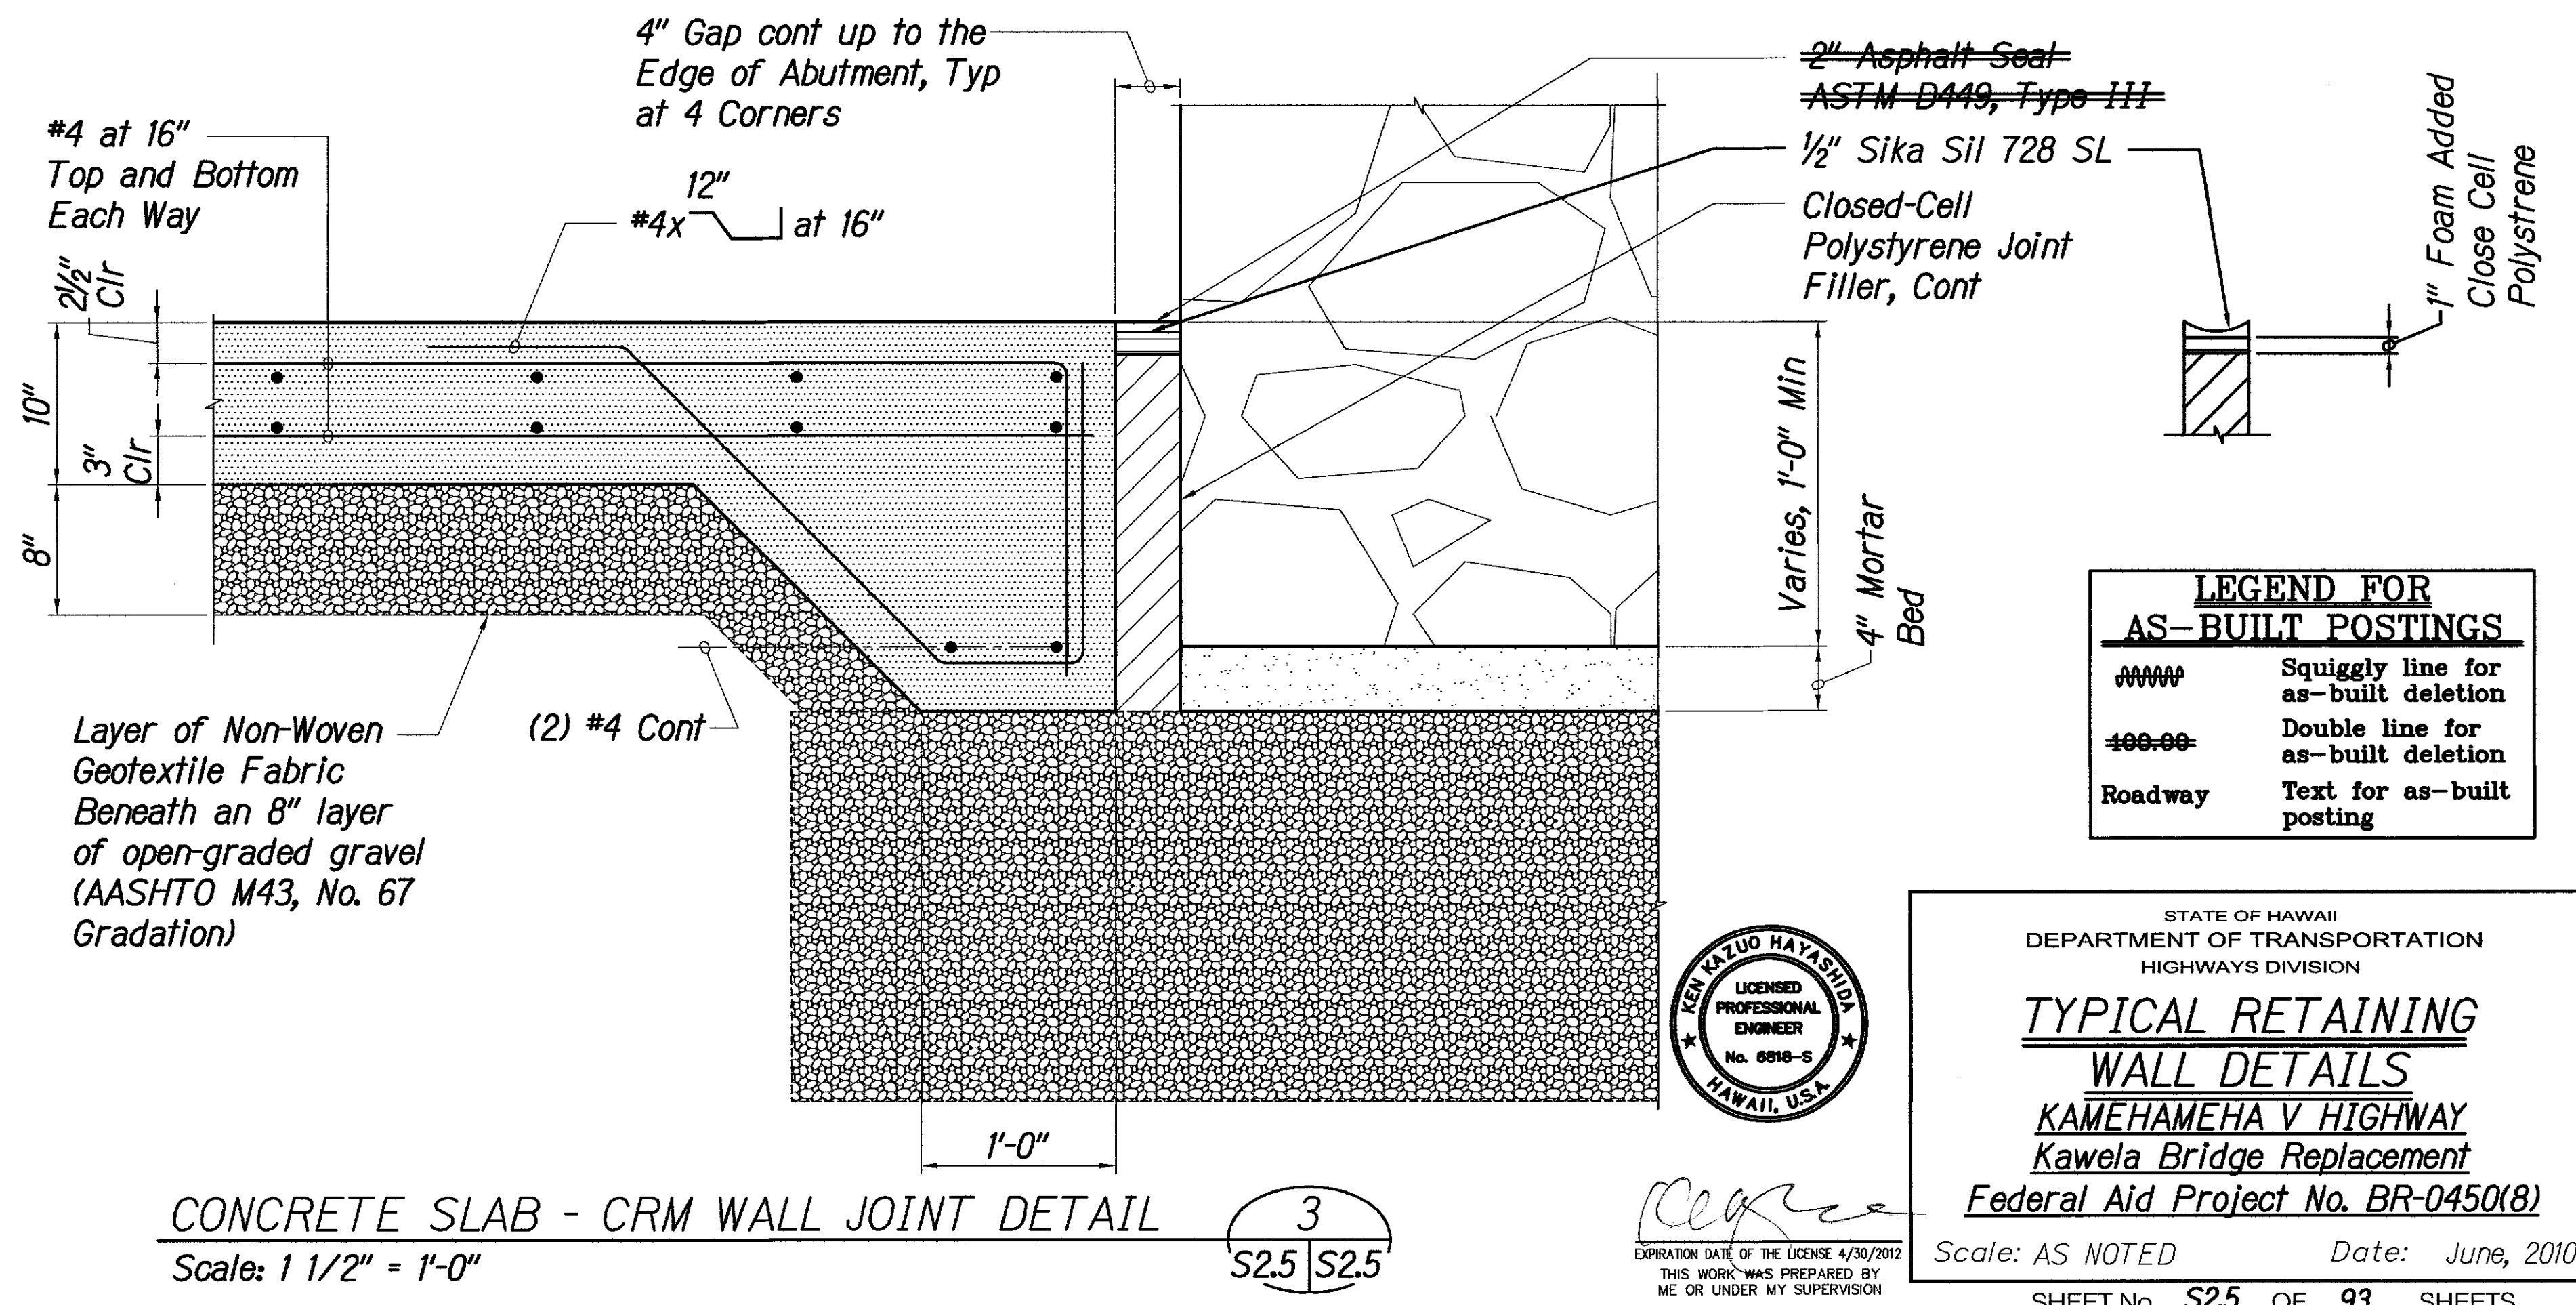

**LEGEND FOR AS-BUILT POSTINGS**

~~~~~	Squiggly line for as-built deletion
==	Double line for as-built deletion
Roadway	Text for as-built posting

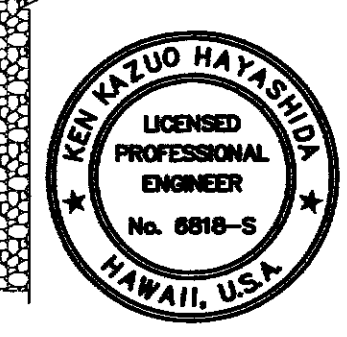







STATE OF HAWAII  
DEPARTMENT OF TRANSPORTATION  
HIGHWAYS DIVISION

**TYPICAL RETAINING WALL DETAILS**  
**KAMEHAMEHA V HIGHWAY**  
**Kawela Bridge Replacement**  
**Federal Aid Project No. BR-0450(8)**

Scale: AS NOTED Date: June, 2010


SHEET No. S25 OF 93 SHEETS

FED. ROAD DIST. NO.	STATE	FED. AID PROJ. NO.	FISCAL YEAR	SHEET NO.	TOTAL SHEETS
HAWAII	HAW.	BR-0450(8)	2011	C.O. 71	93

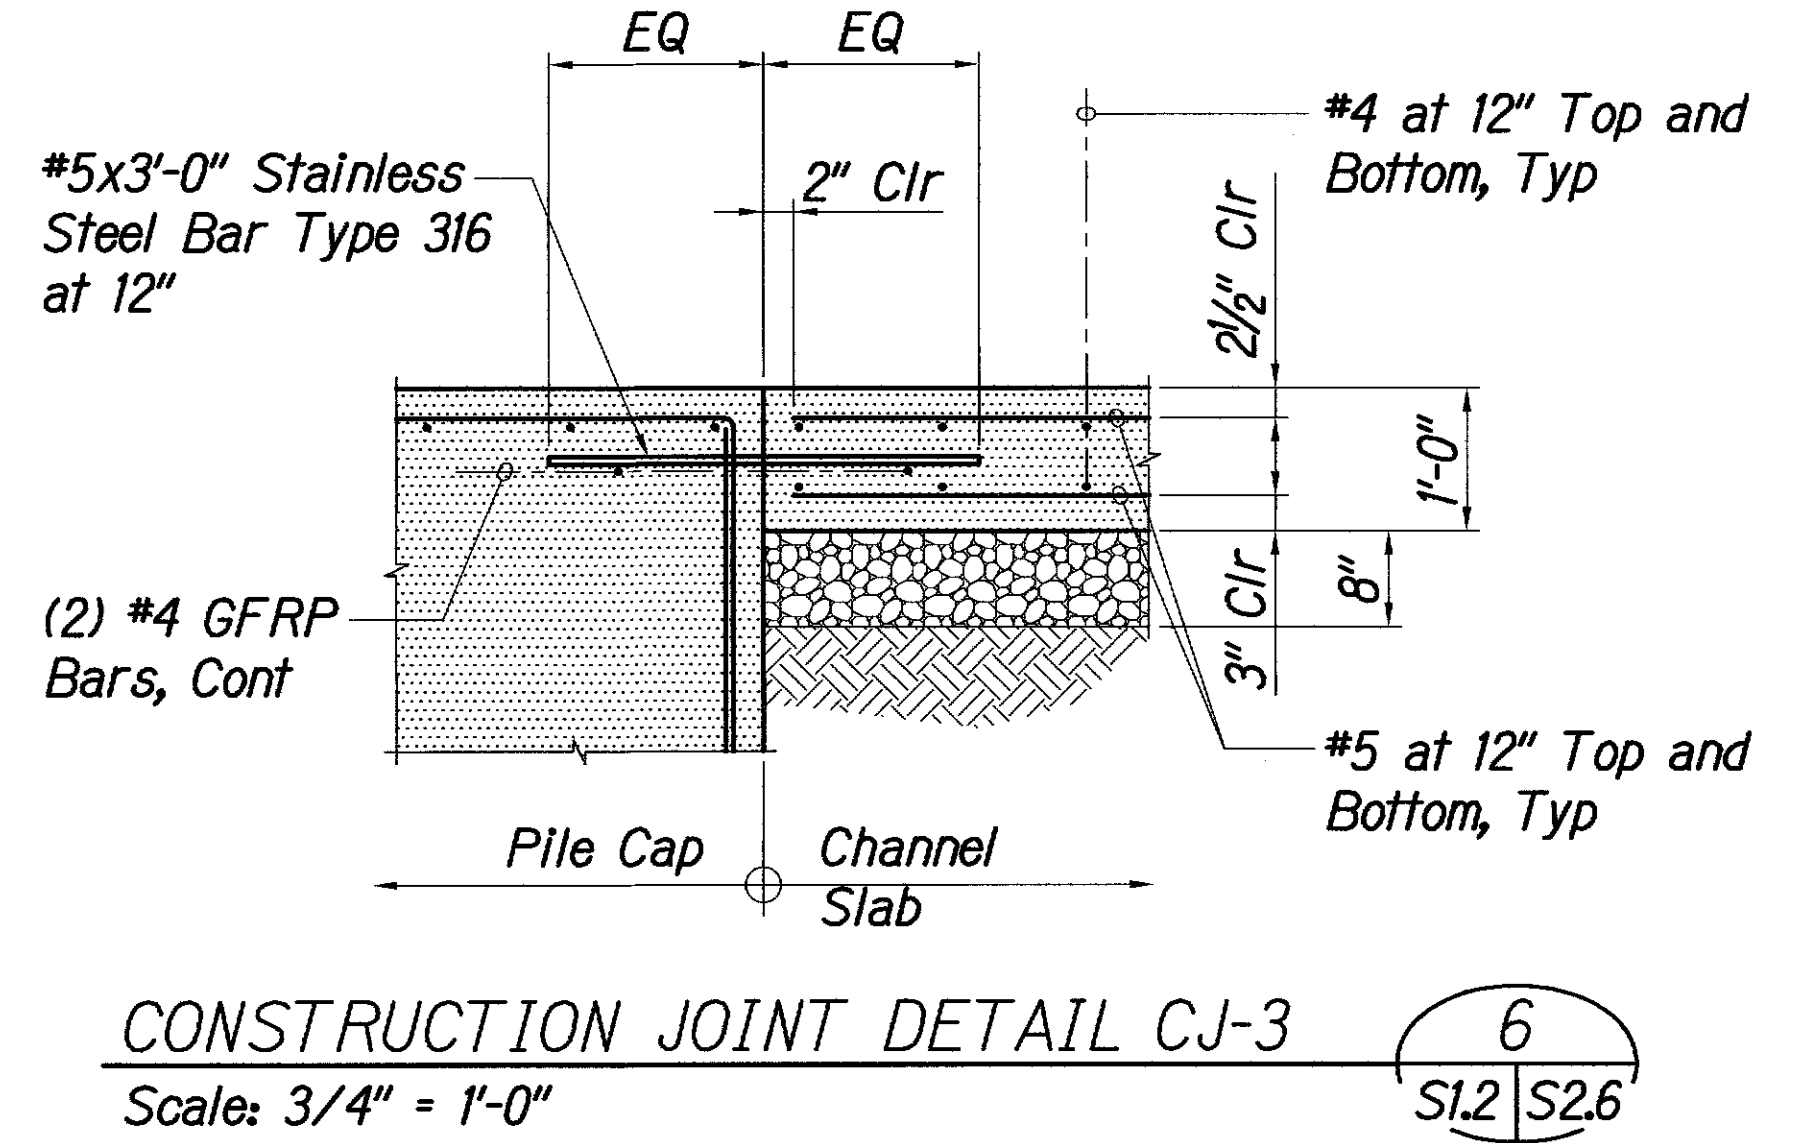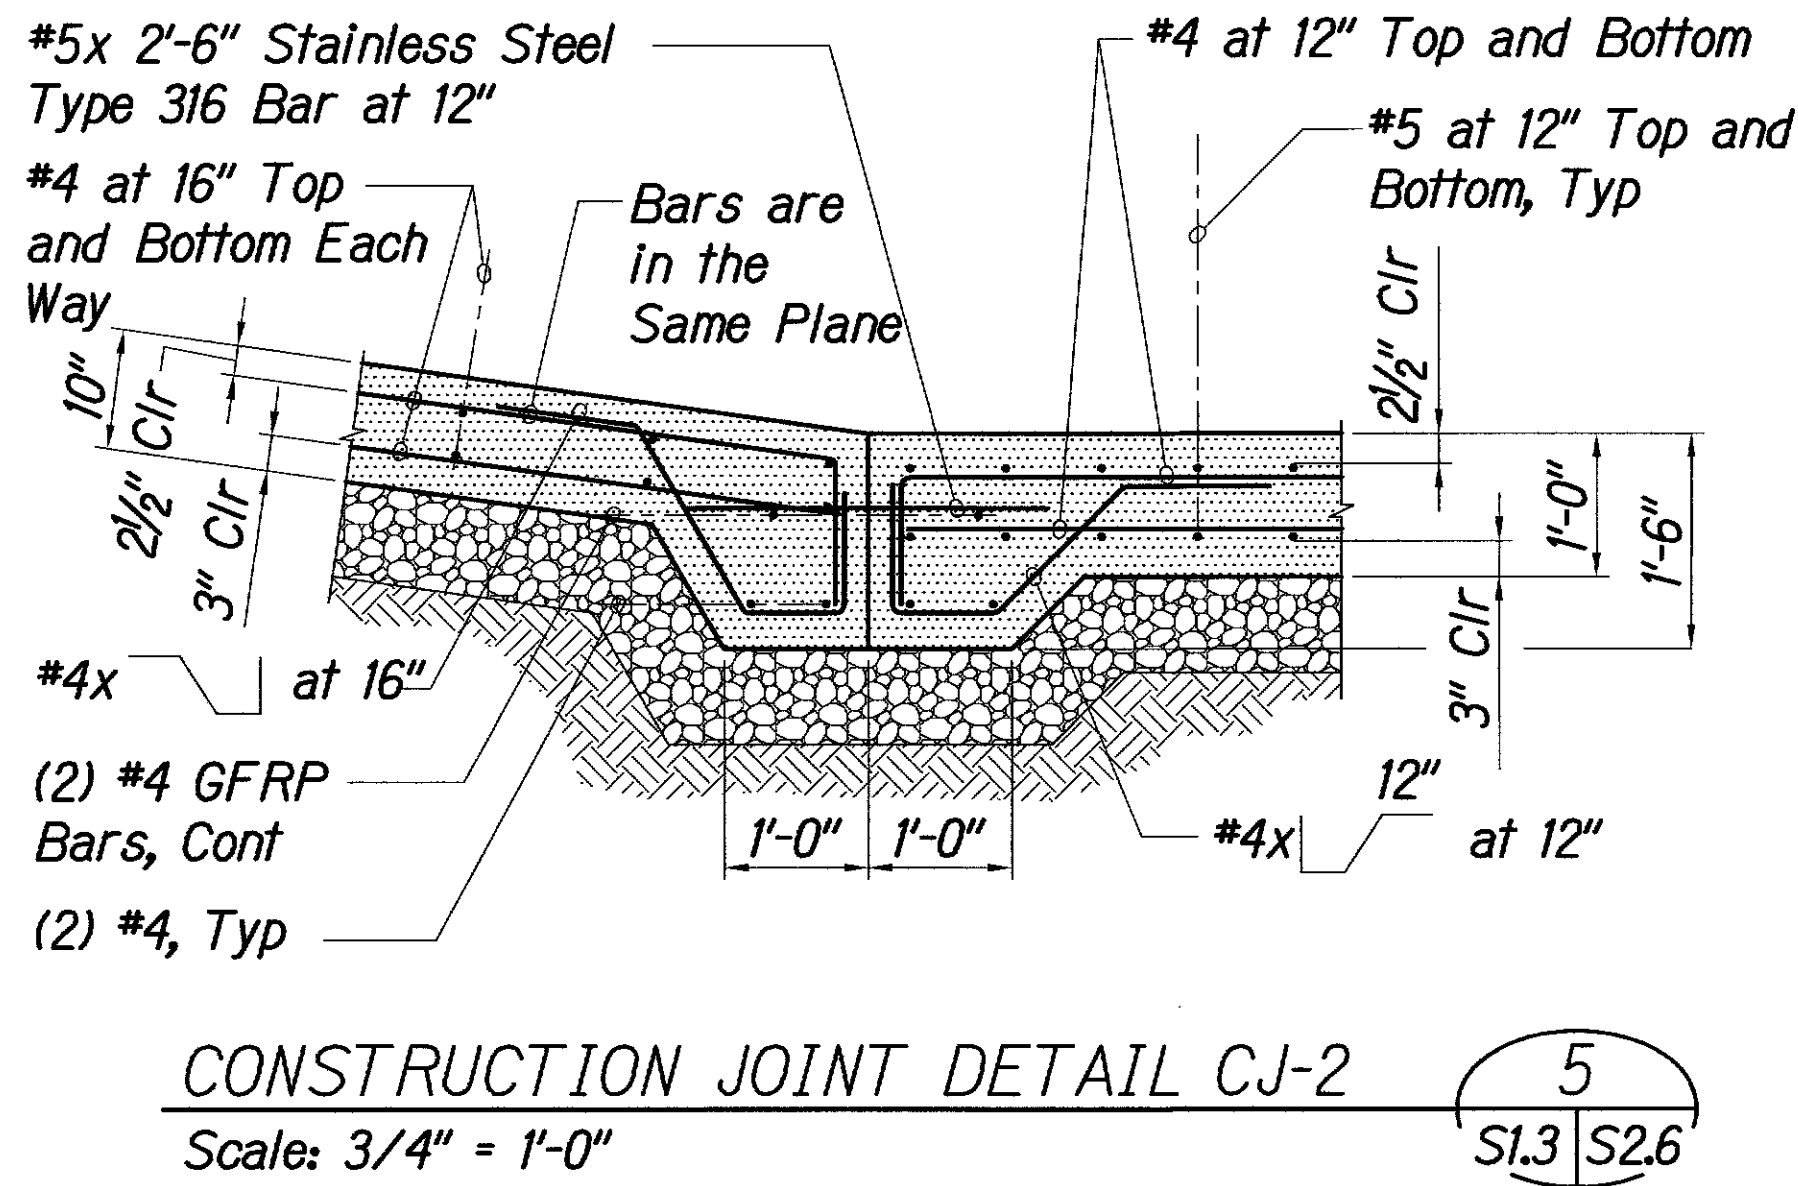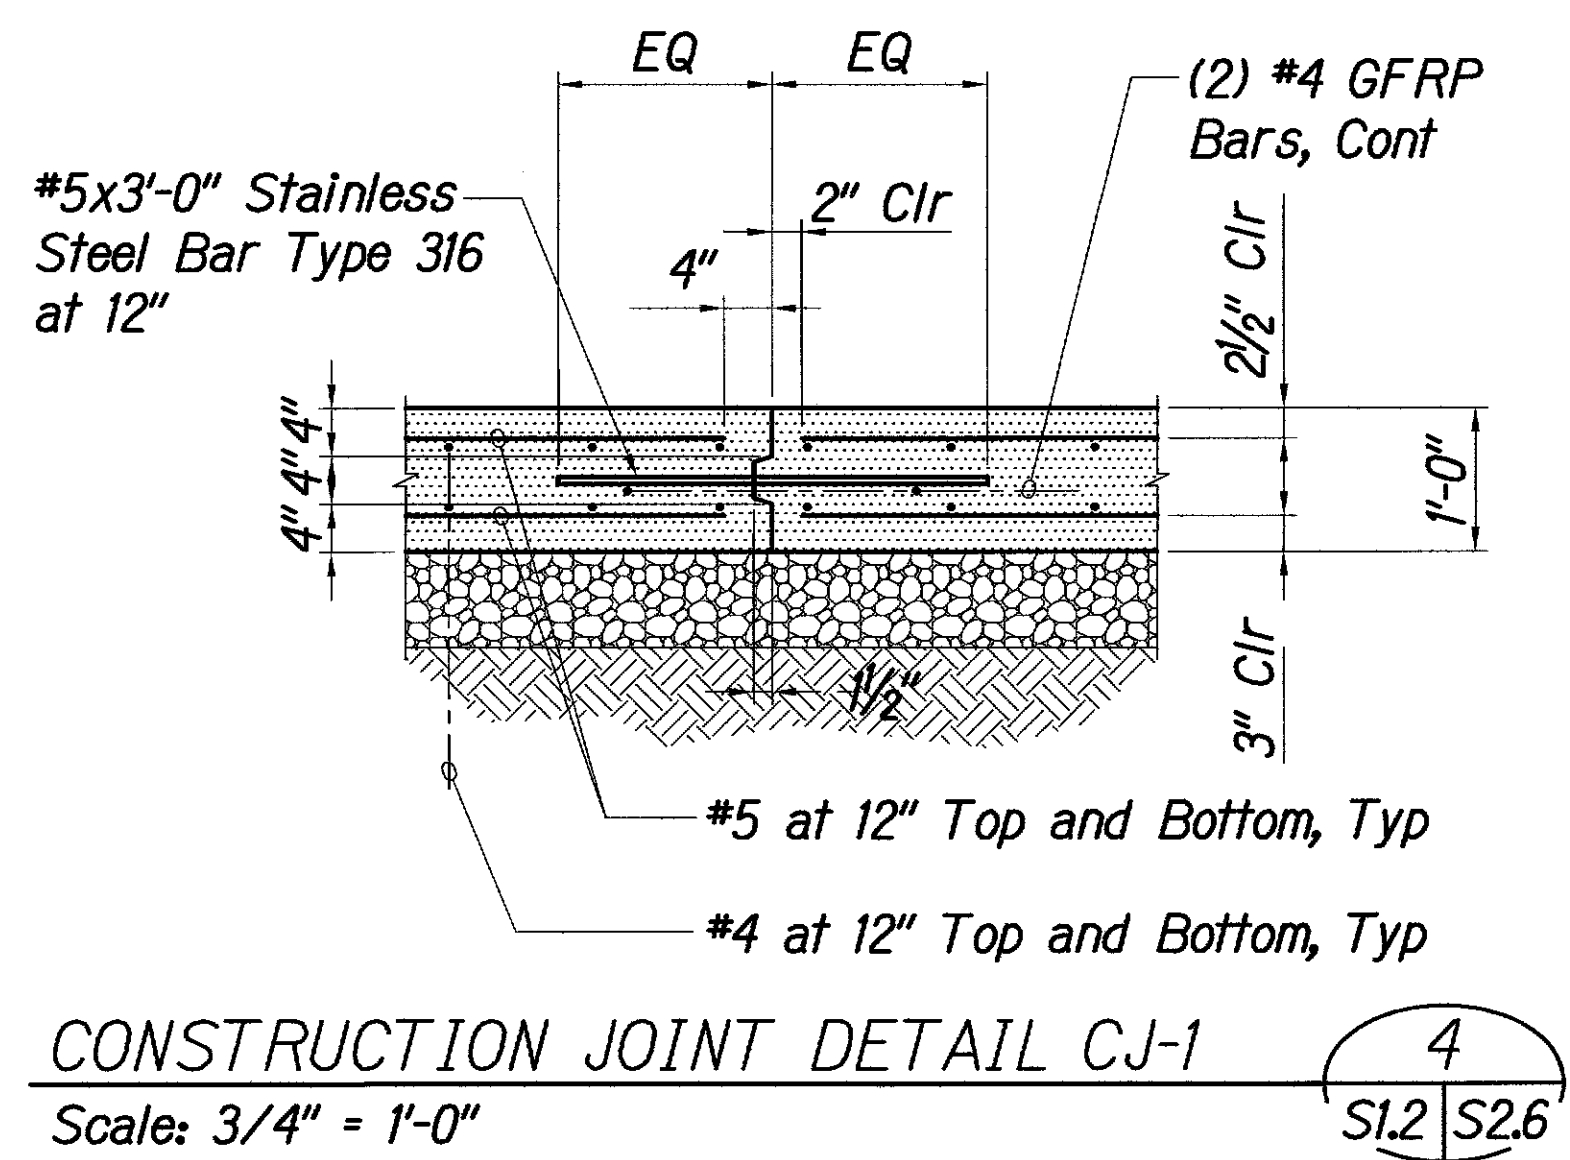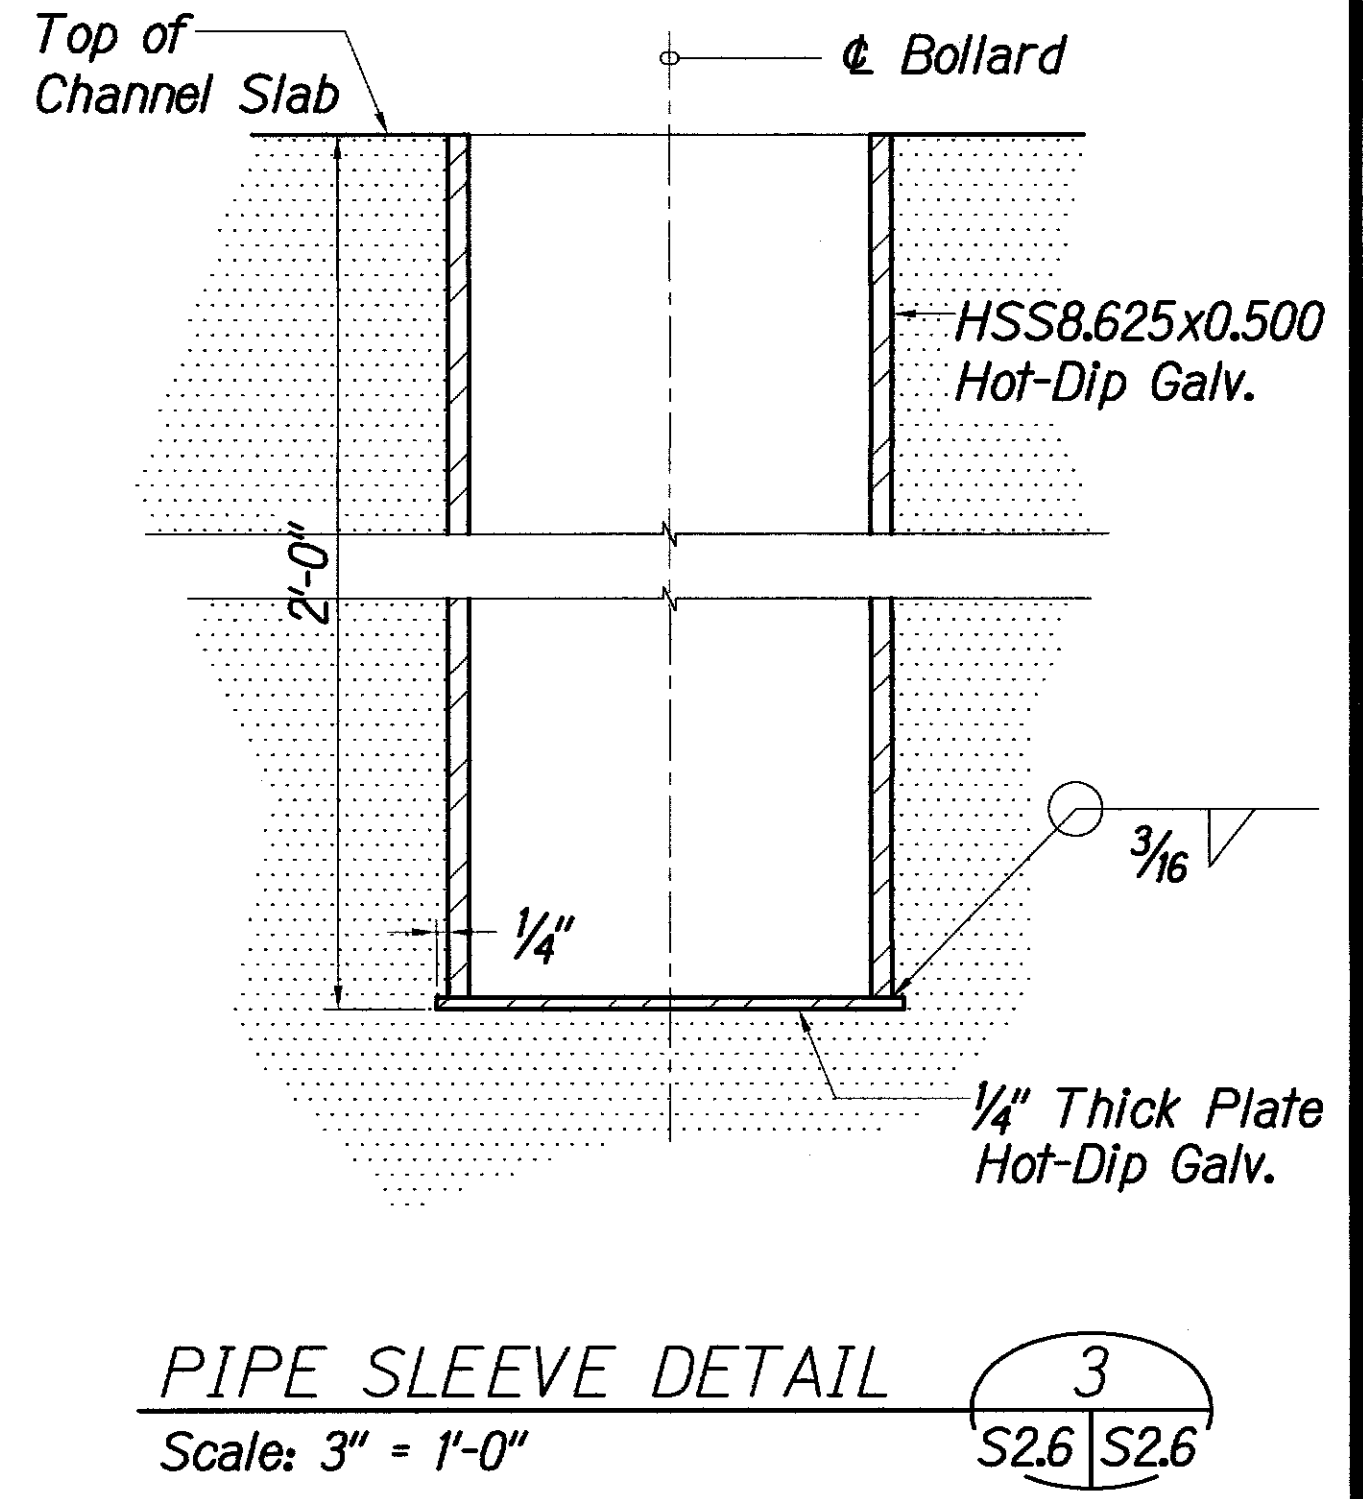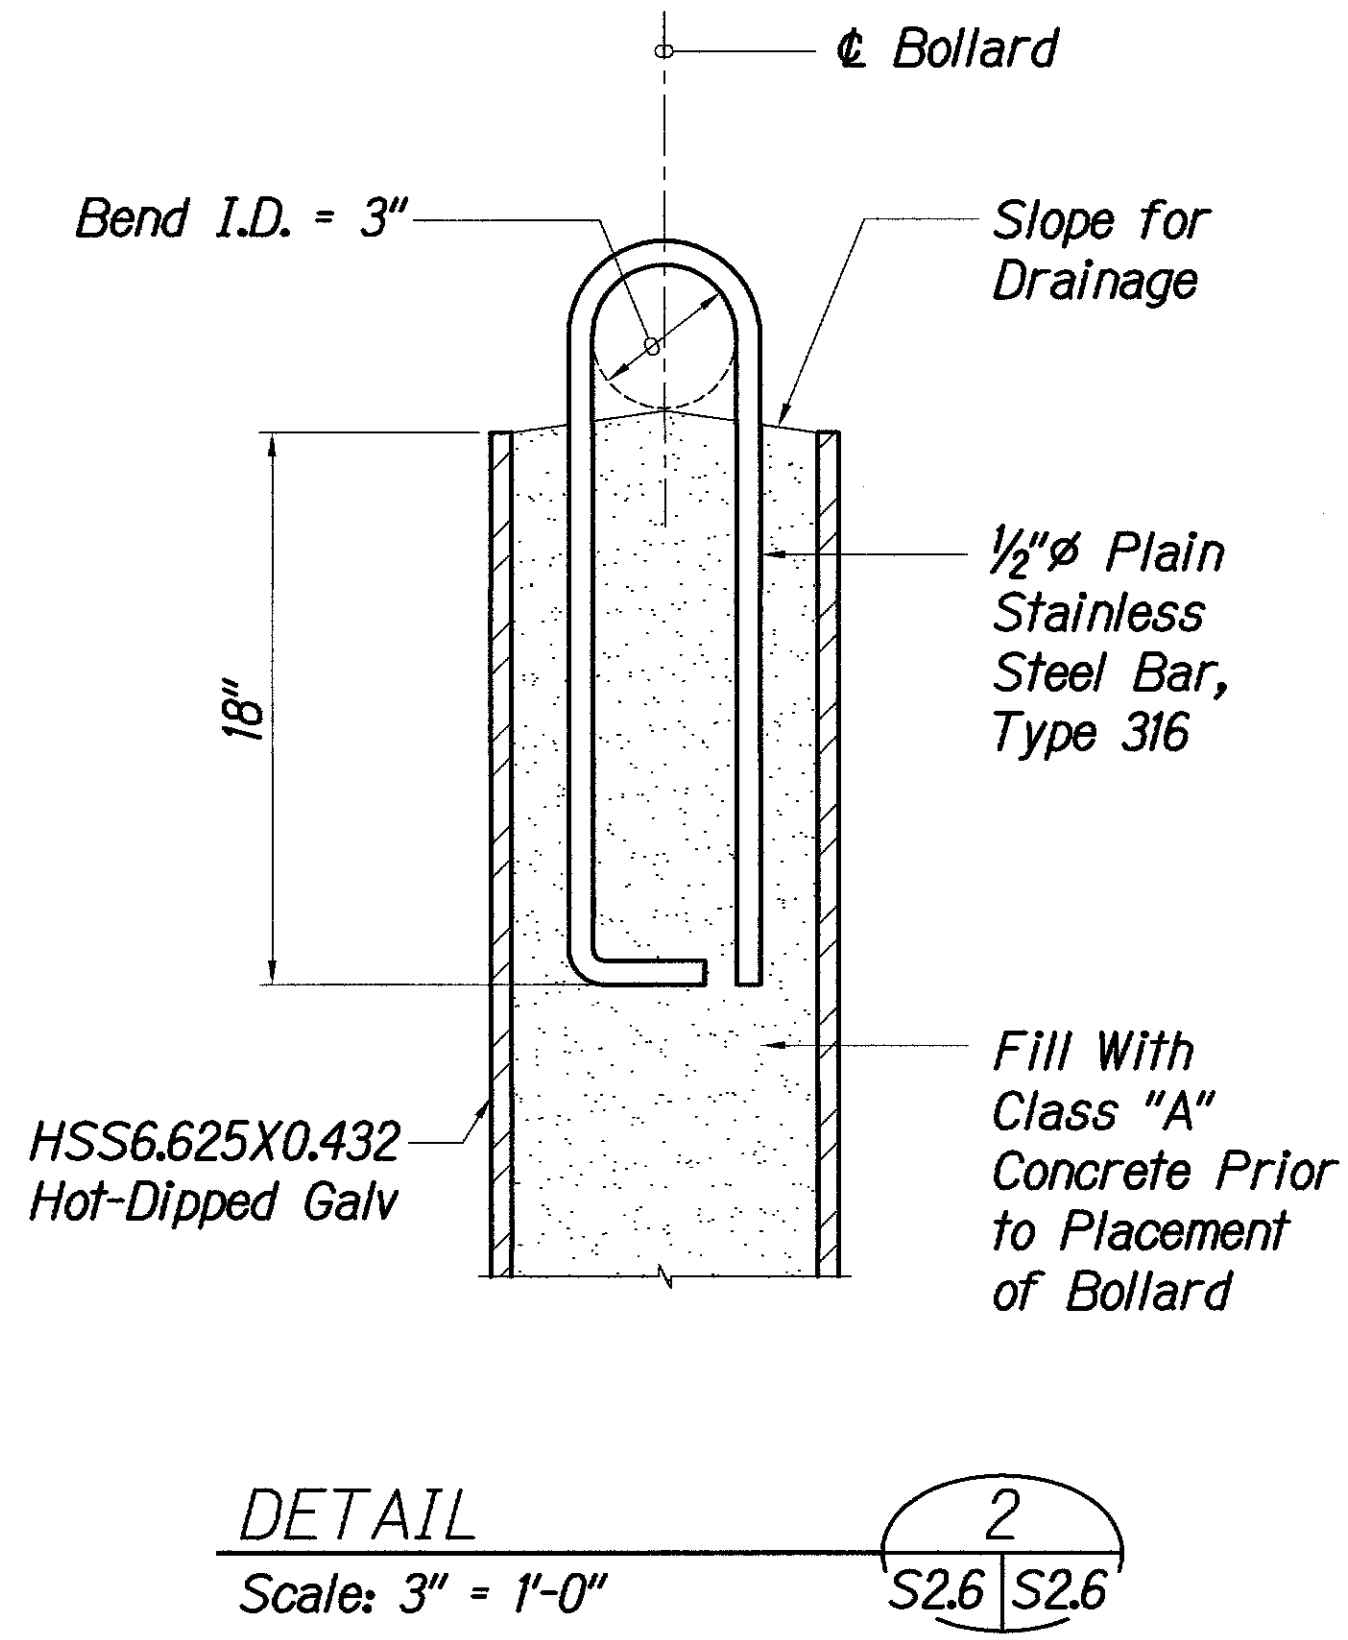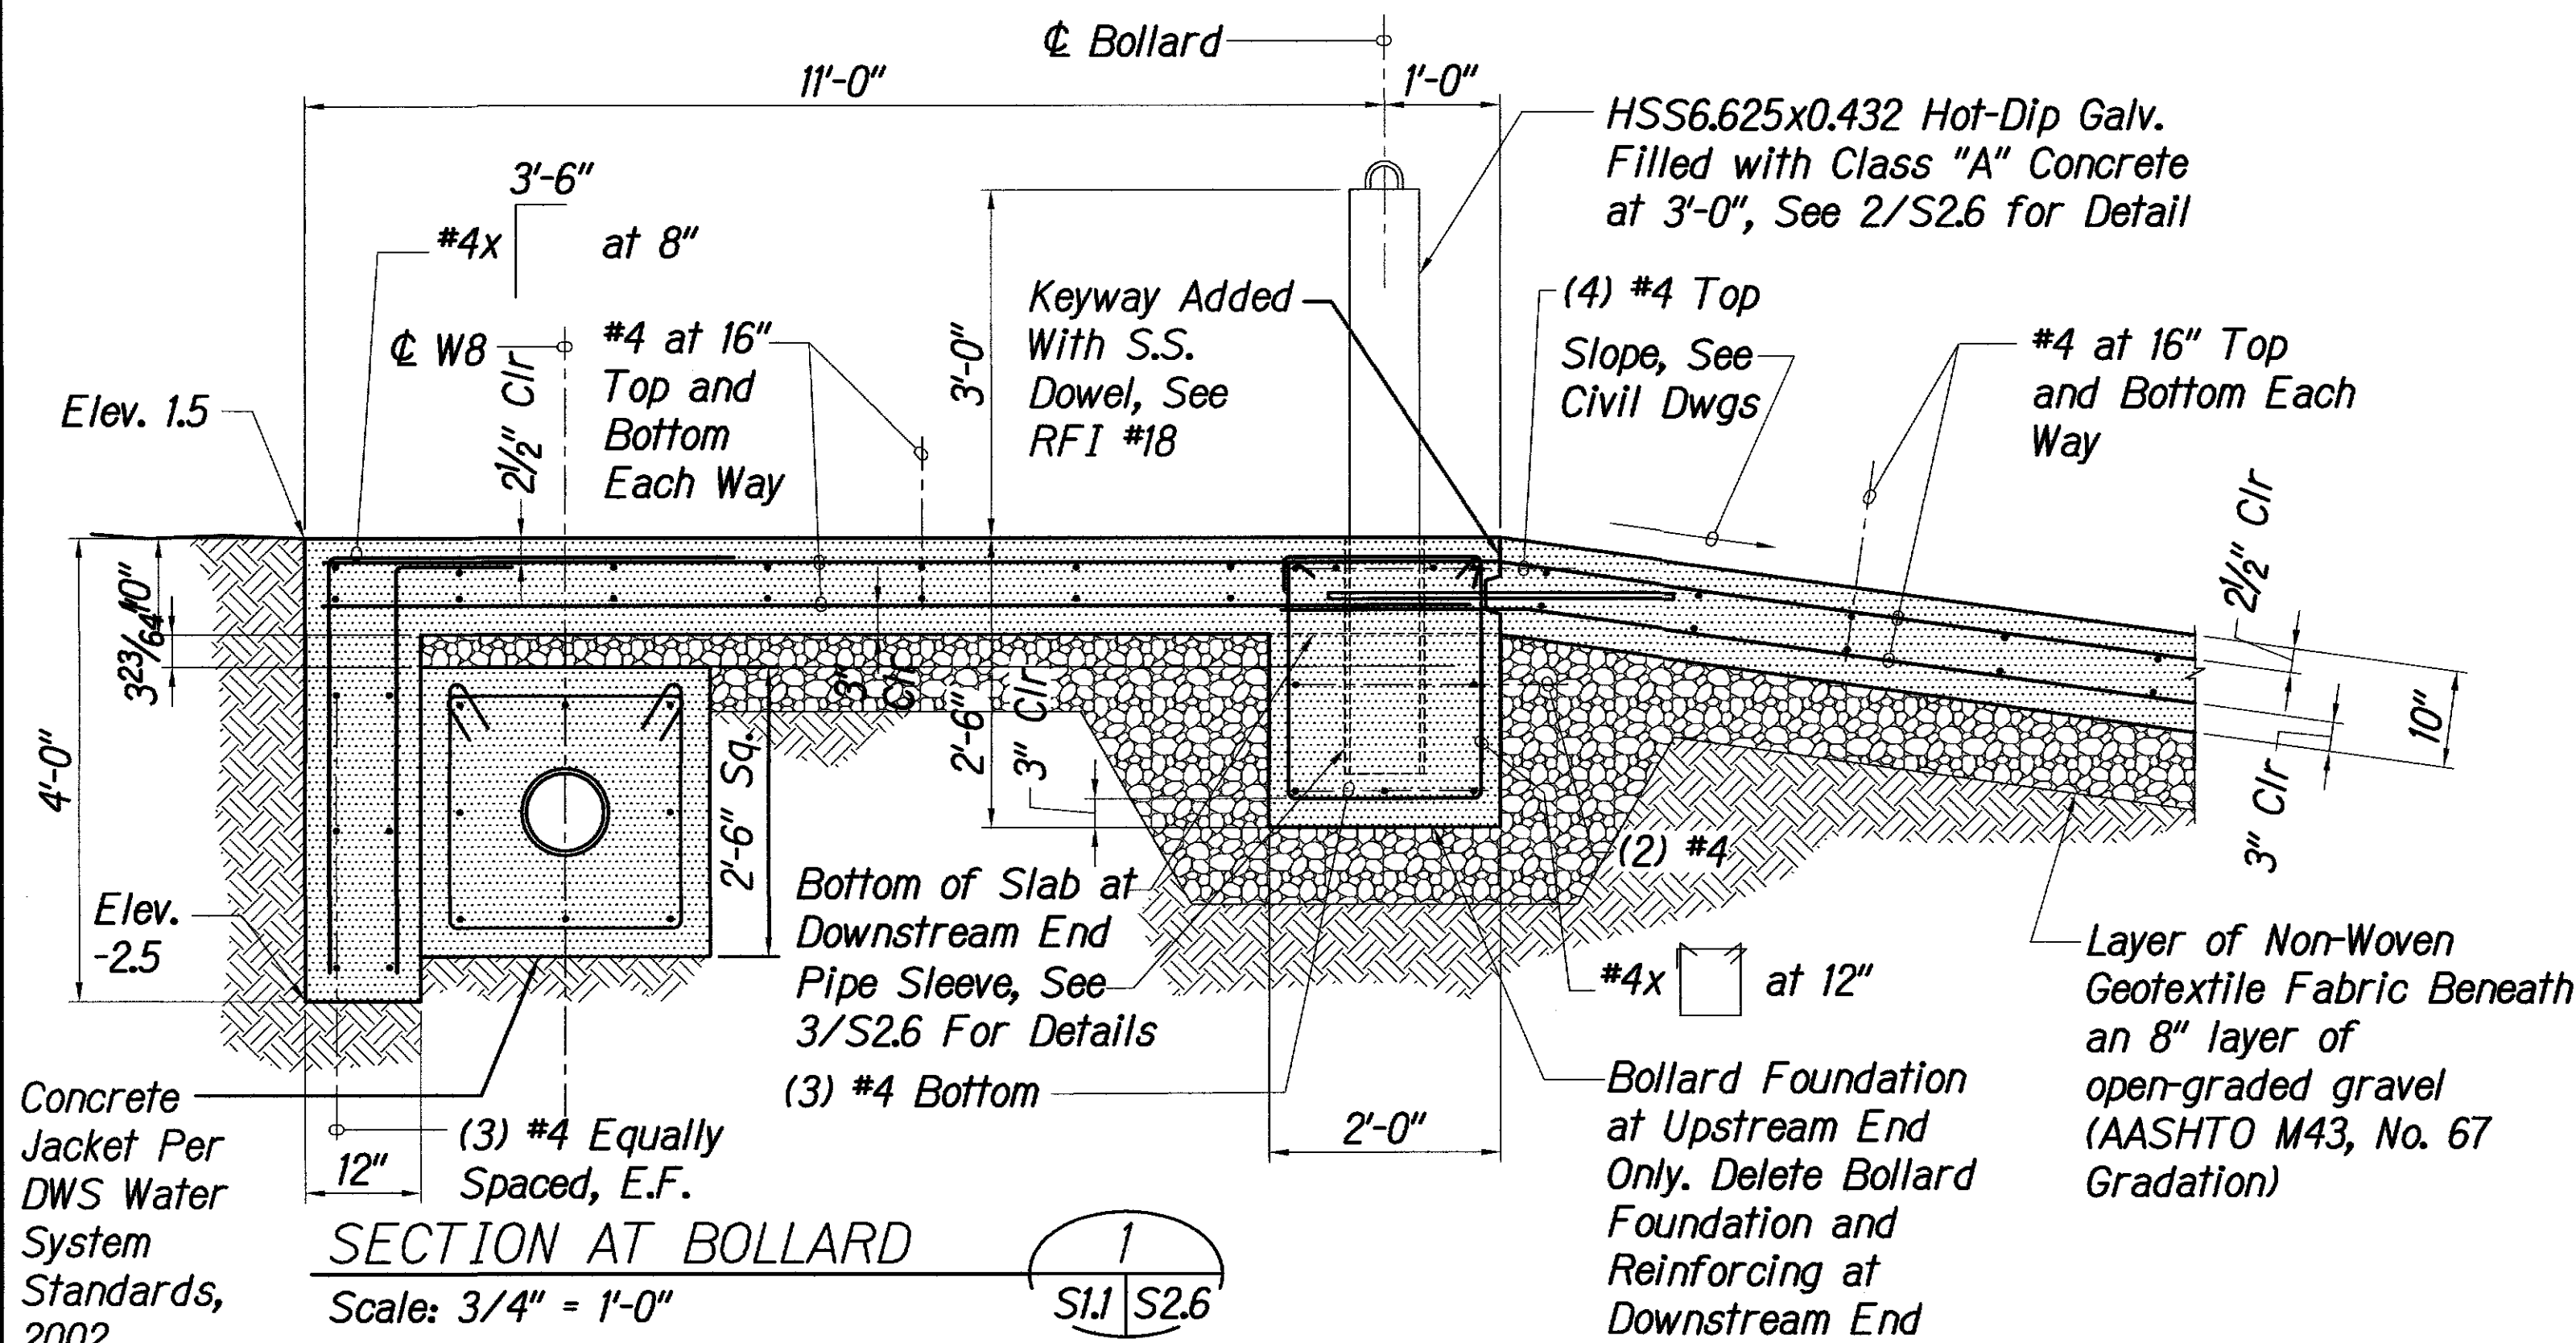

**Note:**  
The stainless steel rebar shall be supported only by GFRP rebar and not the carbon steel rebar. The stainless steel rebars shall never come in contact with carbon steel bars. Tie wires for connecting all stainless steel rebar shall be stainless steel wire or non-metallic wire.






LEGEND FOR AS-BUILT POSTINGS	
~~~~~	Squiggly line for as-built deletion
==	Double line for as-built deletion
Roadway	Text for as-built posting

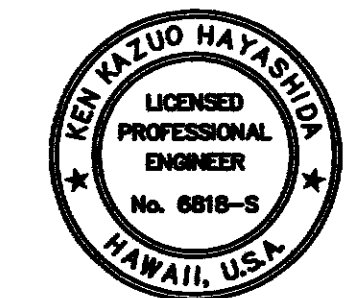

8/10/12	Added W8 Extension to Detail 1
DATE	REVISION
STATE OF HAWAII DEPARTMENT OF TRANSPORTATION HIGHWAYS DIVISION	
<b>CONCRETE CHANNEL SLAB AND BOLLARD DETAILS</b>	
KAMEHAMEHA V HIGHWAY Kawela Bridge Replacement Federal Aid Project No. BR-0450(8)	
Scale: AS NOTED	Date: June, 2010
SHEET No. S26 OF 93 SHEETS	




FED. ROAD DIST. NO.	STATE	FED. AID PROJ. NO.	FISCAL YEAR	SHEET NO.	TOTAL SHEETS
HAWAII	HAW.	BR-0450(8)	2011	C.O. 72	93

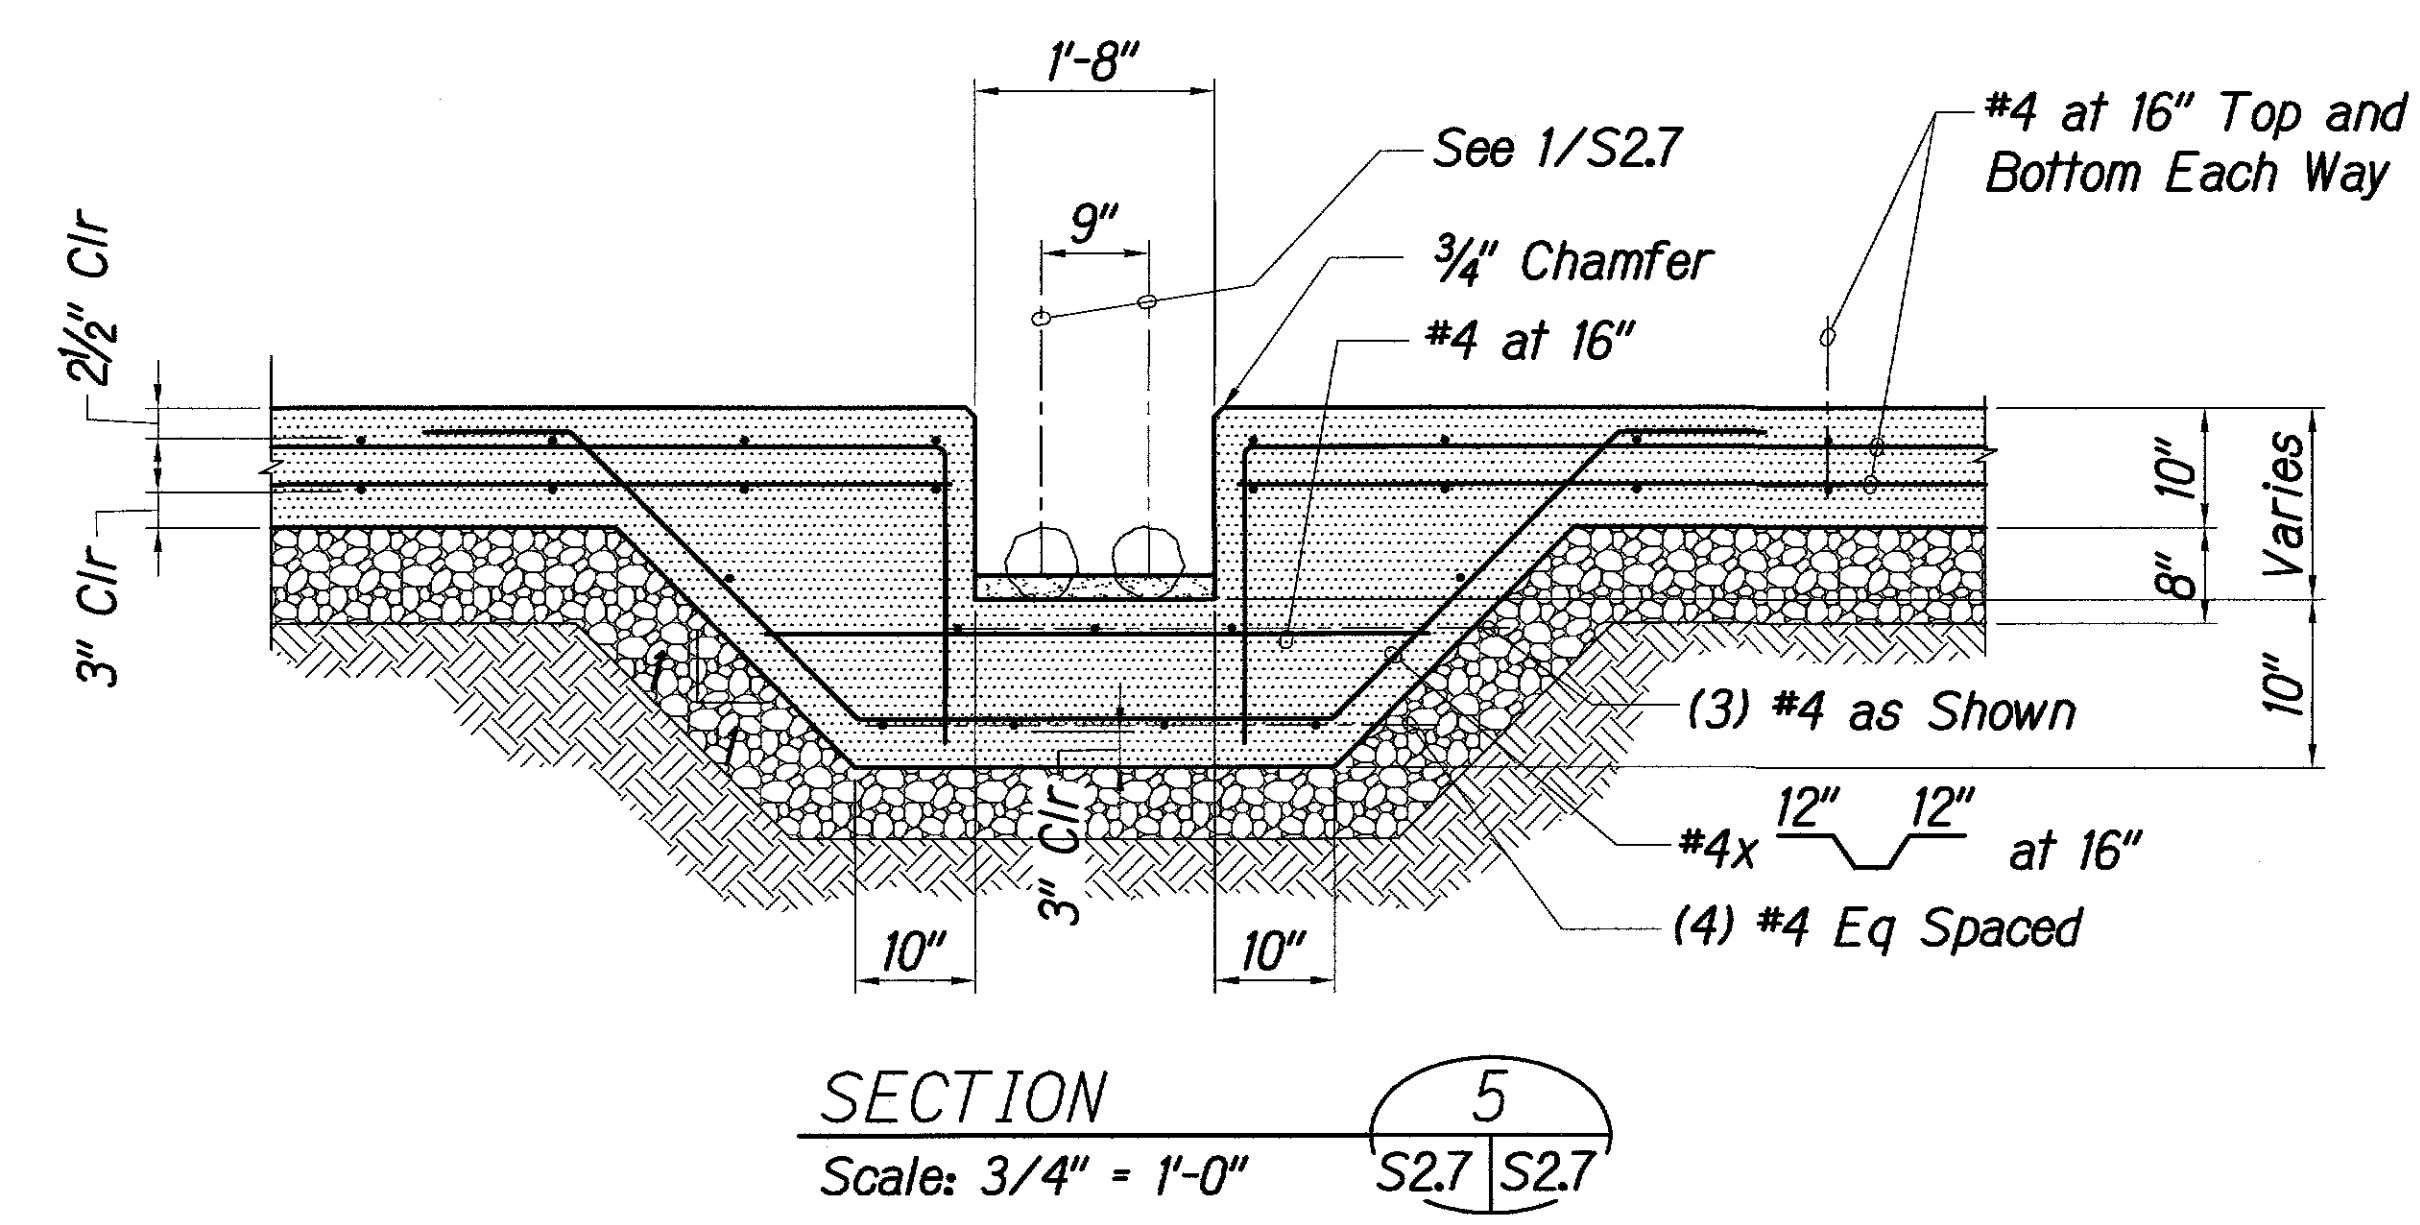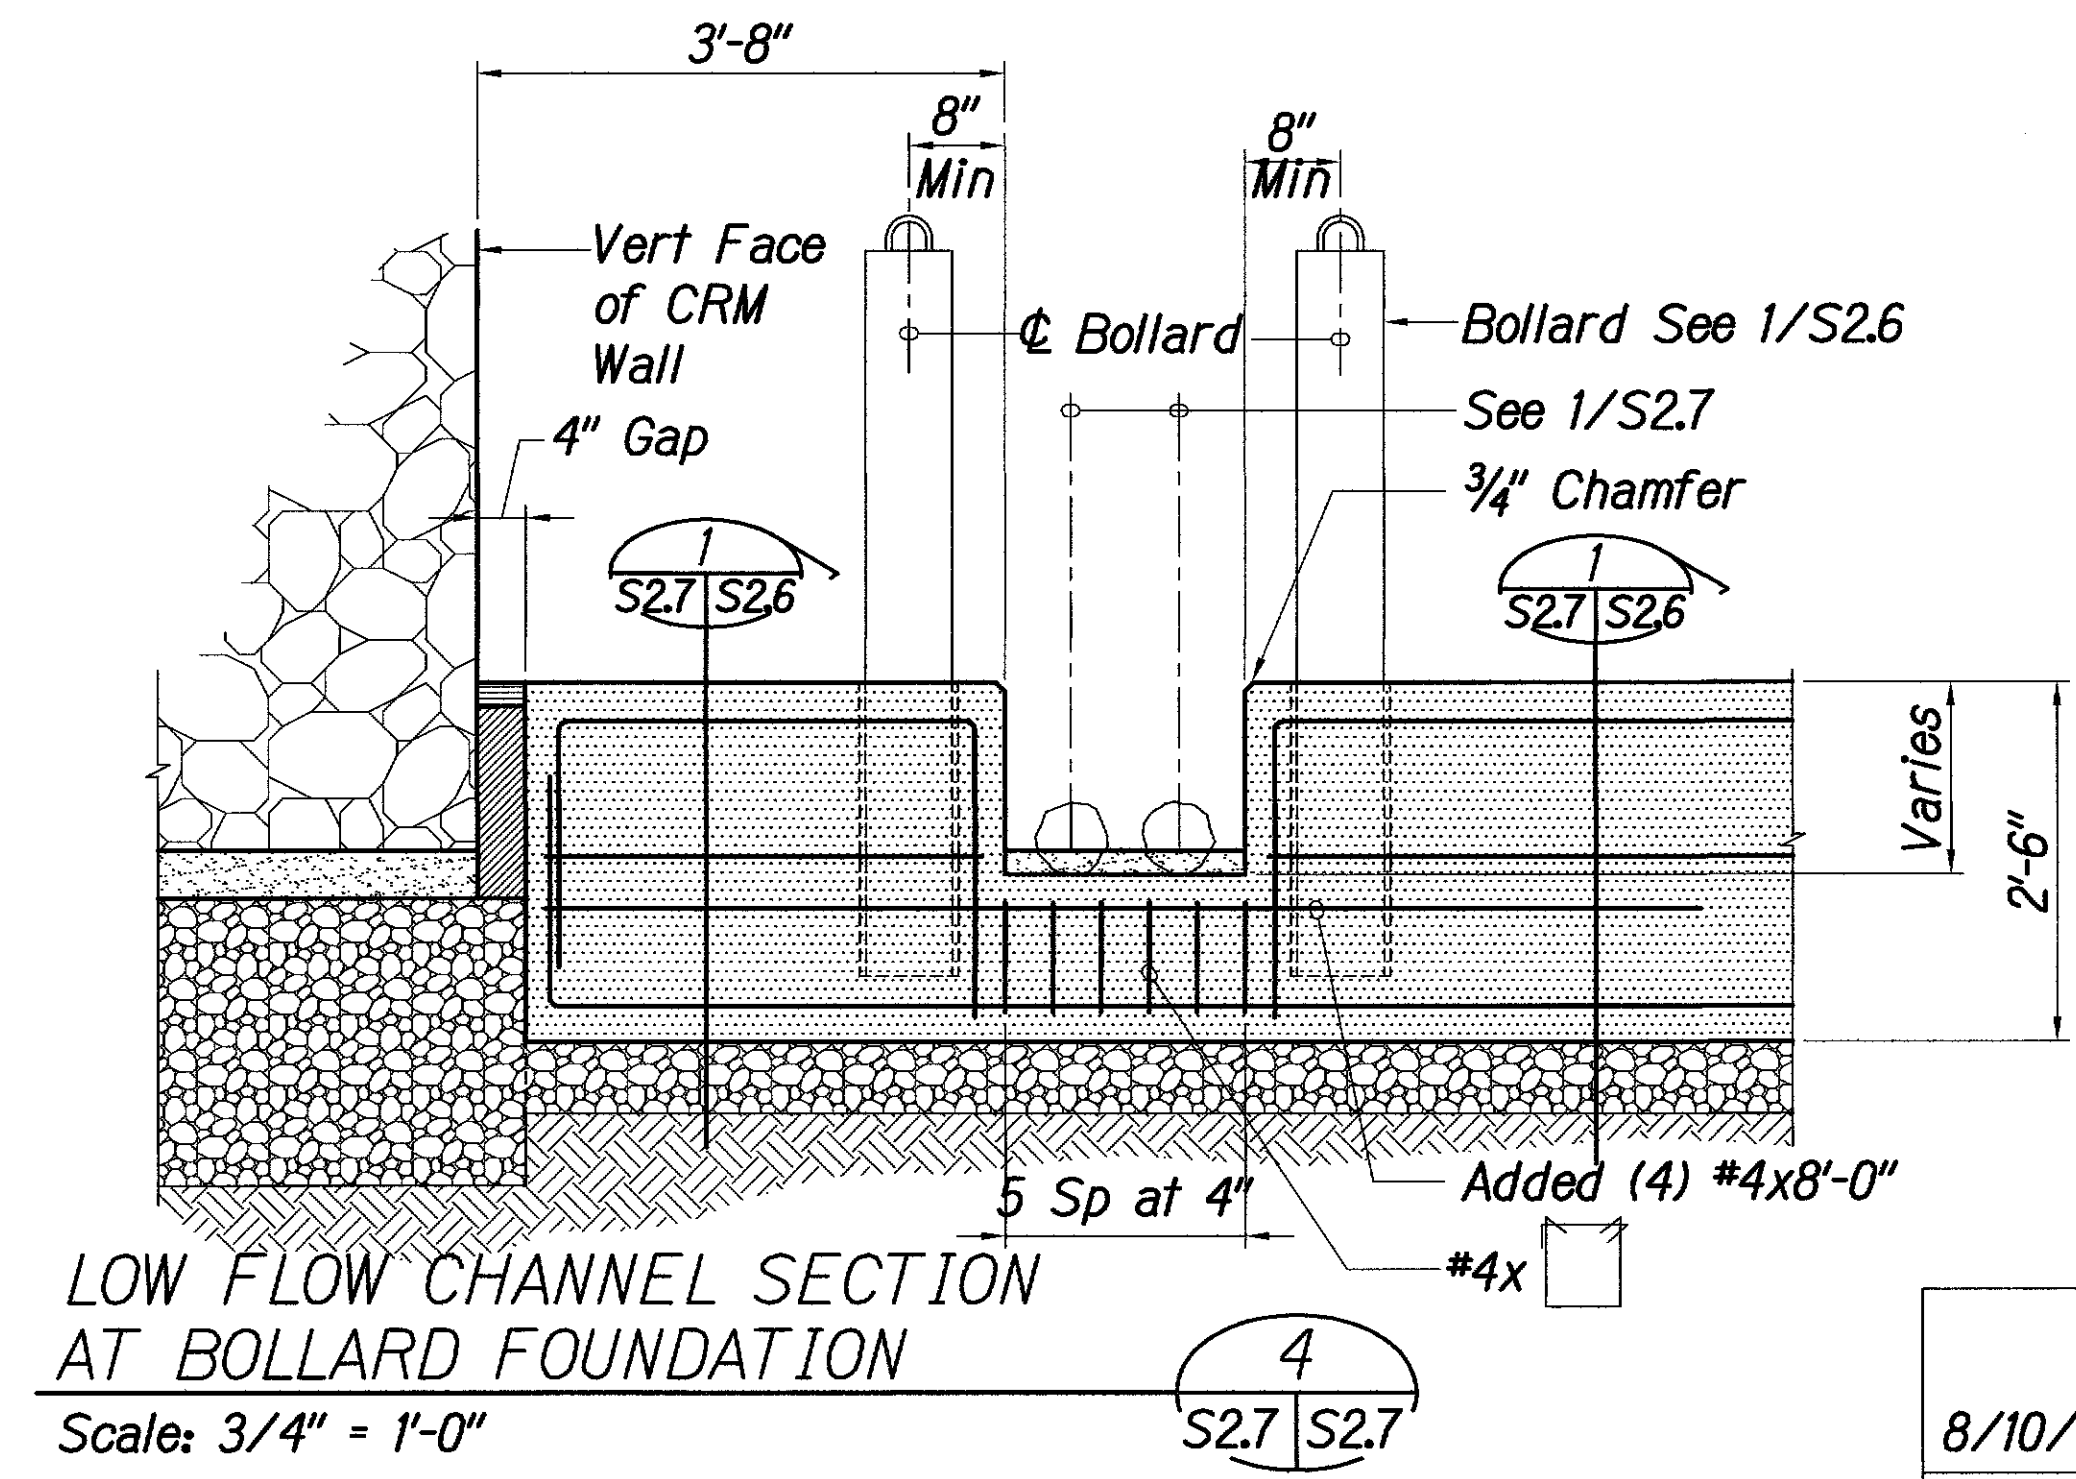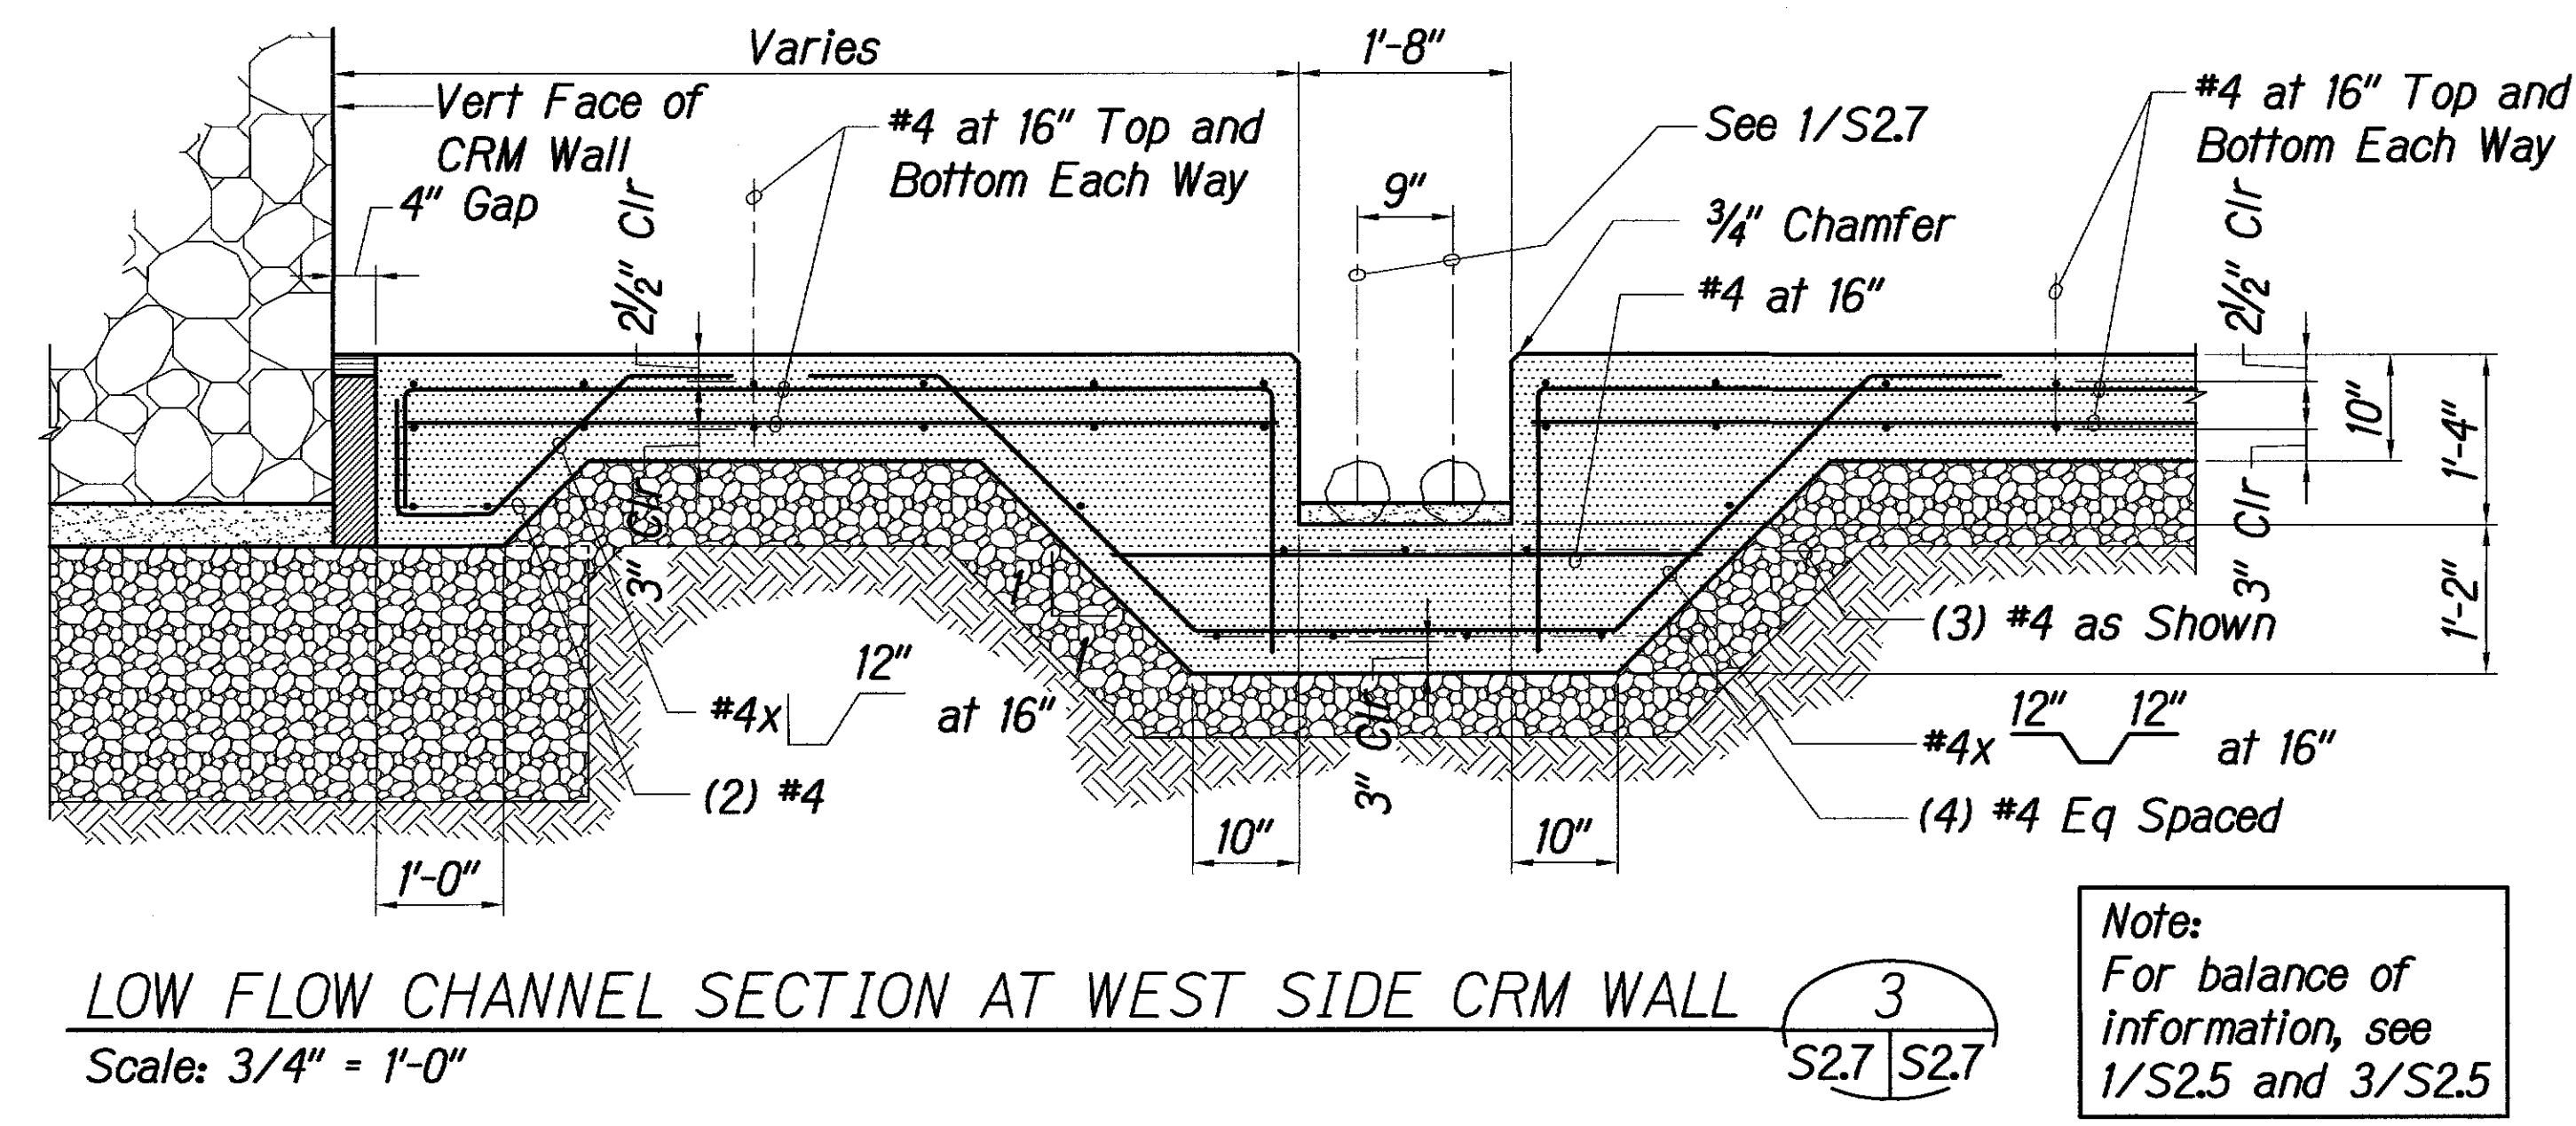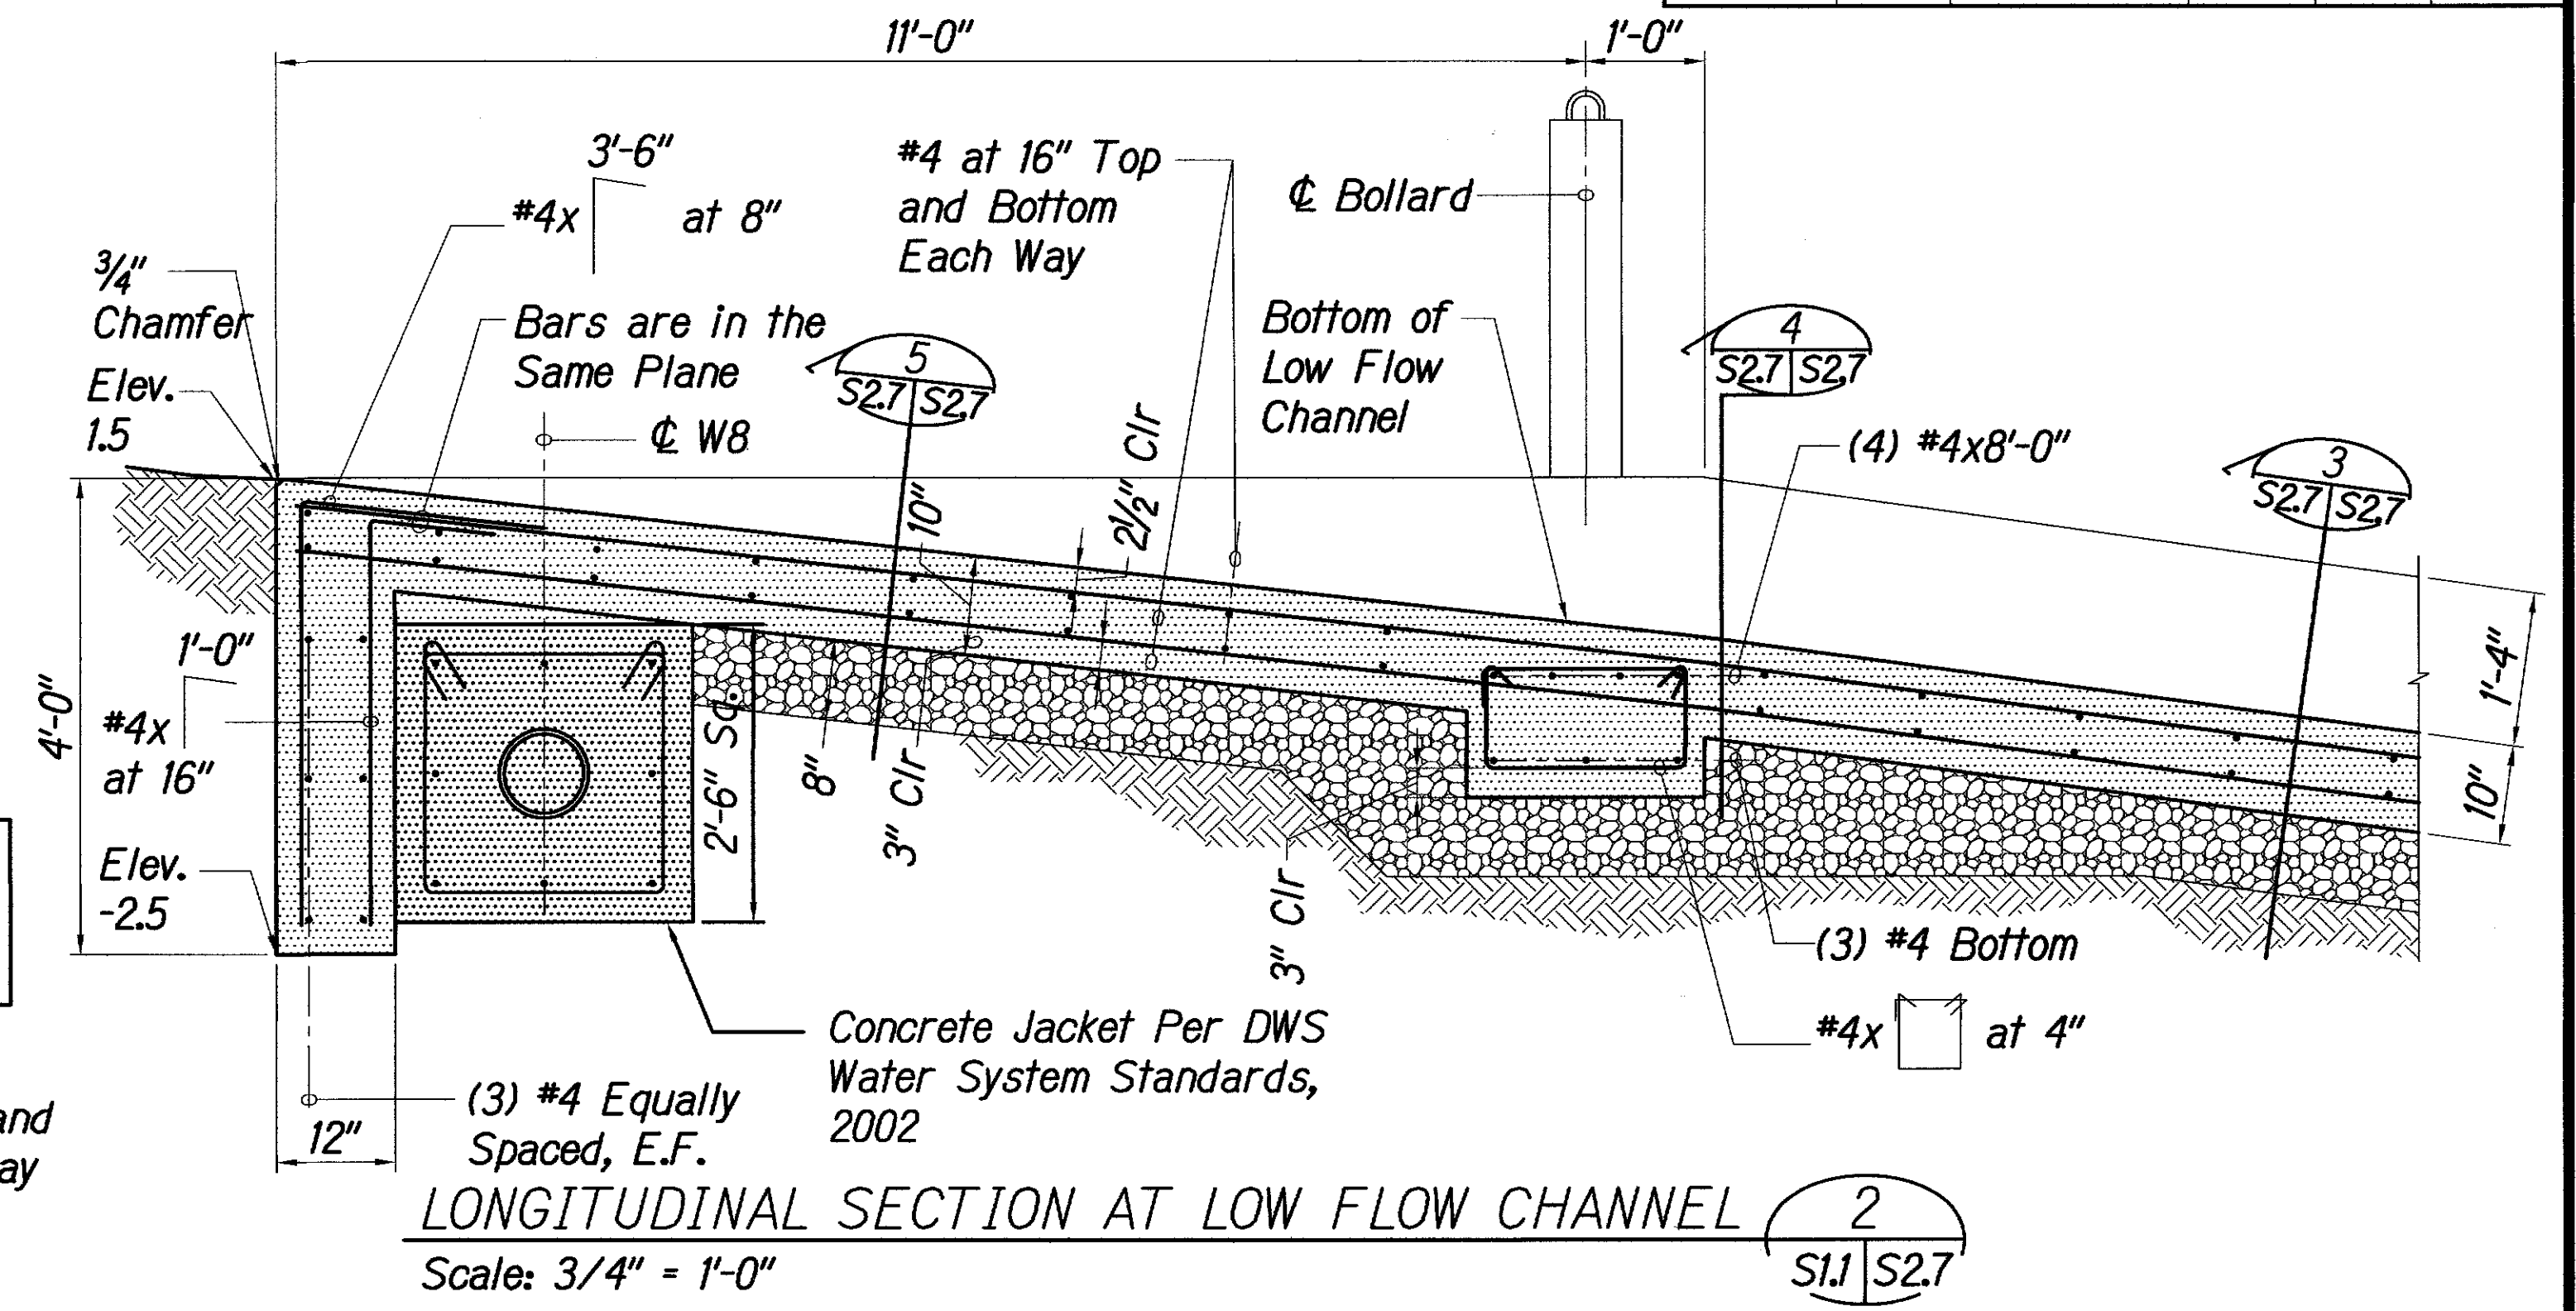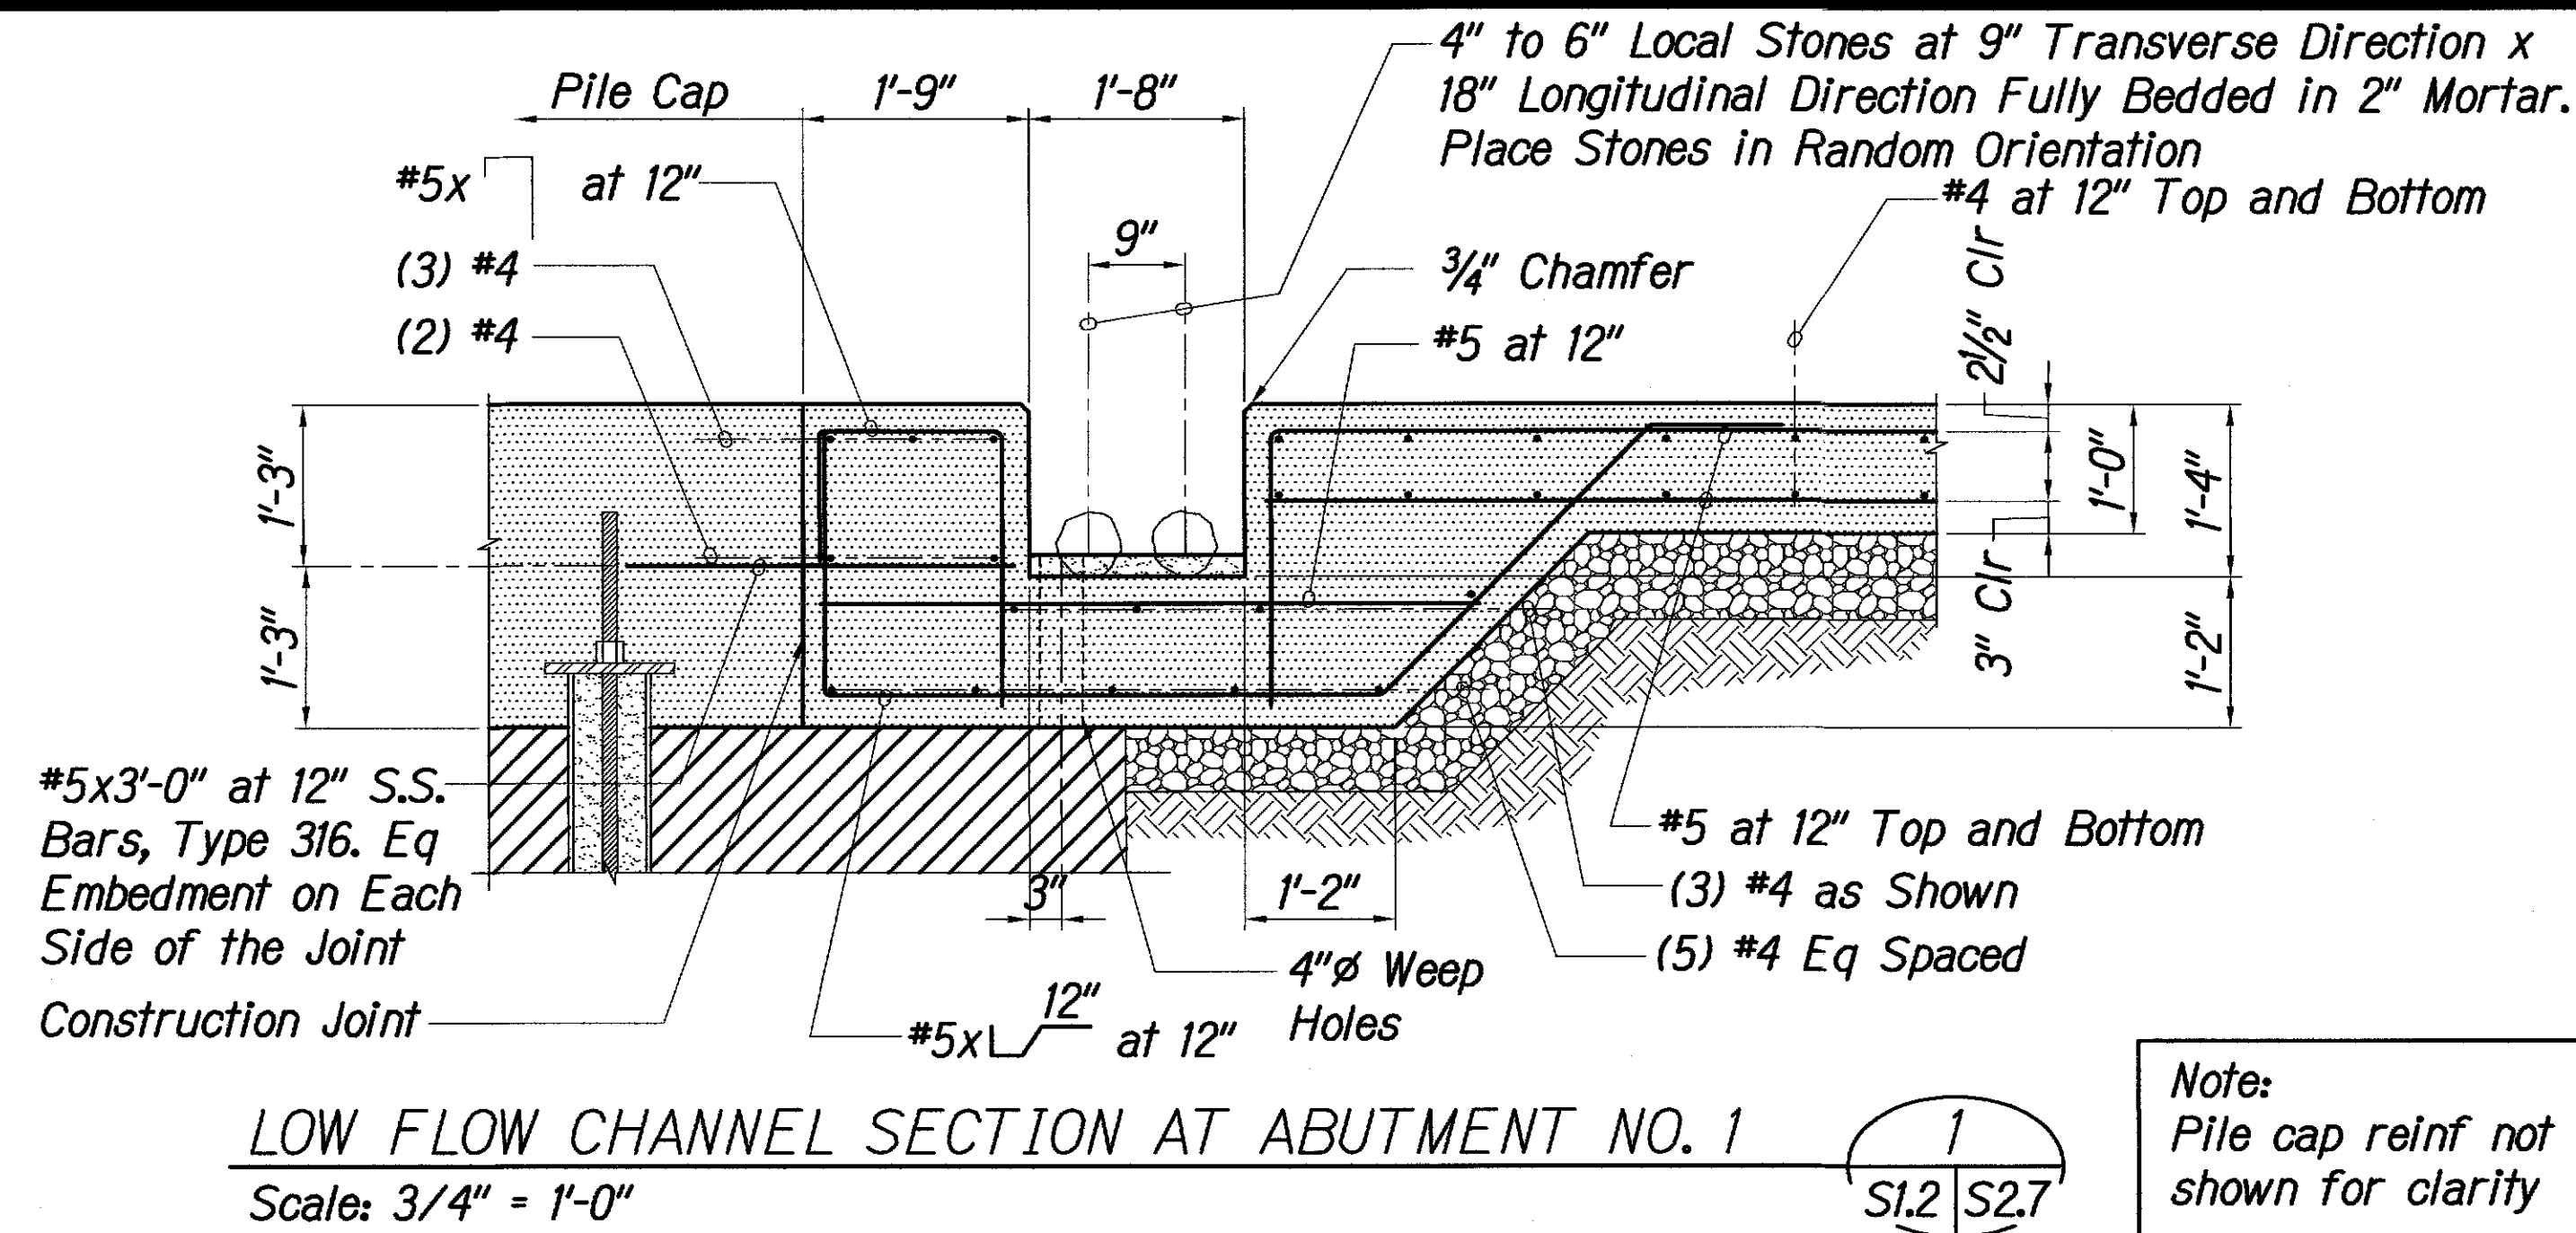

LEGEND FOR AS-BUILT POSTINGS	
~~~~~	Squiggly line for as-built deletion
==	Double line for as-built deletion
Roadway	Text for as-built posting

8/10/12	Added W8 Extension to Detail 2
DATE	REVISION
STATE OF HAWAII DEPARTMENT OF TRANSPORTATION HIGHWAYS DIVISION	
LOW FLOW CHANNEL SECTIONS	
KAMEHAMEHA V HIGHWAY	
Kawela Bridge Replacement	
Federal Aid Project No. BR-0450(8)	
Scale: AS NOTED	Date: June, 2010
SHEET No. S27 OF 93 SHEETS	

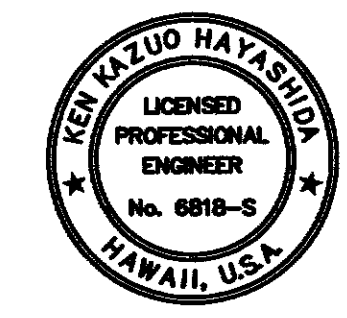


Signature  
EXPIRATION DATE OF THE LICENSE 4/30/2012  
THIS WORK WAS PREPARED BY ME OR UNDER MY SUPERVISION

"AS-BUILT"

C.O. 72


5-09-13\_1528-01 Kawela Bridge AS BUILT S1528\_S-2-7.dwg, 9/13/2016 3:11:09 PM, tamnaha

FED. ROAD DIST. NO.	STATE	FED. AID PROJ. NO.	FISCAL YEAR	SHEET NO.	TOTAL SHEETS
HAWAII	HAW.	BR-0450(8)	2011	73	93

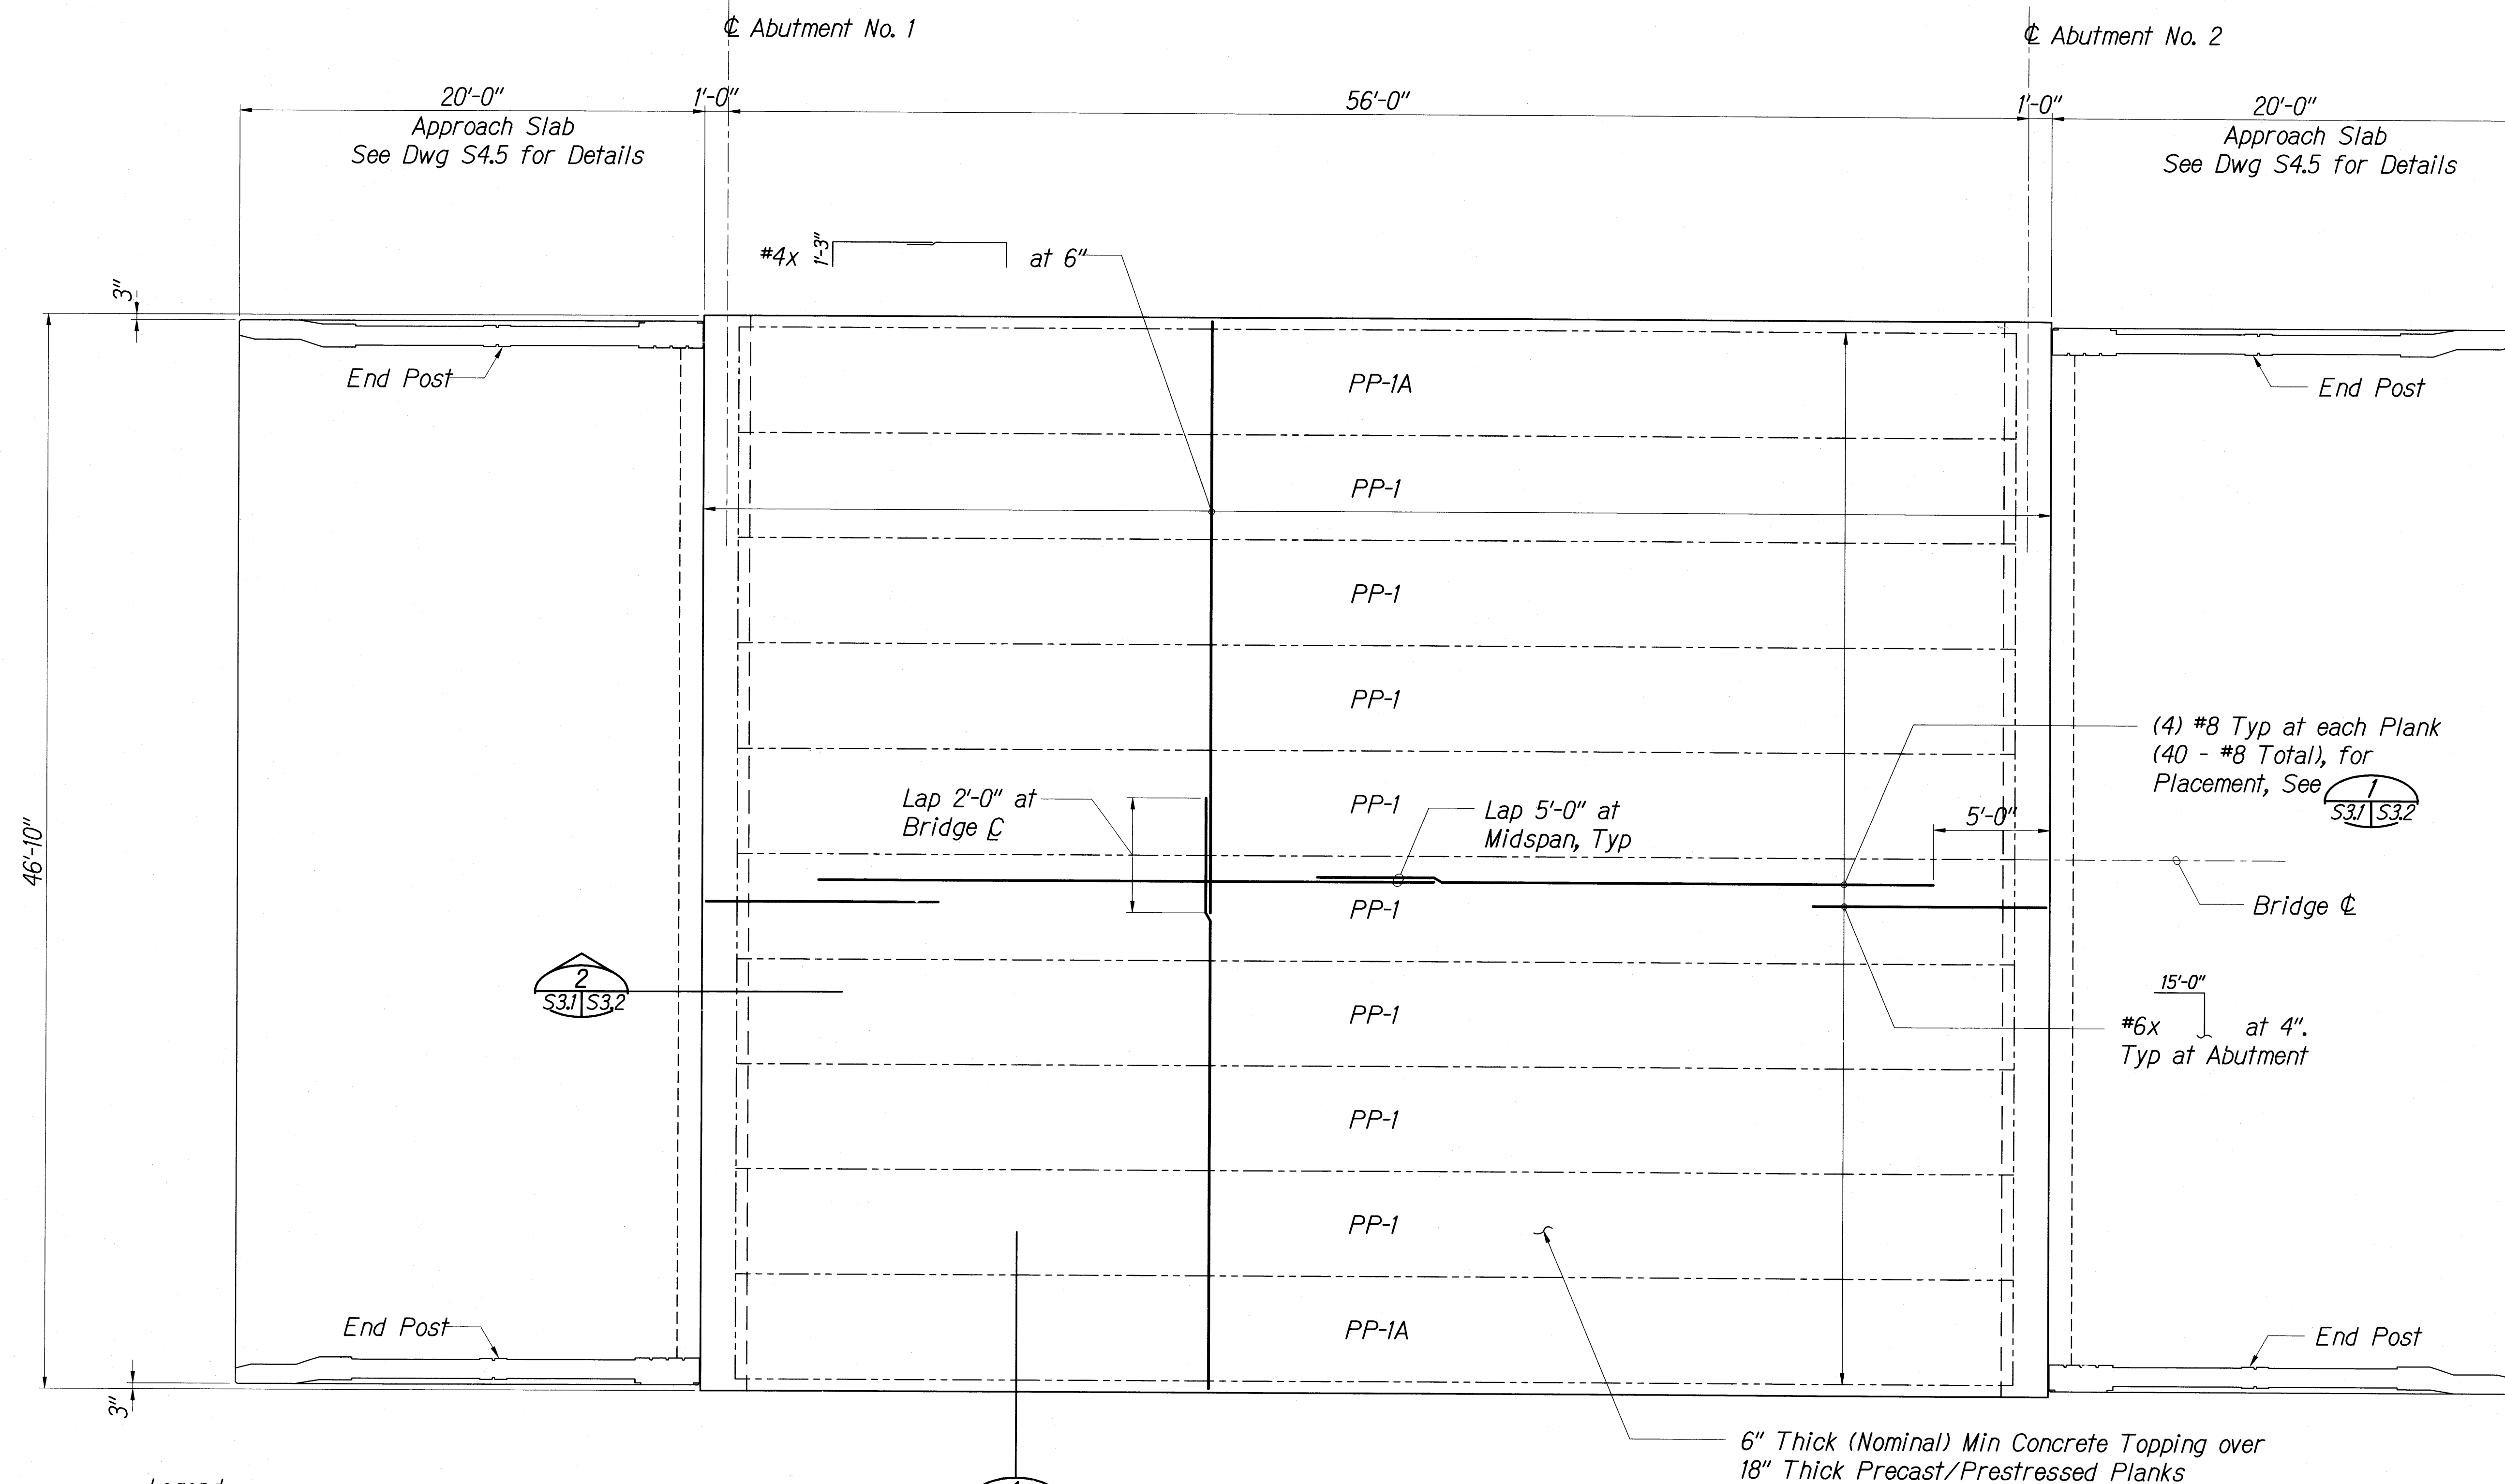

#### Legend



PP-1 Denotes Precast/Prestressed Plank Type, See Dwgs S3.3 and S3.4 for Details

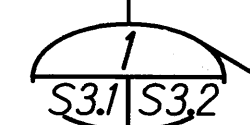

Note: Bridge Railing not Shown for Clarity.

#### DECK FRAMING PLAN

Scale: 1/4" = 1'-0"

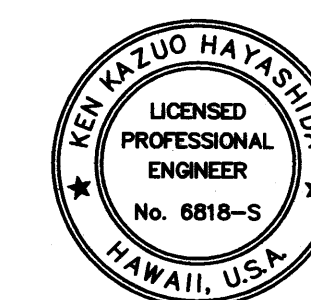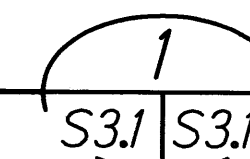

EXPIRATION DATE OF THE LICENSE 4/30/2012  
THIS WORK WAS PREPARED BY  
ME OR UNDER MY SUPERVISION

STATE OF HAWAII  
DEPARTMENT OF TRANSPORTATION  
HIGHWAYS DIVISION

**DECK FRAMING AND  
TOPPING REINFORCING PLAN**


KAMEHAMEHA V HIGHWAY  
Kawela Bridge Replacement  
Federal Aid Project No. BR-0450(8)

Scale: AS NOTED Date: June, 2010


SHEET No. S3.1 OF 93 SHEETS




FED. ROAD DIST. NO.	STATE	FED. AID PROJ. NO.	FISCAL YEAR	SHEET NO.	TOTAL SHEETS
HAWAII	HAW.	BR-0450(8)	2011	74	93

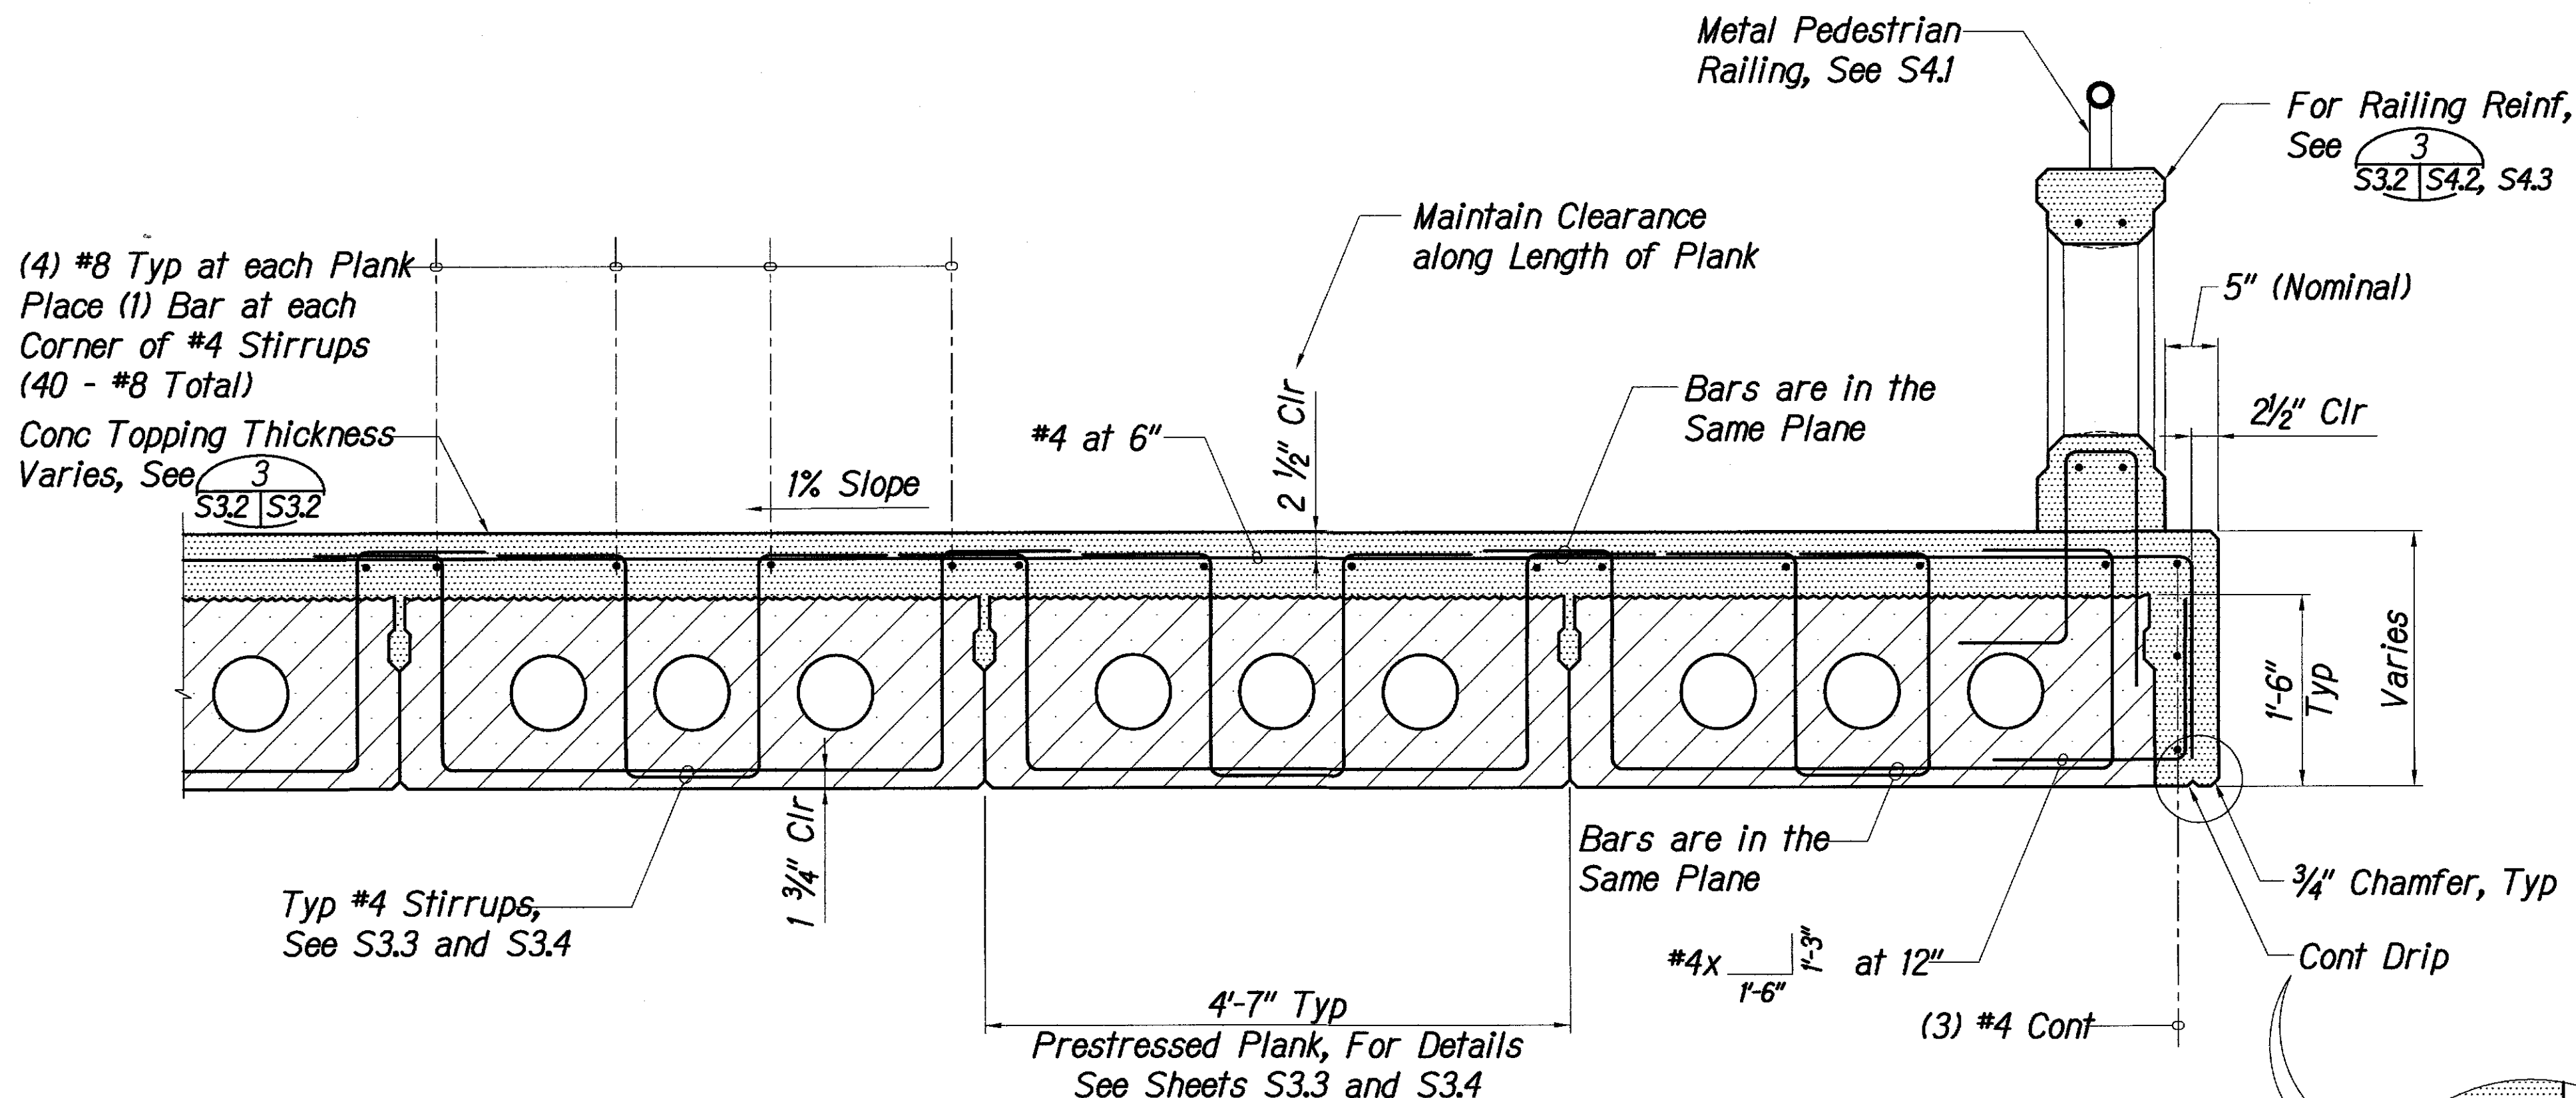

TYPICAL SECTION  
 Scale: 1" = 1'-0"  
 1  
 S3.1 S3.2

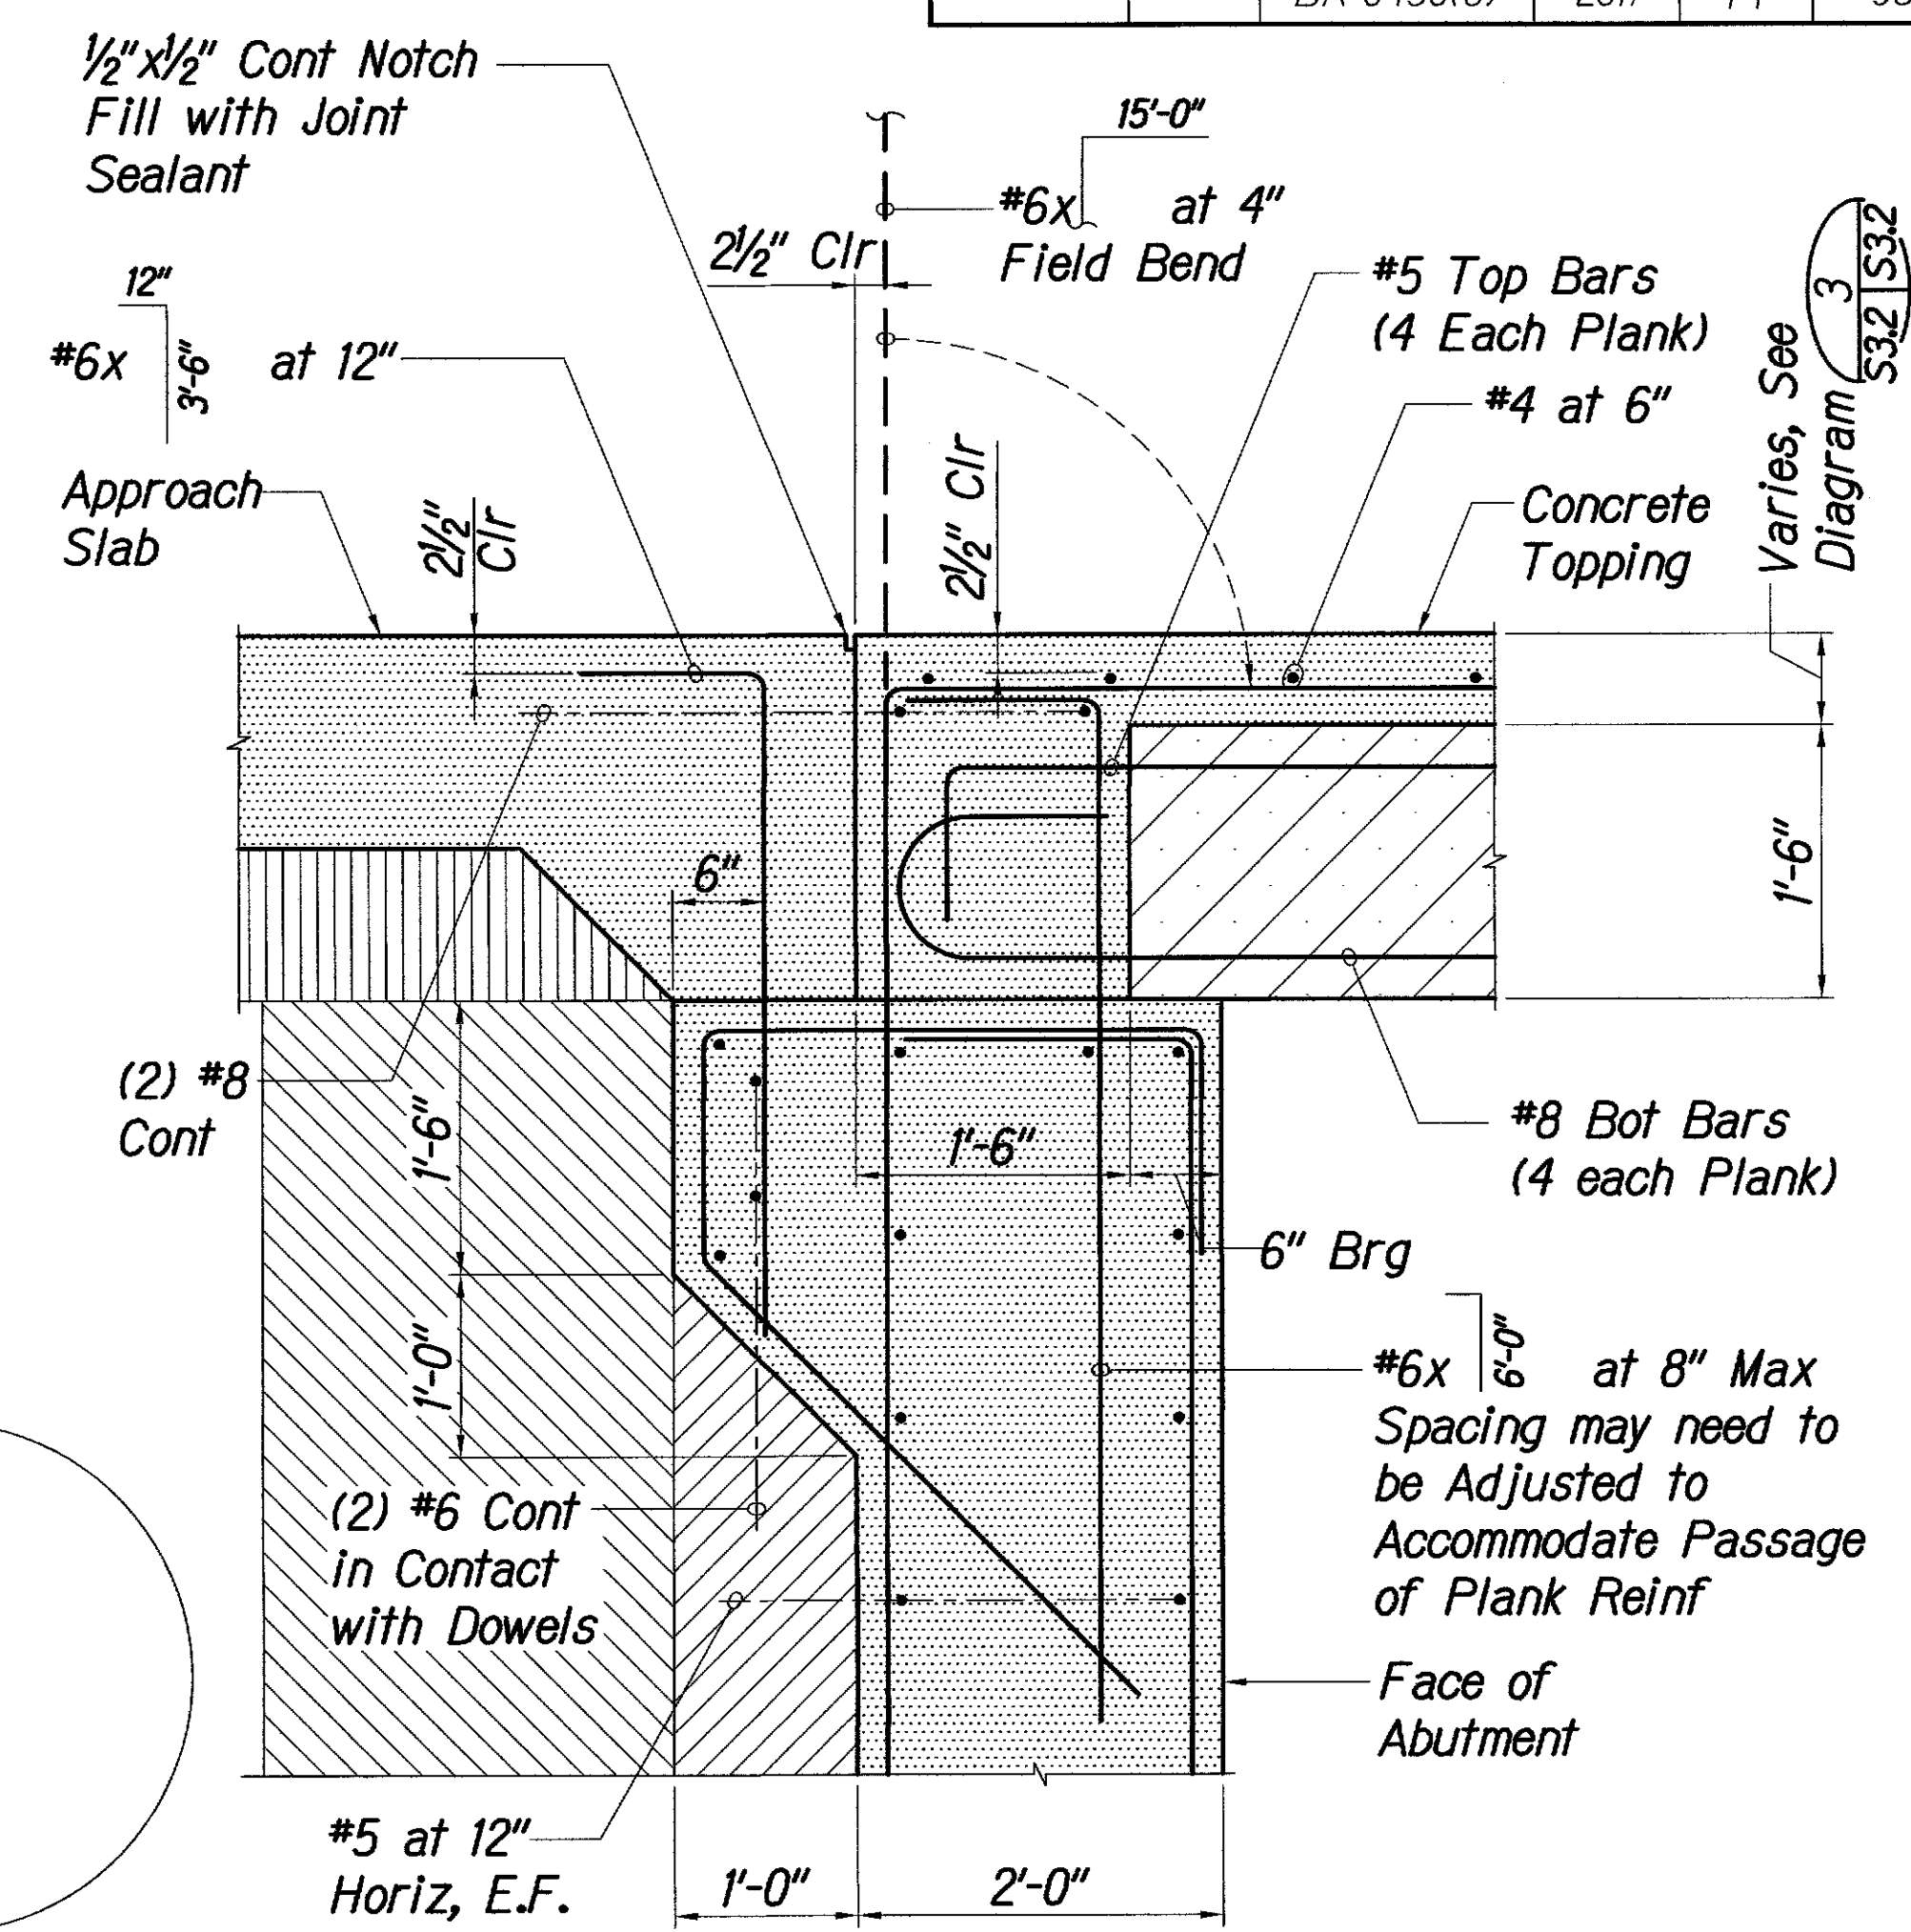

SECTION  
 Scale: 1" = 1'-0"  
 2  
 S3.1 S3.2

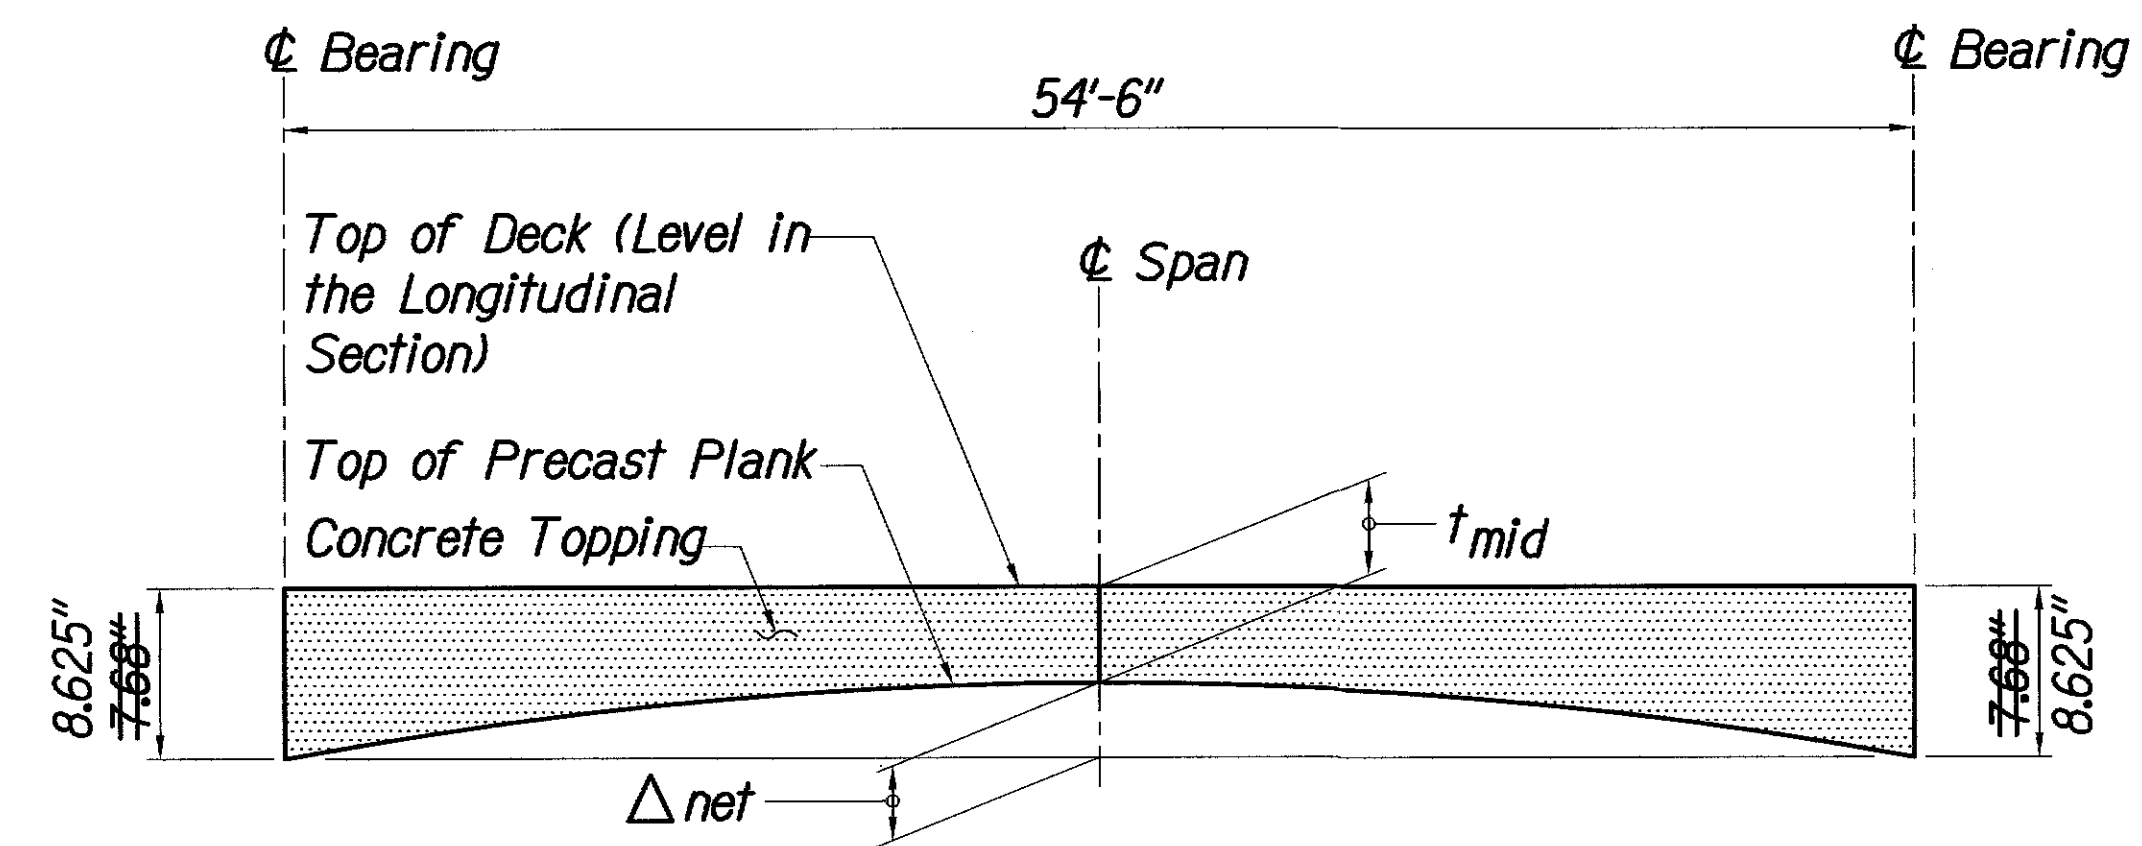

Legend:  
 $\Delta_{net}$  = Precast Plank Net Camber after Pouring Concrete Topping (inches).  
 $t_{mid}$  = 7.68" -  $\Delta_{net}$   
 $t_{min}$  = 5.59" min Concrete Topping Thickness at Midspan  
 $t_{max}$  = 6.59" max Concrete Topping Thickness at Midspan

CONCRETE TOPPING THICKNESS DIAGRAM ALONG LONGITUDINAL SECTION  
 Not to Scale  
 3  
 S3.2 S3.2

LEGEND FOR AS-BUILT POSTINGS	
~~~~~	Squiggly line for as-built deletion
==	Double line for as-built deletion
ROADWAY	Text for as-built posting



STATE OF HAWAII  
 DEPARTMENT OF TRANSPORTATION  
 HIGHWAYS DIVISION

**DECK SECTIONS  
 AND DETAILS**  
**KAMEHAMEHA V HIGHWAY**  
**Kawela Bridge Replacement**  
**Federal Aid Project No. BR-0450(8)**


Scale: AS NOTED Date: June, 2010

SHEET No. S32 OF 93 SHEETS

FED. ROAD DIST. NO.	STATE	FED. AID PROJ. NO.	FISCAL YEAR	SHEET NO.	TOTAL SHEETS
HAWAII	HAW.	BR-0450(8)	2011	75	93

# **PRESTRESSED PLANK NOTES:**

1. Prestressed Concrete 28 Day Strength  $f'_c = 7,000$  psi.  
Prestressed Concrete Strength at time of release  $f_{ci} = 5,500$  psi.
2. Prestressing Strands shall be (7) Wire  $1/2"$   $\phi$  Low Relaxation Steel Strands (Area =  $0.153$  in<sup>2</sup>) conforming to ASTM A416 with an Ultimate Tensile Strength of 270 ksi. Initial Strand Stress (before any Losses) = 202.5 ksi.
3. Non-Prestressed reinforcing Steel shall be deformed bars conforming to ASTM A615, Grade 60, unless noted otherwise.
4. Strand Pattern shall be symmetrical about the Longitudinal  $\phi$  of the Plank.
5. Strand release sequence shall not induce any Lateral Deflection of the Plank.
6. Contractor shall submit shop drawings indicating Proposed Strand Pattern, releasing sequence, Reinforcing details and Hold Down Device details to the Engineer prior to fabrication.
7. During curing, care shall be taken to avoid any Lateral Deflection to the Plank due to improper orientation. Steam curing may be used to accelerate Strength Gain.
8. Lifting Devices shall be placed as close as possible to the Centerline of Bearings of the Plank. Details and locations of Lifting Devices shall be submitted to the Engineer for approval. Such approval does not Relieve the Contractor of his responsibilities if Plank is damaged due to failure of the Lifting Device.
9.  $P_{(e)}$  Effective Prestress Force after all Losses (KIPS)
10.  $L = 55'-0"$  (Prestressed Plank length)
11. The stirrup and "U" bar spacing for Plank PP-1A allows for installation of 8" wide x 4" high scupper openings and window openings as shown on Sheets S4.1 and S4.4. Contractor shall take special care in locating these rebars.

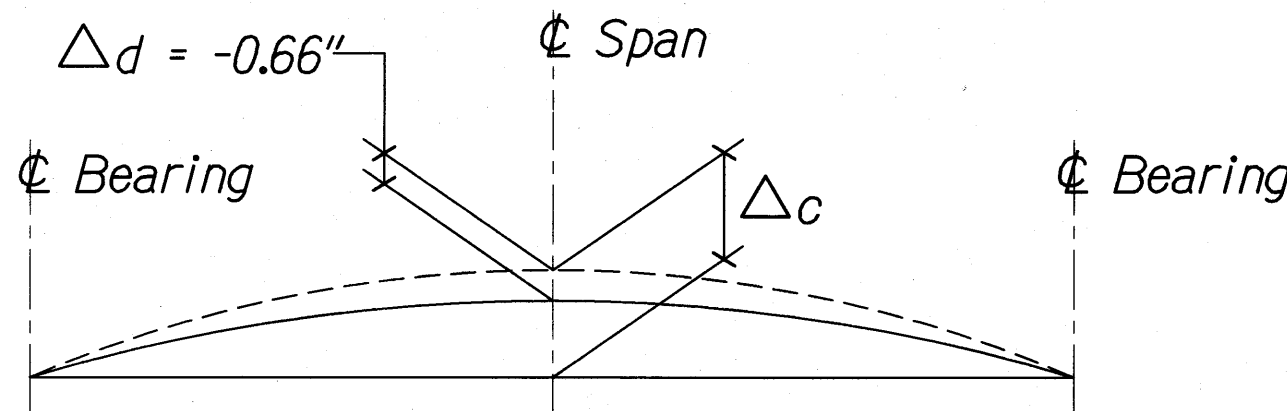


**PRESTRESSED PLANK CAMBER DIAGRAM**

	Calculated Camber $\Delta_c$
2 Days after Release of Prestress	1.30"
at Erection	2.25"


## **CAMBER DIAGRAM NOTES:**

1. The Calculated Camber,  $\Delta_c$ , includes the Effects of the initial Prestress Force and the Weight of the Precast Plank after removal from the Bed. The Calculated Camber value has been Multiplied by Creep factors to approximate the Effect of Camber growth and concrete Creep. Positive values indicate a net Upward Deflection.
2. Camber values were obtained using Modulus of Elasticity,  $E = 3,867$  ksi for concrete strength of 5,500 psi ( $k = 0.86$  in AASHTO LRFD equation 5.4.2.4-1). Type of aggregate to be used in all the Girders shall be obtained from a Single supplier and Quarry site.

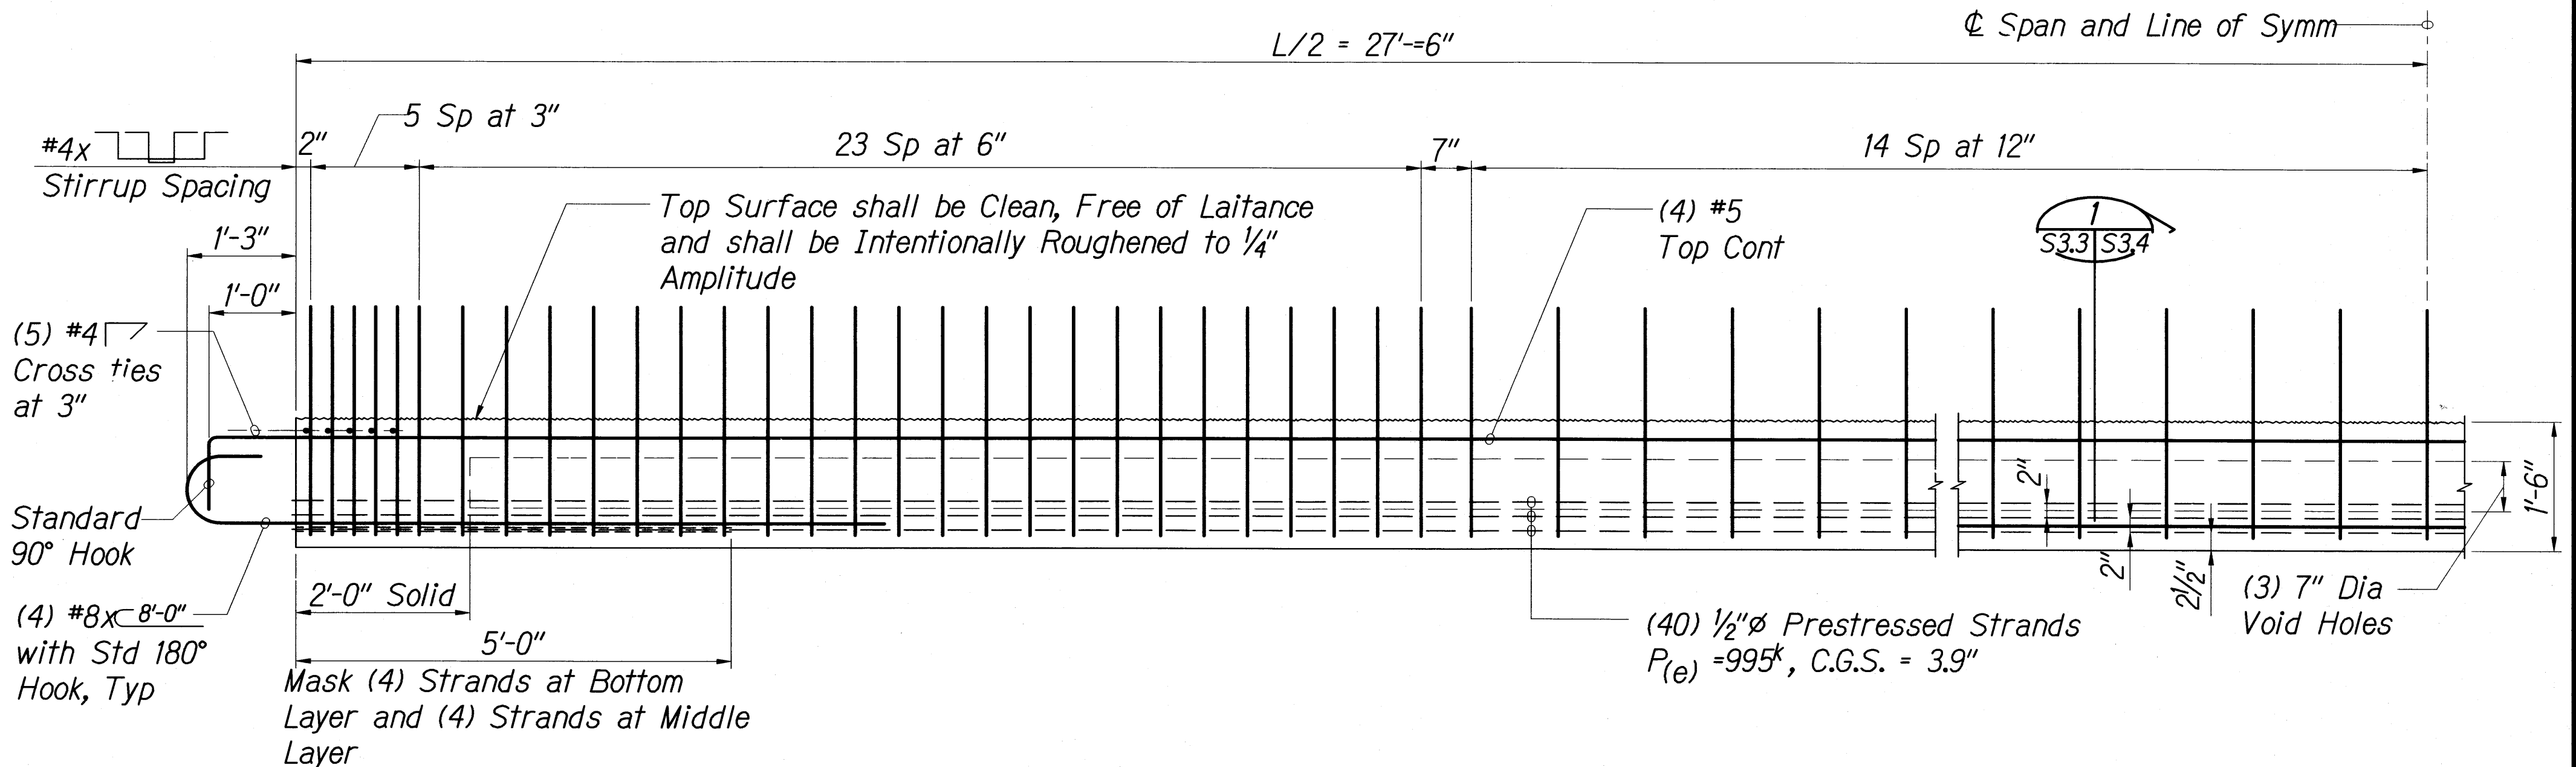

**TYPICAL INTERIOR PRESTRESSED PLANK PP-1**


Scale: 3/4" = 1'-0"

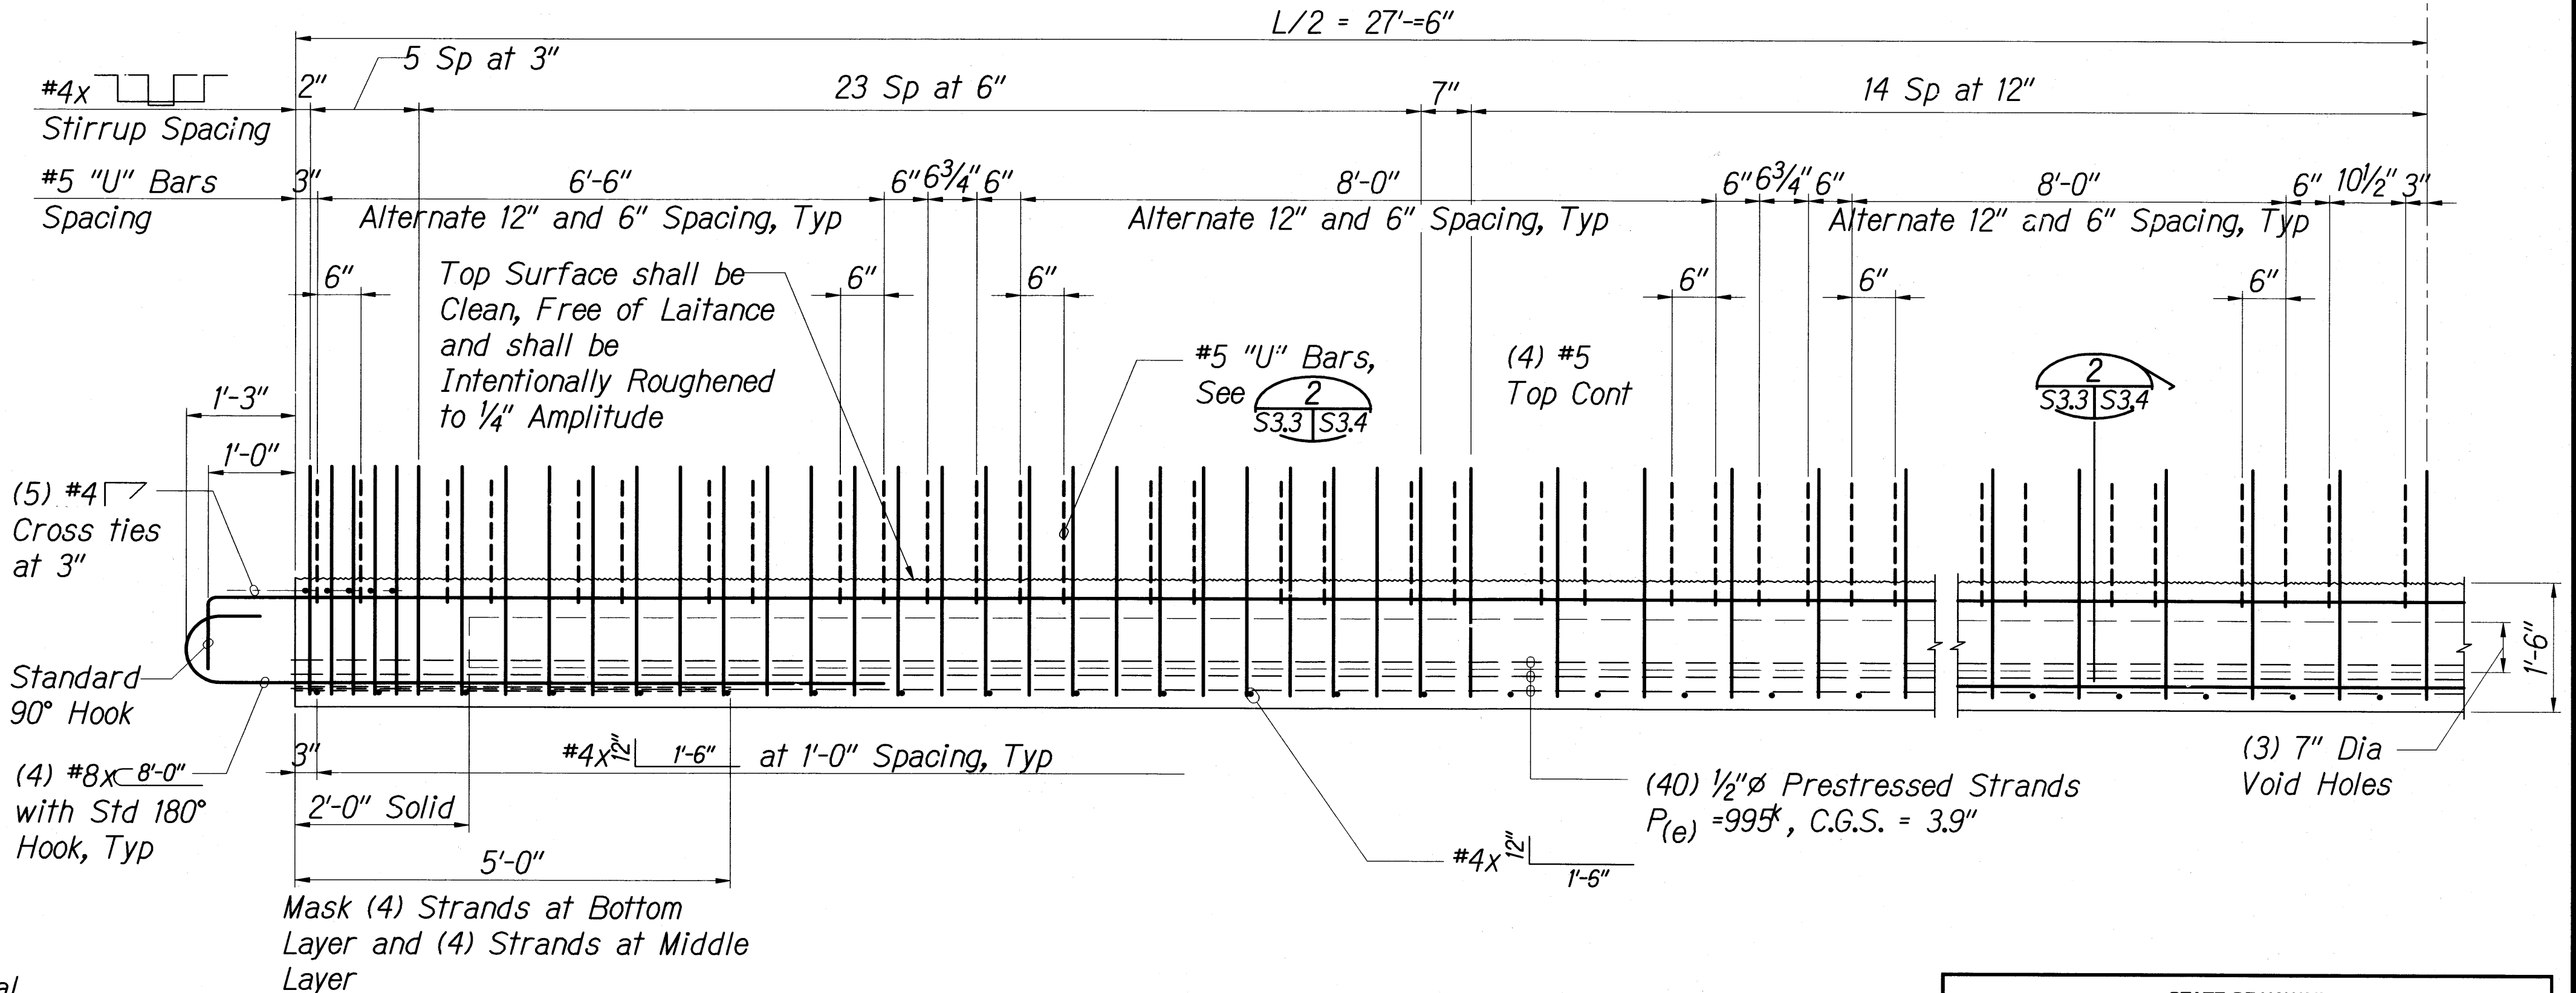

**TYPICAL EXTERIOR PRESTRESSED PLANK PP-1A**

Scale: 3/4" = 1'-0"

3. The Contractor shall measure the Actual Camber of each Girder no more than 2 days after the Release of Prestress and again just before Erection in the field. Actual Camber shall not vary from the Calculated values by  $\pm 1/2"$ .
4. Dead Load deflection,  $\Delta_d$ , is due to the Weight of the Concrete Topping.

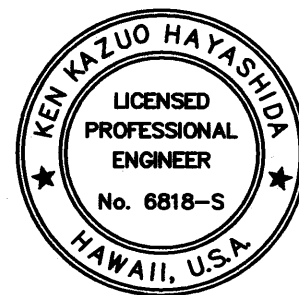

EXPIRATION DATE OF THE LICENSE 4/30/2012  
THIS WORK WAS PREPARED BY ME OR UNDER MY SUPERVISION

STATE OF HAWAII  
DEPARTMENT OF TRANSPORTATION  
HIGHWAYS DIVISION


**TYPICAL PRESTRESSED PLANK**  
**LONGITUDINAL SECTIONS**  
KAMEHAMEHA V HIGHWAY  
Kawela Bridge Replacement  
Federal Aid Project No. BR-0450(8)

Scale: AS NOTED Date: June, 2010


SHEET No. S3.3 OF 93 SHEETS



FED. ROAD DIST. NO.	STATE	FED. AID PROJ. NO.	FISCAL YEAR	SHEET NO.	TOTAL SHEETS
HAWAII	HAW.	BR-0450(8)	2011	76	93

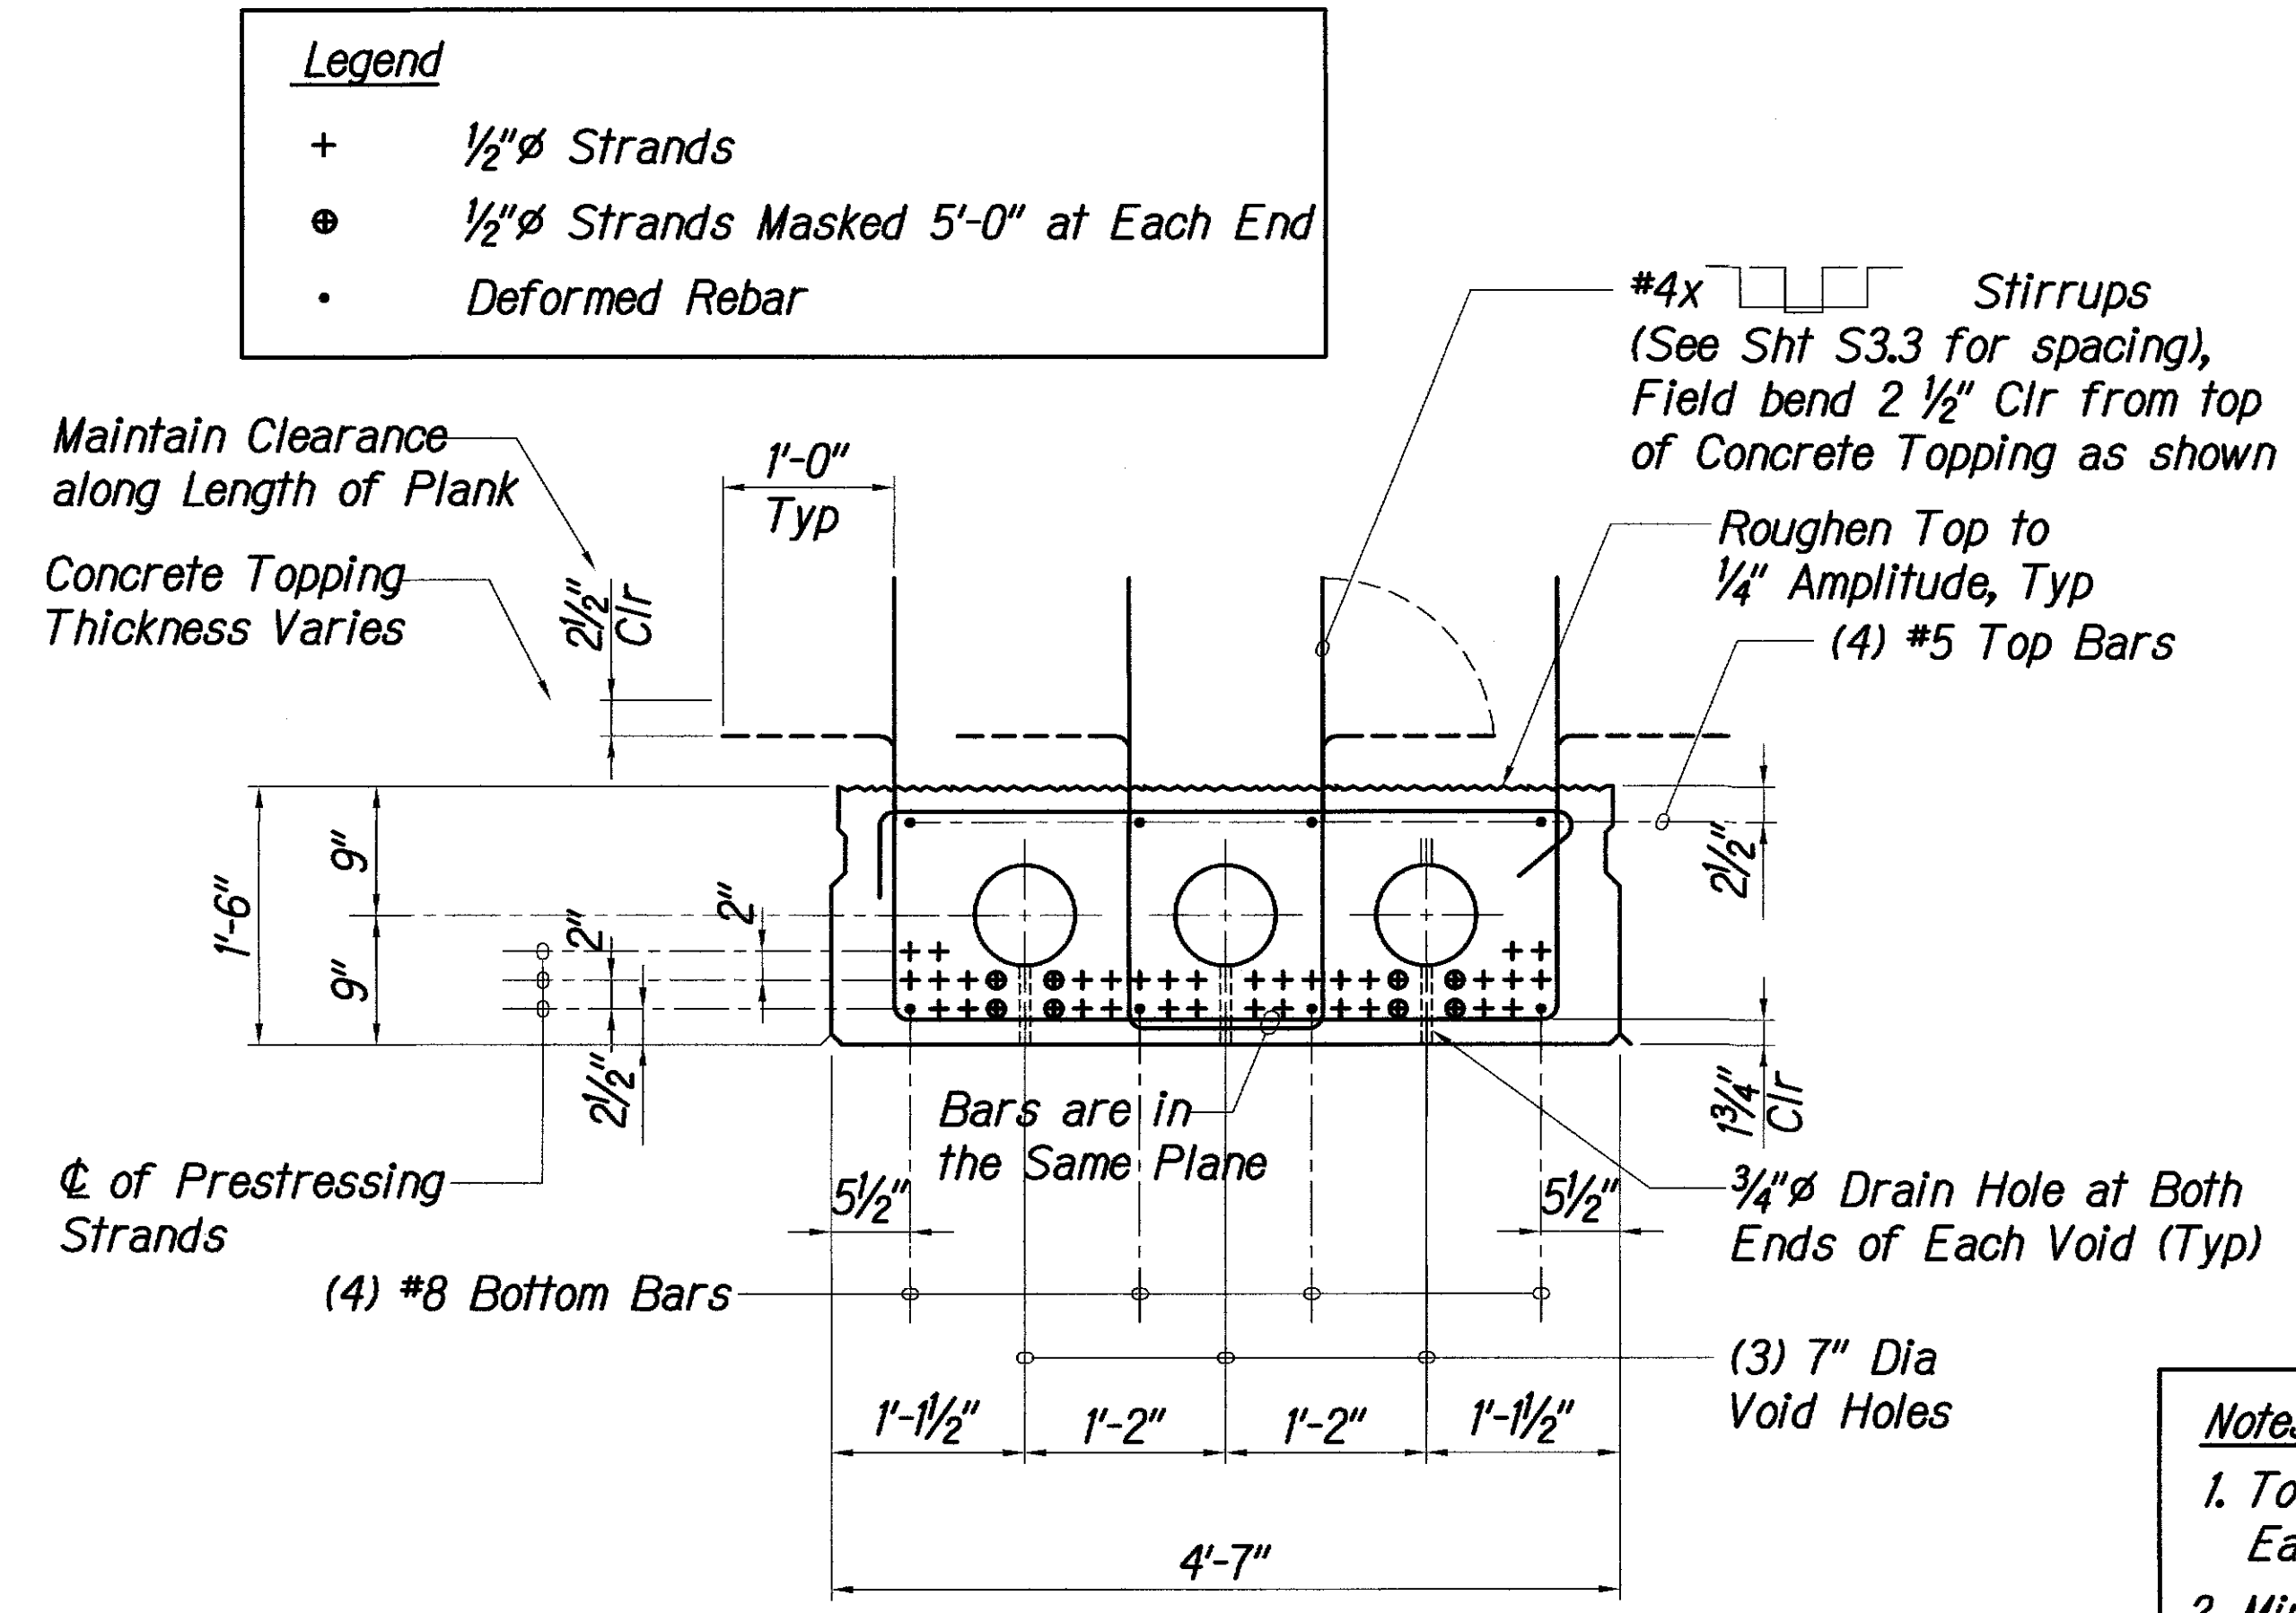


SECTION - PRESTRESSED PLANK PP-1 1  
 Scale: 1" = 1'-0" S3.3 S3.4

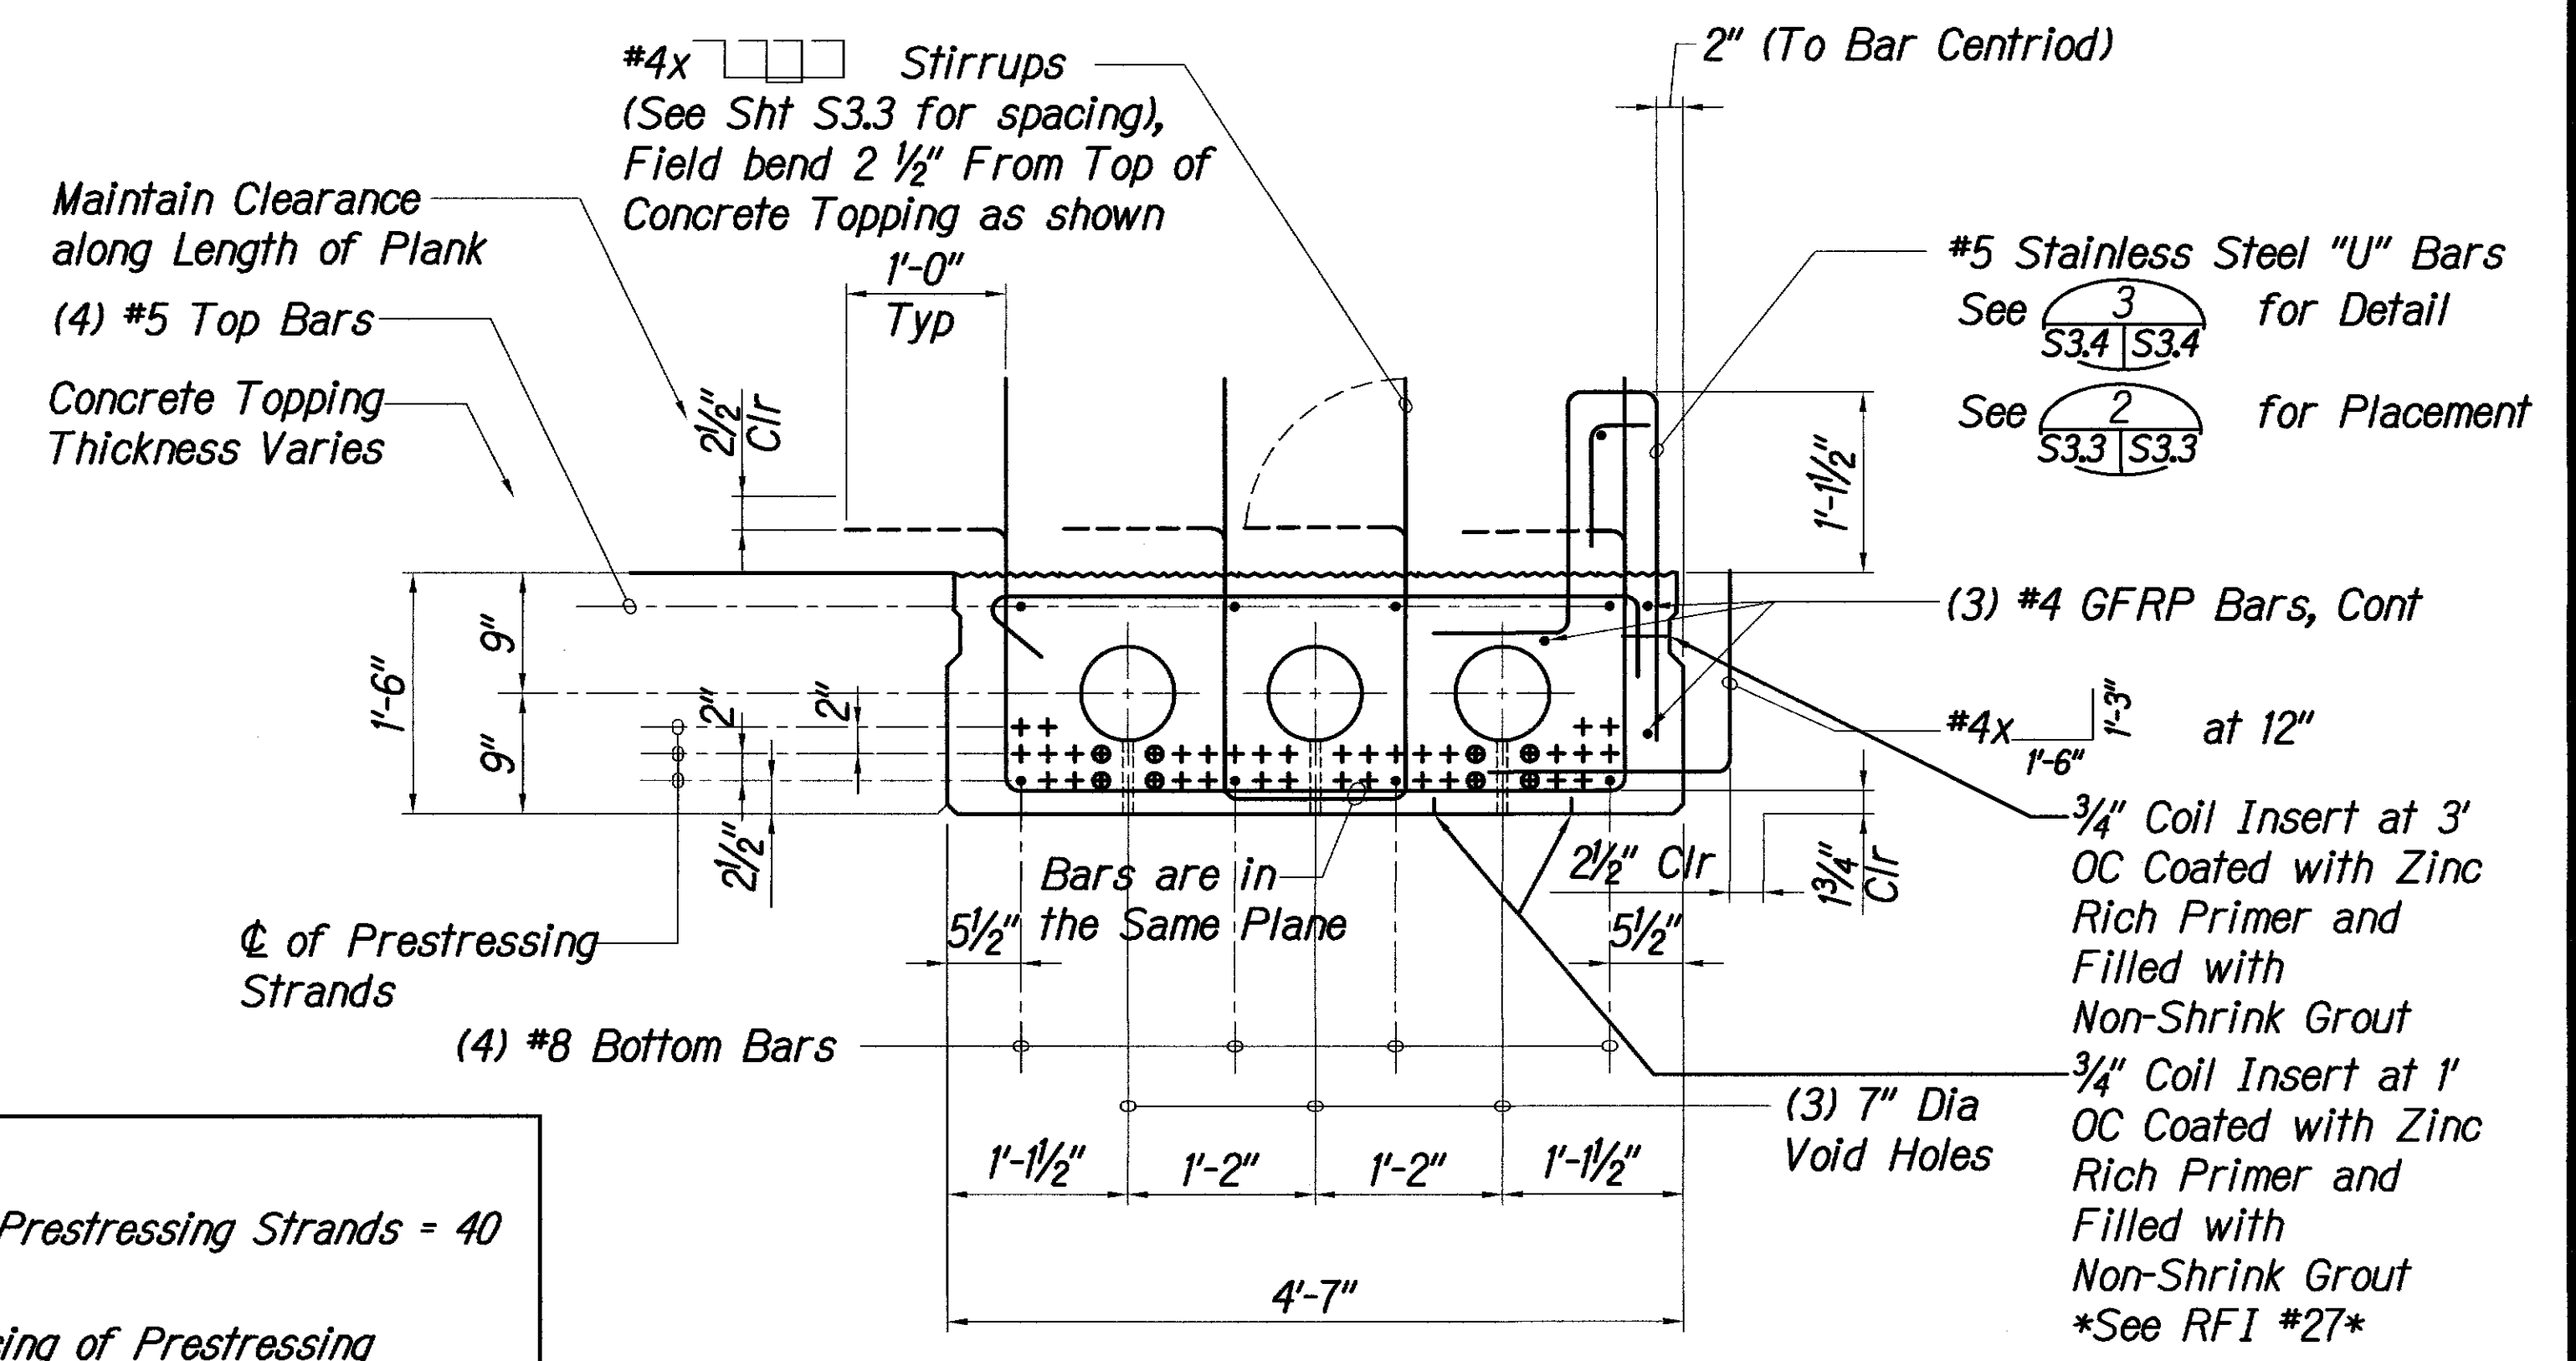

SECTION - PRESTRESSED PLANK PP-1A 2  
 Scale: 1" = 1'-0" S3.3 S3.4


**Notes:**  
 1. Total No. of Prestressing Strands = 40 Each Plank.  
 2. Minimum spacing of Prestressing Strand shall be 2" o.c.

**Notes:**  
 1. The stainless steel rebar shall be supported only by GFRP rebar and not carbon steel rebar. The stainless steel rebars shall never come in contact with carbon steel bars. Tie wires for connecting all stainless steel rebar shall be stainless steel wire or non-metallic wire.  
 2. See reinforcing steel Note E, sheet S0.1, for specifications on GFRP rebar.

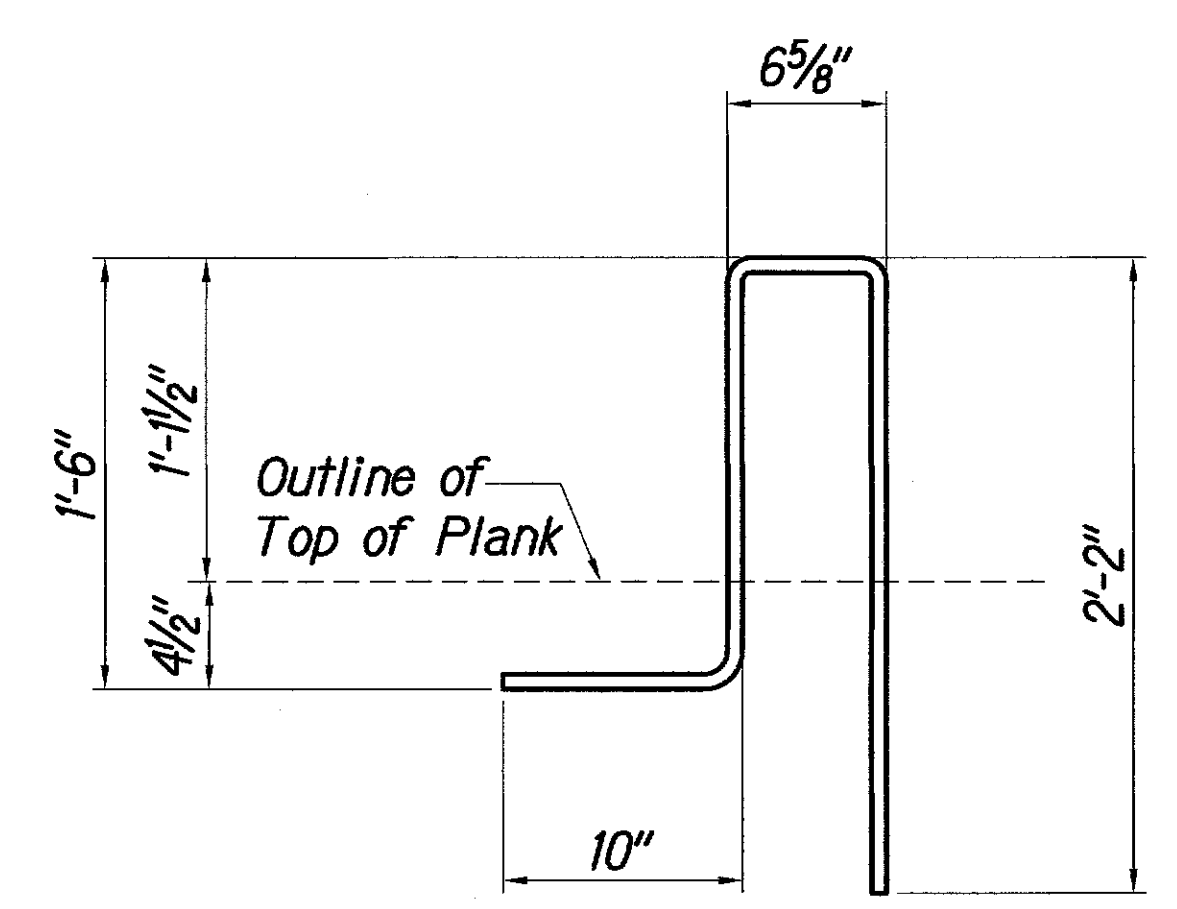

**Note:**  
 "U" Bar shall be #5 Deformed Stainless Steel Bars, Type 316, Grade 60 Conforming to ASTM A955.

"U" BAR (#5) DETAIL 3  
 Not to Scale S3.4 S3.4

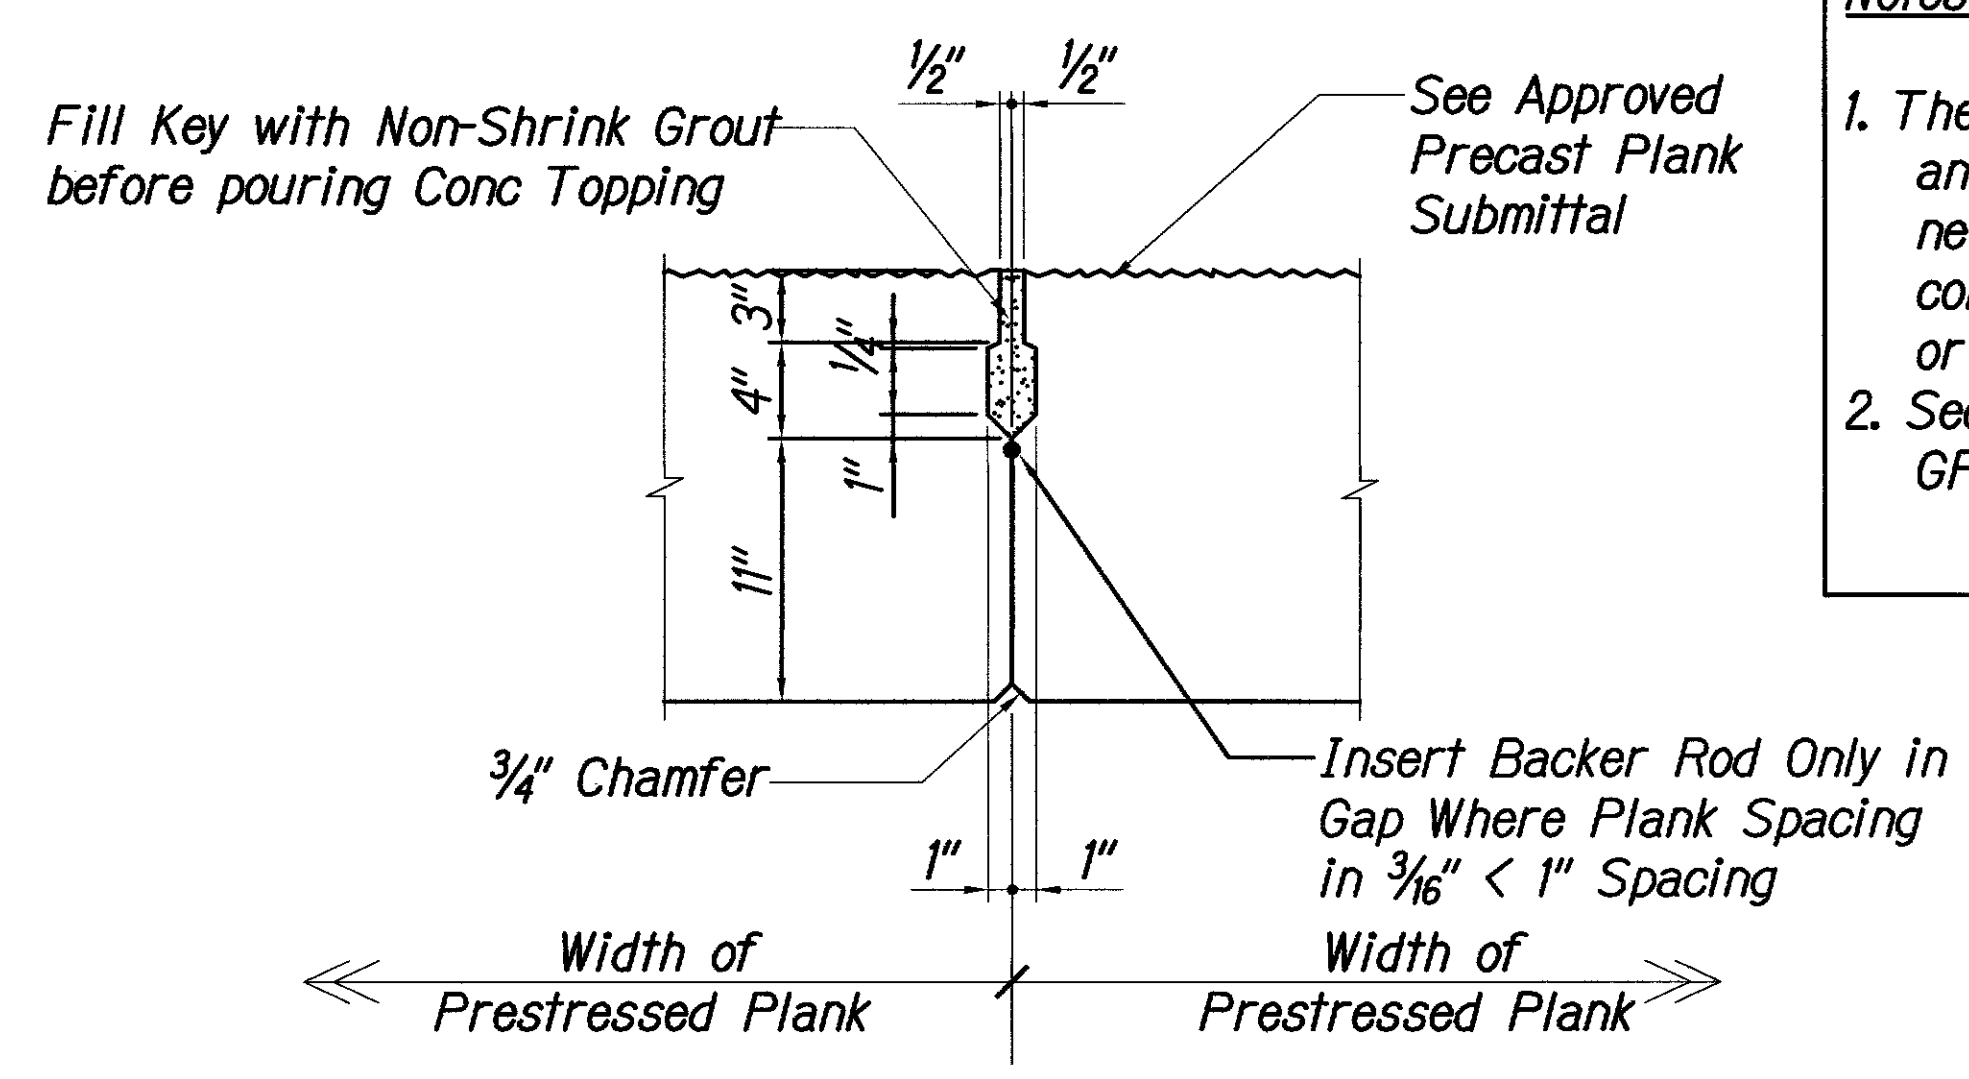

**Note:**  
 Non-Shrink Grout shall have a 7-Day Compressive Strength of 6,000 psi.

TYPICAL PLANK KEY DETAIL 4  
 Not to Scale S3.4 S3.4

**LEGEND FOR AS-BUILT POSTINGS**

~~~~~	Squiggly line for as-built deletion
==	Double line for as-built deletion
ROADWAY	Text for as-built posting



STATE OF HAWAII  
 DEPARTMENT OF TRANSPORTATION  
 HIGHWAYS DIVISION


**PRESTRESSED PLANK SECTIONS AND DETAILS**  
 KAMEHAMEHA V HIGHWAY  
 Kawela Bridge Replacement  
 Federal Aid Project No. BR-0450(8)

Scale: AS NOTED Date: June, 2010


SHEET No. S3.4 OF 93 SHEETS

2016-09-13 15:28-01 Kawela Bridge AS BUILT S3.4.dwg, 9/13/2016 4:48:26 PM, tamahata


FED. ROAD DIST. NO.	STATE	FED. AID PROJ. NO.	FISCAL YEAR	SHEET NO.	TOTAL SHEETS
HAWAII	HAW.	BR-0450(8)	2011	77	93

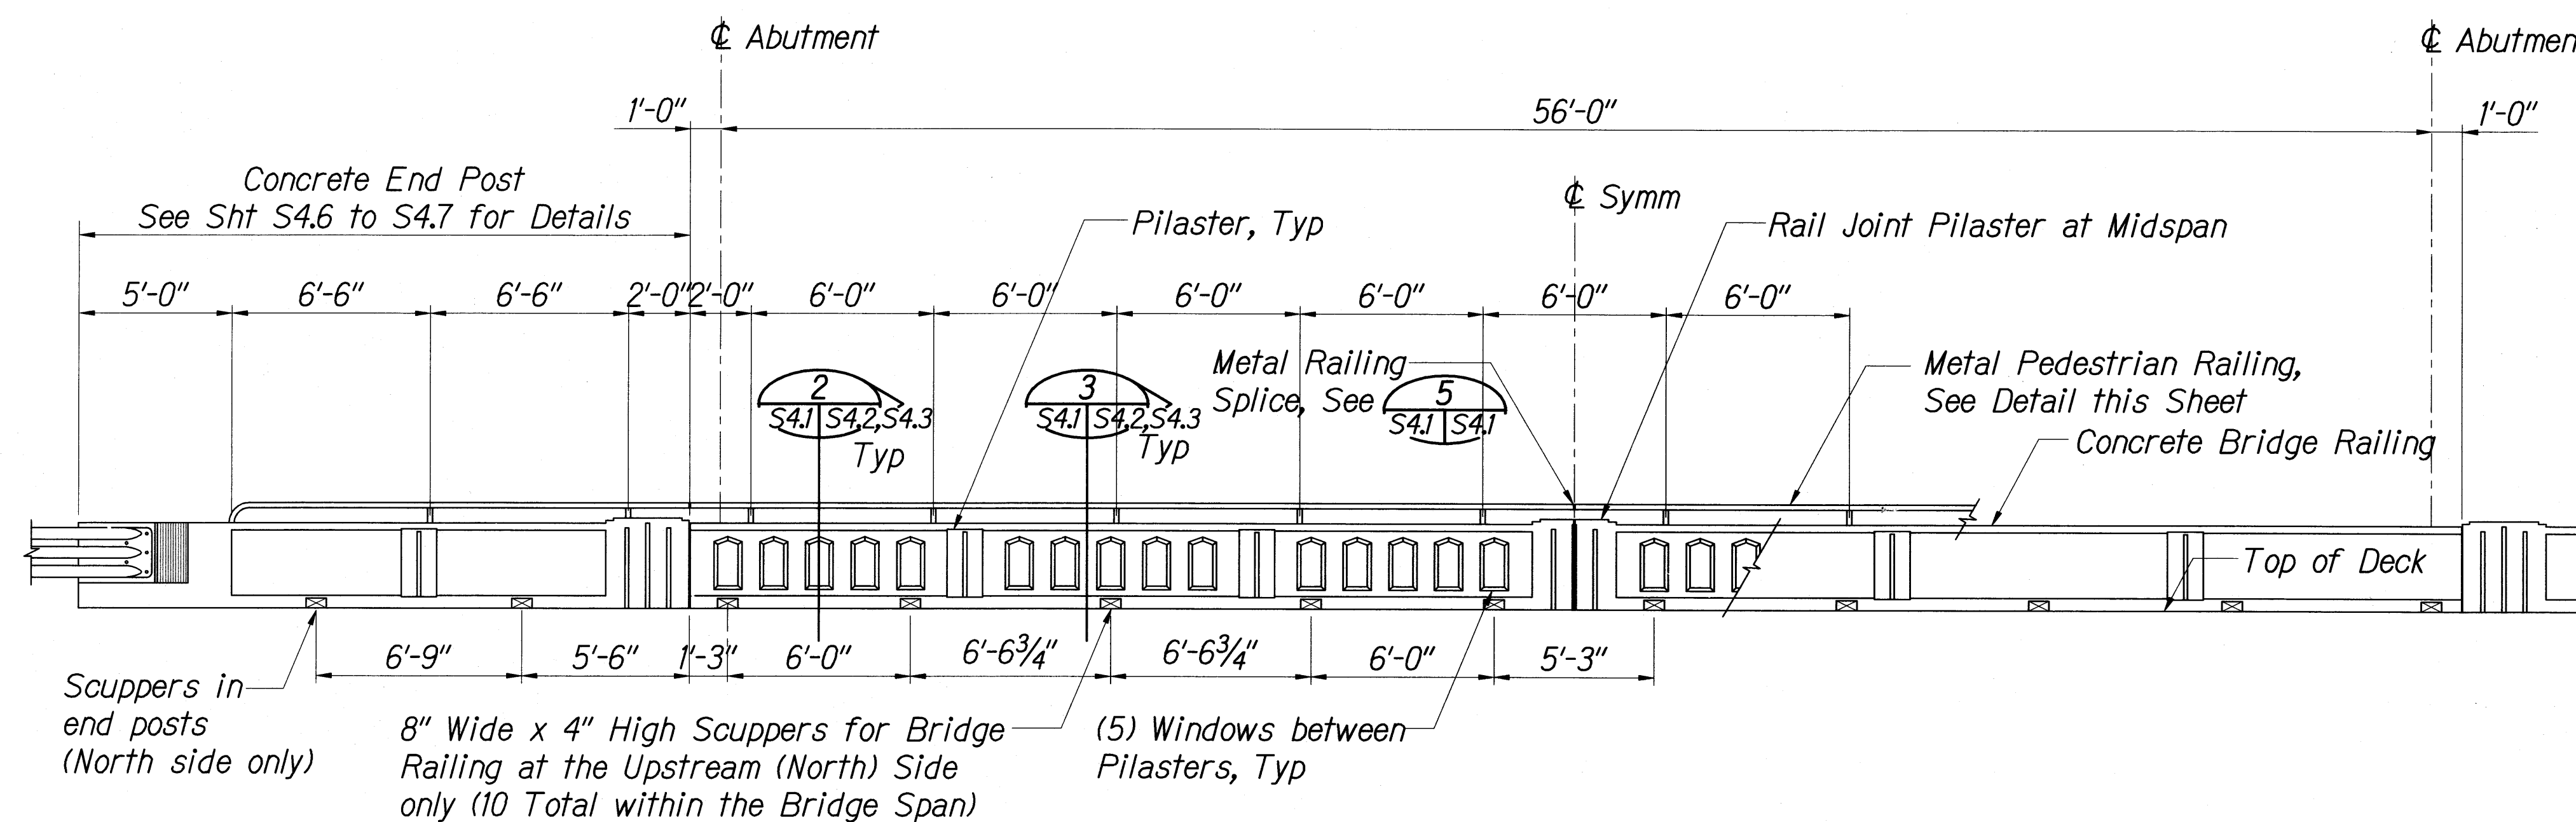


**BRIDGE RAILING ELEVATION**  
Scale: 1/4" = 1'-0"

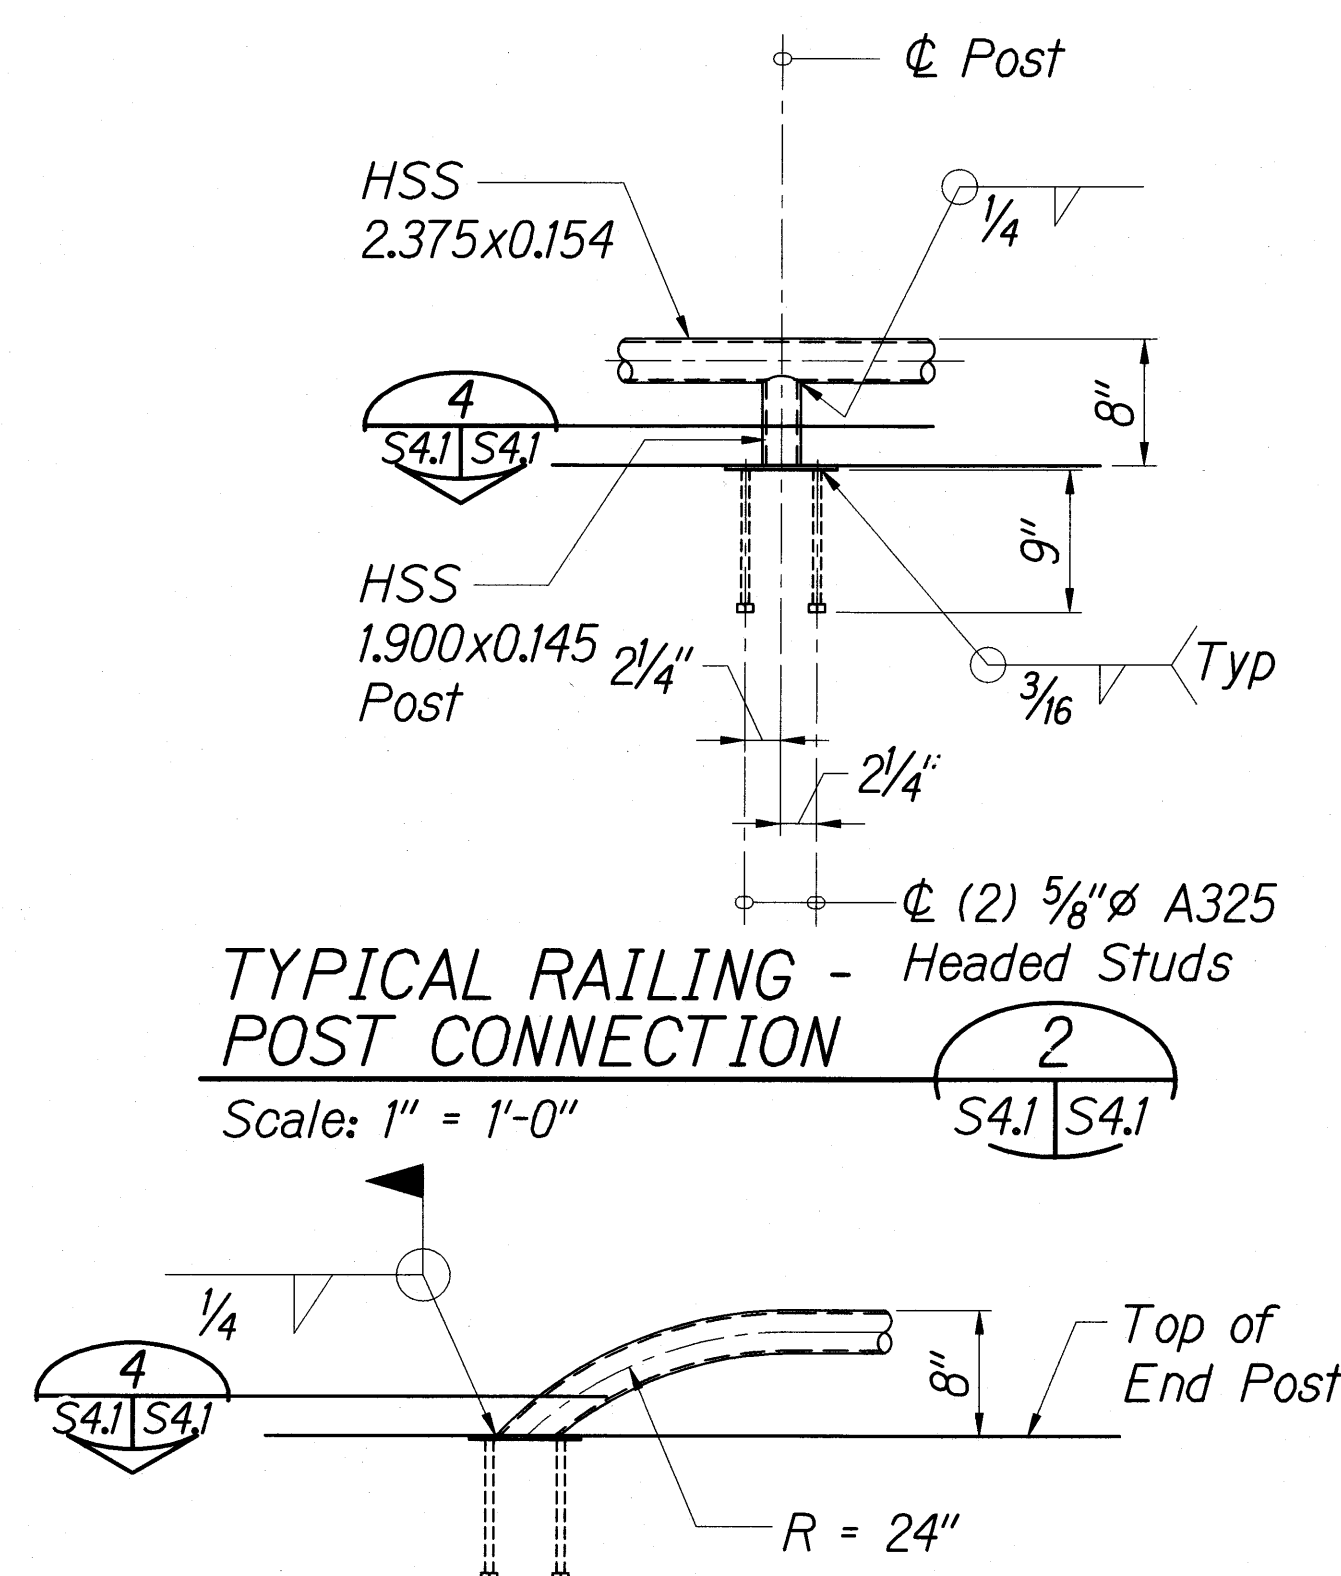


**TYPICAL RAILING - POST CONNECTION**  
Scale: 1" = 1'-0"

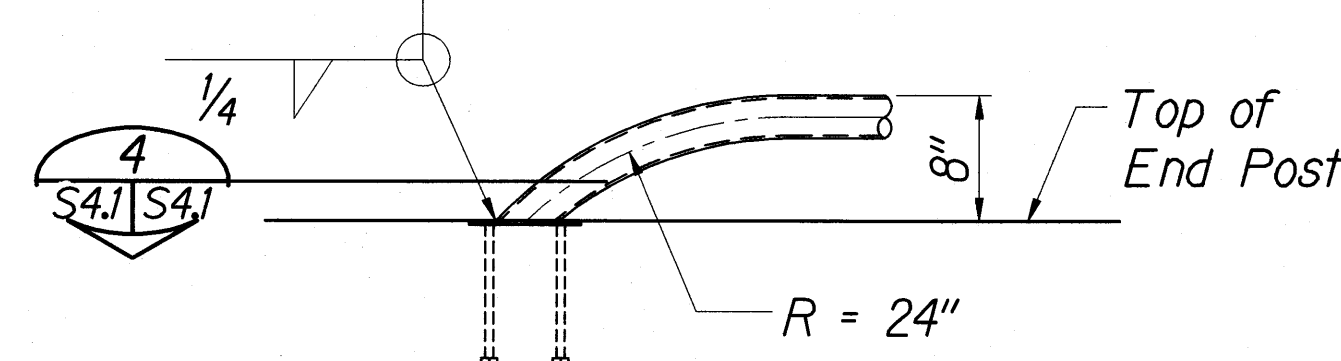

**TYPICAL RAILING - END POST CONN**  
Scale: 1" = 1'-0"

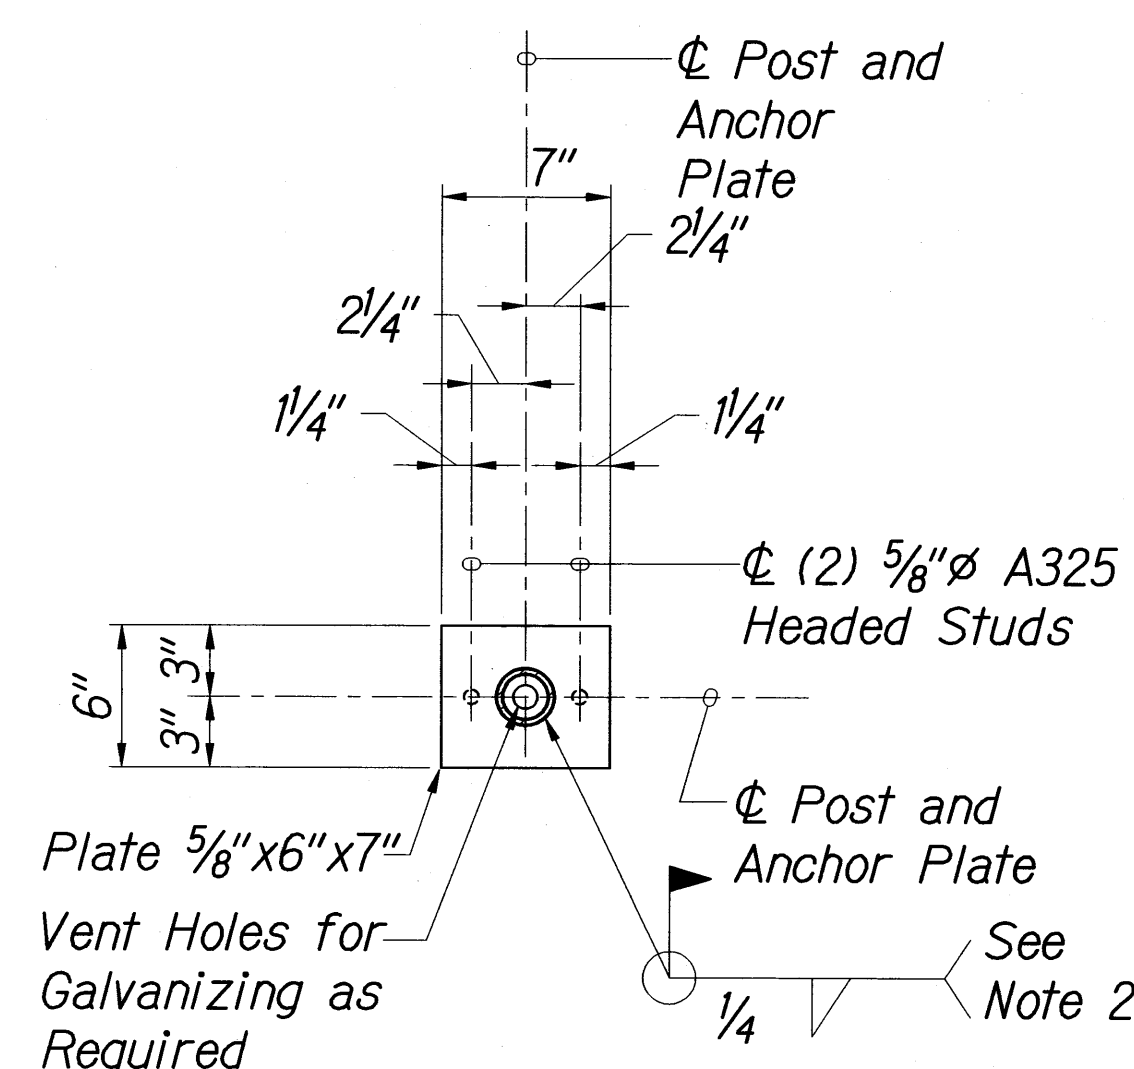


**TYPICAL RAILING - ANCHOR PLATE DETAIL**  
Scale: 1 1/2" = 1'-0"

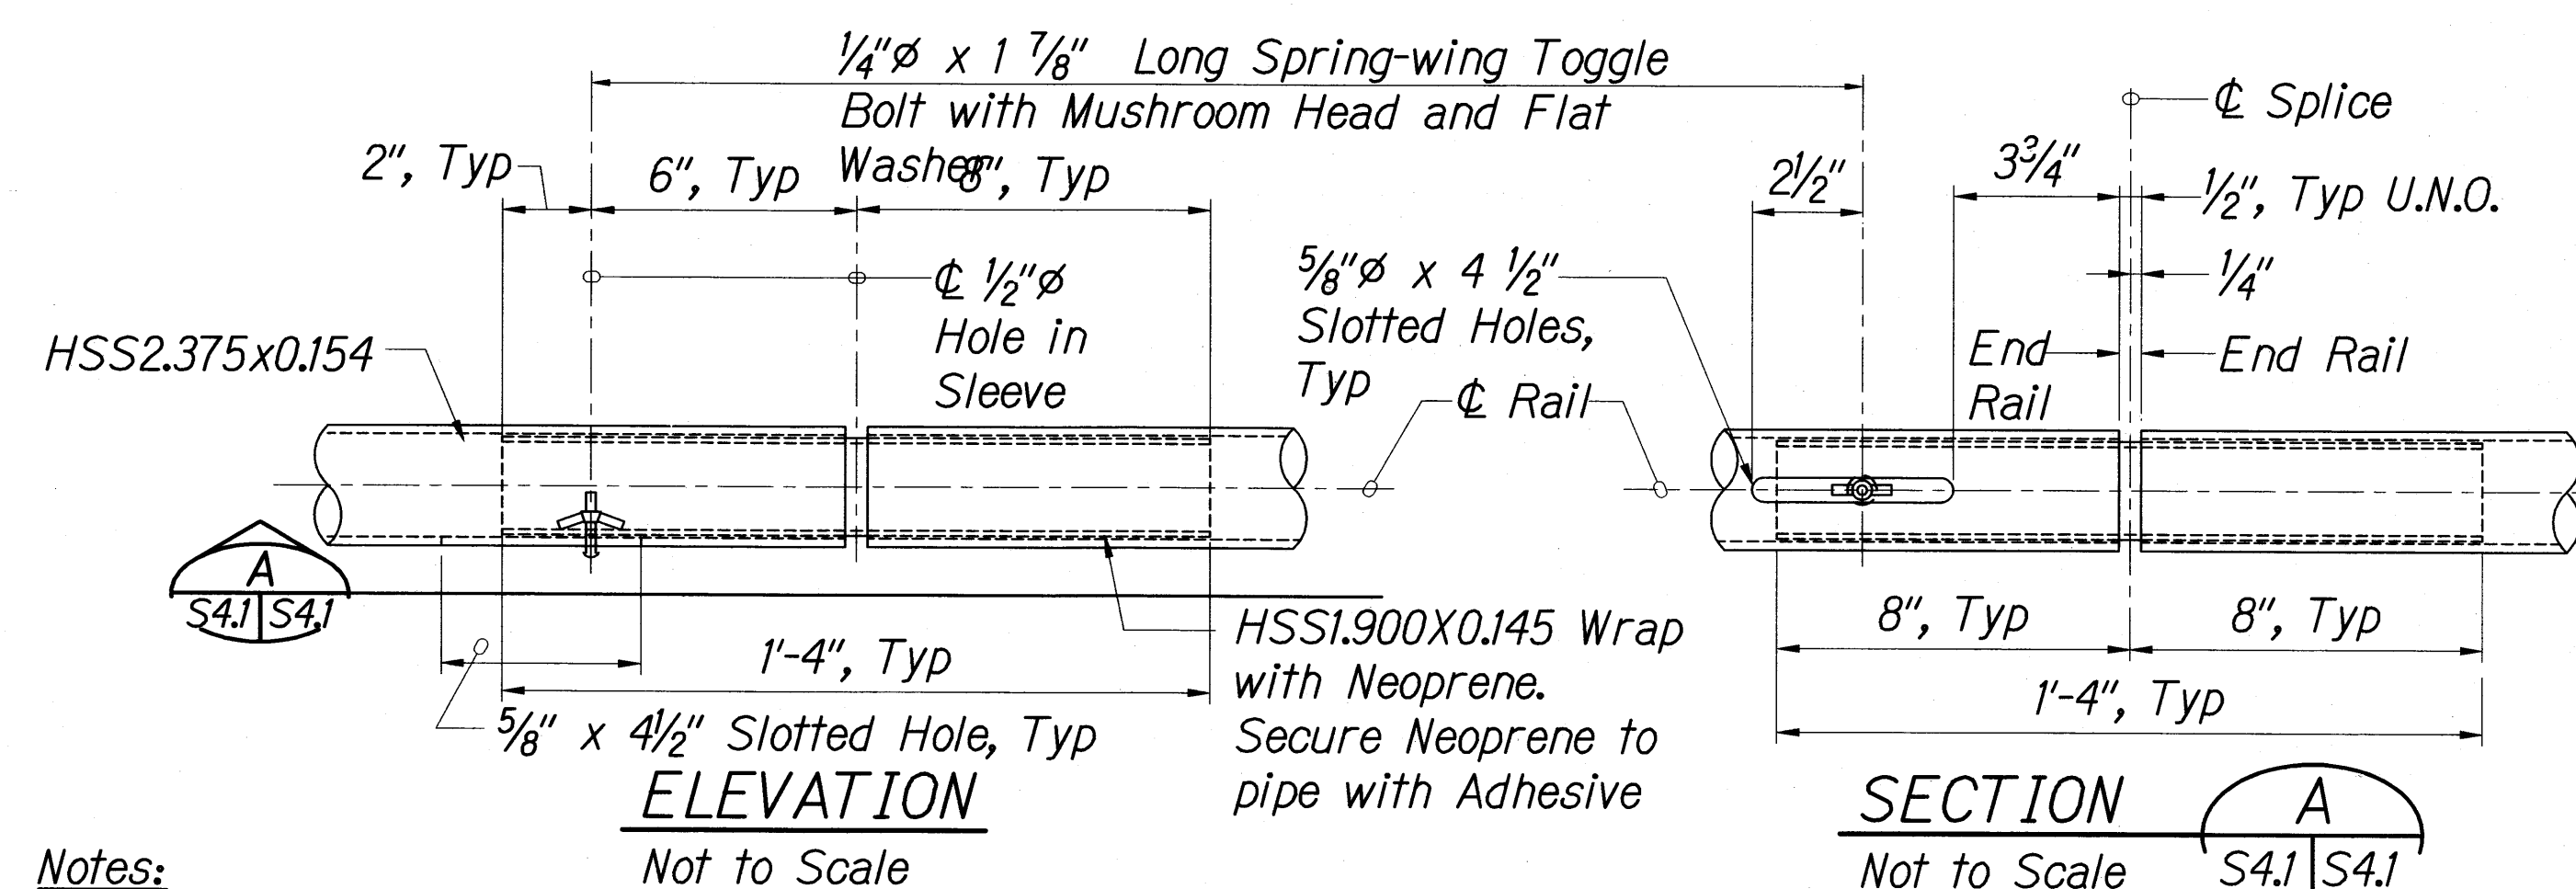

**TYPICAL PIPE SPLICE DETAIL**  
Not to Scale

- Notes:**
- All reinforcing steel in bridge railing shall be deformed, stainless steel bars Type 316 Grade 60 conforming to ASTM A995.
  - Bars "U" (#5) by precast/prestressed plank supplier.
  - The stirrup and "U" bar spacing as shown on Sht 3.3 allows for installation of 8" wide x 4" high scupper openings and window openings. Contractor shall take special care in locating these rebars (Plank PP-1A).
  - Metal Pedestrian Railing:**
    - The metal pedestrian railings shall be hot dip galvanized after fabrication and shop painted according to Paint Schedule, Sht. S0.2.
    - The metal railing posts shall be field welded to embedded plate in the top of concrete railing as shown on Sht. S4.1.
      - After welding is complete, remove all weld slag, splatter, damaged galvanizing material, and all other welding by-products from the surface of the railing posts and embedded plates.
      - Prepare surface of steel per SSPC-SP1.
      - Rust scale shall be cleaned per SSPC-SP3.
      - Apply (2) coats of cold applied, galvanizing compound containing 95% metallic zinc content by weight in dry film and 52% solids content by volume.
      - The coating shall be well stirred before use so that it is completely homogeneous during application.
      - Minimum dry film build is 3 mils, using manufacturer's recoat time directions.
      - The coating shall be applied at sufficient wet film thickness to achieve a minimum dry film.
      - Apply paint system according to paint schedule Sht. S0.2.

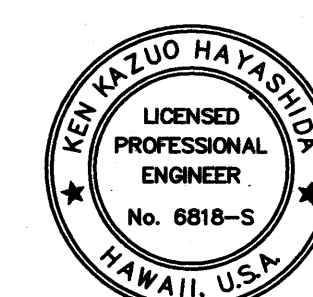

STATE OF HAWAII  
DEPARTMENT OF TRANSPORTATION  
HIGHWAYS DIVISION

**BRIDGE RAILING DETAILS**


KAMEHAMEHA V HIGHWAY  
Kawela Bridge Replacement  
Federal Aid Project No. BR-0450(8)

Scale: AS NOTED Date: June, 2010

SHEET No. S4.1 OF 93 SHEETS




FED. ROAD DIST. NO.	STATE	FED. AID PROJ. NO.	FISCAL YEAR	SHEET NO.	TOTAL SHEETS
HAWAII	HAW.	BR-0450(8)	2011	78	93

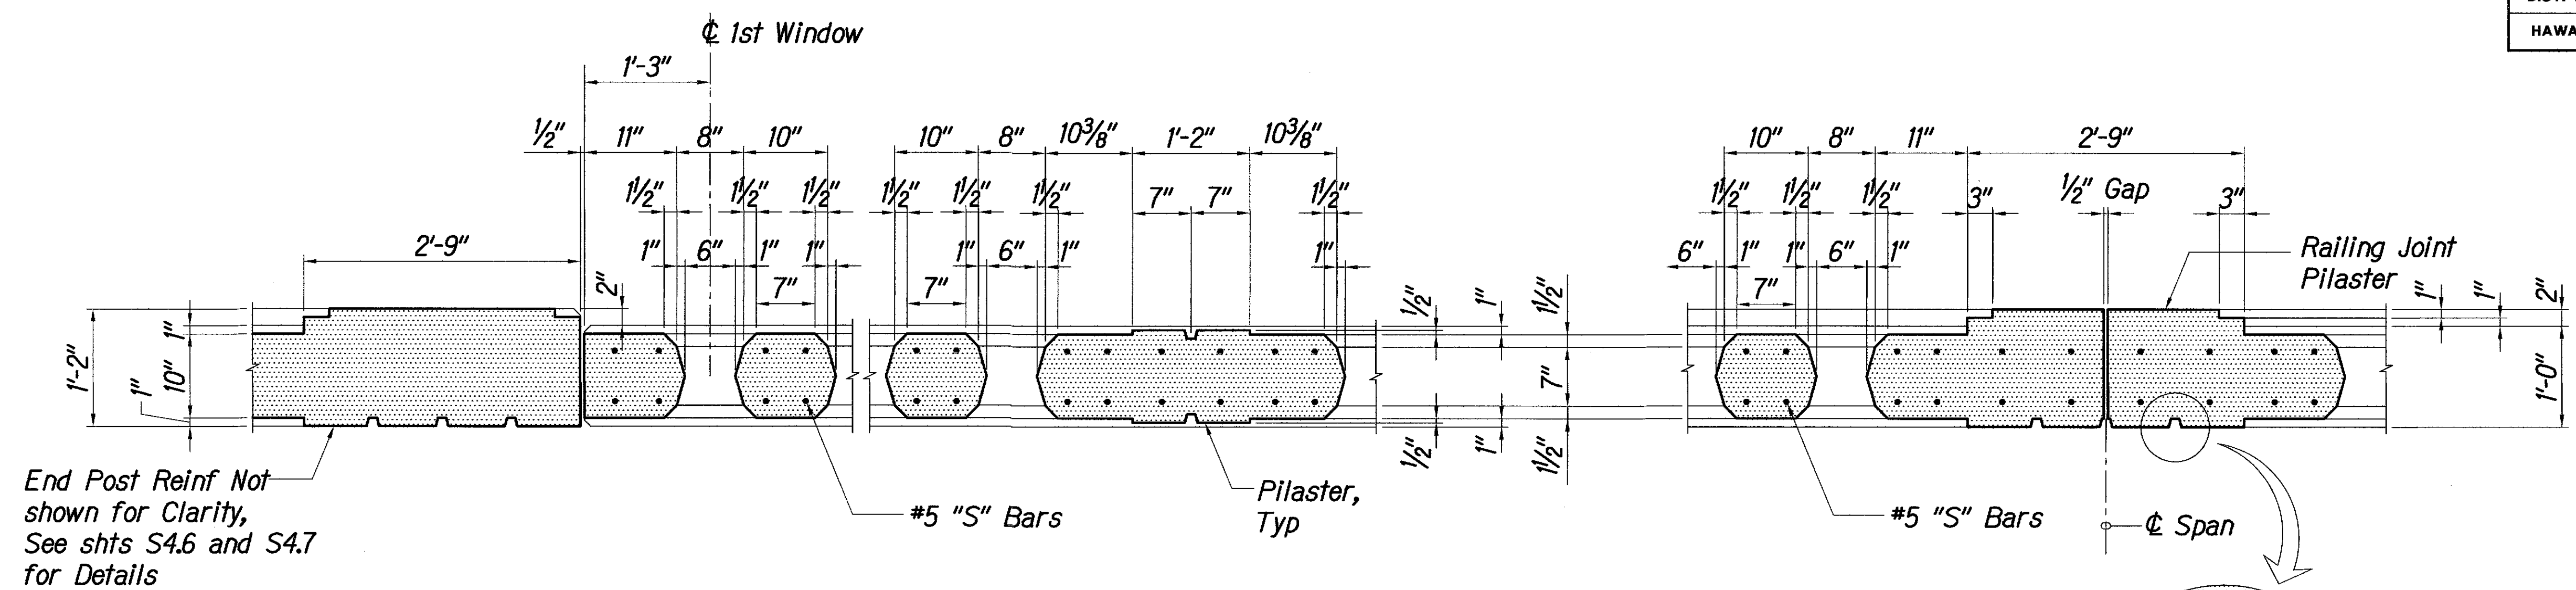


PLAN SECTION 1  
Scale: 1" = 1'-0"  
S4.2 S4.2

Note:  
Typical for Bridge  
Railing and End Post

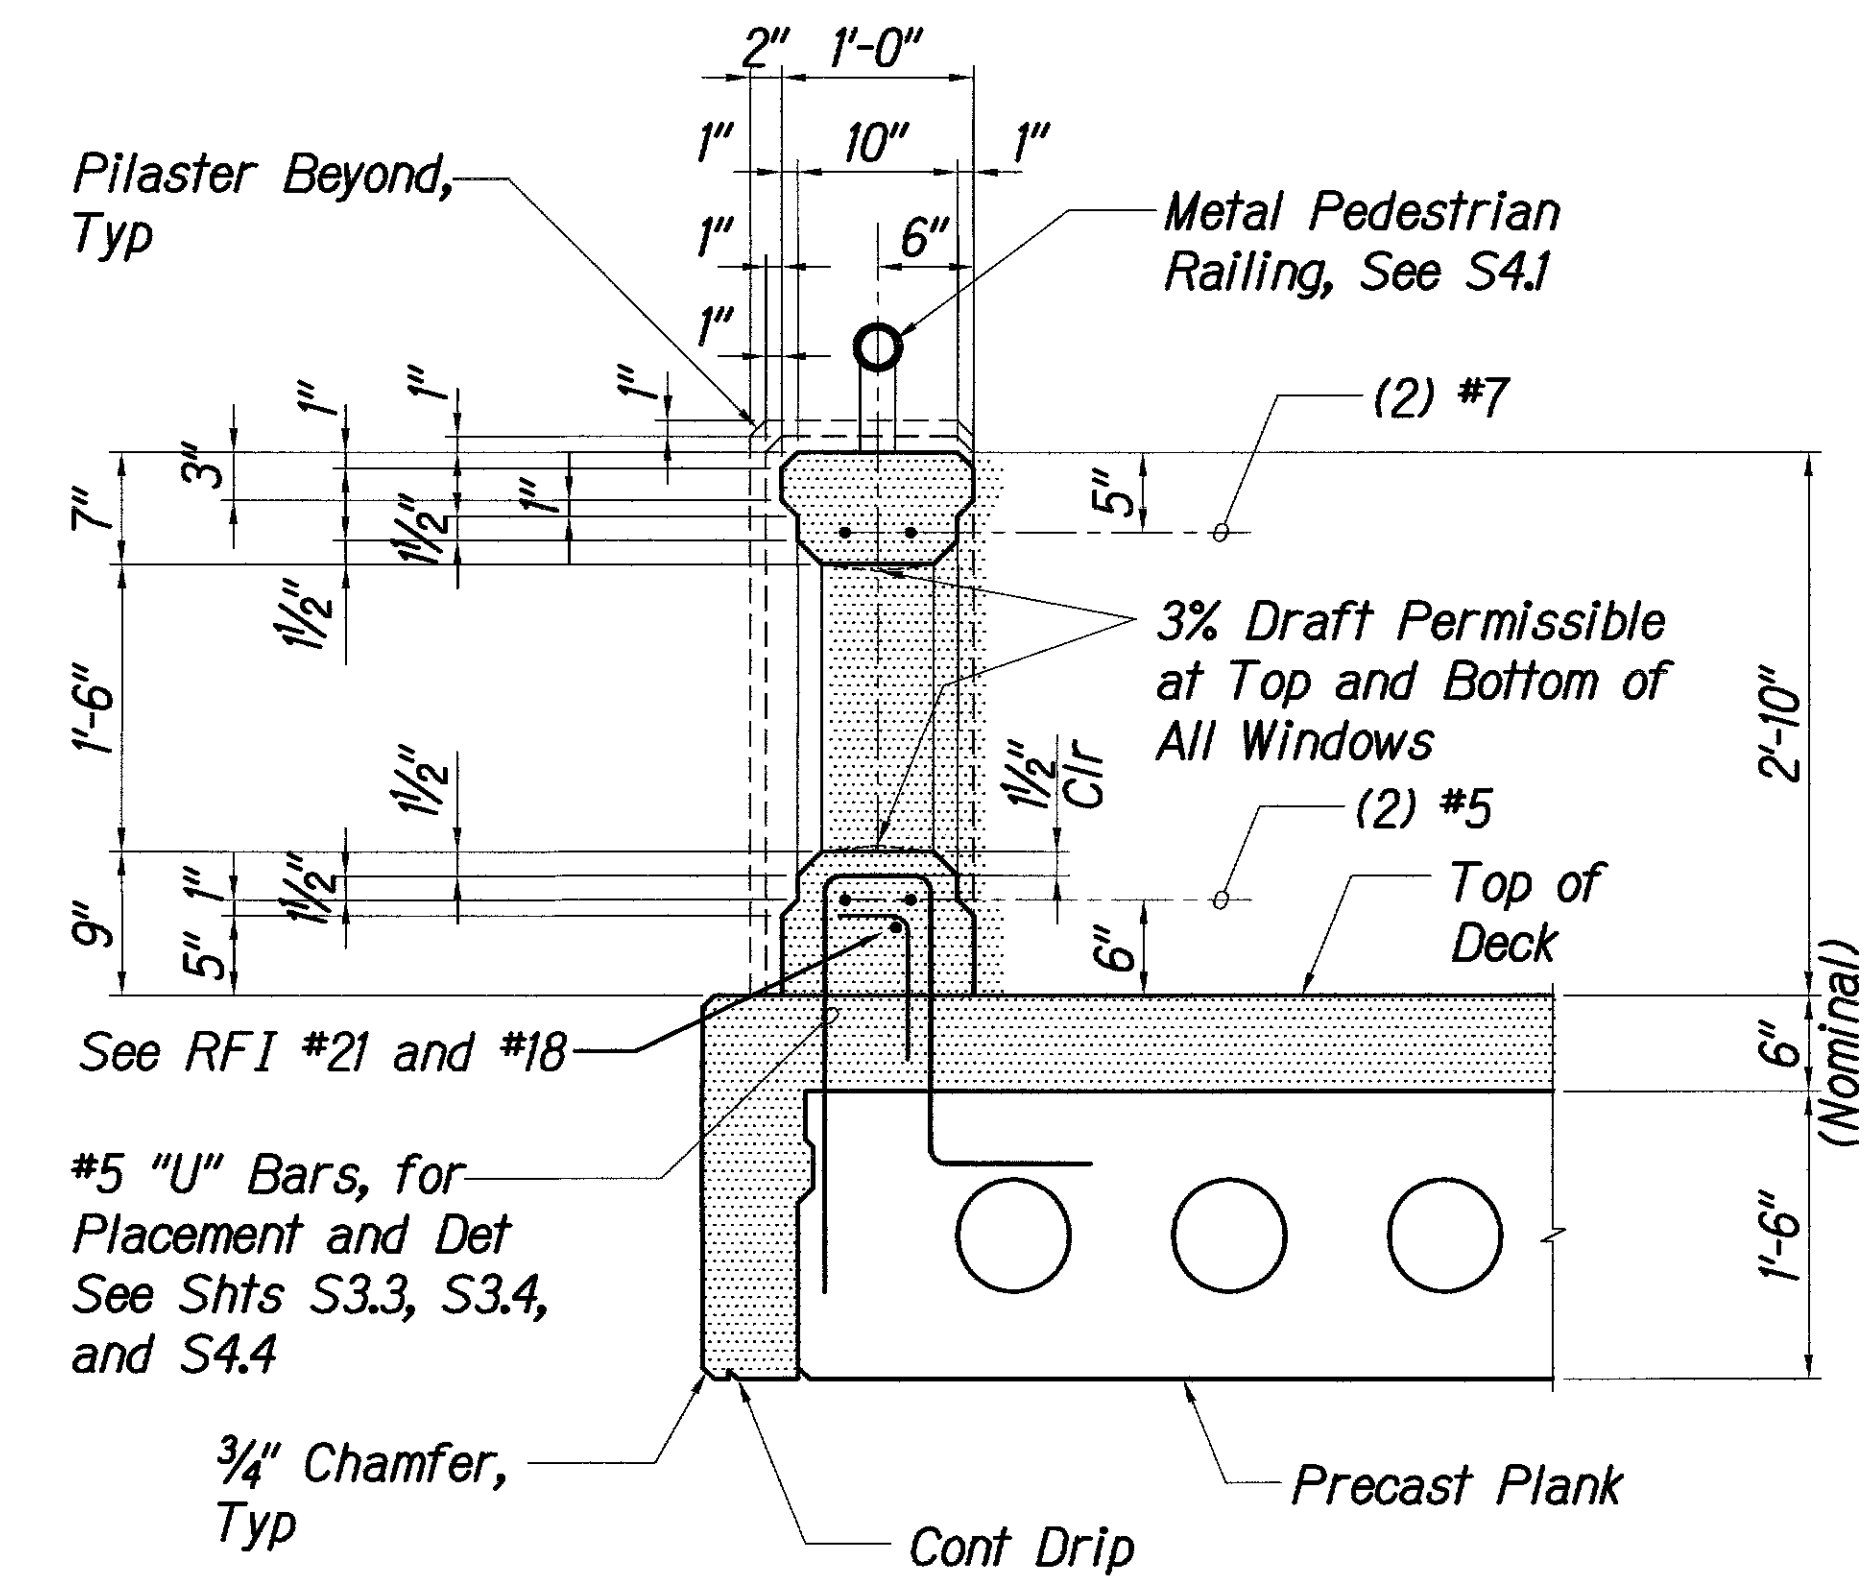


Note:  
Concrete Topping and Precast Plank's  
reinforcing not shown for Clarity.

SECTION THRU WINDOW 2  
Scale: 1" = 1'-0"  
S4.1, S4.4 S4.2

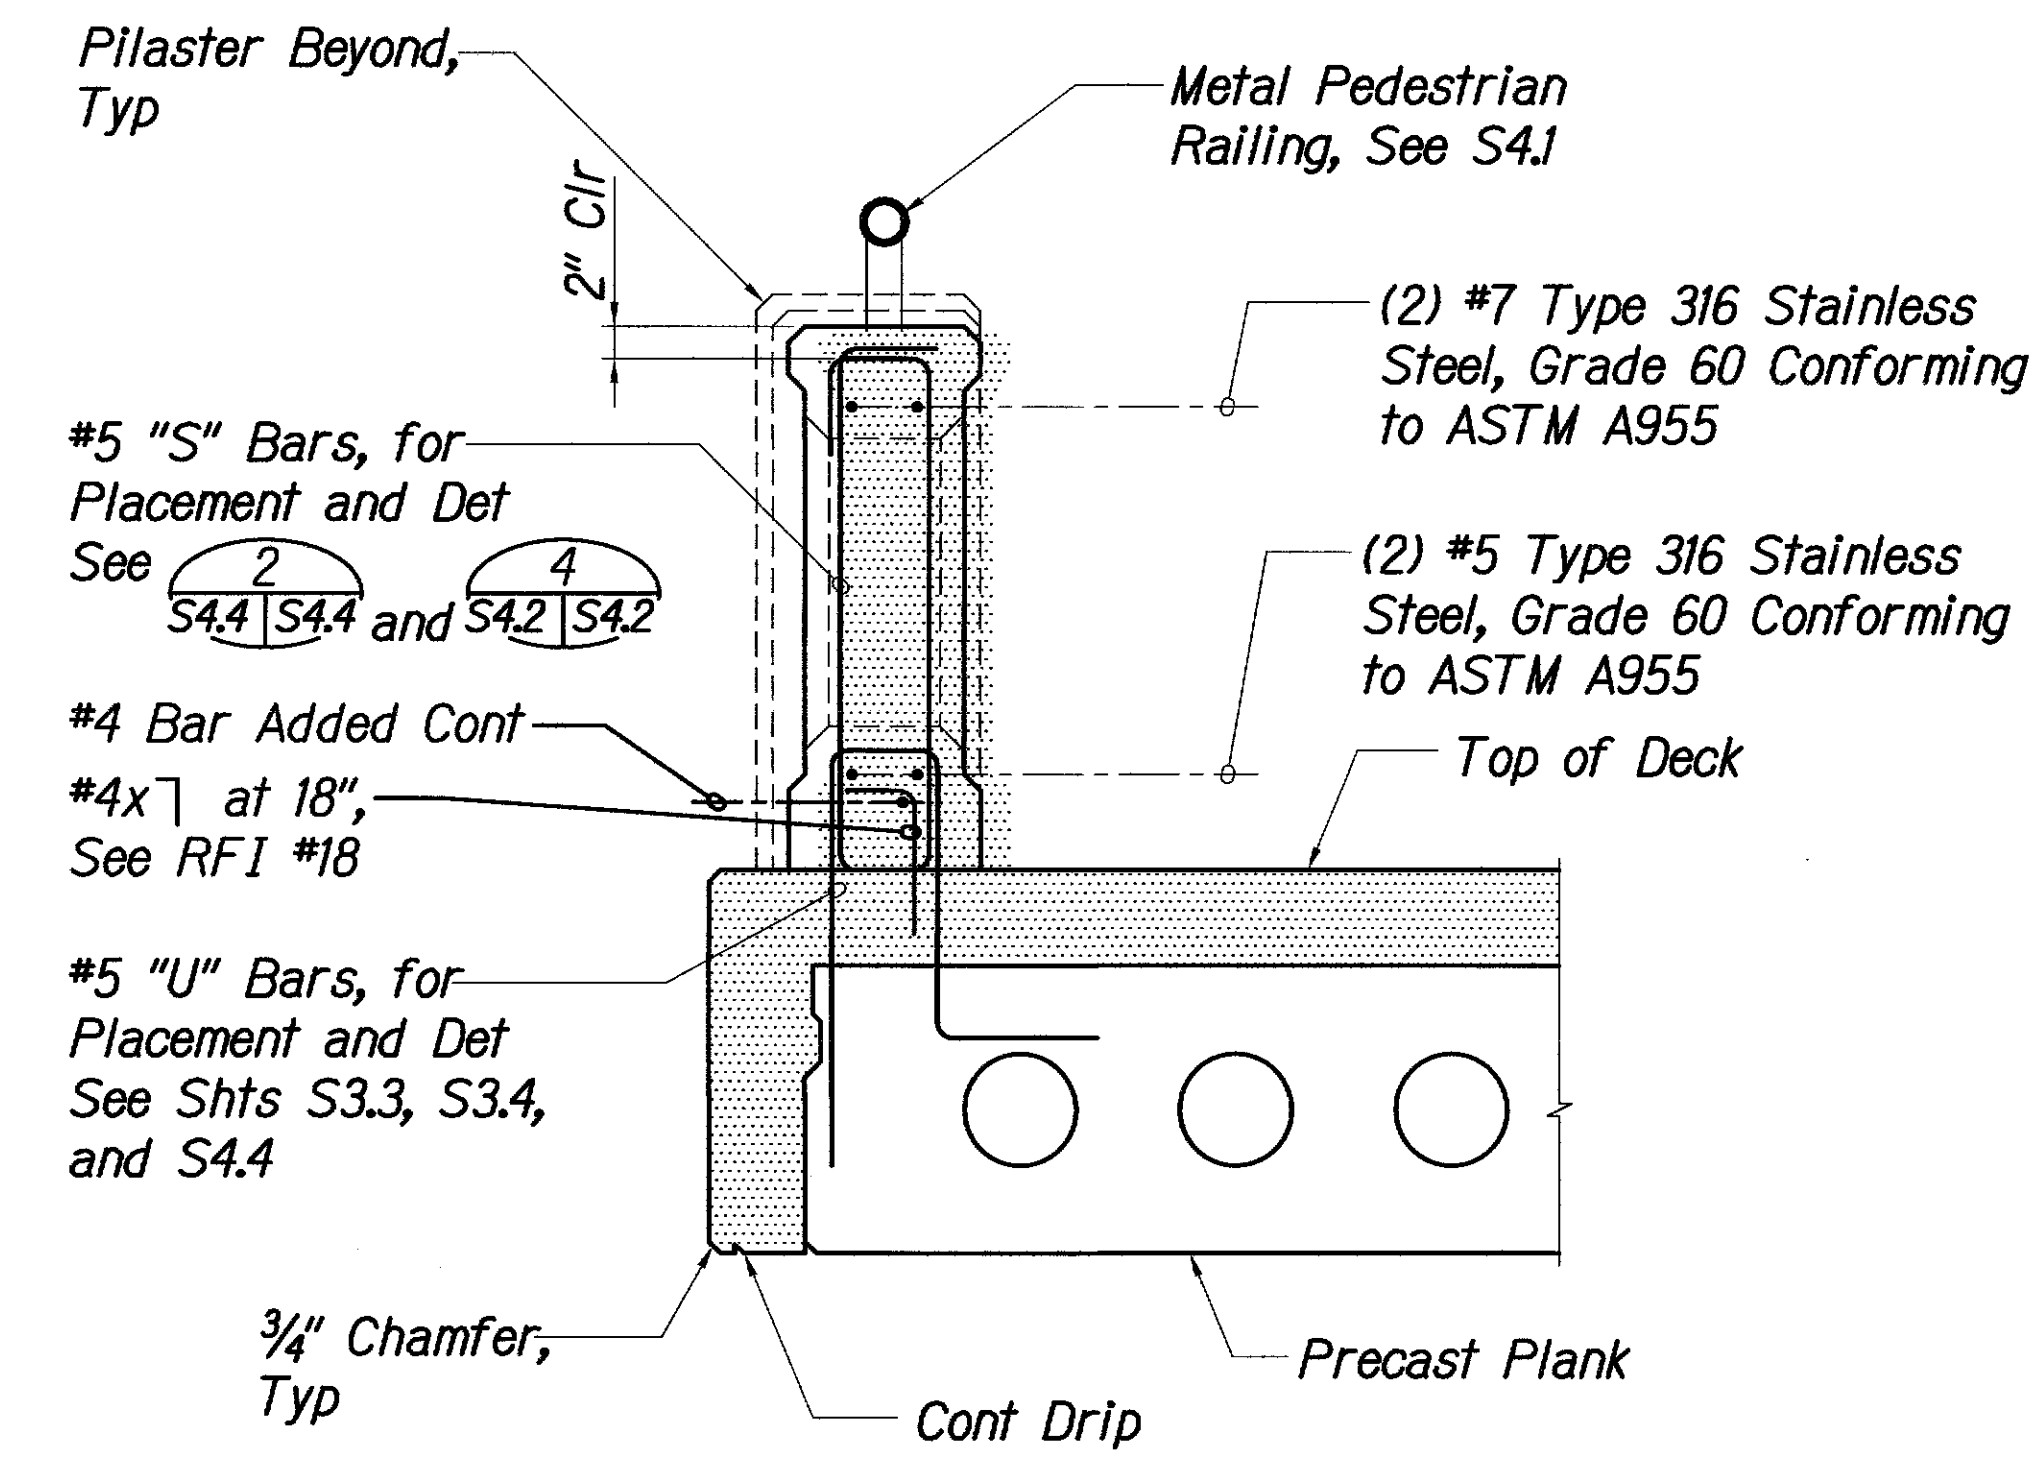

Note:  
For Balance of Information, See 4  
S4.1, S4.4 S4.2


SECTION THRU POST 3  
Scale: 1" = 1'-0"  
S4.1, S4.4 S4.2

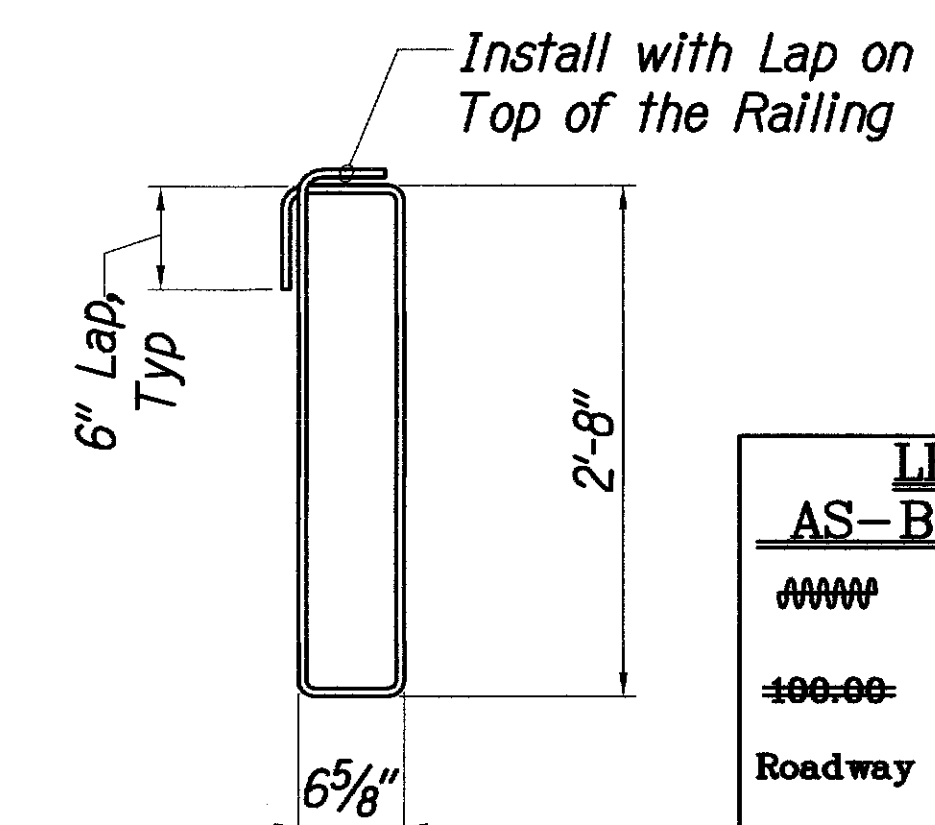

Note:  
"S" Bar shall be #5 Deformed Stainless Steel Bars,  
Type 316, Grade 60 Conforming to ASTM A955.

"S" BAR (#5) DETAIL 4  
Not to Scale  
S4.2 S4.2

LEGEND FOR AS-BUILT POSTINGS	
~~~~~	Squiggly line for as-built deletion
==	Double line for as-built deletion
Roadway	Text for as-built posting

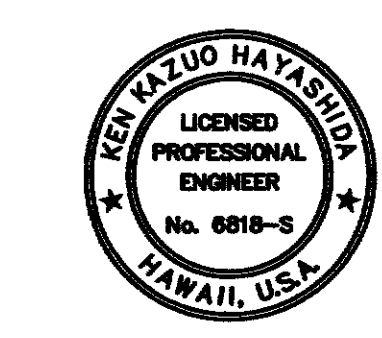


STATE OF HAWAII  
DEPARTMENT OF TRANSPORTATION  
HIGHWAYS DIVISION

**BRIDGE RAILING DETAILS,  
OPTION 1: CAST-IN-PLACE  
KAMEHAMEHA V HIGHWAY  
Kawela Bridge Replacement  
Federal Aid Project No. BR-0450(8)**


Scale: AS NOTED Date: June, 2010

SHEET No. S4.2 OF 93 SHEETS


FED. ROAD DIST. NO.	STATE	FED. AID PROJ. NO.	FISCAL YEAR	SHEET NO.	TOTAL SHEETS
HAWAII	HAW.	BR-0450(8)	2011	79	93

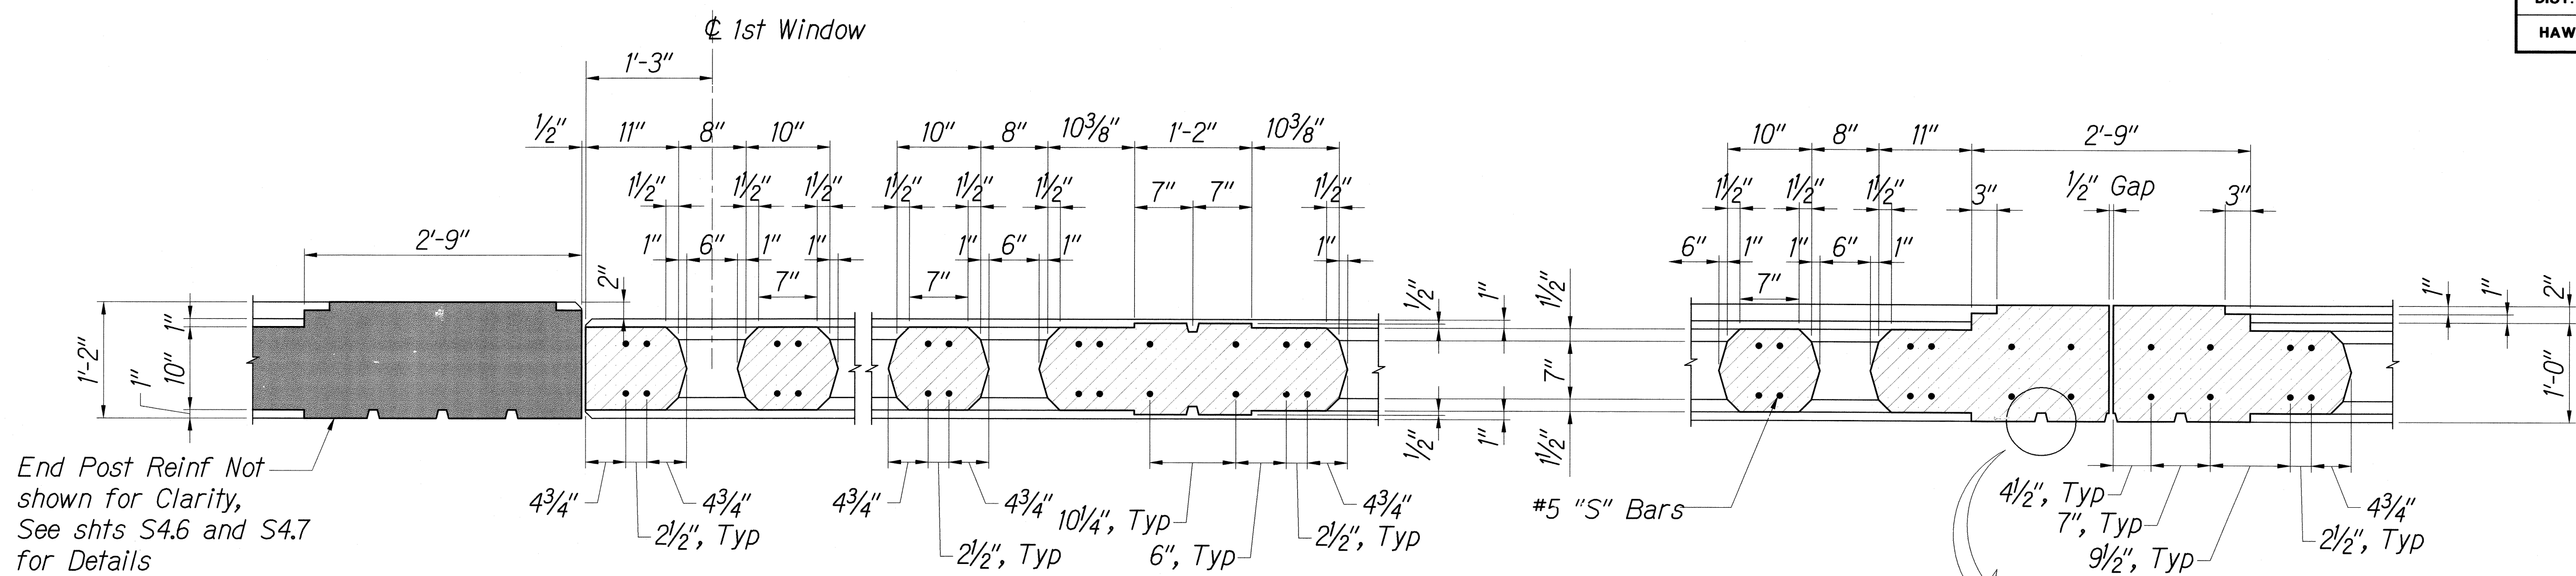

**PLAN SECTION 1**  
Scale: 1" = 1'-0"  
S4.3 | S4.3

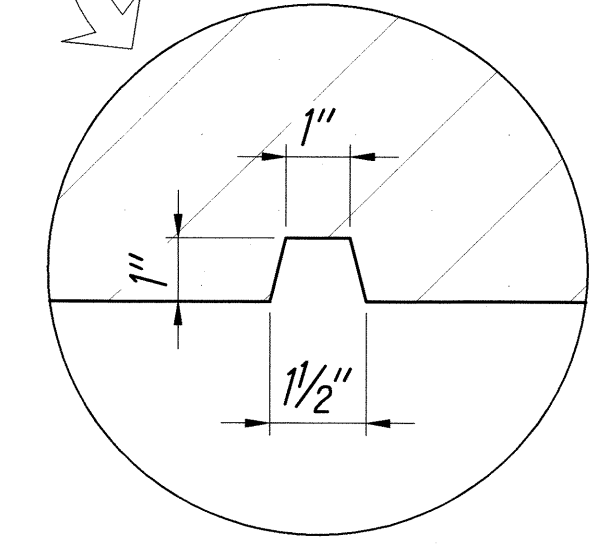


**Note:**  
Typical for Bridge Railing and End Post

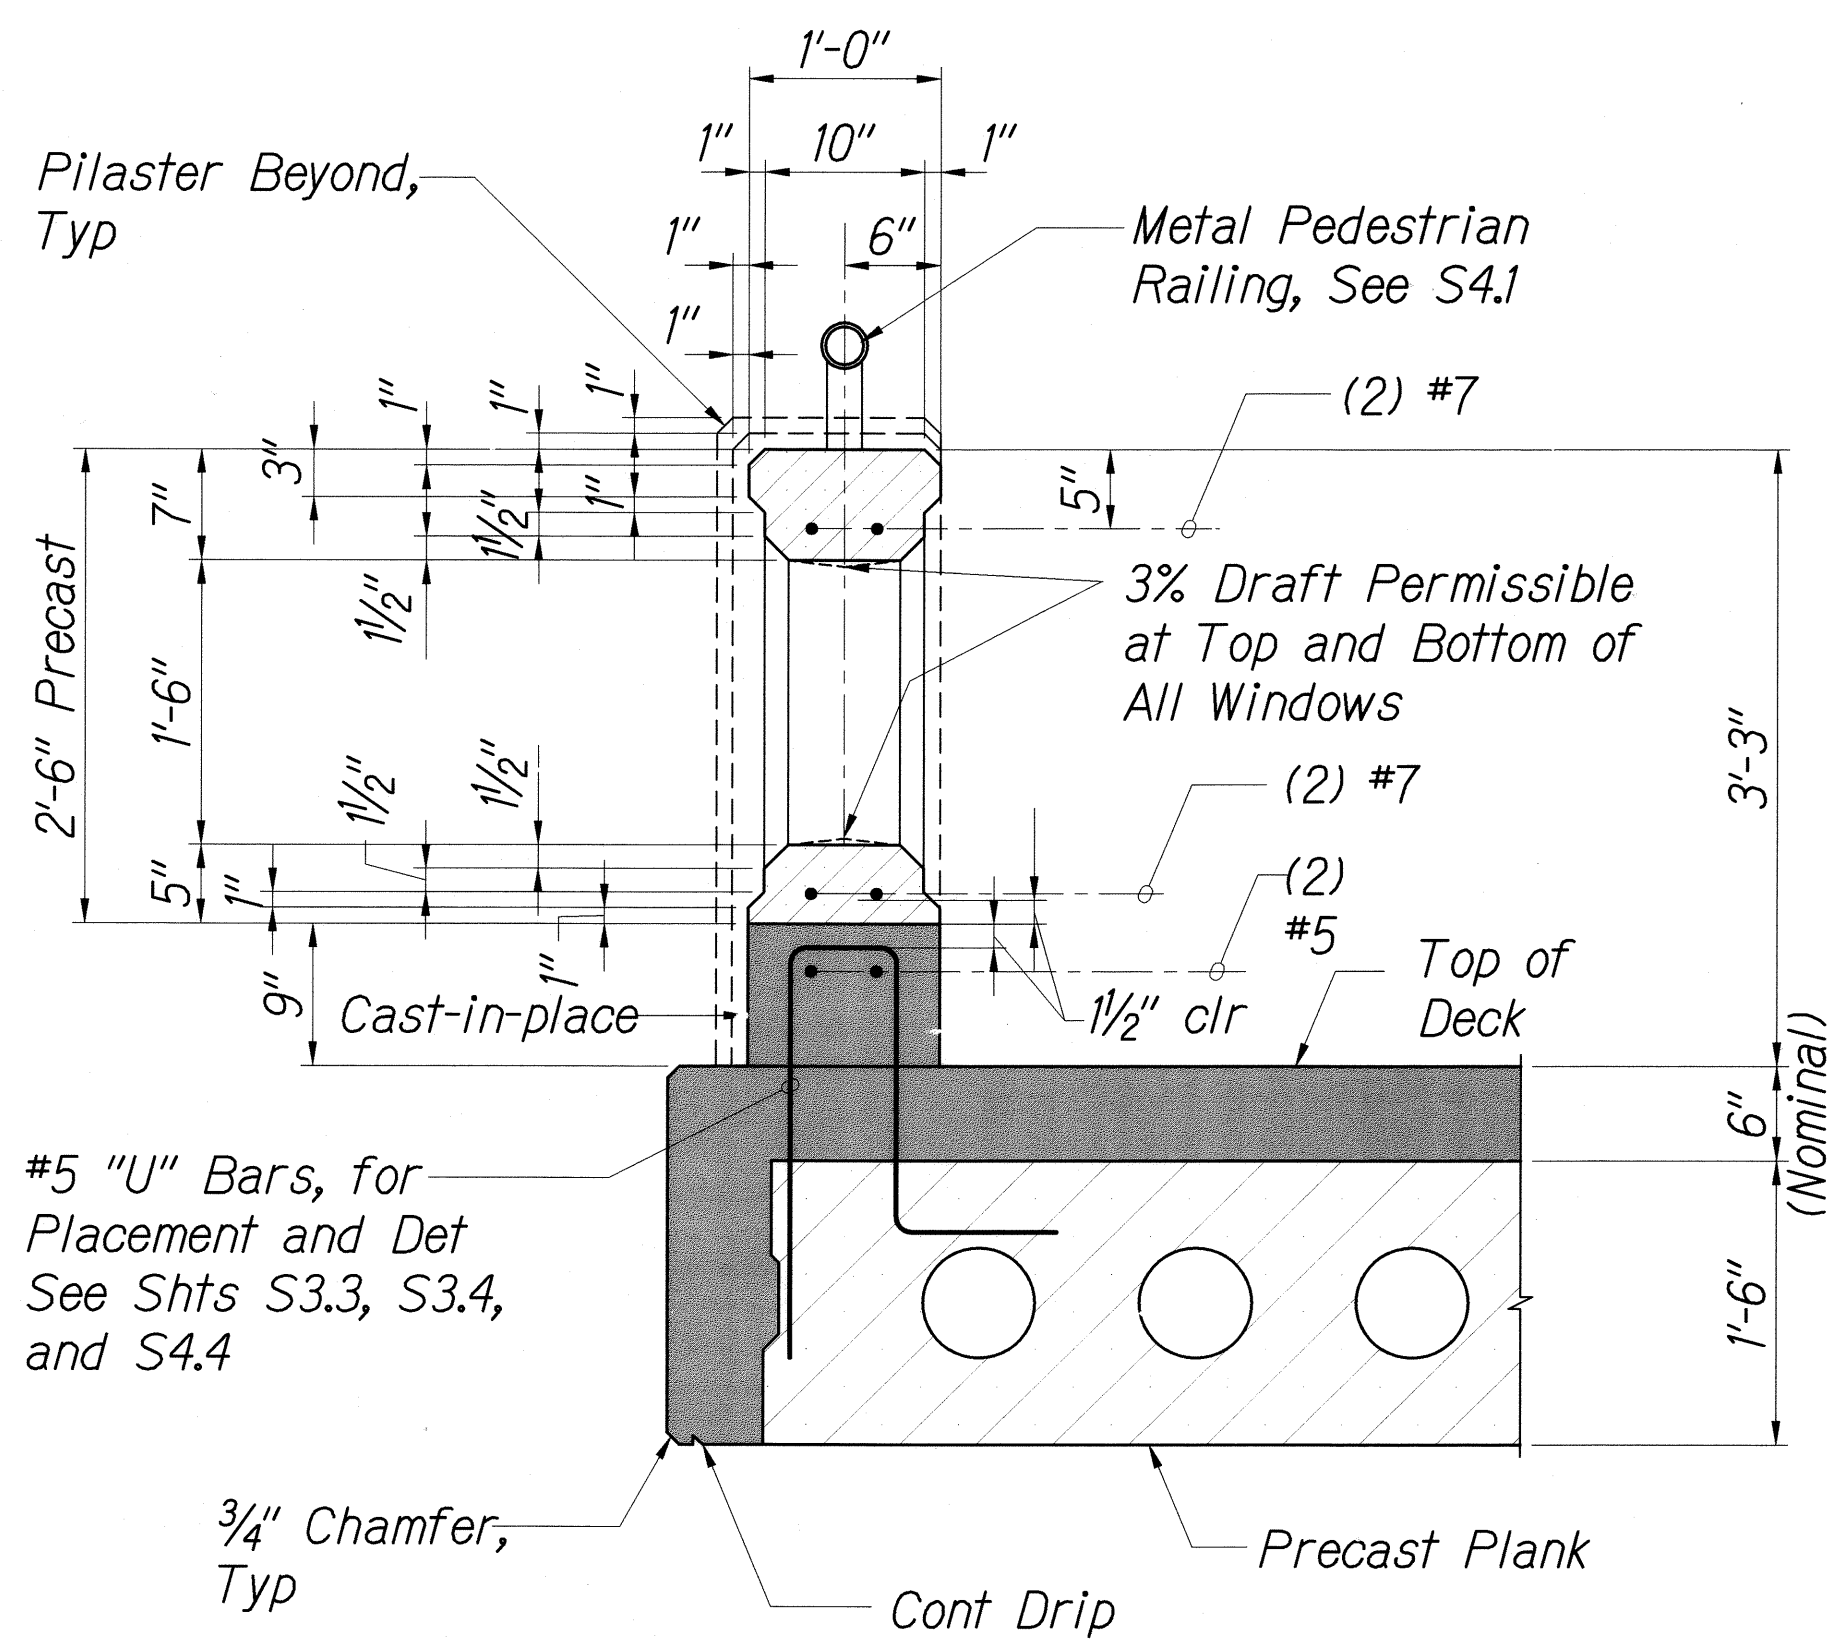


**Note:**  
Concrete Topping and Precast Plank's reinforcing not shown for Clarity.

**SECTION THRU WINDOW 2**  
Scale: 1" = 1'-0"  
S4.1, S4.4 | S4.3

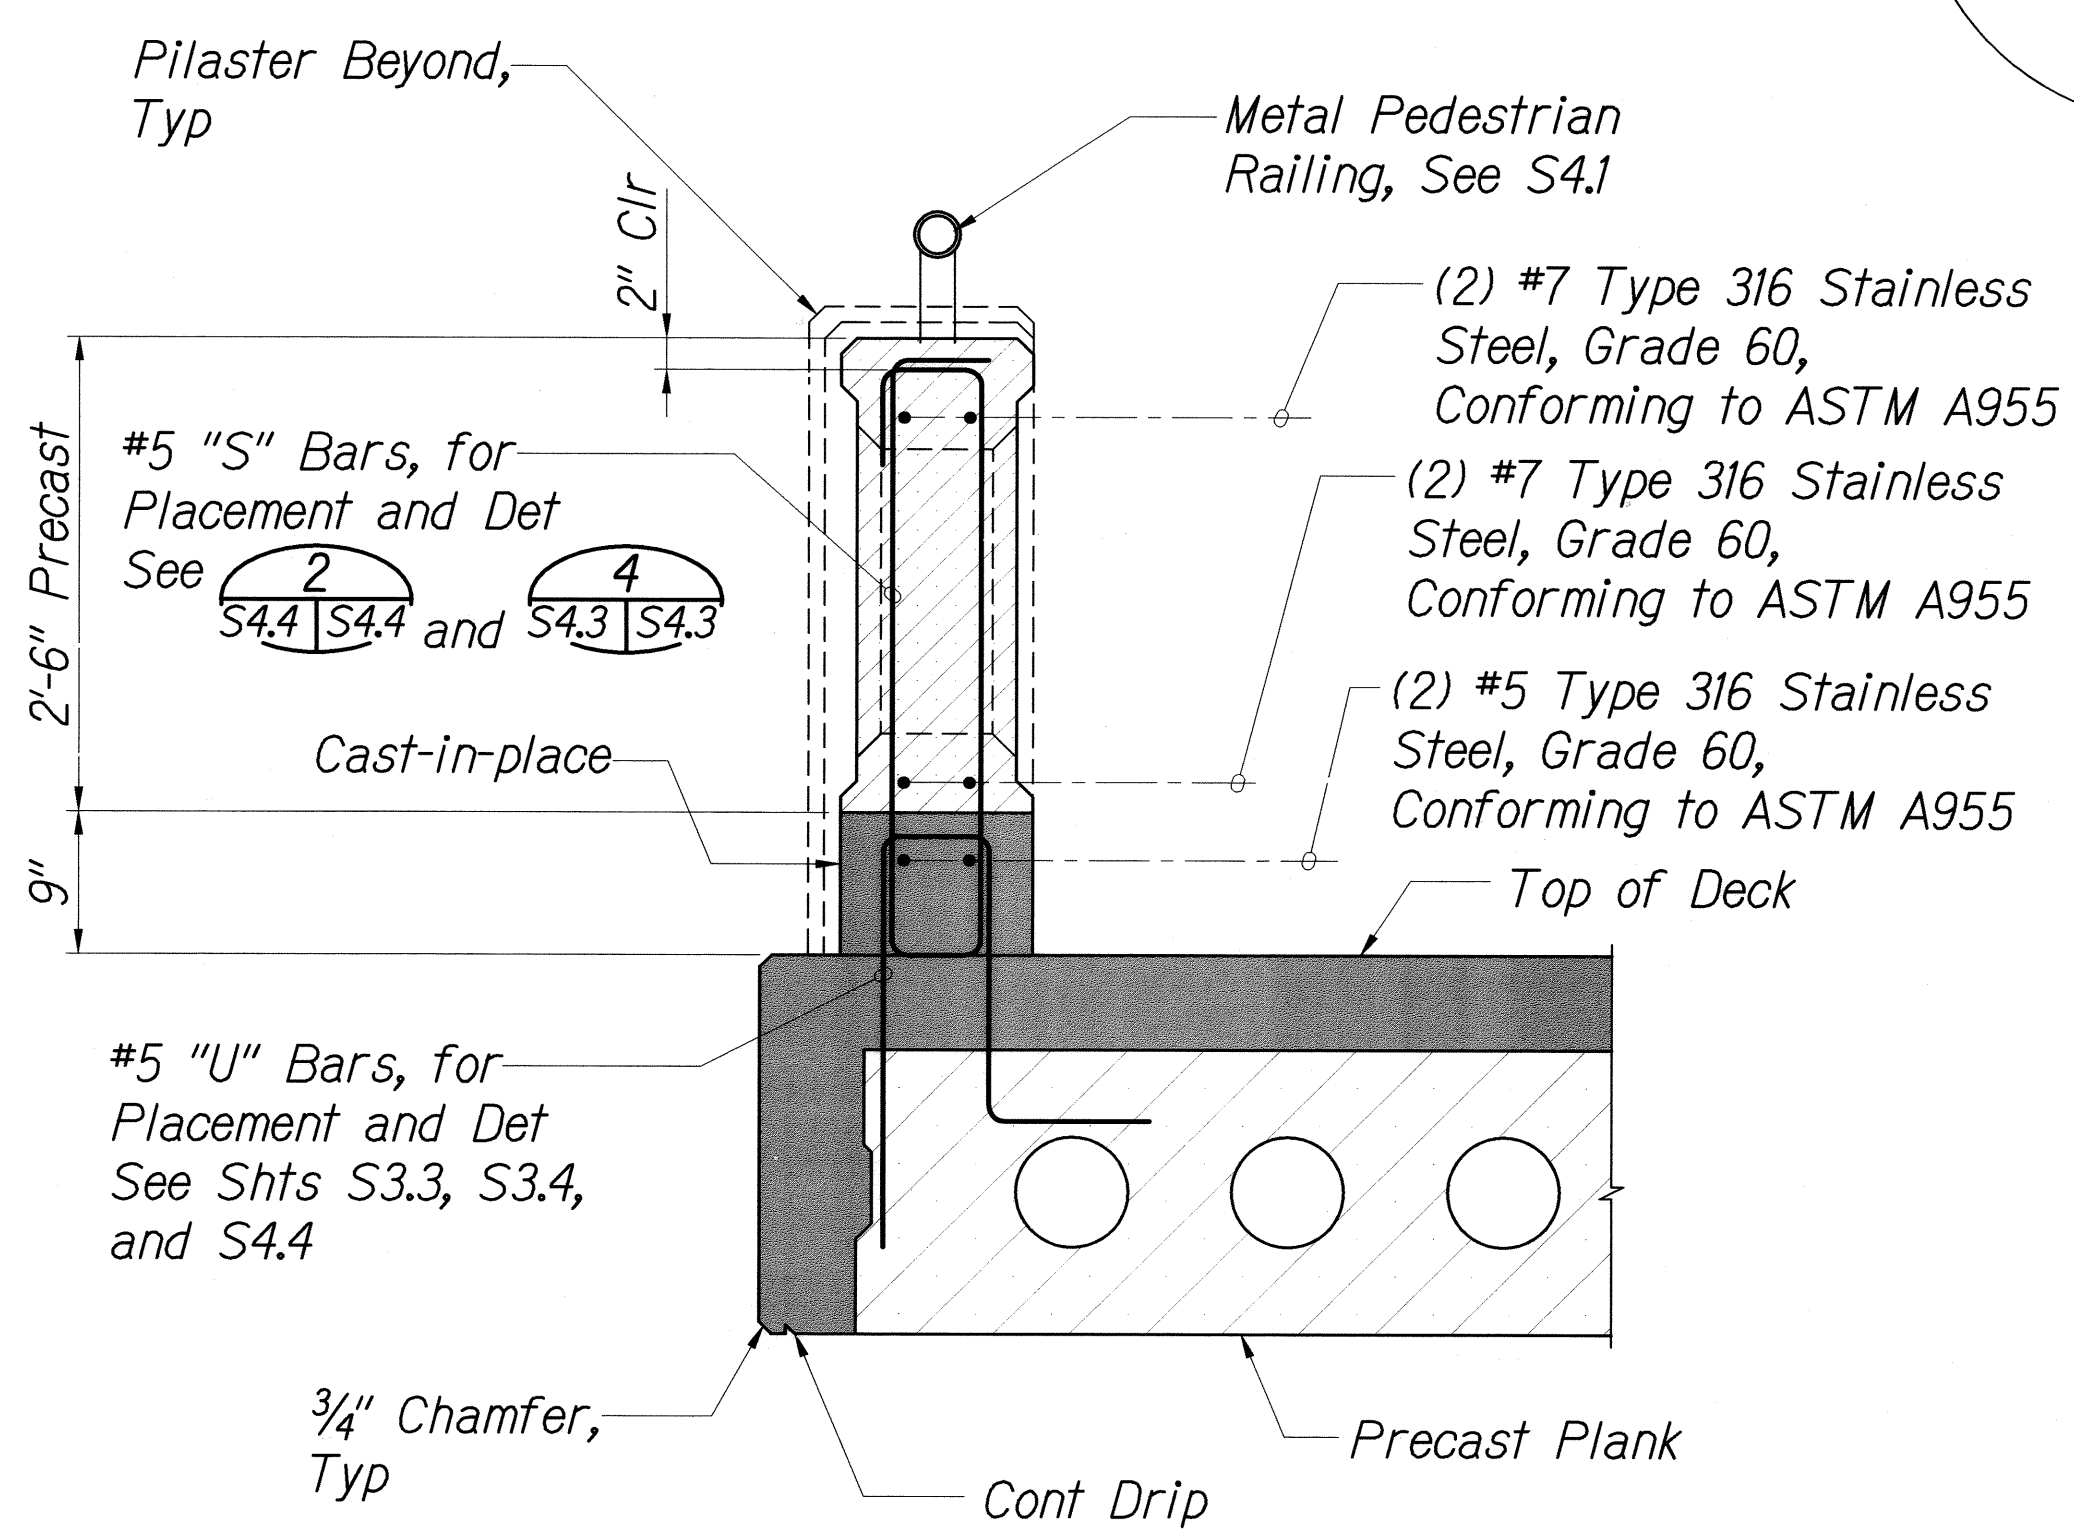


**Note:**  
For Balance of Information, See S4.1, S4.4 | S4.3

**SECTION THRU POST 3**  
Scale: 1" = 1'-0"  
S4.1, S4.4 | S4.3

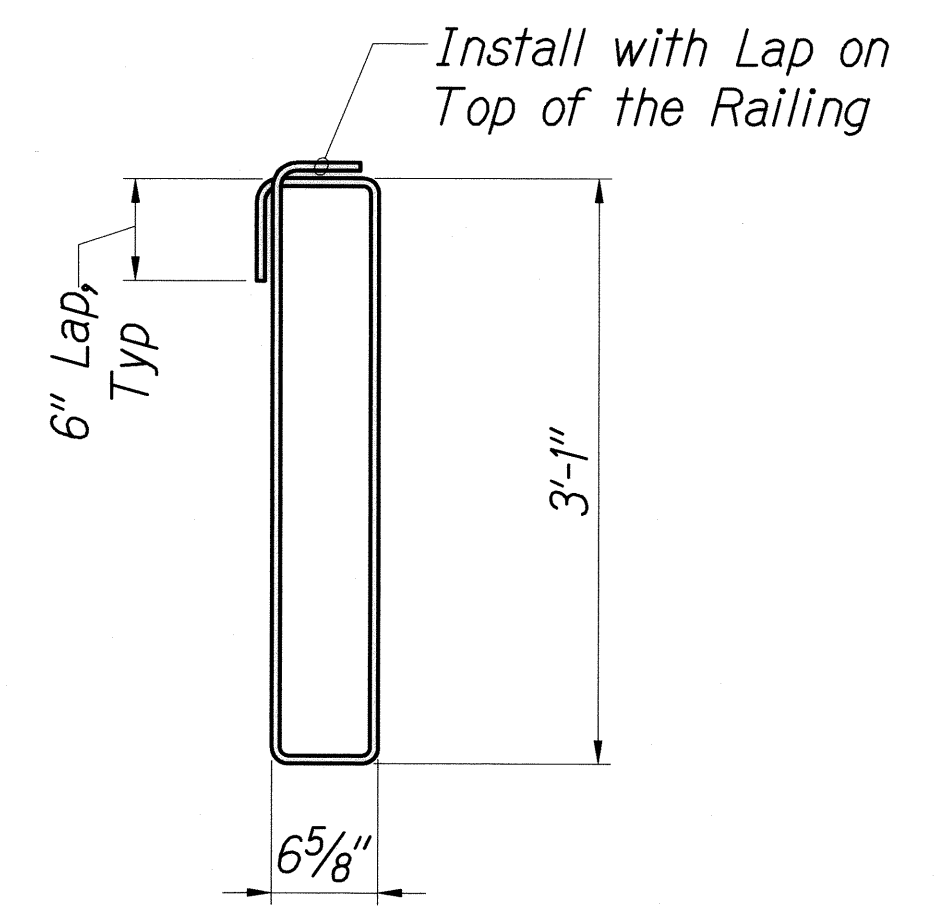

**Note:**  
"S" Bar shall be #5 Deformed Stainless Steel Bars, Type 316, Grade 60 Conforming to ASTM A955.

**"S" BAR (#5) DETAIL 4**  
Not to Scale  
S4.3 | S4.3

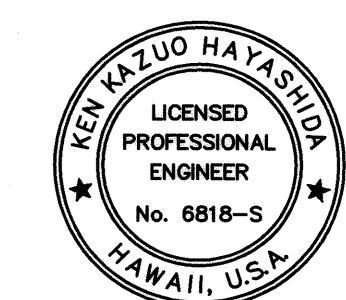

EXPIRATION DATE OF THE LICENSE 4/30/2012  
THIS WORK WAS PREPARED BY ME OR UNDER MY SUPERVISION

STATE OF HAWAII  
DEPARTMENT OF TRANSPORTATION  
HIGHWAYS DIVISION

**BRIDGE RAILING DETAILS,  
OPTION 2: PRECAST**


KAMEHAMEHA V HIGHWAY  
Kawela Bridge Replacement  
Federal Aid Project No. BR-0450(8)

Scale: AS NOTED Date: June, 2010


SHEET No. S4.3 OF 93 SHEETS



FED. ROAD DIST. NO.	STATE	FED. AID PROJ. NO.	FISCAL YEAR	SHEET NO.	TOTAL SHEETS
HAWAII	HAW.	BR-0450(8)	2011	80	93

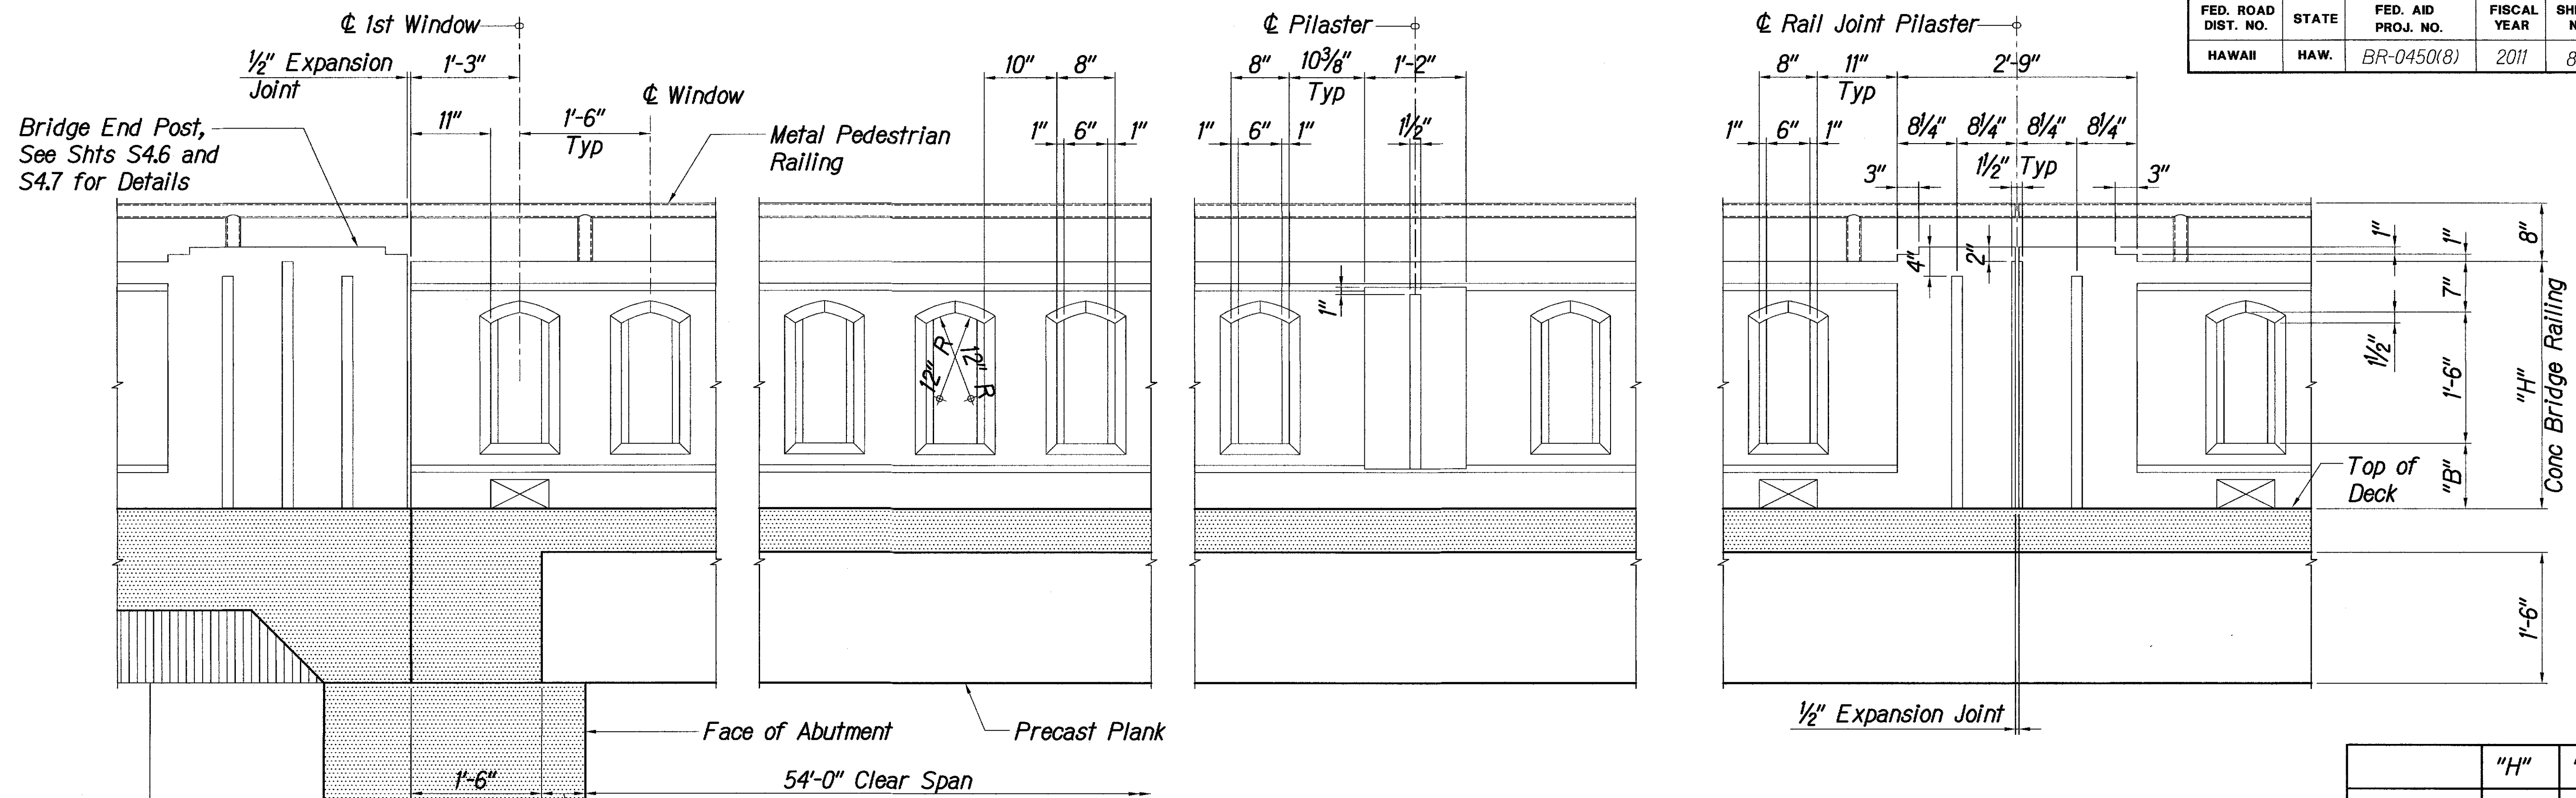

	"H"	"B"
OPTION 1	2'-10"	9"
OPTION 2	3'-3"	1'-2"

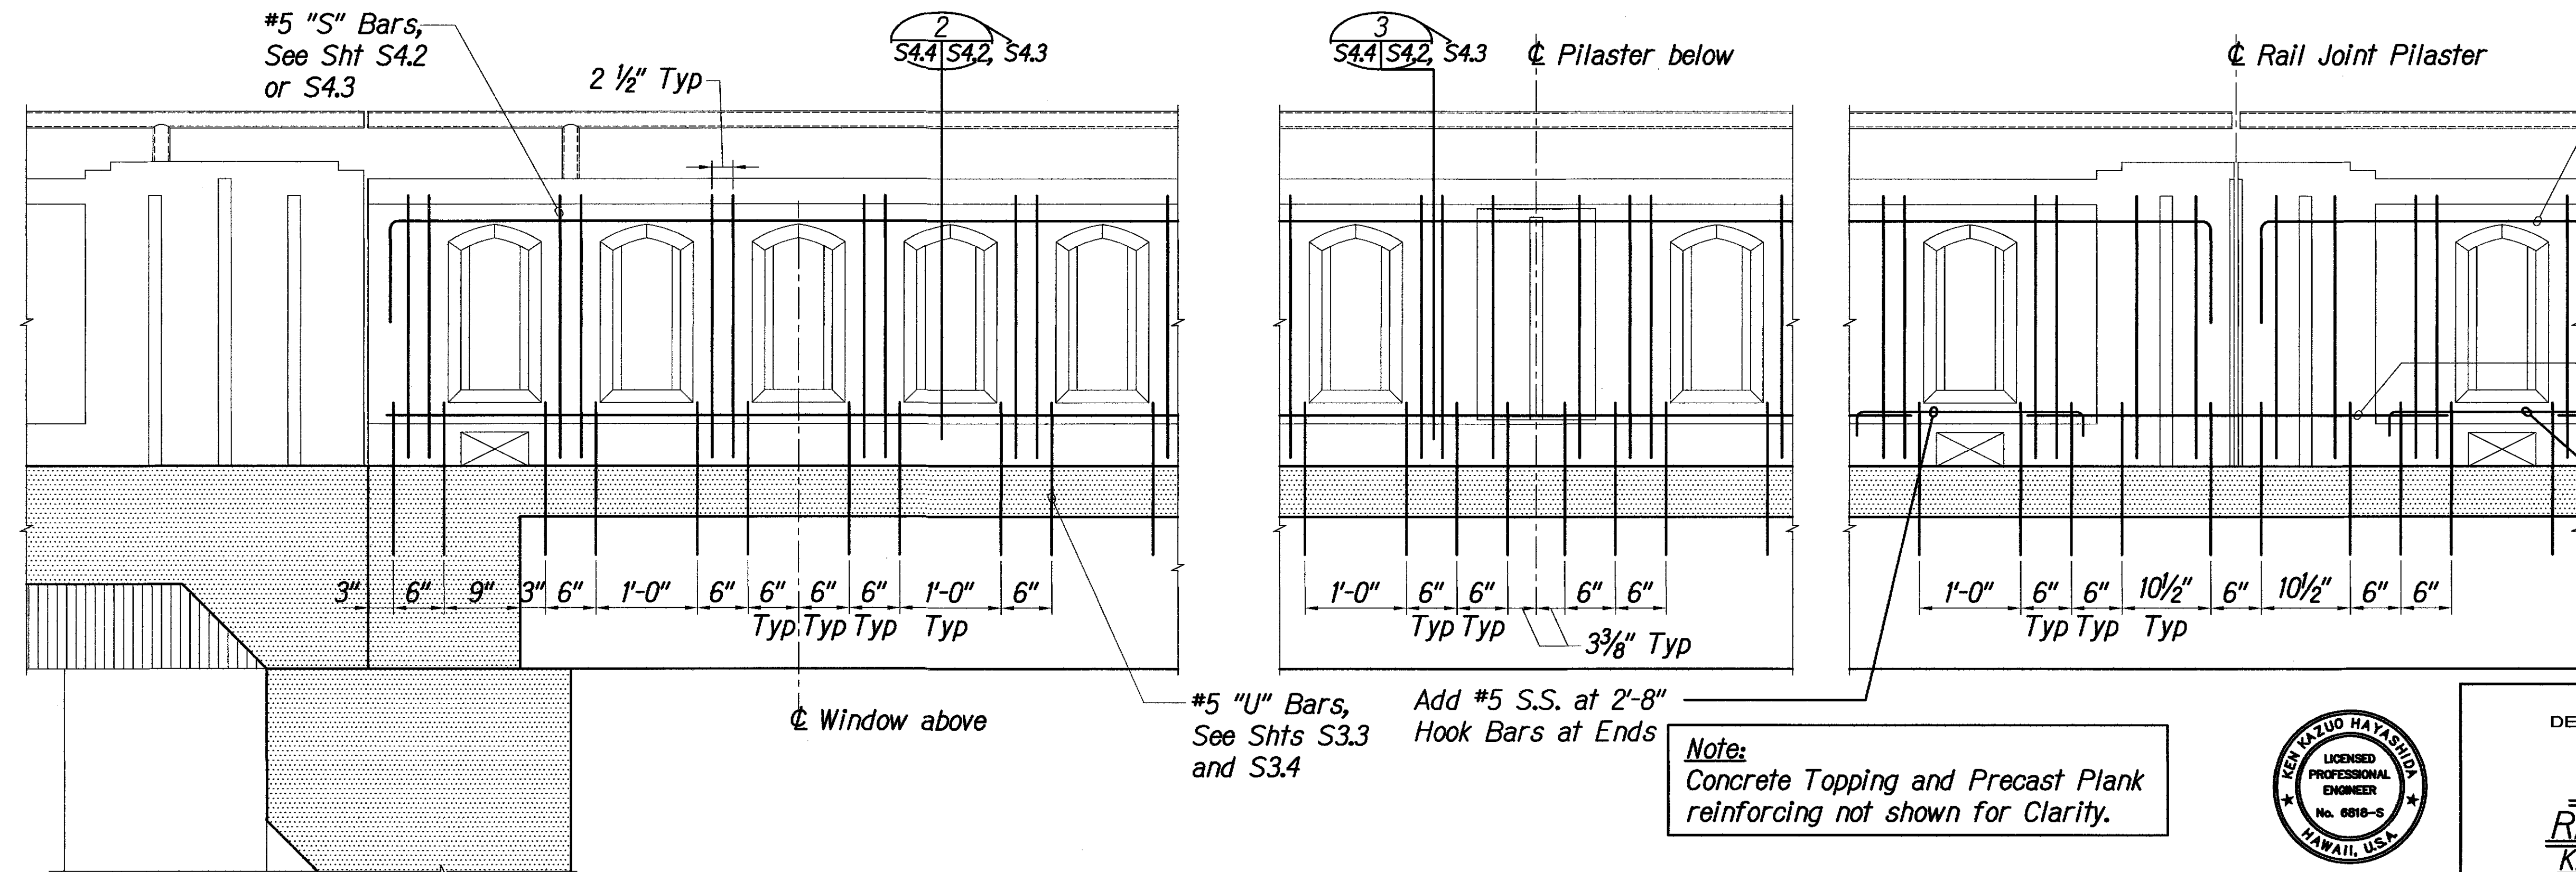


**LEGEND FOR AS-BUILT POSTINGS**

~~~~~~~~~ Squiggly line for as-built deletion

~~=====~~ Double line for as-built deletion

~~ROADWAY~~ Text for as-built posting

**Note:**  
Concrete Topping and Precast Plank reinforcing not shown for Clarity.

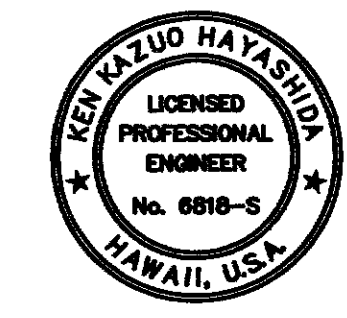

STATE OF HAWAII  
DEPARTMENT OF TRANSPORTATION  
HIGHWAYS DIVISION

**PARTIAL BRIDGE RAILING ELEVATION**  
**KAMEHAMEHA V HIGHWAY**  
**Kawela Bridge Replacement**  
**Federal Aid Project No. BR-0450(8)**

Scale: AS NOTED      Date: June, 2010


SHEET No. **S4.4** OF 93 SHEETS

2  
S4.4 S4.4


"AS-BUILT"

2016-09-13 1528-01 Kawela Bridge AS BUILT S1528 S-4-4.dwg, 9/13/2016 4:45:09 PM, tamahata


| FED. ROAD DIST. NO. | STATE | FED. AID PROJ. NO. | FISCAL YEAR | SHEET NO. | TOTAL SHEETS |
|---------------------|-------|--------------------|-------------|-----------|--------------|
| HAWAII              | HAW.  | BR-0450(8)         | 2011        | 81        | 93           |

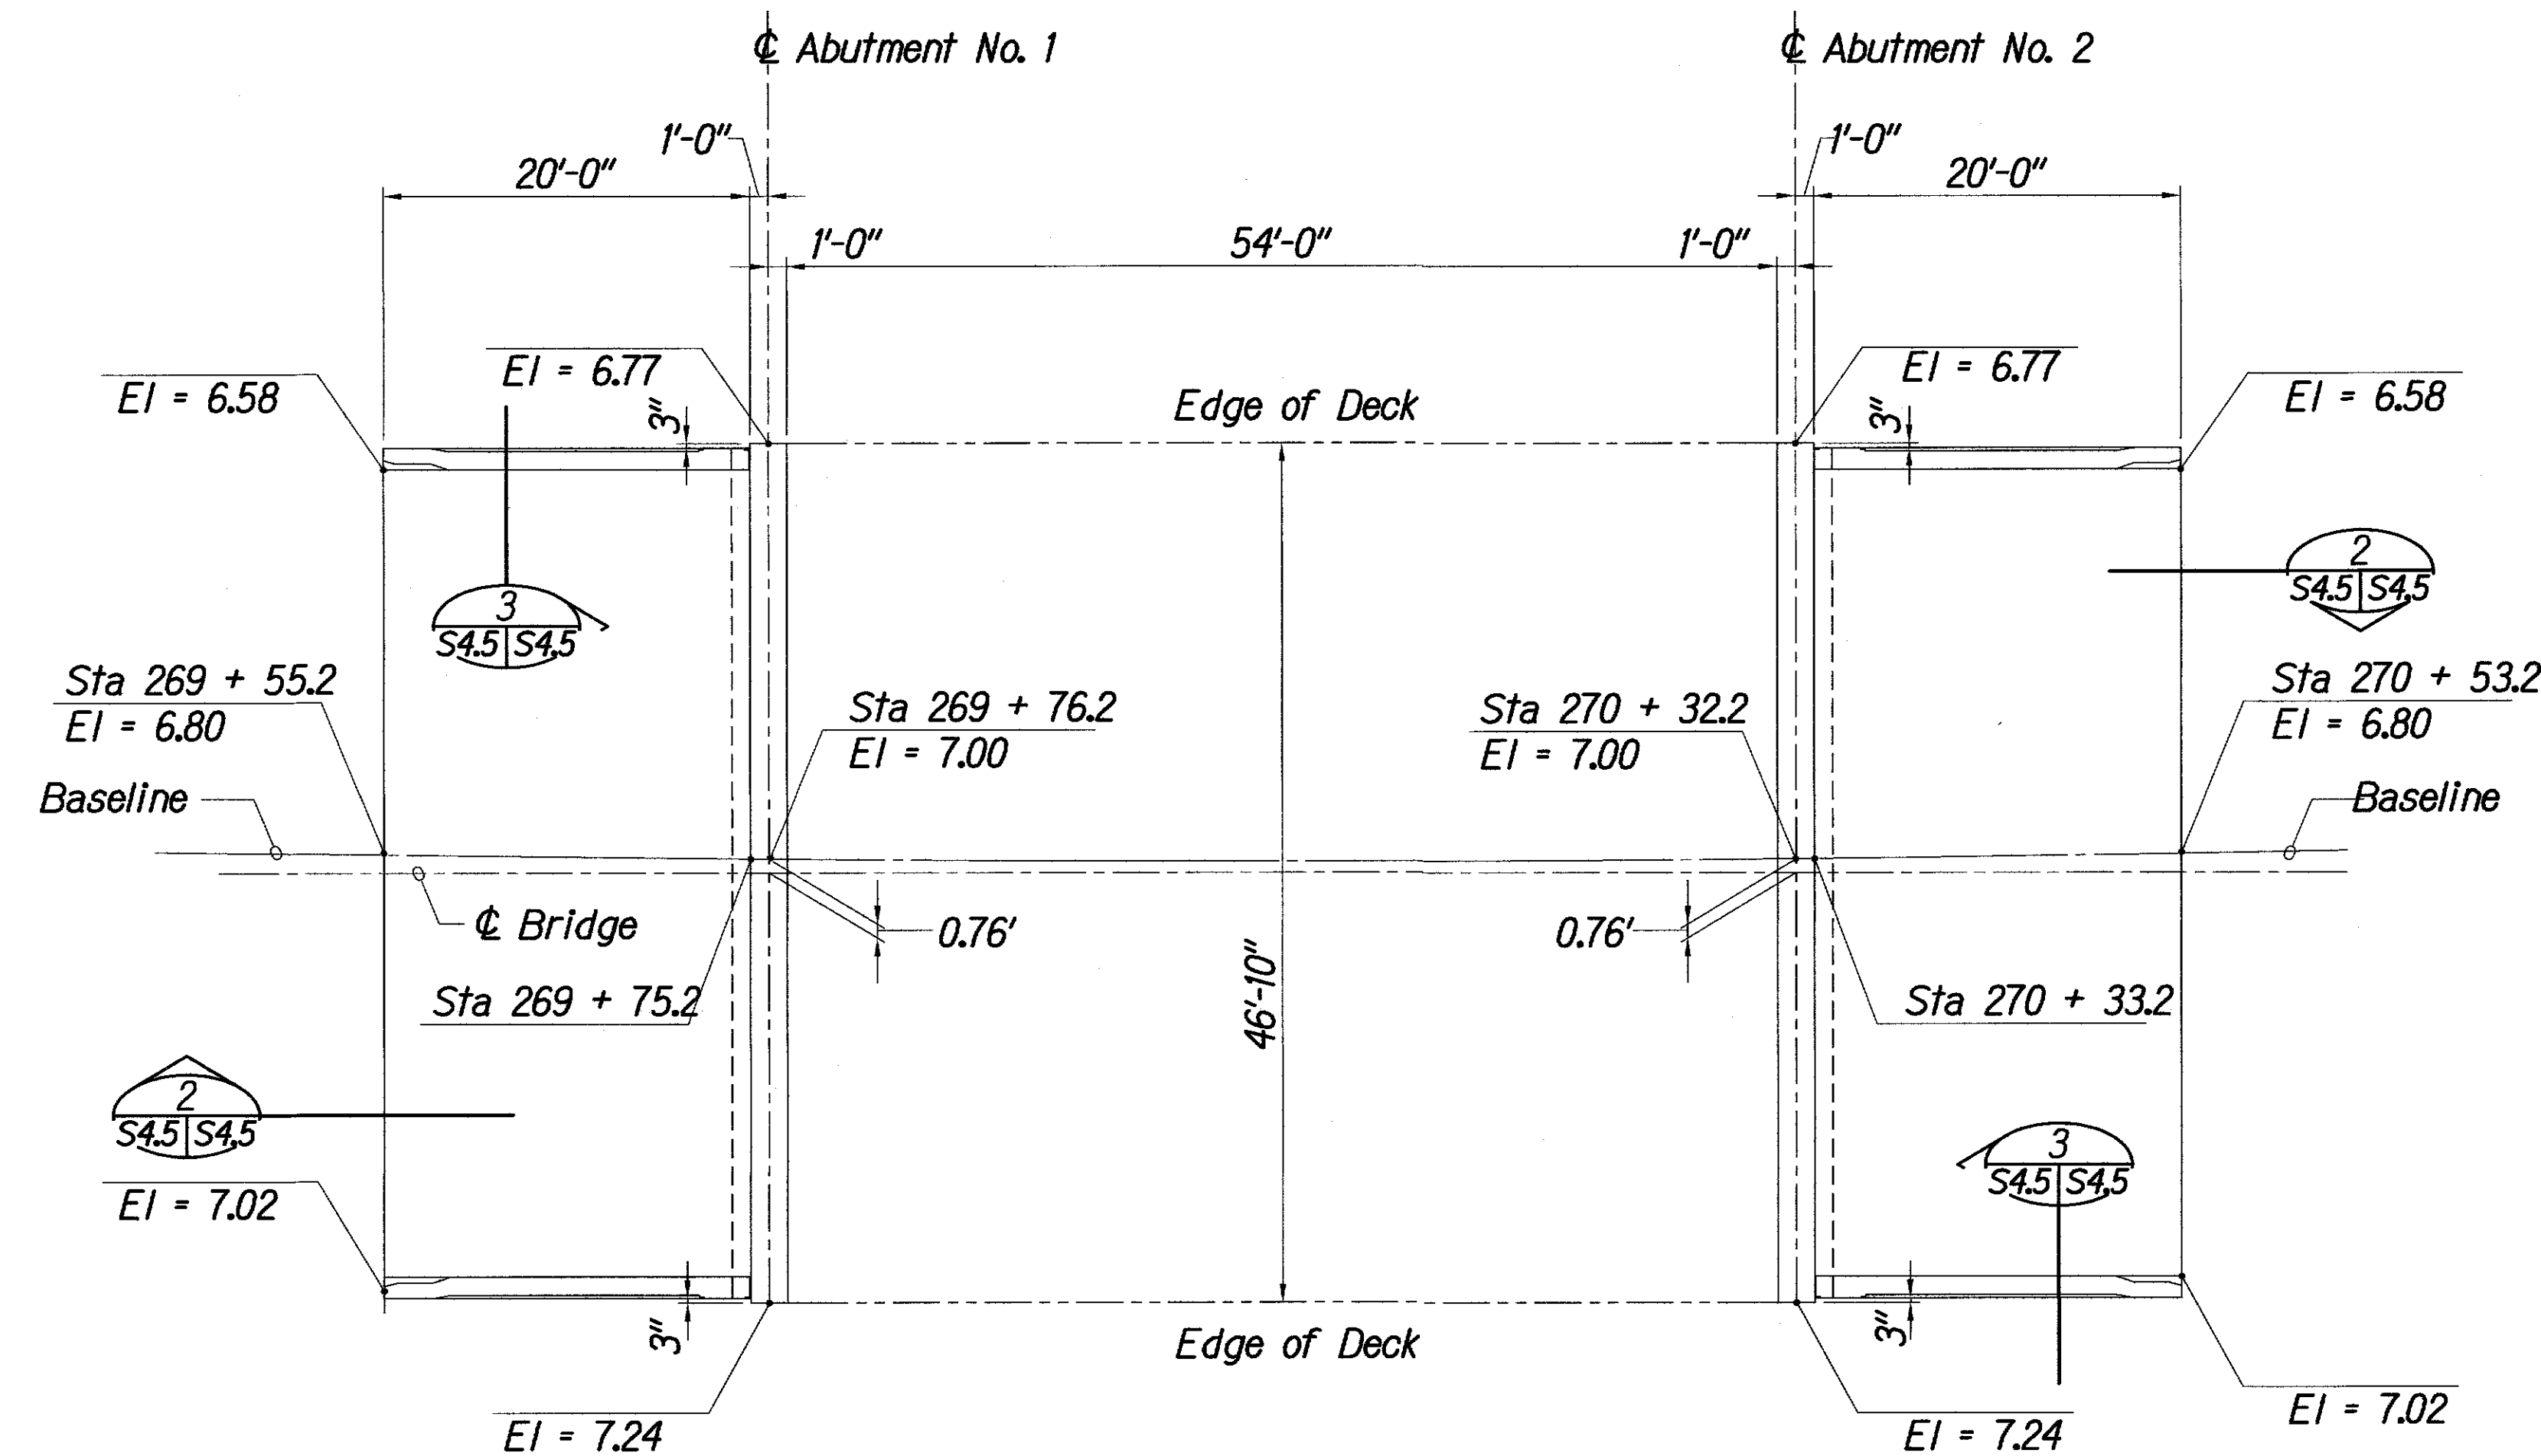

**Note:**  
All Elevations are at the Top of Slab.

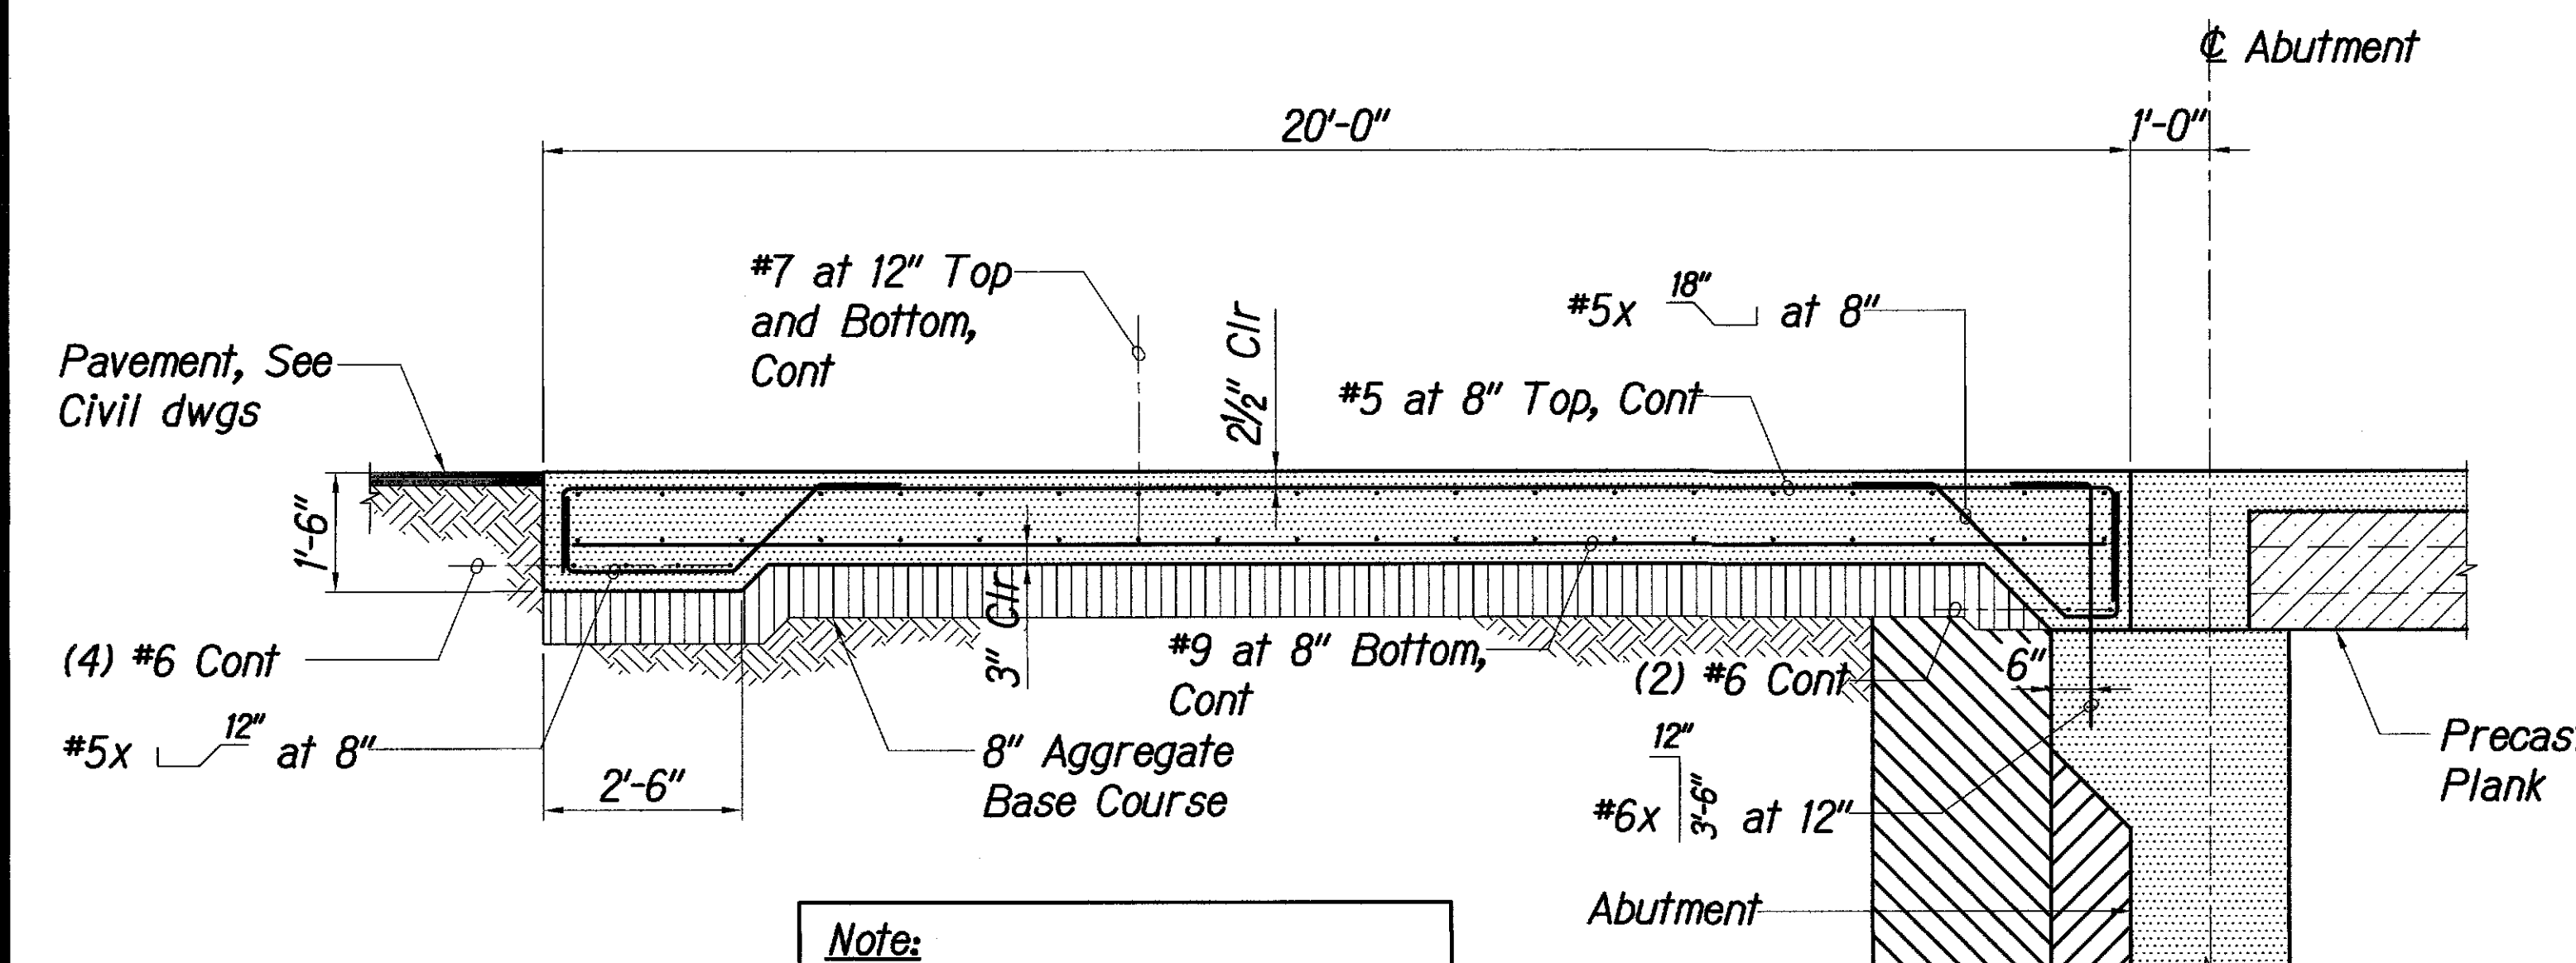


**Note:**  
Abutment and Deck reinforcing not shown for Clarity.

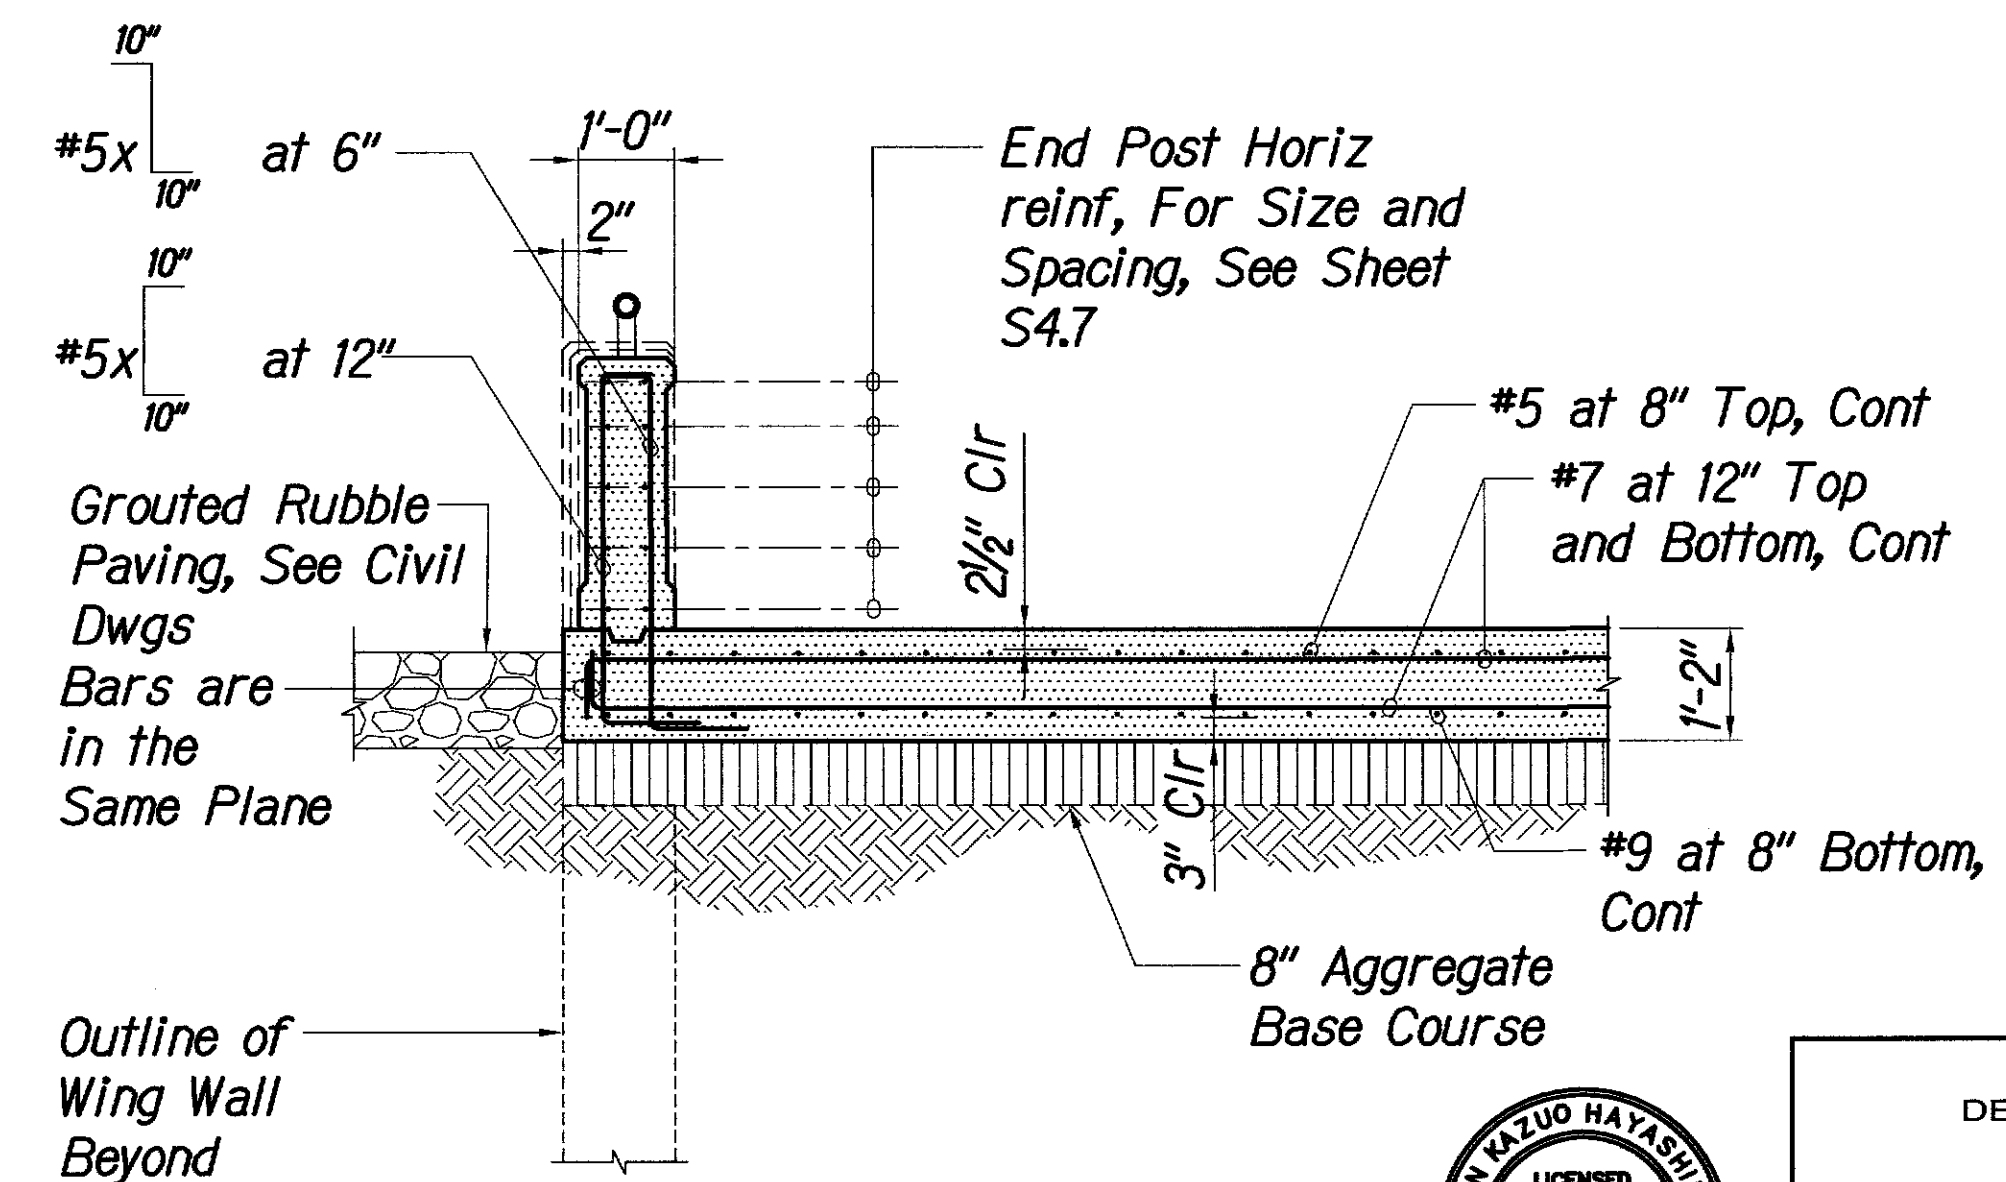

**LEGEND FOR AS-BUILT POSTINGS**

|         |                                     |
|---------|-------------------------------------|
| ~~~~~   | Squiggly line for as-built deletion |
| ==      | Double line for as-built deletion   |
| Roadway | Text for as-built posting           |

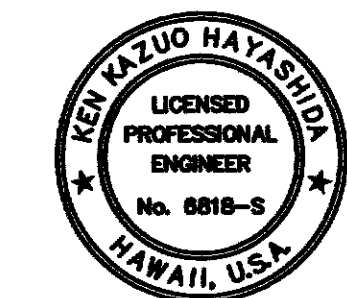

STATE OF HAWAII  
DEPARTMENT OF TRANSPORTATION  
HIGHWAYS DIVISION

**APPROACH SLAB PLAN AND SECTIONS**

**KAMEHAMEHA V HIGHWAY**  
**Kawela Bridge Replacement**  
**Federal Aid Project No. BR-0450(8)**

Scale: AS NOTED Date: June, 2010

SHEET No. S4.5 OF 93 SHEETS


THIS WORK WAS PREPARED BY ME OR UNDER MY SUPERVISION

2016-09-13 15:28-01 Kawela Bridge AS BUILT S4.5.dwg, 9/13/2016 4:44:50 PM, tamaraha







| FED. ROAD DIST. NO. | STATE | FED. AID PROJ. NO. | FISCAL YEAR | SHEET NO. | TOTAL SHEETS |
|---------------------|-------|--------------------|-------------|-----------|--------------|
| HAWAII              | HAW.  | BR-0450(8)         | 2011        | 83        | 93           |

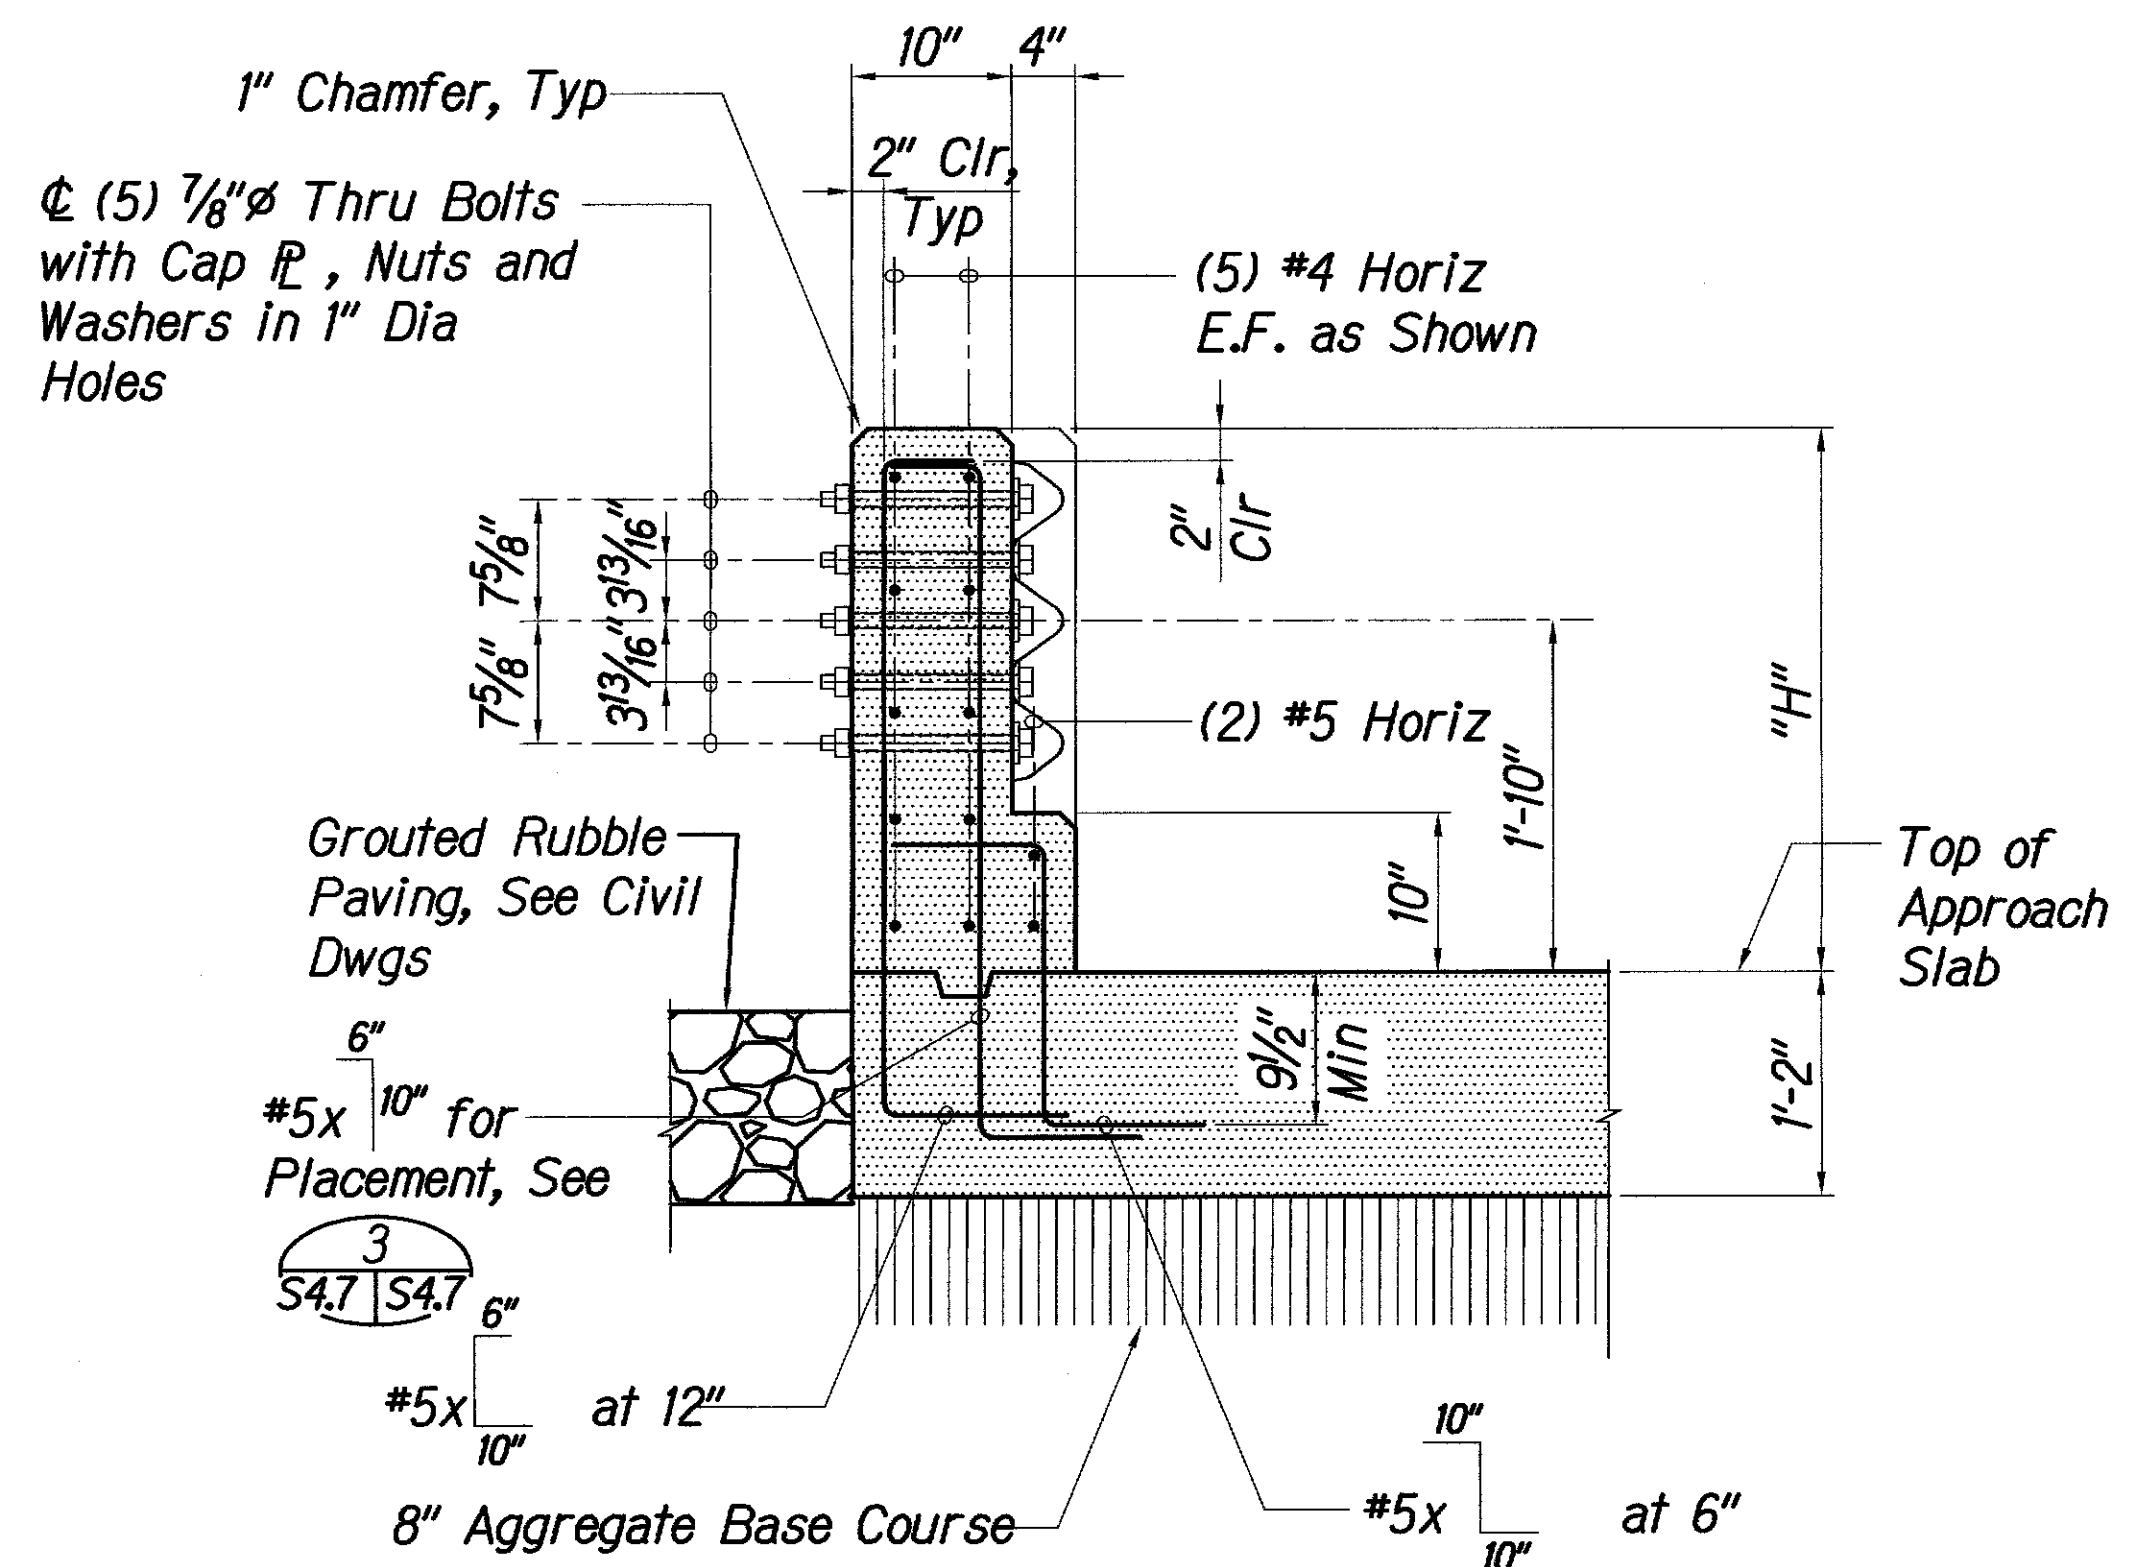


SECTION 1  
Scale: 1" = 1'-0"  
S4.7 S4.7

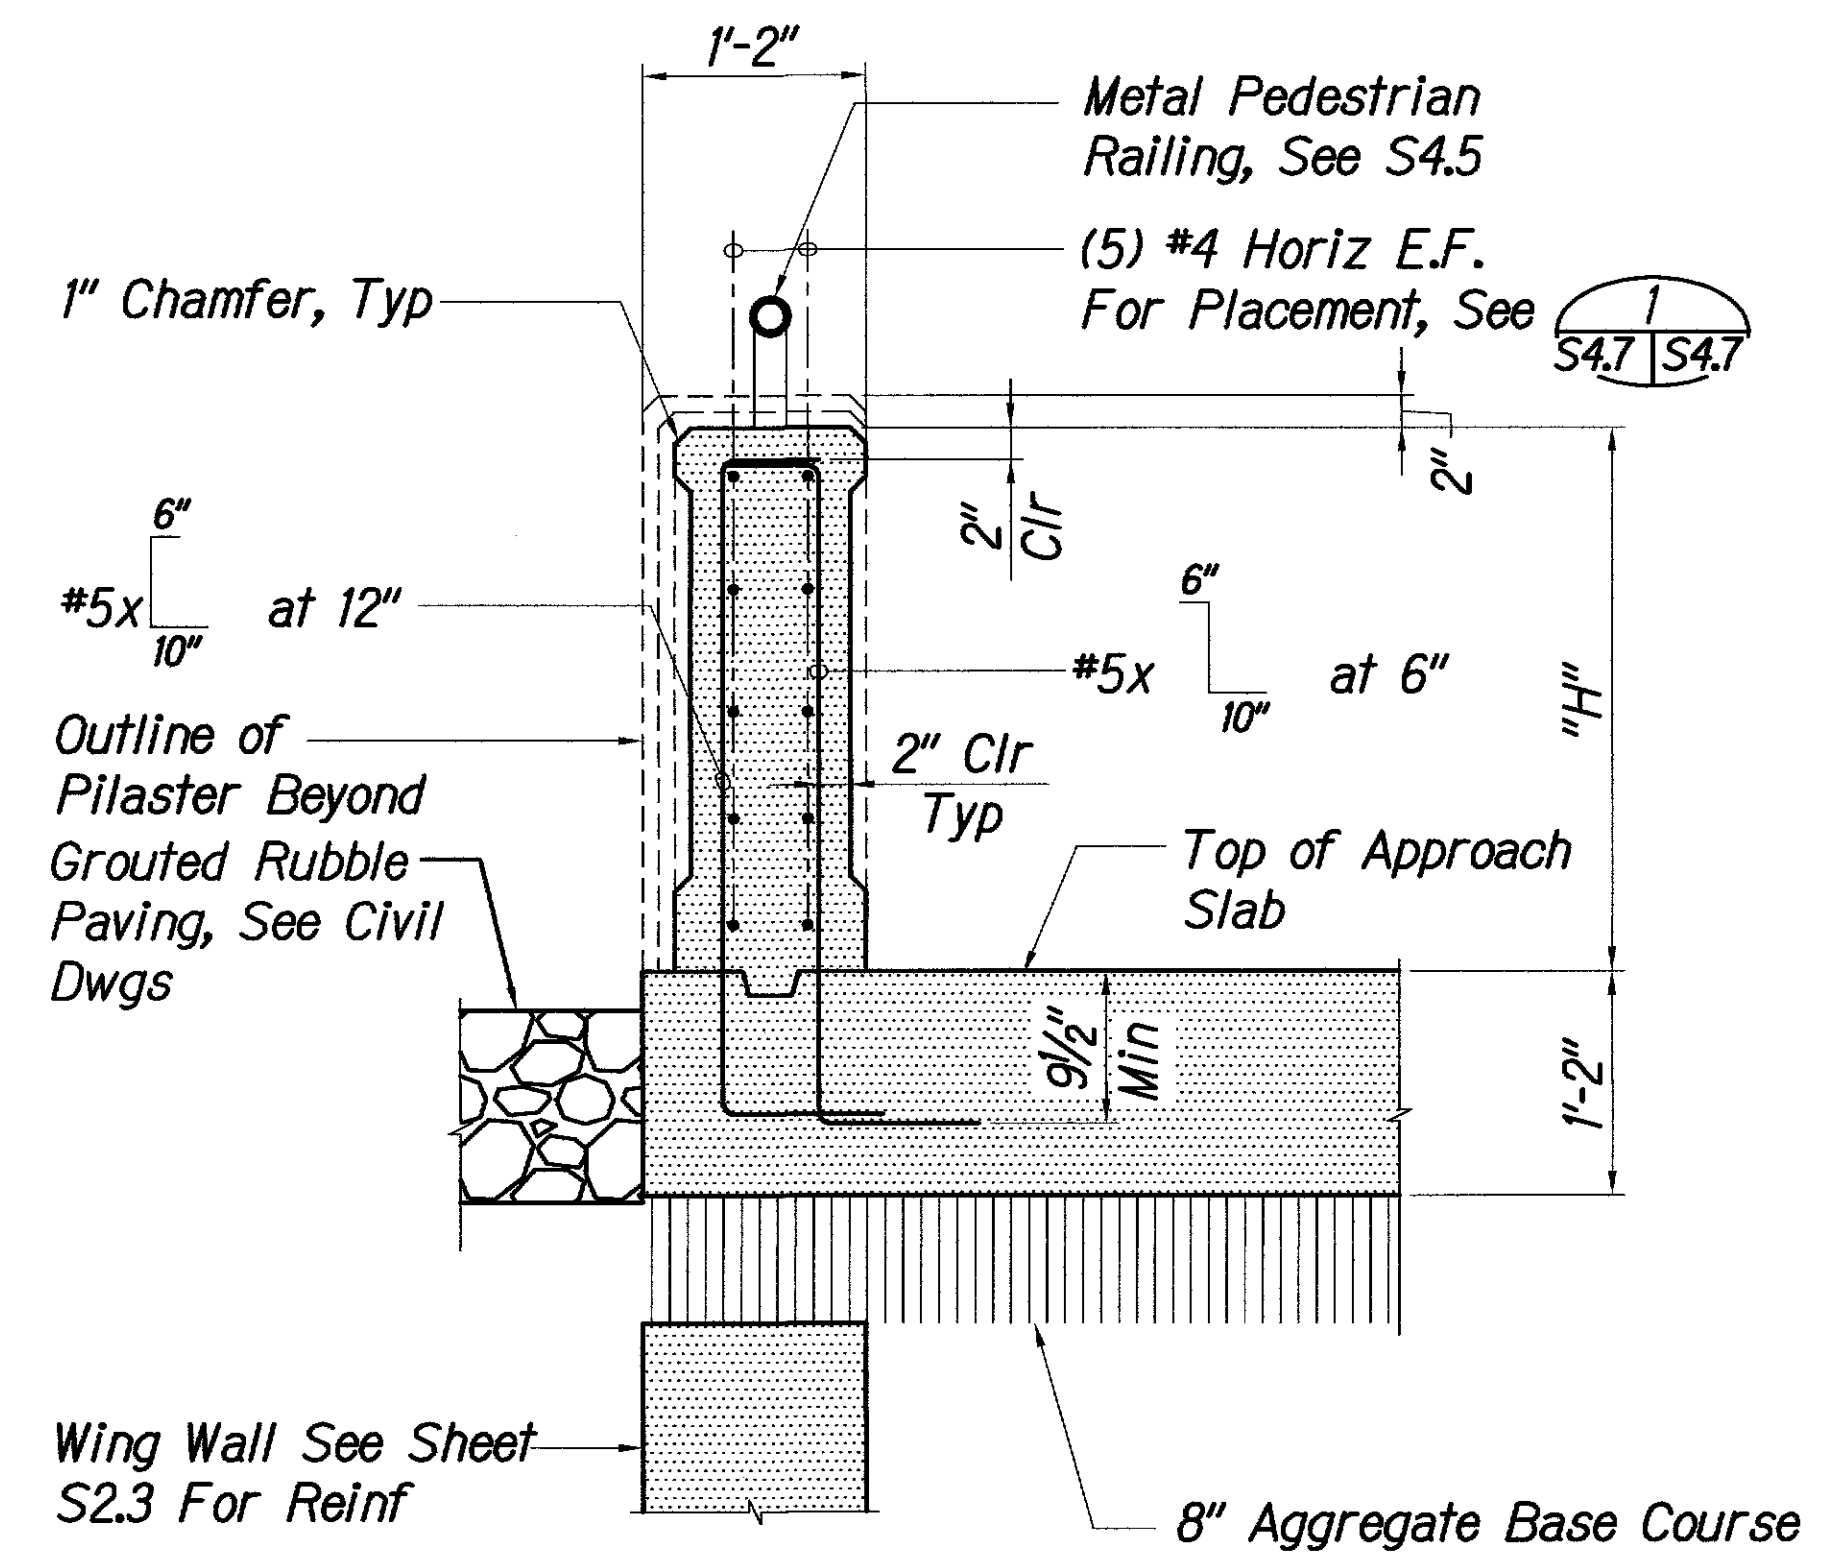


SECTION 2  
Scale: 1" = 1'-0"  
S2.3, S4.7 S4.7

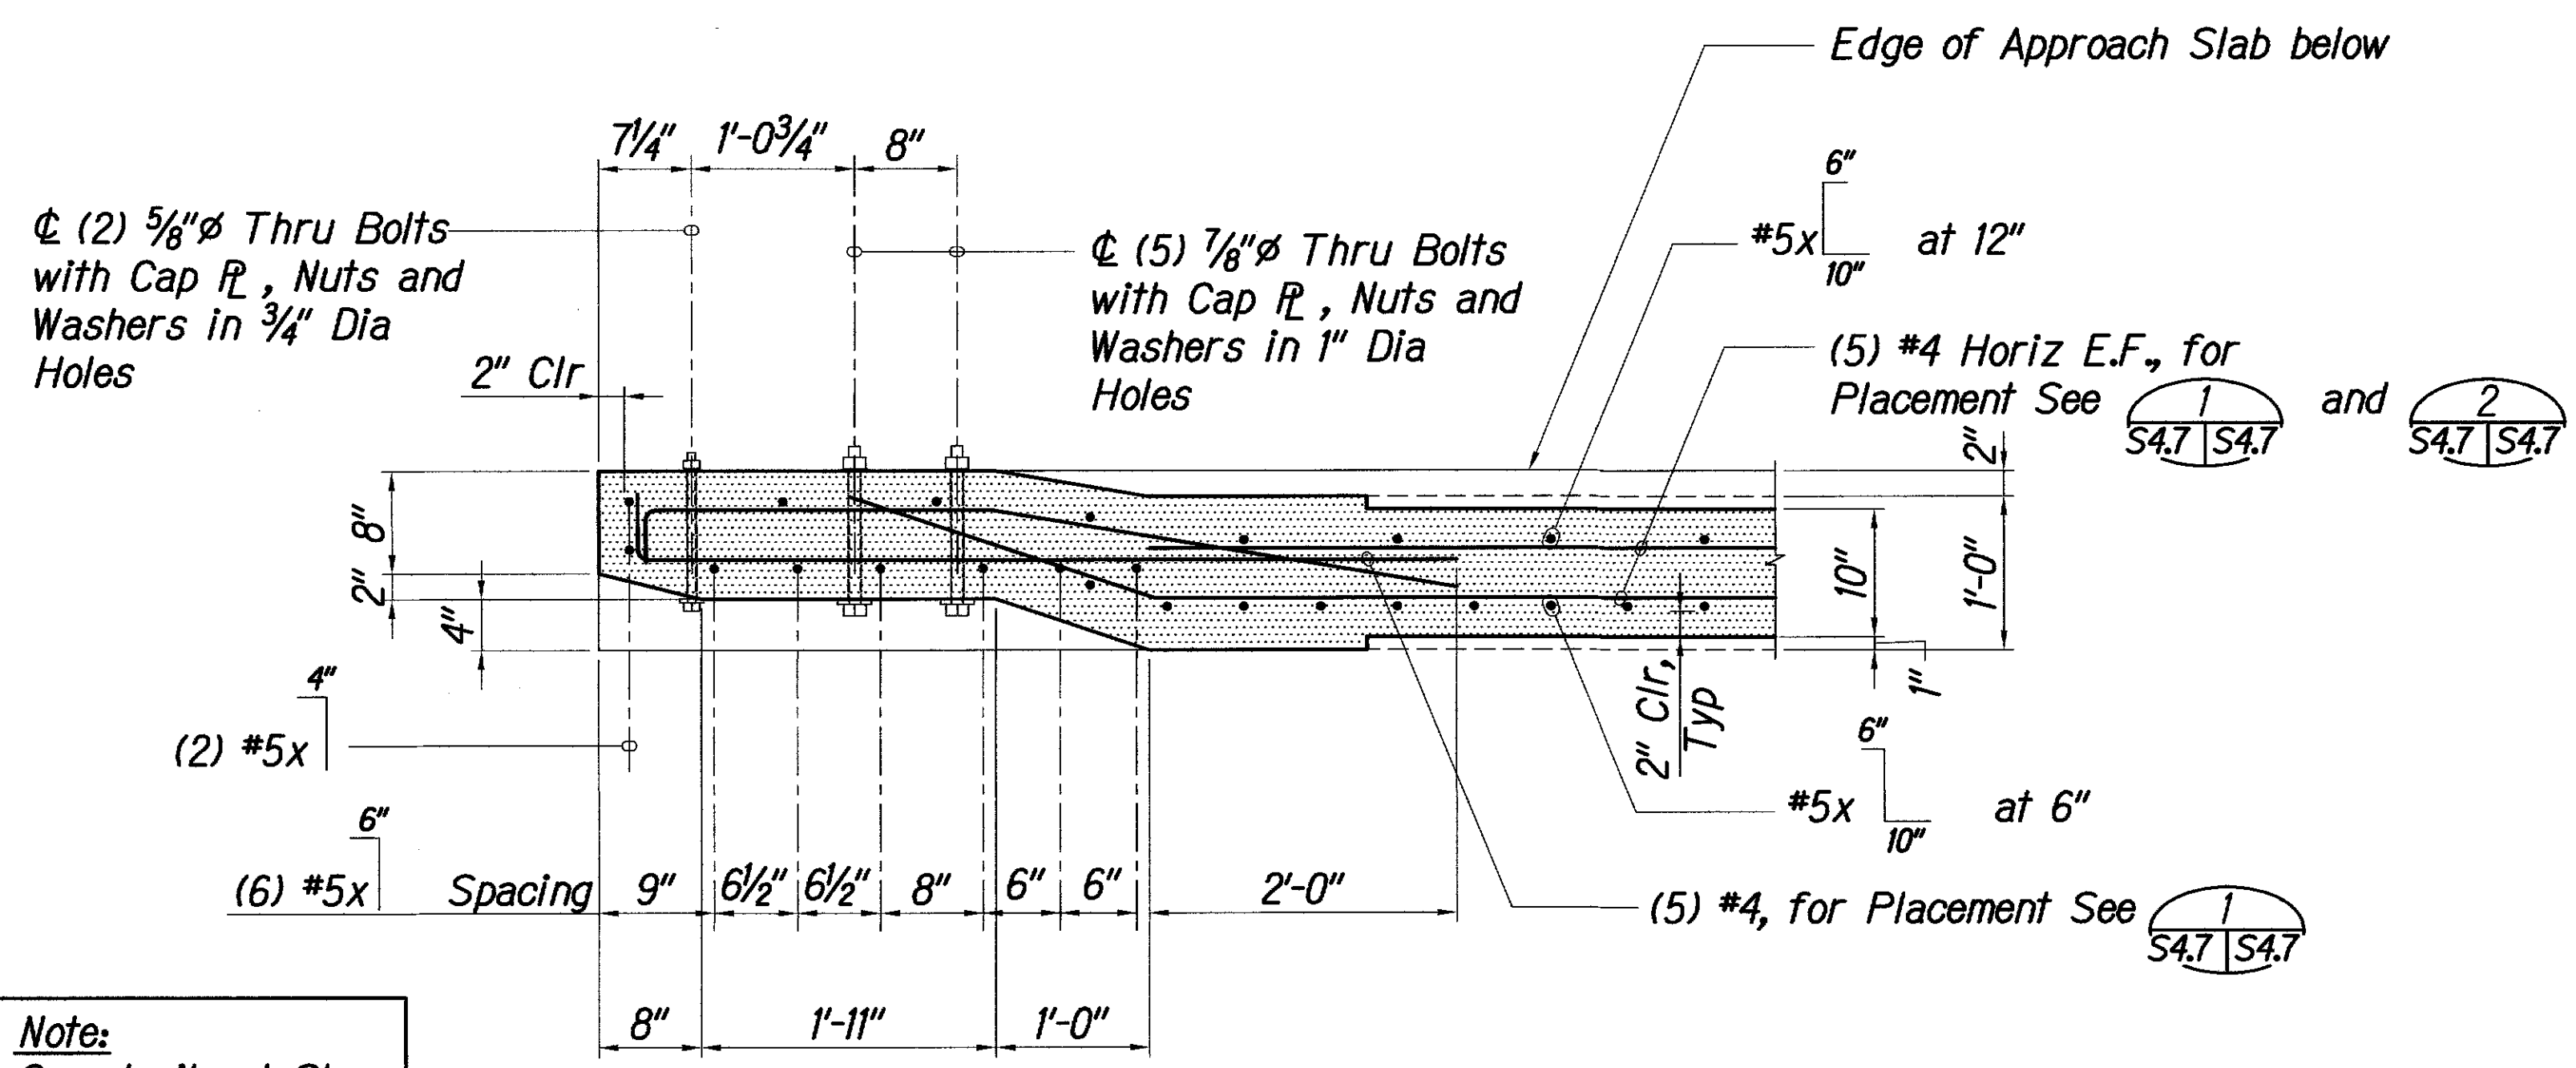

PARTIAL PLAN SECTION SHOWING REINF.  
Scale: 1" = 1'-0"  
S4.6 S4.7

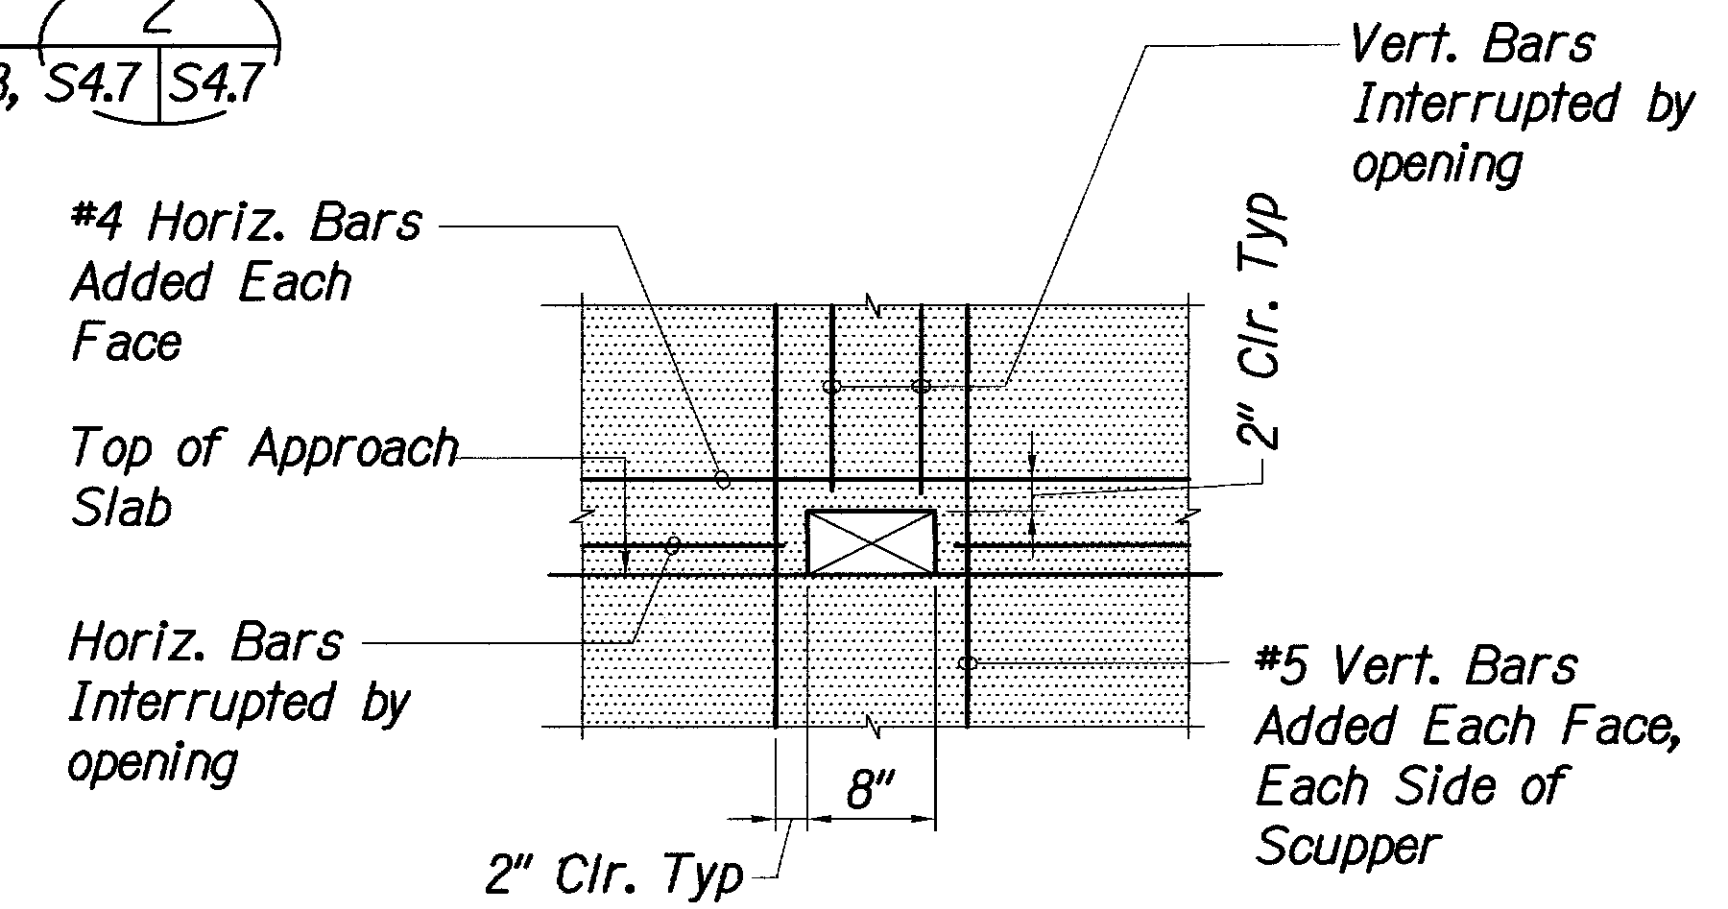

TYPICAL ADDED REINF. AT SCUPPER OPENING  
Scale: 1" = 1'-0"  
S4.7 S4.7

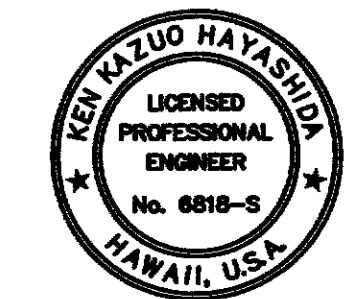

STATE OF HAWAII  
DEPARTMENT OF TRANSPORTATION  
HIGHWAYS DIVISION

**END POST SECTIONS  
AND DETAILS**  
**KAMEHAMEHA V HIGHWAY**  
**Kawela Bridge Replacement**  
**Federal Aid Project No. BR-0450(8)**

Scale: AS NOTED Date: June, 2010

SHEET No. S4.7 OF 93 SHEETS