




FED. ROAD DIST. NO.	STATE	PROJ. NO.	FISCAL YEAR	SHEET NO.	TOTAL SHEETS
HAWAII	HAW.	450A-01-08M	2008	8	25

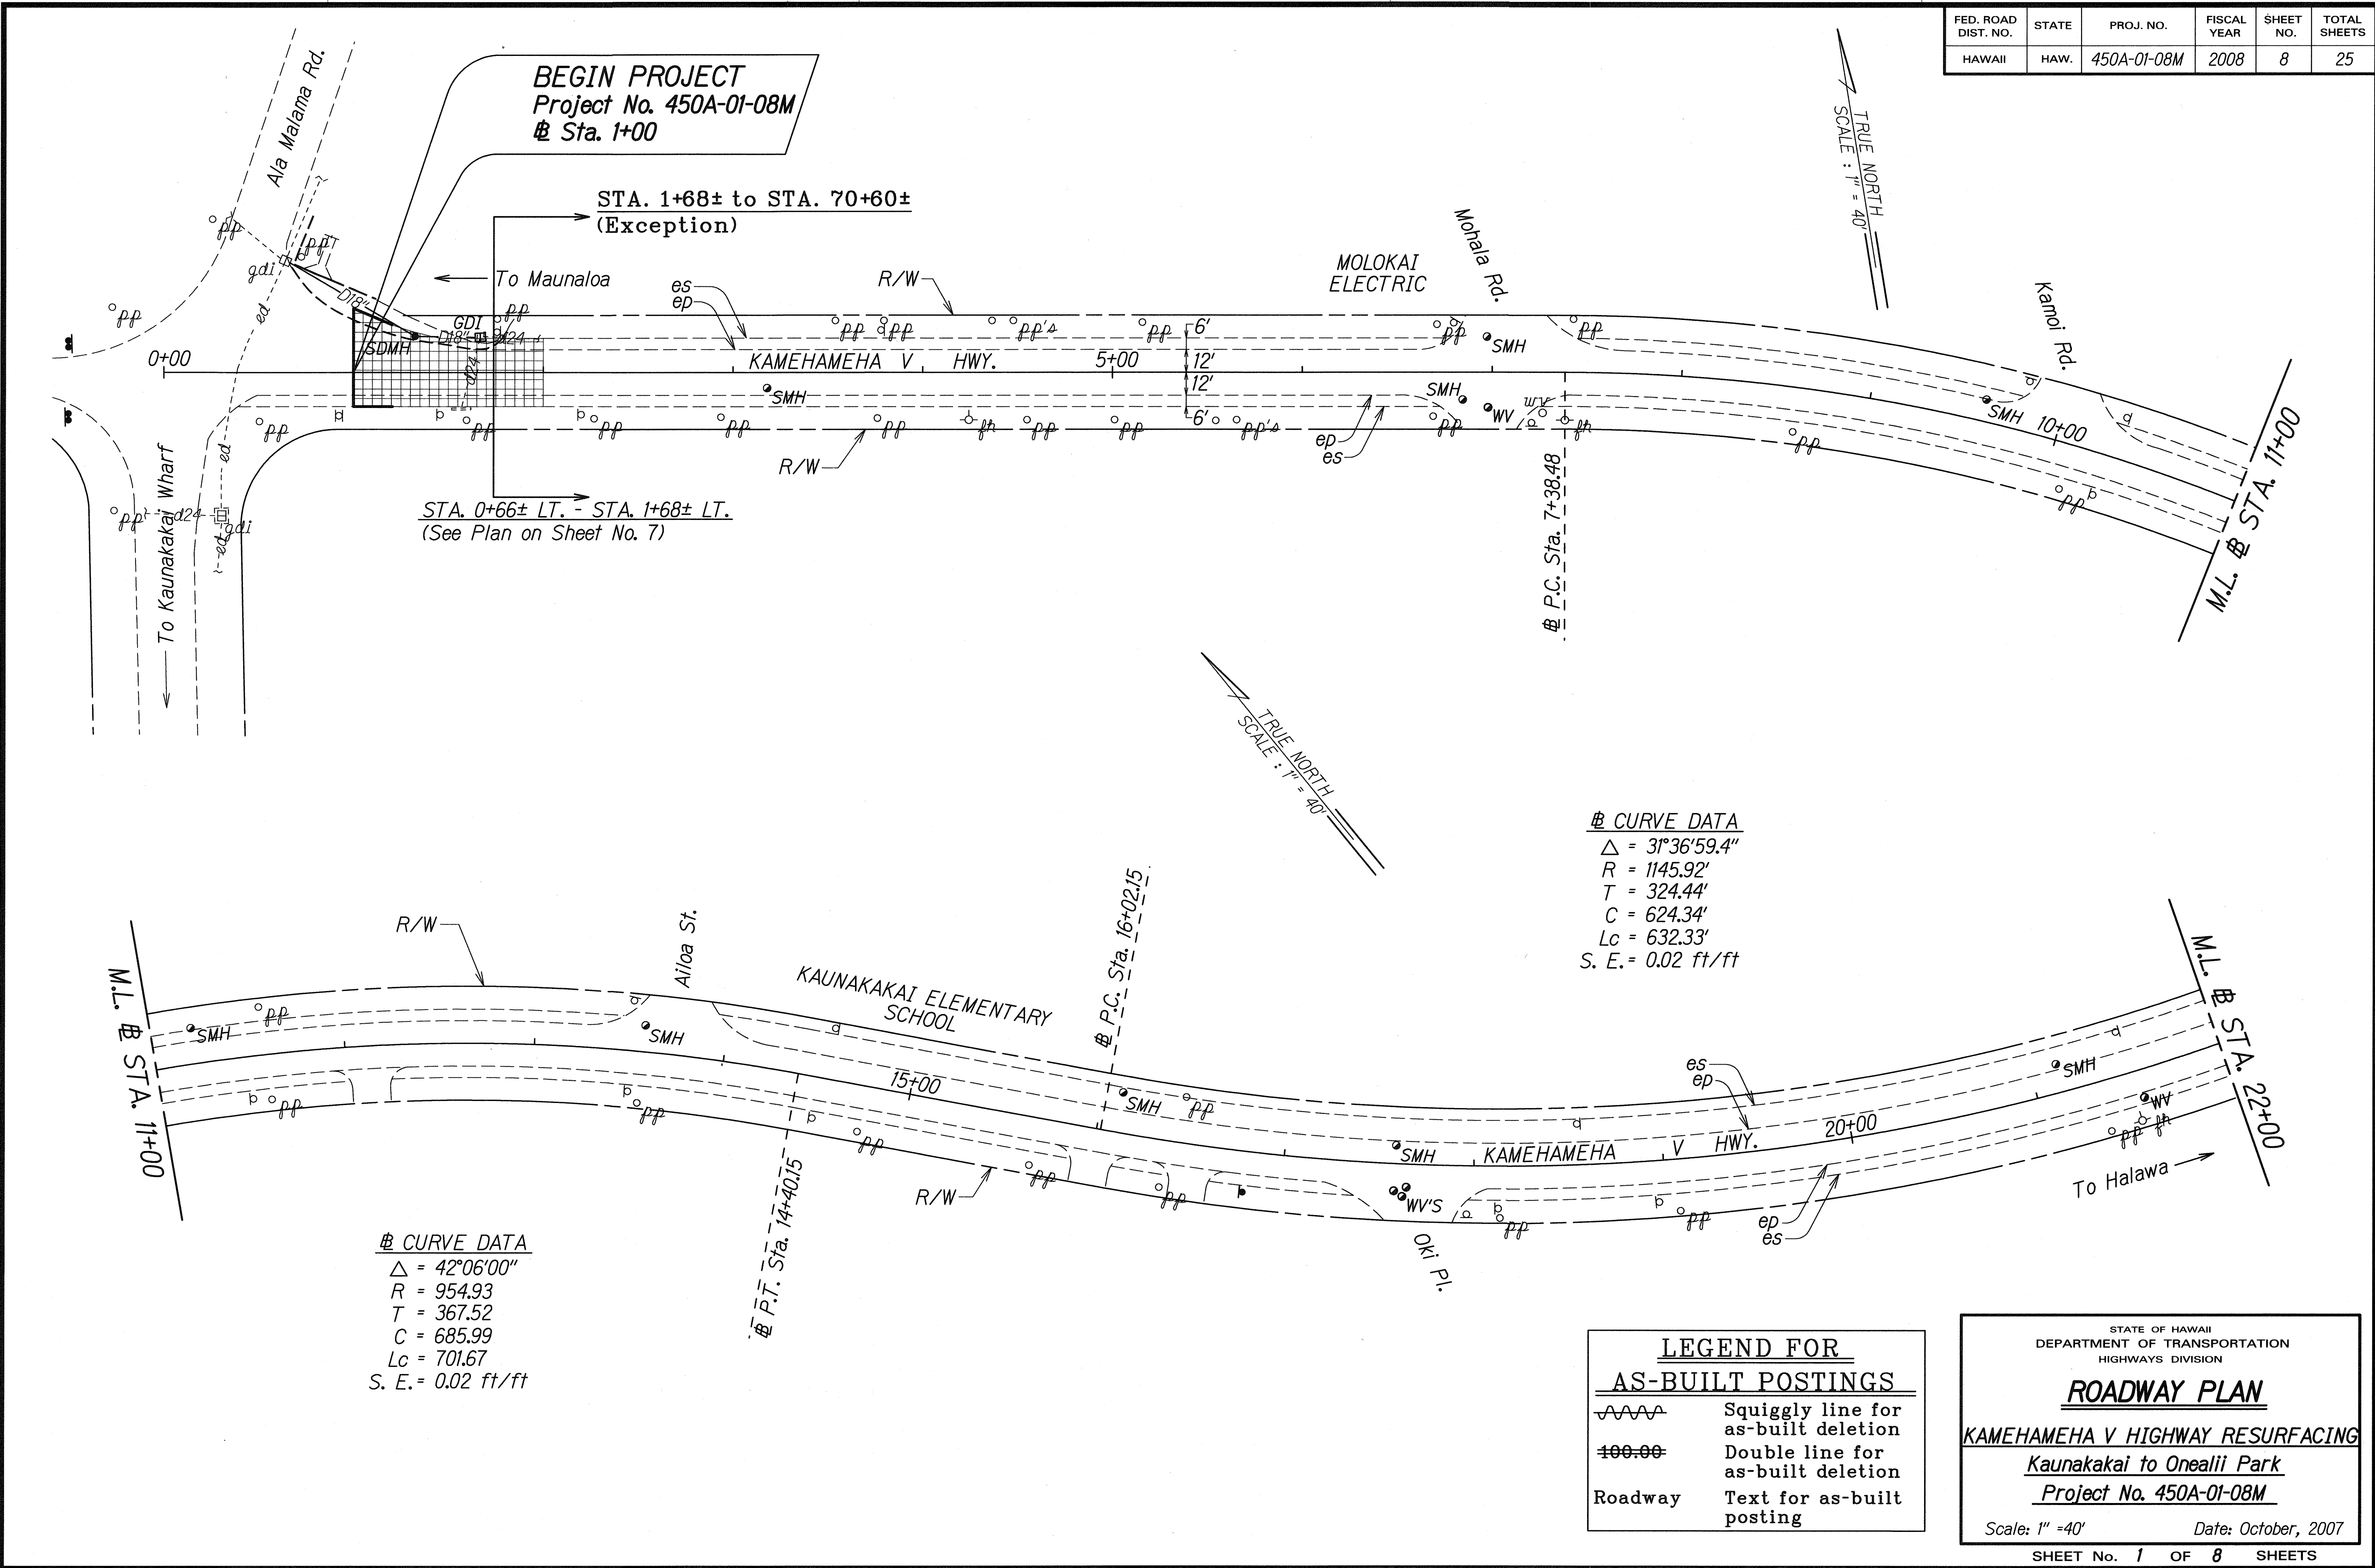

"AS-BUILT"

FED. ROAD DIST. NO.	STATE	PROJ. NO.	FISCAL YEAR	SHEET NO.	TOTAL SHEETS
HAWAII	HAW.	450A-01-08M	2008	9	25

STA. 1+68± to STA. 70+60±
(Exception)

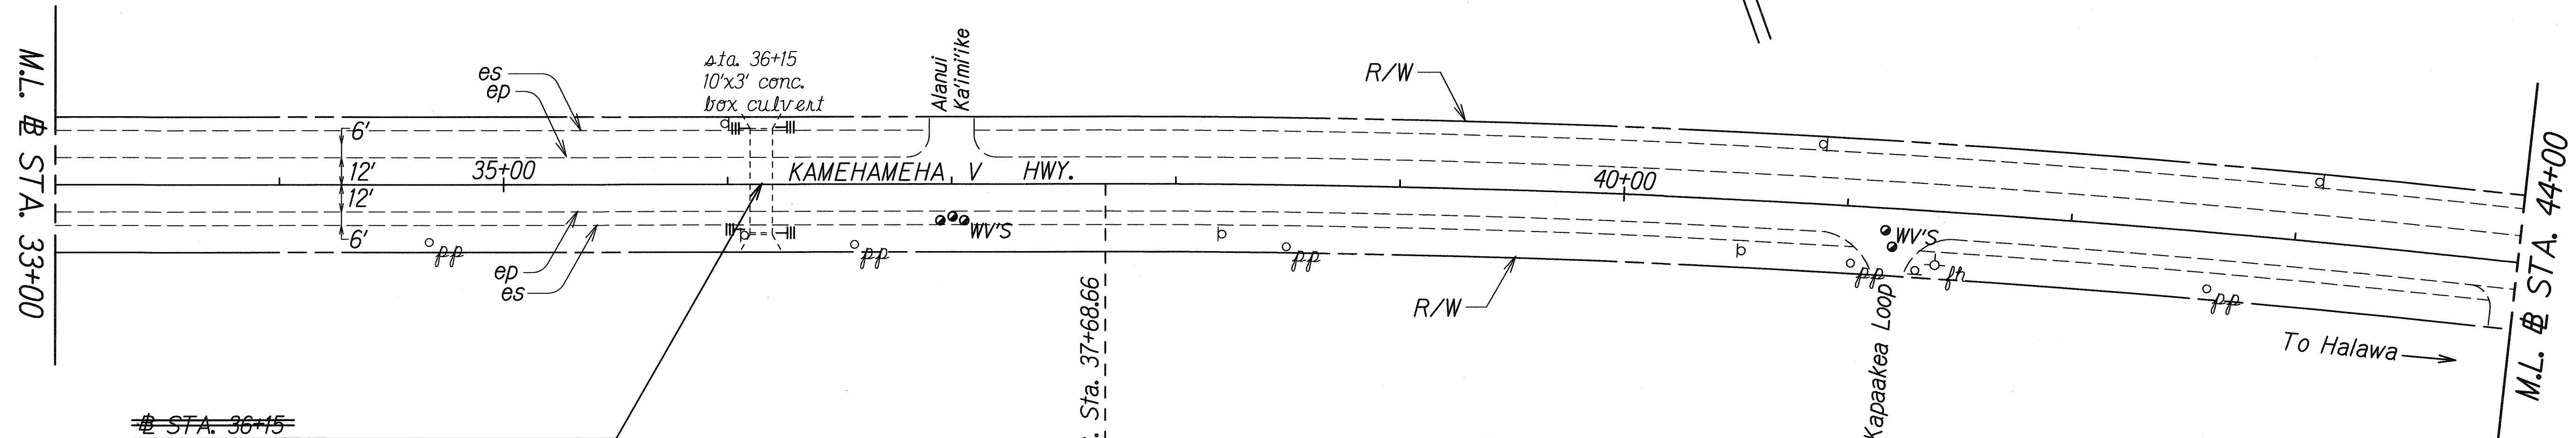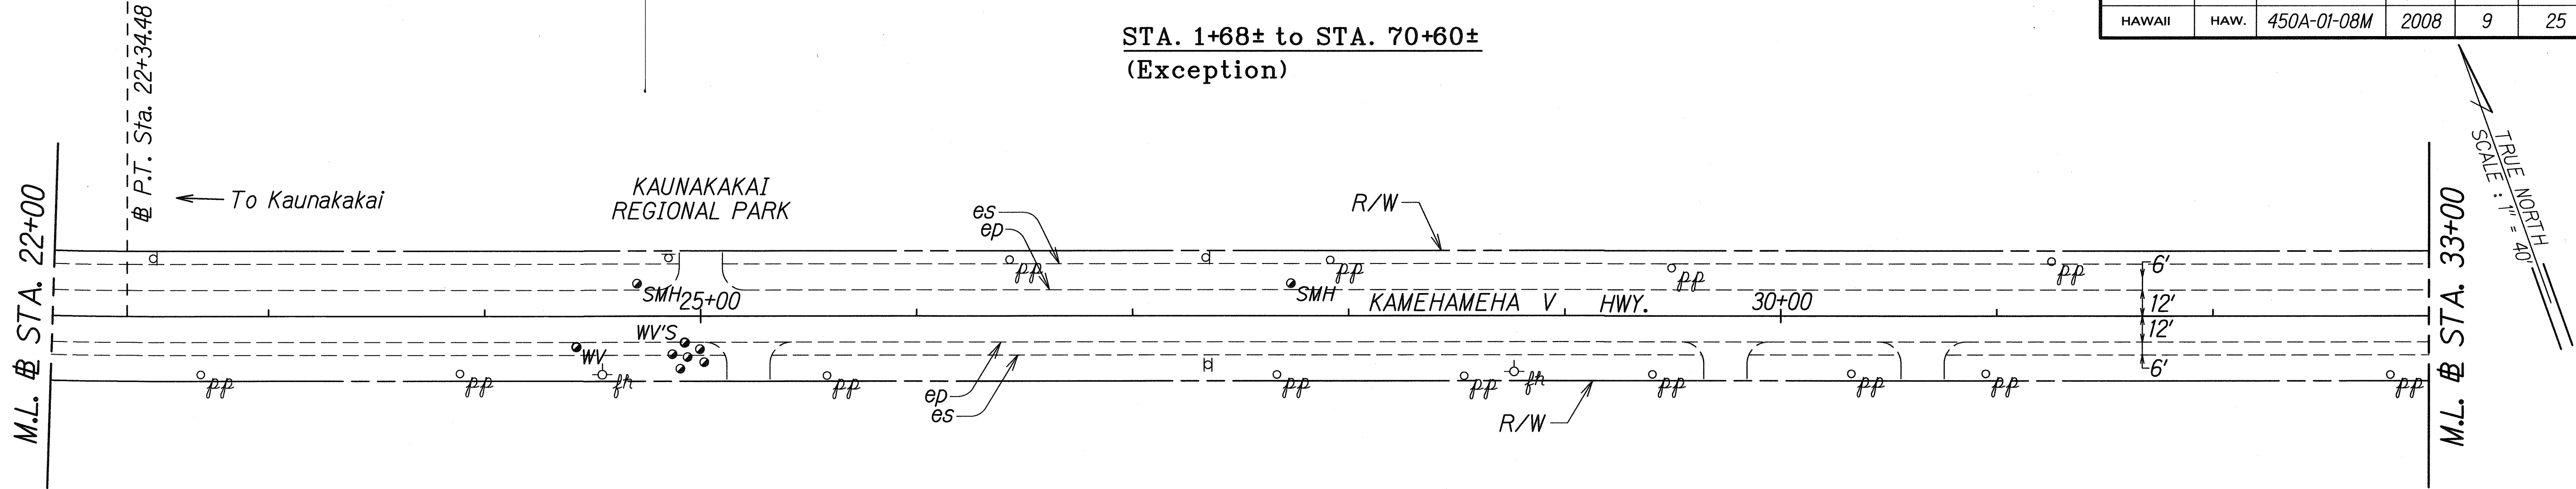

~~Sta. 36+15~~
~~Clean, remove and dispose of silt, trash,~~
~~vegetation growth from existing culverts~~
~~and adjoining drainage structures within~~
~~project limits.~~



△ CURVE DATA
 $\Delta = 7^\circ 24' 00''$
 $R = 5729.58'$
 $T = 370.52'$
 $C = 739.49'$
 $Lc = 740.00'$
 $S. E. = 0.02 \text{ ft/ft}$

LEGEND FOR AS-BUILT POSTINGS	
	Squiggly line for as-built deletion
	Double line for as-built deletion
Roadway	Text for as-built posting

STATE OF HAWAII
DEPARTMENT OF TRANSPORTATION
HIGHWAYS DIVISION
ROADWAY PLAN
KAMEHAMEHA V HIGHWAY RESURFACING
Kaunakakai to Oneali Park
Project No. 450A-01-08M
Scale: 1" = 40' Date: October, 2007
SHEET No. 2 OF 8 SHEETS

"AS-BUILT"

FED. ROAD DIST. NO.	STATE	PROJ. NO.	FISCAL YEAR	SHEET NO.	TOTAL SHEETS
HAWAII	HAW.	450A-01-08M	2008	10	25

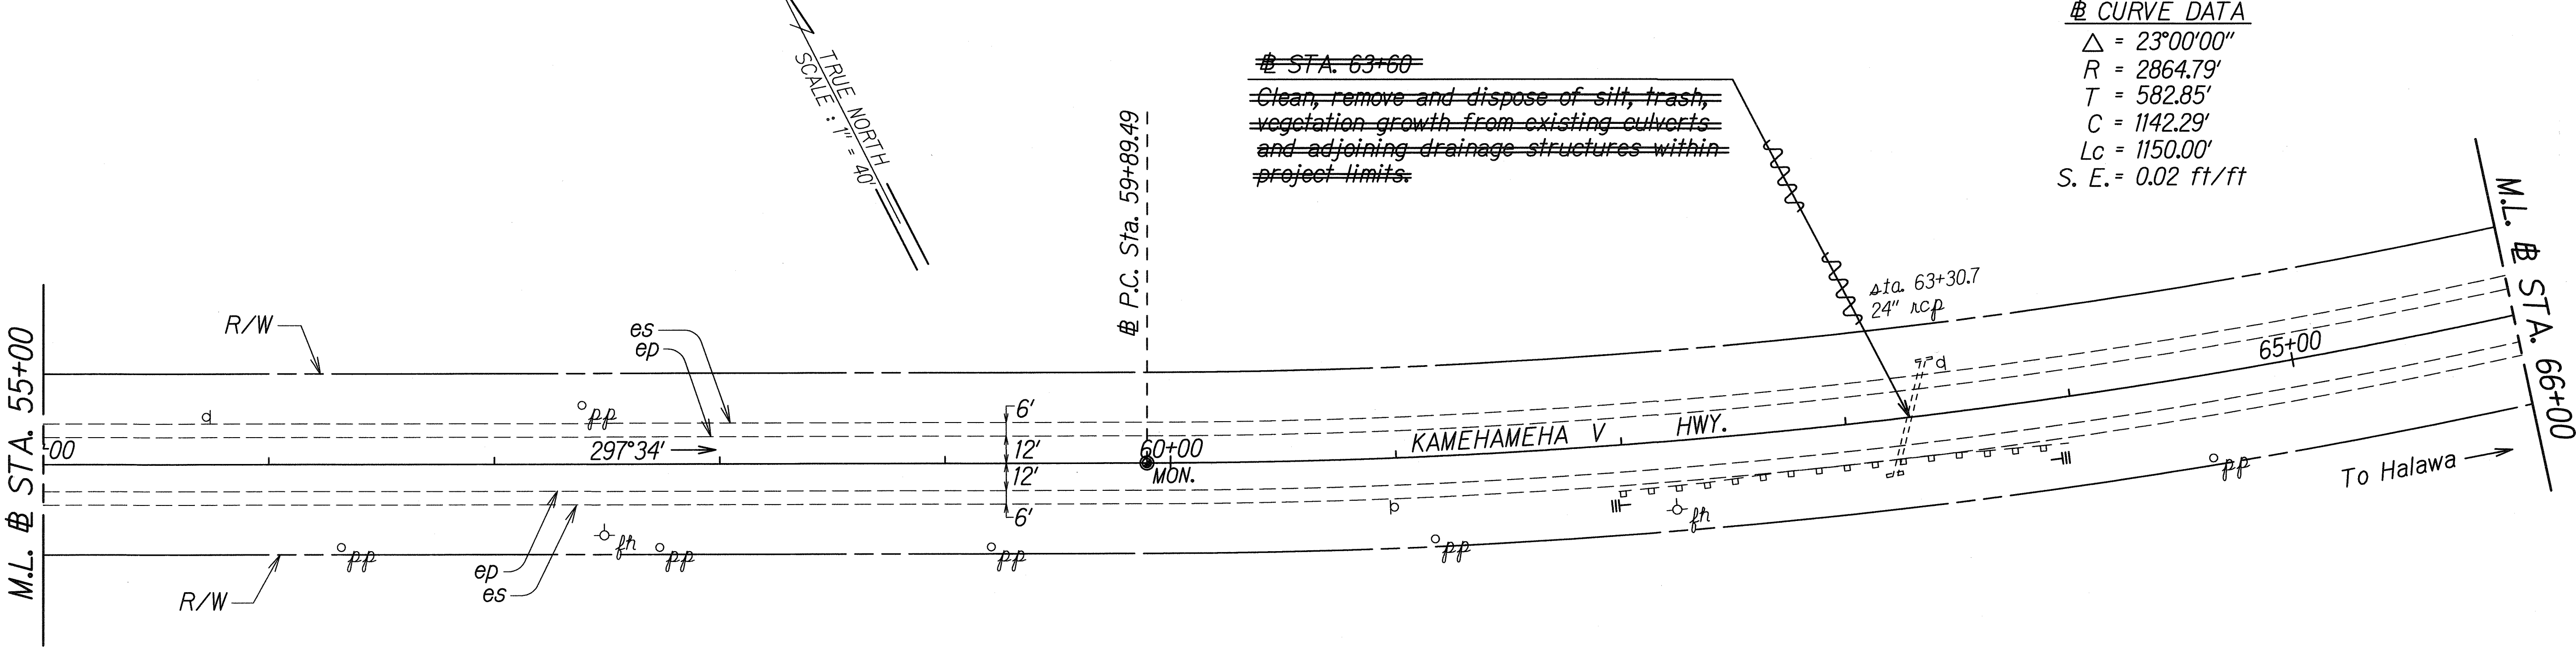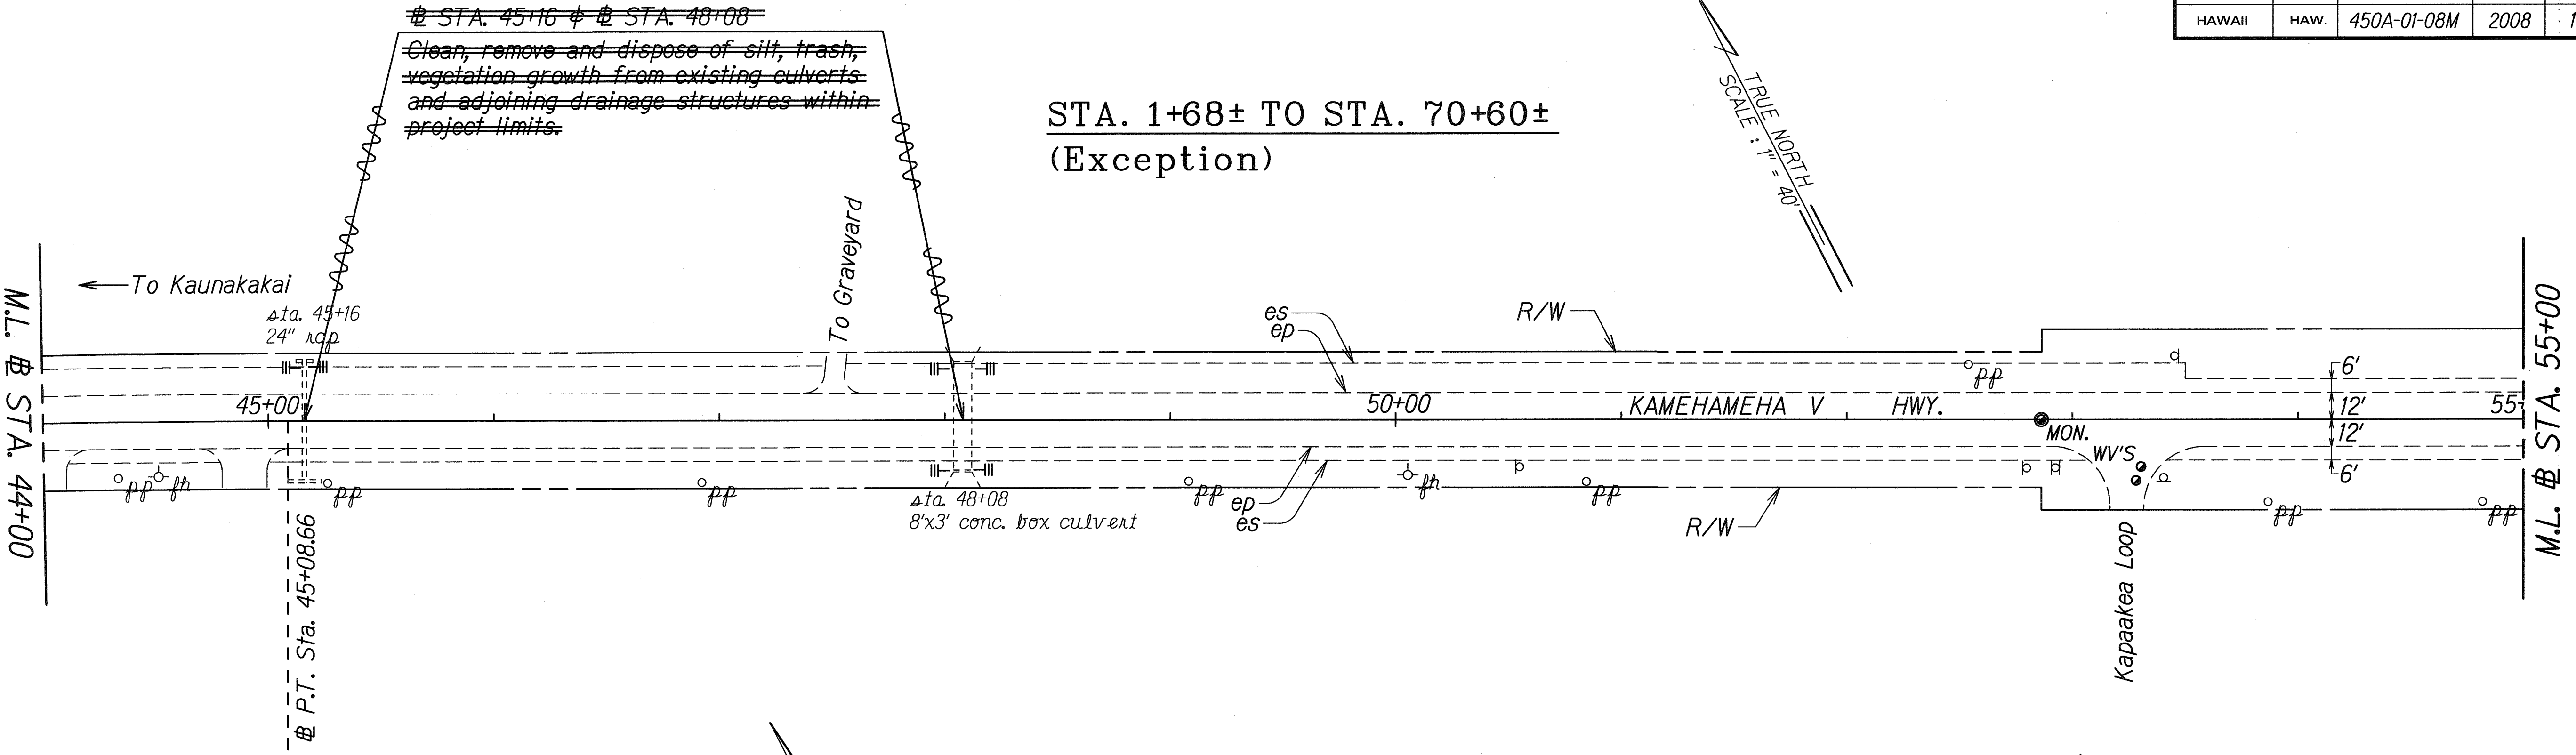

CURVE DATA

Δ	= 23°00'00"
R	= 2864.79'
T	= 582.85'
C	= 1142.29'
Lc	= 1150.00'
S. E.	= 0.02 ft/ft

~~STA. 62+00± RT. - STA. 64+00± RT.~~
~~Reset existing guardrail posts (20 each)~~
~~Install RM-5 mounted on rail @ 25' o.c. (9 each)~~

LEGEND FOR AS-BUILT POSTINGS	
	Squiggly line for as-built deletion
	Double line for as-built deletion
Roadway	Text for as-built posting

STATE OF HAWAII
DEPARTMENT OF TRANSPORTATION
HIGHWAYS DIVISION

ROADWAY PLAN

KAMEHAMEHA V HIGHWAY RESURFACING
Kaunakakai to Onealii Park
Project No. 450A-01-08M


Scale: 1" = 40' Date: October, 2007

SHEET No. 3 OF 8 SHEETS

SURVEY PLOTTED BY	DATE
DRAWN BY	2/10/08
TRACED BY	
DESIGNED BY	
CHECKED BY	
ORIGINAL PLAN	
NOTE BOOK	
DESIGNED BY	
CHECKED BY	

"AS-BUILT"

FED. ROAD DIST. NO.	STATE	PROJ. NO.	FISCAL YEAR	SHEET NO.	TOTAL SHEETS
HAWAII	HAW.	450A-01-08M	2008	11	25

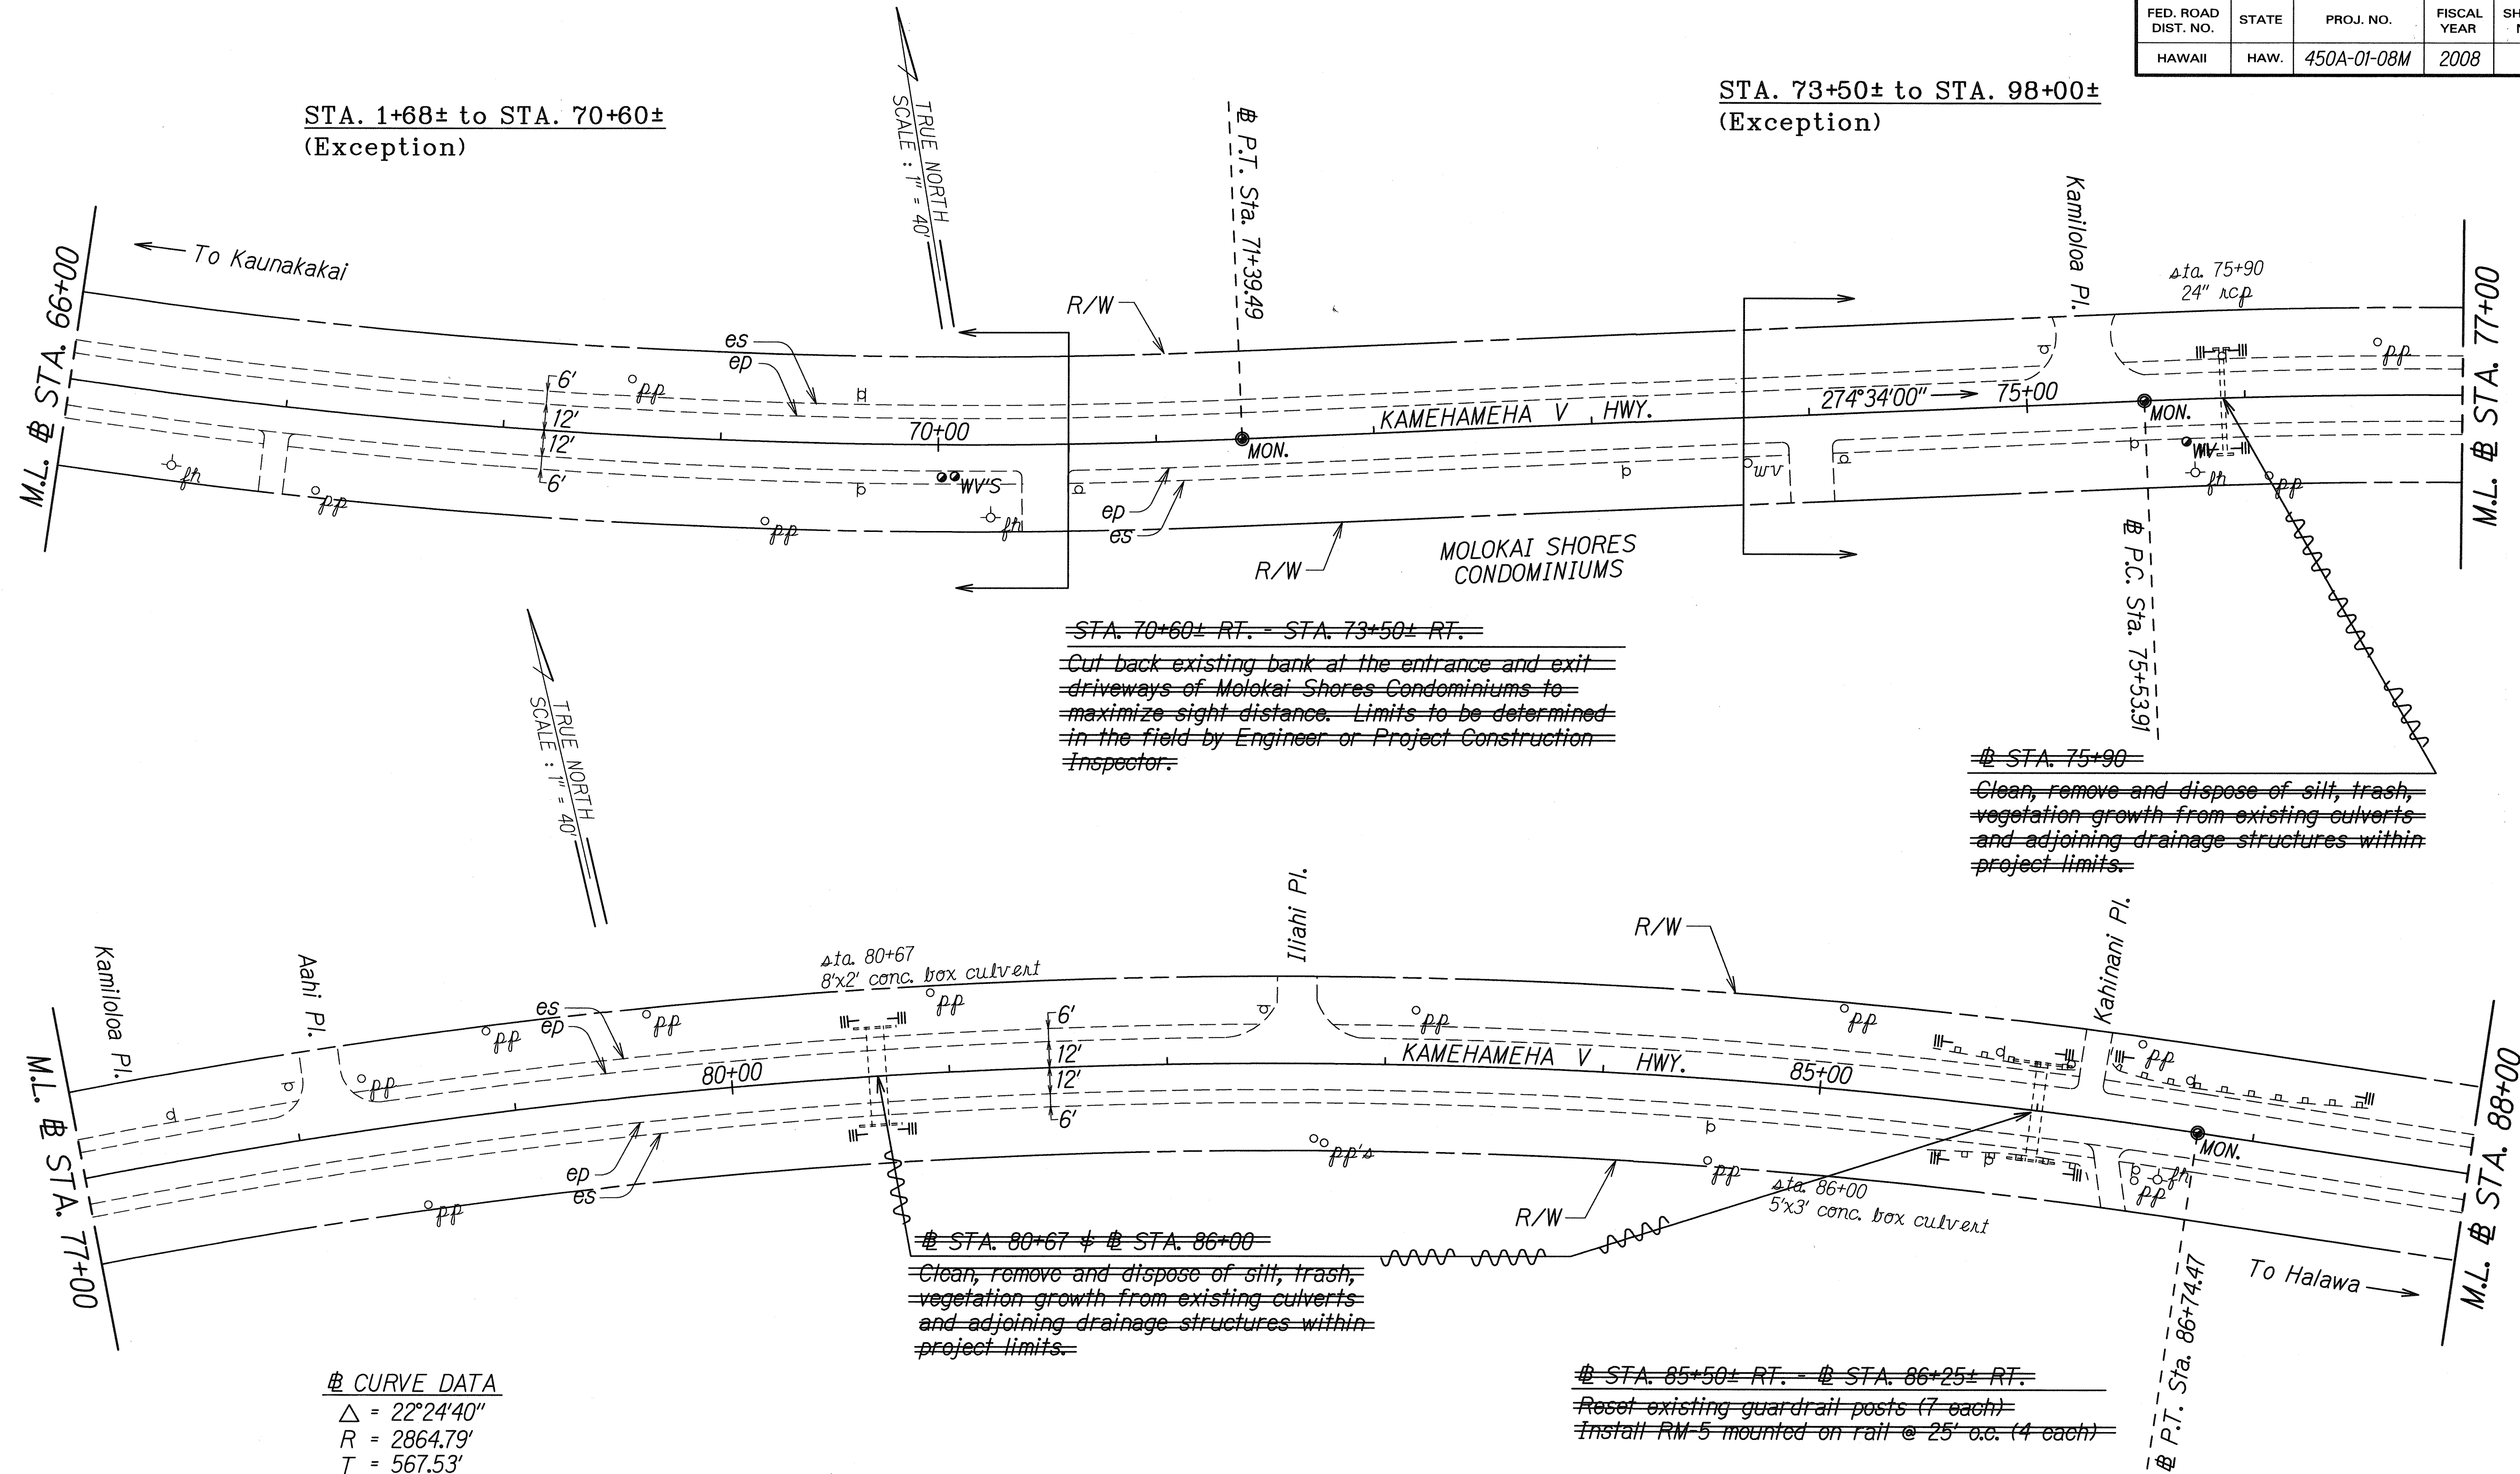

STA. 1+68± to STA. 70+60±
(Exception)

STA. 73+50± to STA. 98+00±
(Exception)

~~STA. 70+60± RT. - STA. 73+50± RT.~~
~~Cut back existing bank at the entrance and exit~~
~~driveways of Molokai Shores Condominiums to~~
~~maximize sight distance. Limits to be determined~~
~~in the field by Engineer or Project Construction~~
~~Inspector.~~

~~# STA. 75+90~~
~~Clean, remove and dispose of silt, trash,~~
~~vegetation growth from existing culverts~~
~~and adjoining drainage structures within~~
~~project limits.~~

~~# STA. 80+67 # STA. 86+00~~
~~Clean, remove and dispose of silt, trash,~~
~~vegetation growth from existing culverts~~
~~and adjoining drainage structures within~~
~~project limits.~~

~~# STA. 85+50± RT. - # STA. 86+25± RT.~~
~~Reset existing guardrail posts (7 each)~~
~~Install RM-5 mounted on rail @ 25' o.c. (4 each)~~

CURVE DATA
Δ = 22°24'40"
R = 2864.79'
T = 567.53'
C = 1113.43'
Lc = 1120.56'
S. E. = 0.02 ft/ft

LEGEND FOR AS-BUILT POSTINGS	
	Squiggly line for as-built deletion
	Double line for as-built deletion
Roadway	Text for as-built posting

STATE OF HAWAII
DEPARTMENT OF TRANSPORTATION
HIGHWAYS DIVISION

ROADWAY PLAN

KAMEHAMEHA V HIGHWAY RESURFACING
Kaunakakai to Oneali Park
Project No. 450A-01-08M


Scale: 1" = 40' Date: October, 2007

SHEET No. 4 OF 8 SHEETS

ORIGINAL PLAN	SURVEY PLOTTED BY	DATE
NOTED BOOK	DRAWN BY	Aug. 00
DESIGNED BY	CHECKED BY	
CHECKED BY		


"AS-BUILT"

FED. ROAD DIST. NO.	STATE	PROJ. NO.	FISCAL YEAR	SHEET NO.	TOTAL SHEETS
HAWAII	HAW.	450A-01-08M	2008	12	25

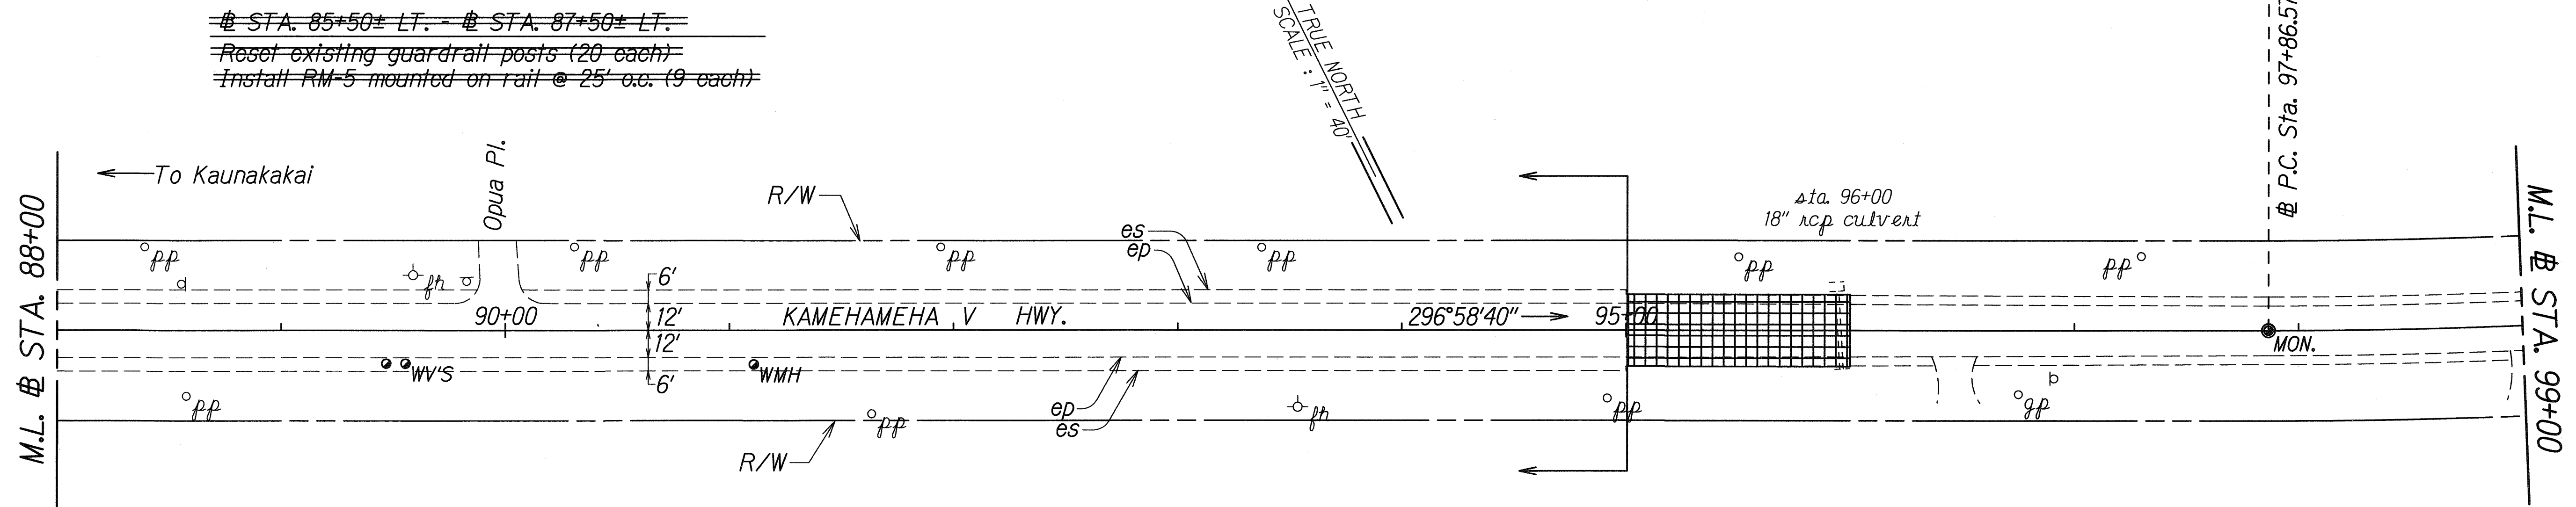

CURVE DATA
 $\Delta = 20^\circ 49' 00''$
 $R = 2864.79'$
 $T = 526.22'$
 $C = 1035.12'$
 $L_c = 1040.83'$
 $S. E. = 0.02 \text{ ft/ft}$

STA. 104+60± LT. - # STA. 106+90± LT.
 Remove existing end terminals and install Type FLEAT-350 (2 each).
 Reset existing guardrail posts (20 each).
 Install RM-5 mounted on rail @ 25' o.c. (9 each).

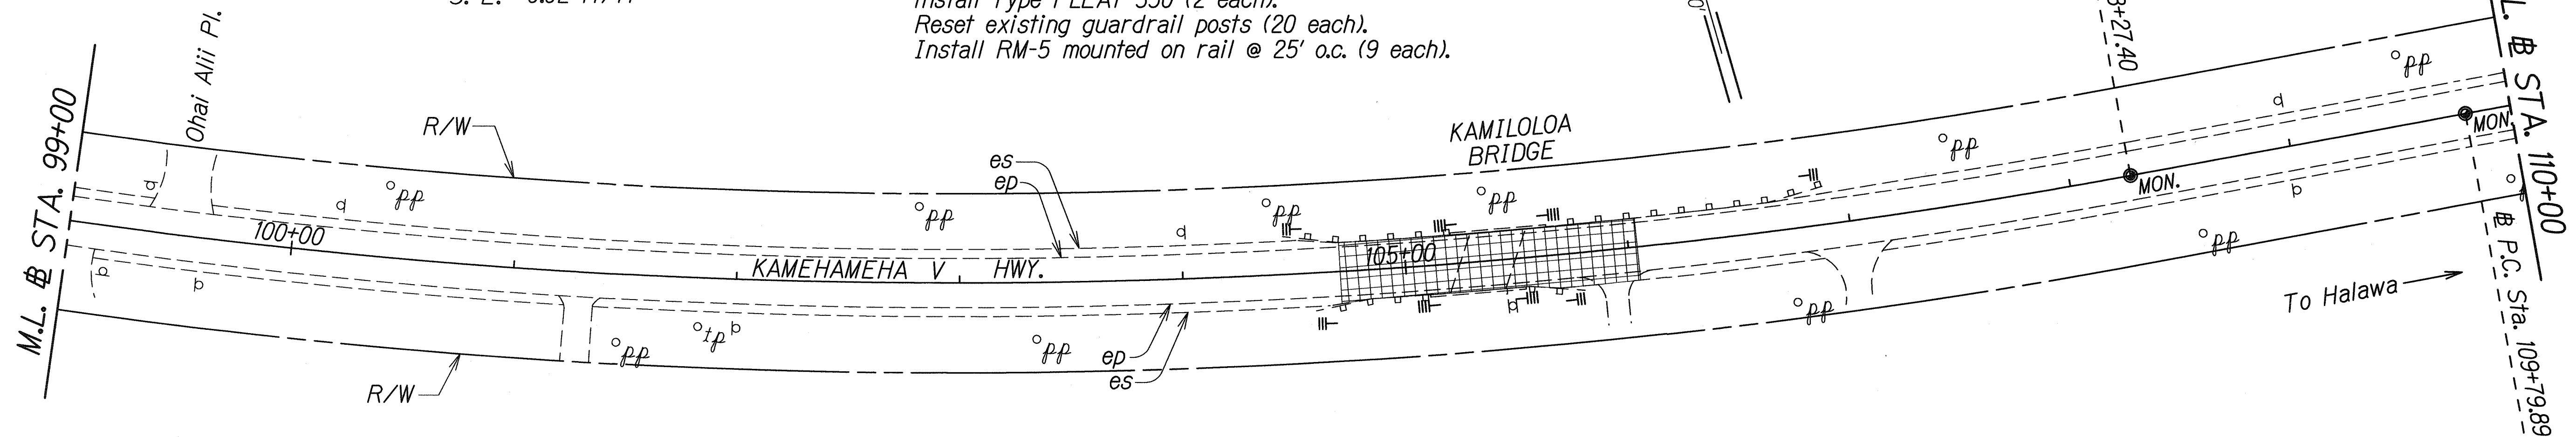

STA. 104+60± RT. - # STA. 105+80± RT.
 Remove existing end terminals and install Type FLEAT-350 (2 each).
 Reset existing guardrail posts (4 each).
 Install RM-5 mounted on rail @ 25' o.c. (5 each).

LEGEND FOR AS-BUILT POSTINGS	
	Squiggly line for as-built deletion
	Double line for as-built deletion
Roadway	Text for as-built posting

STATE OF HAWAII
 DEPARTMENT OF TRANSPORTATION
 HIGHWAYS DIVISION

ROADWAY PLAN

KAMEHAMEHA V HIGHWAY RESURFACING
 Kaunakakai to Oneali Park
 Project No. 450A-01-08M

Scale: 1" = 40' Date: October, 2007


SHEET No. 5 OF 8 SHEETS

ORIGINAL PLAN	DATE
NOTED BY	DATE
DESIGNED BY	DATE
CHECKED BY	DATE


"AS-BUILT"

12

FED. ROAD DIST. NO.	STATE	PROJ. NO.	FISCAL YEAR	SHEET NO.	TOTAL SHEETS
HAWAII	HAW.	450A-01-08M	2008	13	25

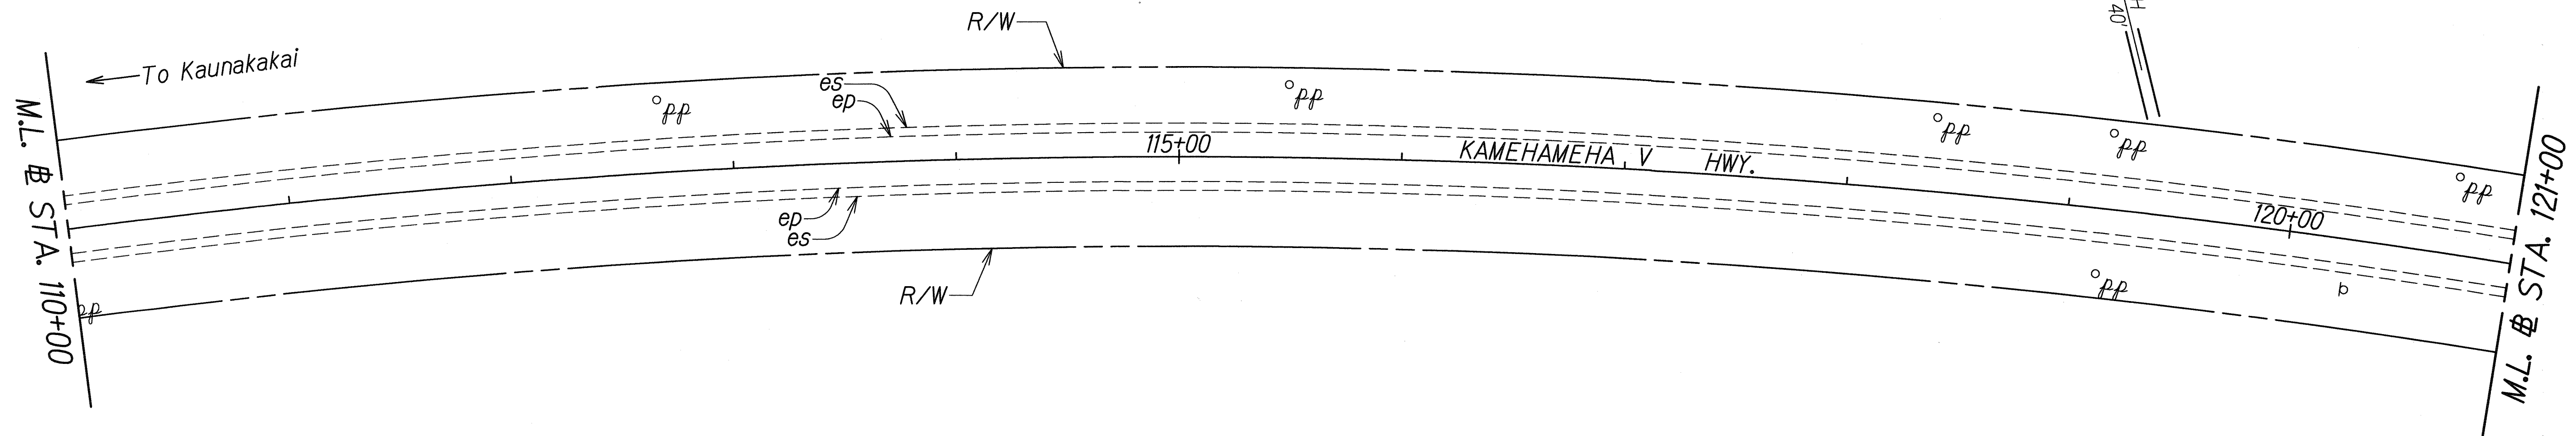

STA. 129+80± LT. - STA. 132+00± LT.
 Remove ~~end~~ approach terminal and
 install Type ~~FLAT-350 (1 each)~~ "G" (1 each).
 Reset existing guardrail posts (27 each).
 Install RM-5 mounted on rail @ 25' o.c. (10 each).

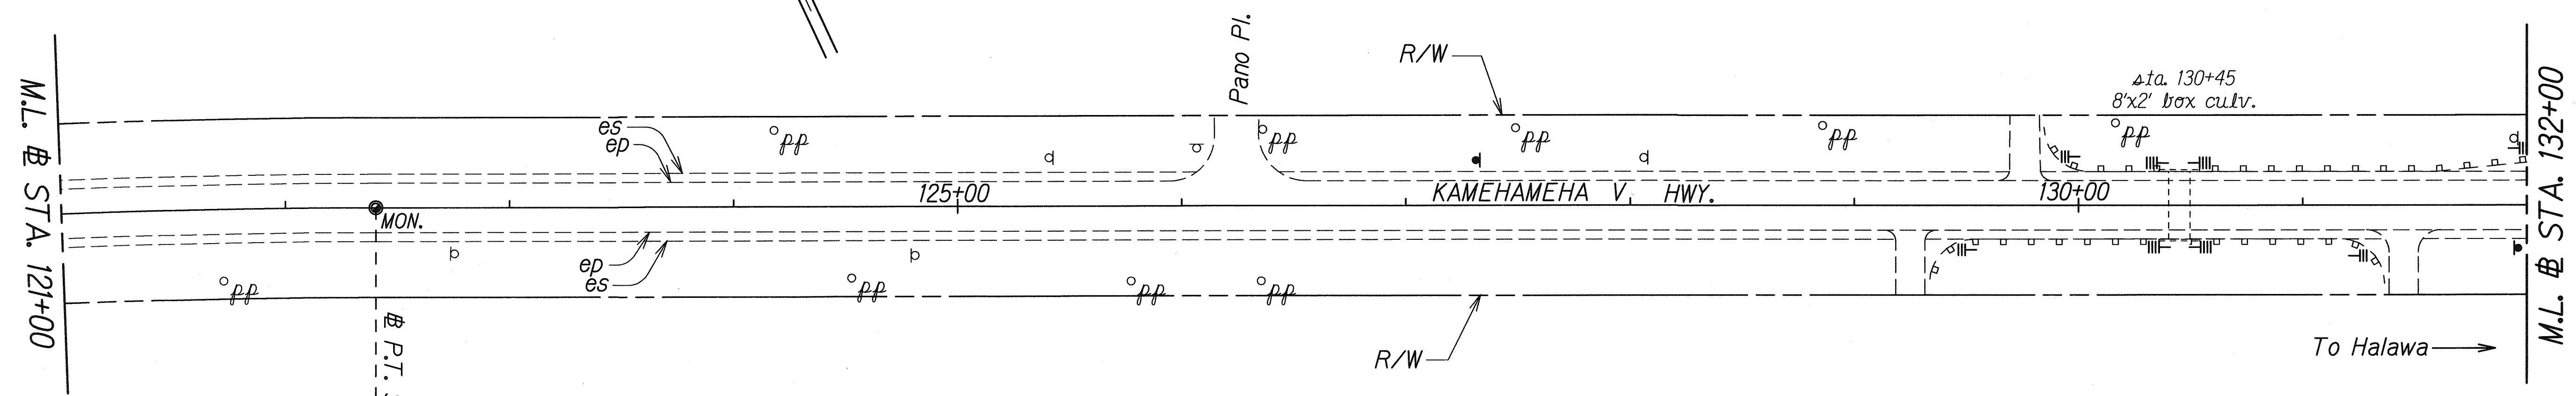

STA. 129+25± RT. - STA. 131+45± RT.
 Reset existing guardrail posts (36 each).
 Install RM-5 mounted on rail @ 25' o.c. (10 each).


LEGEND FOR AS-BUILT POSTINGS	
	Squiggly line for as-built deletion
	Double line for as-built deletion
Roadway	Text for as-built posting

STATE OF HAWAII
 DEPARTMENT OF TRANSPORTATION
 HIGHWAYS DIVISION

ROADWAY PLAN
 KAMEHAMEHA V HIGHWAY RESURFACING
 Kaunakakai to Onealii Park
 Project No. 450A-01-08M
 Scale: 1" = 40' Date: October, 2007

ORIGINAL PLAN	SURVEY PLOTTED BY	DATE
NOTE BOOK	DRAWN BY	10/20/07
FILED BY	TRACED BY	
REVIEWED BY	CHECKED BY	
APPROVED BY		

FED. ROAD DIST. NO.	STATE	PROJ. NO.	FISCAL YEAR	SHEET NO.	TOTAL SHEETS
HAWAII	HAW.	450A-01-08M	2008	ADD.14	25

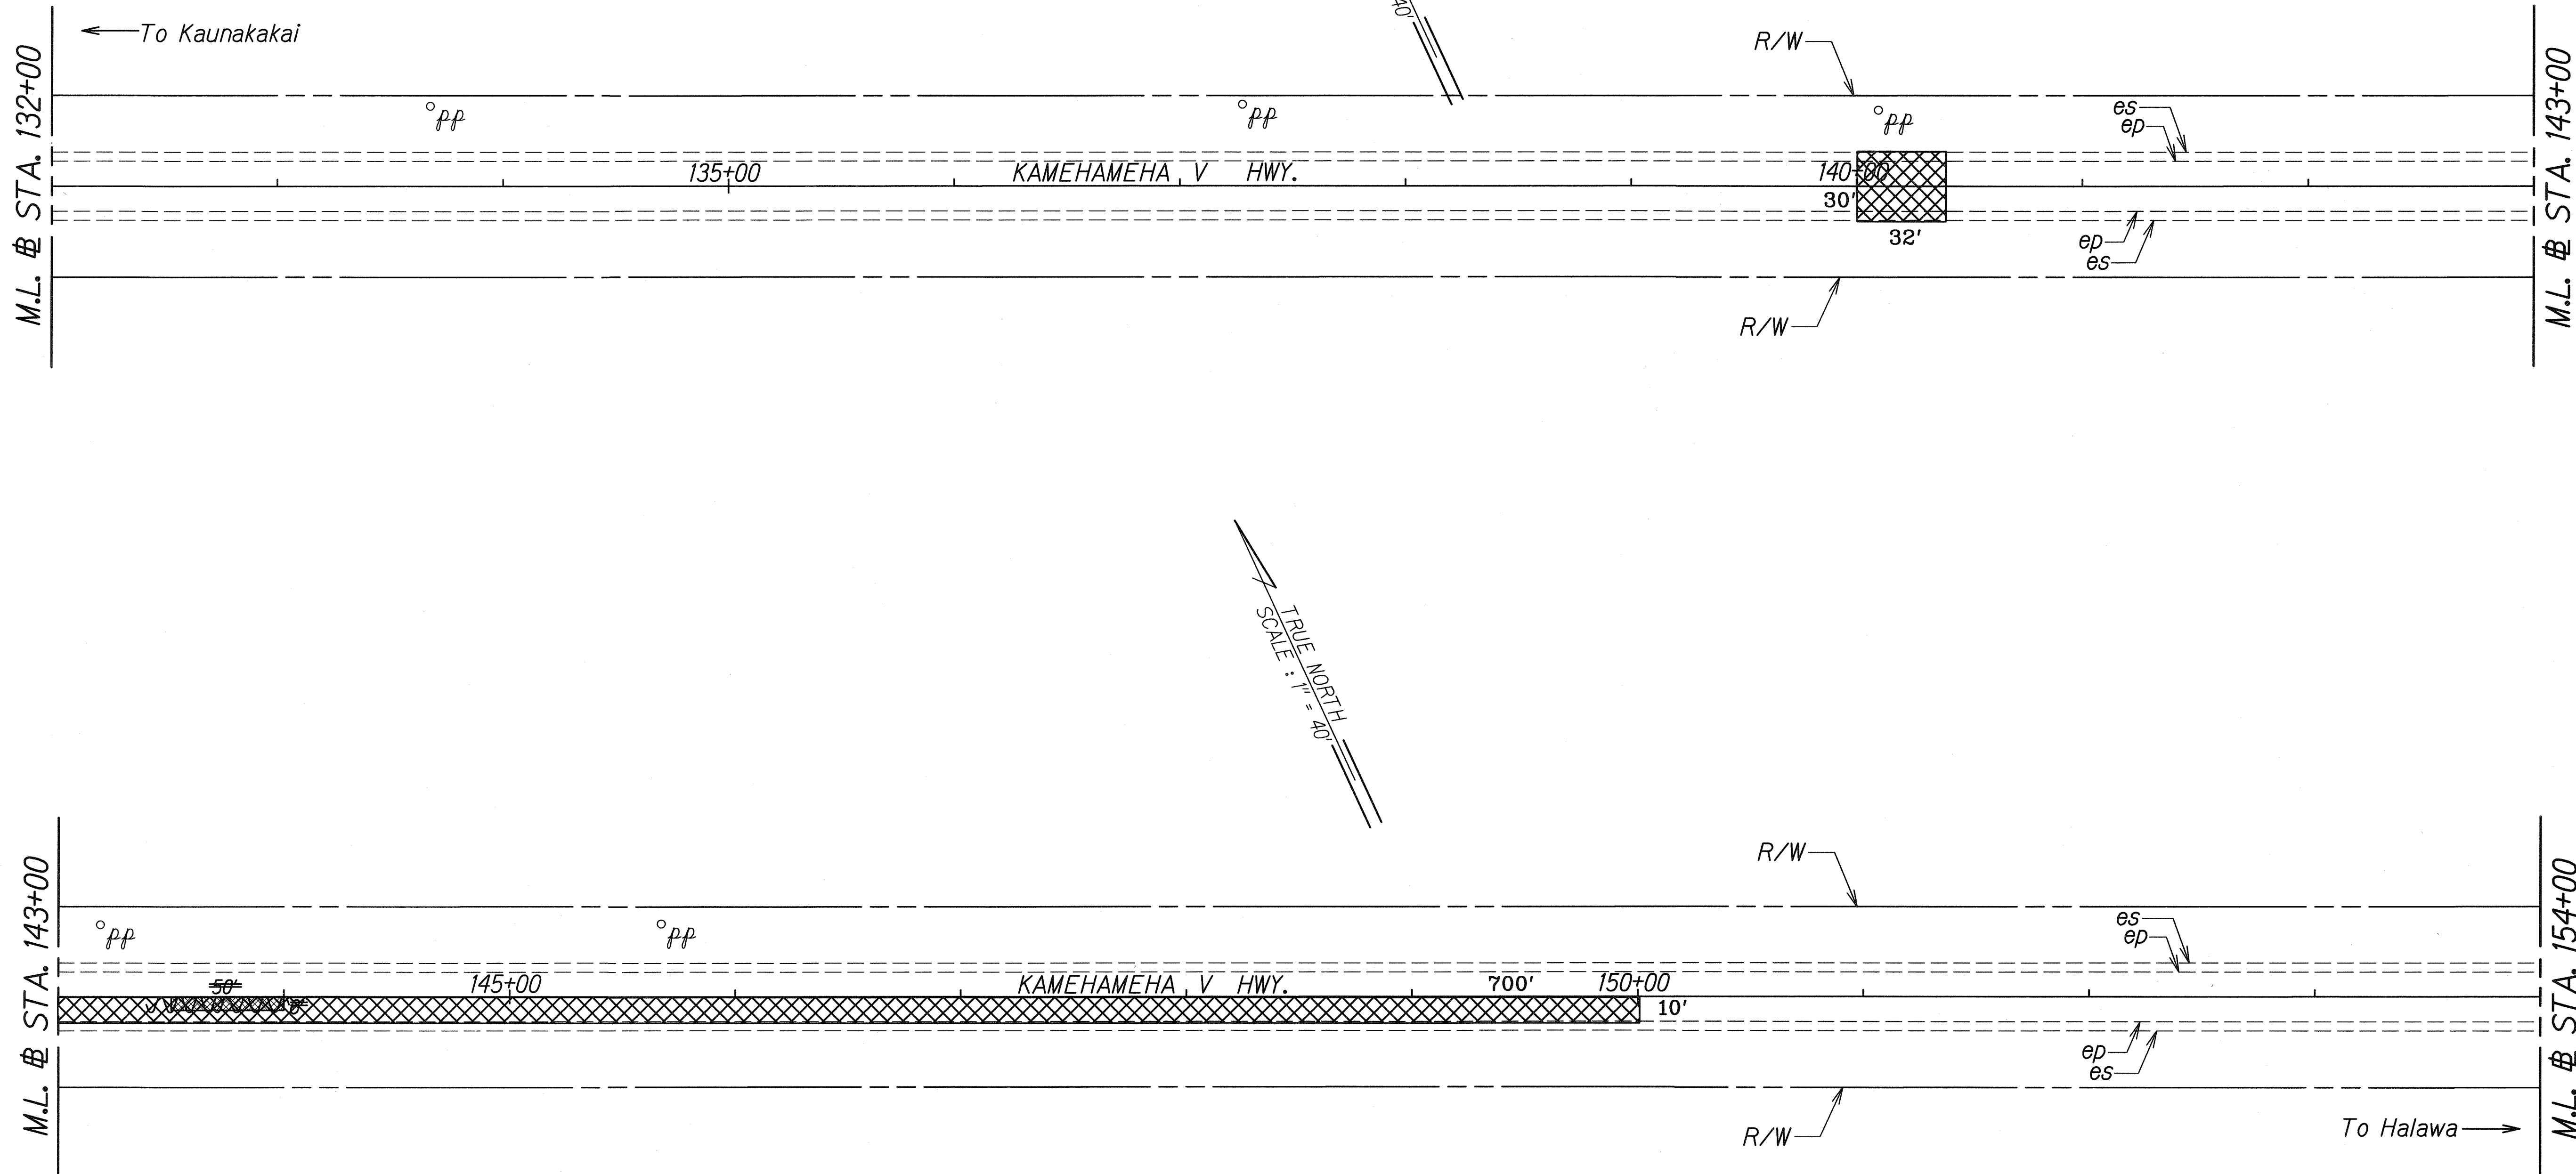

ORIGINAL PLAN	SURVEY PLOTTED BY	DATE
NOTED WORK	DRAWN BY	10/07
DESIGNED BY	DESIGNED BY	
CHECKED BY	CHECKED BY	

LEGEND FOR AS-BUILT POSTINGS	
	Squiggly line for as-built deletion
	Double line for as-built deletion
Roadway	Text for as-built posting

4-18-08 Add location of Reconstruction Area.


DATE REVISION

STATE OF HAWAII DEPARTMENT OF TRANSPORTATION HIGHWAYS DIVISION
ROADWAY PLAN
KAMEHAMEHA V HIGHWAY RESURFACING Kaunakakai to Oneali Park Project No. 450A-01-08M
Scale: 1" = 40' Date: October, 2007
SHEET No. 7 OF 8 SHEETS

"AS-BUILT"

ADD.14

FED. ROAD DIST. NO.	STATE	PROJ. NO.	FISCAL YEAR	SHEET NO.	TOTAL SHEETS
HAWAII	HAW.	450A-01-08M	2008	ADD.15	25

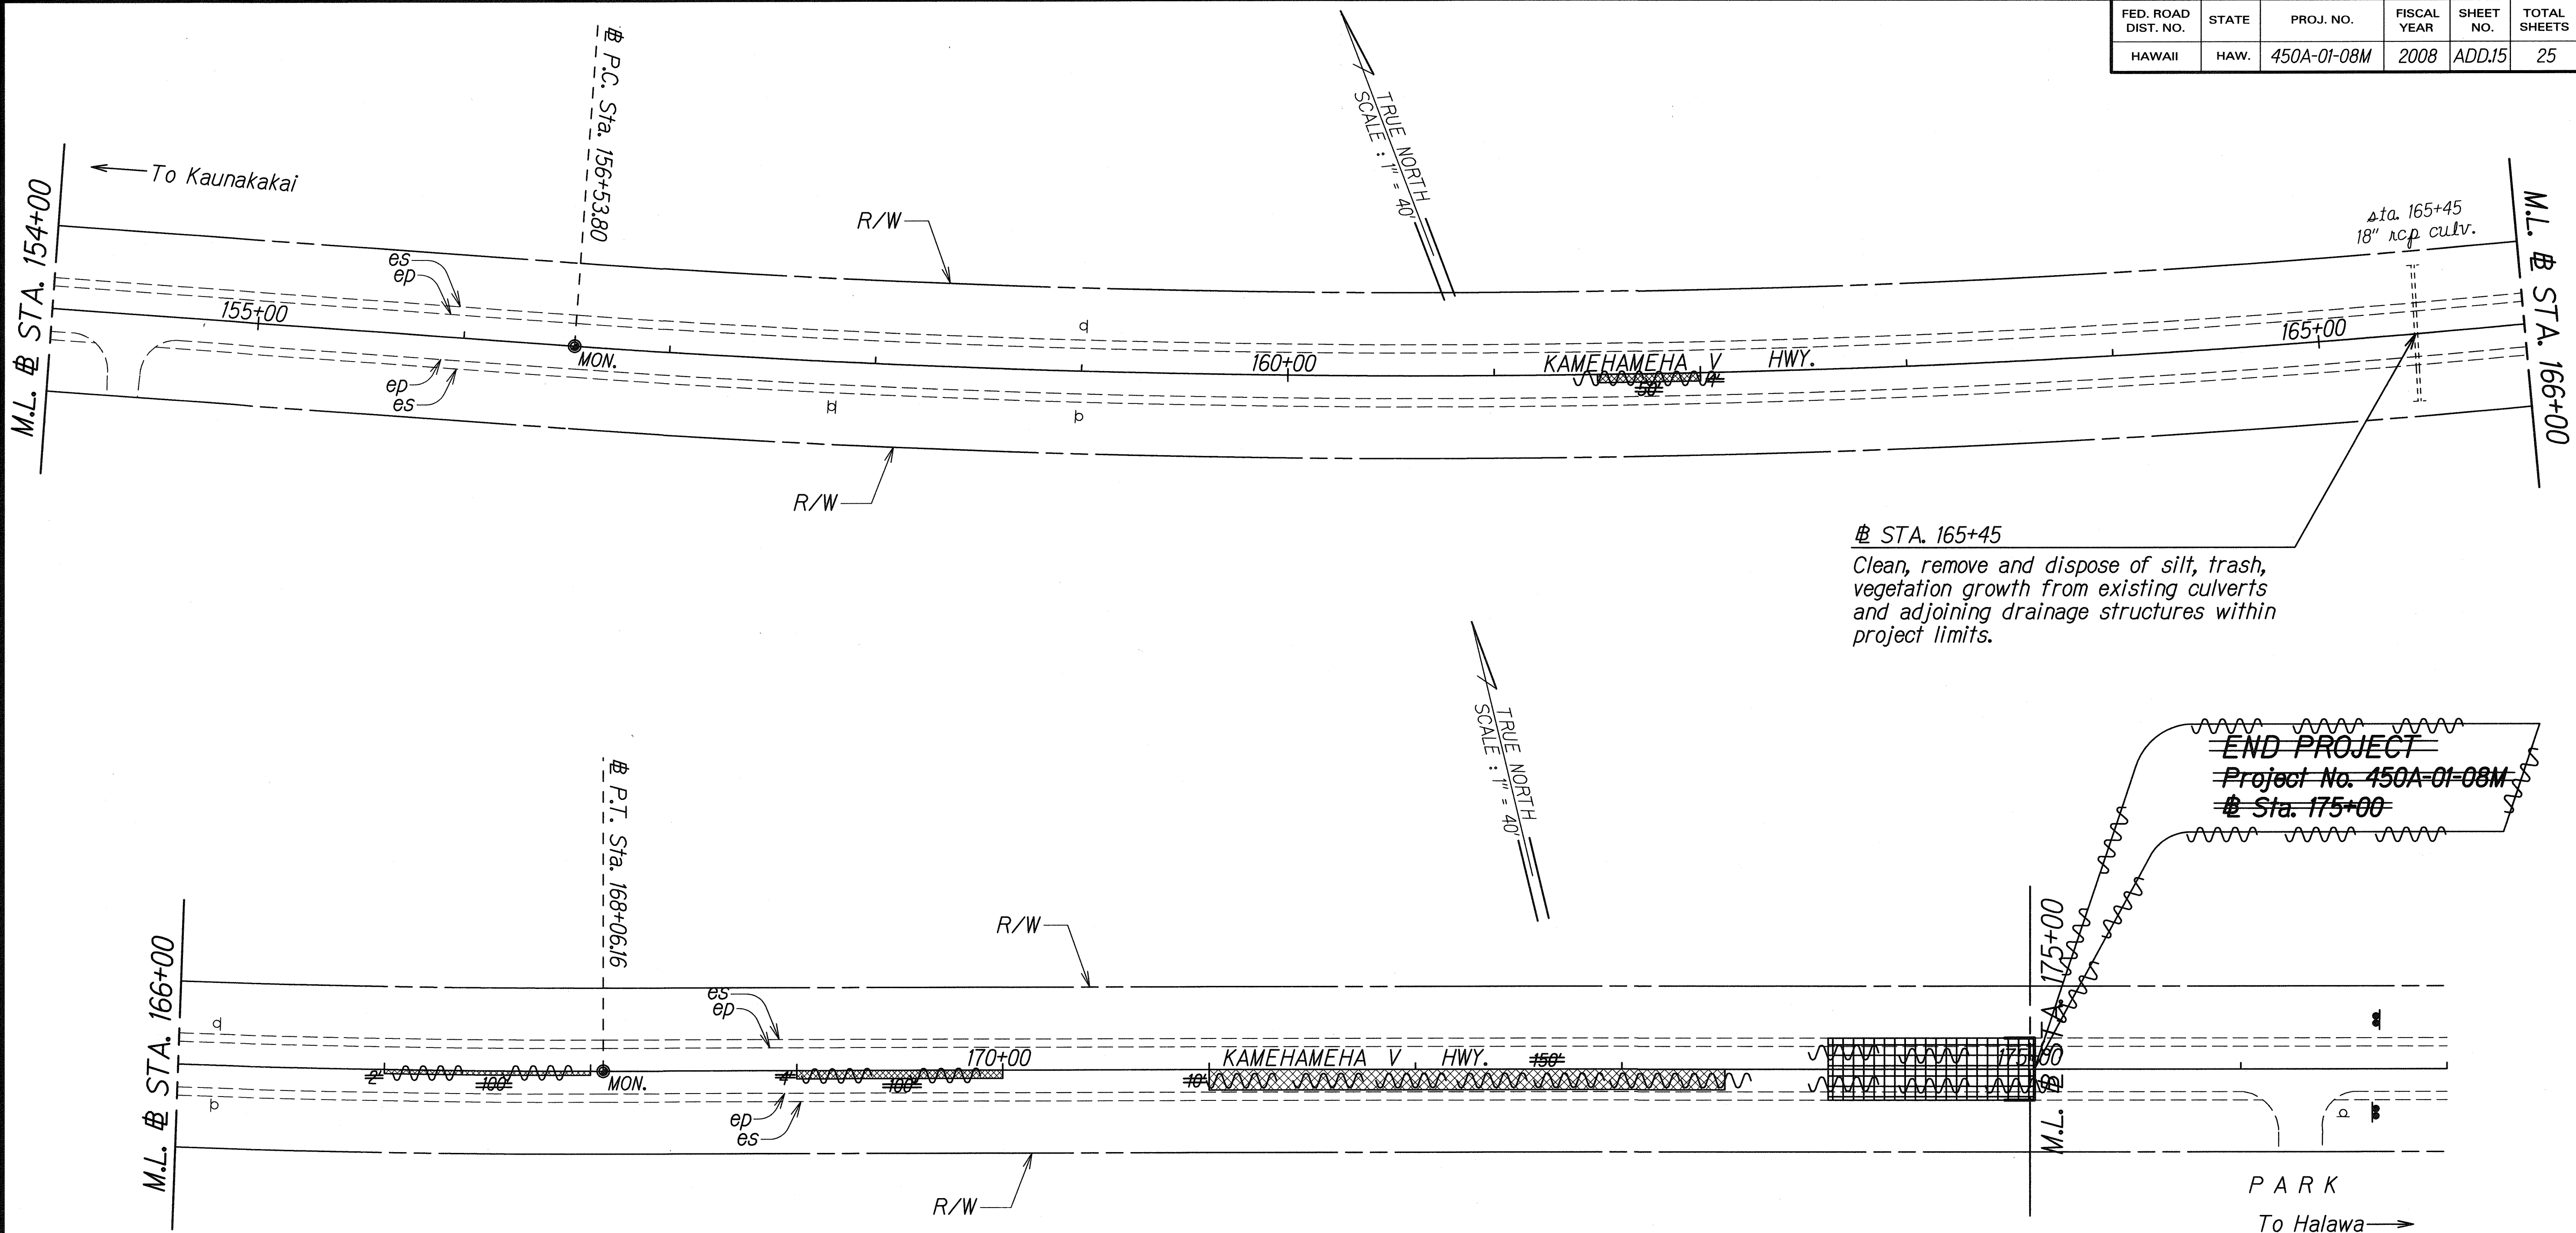

ORIGINAL PLAN	SURVEY PLOTTED BY	DATE
NOTE BOOK	DRAWN BY	10/20/07
DESIGNED BY	CHECKED BY	
DESIGNED BY	CHECKED BY	
DESIGNED BY	CHECKED BY	

LEGEND FOR AS-BUILT POSTINGS	
	Squiggly line for as-built deletion
	Double line for as-built deletion
Roadway	Text for as-built posting

4-18-08	Add location of Reconstruction Area.
---------	--------------------------------------


DATE	REVISION
------	----------

STATE OF HAWAII DEPARTMENT OF TRANSPORTATION HIGHWAYS DIVISION	
ROADWAY PLAN	
KAMEHAMEHA V HIGHWAY RESURFACING	
Kaunakakai to Onealii Park	
Project No. 450A-01-08M	
Scale: 1" = 40'	Date: October, 2007
SHEET No. 8 OF 8 SHEETS	

"AS-BUILT"

ADD.15

FED. ROAD DIST. NO.	STATE	PROJ. NO.	FISCAL YEAR	SHEET NO.	TOTAL SHEETS
HAWAII	HAW.	450A-01-08M	2008	15S-1	25

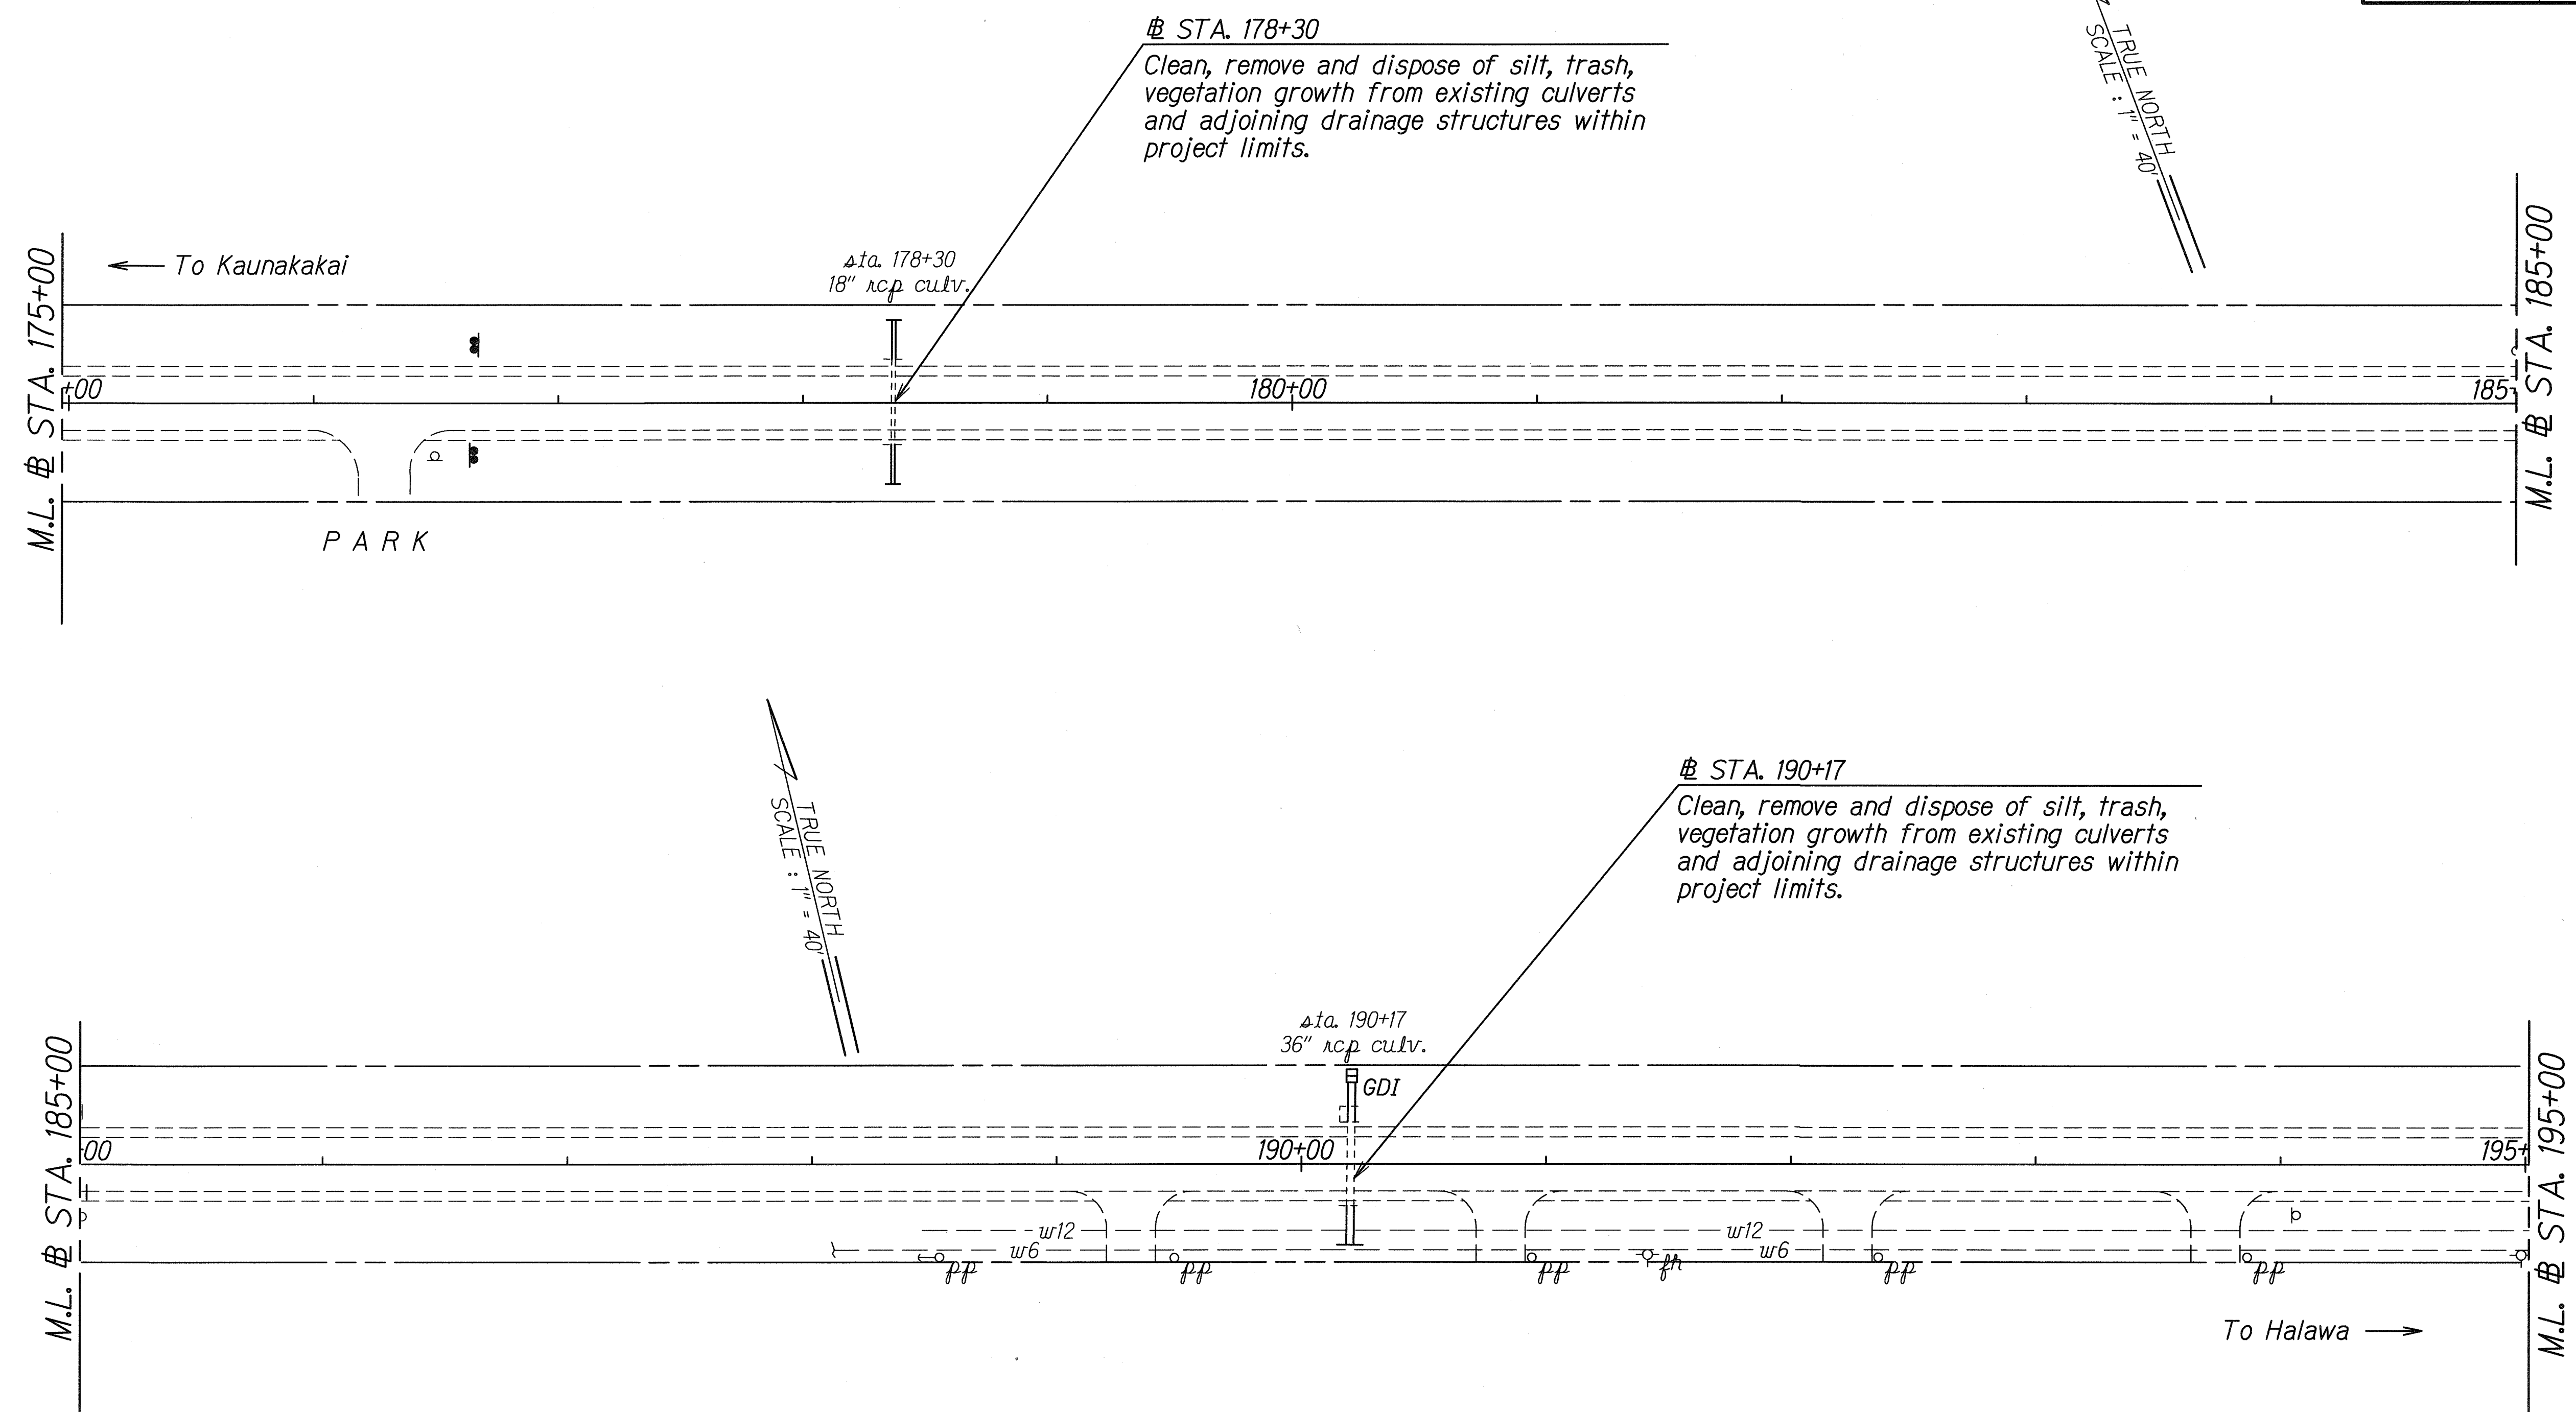

ORIGINAL PLAN	SURVEY PLOTTED BY	DATE
NOTE BOOK	DRAWN BY	10/07
DESIGNED BY	TRACED BY	
CHECKED BY	DESIGNED BY	
	CHECKED BY	


Note: This tracing prepared during "AS-BUILT" posting.

STATE OF HAWAII DEPARTMENT OF TRANSPORTATION HIGHWAYS DIVISION	
ROADWAY PLAN	
KAMEHAMEHA V HIGHWAY RESURFACING	
Kaunakakai to Oneali Park	
Project No. 450A-01-08M	
Scale: 1" = 40'	Date: October, 2007
SHEET No. 1 OF 2 SHEETS	

"AS-BUILT"

15 S-1

FED. ROAD DIST. NO.	STATE	PROJ. NO.	FISCAL YEAR	SHEET NO.	TOTAL SHEETS
HAWAII	HAW.	450A-01-08M	2008	15 S-2	25

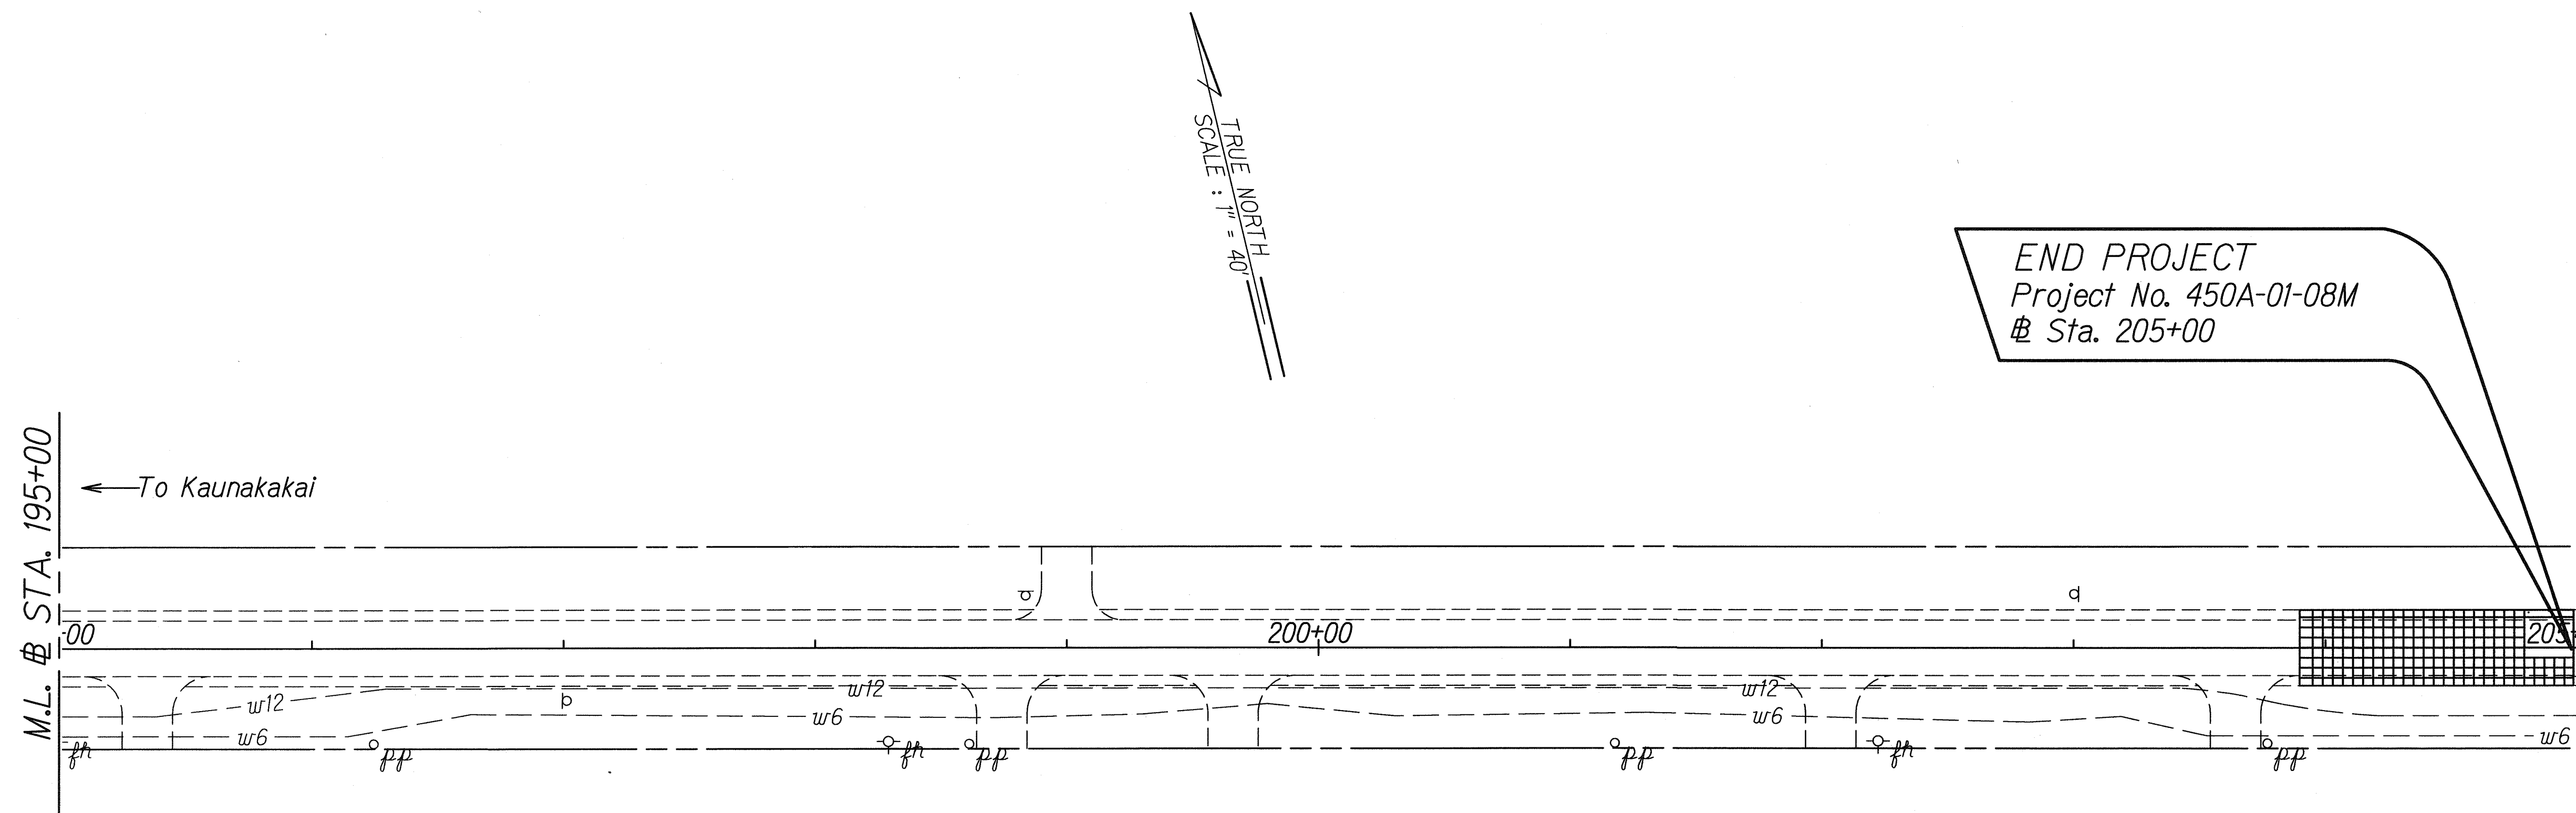

ORIGINAL PLAN	SURVEY PLOTTED BY	DATE
NOTE BOOK	DRAWN BY	10/20/07
DESIGNED BY	TRACED BY	
CHECKED BY	DESIGNED BY	
	CHECKED BY	

Note: This tracing prepared during "AS-BUILT" posting.

STATE OF HAWAII DEPARTMENT OF TRANSPORTATION HIGHWAYS DIVISION	
ROADWAY PLAN	
KAMEHAMEHA V HIGHWAY RESURFACING	
Kaunakakai to Onealii Park	
Project No. 450A-01-08M	
Scale: 1" = 40'	Date: October, 2007
SHEET No. 2 OF 2 SHEETS	

"AS-BUILT"

15 S-2