

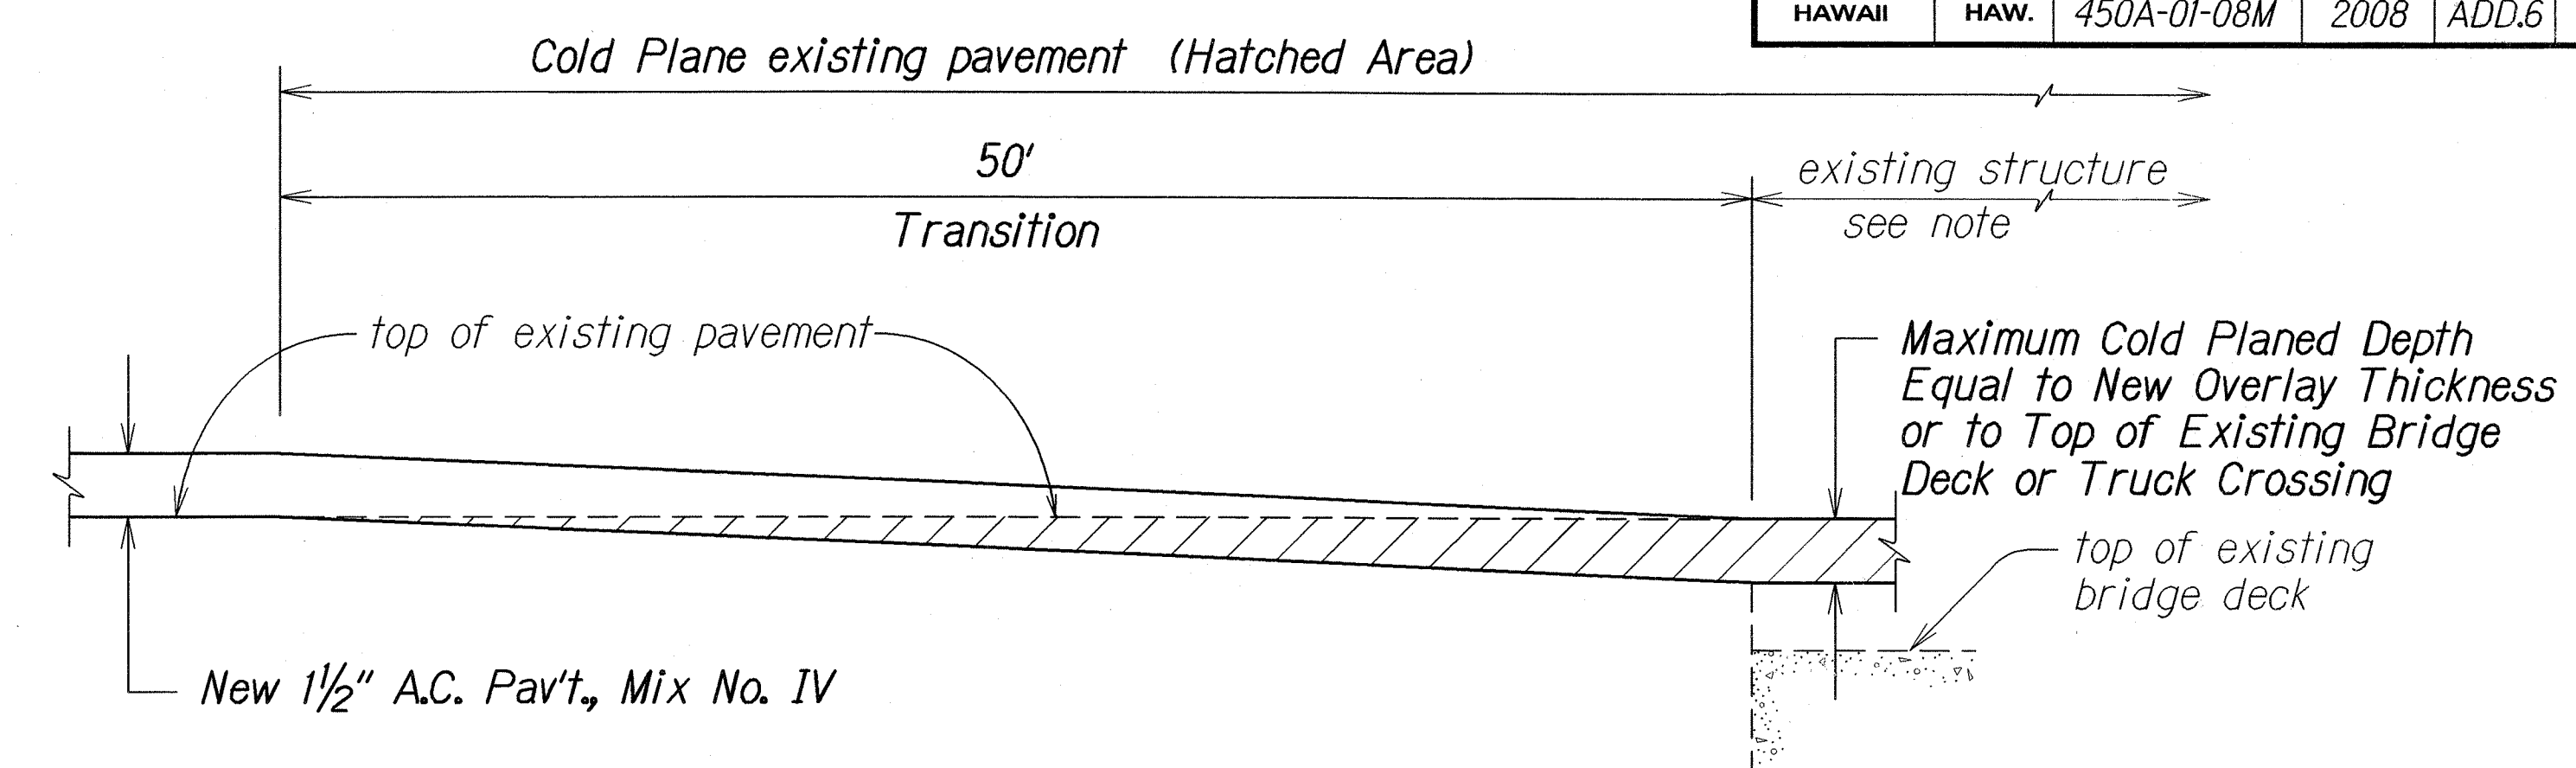
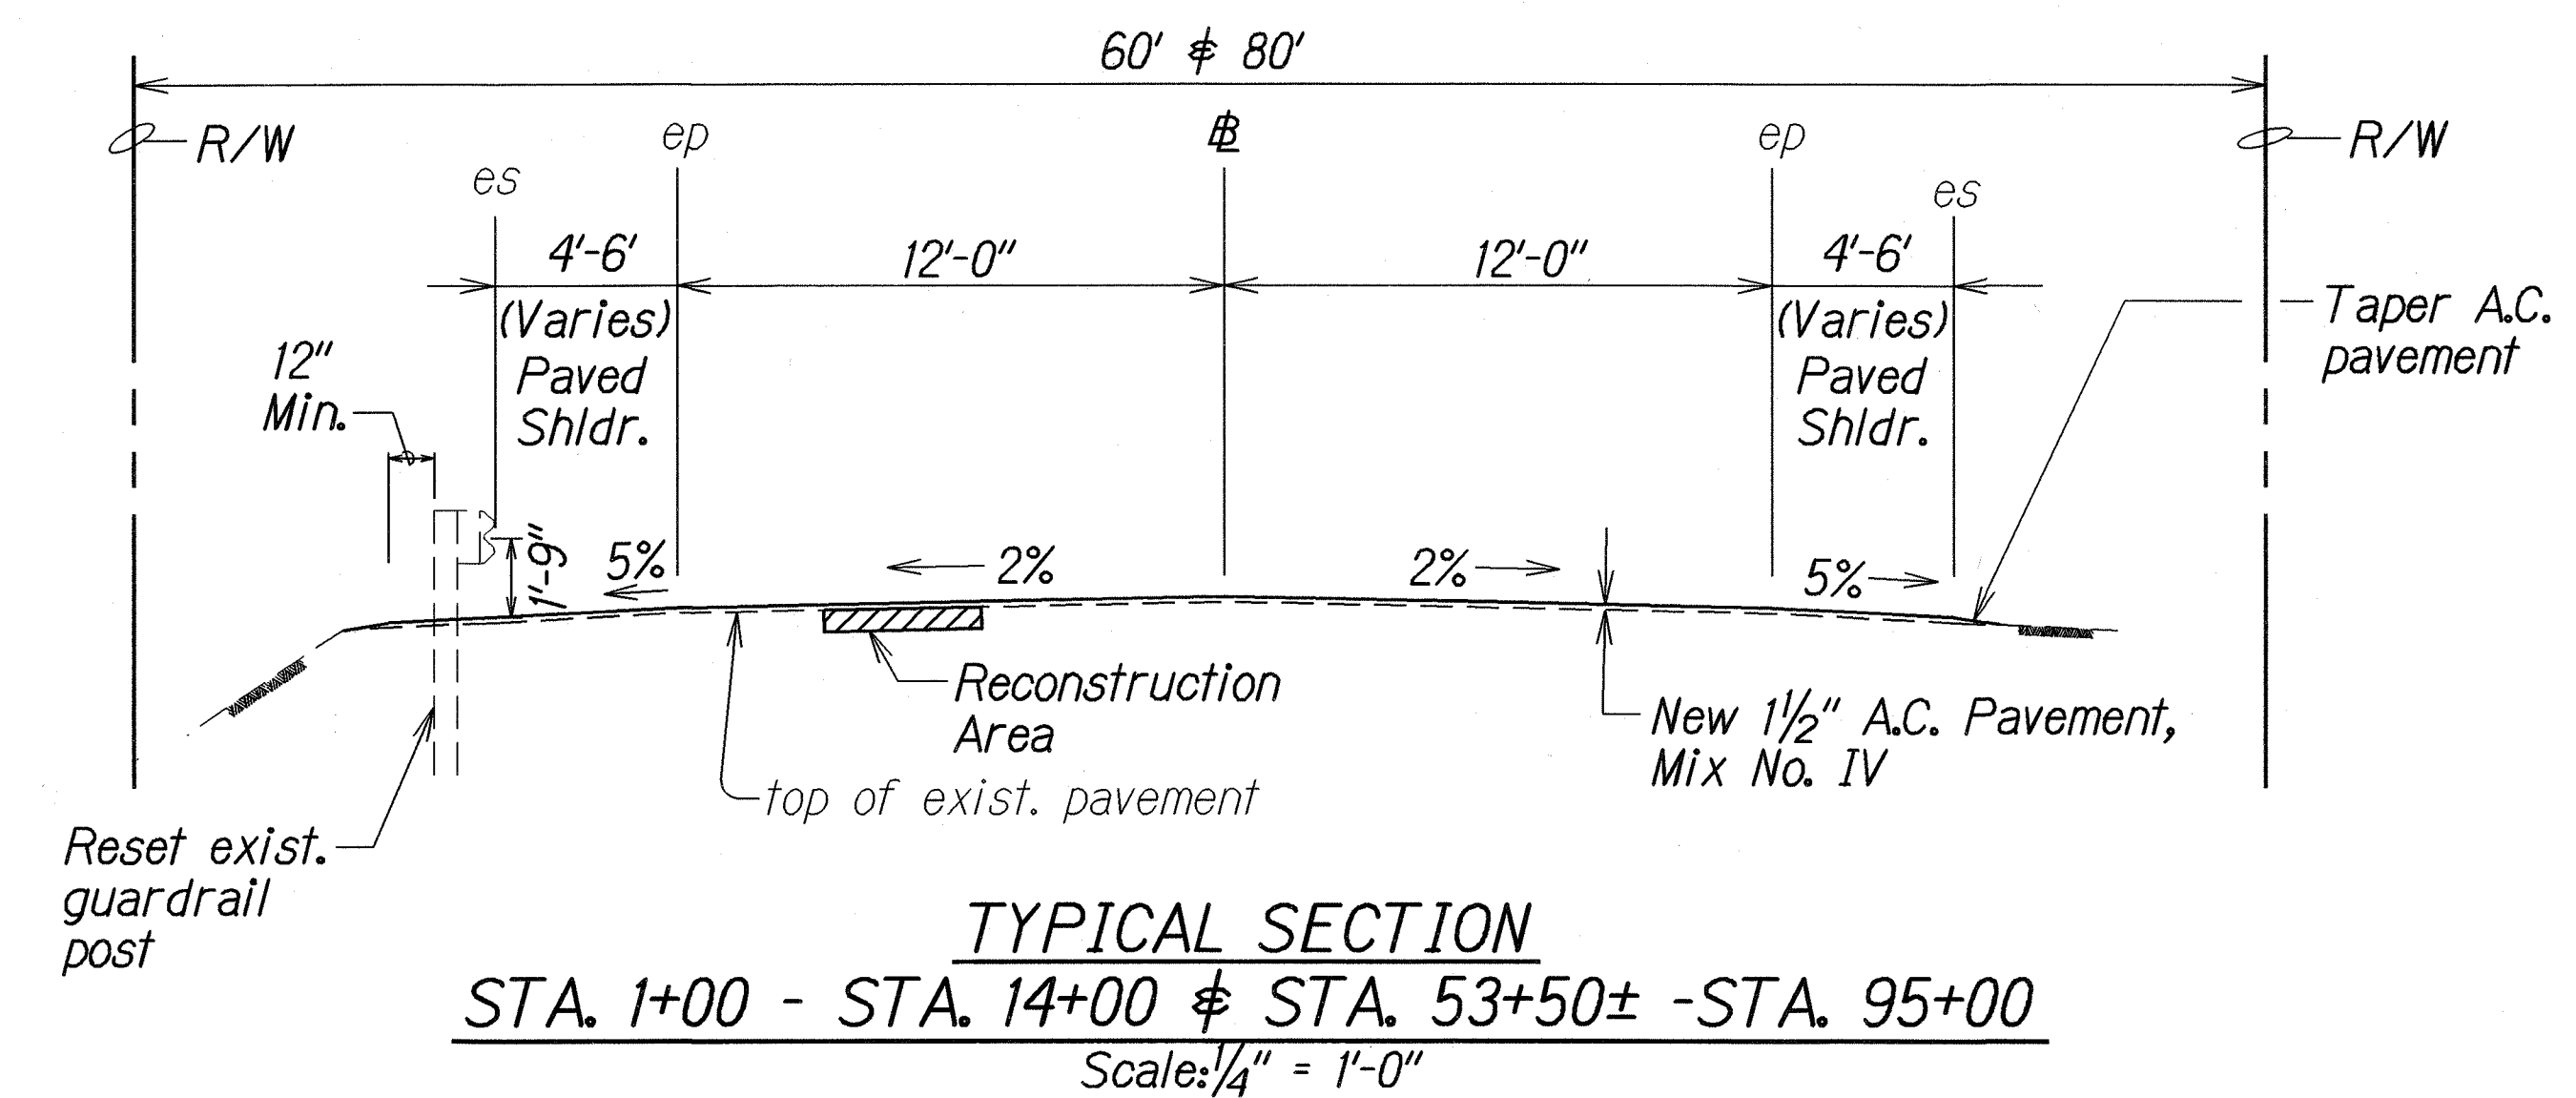
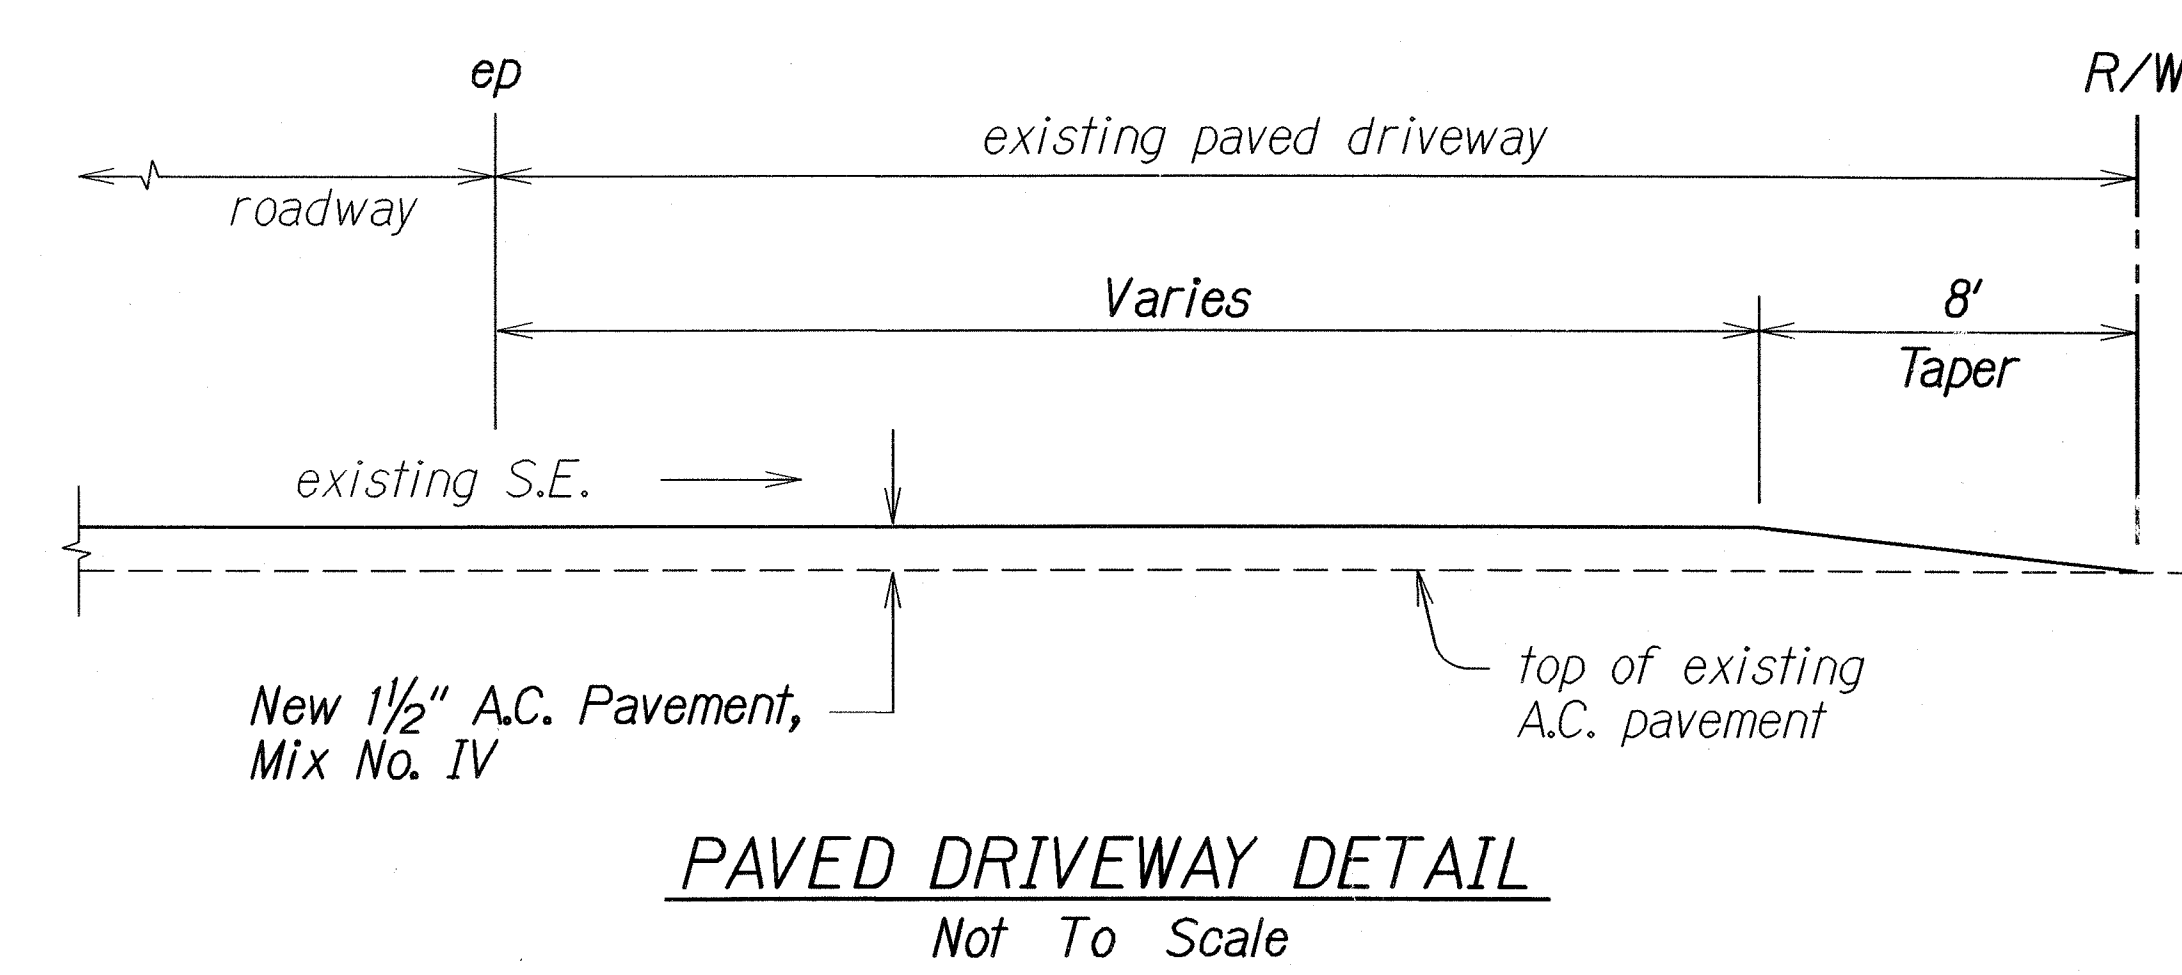
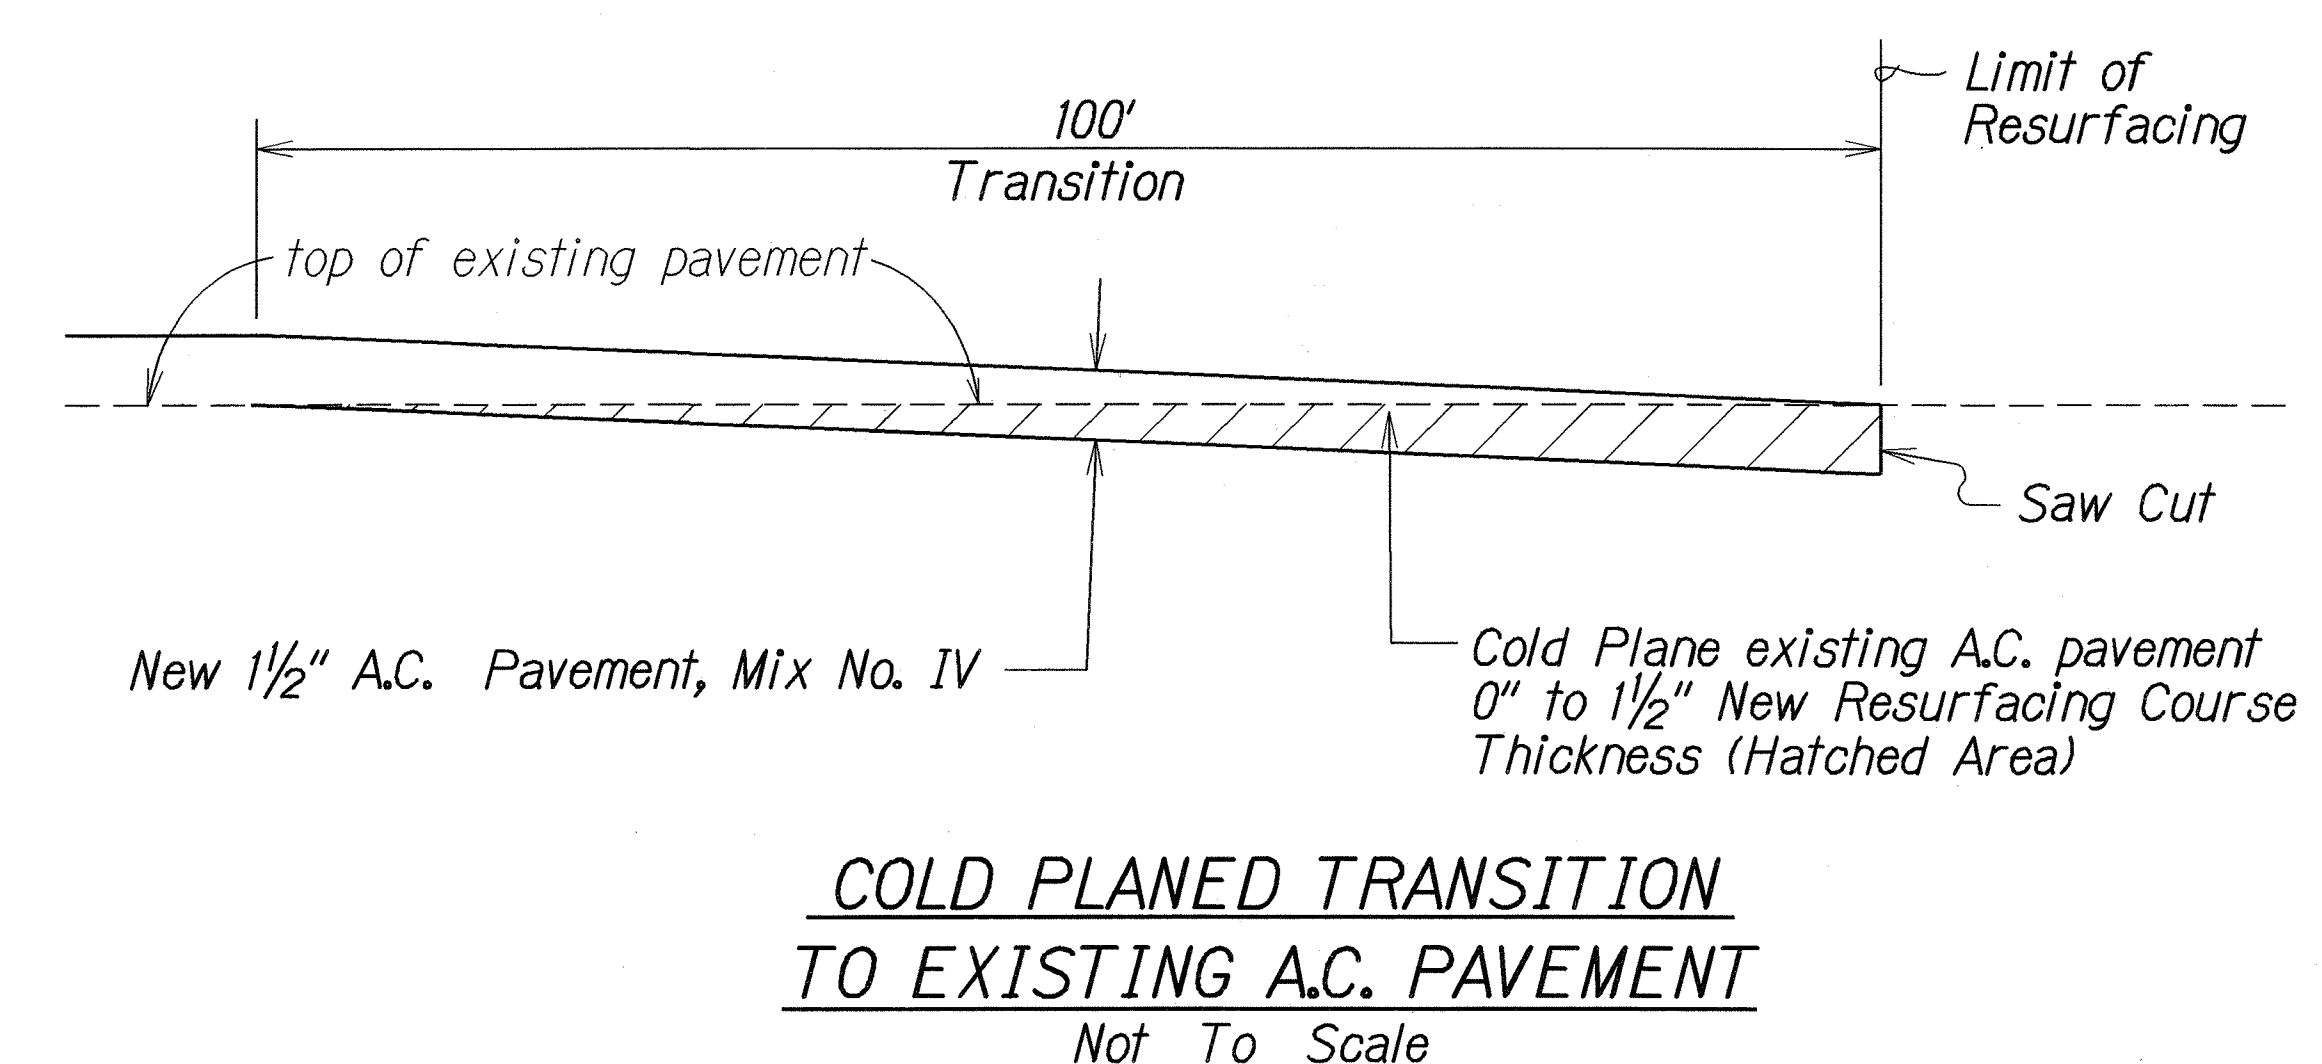


FED. ROAD DIST. NO.	STATE	PROJ. NO.	FISCAL YEAR	SHEET NO.	TOTAL SHEETS
HAWAII	HAW.	450A-01-08M	2008	ADD.6	25

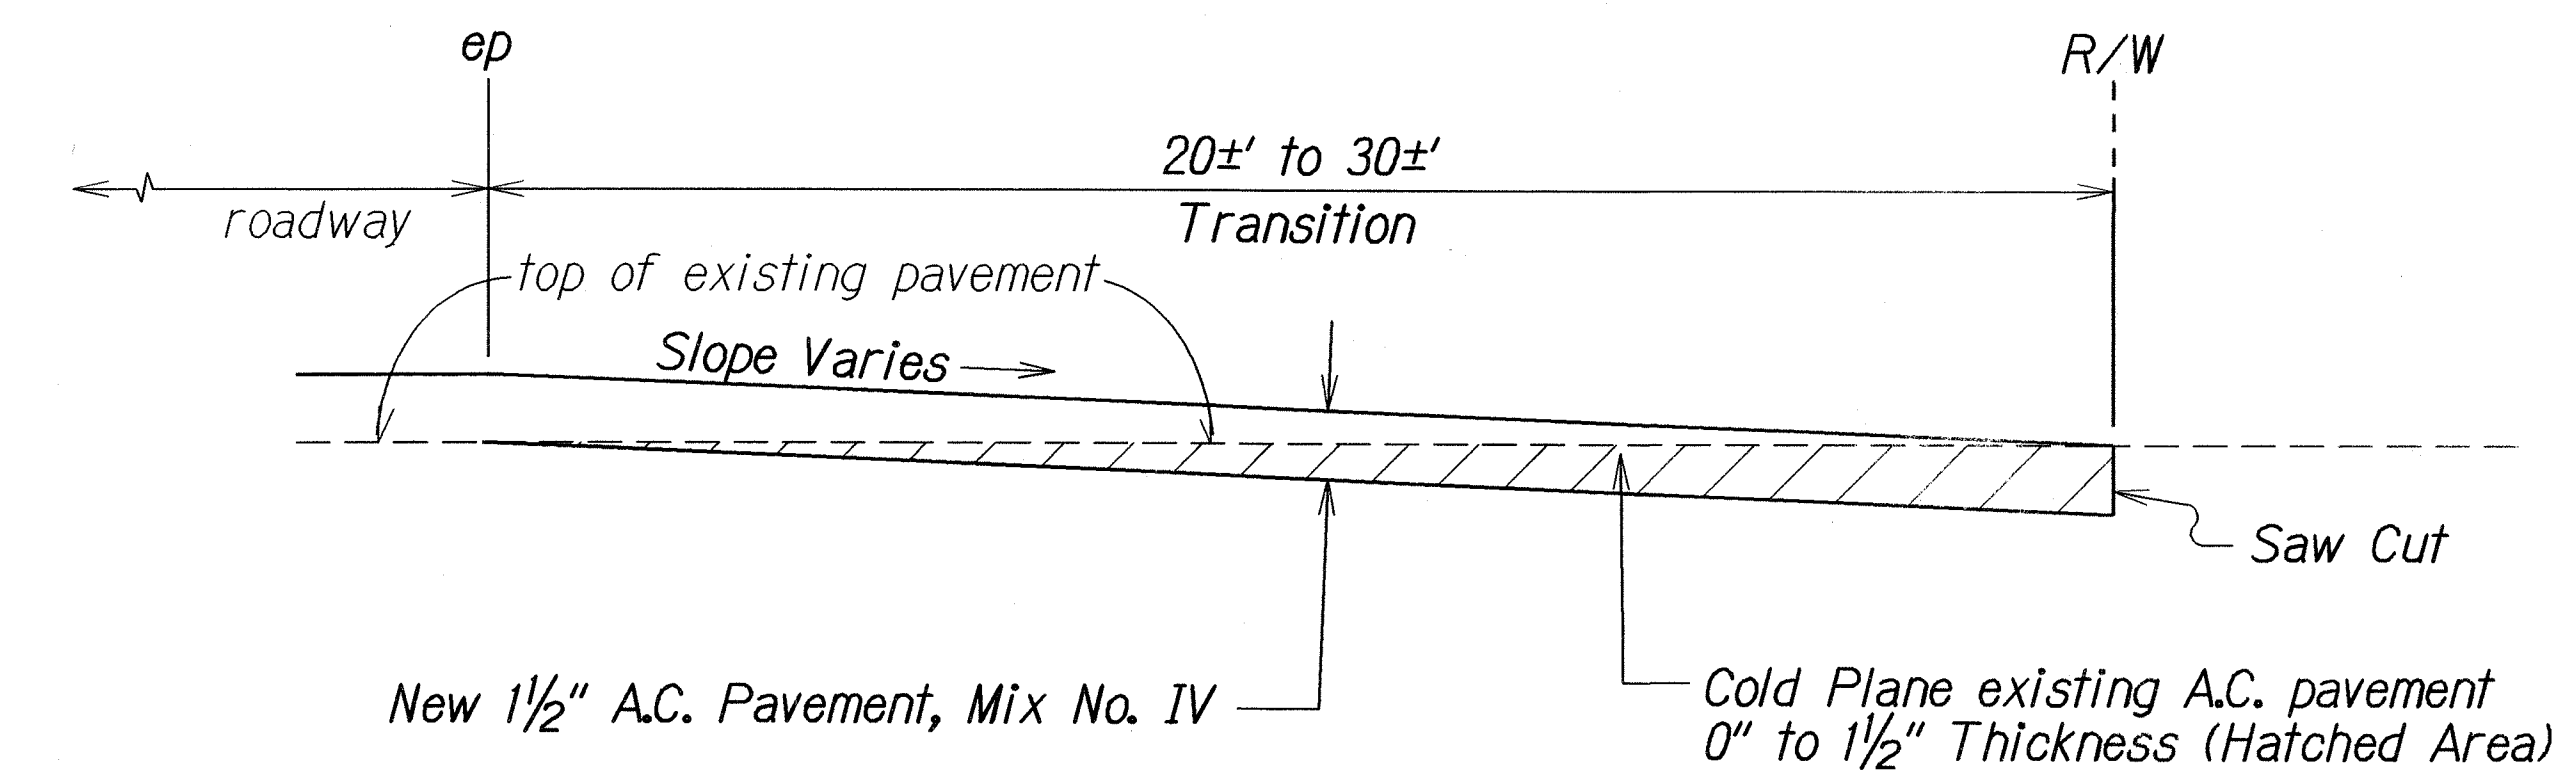


Note: In cold planing the pavement over the structure, the Contractor shall exercise care not to damage any portion of the structure, especially the slab, joints, drainage pipes or reinforcement. Any damage to the structure during the cold planing operations shall be repaired by the Contractor at his expense. Repair work shall be directed by the Engineer. The Contractor shall verify the thickness of the pavement by taking several measurements throughout the structure.

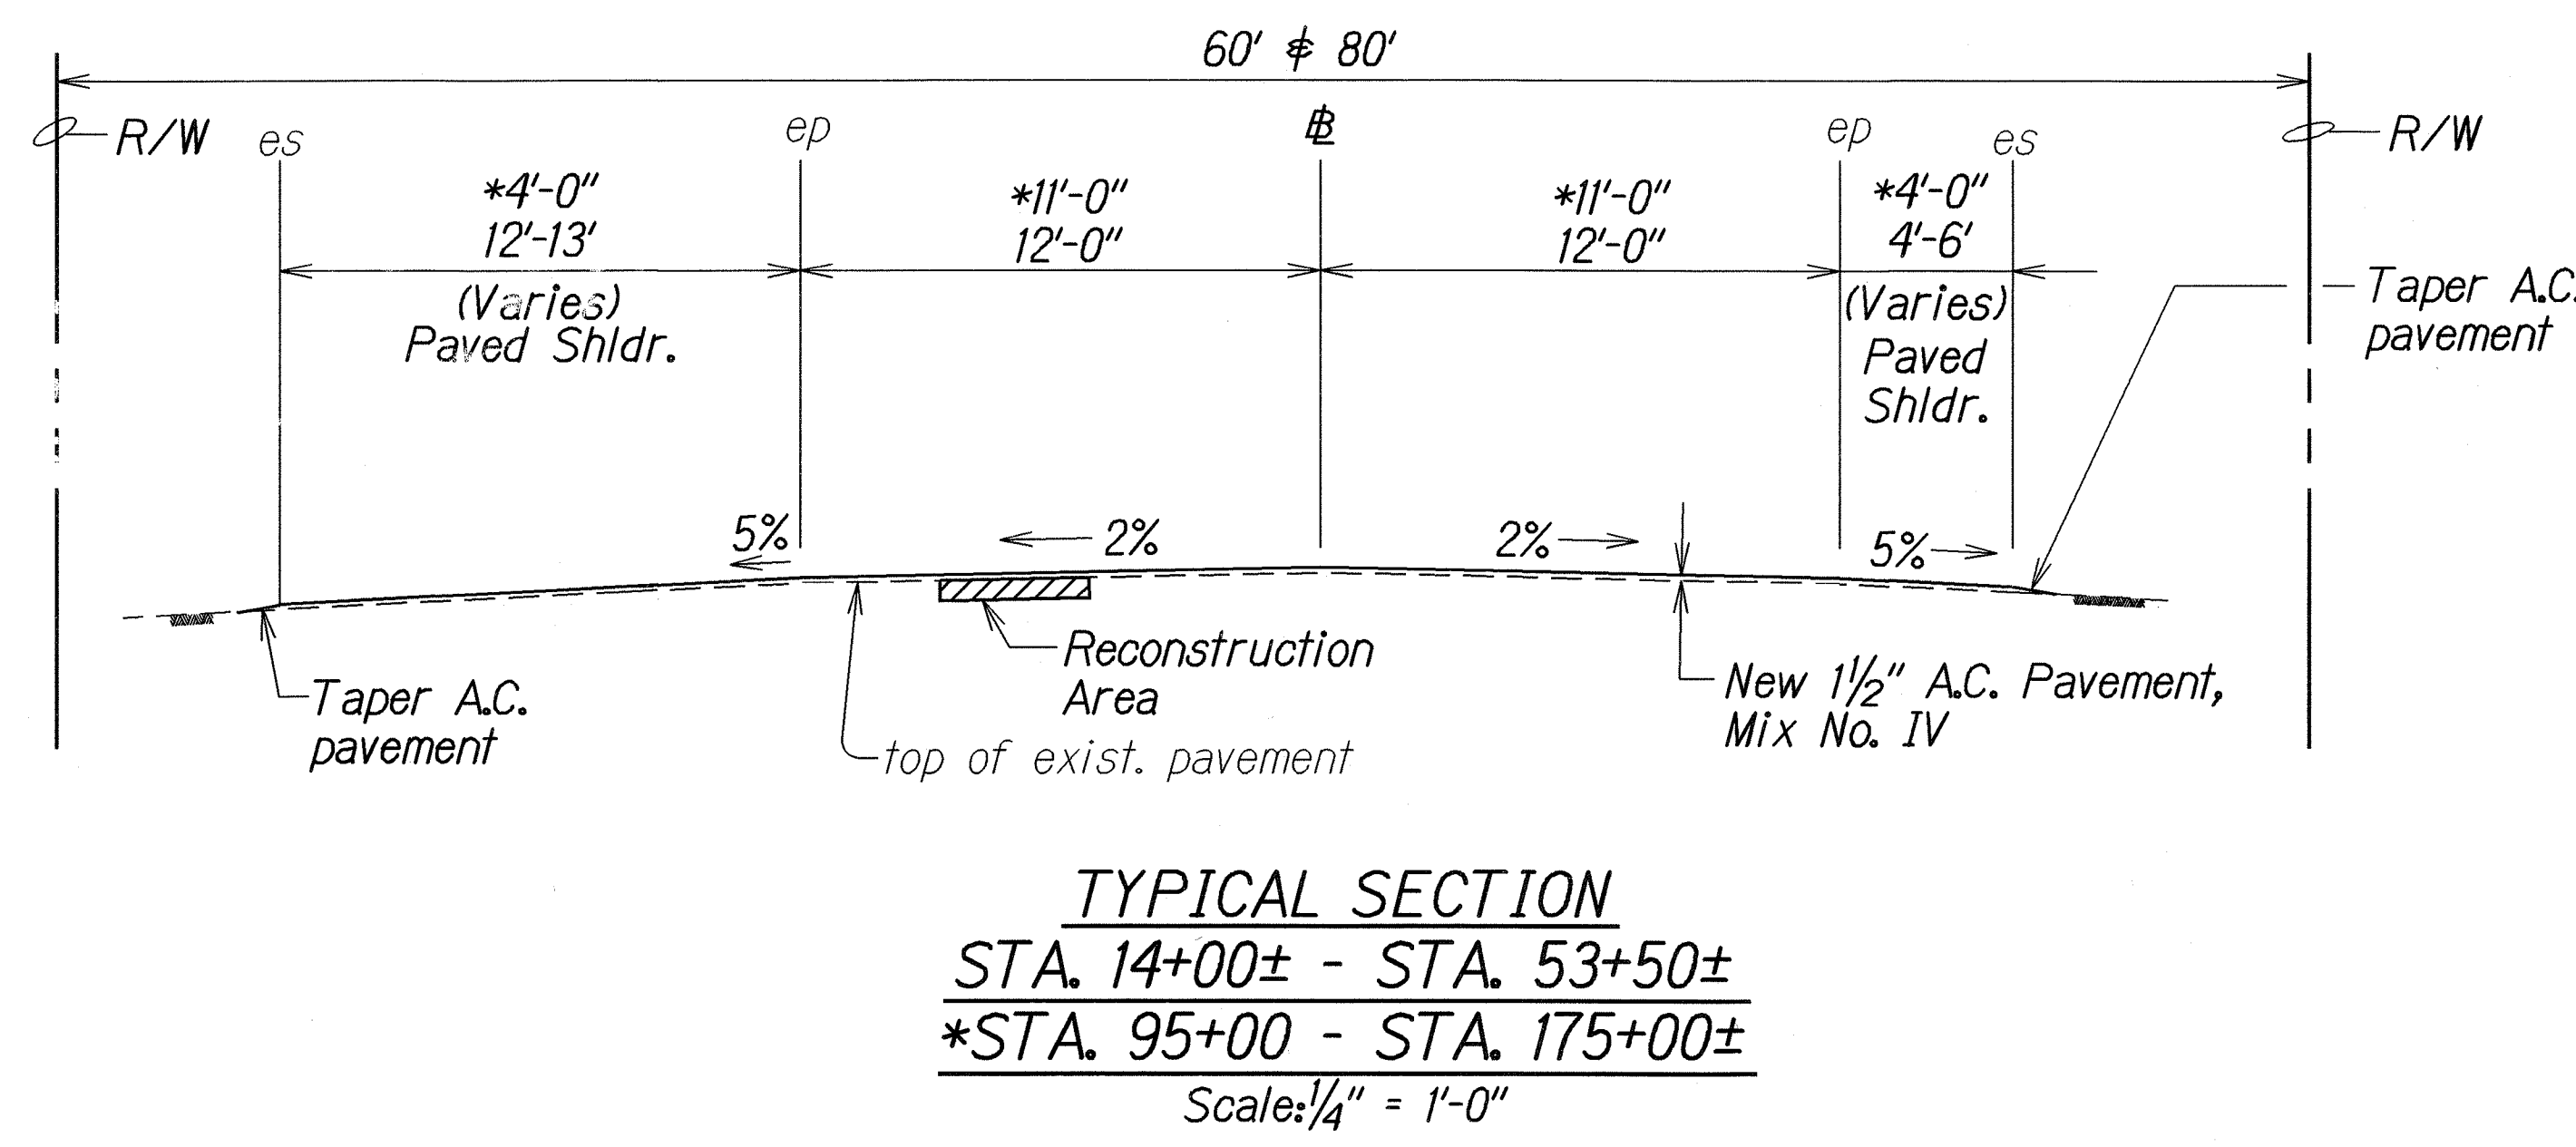


4-18-08	Revised Typical Section Sta. 1+00 - Sta. 14+00 & Sta. 53+50 - Sta. 95+00. Delete 2' Min.
DATE	REVISION
STATE OF HAWAII DEPARTMENT OF TRANSPORTATION HIGHWAYS DIVISION	
TYPICAL SECTIONS & DETAILS	
KAMEHMEHA V HIGHWAY RESURFACING	
Kaunakakai to Onealii Park	
Project No. 450A-01-08M	
Scale: As Shown	Date: October, 2007
SHEET No. 1 OF 2 SHEETS	

ORIGINAL PLAN	DATE: Aug. 2008
NOTED BY	
DESIGNED BY	
CHECKED BY	


FED. ROAD DIST. NO.	STATE	PROJ. NO.	FISCAL YEAR	SHEET NO.	TOTAL SHEETS
HAWAII	HAW.	450A-01-08M	2008	7	25

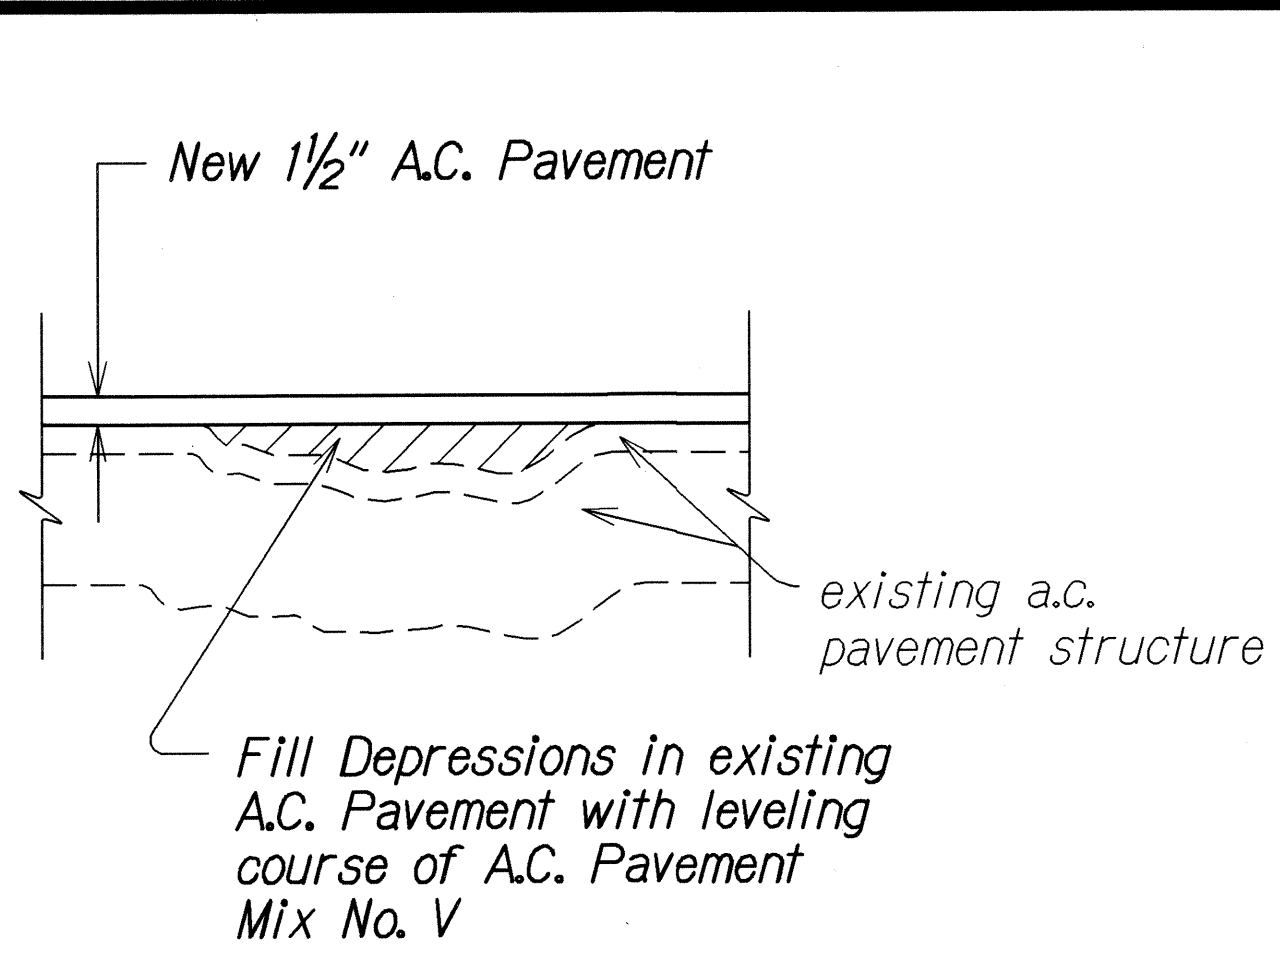

LEVELING COURSE DETAIL
Not To Scale

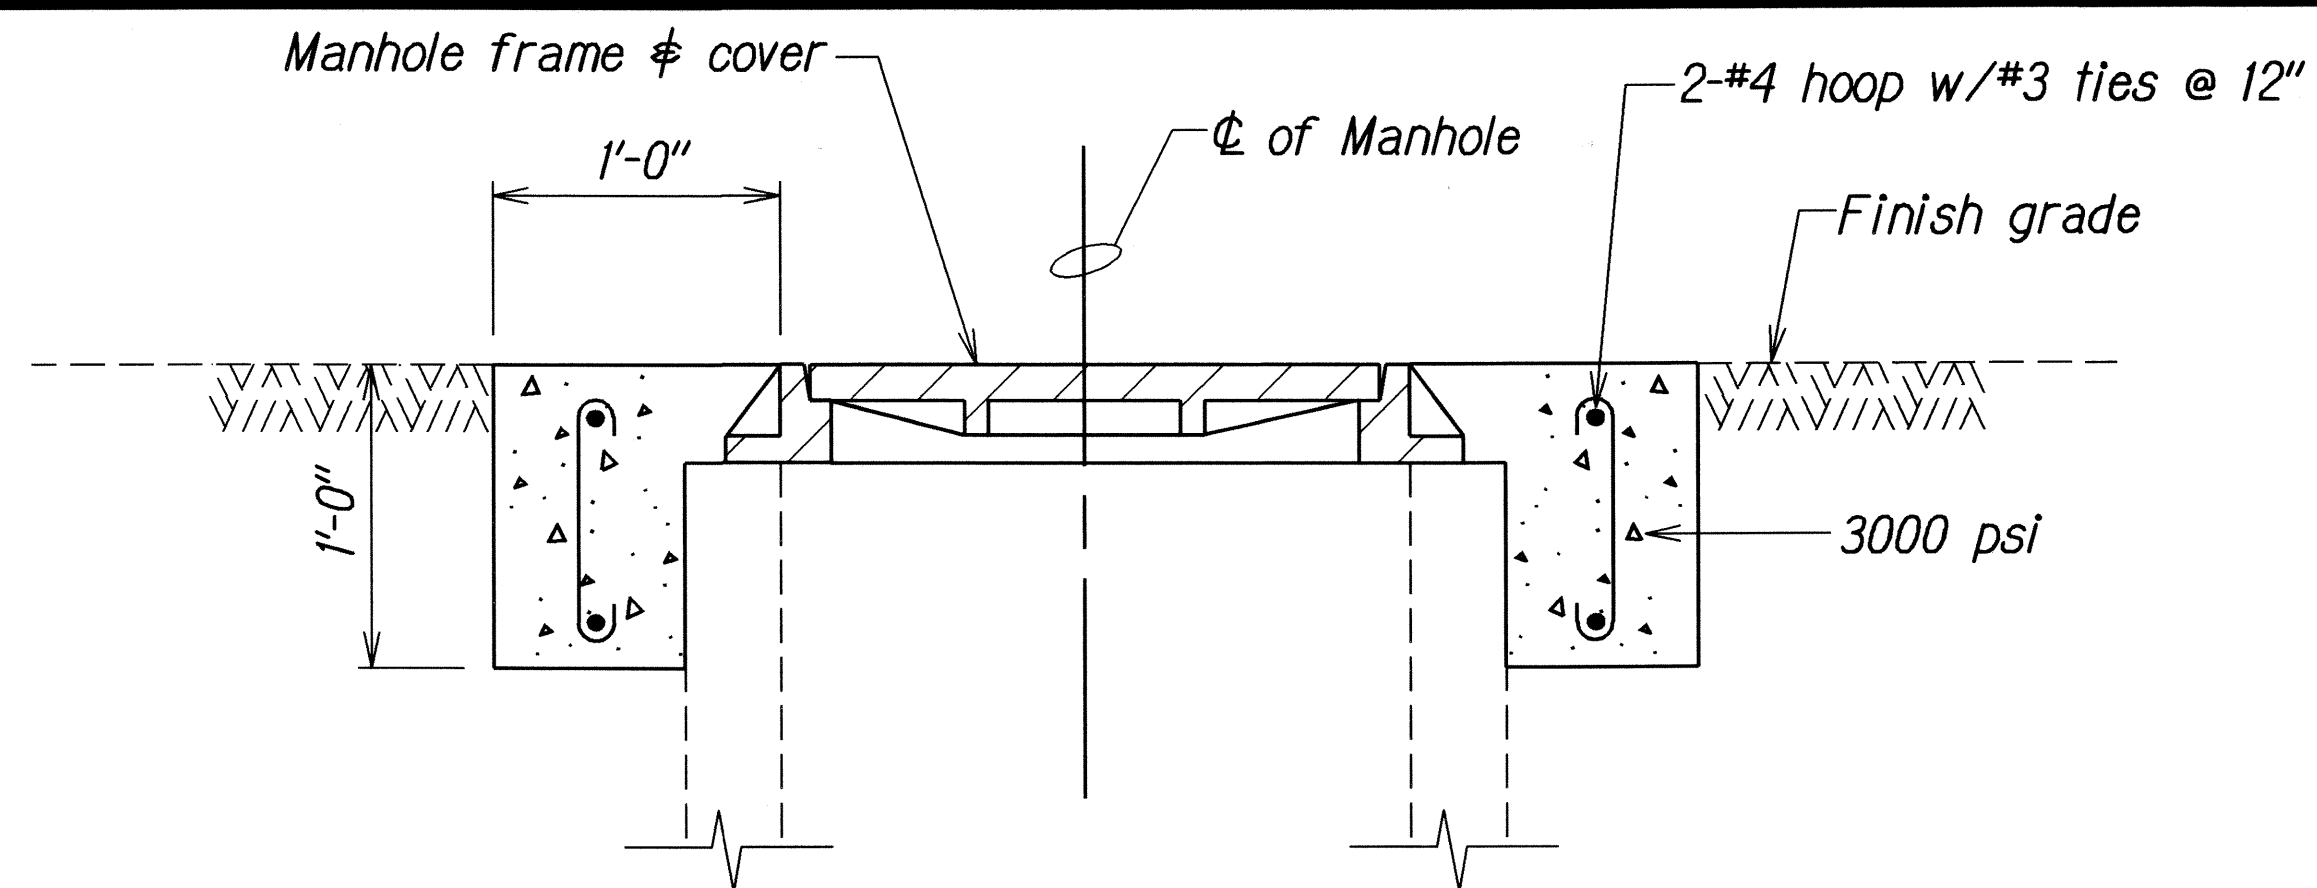


DETAIL - CONCRETE COLLAR FOR
ADJUSTMENTS OF MANHOLES AND VALVE BOX
Not To Scale

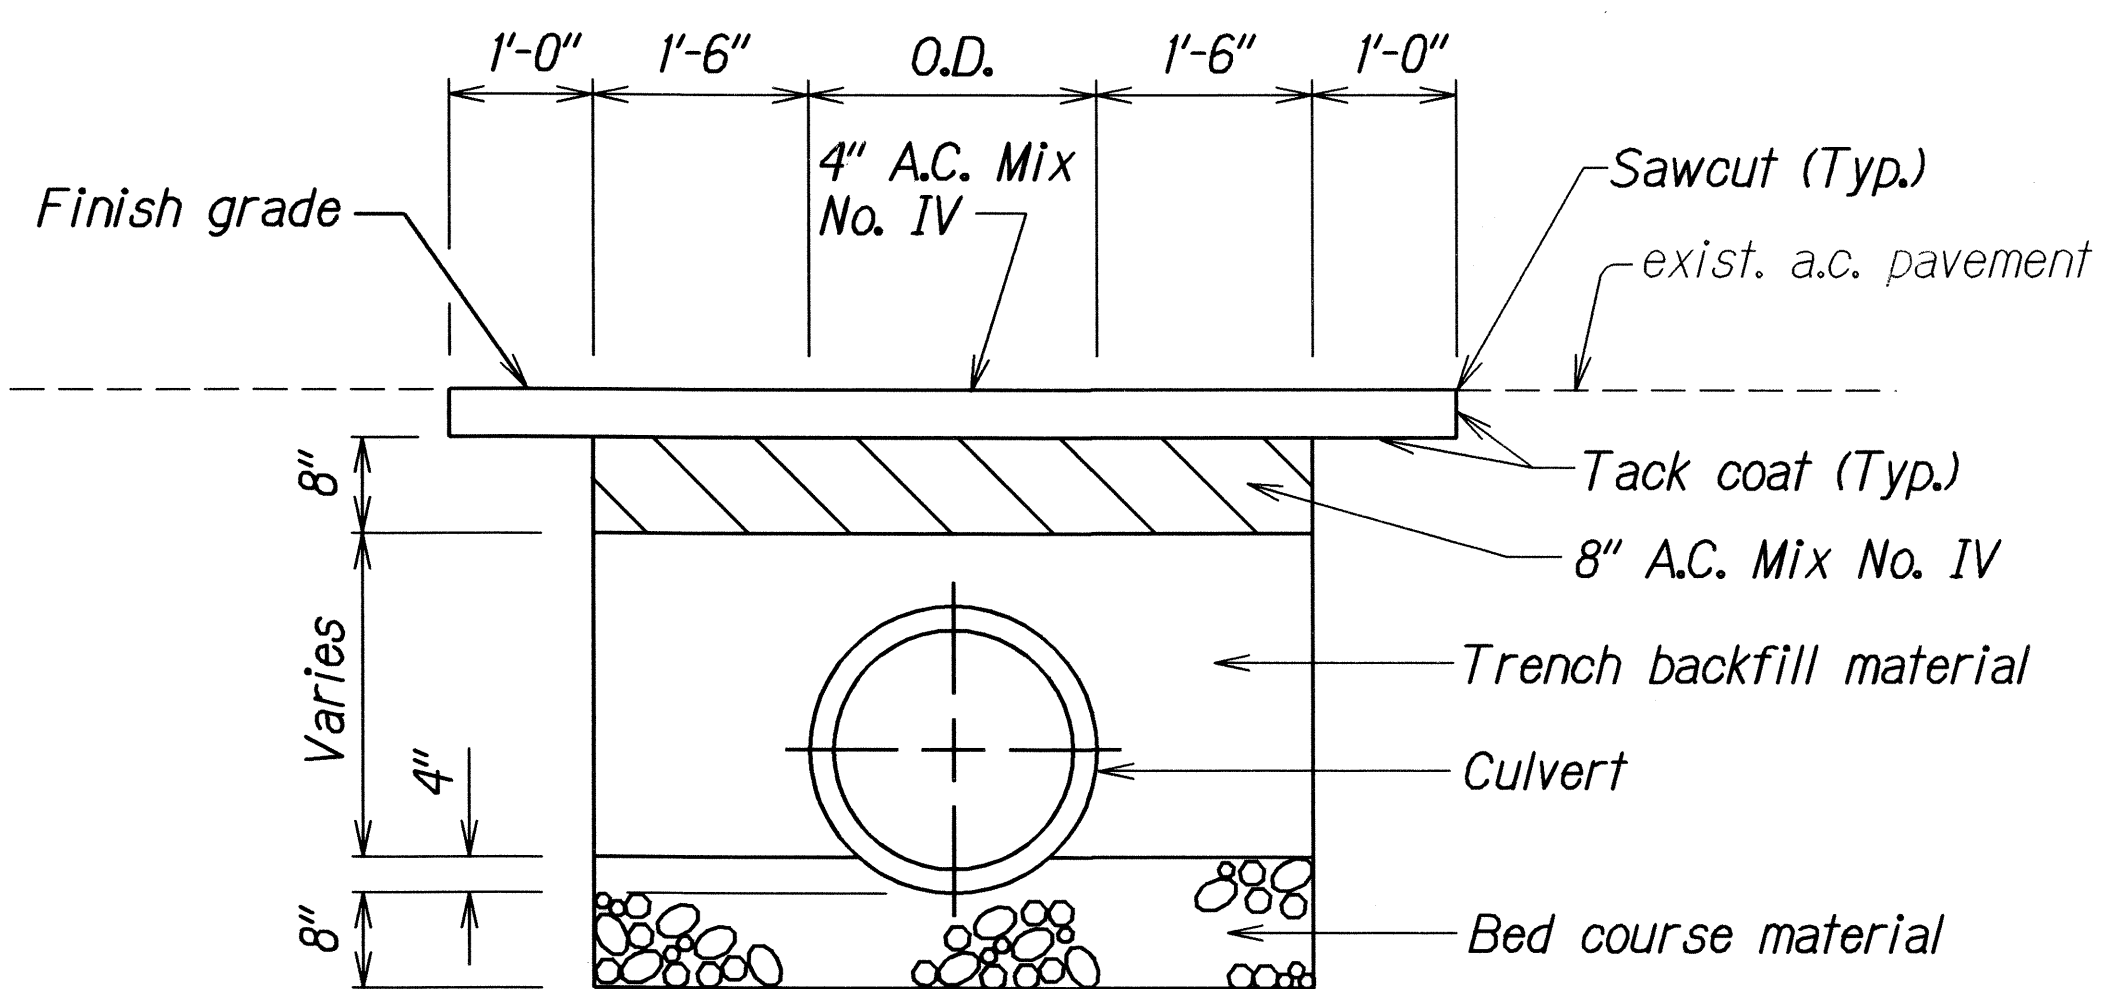


TYPICAL DETAILS OF CULVERT TRENCH RESTORATION
OF EXISTING PAVEMENT STRUCTURE
Not To Scale

NOTE:
Structure excavation of culvert trench restoration shall be considered incidental to Item No. 603.1020.

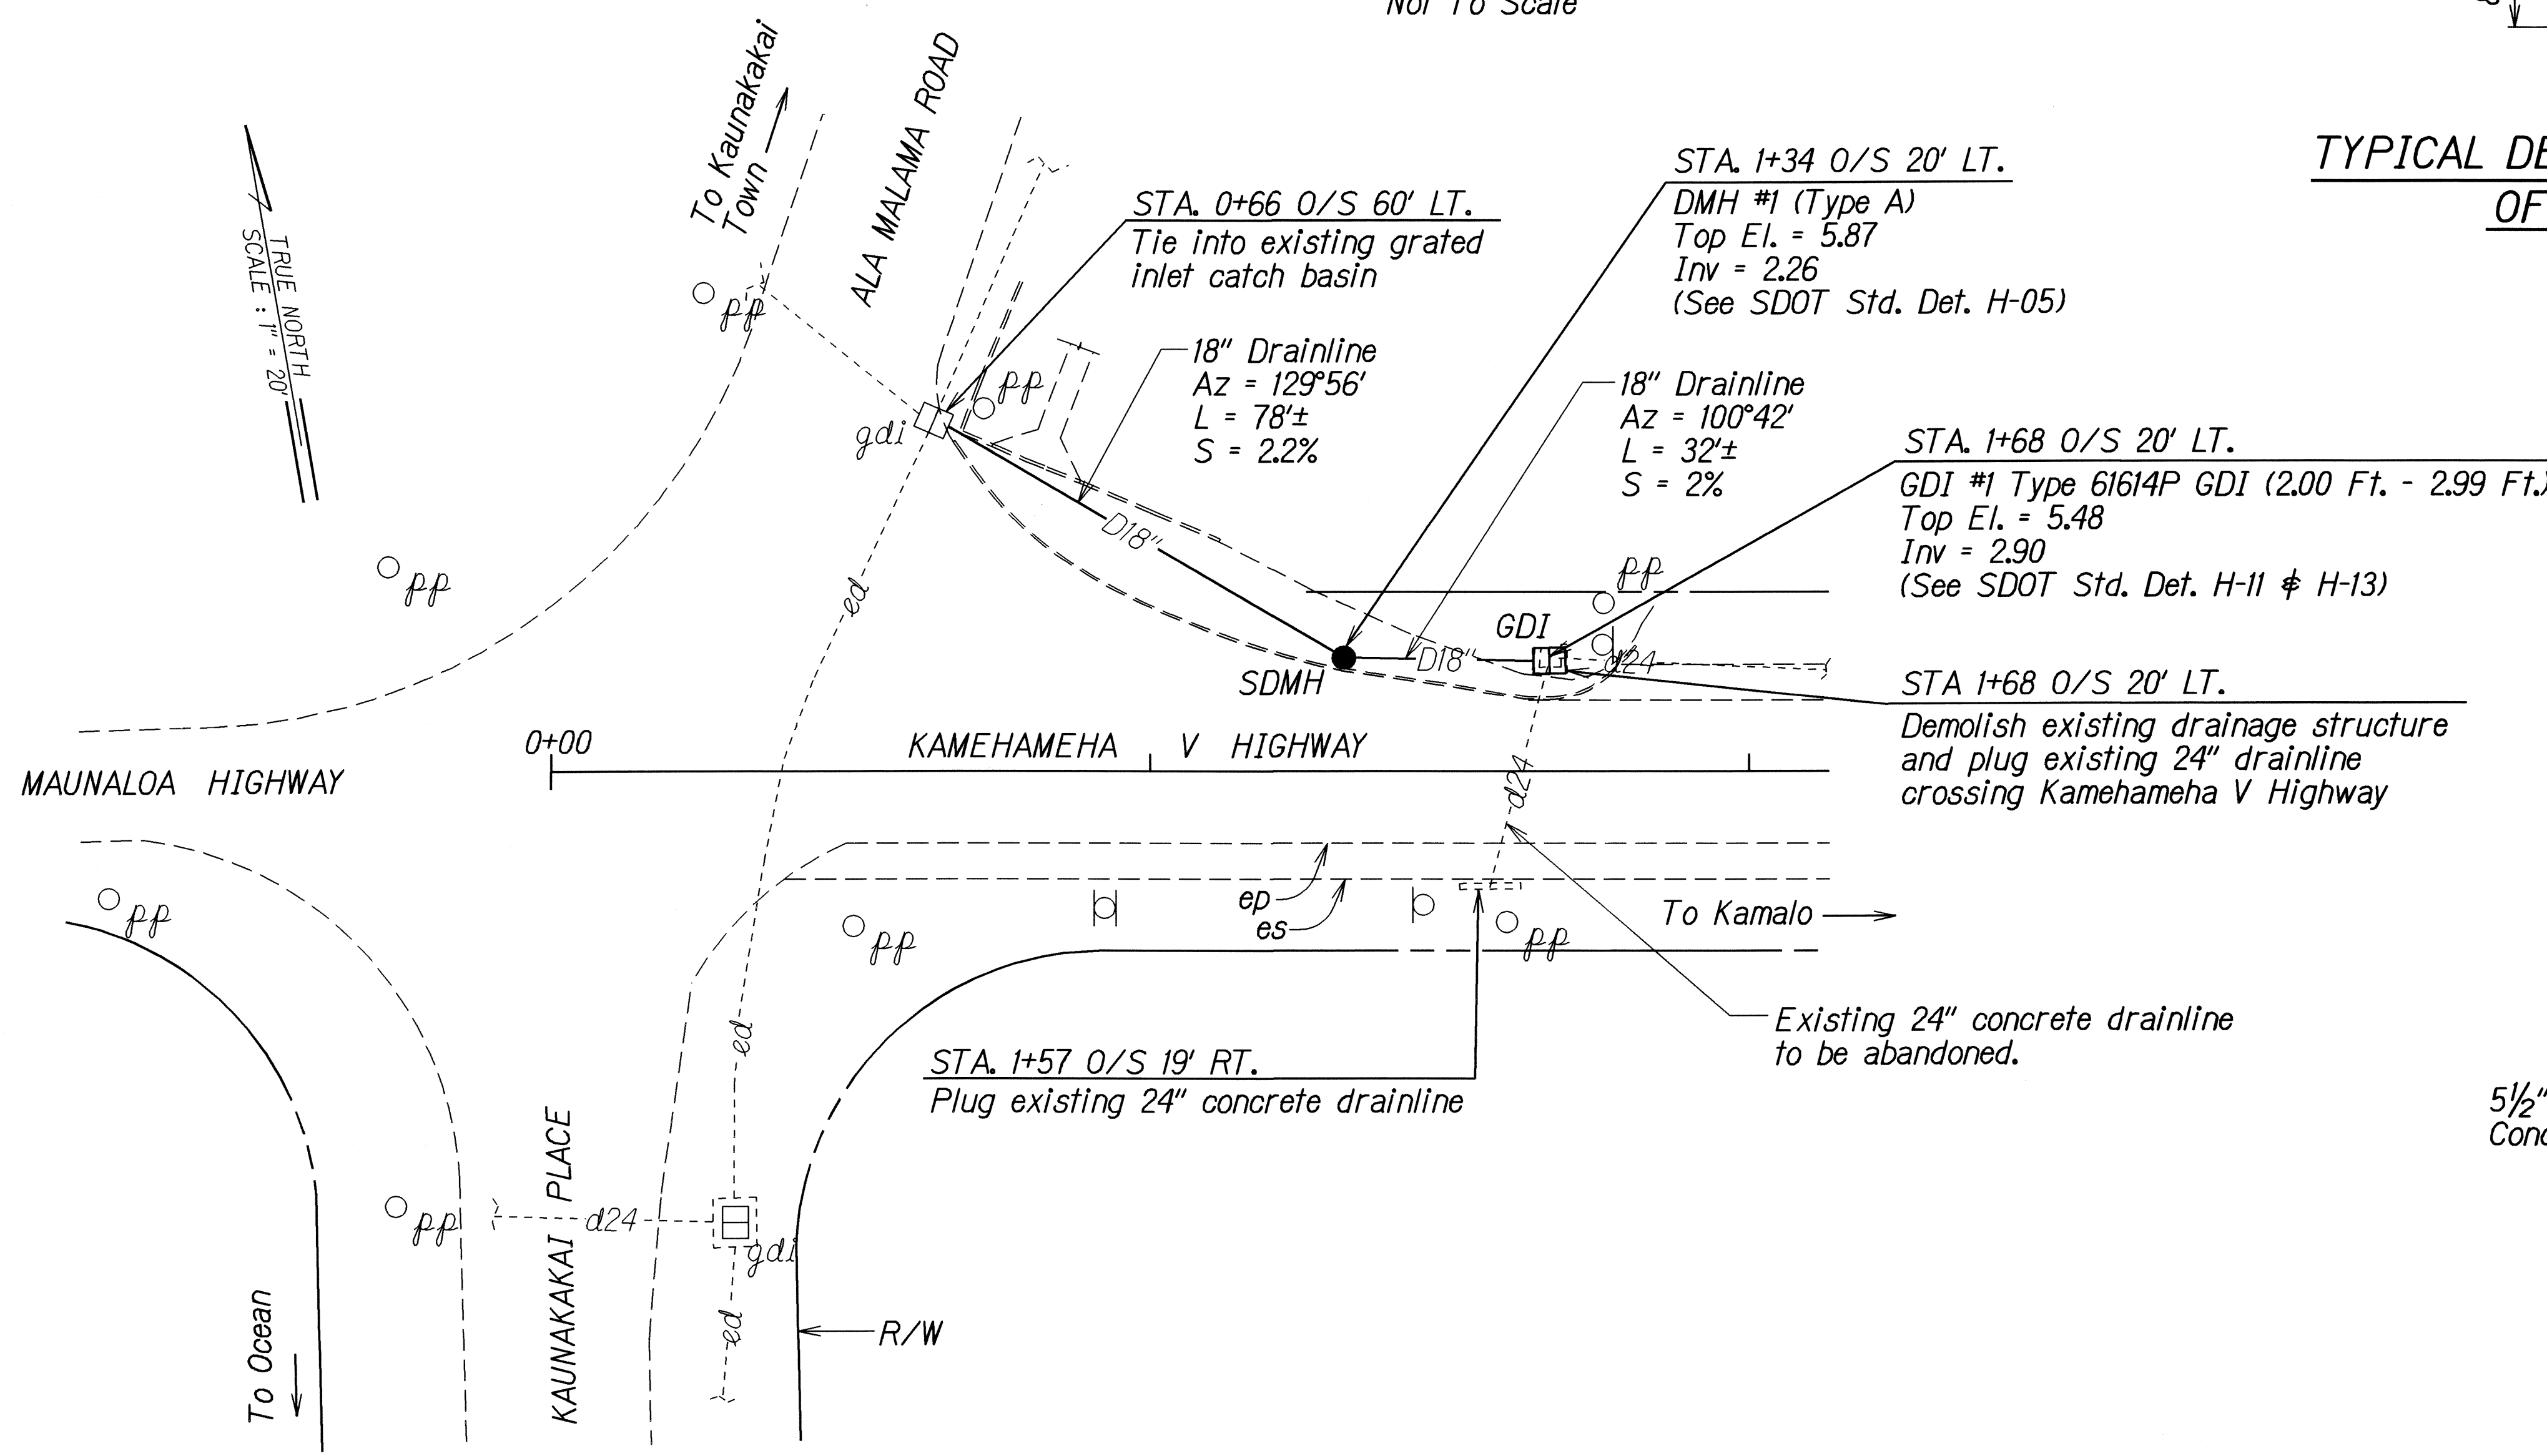

PLAN
Scale: 1"= 20'

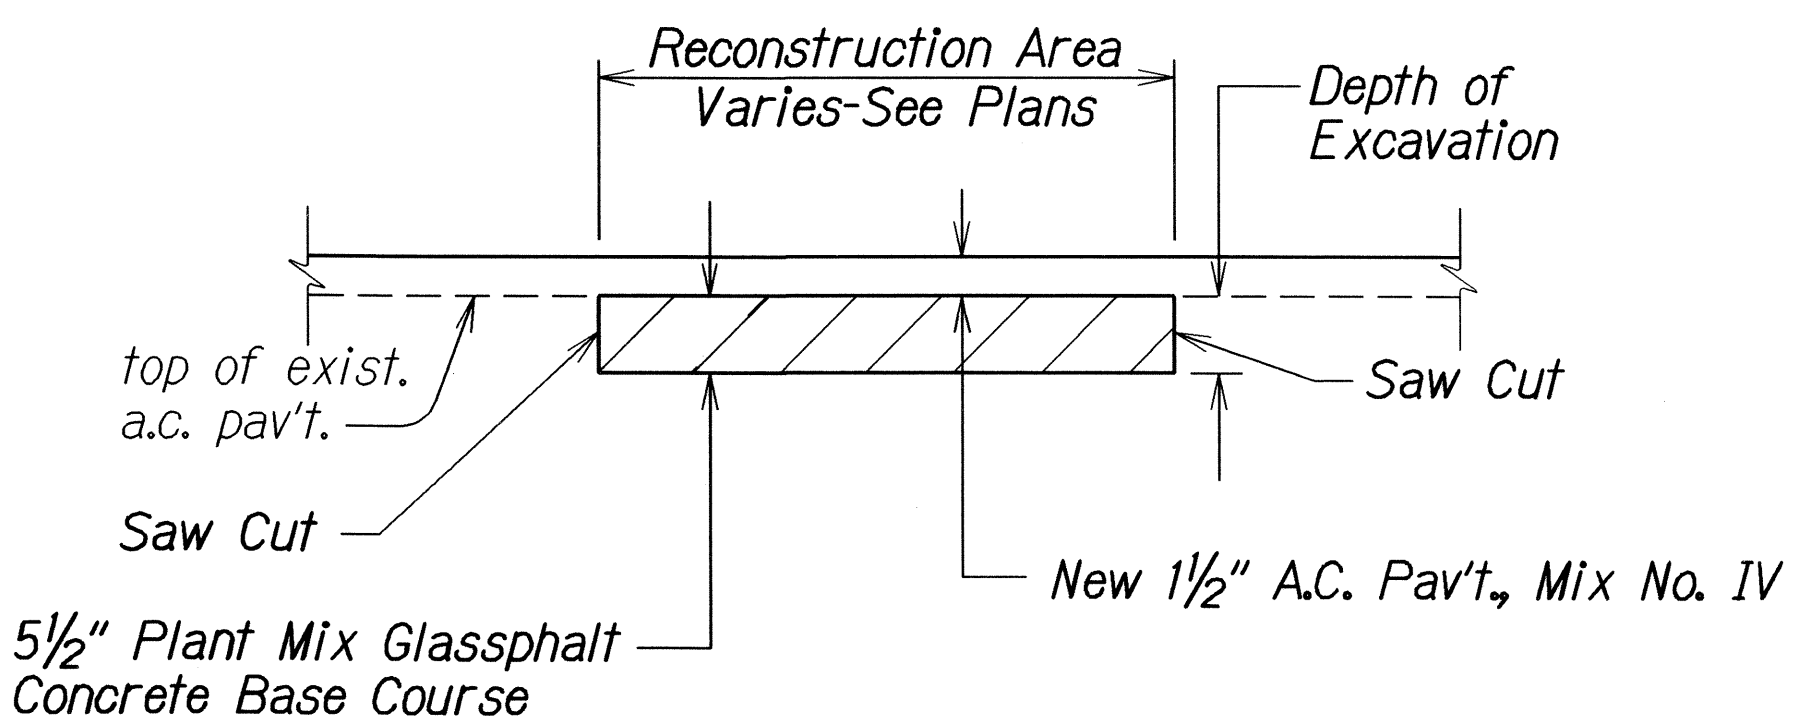

A.C. PAVEMENT RECONSTRUCTION DETAIL
Not To Scale

ORIGINAL PLAN	DATE
SURVEY PLOTTED BY	DATE
DRAWN BY	DATE
NOTE BOOK DESIGNED BY	DATE
QUANTITIES BY	DATE
CHECKED BY	DATE

STATE OF HAWAII
DEPARTMENT OF TRANSPORTATION
HIGHWAYS DIVISION

TYPICAL SECTIONS & DETAILS
KAMEHAMEHA V HIGHWAY RESURFACING
Kaunakakai to Onealii Park
Project No. 450A-01-08M
Scale: As Shown
Date: October, 2007

SHEET No. 2 OF 2 SHEETS