

FED. ROAD DIST. NO.	STATE	PROJ. NO.	FISCAL YEAR	SHEET NO.	TOTAL SHEETS
HAWAII	HAW.	450AB-01-13M	2016	ADD.19	32

LEGEND

4 each Type A Raised Pavement Markers
Type C Raised Pavement Markers @ 40'-0" o.c.

4 each Type J Raised Pavement Markers
Type D Raised Pavement Markers @ 40'-0" o.c.

8" White Stripe with Type C Raised Pavement Markers @ 20'-0" o.c. (Thermoplastic)

4" Double Solid Yellow with Type D Raised Pavement Markers @ 20'-0" o.c. (Thermoplastic)

4" Double Solid Yellow Stripes with Type H Raised Pavement Markers @ 20'-0" o.c. (Thermoplastic)

4" Yellow Edge Stripe with Type H Raised Pavement Markers @ 40'-0" o.c. (Thermoplastic)

4" Double Solid White Stripes with Type C Raised Pavement Markers @ 20'-0" o.c. (Thermoplastic)

Lane Change Restriction Marking
4 each Type A Raised Pavement Markers
Unless Noted Otherwise in The Plans
Type C Raised Pavement Markers @ 20'-0" o.c.
4" White Stripe (Thermoplastic)

4" or 8" White Edge Stripe with Type C Raised Pavement Markers @ 40'-0" o.c. (Thermoplastic)

4" White Guide Lines (Thermoplastic)

Transverse Median Marking (Thermoplastic)

Transverse Shoulder Marking (Thermoplastic)

Channelizing Island or Deceleration Lane Gore (Thermoplastic)

Crosswalk and Stop Line. All Stop Lines shall be 10'-0" from Crosswalk unless otherwise noted. The circled number indicates the number of lanes for payment (Thermoplastic)

STOP

Pavement Arrow (Thermoplastic)

Pavement Word (Thermoplastic)

4 Each Type J Raised Pavement Markers
Type D Raised Pavement Markers @ 40'-0" o.c.
Type H Raised Pavement Markers (Reflective Surface facing no-passing direction)
4" Single Solid Yellow Stripe (Thermoplastic)


Extension of Edge Line, 4" Wide x 2'-0" Long White Stripe @ 10'-0" o.c. w/Type C Markers @ 40'-0" o.c. (Thermoplastic)

SW

FW


Reflector Marker (RM-2, White) w/steel post

Reflector Marker (RM-2, White) w/flexible post

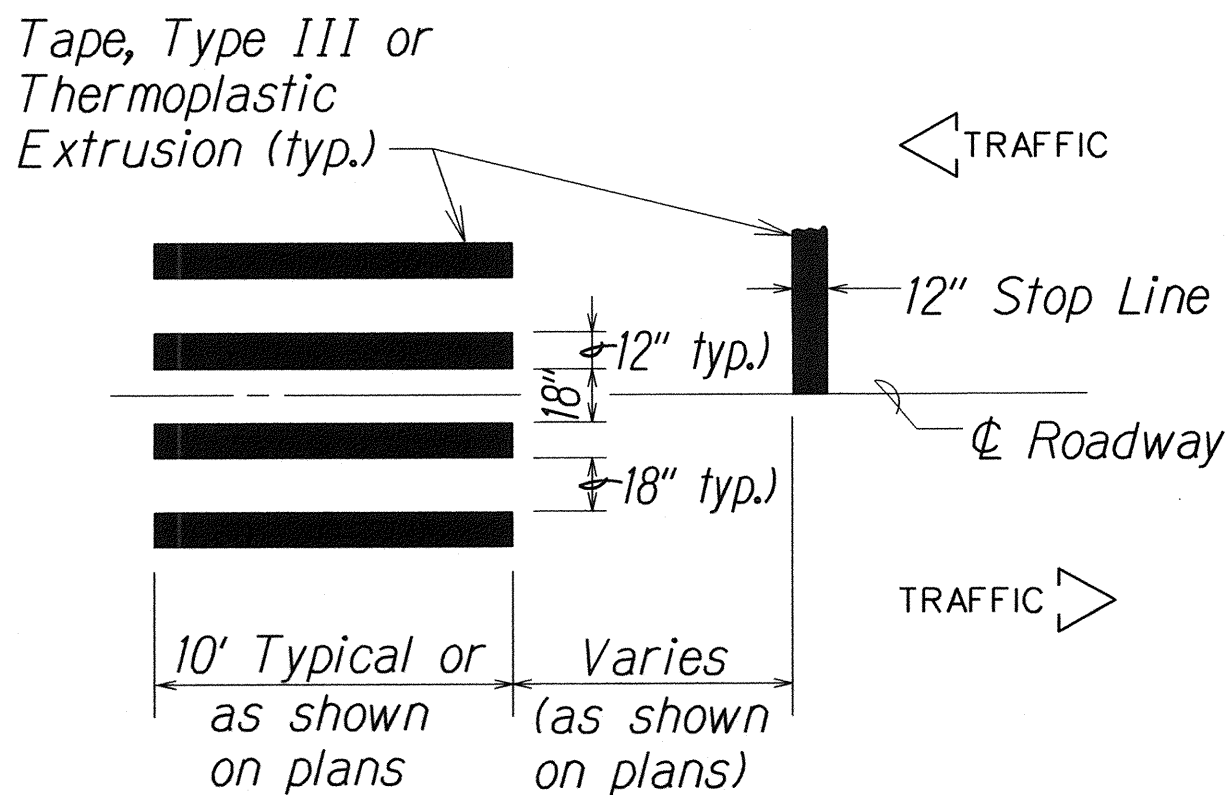


DETAIL "A"


CROSSWALK STRIPING DETAIL
Not to Scale

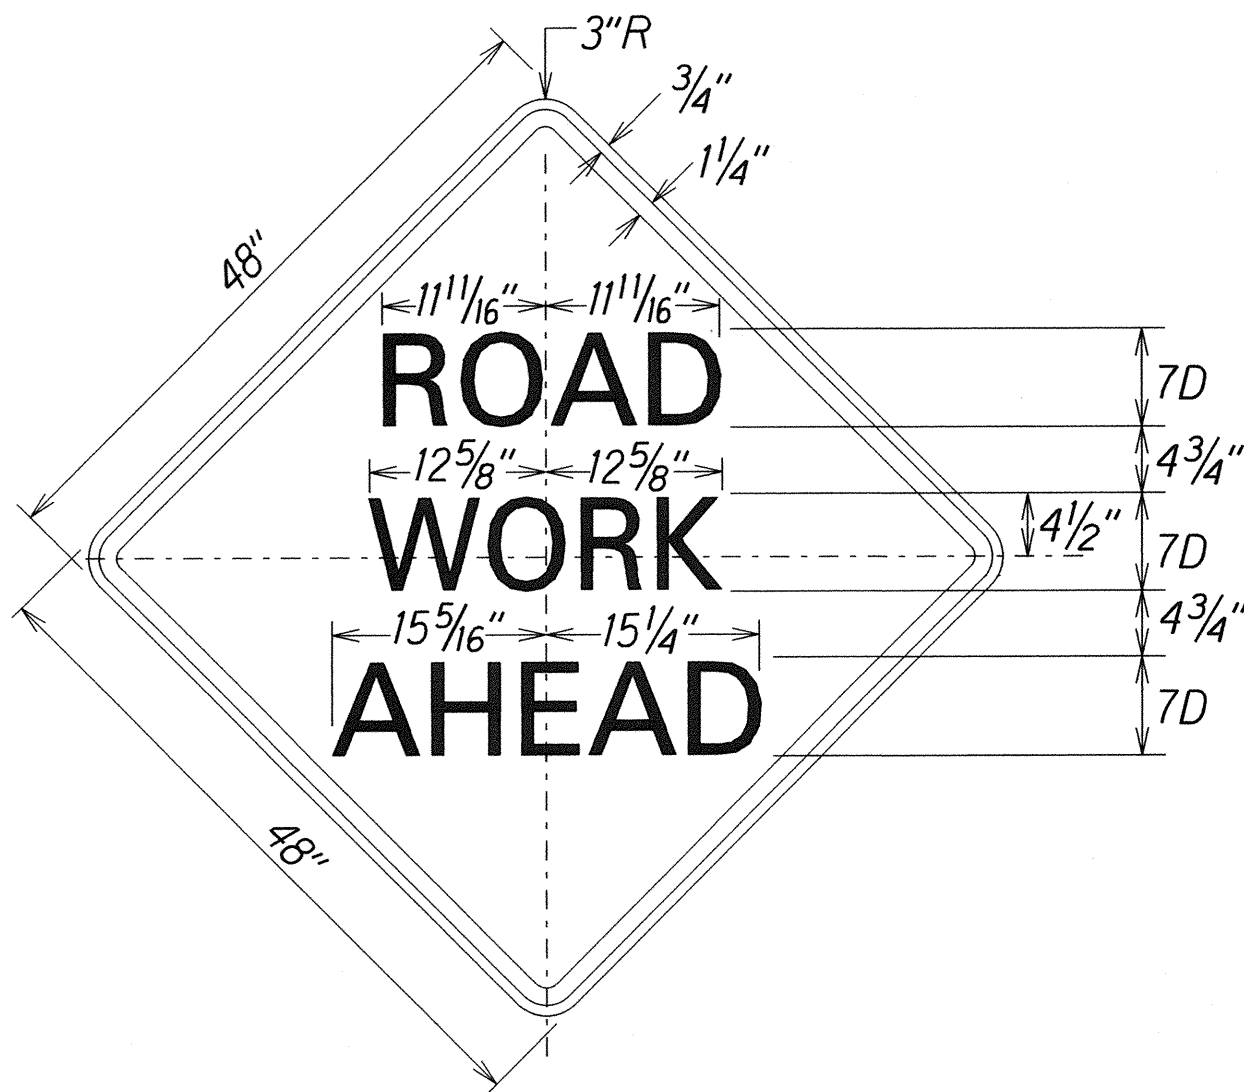

CW20-1Ad
Scale: 1" = 1'-0"
Colors:
Legend: Black (Non Refl)
Background: Orange

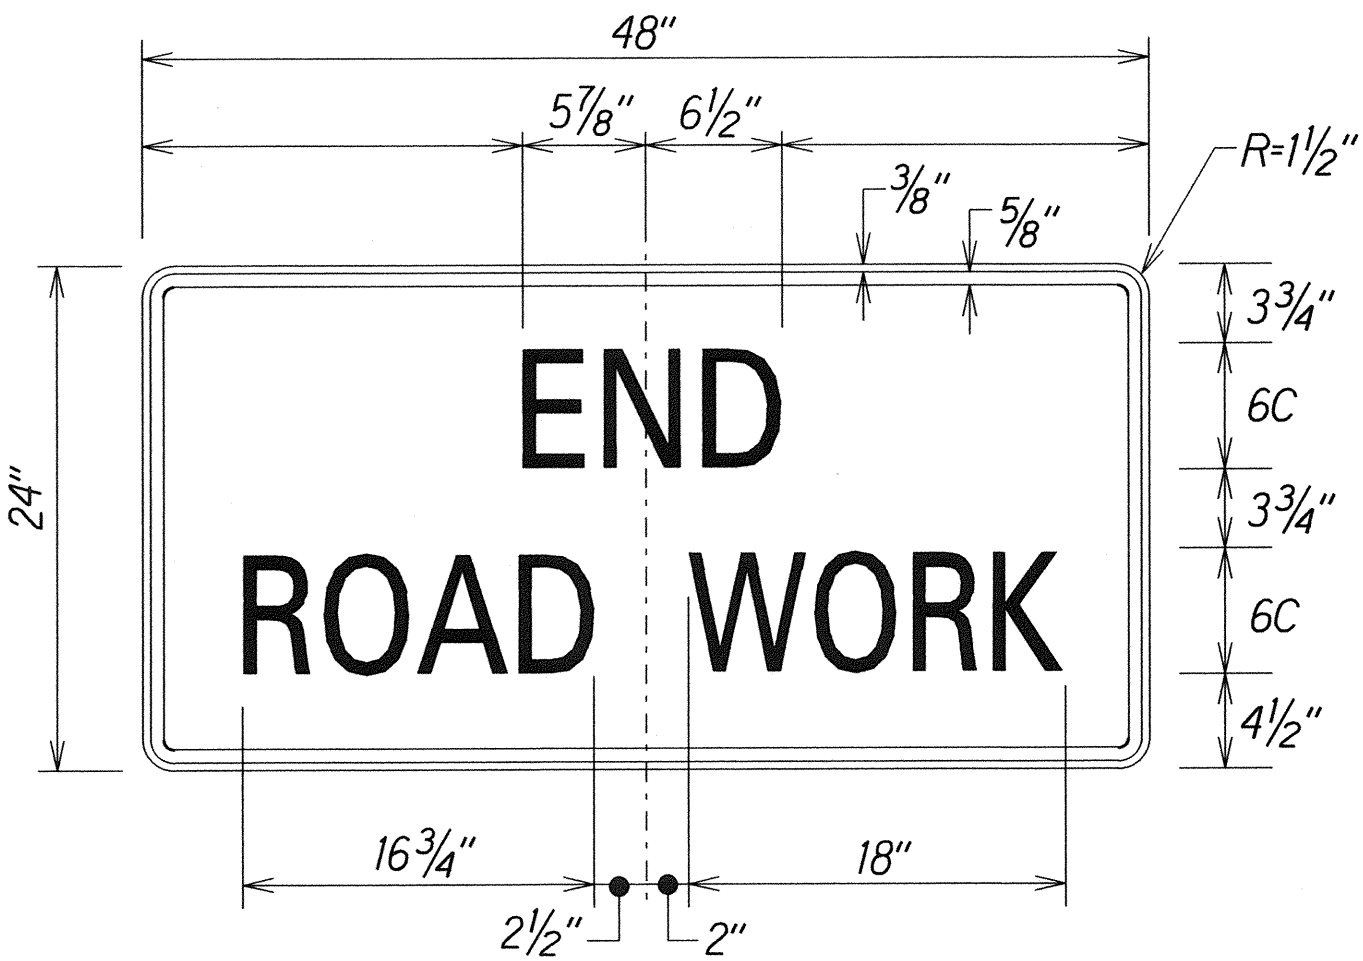


CG20-2A
Scale: 1 1/2" = 1'-0"
Colors:
Legend: Black (Non Refl)
Background: Orange (Relf)

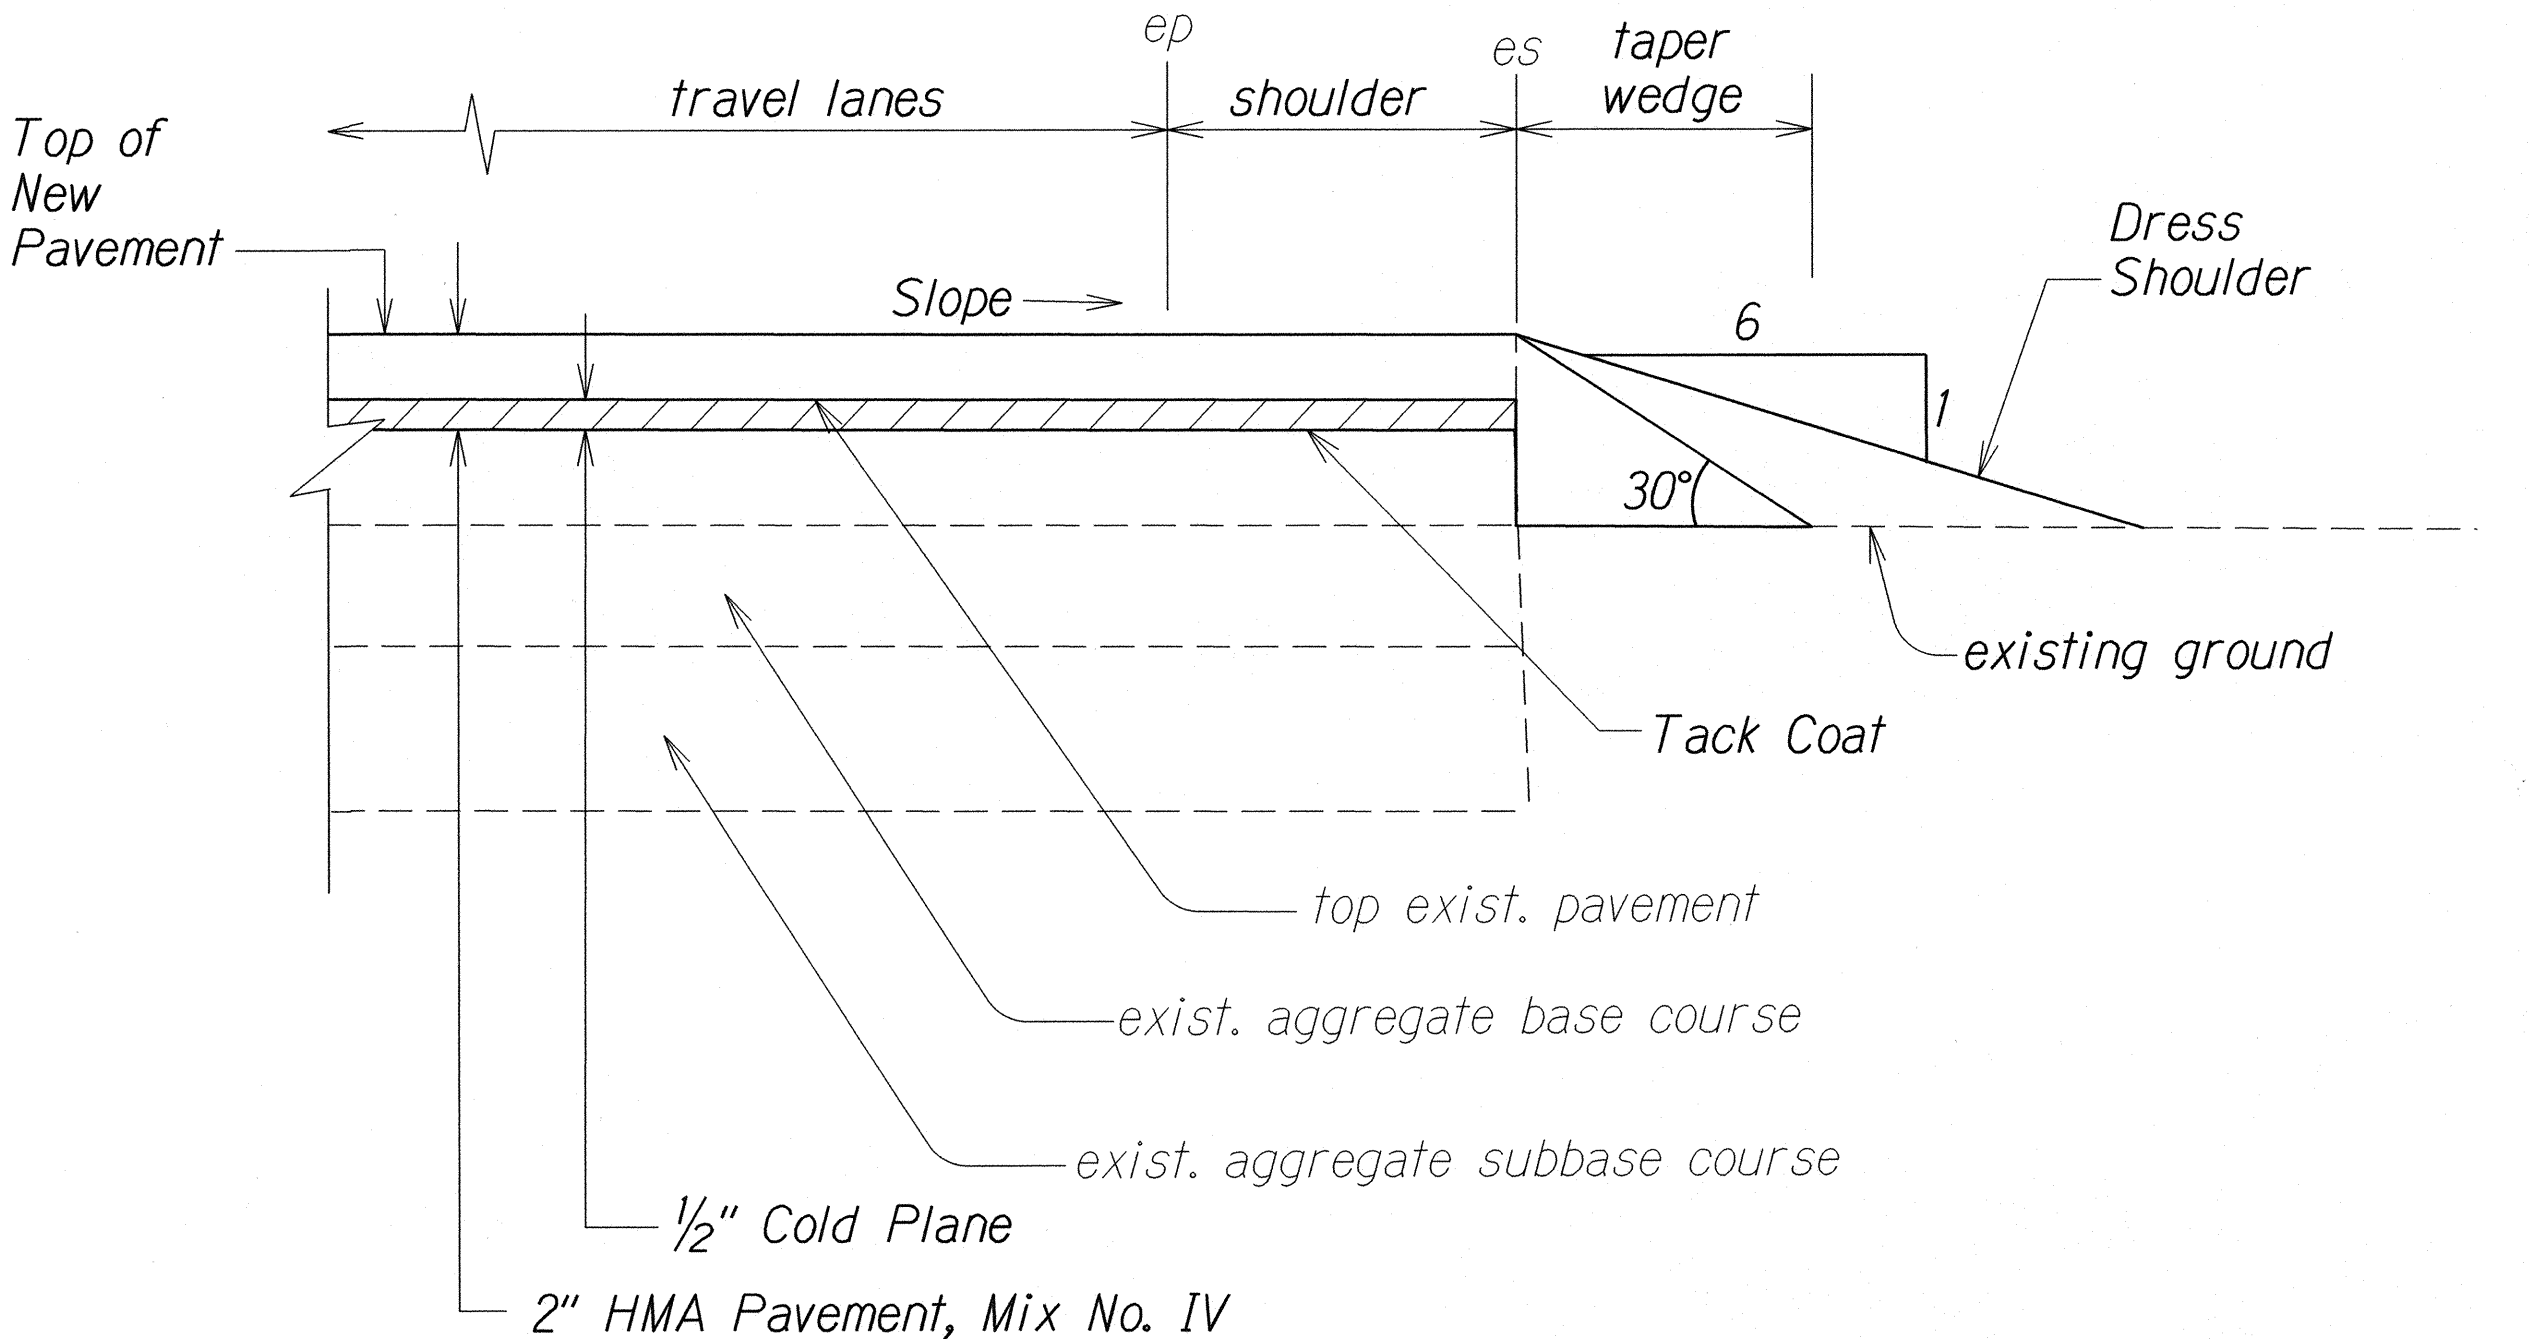

Note: Contractor shall mount a device directly on the paver screed extension to provide a 30° beveled shoulder edge.

2 TYPICAL PAVEMENT EDGE DETAIL
Not To Scale

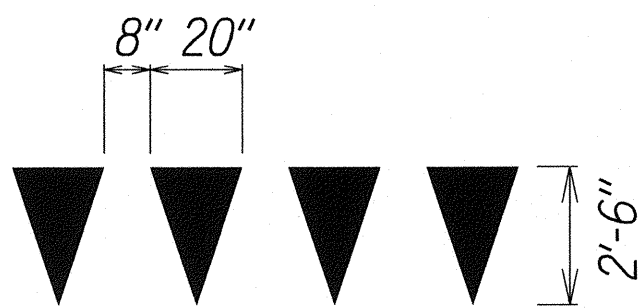

YIELD LINE DETAIL
Not to Scale

4-27-16	Add Typical Pavement Edge Detail.
DATE	REVISION
STATE OF HAWAII DEPARTMENT OF TRANSPORTATION HIGHWAYS DIVISION PAVEMENT MARKING LEGEND, DETAILS & NOTES KAMEHAMEHA V HIGHWAY RESURFACING Kapuokoolau to Kamalo Project No. 450AB-01-13M Scale: As Noted Date: February, 2016 SHEET No. 1 OF 1 SHEETS	

SURVEY PLOTTED BY	DATE
DRAWN BY	DESIGNED BY
NOTE BOOK	QUANTITIES BY
DESIGNED BY	CHECKED BY
DATE	DATE