

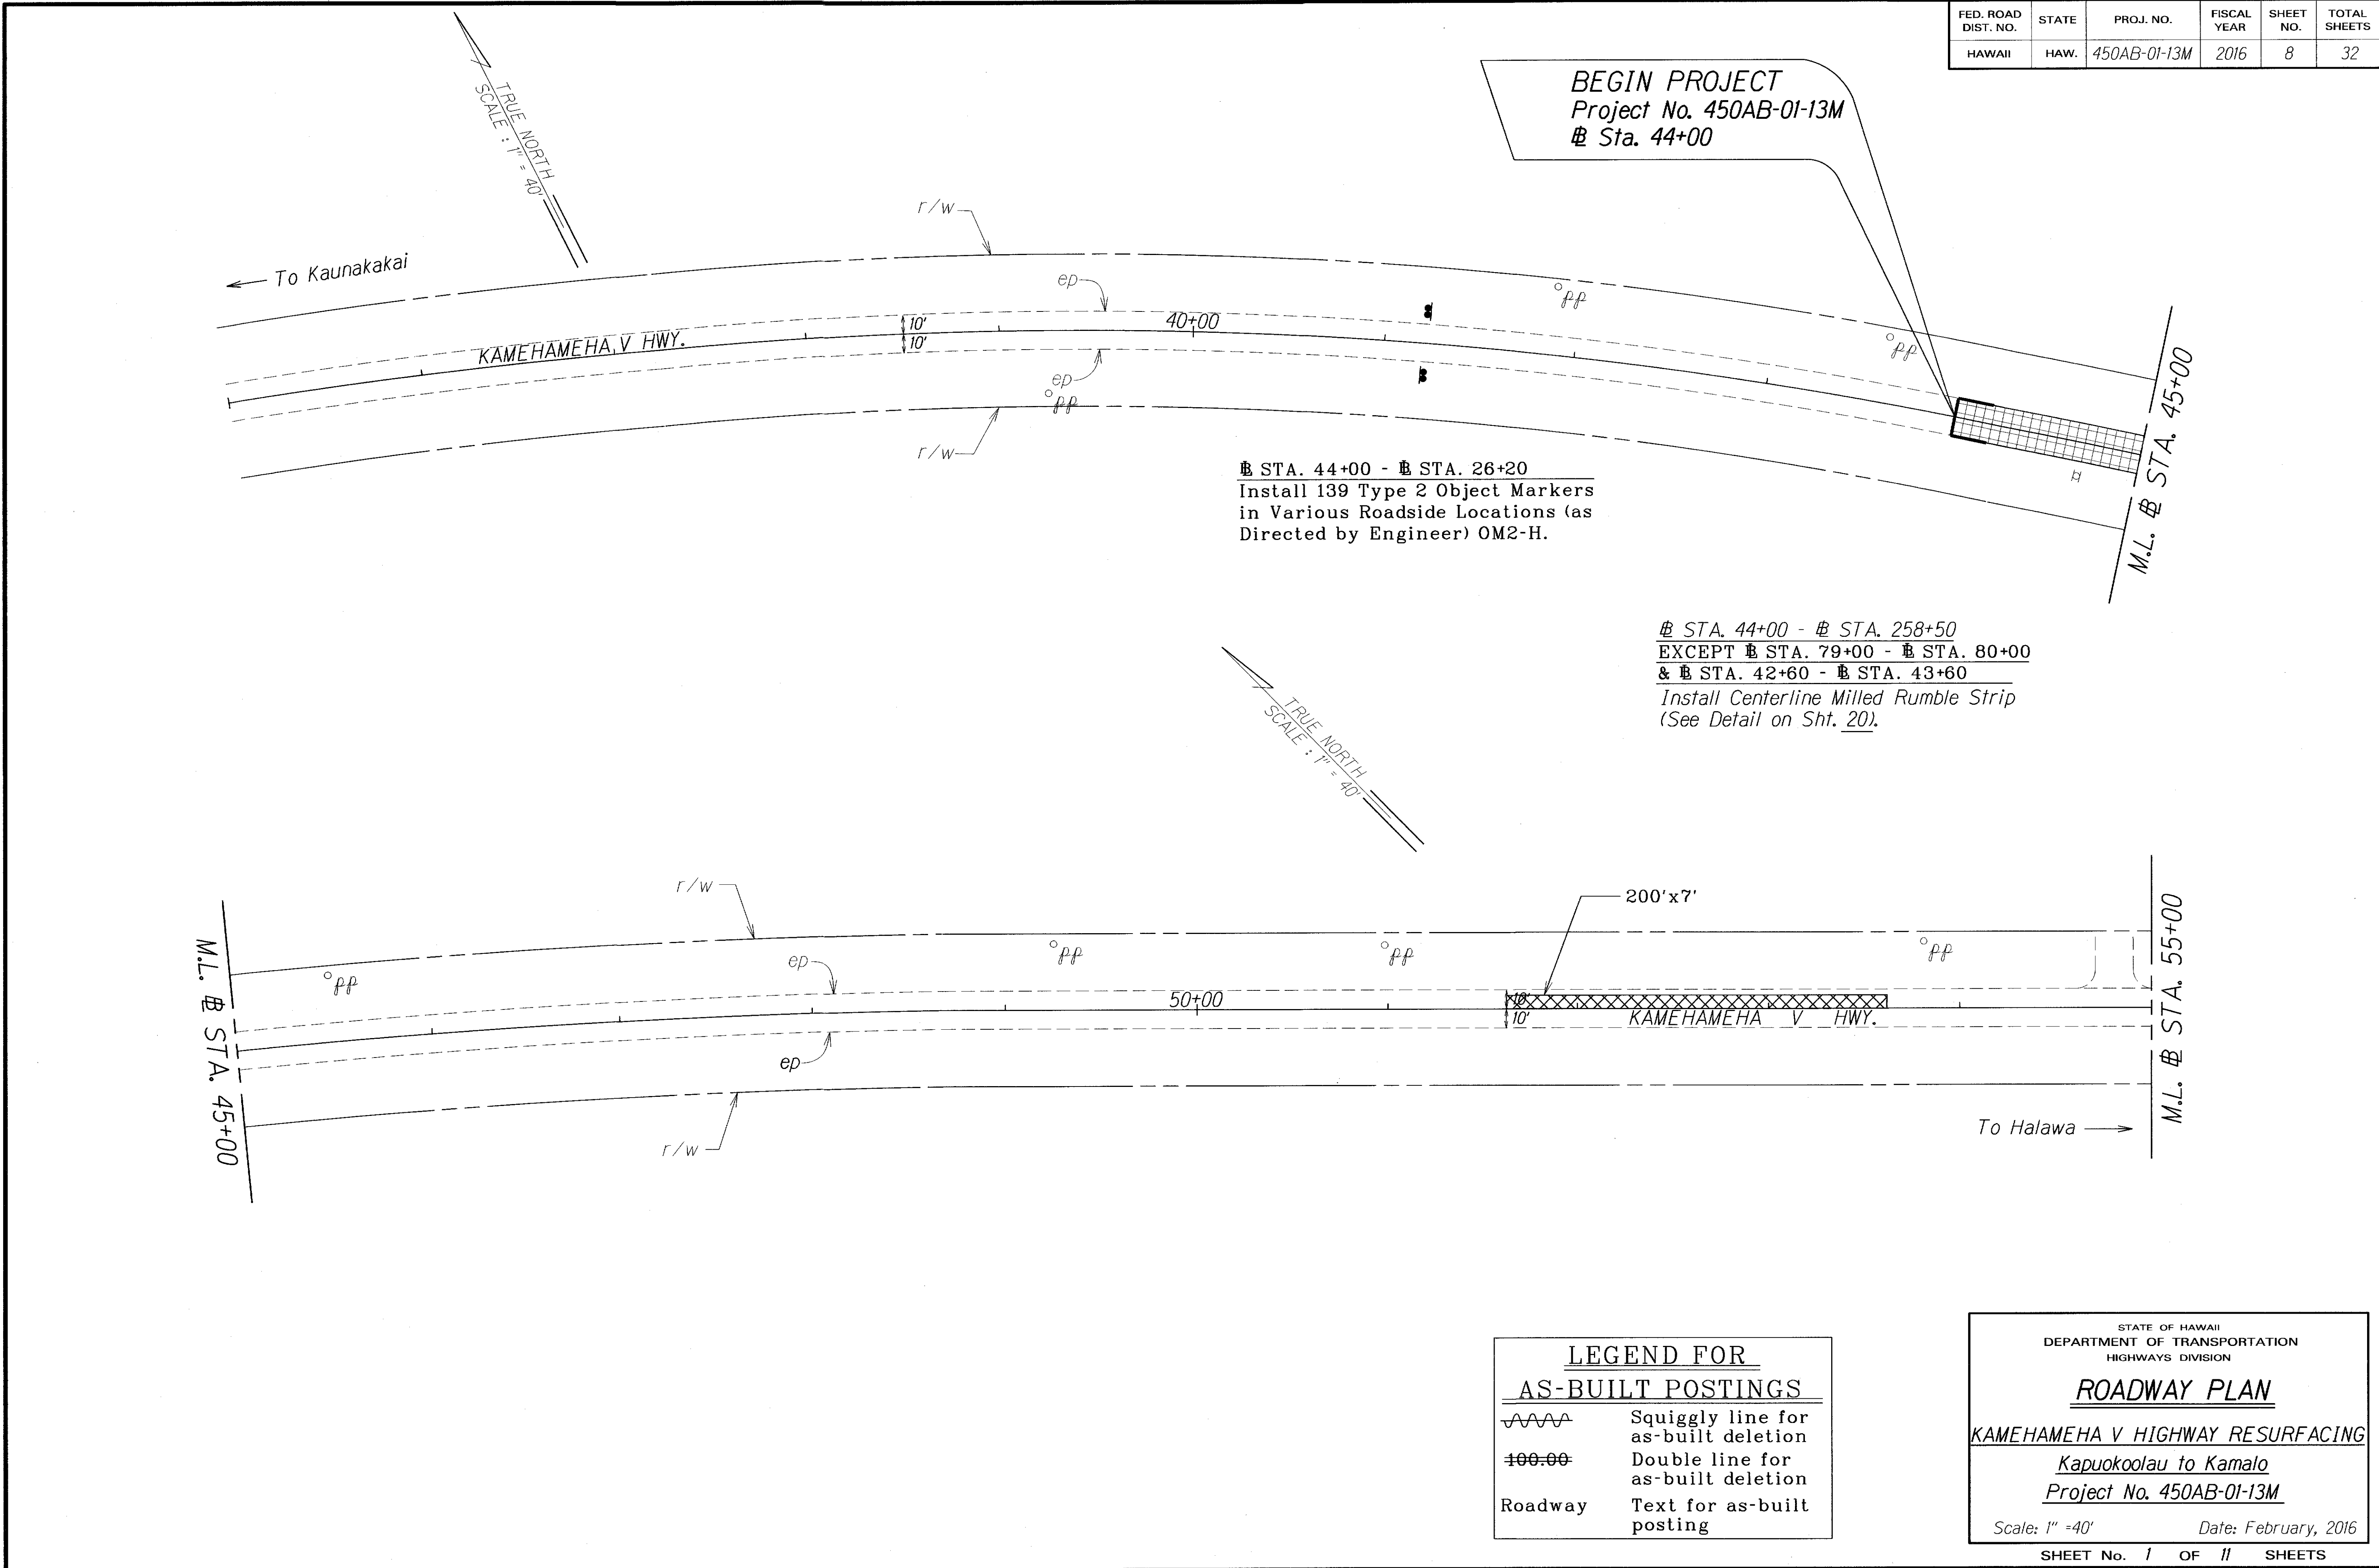


FED. ROAD DIST. NO.	STATE	PROJ. NO.	FISCAL YEAR	SHEET NO.	TOTAL SHEETS
HAWAII	HAW.	450AB-01-13M	2016	8	32

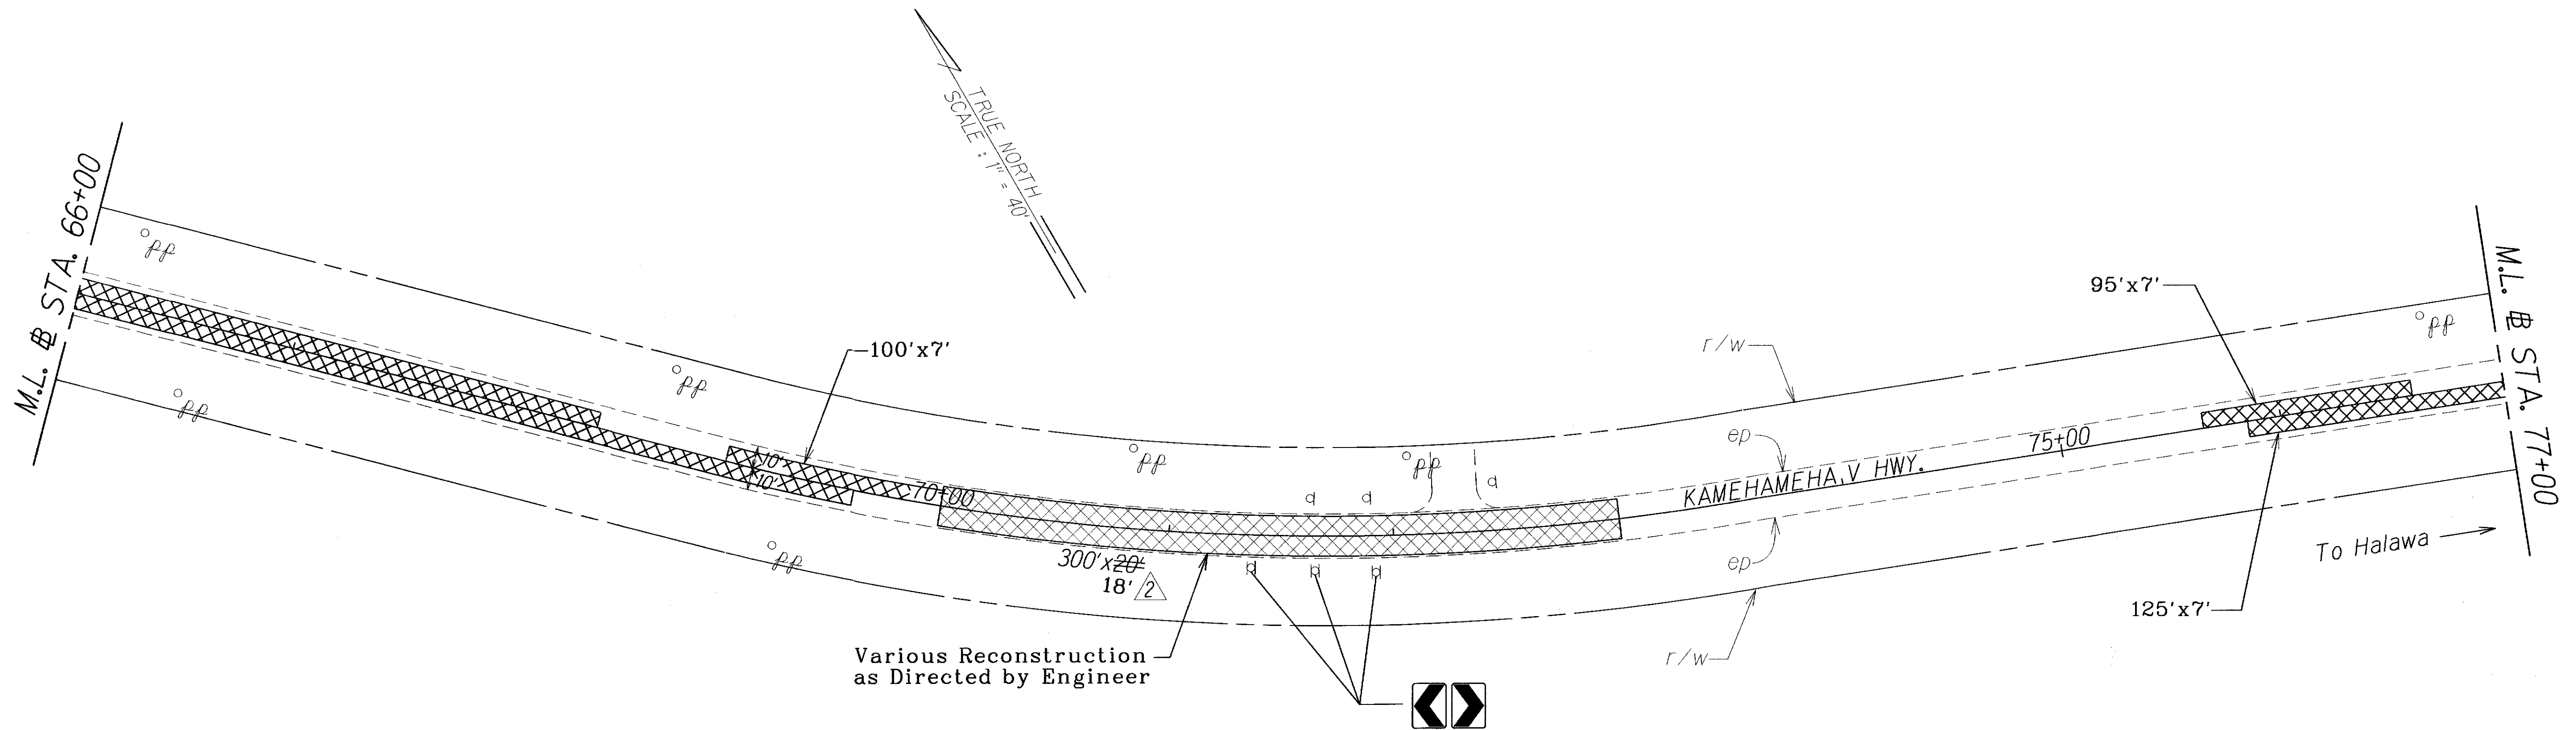

ORIGINAL PLAN	SURVEY PLOTTED BY	DATE
NOTE BOOK	DESIGNED BY	
QUANTITIES BY	CHECKED BY	

FED. ROAD DIST. NO.	STATE	PROJ. NO.	FISCAL YEAR	SHEET NO.	TOTAL SHEETS
HAWAII	HAW.	450AB-01-13M	2016	ADD.9	32

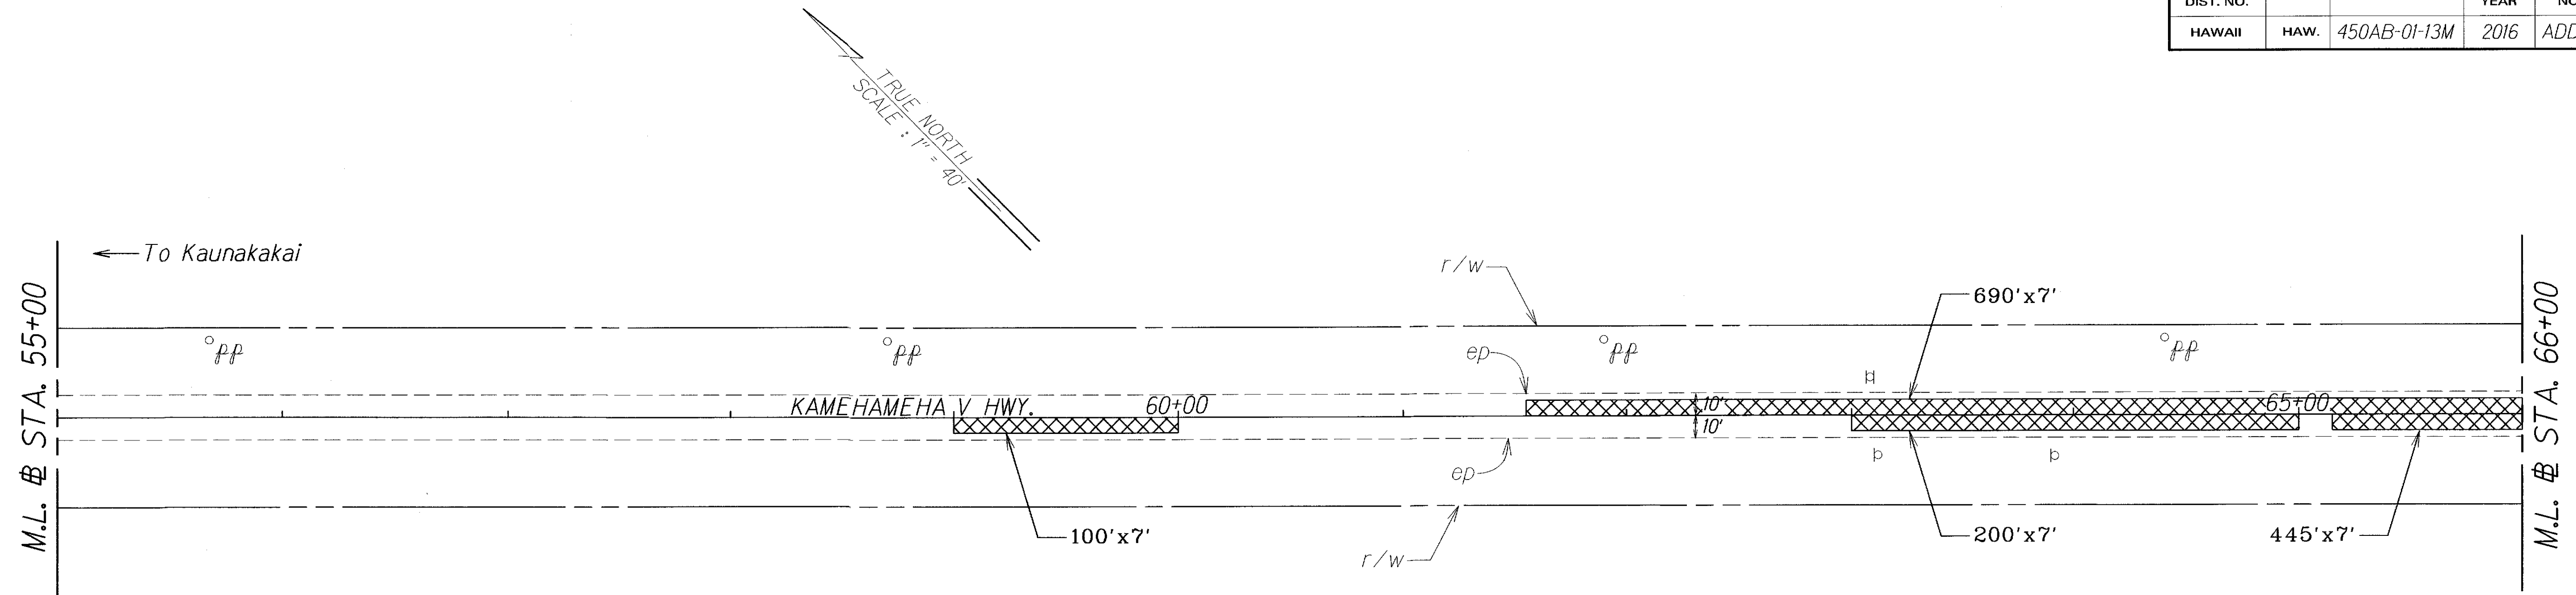

ORIGINAL PLAN	SURVEY PLOTTED BY	DATE
NOTE BOOK	DESIGNED BY	
QUANTITIES BY	CHECKED BY	

LEGEND FOR AS-BUILT POSTINGS	
	Squiggly line for as-built deletion
	Double line for as-built deletion
Roadway	Text for as-built posting

	4-27-16	Change Reconstruction Width.
--	---------	------------------------------



DATE	REVISION
------	----------

STATE OF HAWAII DEPARTMENT OF TRANSPORTATION HIGHWAYS DIVISION	
ROADWAY PLAN	
KAMEHAMEHA V HIGHWAY RESURFACING	
Kapuokoolau to Kamalo	
Project No. 450AB-01-13M	
Scale: 1" = 40'	Date: February, 2016
SHEET No. 2 OF 11 SHEETS	

"AS-BUILT"

ADD. 9

FED. ROAD DIST. NO.	STATE	PROJ. NO.	FISCAL YEAR	SHEET NO.	TOTAL SHEETS
HAWAII	HAW.	450AB-01-13M	2016	ADD.10	32

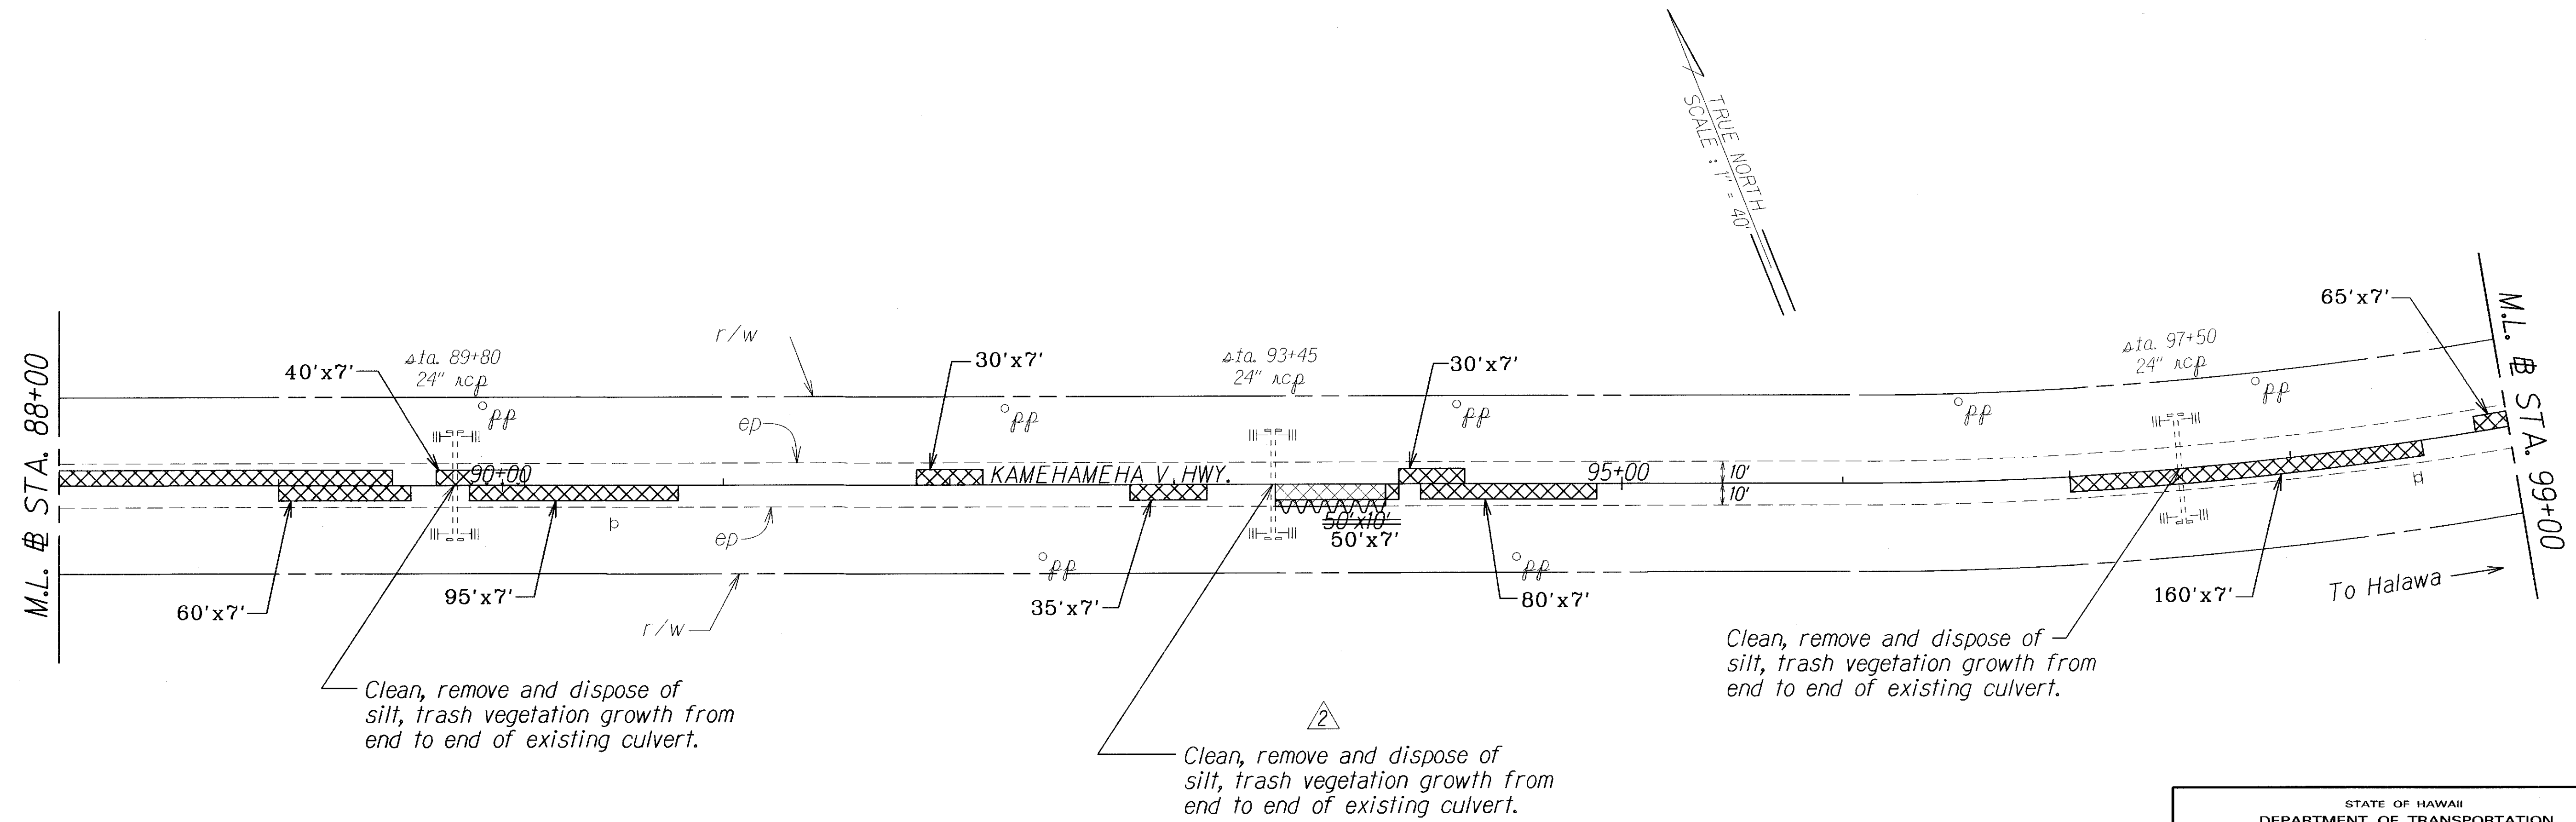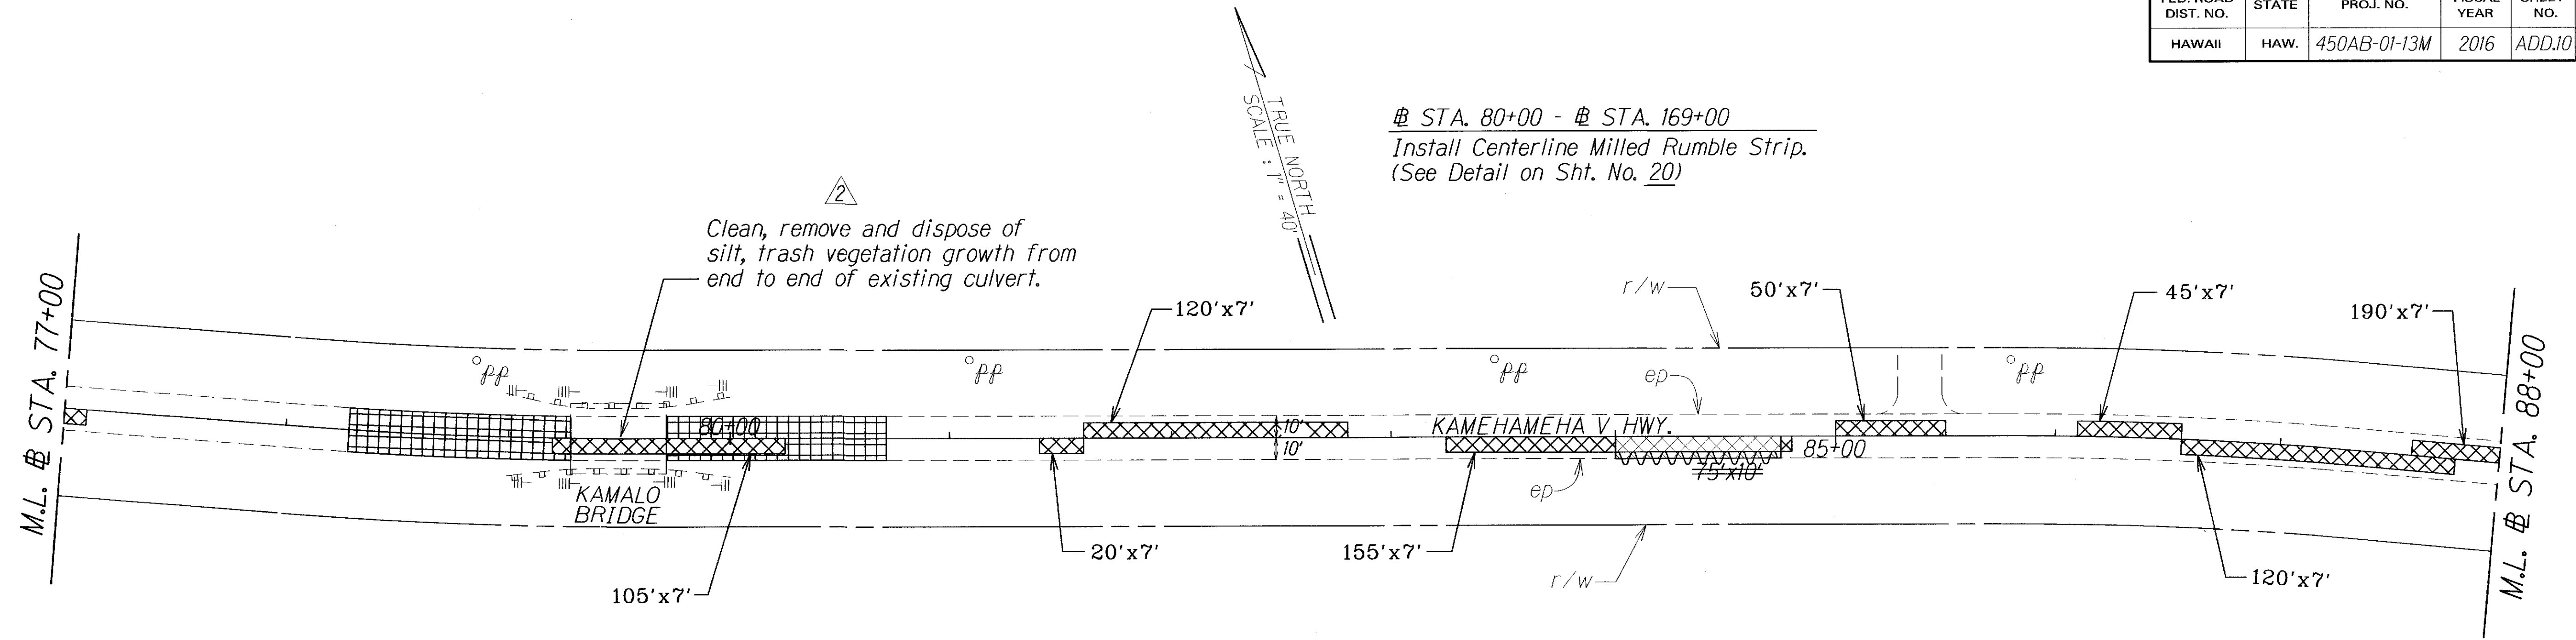

LEGEND FOR AS-BUILT POSTINGS	
	Squiggly line for as-built deletion
	Double line for as-built deletion
Roadway	Text for as-built posting

4-27-16 Add Culvert Notes.

DATE REVISION



STATE OF HAWAII
DEPARTMENT OF TRANSPORTATION
HIGHWAYS DIVISION
ROADWAY PLAN
KAMEHAMEHA V HIGHWAY RESURFACING
Kapukoolau to Kamalo
Project No. 450AB-01-13M
Scale: 1" = 40' Date: February, 2016
SHEET No. 3 OF 11 SHEETS

"AS-BUILT"

ADD. 10

ORIGINAL PLAN	SURVEY PLOTTED BY	DATE
NOTE BOOK	DRAWN BY	
DESIGNED BY	CHECKED BY	
QUANTITIES BY		
CHECKED BY		

FED. ROAD DIST. NO.	STATE	PROJ. NO.	FISCAL YEAR	SHEET NO.	TOTAL SHEETS
HAWAII	HAW.	450AB-01-13M	2016	ADD.11	32

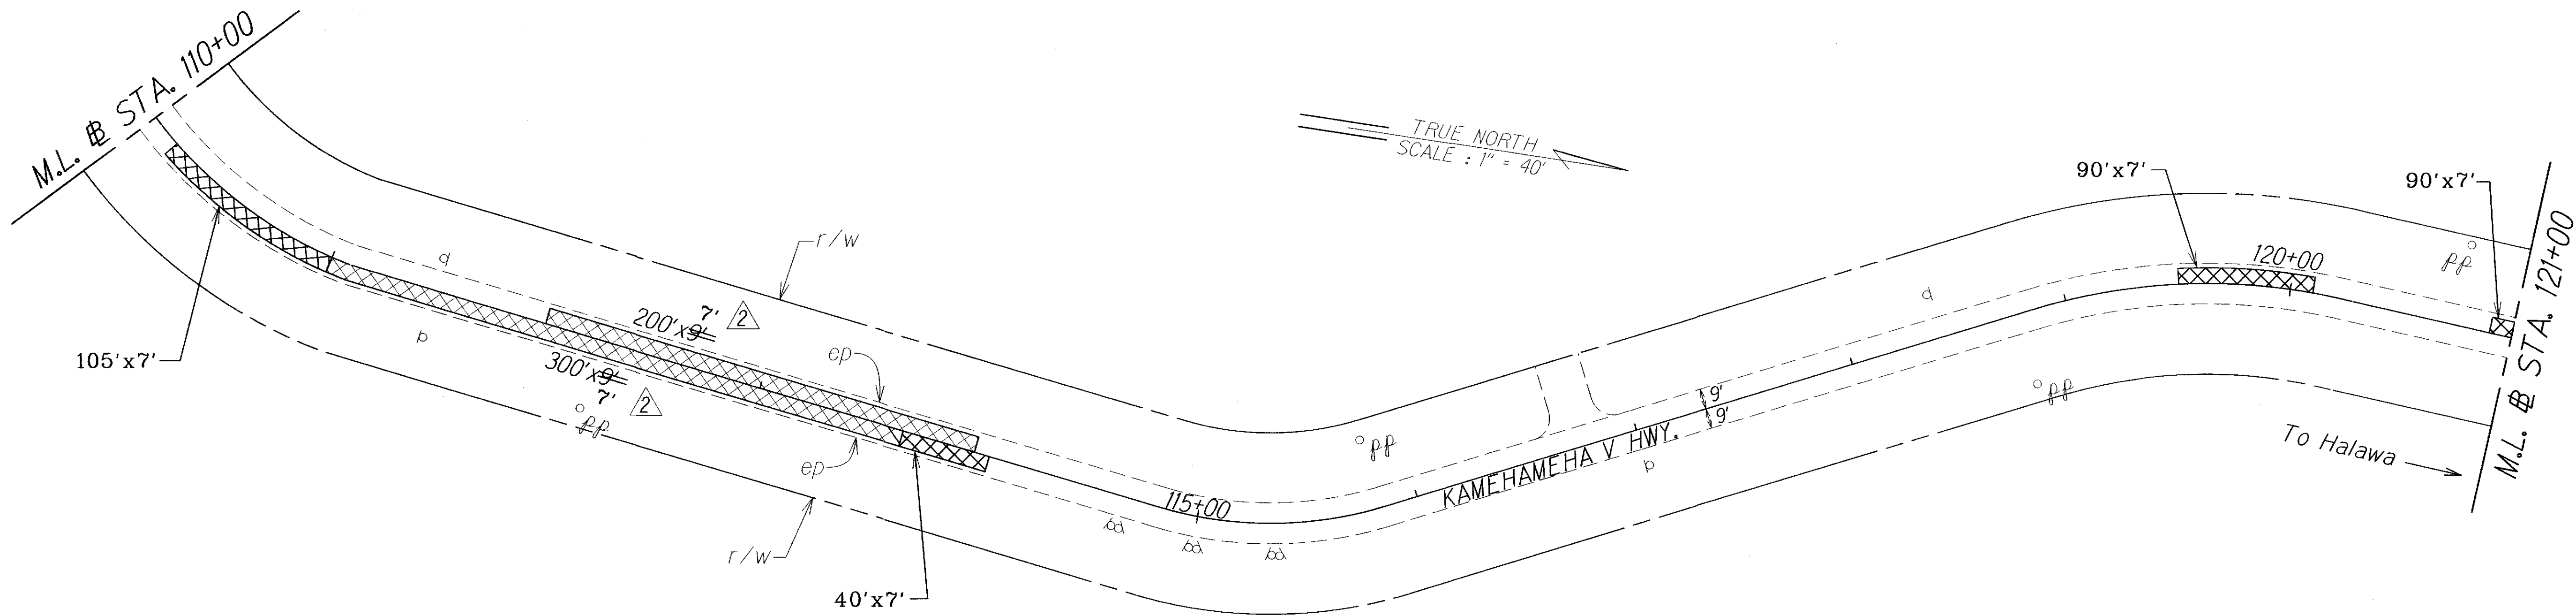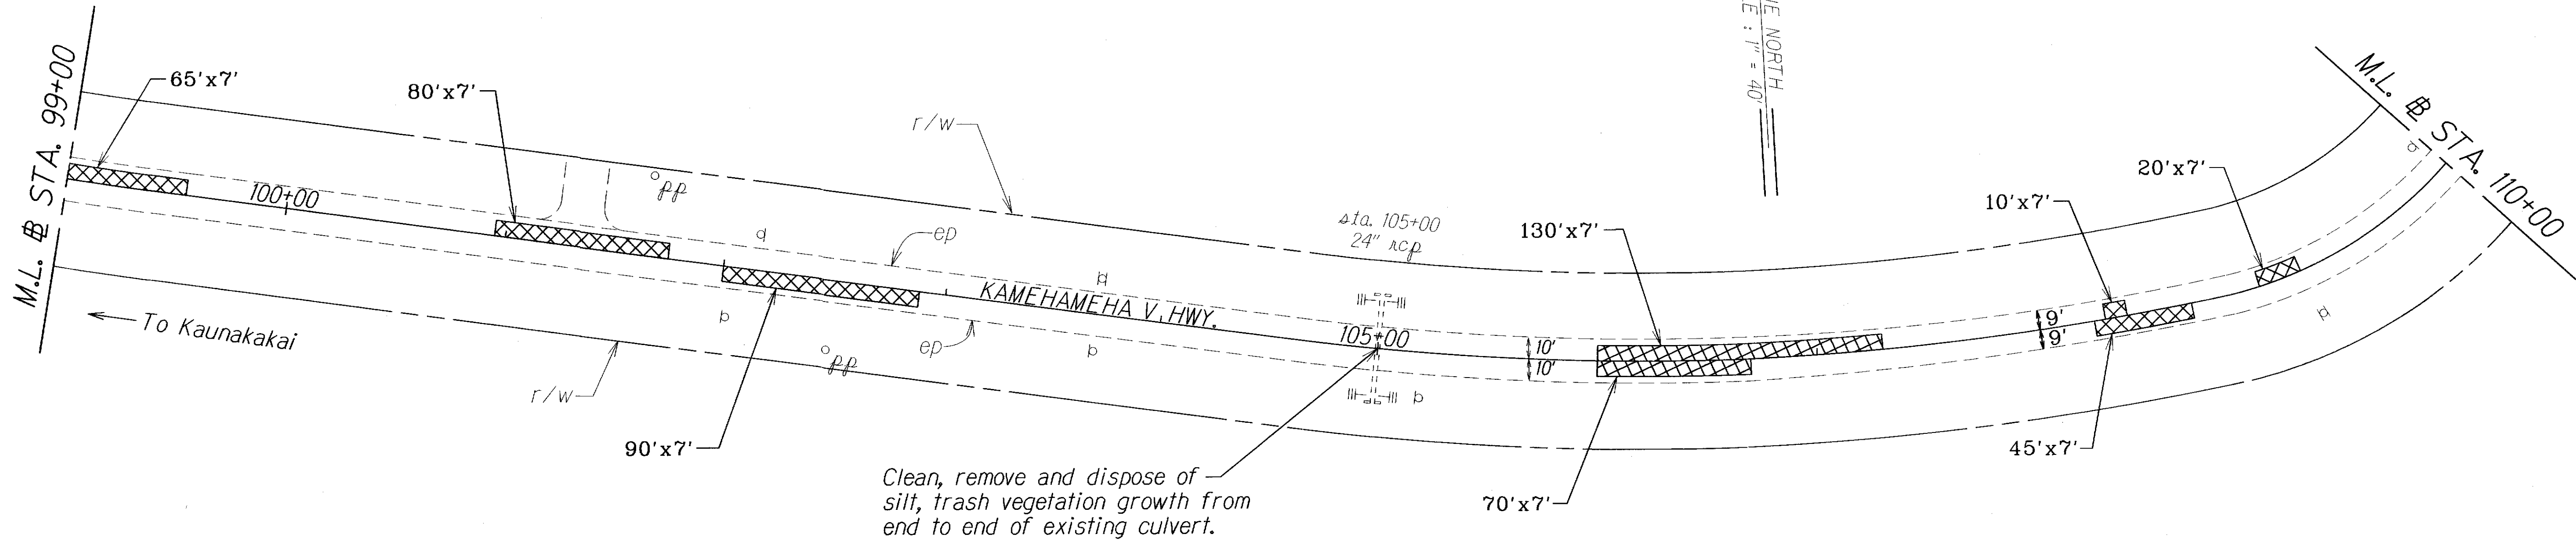

DESIGNED BY	DATE
DRAWN BY	
CHECKED BY	
NOTED BY	
QUANTITIES BY	
CHECKED BY	

LEGEND FOR AS-BUILT POSTINGS	
	Squiggly line for as-built deletion
	Double line for as-built deletion
Roadway	Text for as-built posting

2	4-27-16	Change Reconstruction Width.
---	---------	------------------------------


DATE	REVISION
------	----------

STATE OF HAWAII DEPARTMENT OF TRANSPORTATION HIGHWAYS DIVISION	
ROADWAY PLAN	
KAMEHAMEHA V HIGHWAY RESURFACING Kapuokoolau to Kamalo Project No. 450AB-01-13M	
Scale: 1" = 40'	Date: February, 2016
SHEET No. 4 OF 11 SHEETS	

"AS-BUILT"

ADD. 11

FED. ROAD DIST. NO.	STATE	PROJ. NO.	FISCAL YEAR	SHEET NO.	TOTAL SHEETS
HAWAII	HAW.	450AB-01-13M	2016	ADD.12	32

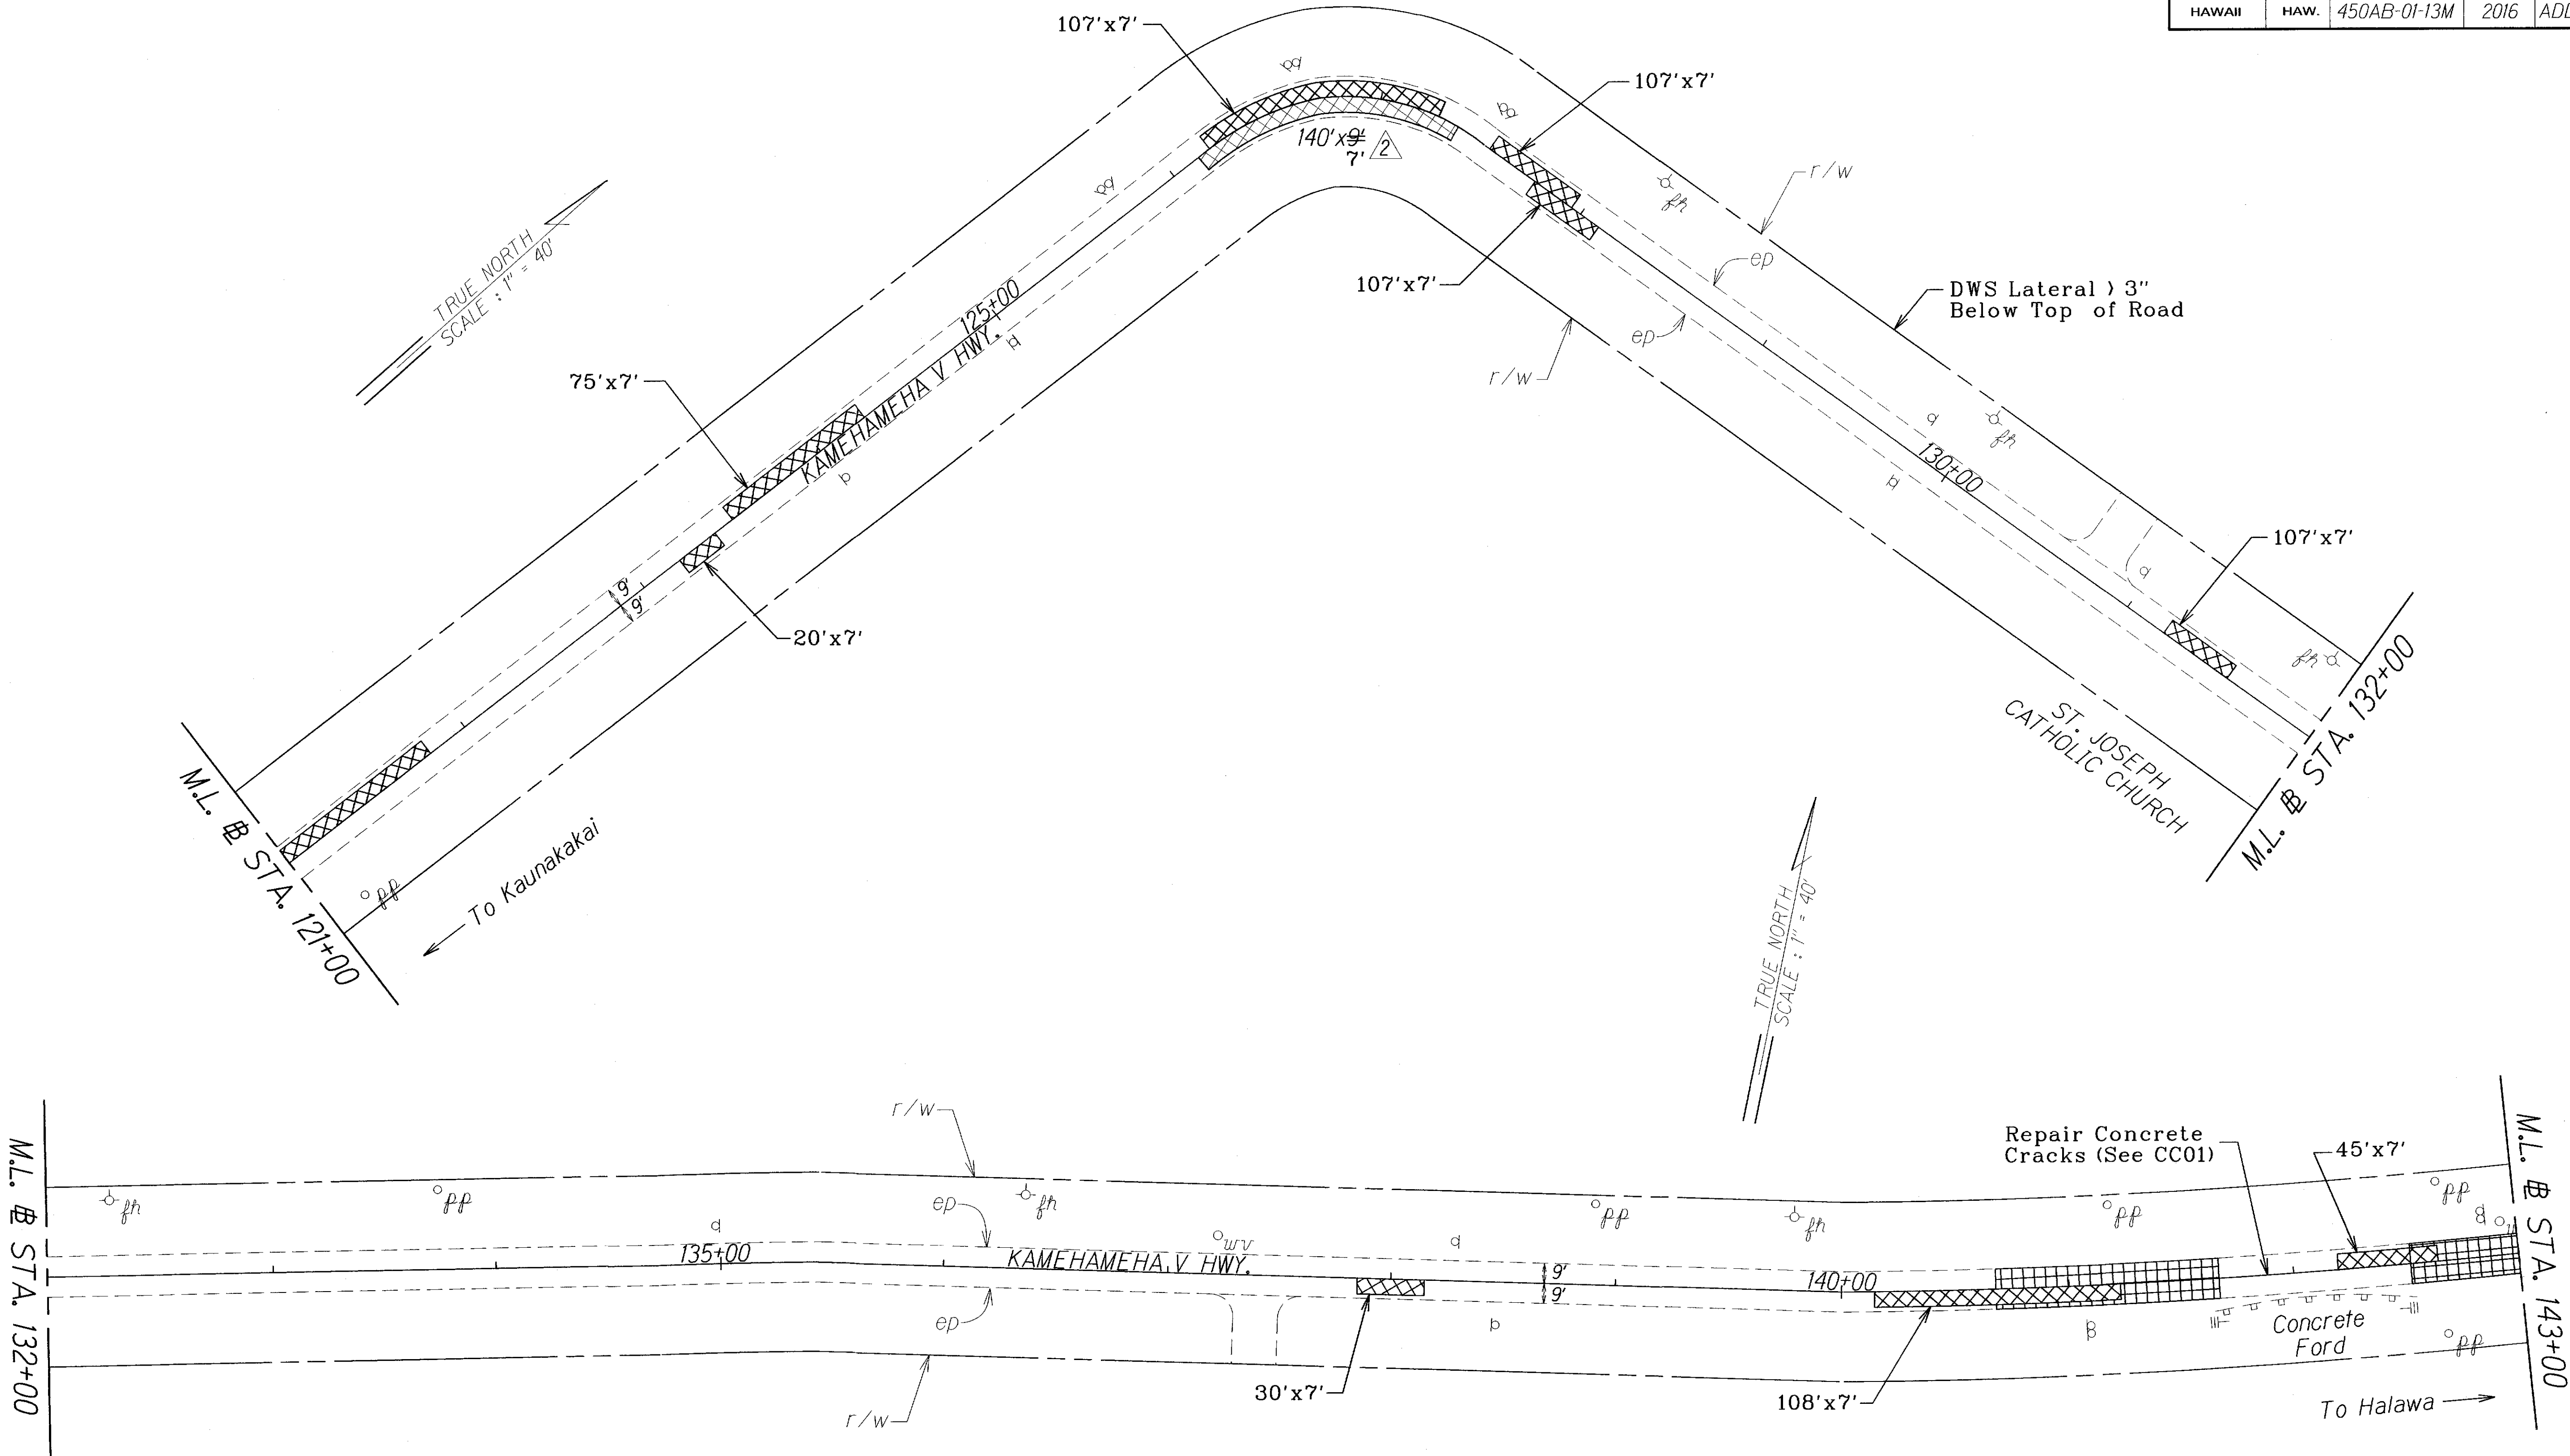

ORIGINAL PLAN	DATE
SURVEY PLOTTED BY	
DRAWN BY	
DESIGNED BY	
QUANTITIES BY	
CHECKED BY	

LEGEND FOR AS-BUILT POSTINGS	
	Squiggly line for as-built deletion
	Double line for as-built deletion
Roadway	Text for as-built posting

2	4-27-16	Change Reconstruction Width.
---	---------	------------------------------


DATE	REVISION
------	----------

STATE OF HAWAII DEPARTMENT OF TRANSPORTATION HIGHWAYS DIVISION	
ROADWAY PLAN	
KAMEHAMEHA V HIGHWAY RESURFACING	
Kapuokoolau to Kamalo	
Project No. 450AB-01-13M	
Scale: 1" = 40'	Date: February, 2016
SHEET No. 5 OF 11 SHEETS	

"AS-BUILT"

ADD. 12

FED. ROAD DIST. NO.	STATE	PROJ. NO.	FISCAL YEAR	SHEET NO.	TOTAL SHEETS
HAWAII	HAW.	450AB-01-13M	2016	ADD.13	32

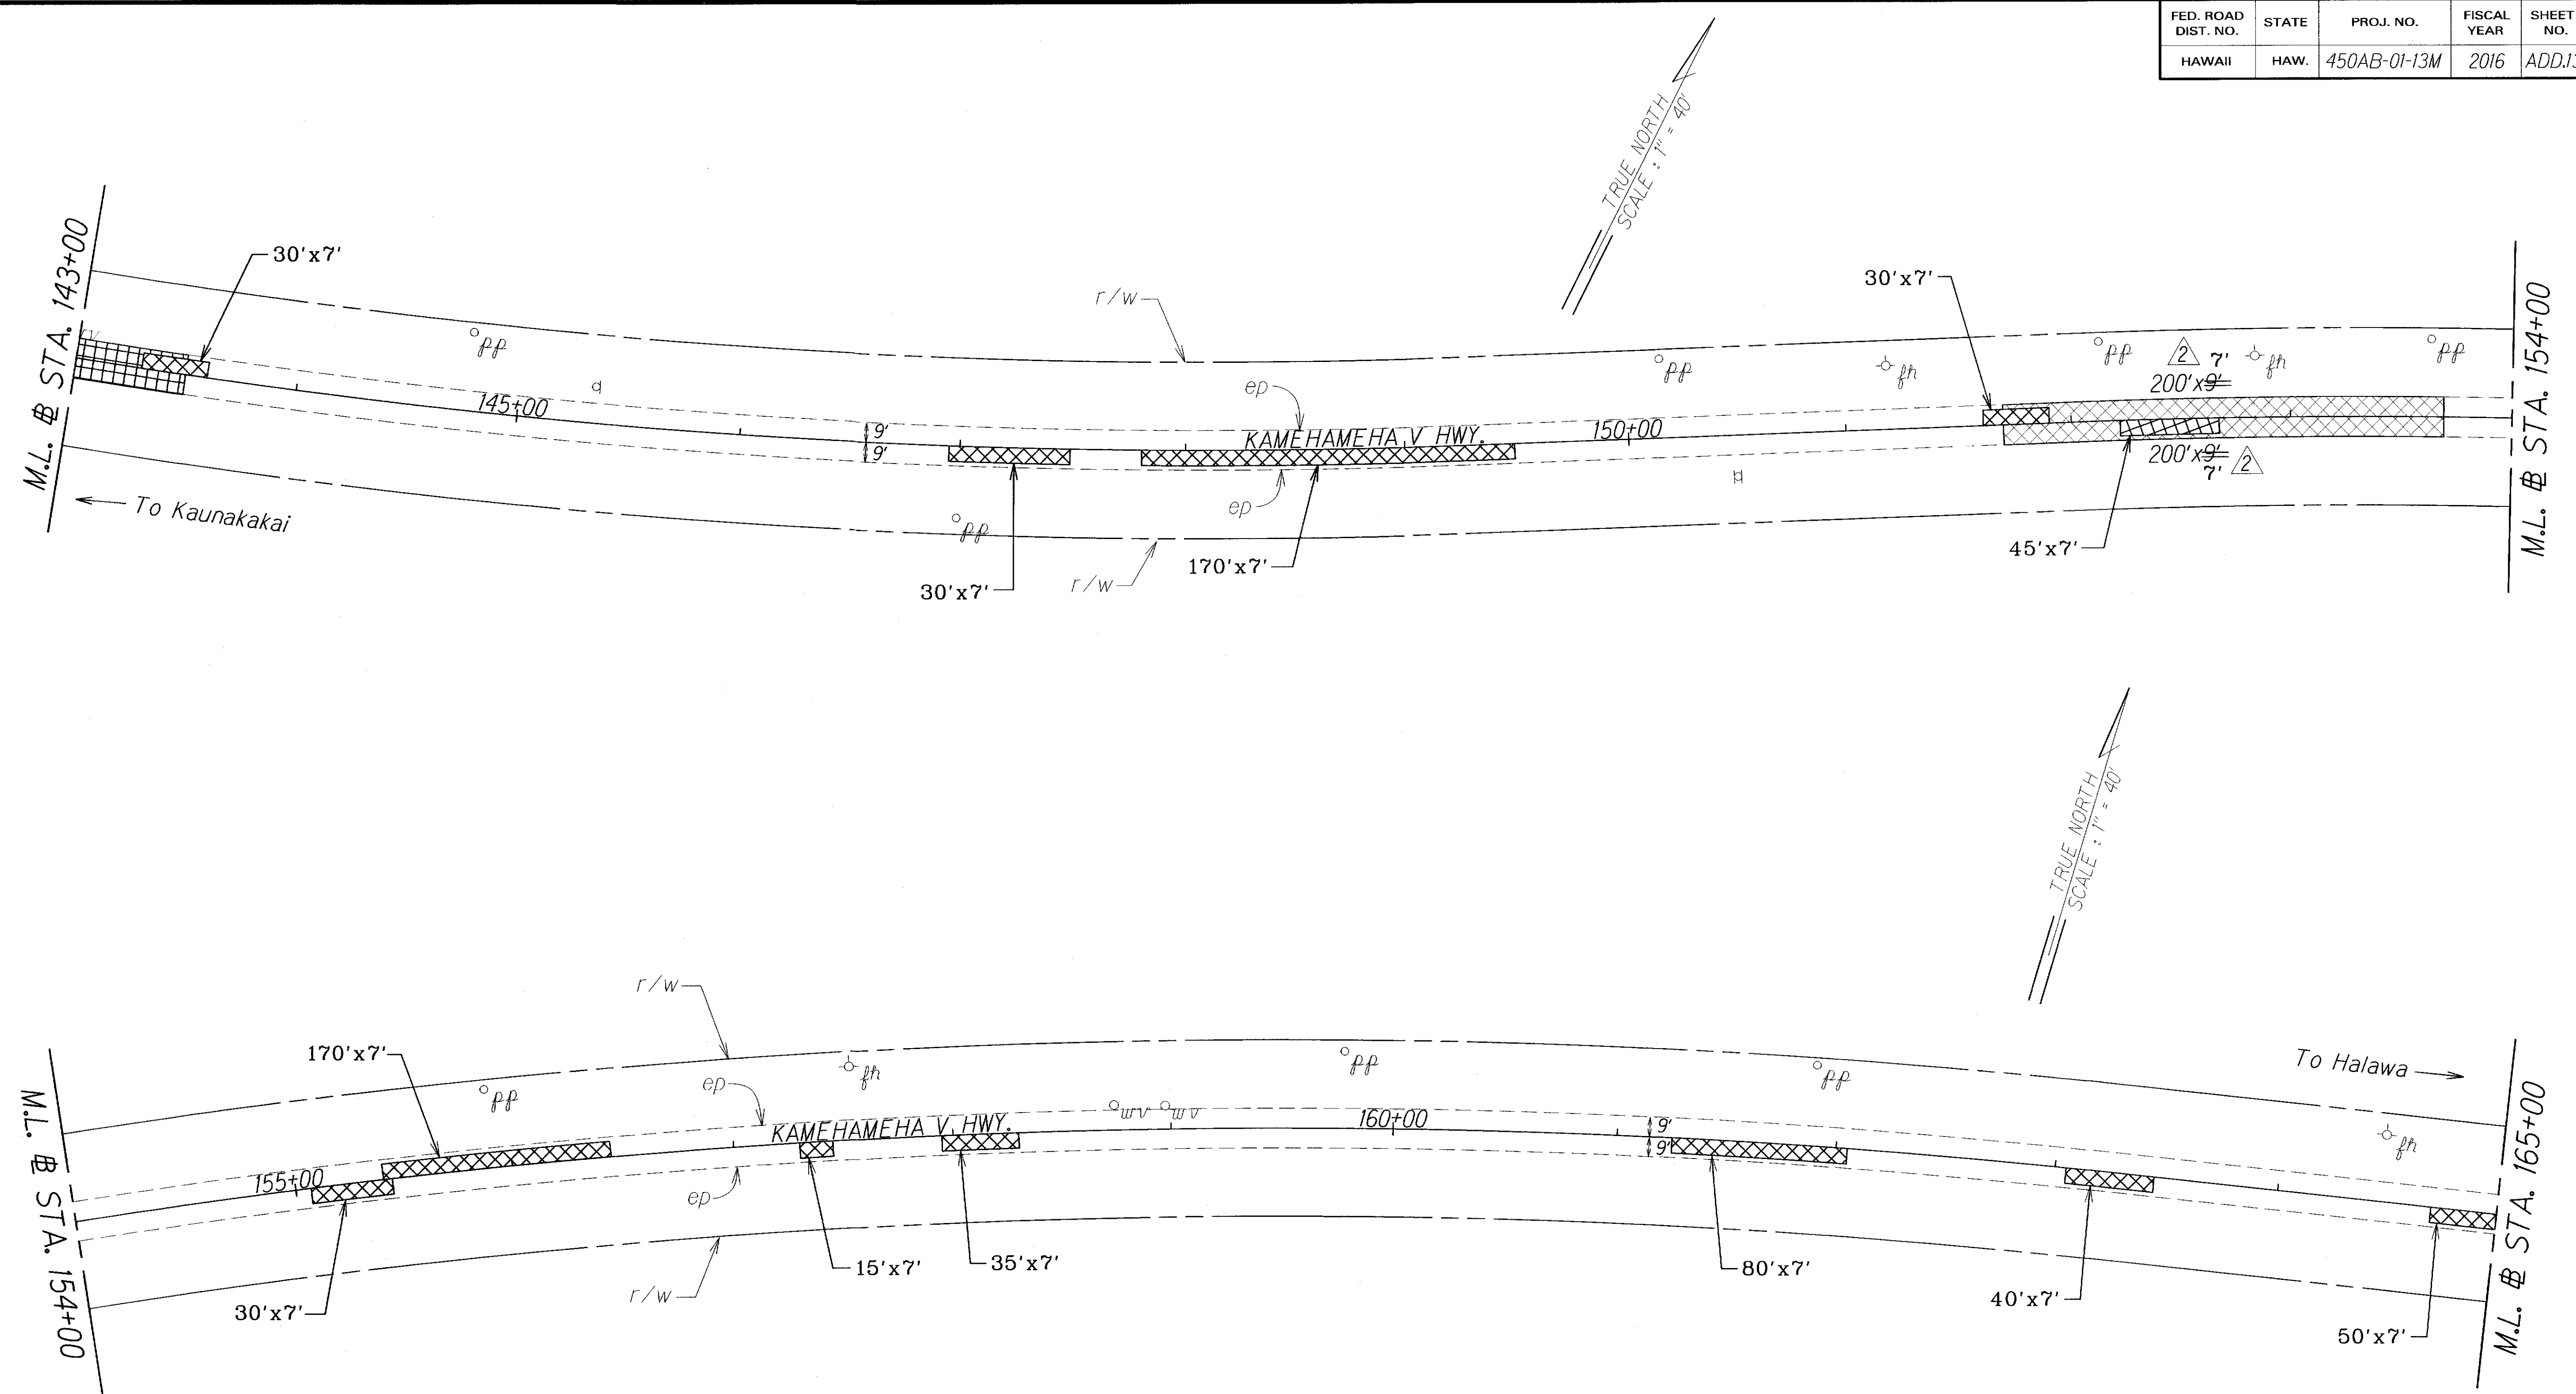

ORIGINAL PLAN	SURVEY PLOTTED BY	DATE
DESIGNED BY		
NOTED BY		
QUANTITIES BY		
CHECKED BY		

* 3" ATB Various Locations Sta. 157+00 to Sta. 197+00, 293 Ton to 3".
For A.C. Reconstruction Details See Plan Sheet No. 7.

LEGEND FOR AS-BUILT POSTINGS	
	Squiggly line for as-built deletion
	Double line for as-built deletion
Roadway	Text for as-built posting

	4-27-16	Change Reconstruction Width.
DATE	REVISION	

STATE OF HAWAII
DEPARTMENT OF TRANSPORTATION
HIGHWAYS DIVISION

ROADWAY PLAN

KAMEHAMEHA V HIGHWAY RESURFACING
Kapuokoolau to Kamalo
Project No. 450AB-01-13M



Scale: 1" = 40' Date: February, 2016

SHEET No. 6 OF 11 SHEETS

"AS-BUILT"

ADD. 13

FED. ROAD DIST. NO.	STATE	PROJ. NO.	FISCAL YEAR	SHEET NO.	TOTAL SHEETS
HAWAII	HAW.	450AB-01-13M	2016	14	32

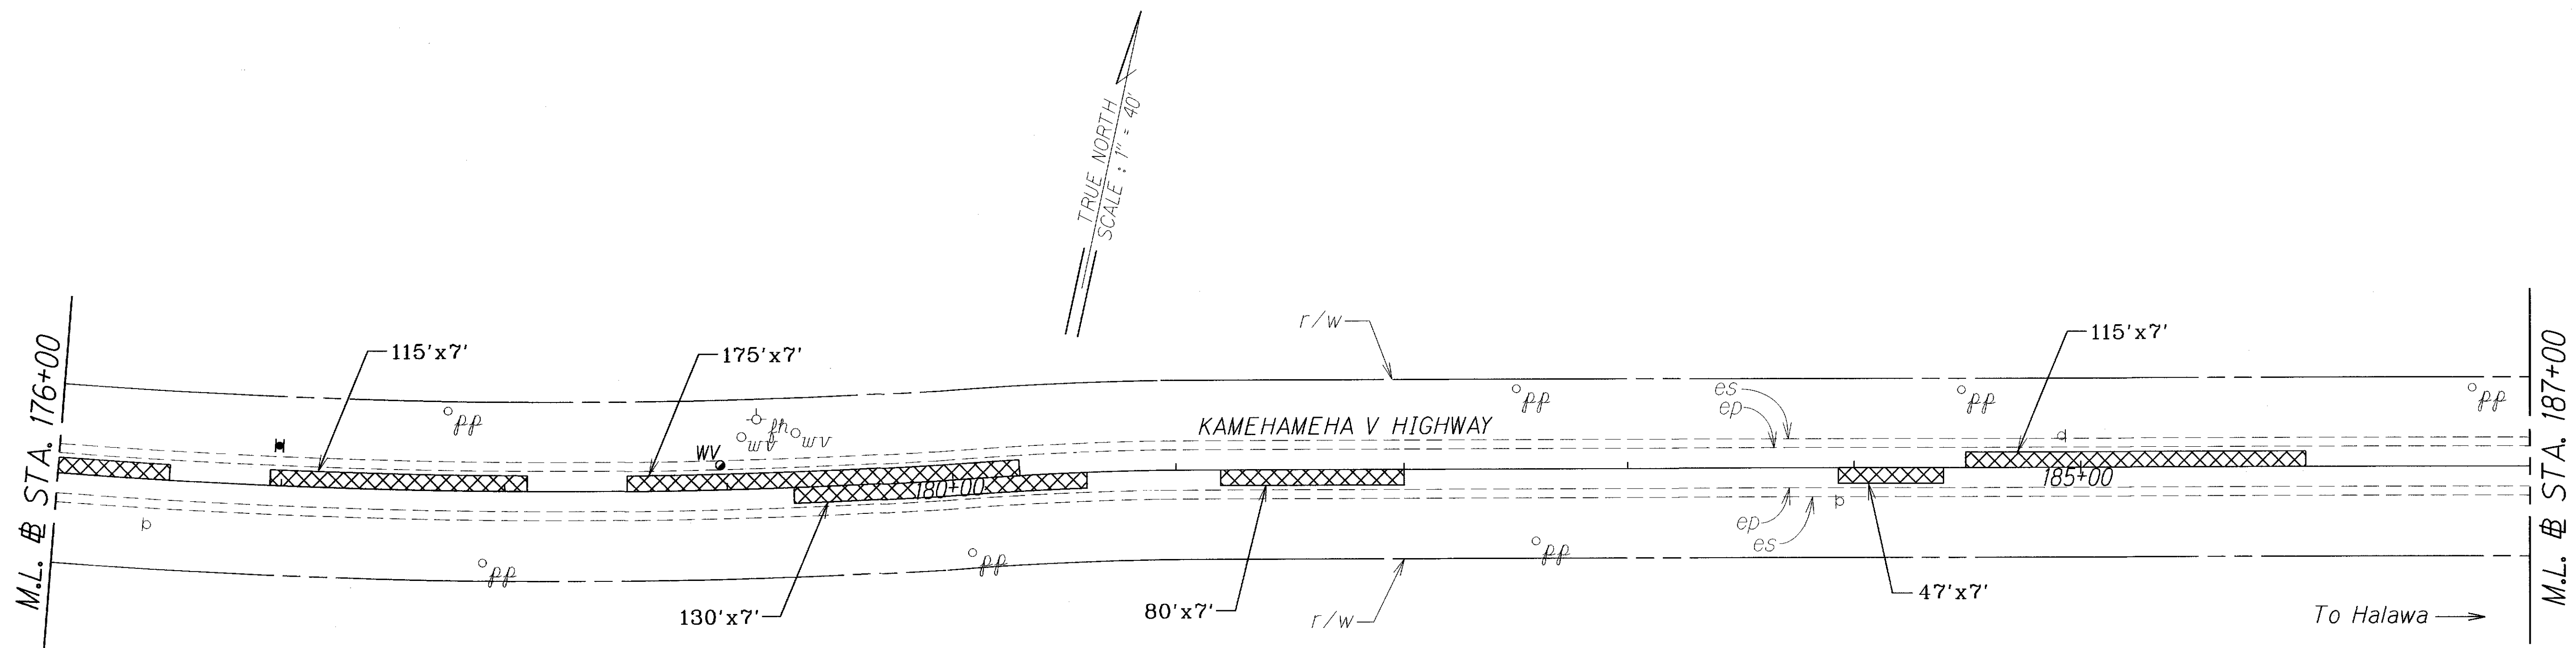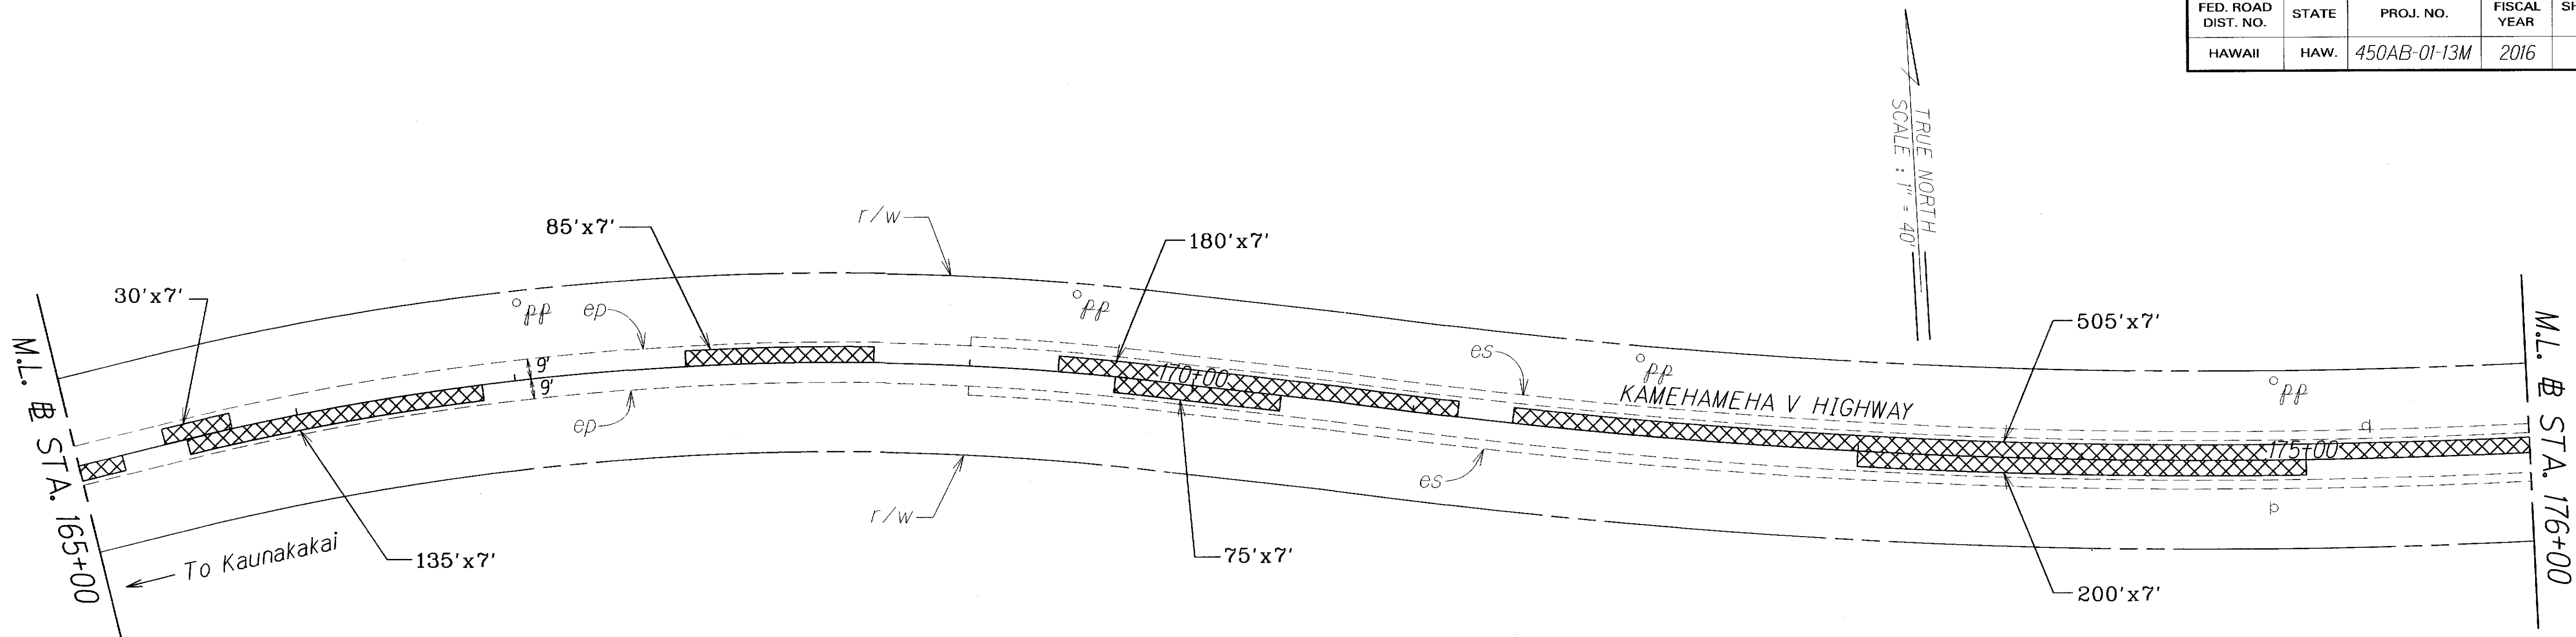


ORIGINAL PLAN	SURVEY PLOTTED BY	DATE
NOTE BOOK	DRAWN BY	
DESIGNED BY	CHECKED BY	
QUANTITIES BY		
CHECKED BY		

LEGEND FOR AS-BUILT POSTINGS	
	Squiggly line for as-built deletion
	Double line for as-built deletion
Roadway	Text for as-built posting

STATE OF HAWAII DEPARTMENT OF TRANSPORTATION HIGHWAYS DIVISION	
ROADWAY PLAN	
KAMEHAMEHA V HIGHWAY RESURFACING	
Kapuokoolau to Kamalo	
Project No. 450AB-01-13M	
Scale: 1" = 40'	Date: February, 2016
SHEET No. 7 OF 11 SHEETS	

"AS-BUILT"

FED. ROAD DIST. NO.	STATE	PROJ. NO.	FISCAL YEAR	SHEET NO.	TOTAL SHEETS
HAWAII	HAW.	450AB-01-13M	2016	ADD.15	32

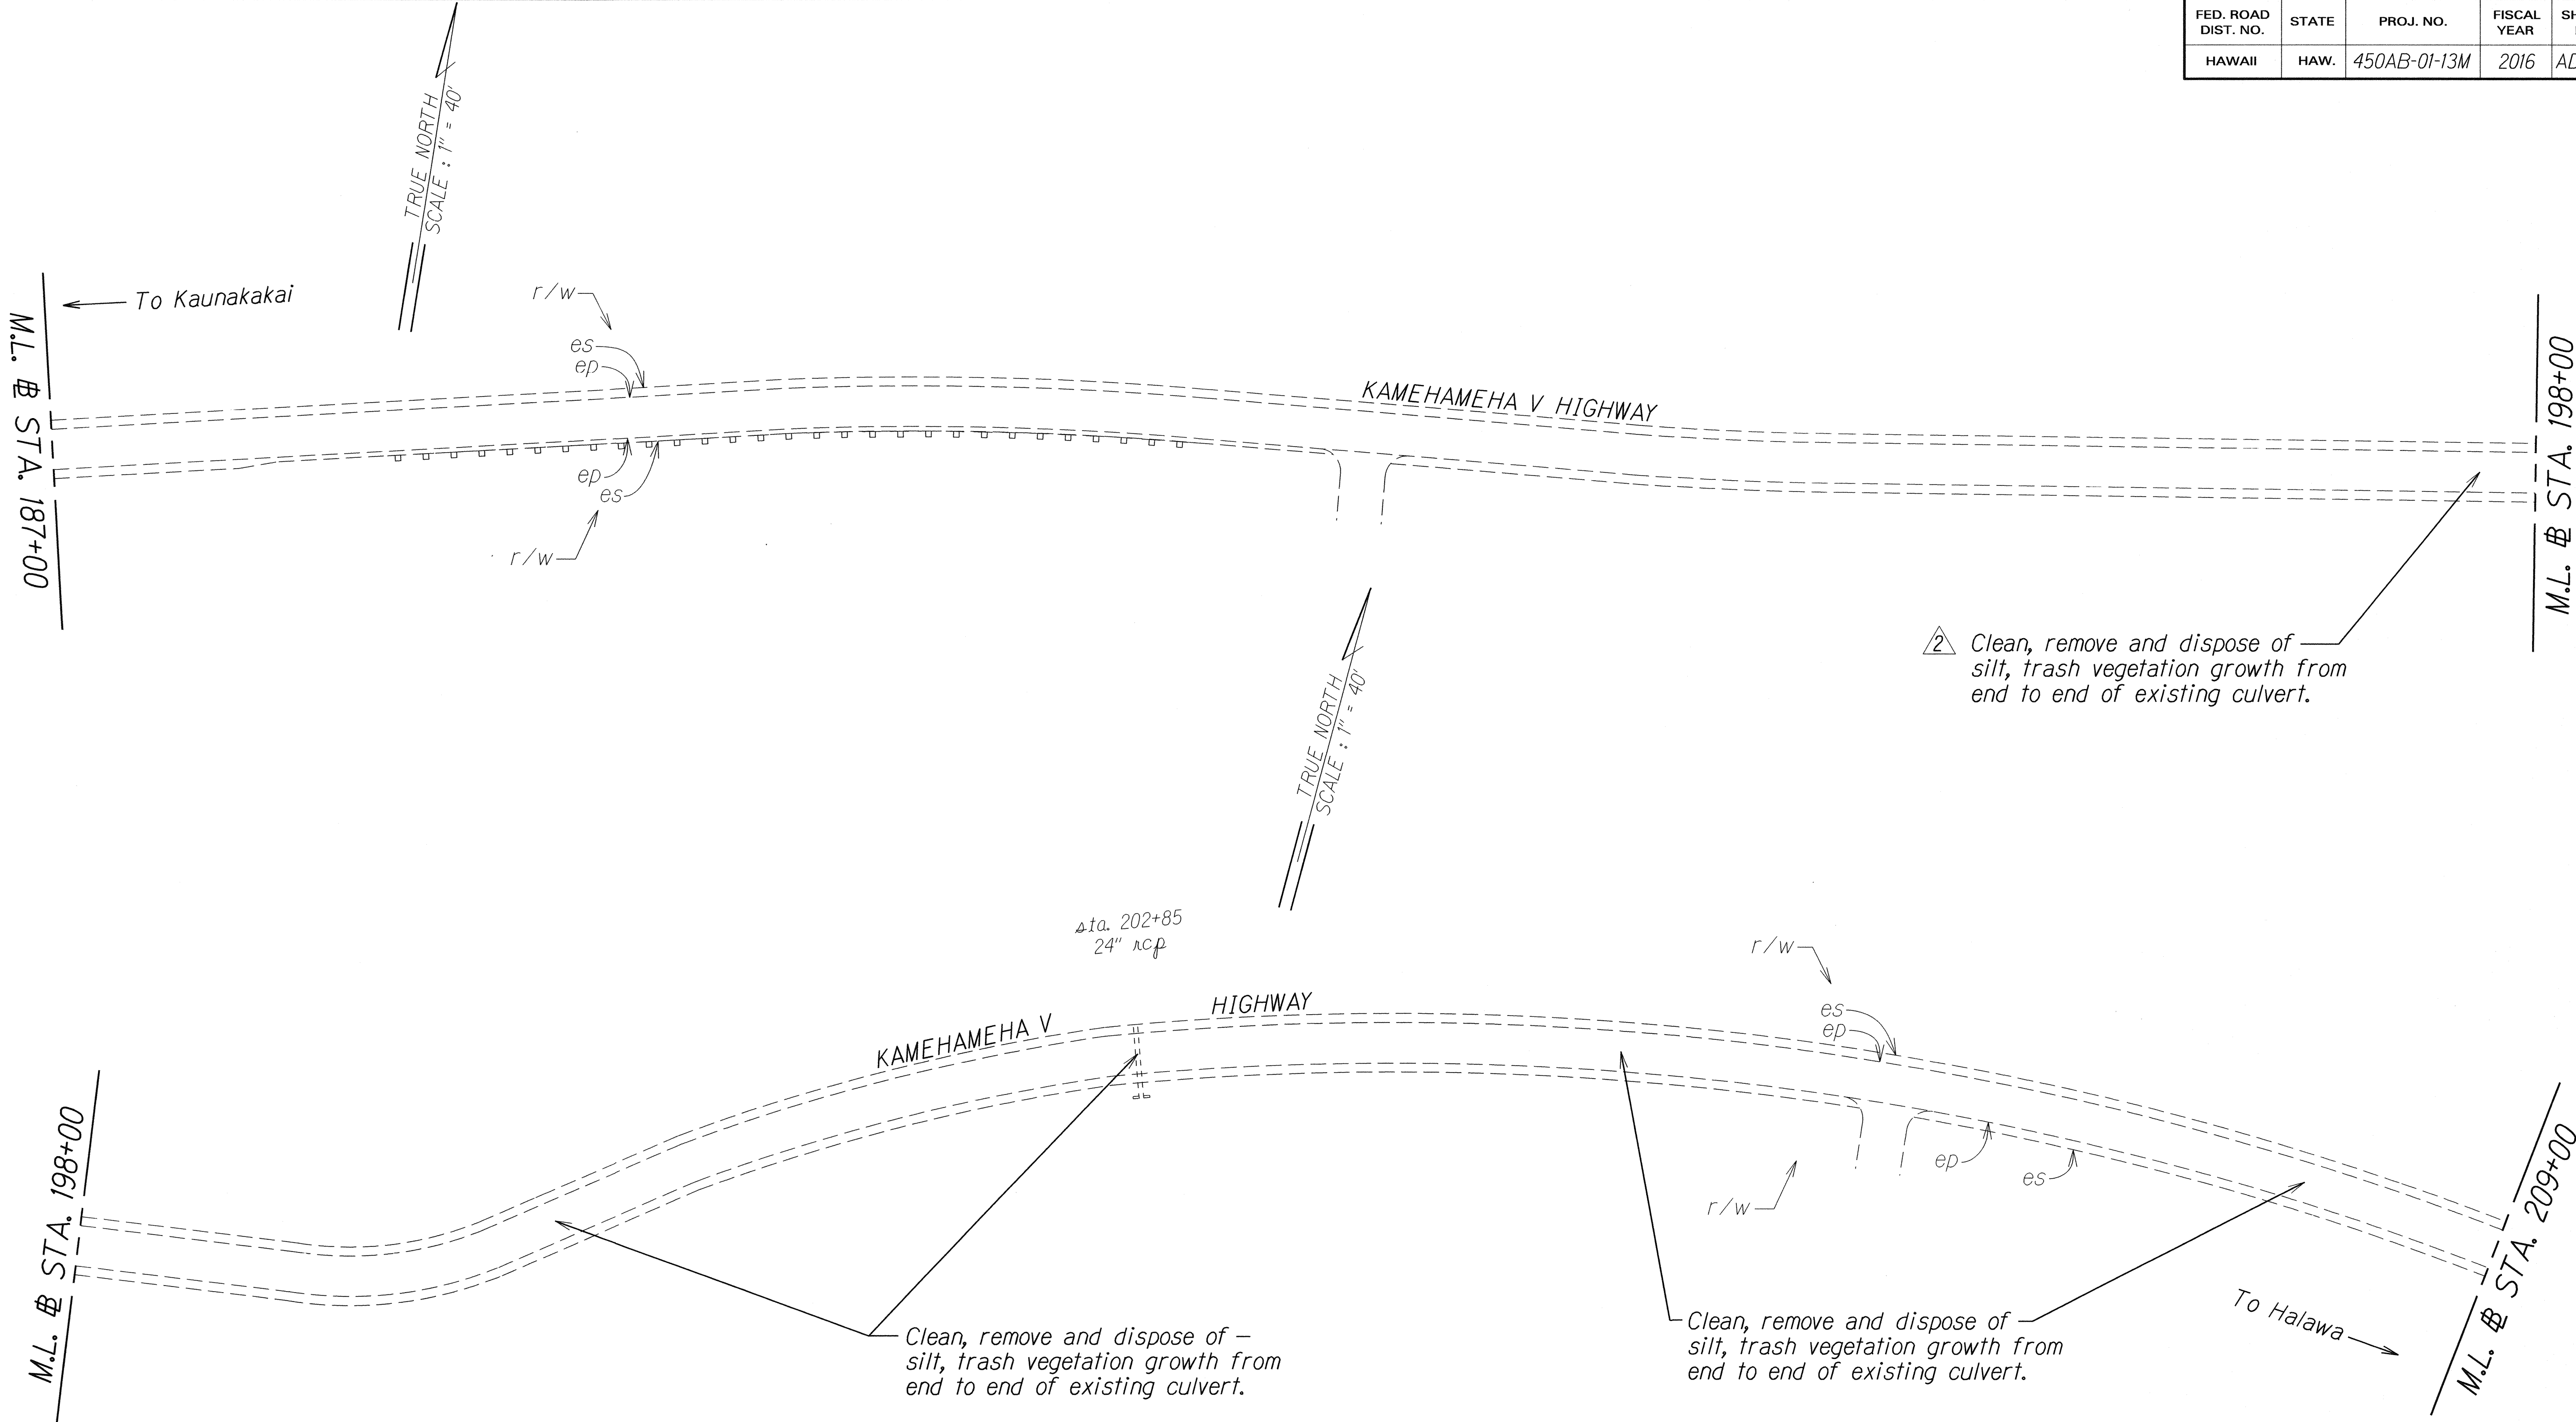

ORIGINAL PLAN	SURVEY PLOTTED BY	DATE
NOTE BOOK	DESIGNED BY	
	QUANTITIES BY	
	CHECKED BY	

4-27-16 Add Culvert Notes.

DATE REVISION


STATE OF HAWAII
DEPARTMENT OF TRANSPORTATION
HIGHWAYS DIVISION

ROADWAY PLAN
KAMEHAMEHA V HIGHWAY RESURFACING
Kapuokoolau to Kamalo
Project No. 450AB-01-13M

Scale: 1" = 40'
Date: February, 2016

SHEET No. 8 OF 11 SHEETS

FED. ROAD DIST. NO.	STATE	PROJ. NO.	FISCAL YEAR	SHEET NO.	TOTAL SHEETS
HAWAII	HAW.	450AB-01-13M	2016	16	32

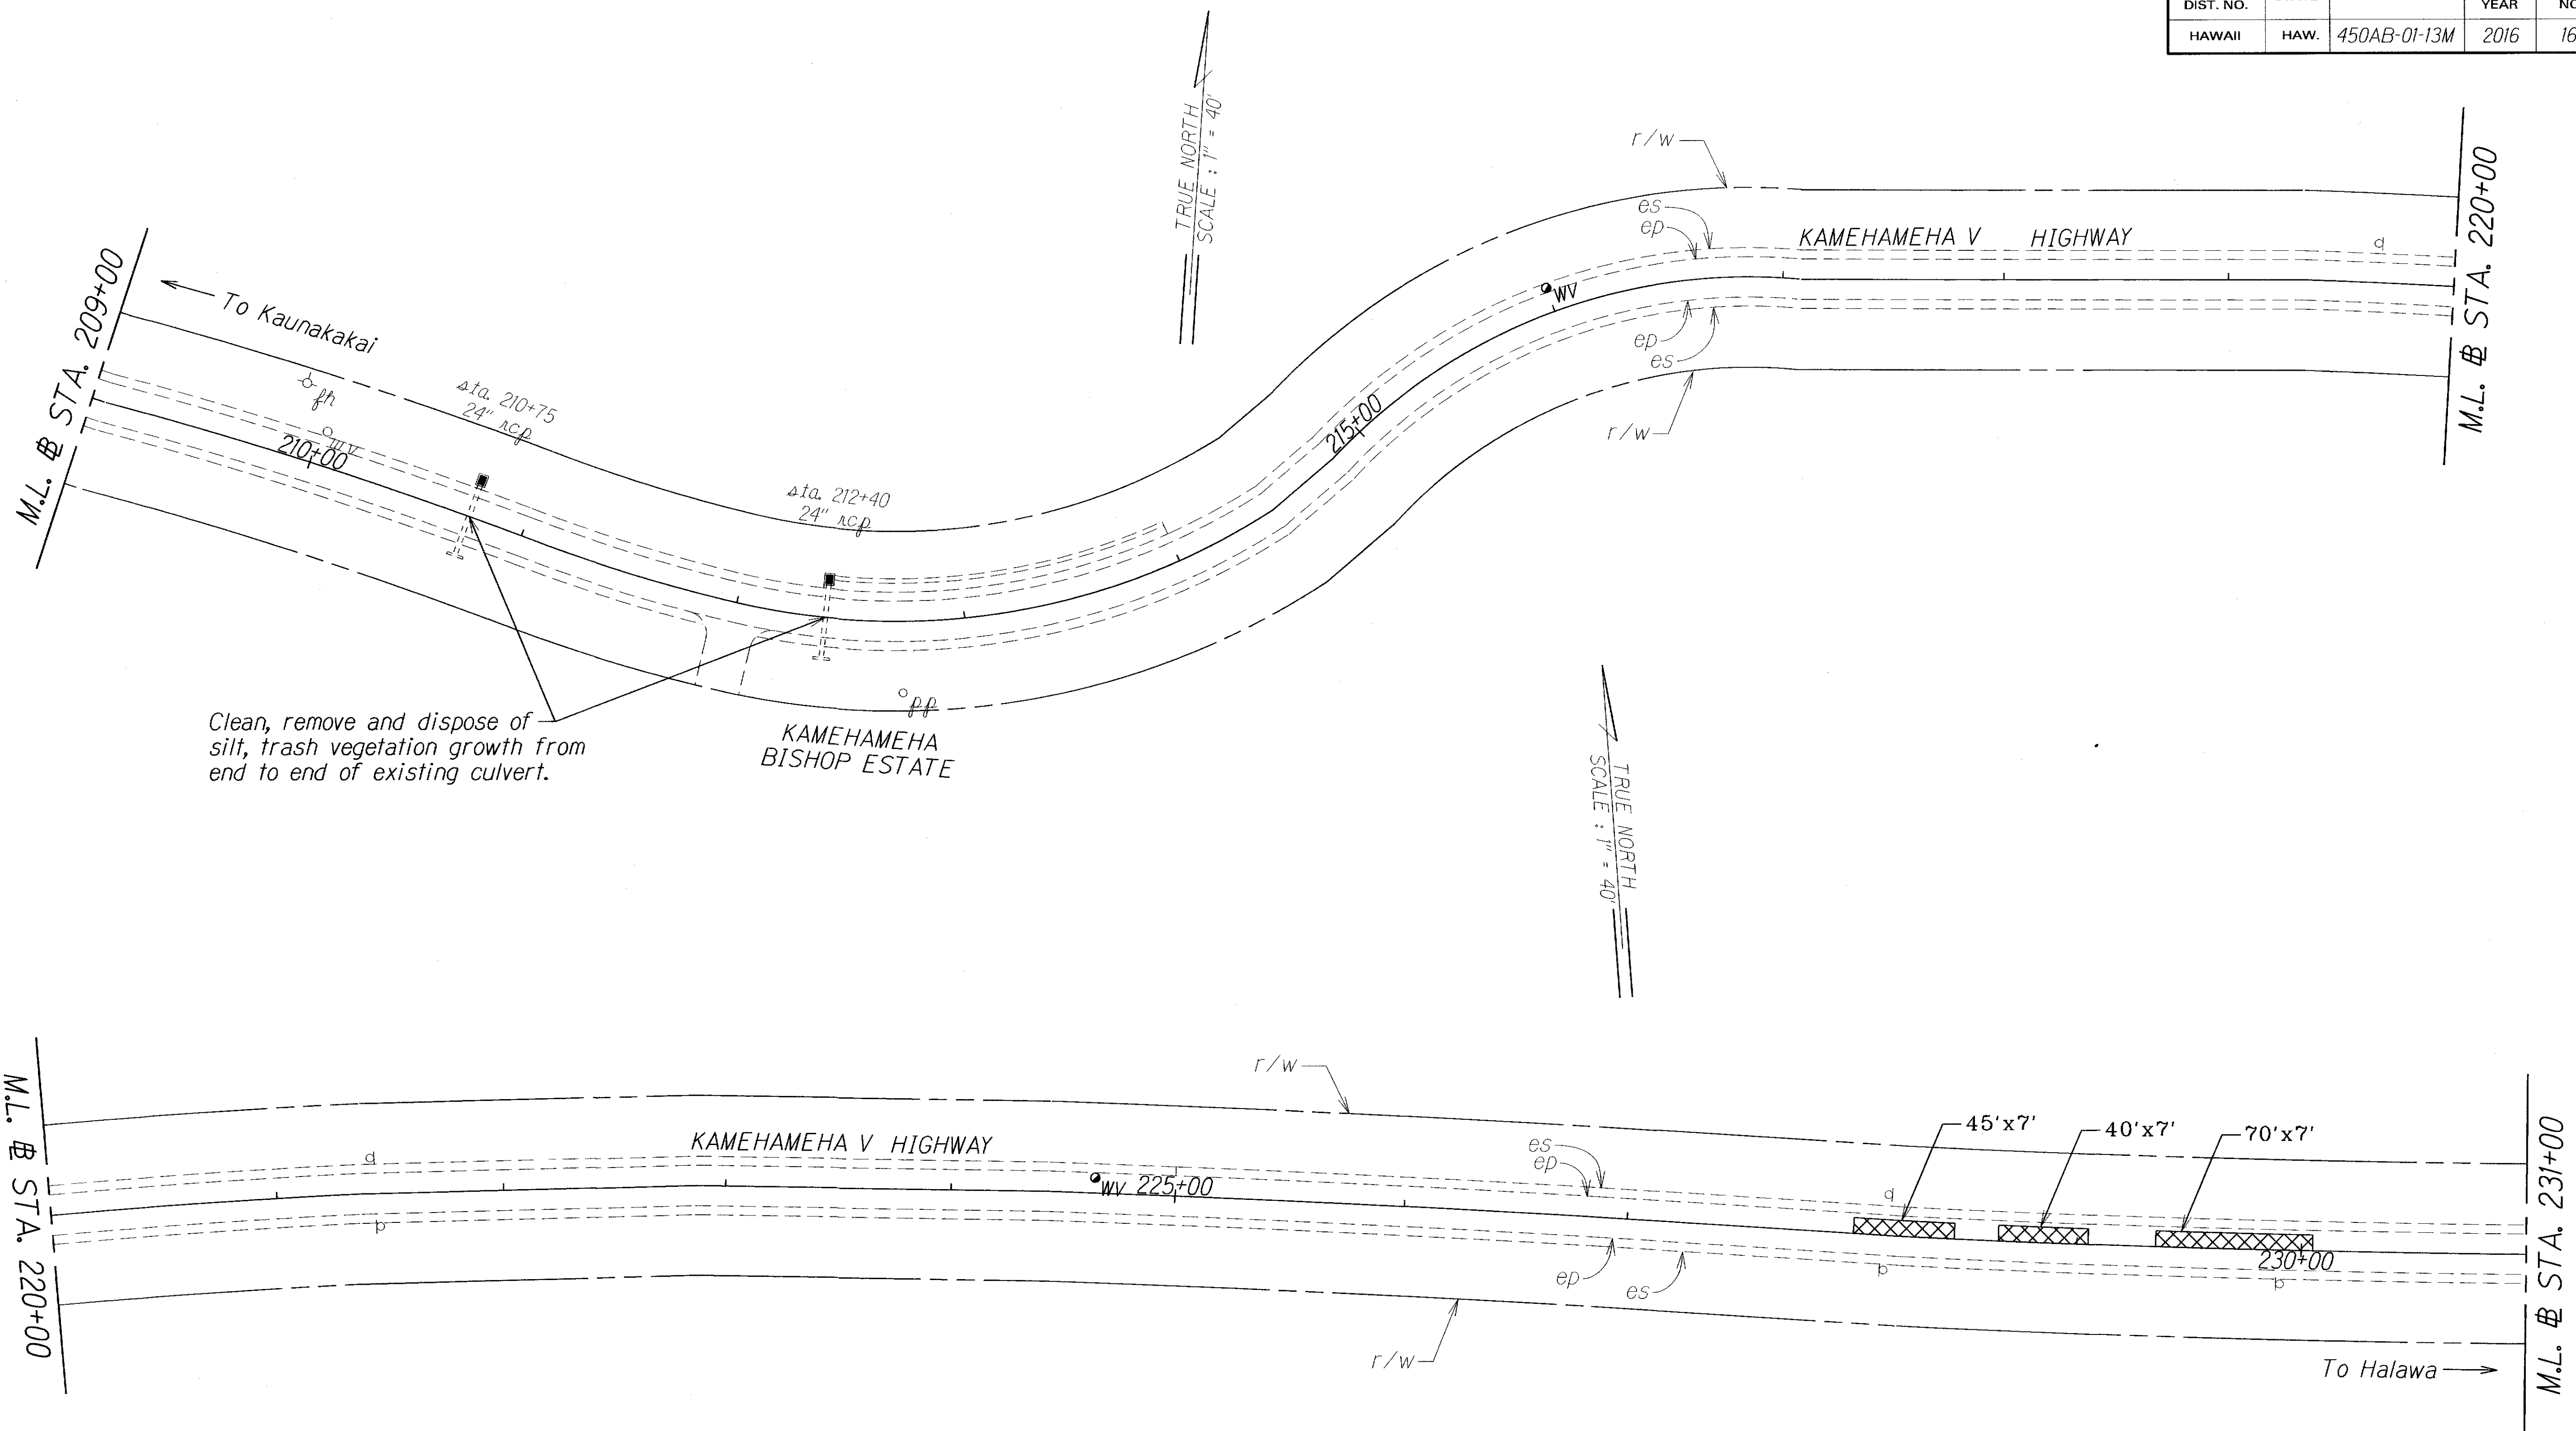


ORIGINAL PLAN	SURVEY PLOTTED BY	DATE
NOTE BOOK	DRAWN BY	2/22/16
	DESIGNED BY	
	QUANTITIES BY	
	CHECKED BY	

LEGEND FOR AS-BUILT POSTINGS	
	Squiggly line for as-built deletion
	Double line for as-built deletion
Roadway	Text for as-built posting

STATE OF HAWAII DEPARTMENT OF TRANSPORTATION HIGHWAYS DIVISION	
ROADWAY PLAN	
KAMEHAMEHA V HIGHWAY RESURFACING	
Kapuokoolau to Kamalo	
Project No. 450AB-01-13M	
Scale: 1" = 40'	Date: February, 2016
SHEET No. 9 OF 11 SHEETS	

"AS-BUILT"

FED. ROAD DIST. NO.	STATE	PROJ. NO.	FISCAL YEAR	SHEET NO.	TOTAL SHEETS
HAWAII	HAW.	450AB-01-13M	2016	ADD.17	32

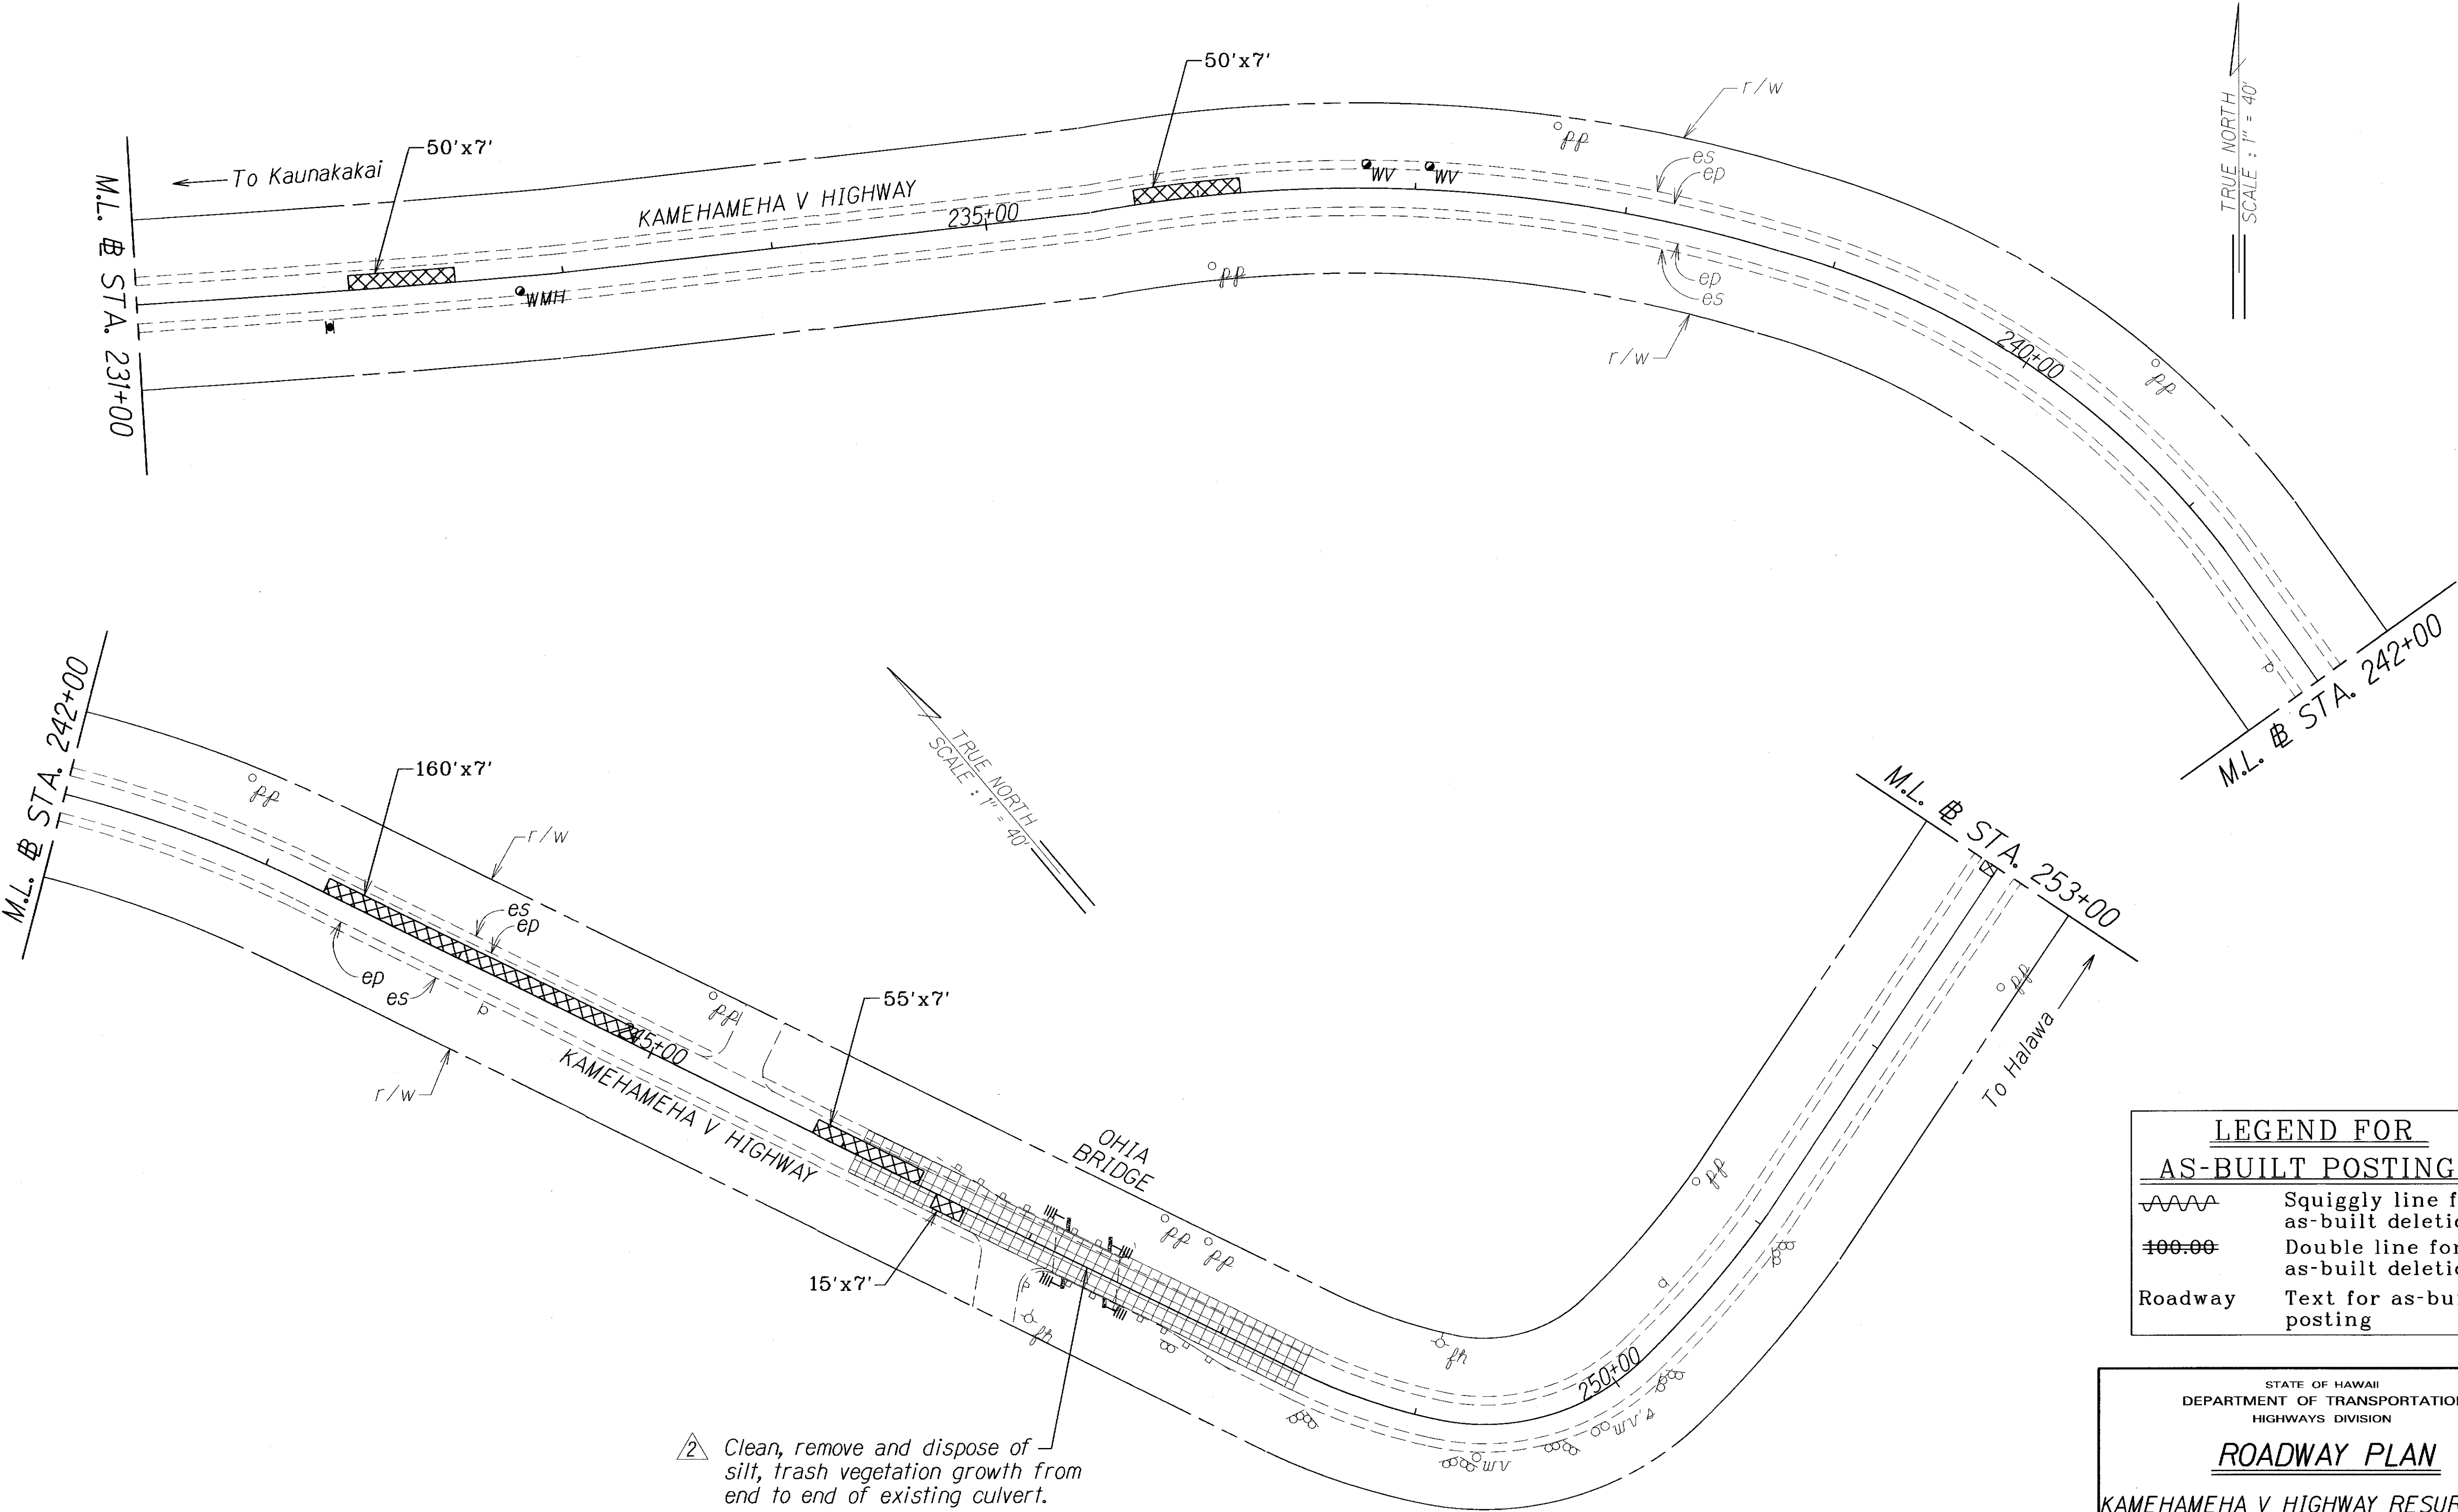

LEGEND FOR AS-BUILT POSTINGS	
	Squiggly line for as-built deletion
	Double line for as-built deletion
Roadway	Text for as-built posting

STATE OF HAWAII
DEPARTMENT OF TRANSPORTATION
HIGHWAYS DIVISION

ROADWAY PLAN
KAMEHAMEHA V HIGHWAY RESURFACING
Kapuokoolau to Kamalo
Project No. 450AB-01-13M
Scale: 1" = 40'
Date: February, 2016

SHEET No. 10 OF 11 SHEETS

ORIGINAL PLAN	DATE
NOTED BY	DATE
DESIGNED BY	DATE
CHECKED BY	DATE


2 4-27-16 Add Culvert Notes.

DATE REVISION

"AS-BUILT"

ADD. 17

FED. ROAD DIST. NO.	STATE	PROJ. NO.	FISCAL YEAR	SHEET NO.	TOTAL SHEETS
HAWAII	HAW.	450AB-01-13M	2016	18	32

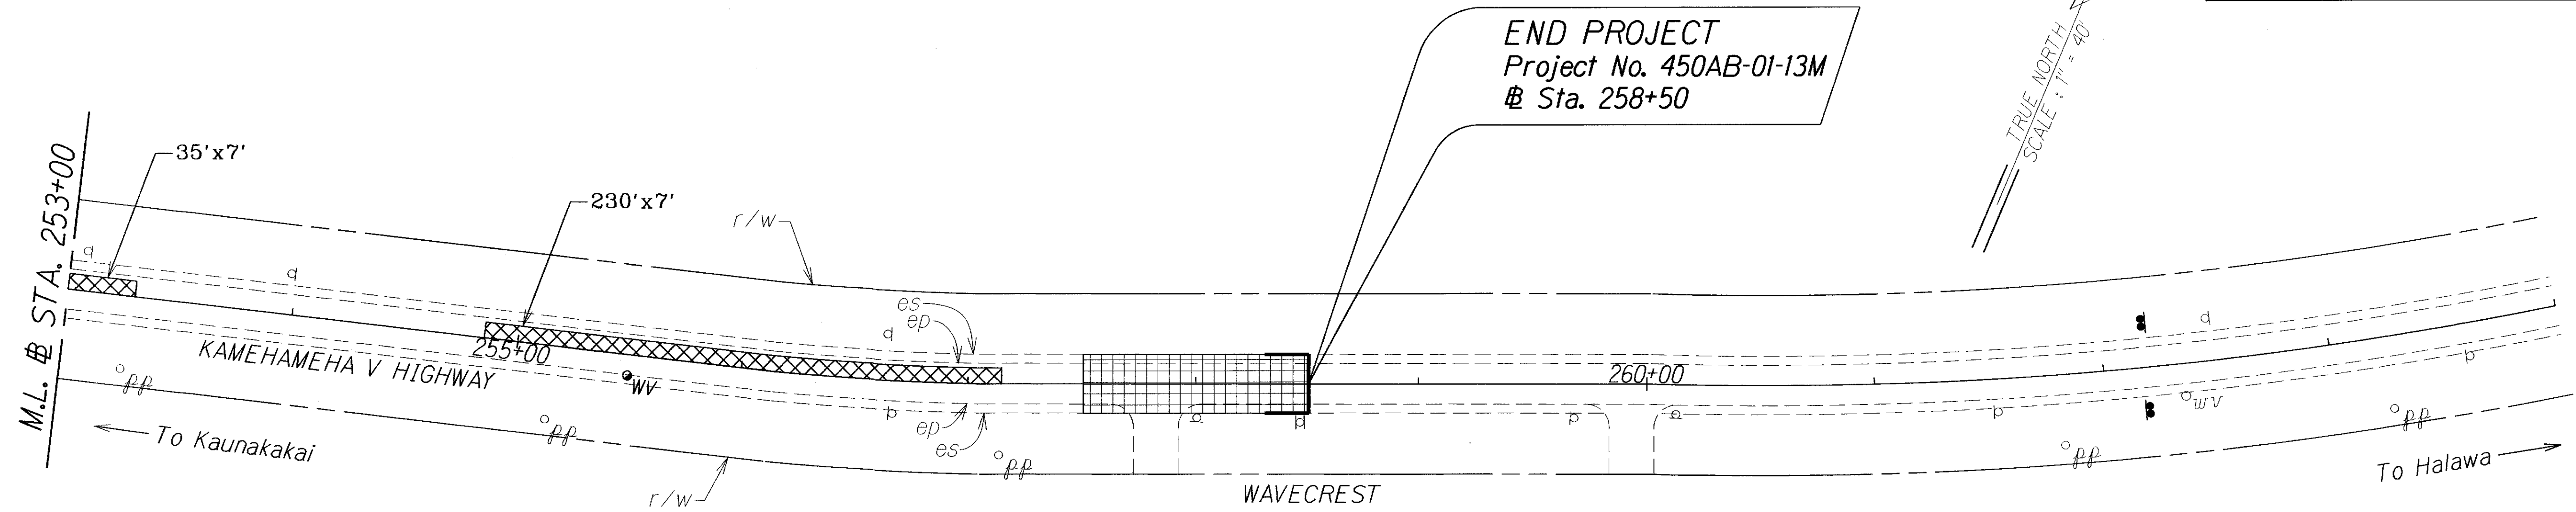

ORIGINAL PLAN	SURVEY PLOTTED BY	DATE
NOTE BOOK	DESIGNED BY	
	QUANTITIES BY	
	CHECKED BY	

LEGEND FOR AS-BUILT POSTINGS	
	Squiggly line for as-built deletion
	Double line for as-built deletion
Roadway	Text for as-built posting

STATE OF HAWAII DEPARTMENT OF TRANSPORTATION HIGHWAYS DIVISION	
ROADWAY PLAN	
KAMEHAMEHA V HIGHWAY RESURFACING	
Kapuokoolau to Kamalo	
Project No. 450AB-01-13M	
Scale: 1" = 40'	Date: February, 2016
SHEET No. 11 OF 11 SHEETS	

"AS-BUILT"