




FED. ROAD DIST. NO.	STATE	PROJ. NO.	FISCAL YEAR	SHEET NO.	TOTAL SHEETS
HAWAII	HAW.	450A-01-12M	2014	6	38

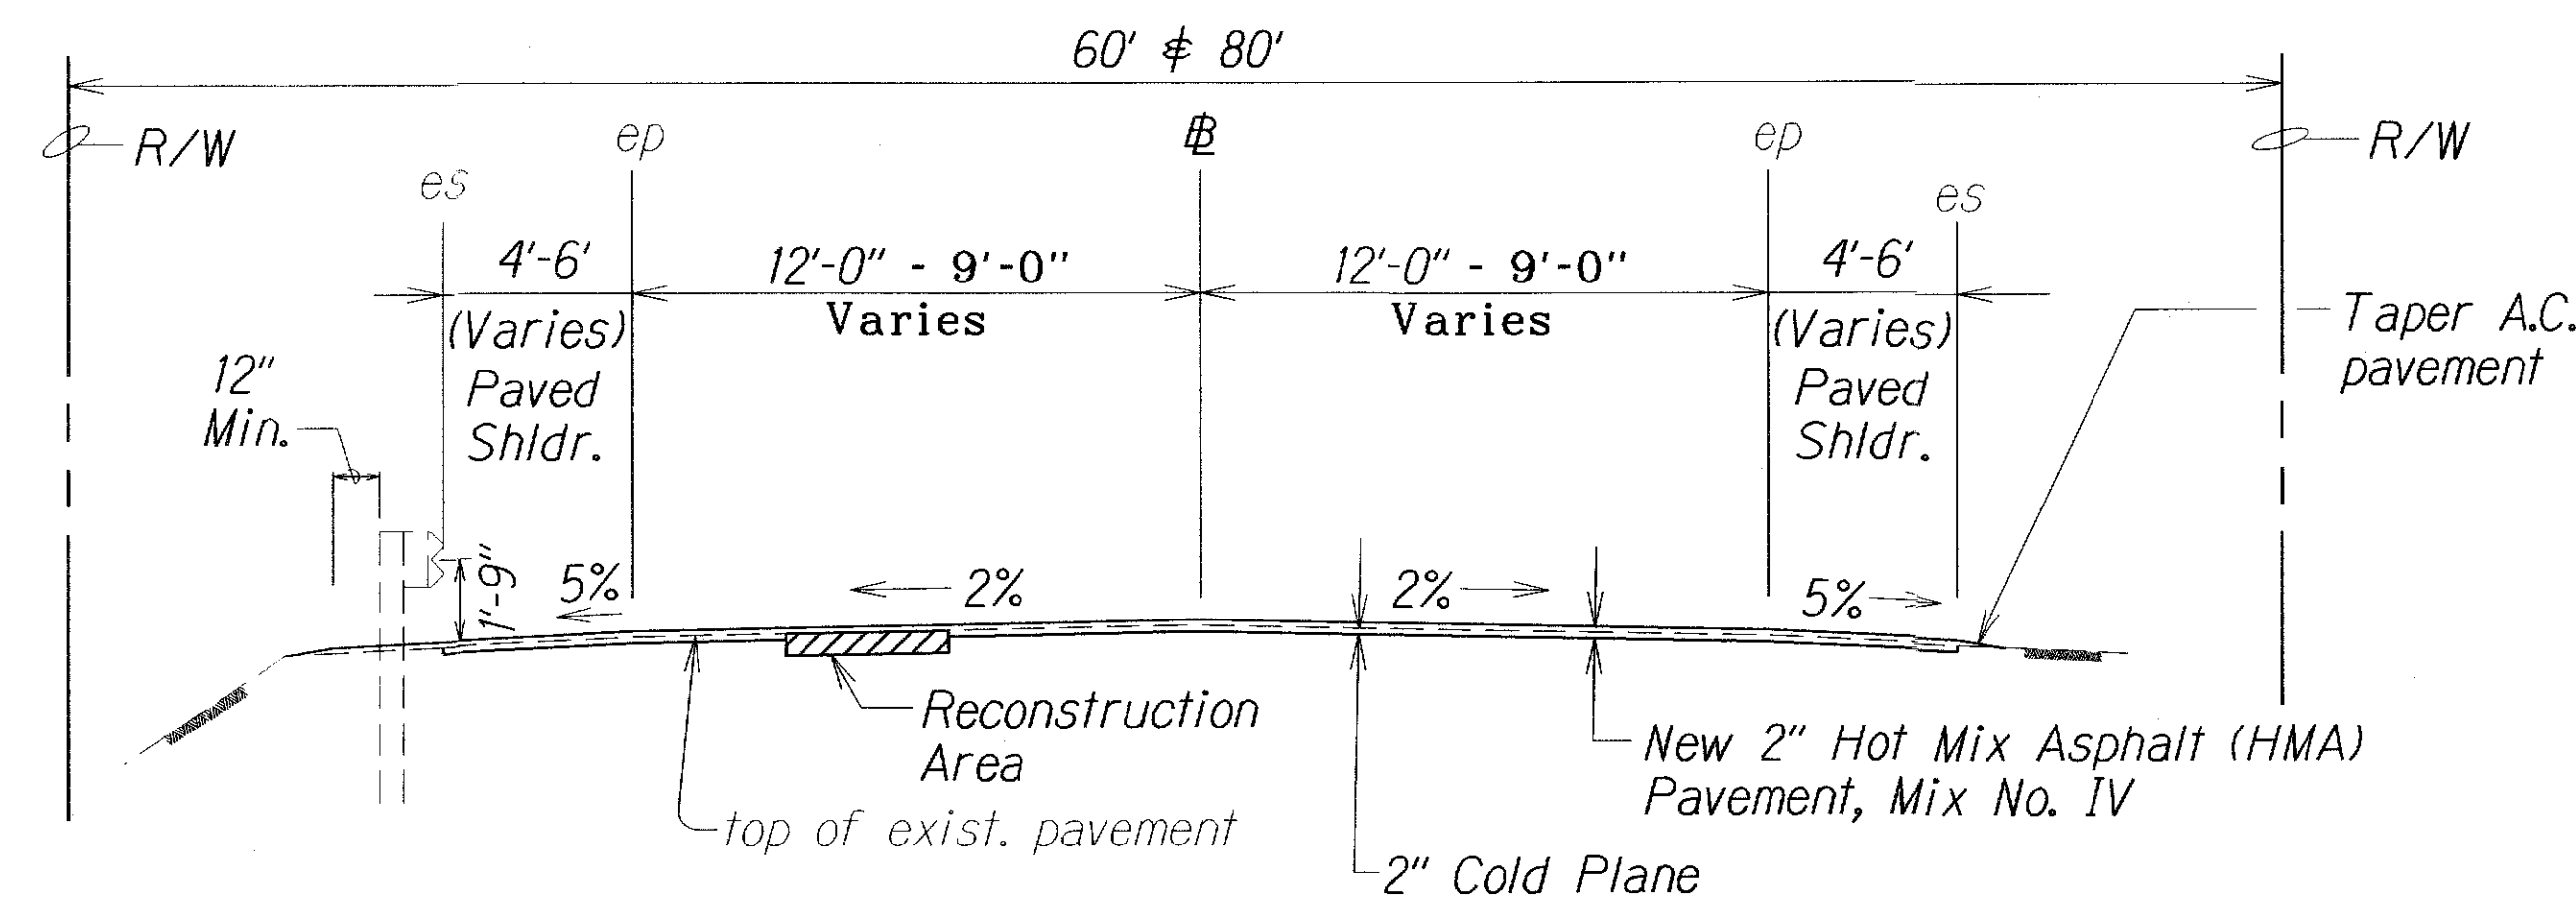


**TYPICAL SECTION**  
**STA. 1+00 - STA. 14+00 & STA. 53+50± - STA. 95+00 (WORK AREA 1)**  
 Scale: 1/4" = 1'-0"

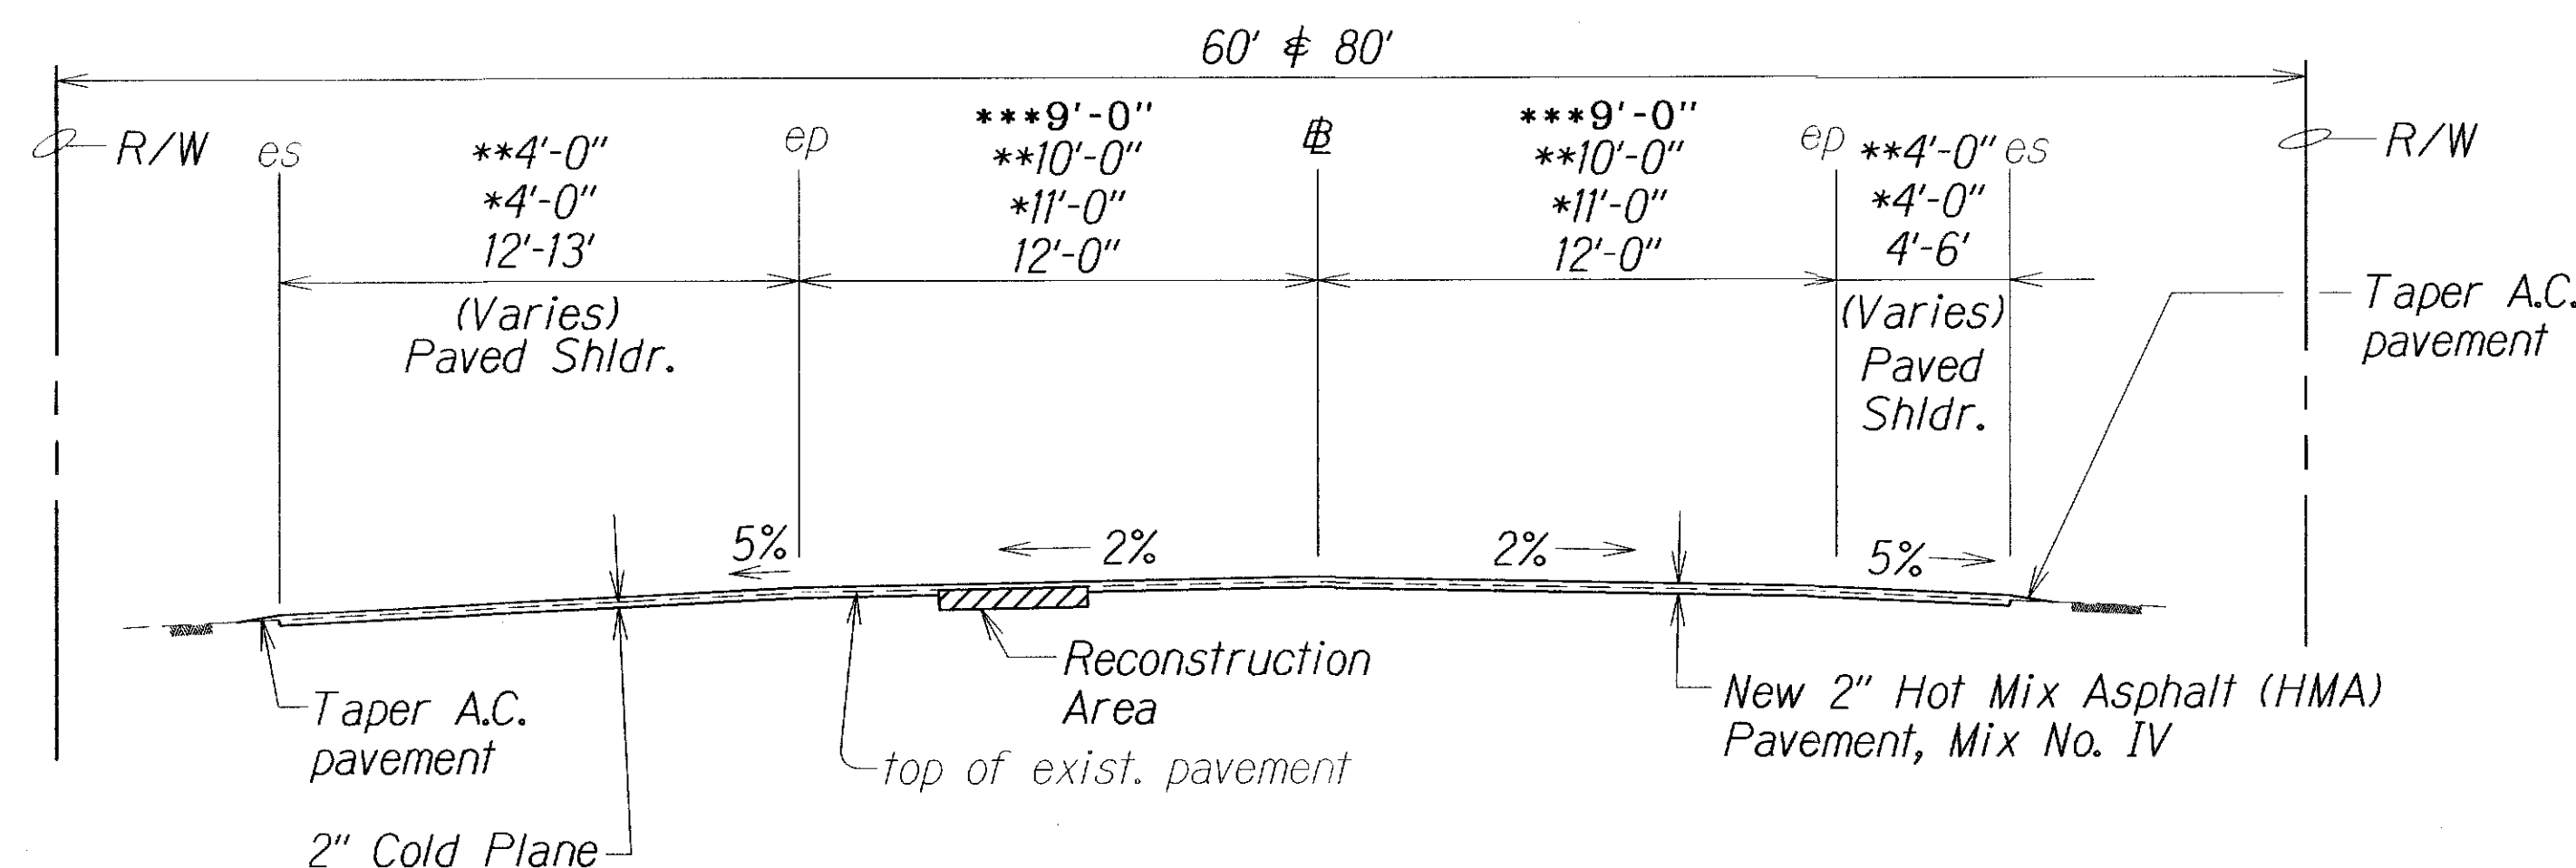

**TYPICAL SECTION**  
**STA. 14+00± - STA. 53+50± (WORK AREA 1)**  
**\*STA. 205+00 - STA. 377+80 (WORK AREA 2)**  
**\*\*STA. 377+80 - STA. 395+00 (WORK AREA 2)**  
**\*\*\*STA. 395+00 - STA. 43+95 (WORK AREA 3)**  
**\*\*\*\*STA. 43+95 - STA. 26+00 (WORK AREA 4)**  
 Scale: 1/4" = 1'-0"

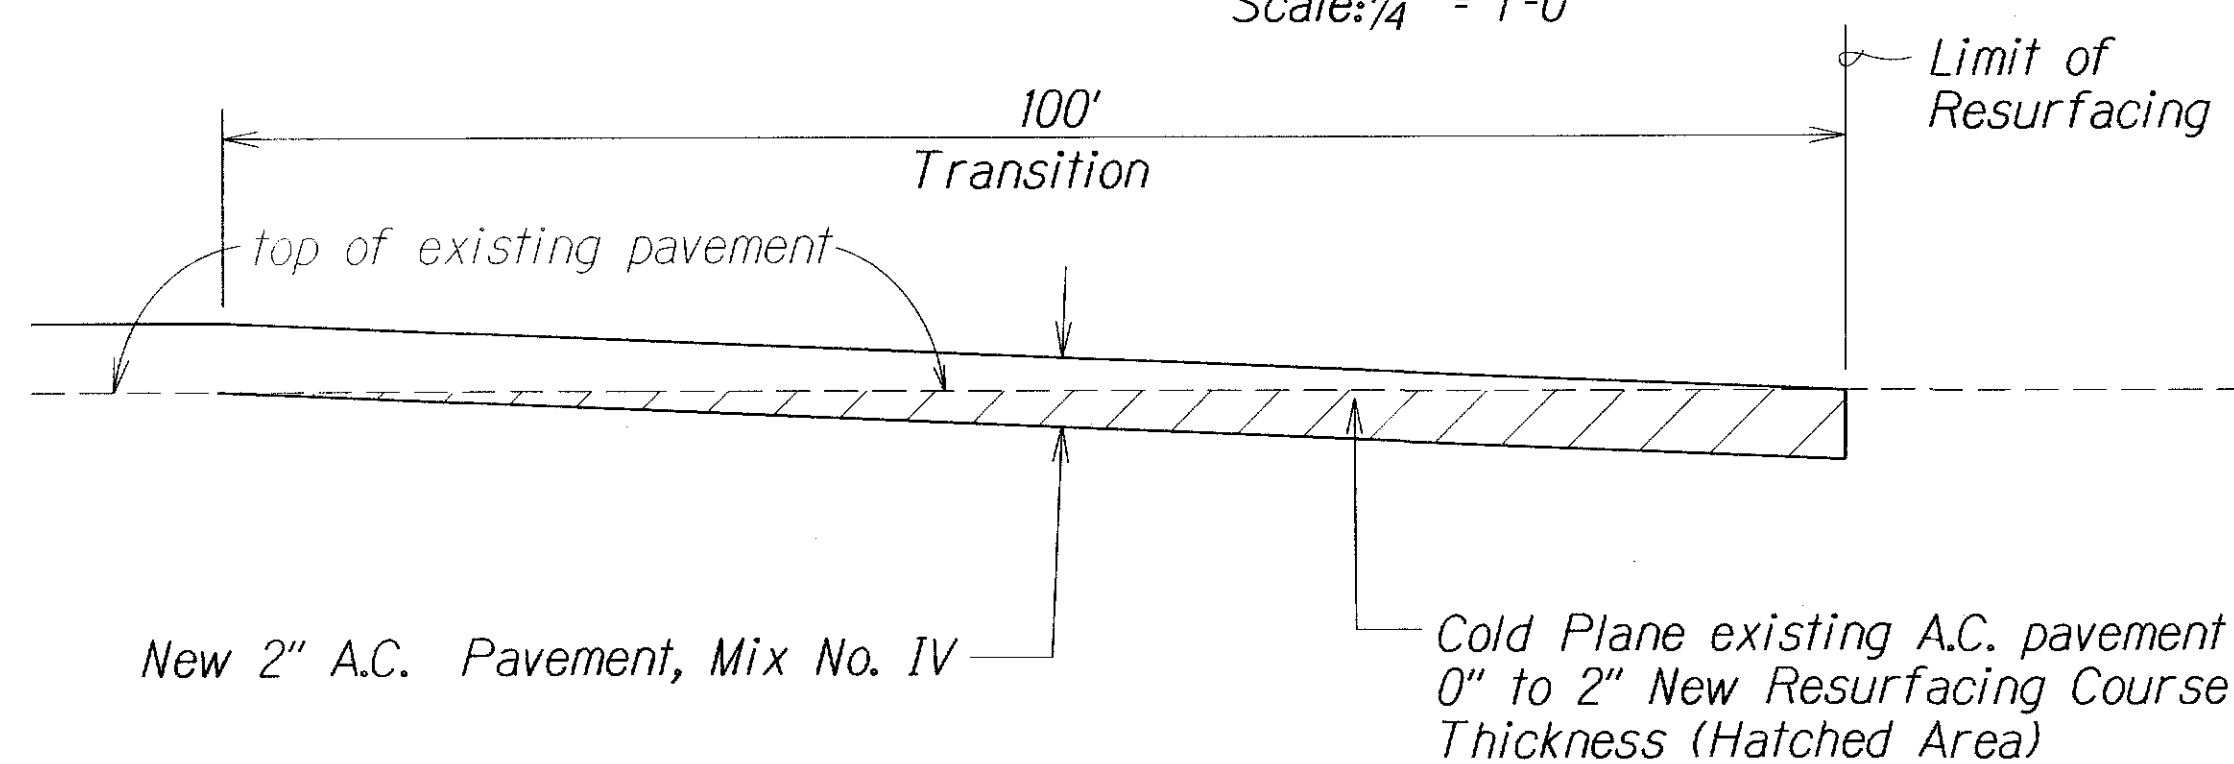


**COLD PLANED TRANSITION TO EXISTING A.C. PAVEMENT**  
 Not To Scale

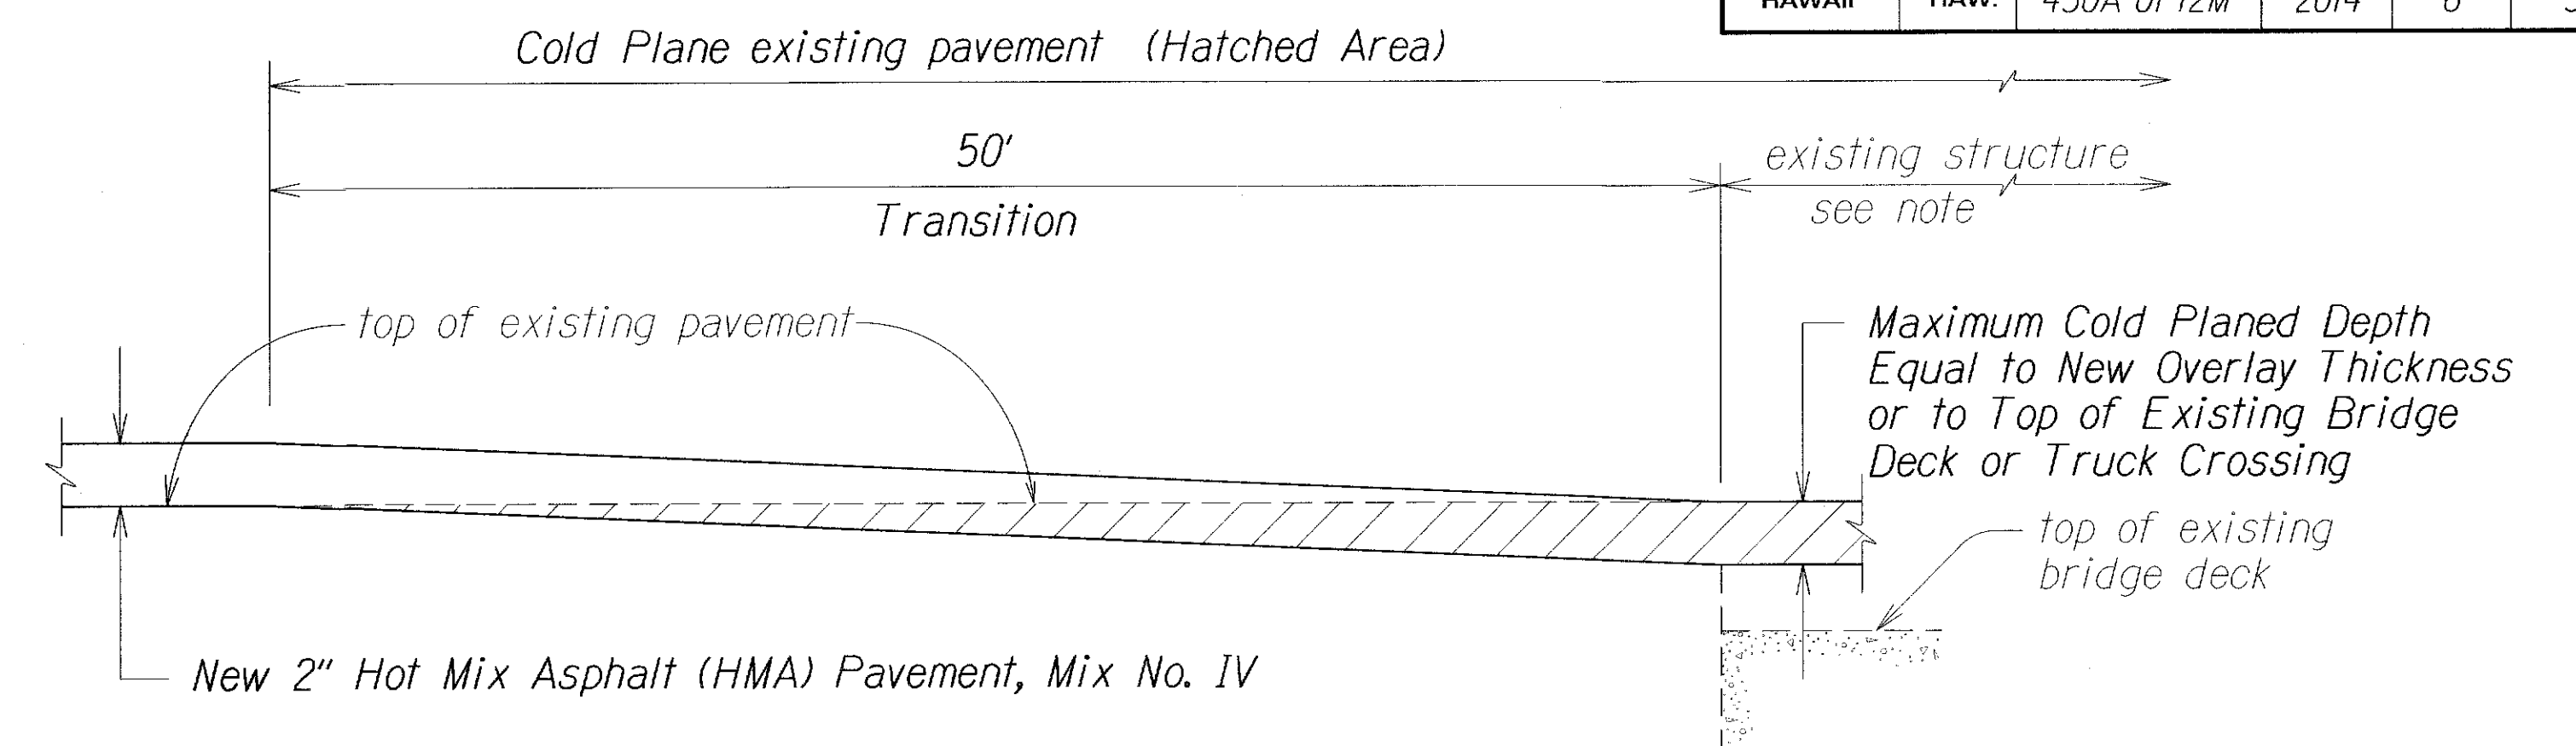


Note: In cold planing the pavement over the structure, the Contractor shall exercise care not to damage any portion of the structure, especially the slab, joints, drainage pipes or reinforcement. Any damage to the structure during the cold planing operations shall be repaired by the Contractor at his expense. Repair work shall be directed by the Engineer. The Contractor shall verify the thickness of the pavement by taking several measurements throughout the structure.

**COLD PLANED TRANSITION AND RESURFACING OVER EXISTING STRUCTURE**  
 Not to Scale

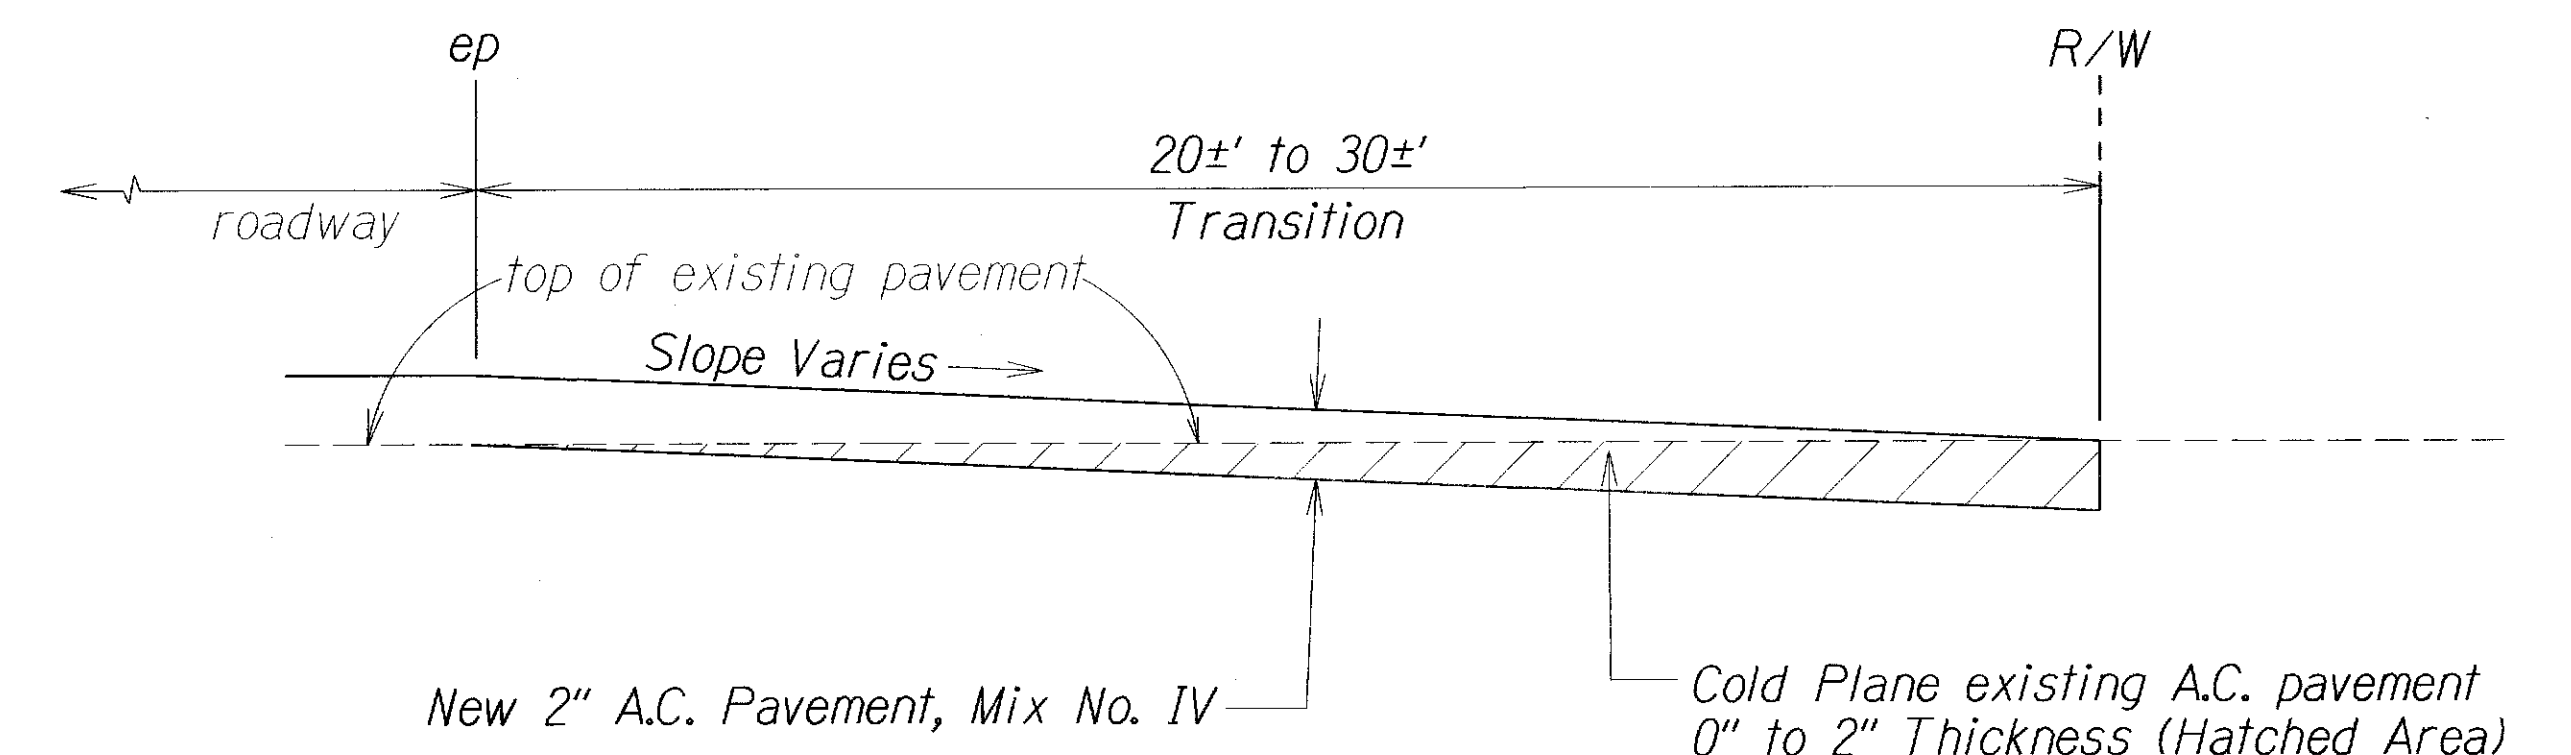

**PAVED SIDE ROAD DETAIL**  
 Not To Scale

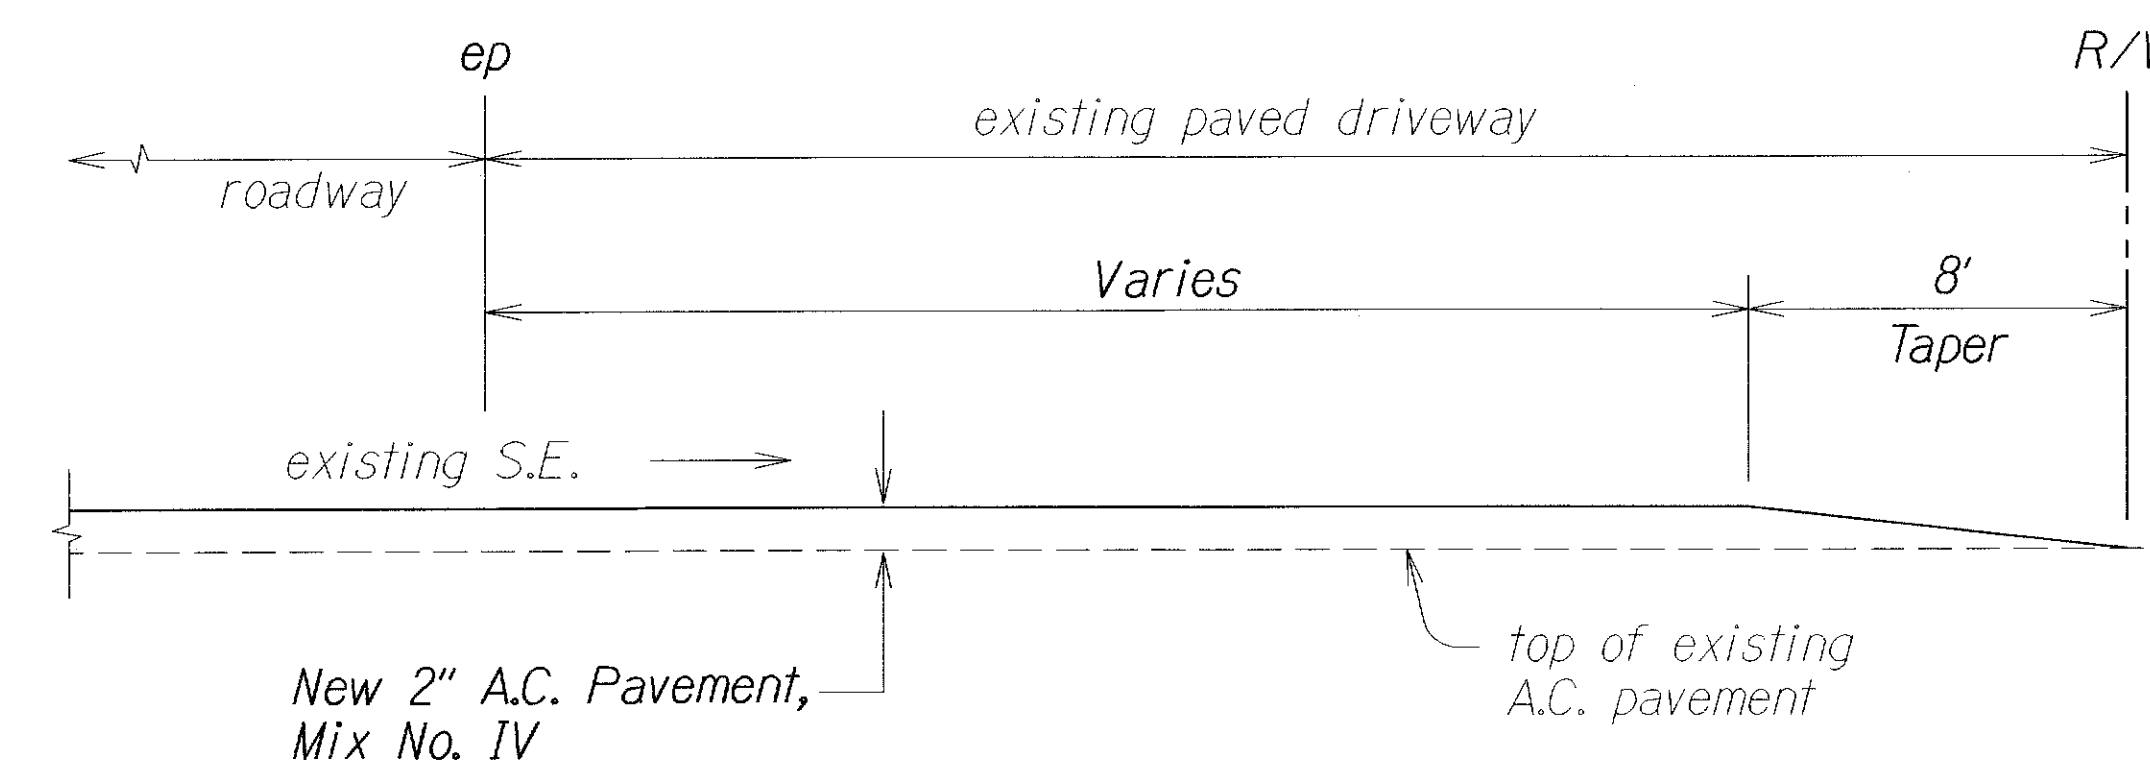


**PAVED DRIVEWAY DETAIL**  
 Not To Scale


LEGEND FOR AS-BUILT POSTINGS	
	Squiggly line for as-built deletion
	Double line for as-built deletion
Roadway	Text for as-built posting

STATE OF HAWAII DEPARTMENT OF TRANSPORTATION HIGHWAYS DIVISION	
<b>TYPICAL SECTIONS &amp; DETAILS</b>	
KAMEHAMEHA V HIGHWAY RESURFACING	
Kaunakakai to Kamiloloa Bridge and Vicinity of Makakupaia Bridge to Kapuokoolau	
Project No. 450A-01-12M	
Scale: As Shown	Date: January, 2014
SHEET No. 1 OF 2 SHEETS	


FED. ROAD DIST. NO.	STATE	PROJ. NO.	FISCAL YEAR	SHEET NO.	TOTAL SHEETS
HAWAII	HAW.	450A-01-12M	2014	7	38

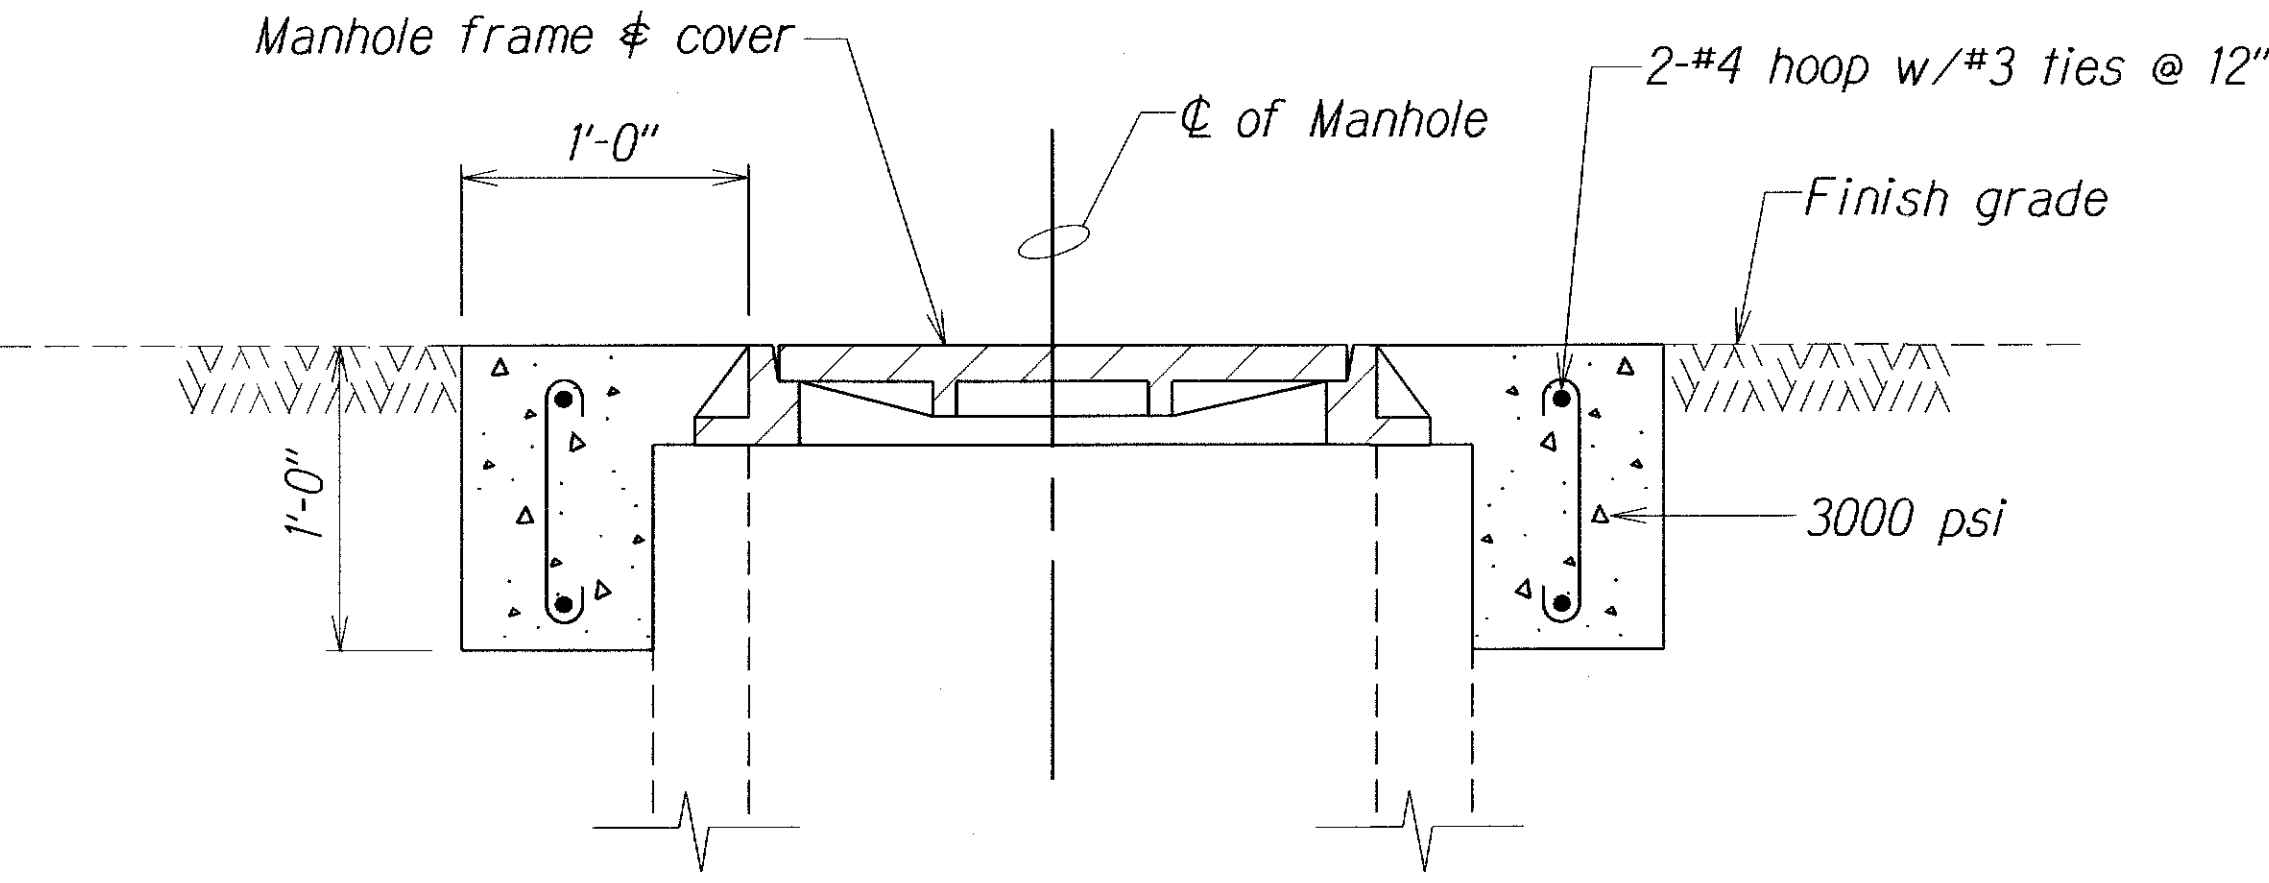


DETAIL - CONCRETE COLLAR FOR  
AJUSTMENTS OF MANHOLES AND VALVE BOX  
Not To Scale

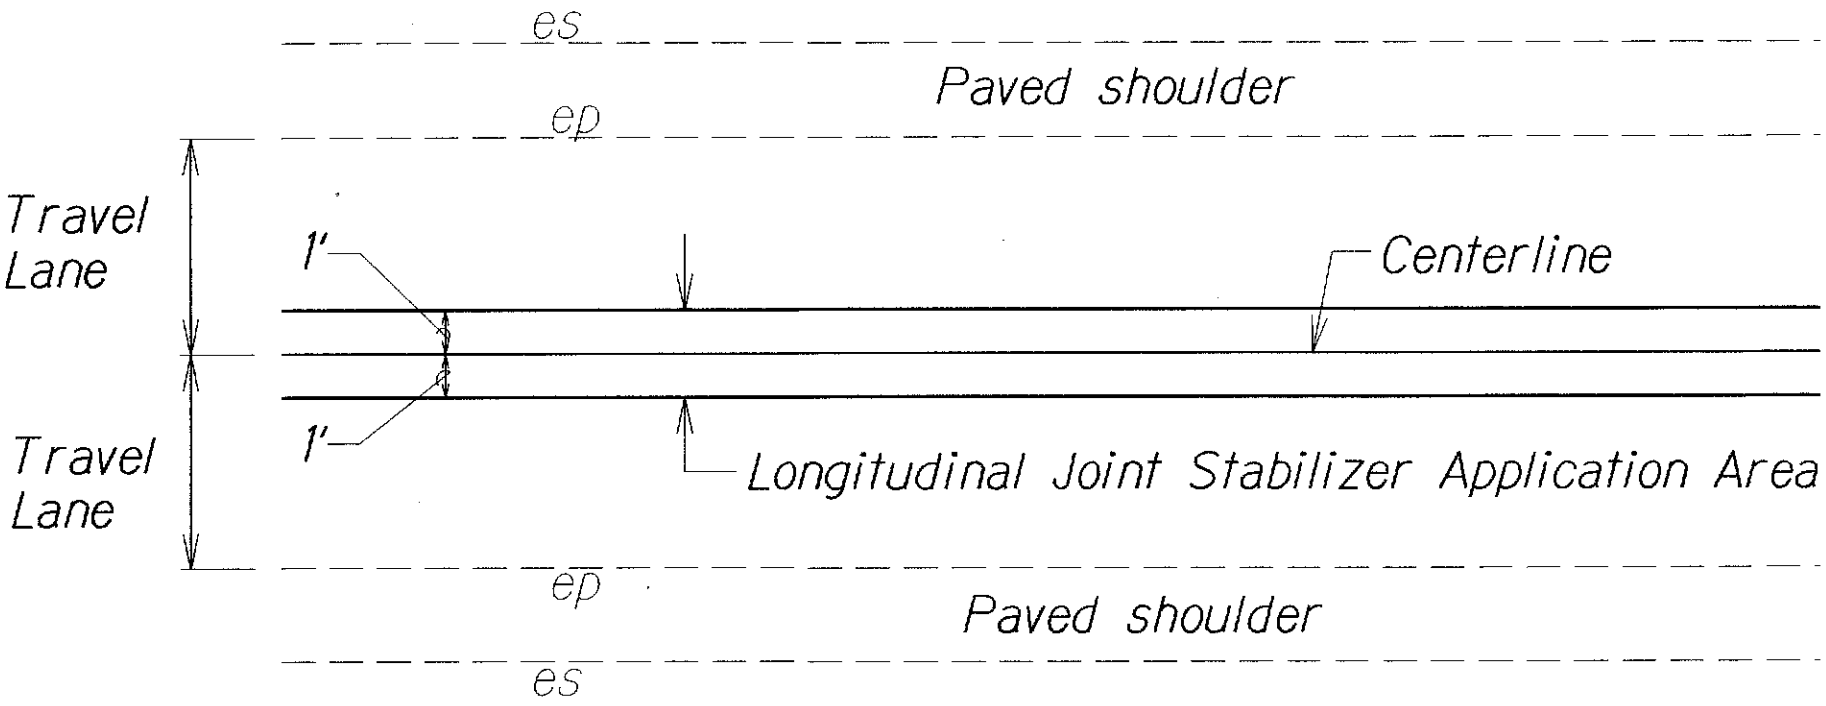


TYPICAL SECTION FOR  
LONGITUDINAL JOINT STABILIZER  
Not To Scale

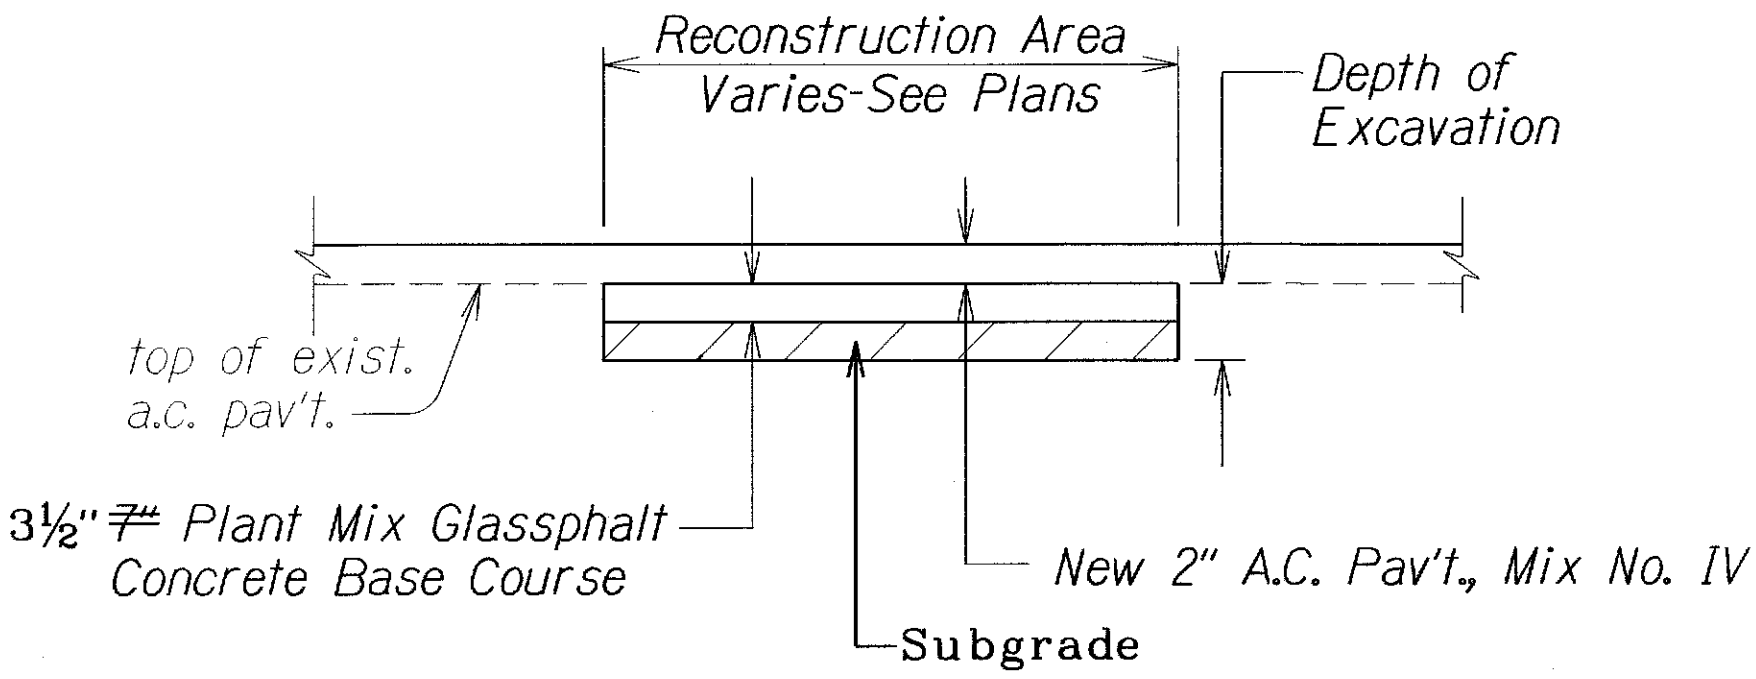


WORK AREA 1 - A.C. PAVEMENT RECONSTRUCTION DETAIL  
Not To Scale

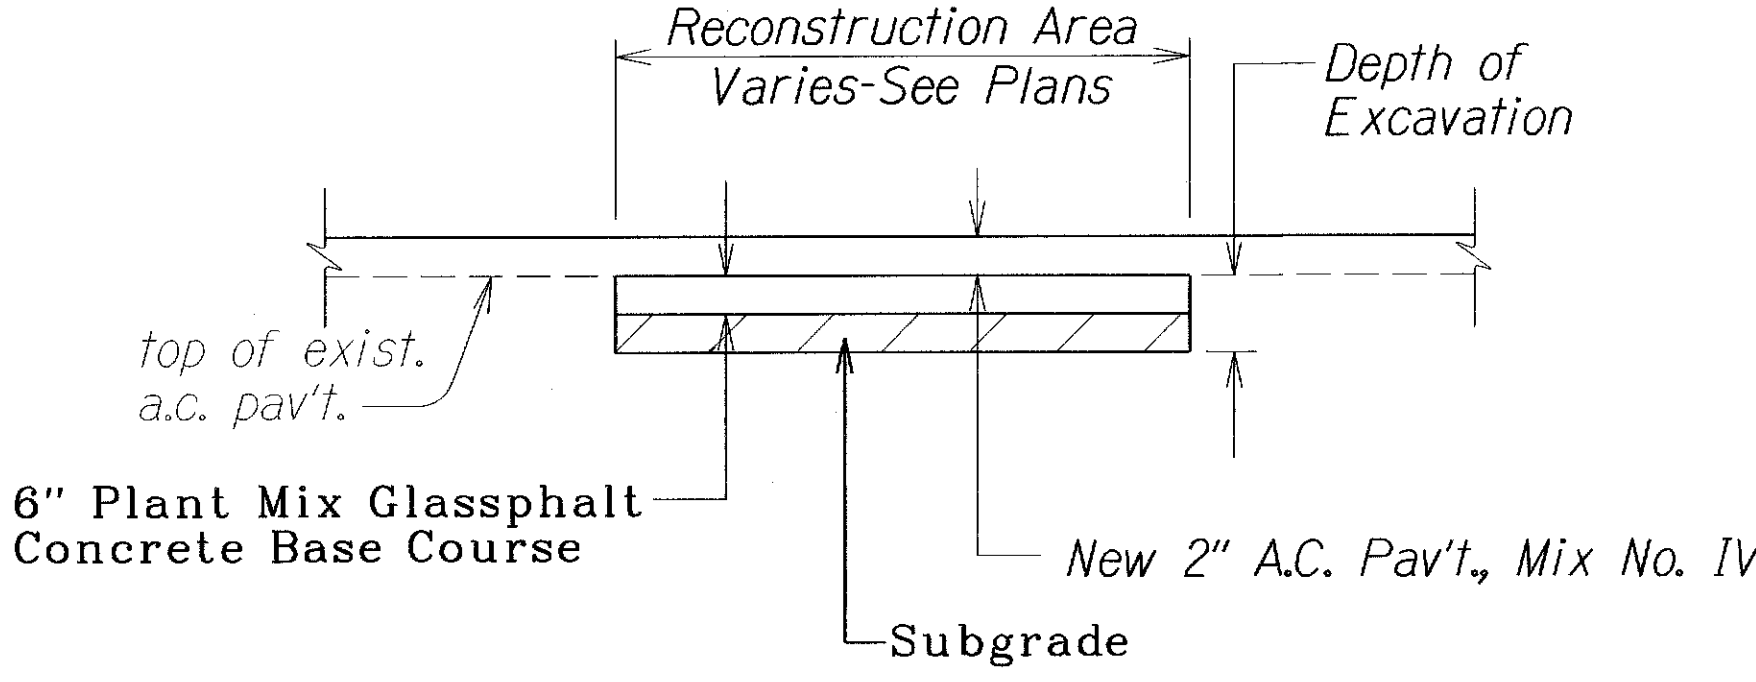

WORK AREA 3 - A.C. PAVEMENT RECONSTRUCTION DETAIL  
Sta. 395+00 to Sta. 319+00

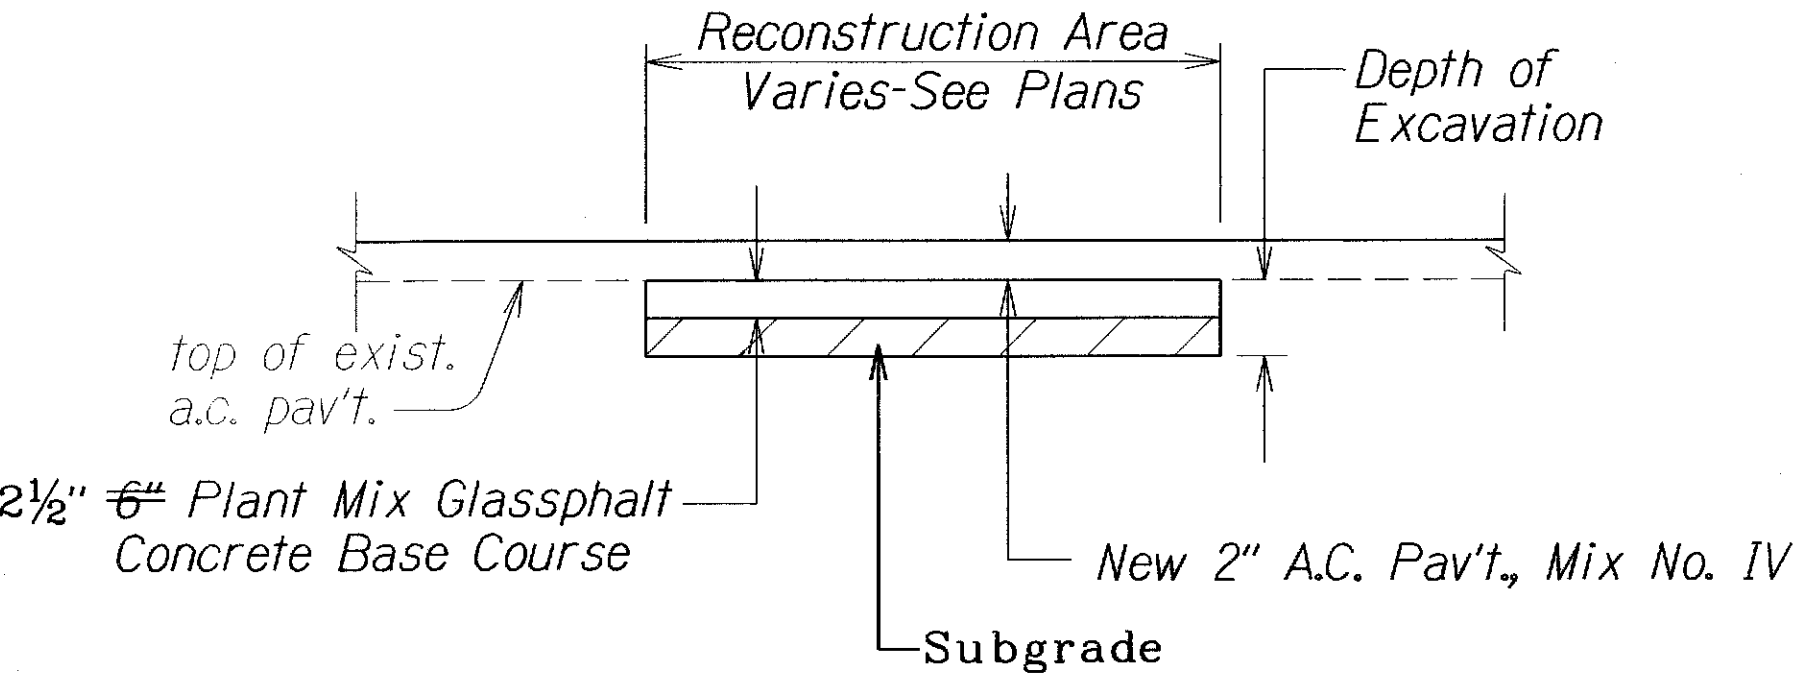

WORK AREA 2 - A.C. PAVEMENT RECONSTRUCTION DETAIL  
Not To Scale

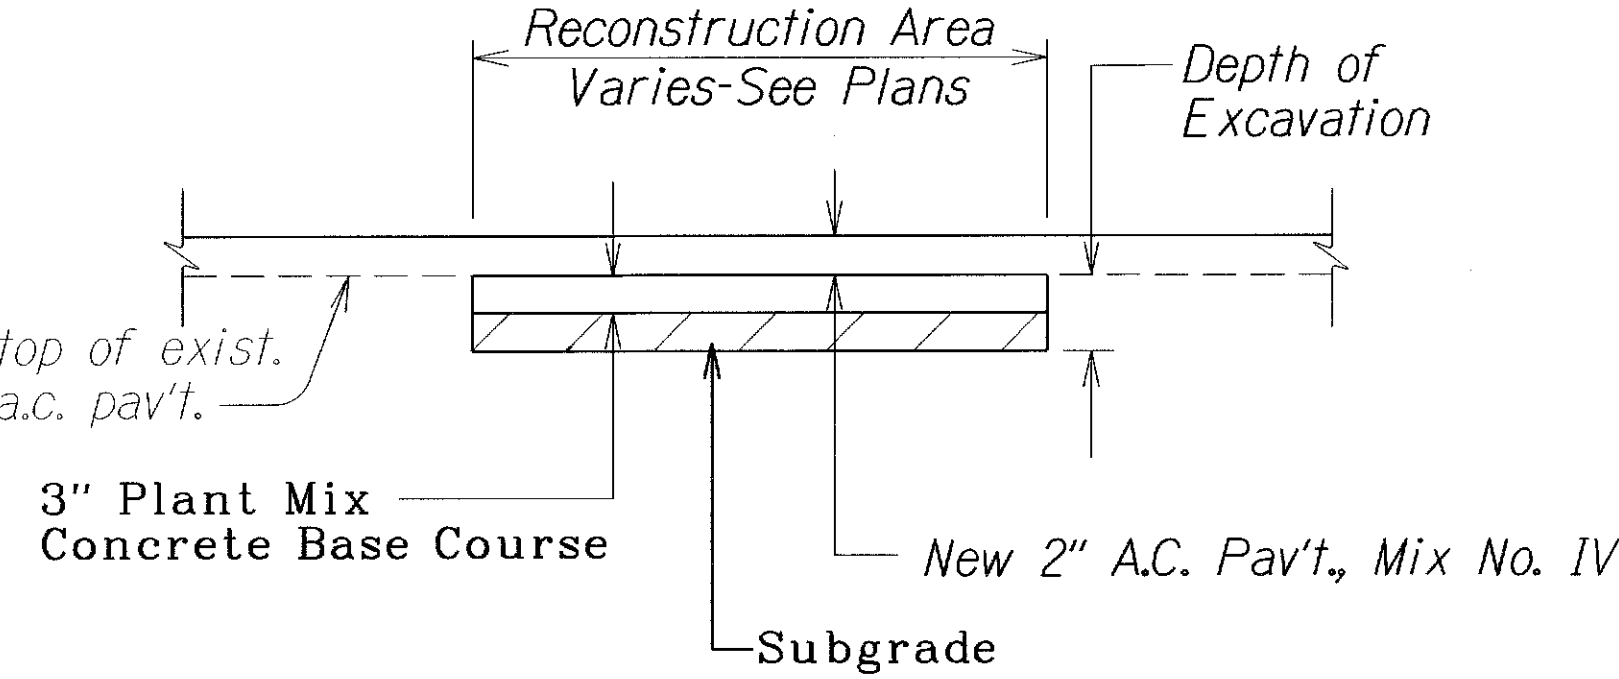

WORK AREA 4 - A.C. PAVEMENT RECONSTRUCTION DETAIL  
Sta. 319+00 to Sta. 205+00

LEGEND FOR AS-BUILT POSTINGS	
	Squiggly line for as-built deletion
	Double line for as-built deletion
	Text for as-built posting

STATE OF HAWAII  
DEPARTMENT OF TRANSPORTATION  
HIGHWAYS DIVISION

TYPICAL SECTIONS & DETAILS  
KAMEHAMEHA V HIGHWAY RESURFACING  
Kaunakakai to Kamiloloa Bridge and  
Vicinity of Makakupaia Bridge to Kapukoolau  
Project No. 450A-01-12M  
Scale: As Shown      Date: January, 2014  
SHEET No. 2 OF 2 SHEETS

SURVEY PLOTTED BY	DATE
DRAWN BY	
DESIGNED BY	
CHECKED BY	
ORIGINAL PLAN	
NOTE BOOK	