


FED. ROAD DIST. NO.	STATE	FED. AID PROJ. NO.	FISCAL YEAR	SHEET NO.	TOTAL SHEETS
HAWAII	HAW	19-D	1937	24	31

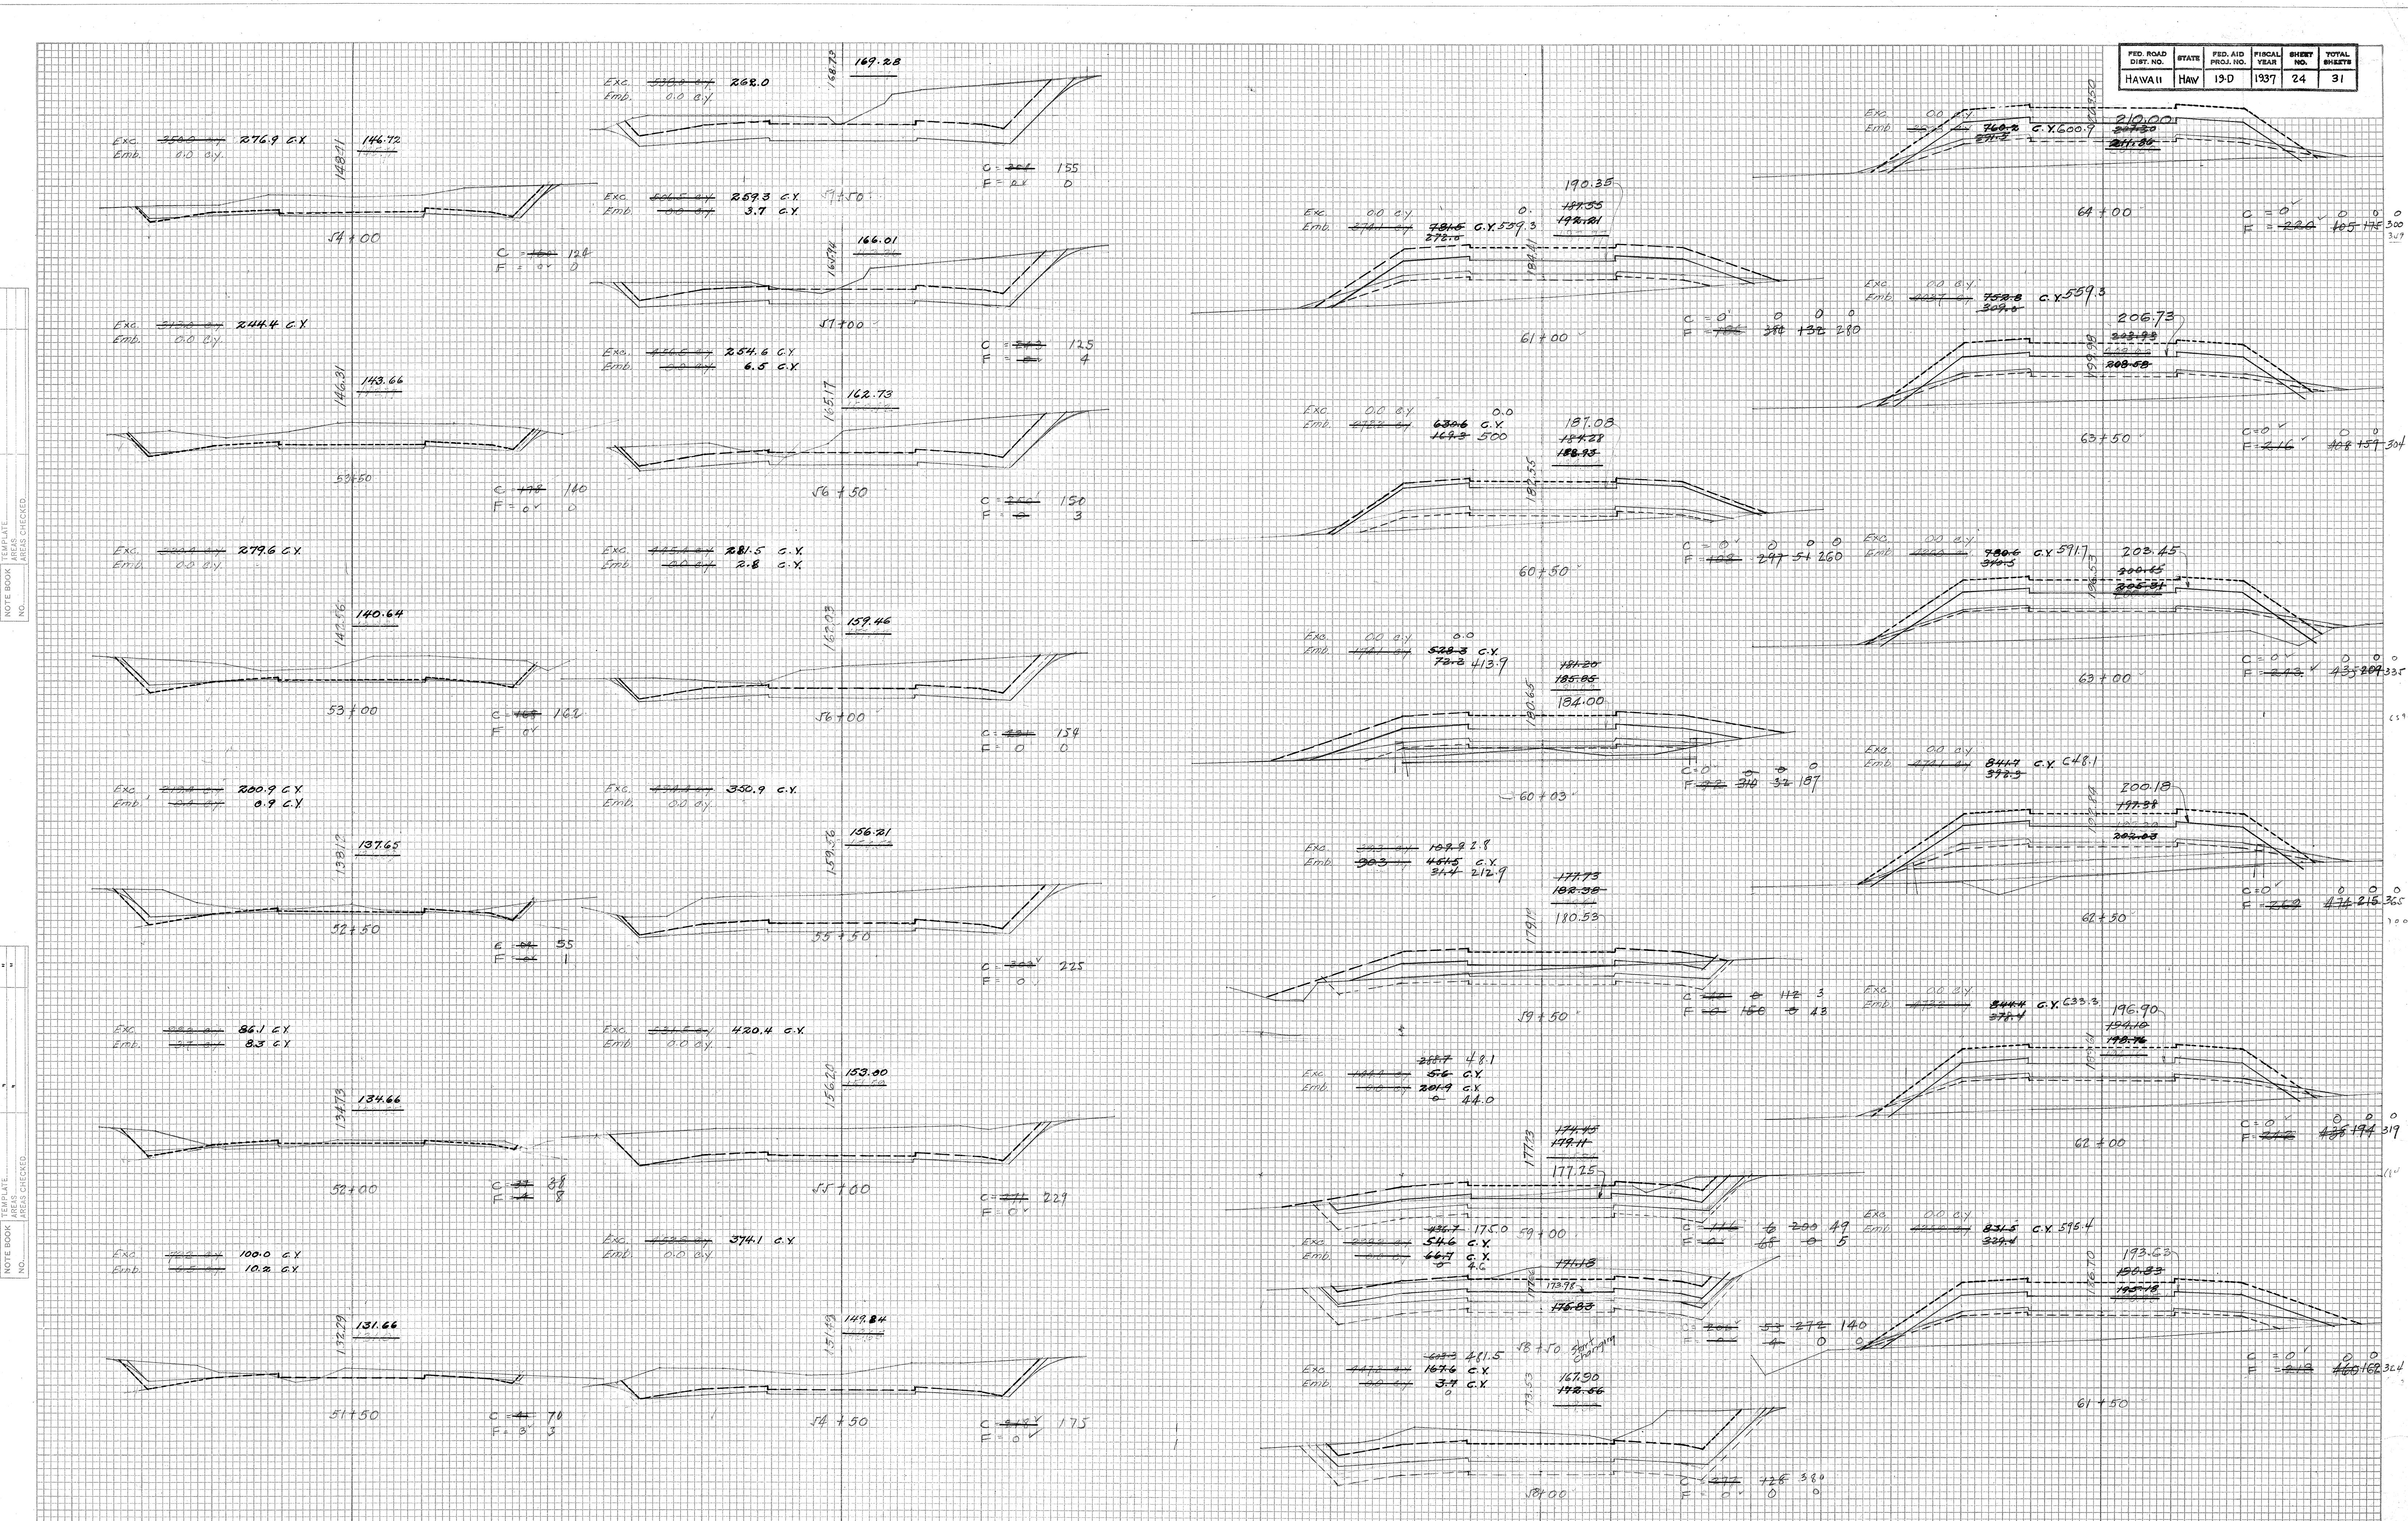

FED. ROAD DIST. NO.	STATE	FED. AID PROJ. NO.	FISCAL YEAR	SHEET NO.	TOTAL SHEETS
HAWAII	HAW	19-D	1937	17	23

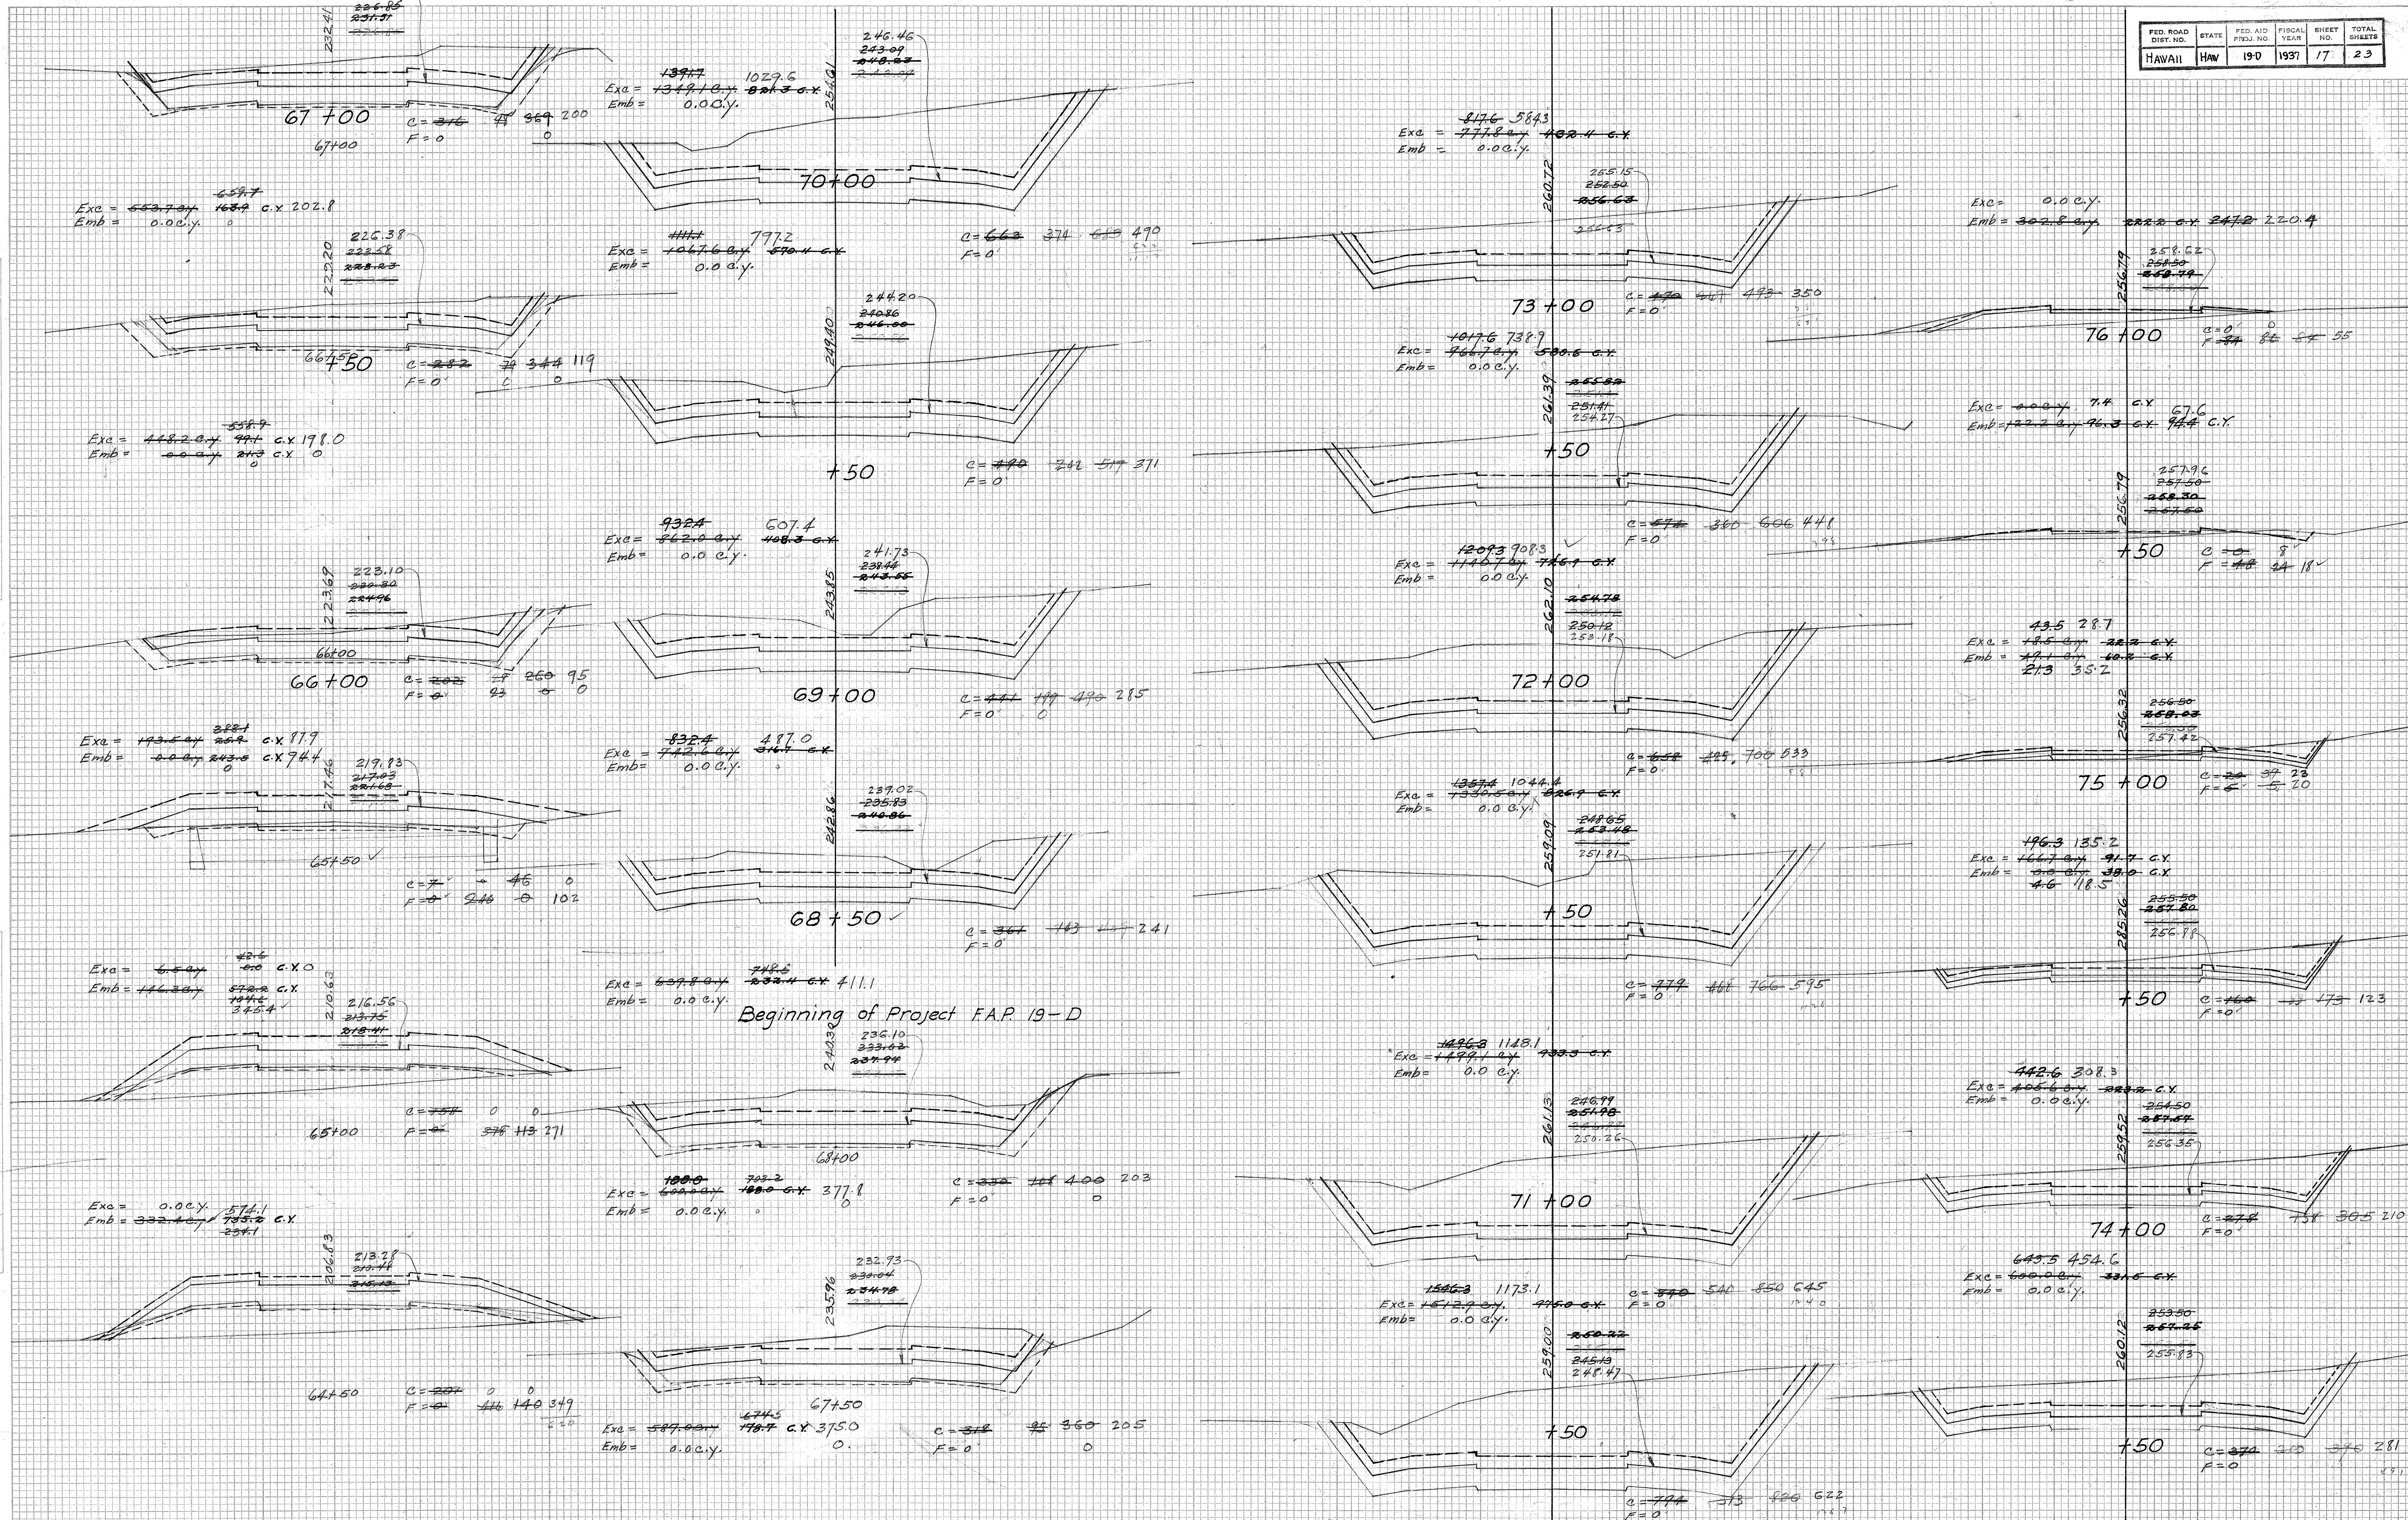


PLATE 3—CROSS SECTION O. P. R. & R. E. STAN
KEUFFEL & ESSÉR CO., NEW YORK.

$$E_{\text{FC}} = 11,105.1$$

$$E_{\text{Mto}} = 1,355.6$$



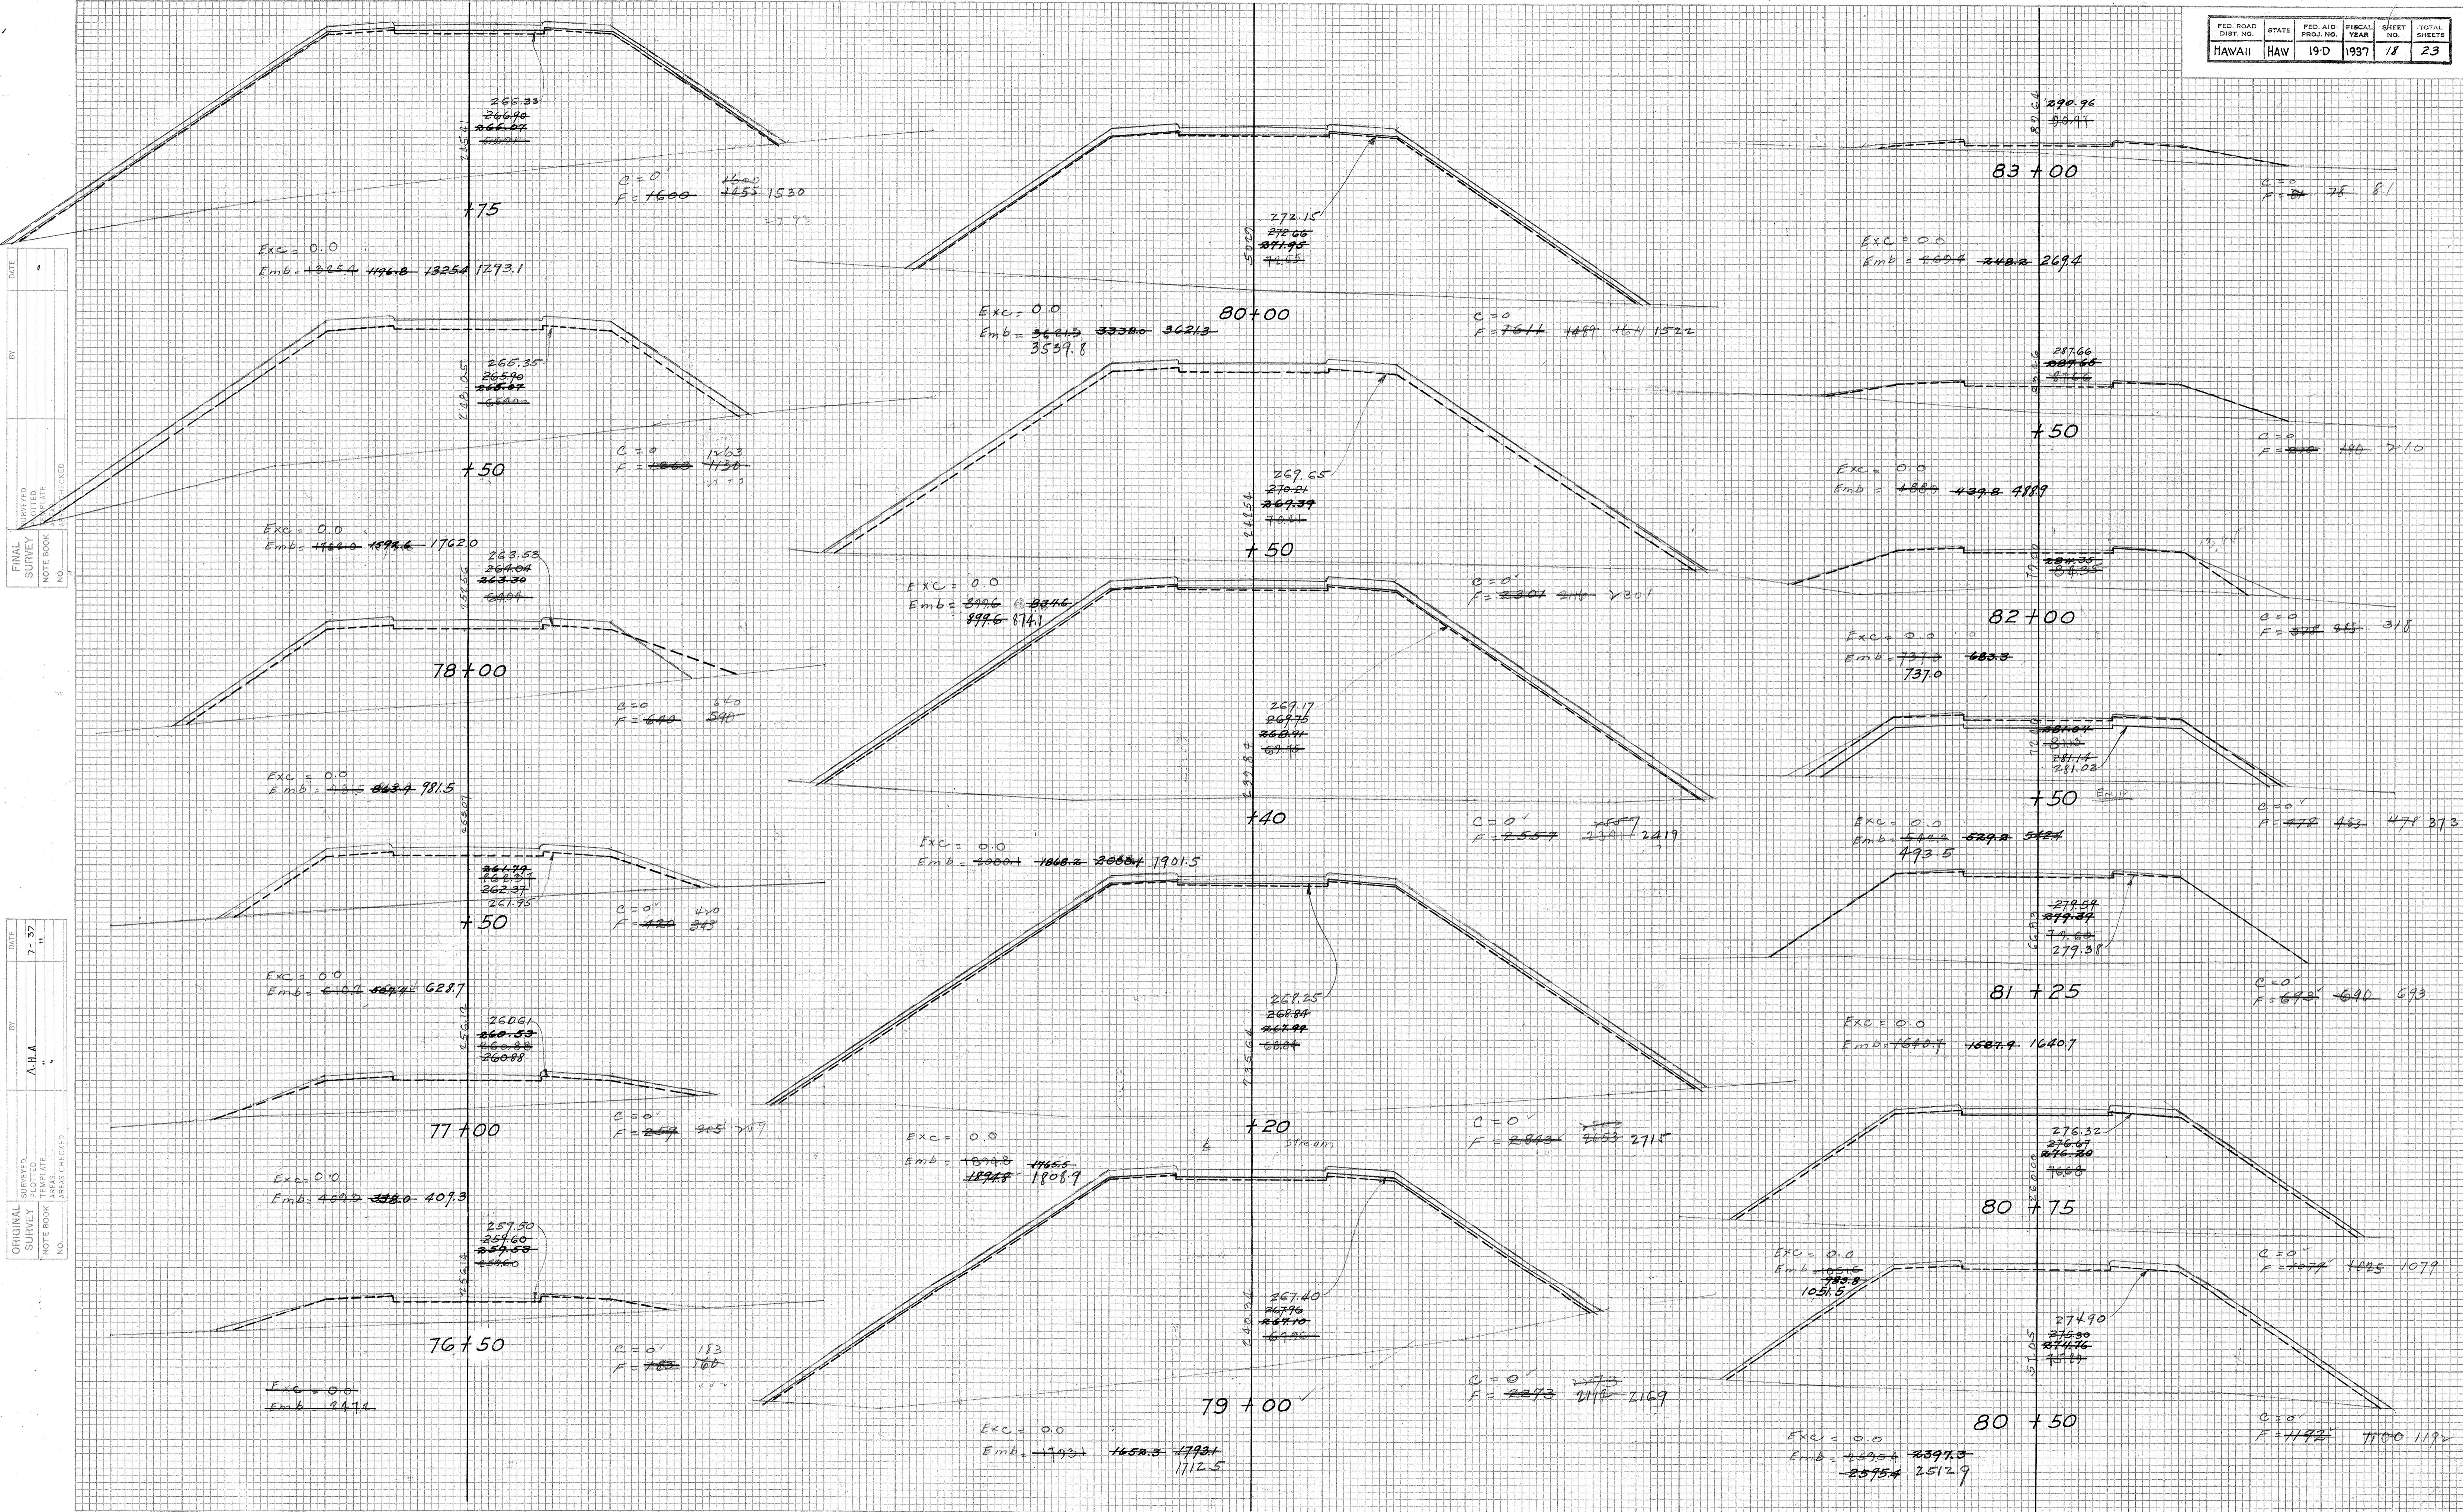


PLATE 3-CROSS SECTION ~~E~~ P. R. & R. E. STANDAR
KEUFFEL & ESSER CO., NEW YORK.

ROAD NO.	STATE	FED. AID PROJ. NO.	FISCAL YEAR	SHEET NO.	TOTAL SHEETS
All	HAW	19-D	1937	19	23

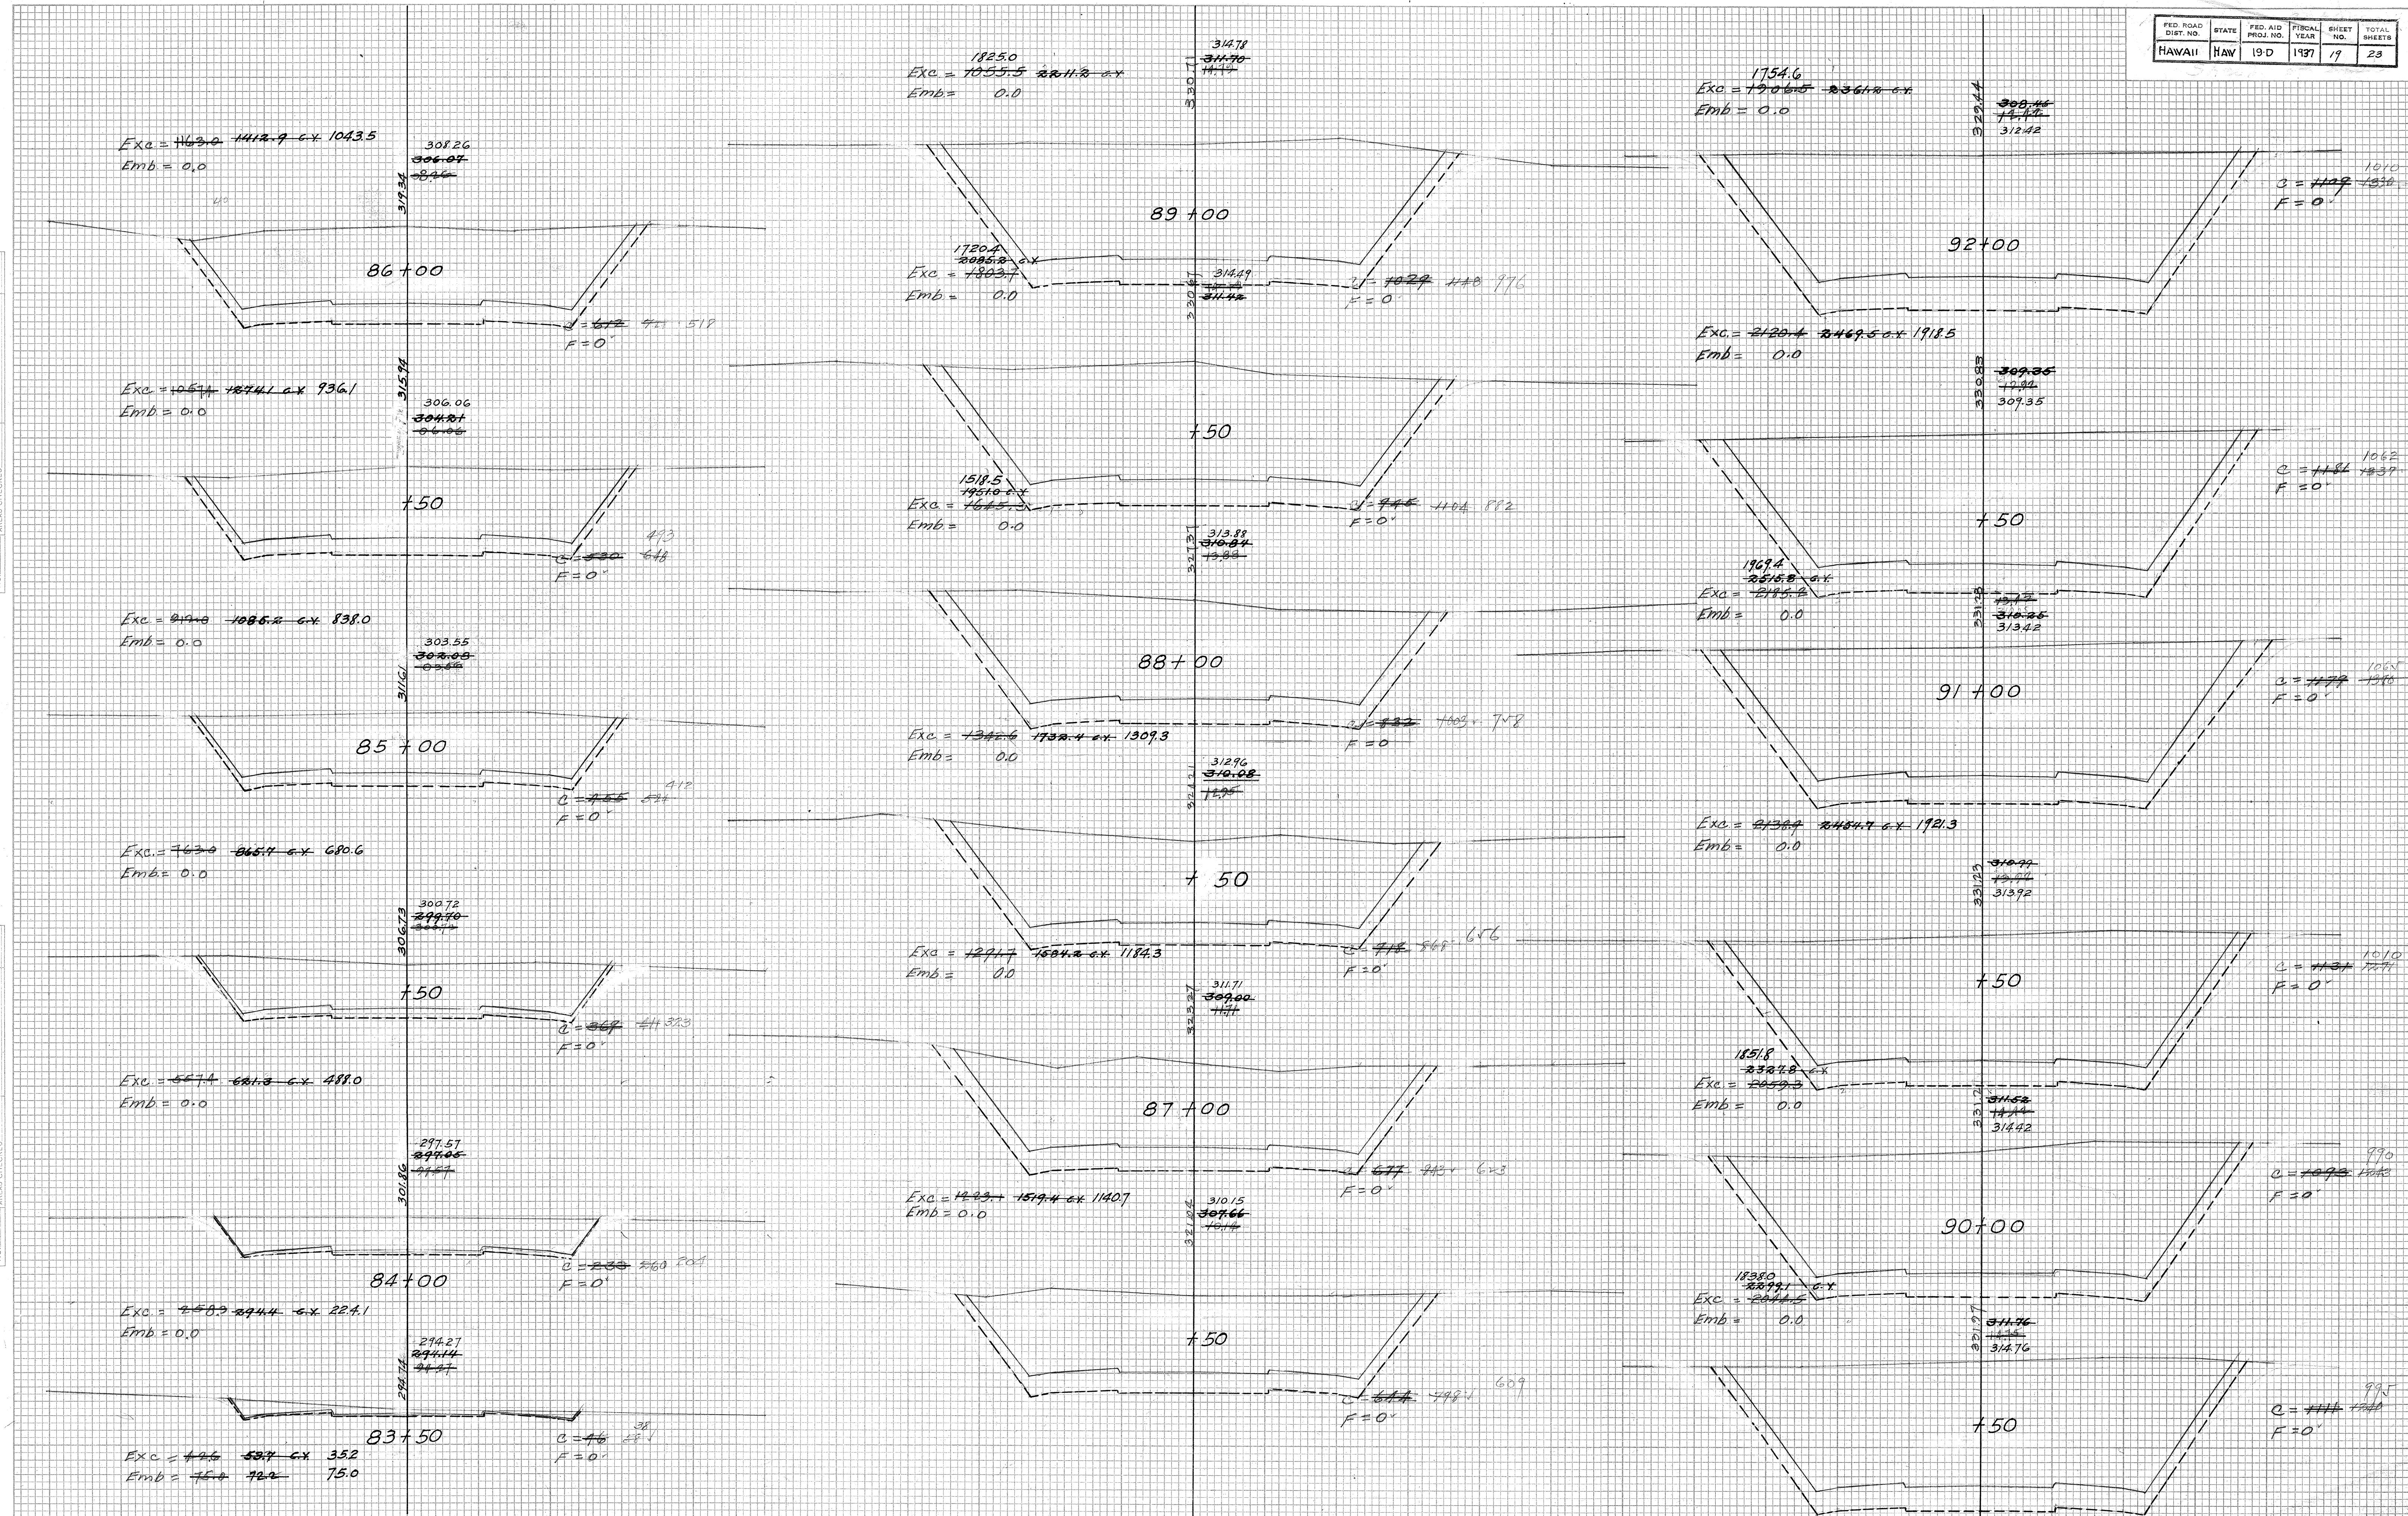

FED. ROAD DIST. NO.	STATE	FED. AID PROJ. NO.	FISCAL YEAR	HEET NO.	TOTAL SHEETS
HAWAII	HAW	19-D	1937	20	23

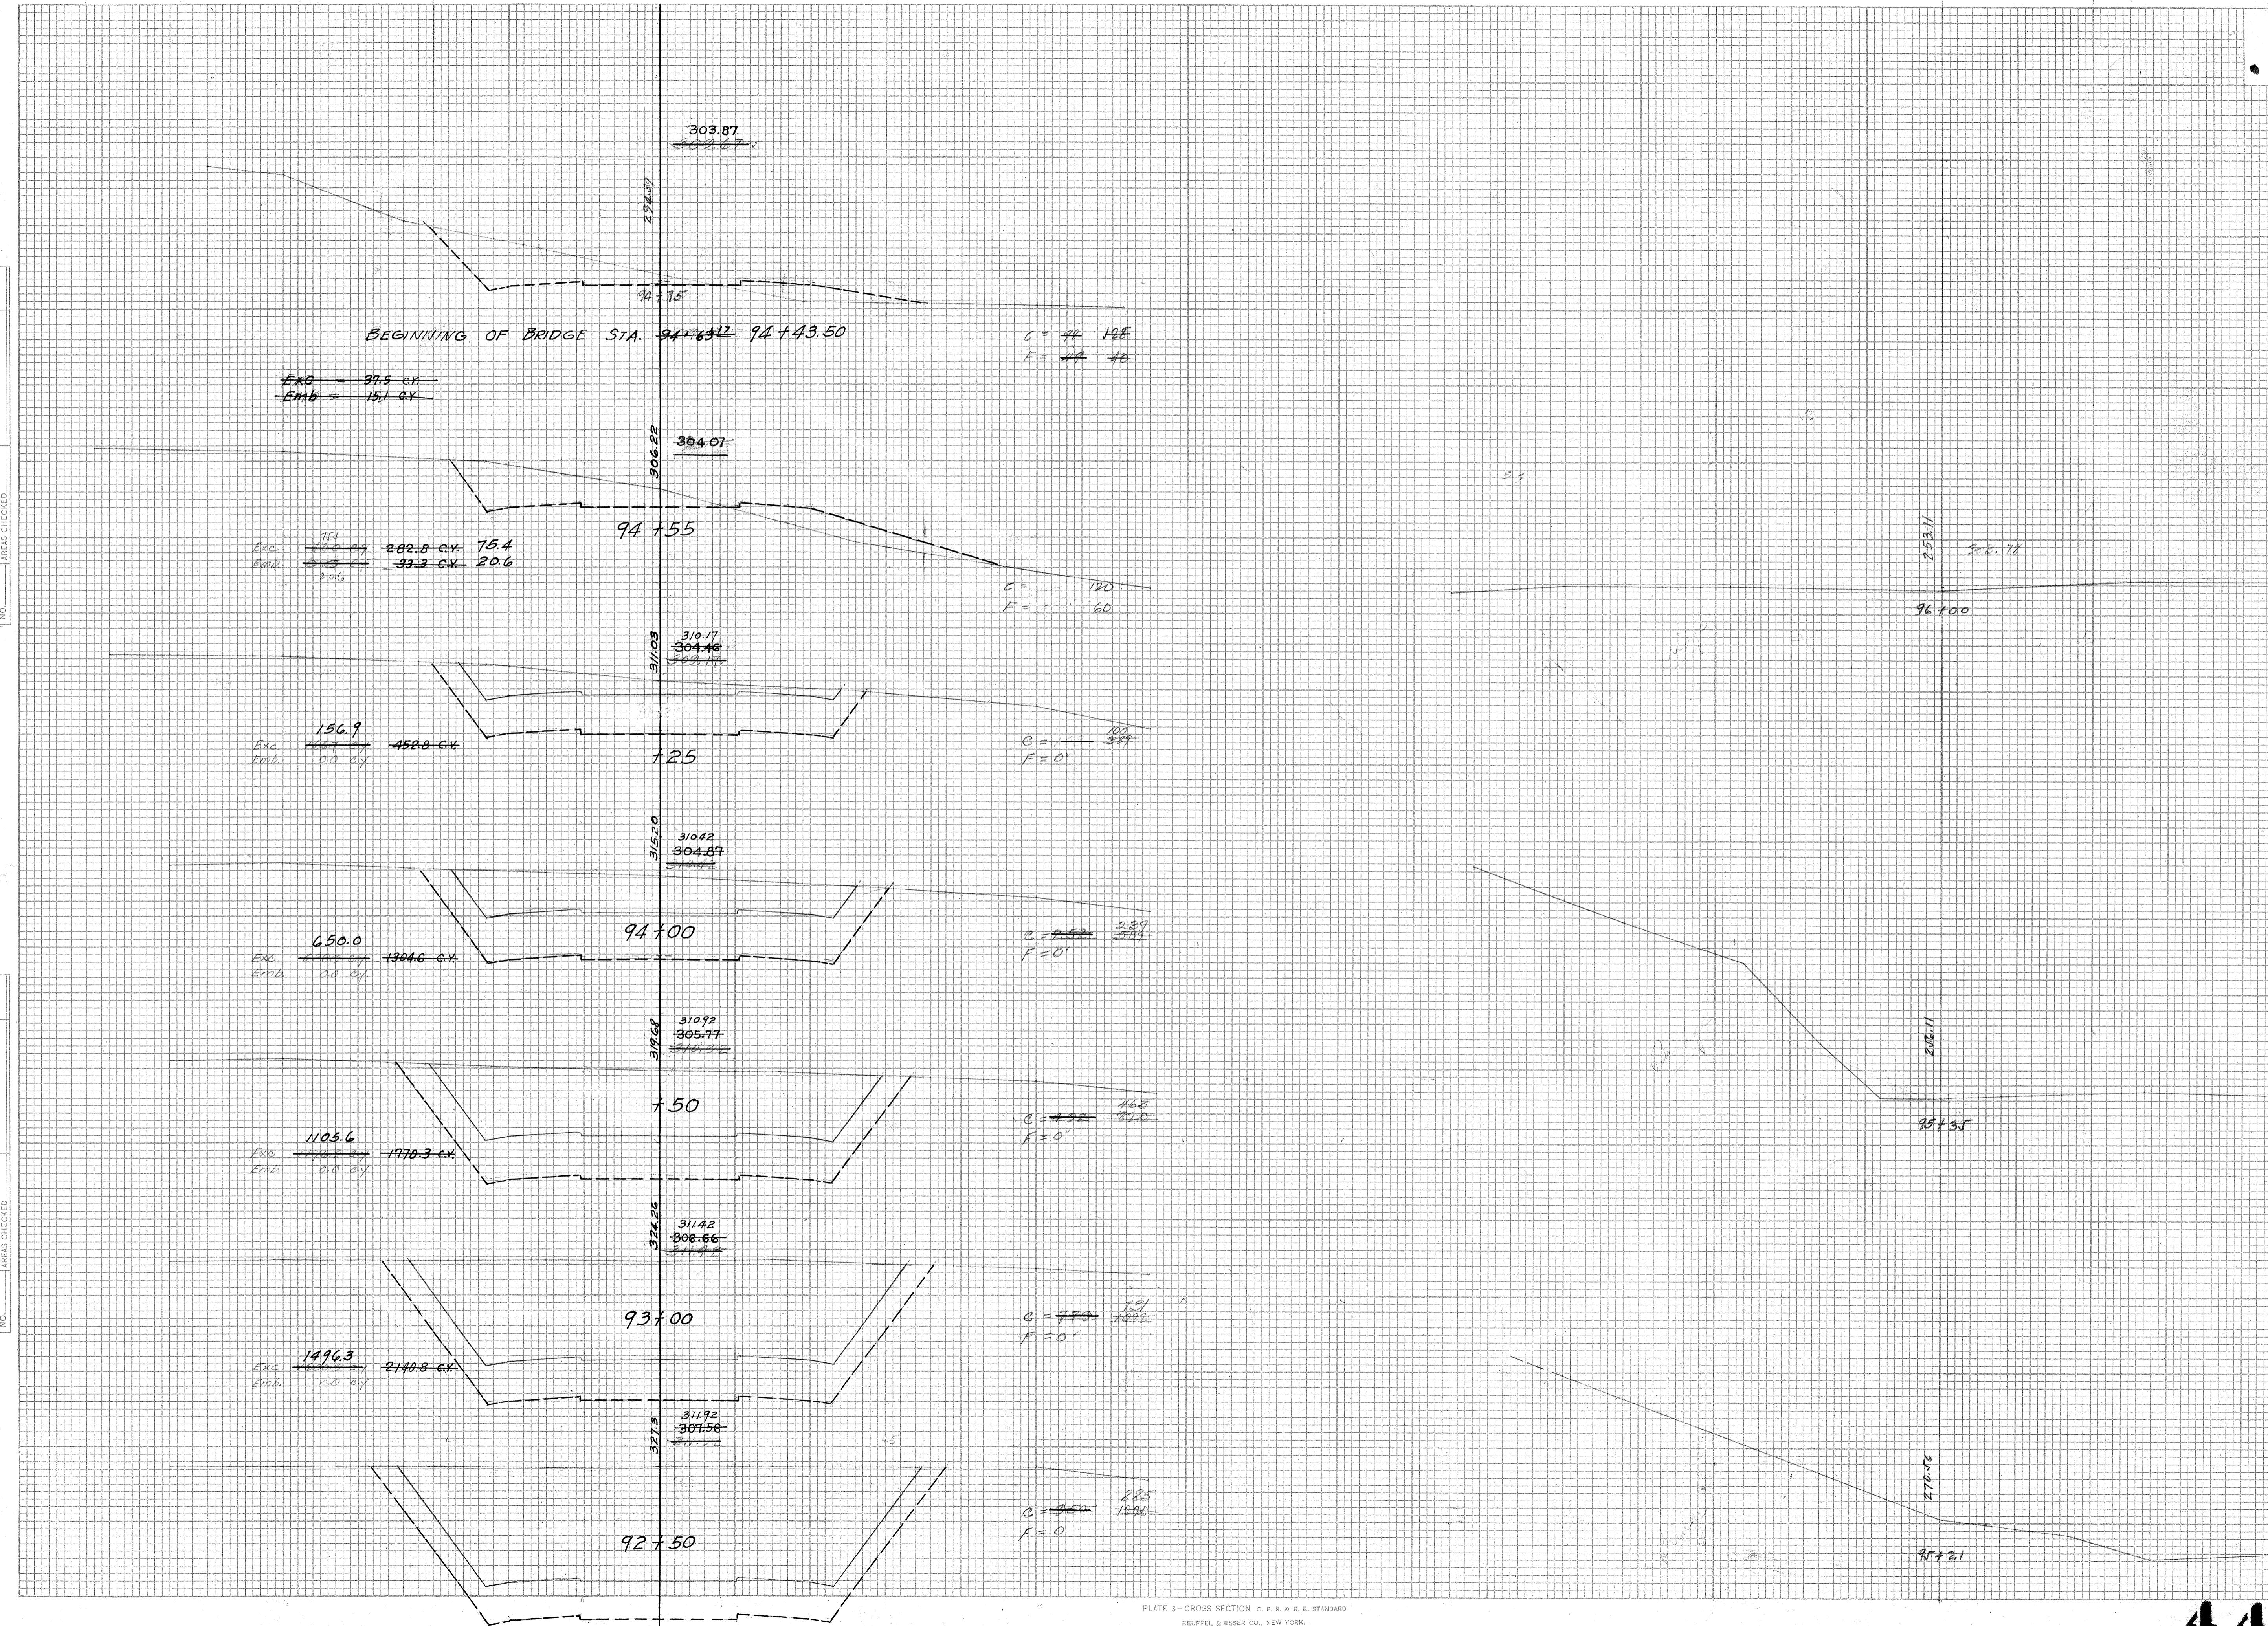

ORIGINAL SURVEYED	BY	DATE
SURVEY PLOTTED	AIA	7-53
NOTE BOOK	NO.	
AREAS PLOTTED		
AREAS CHECKED		

ORIGINAL SURVEYED	BY	DATE
SURVEY PLOTTED	AIA	7-53
NOTE BOOK	NO.	
AREAS PLOTTED		
AREAS CHECKED		

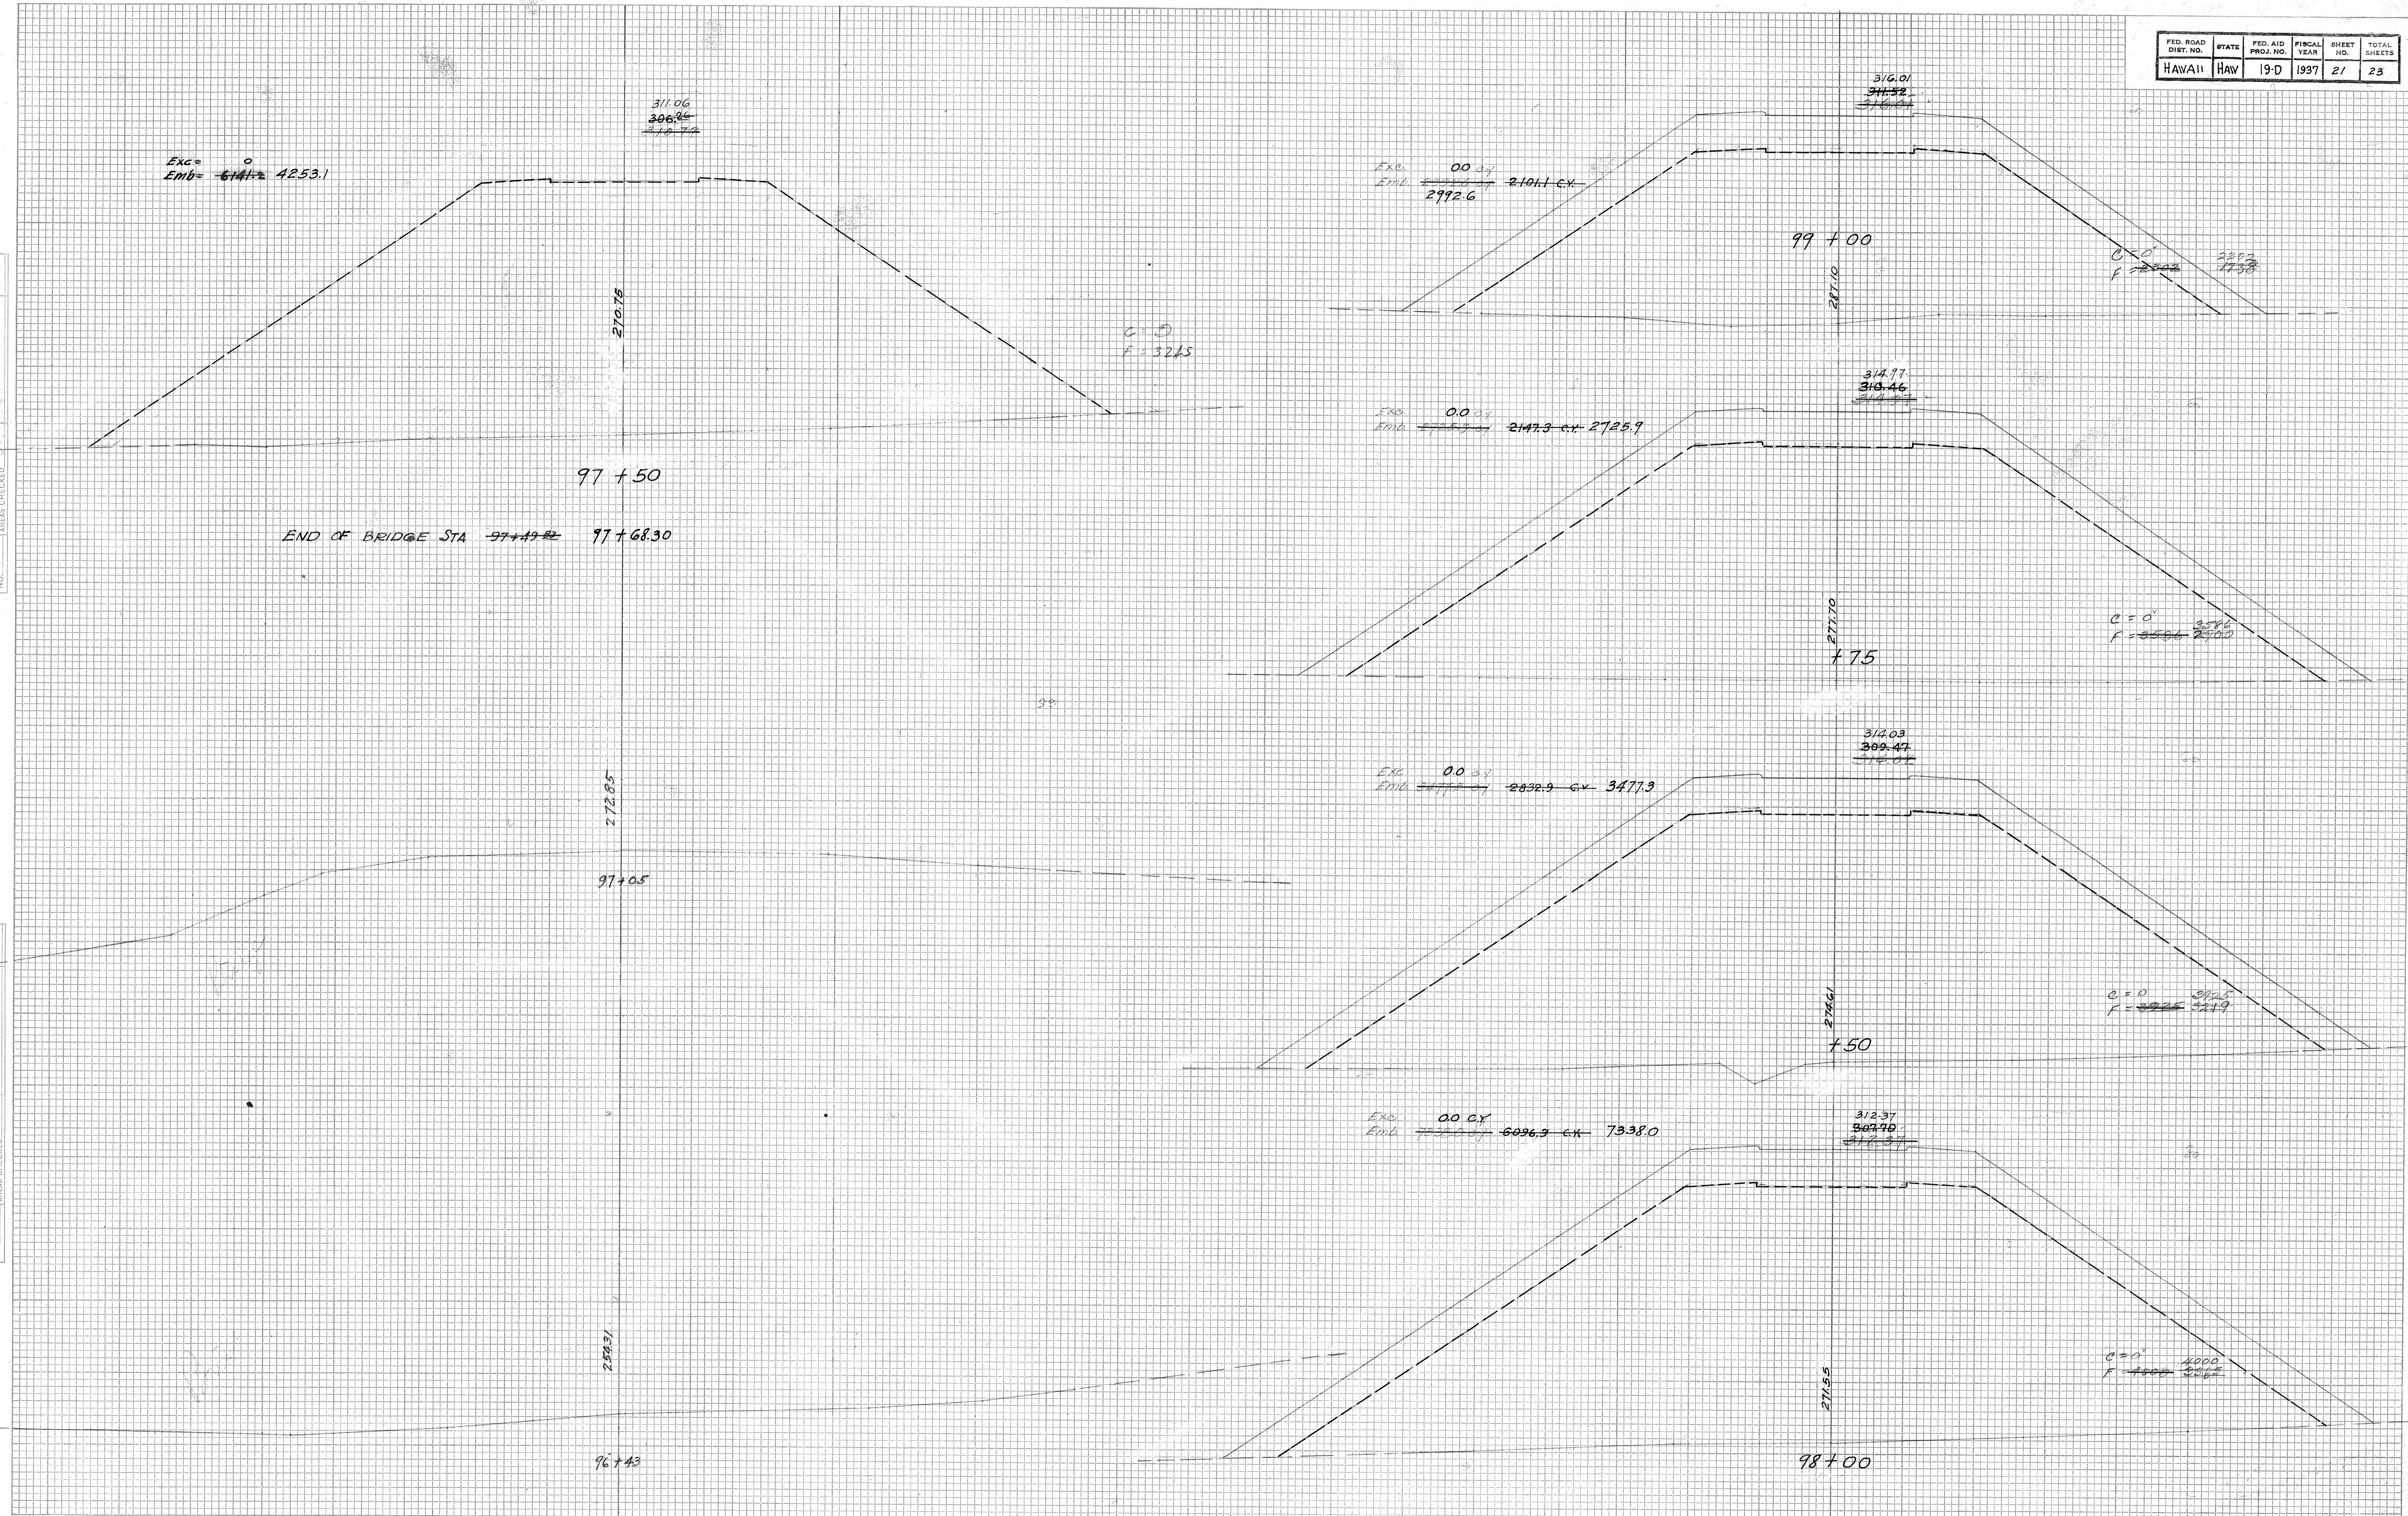



PLATE 3 - CROSS SECTION O. P. R. & R. E. STANDARD
KEUFFEL & ESSER CO., NEW YORK.

4433.21

FED. ROAD DIST. NO.	STATE	FED. AID PROJ. NO.	FISCAL YEAR	SHEET NO.	NO. OF SHEETS
HAWAII	HAV	19-D	1937	22	23

FINAL SURVEY	SURVEYED BY	DATE
PLOTTED		
NOTE BOOK NO.	TEMPLATE AREA CHECKED	

ORIGINAL SURVEY	SURVEYED BY	DATE
PLOTTED	A.H.A.	
NOTE BOOK NO.	TEMPLATE AREA CHECKED	

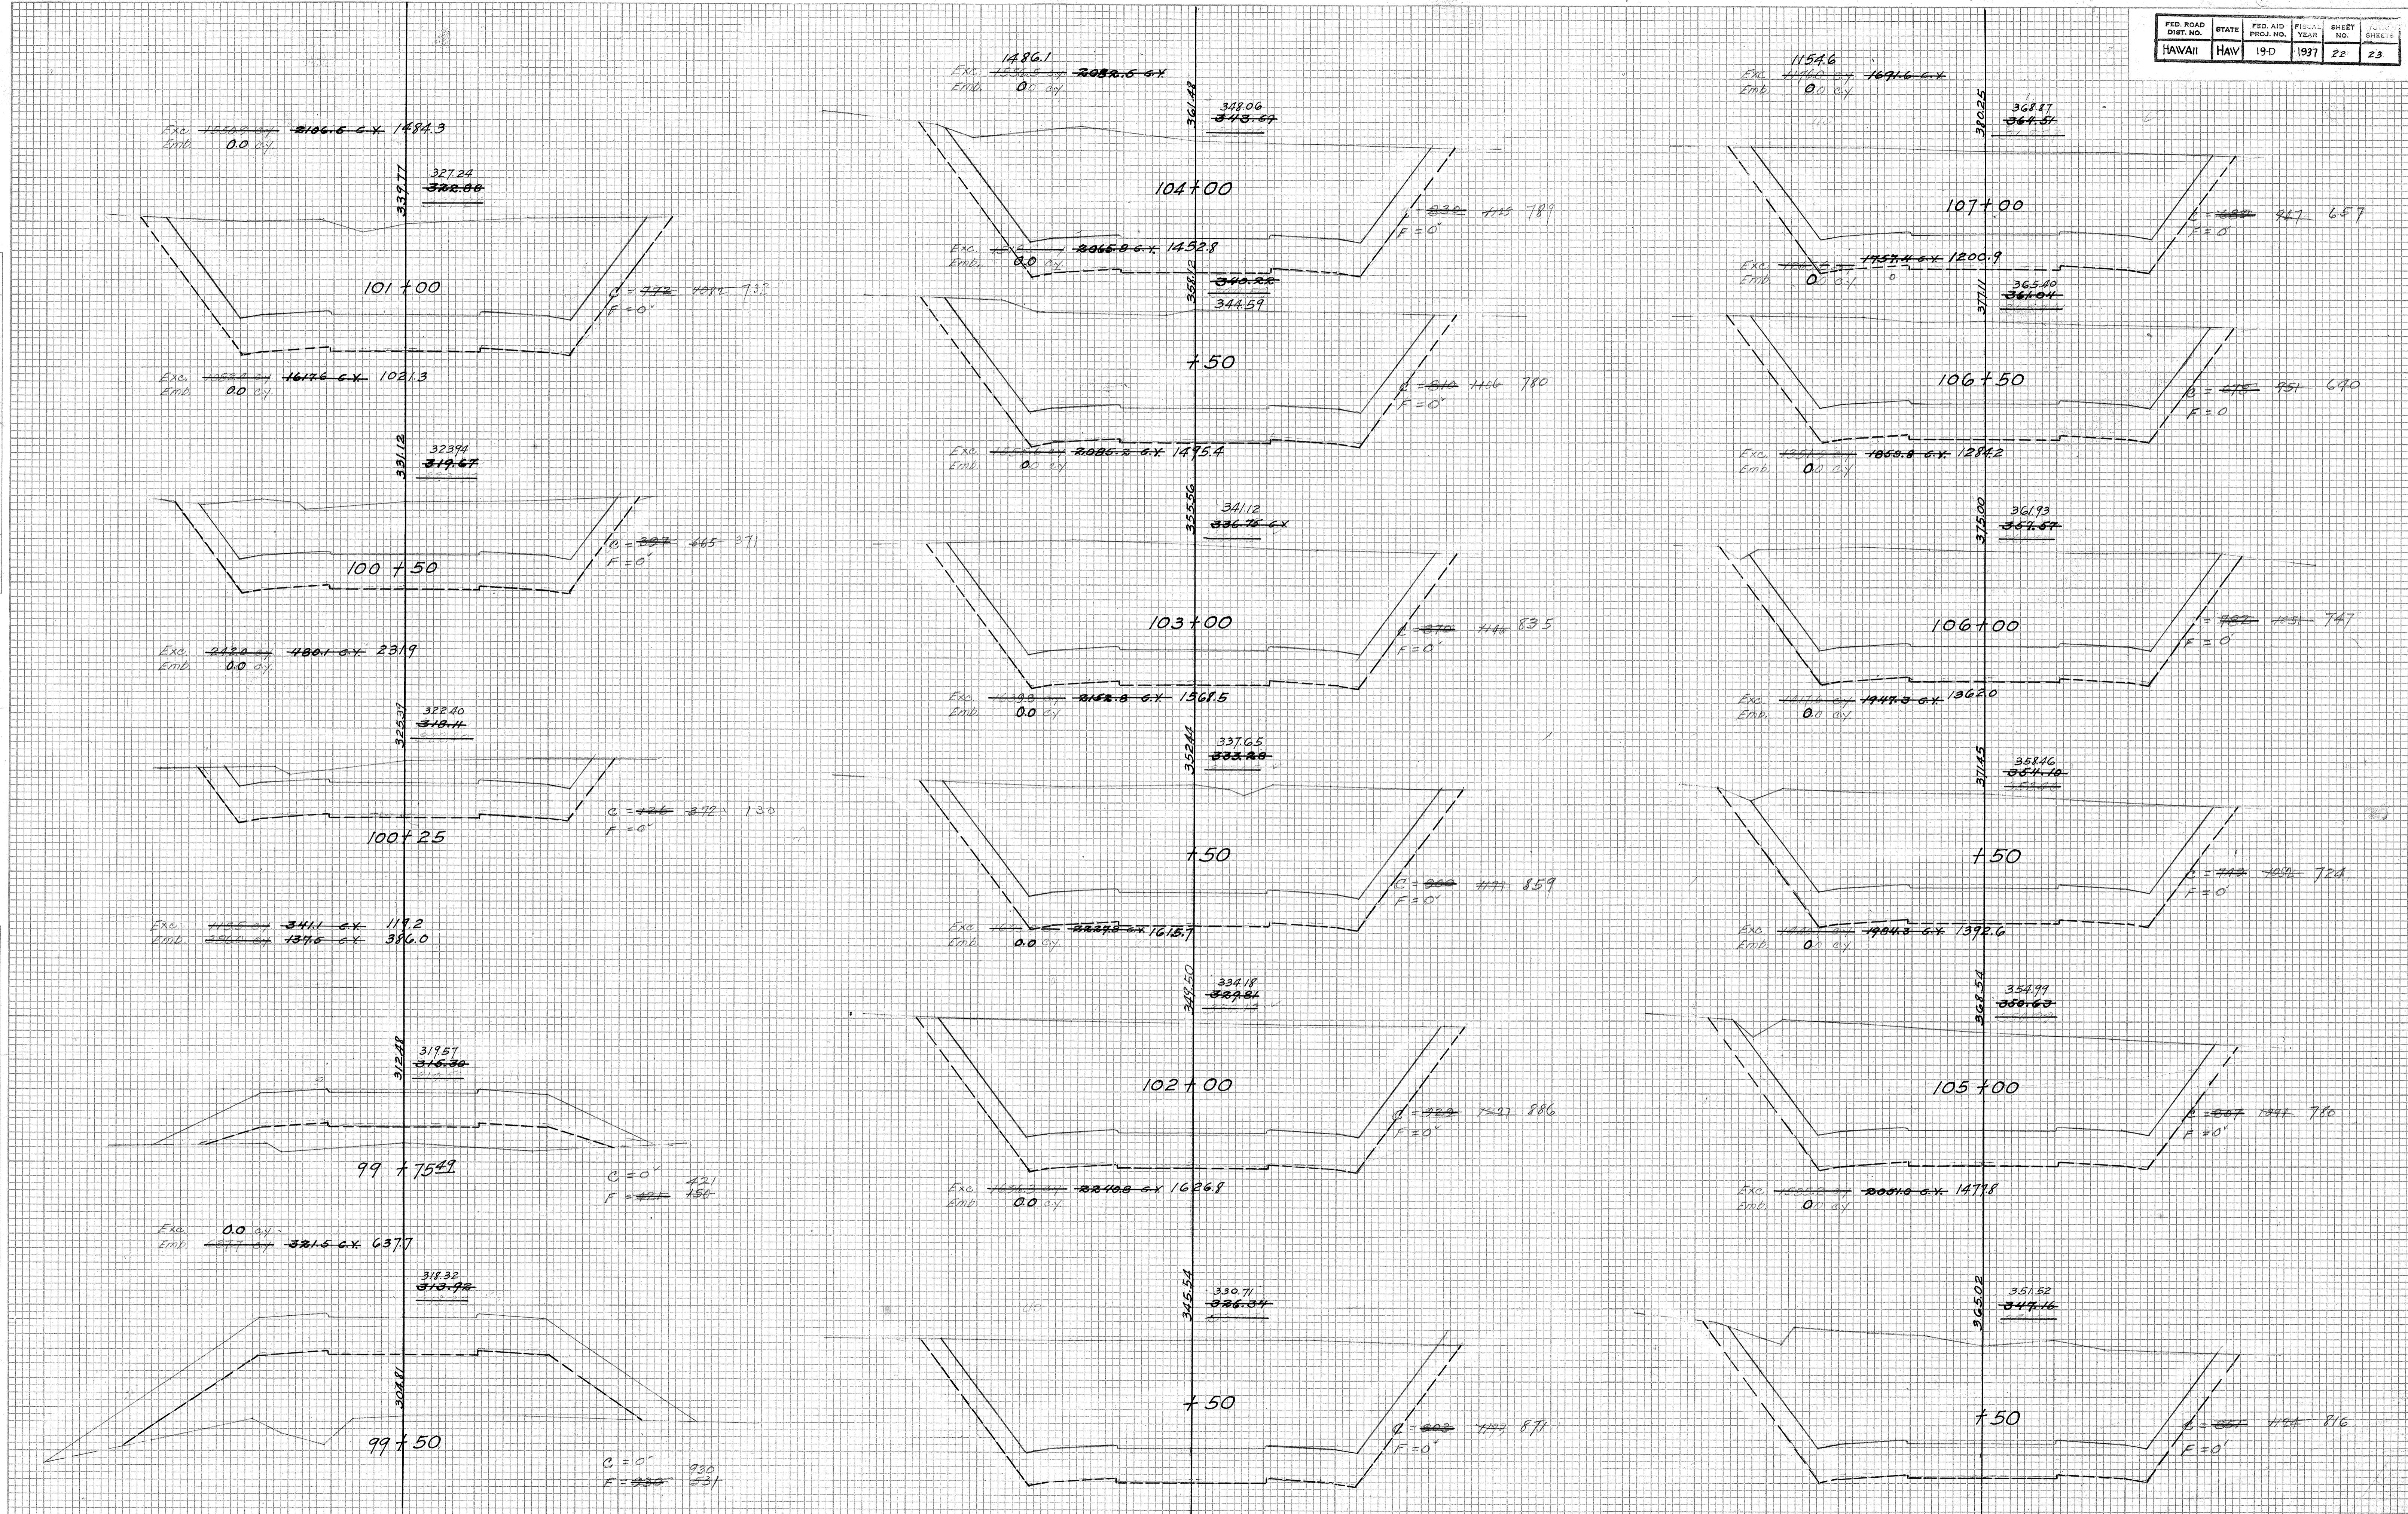

FED. ROAD DIST. NO.	STATE	FED. AID PROJ. NO.	FISCAL YEAR	SHEET NO.	TOTAL SHEETS
HAWAII	HAW	19-D	1937	23	23

ORIGINAL SURVEY BY A.H.A. DATE 1-31

ORIGINAL SURVEY BY A.H.A. DATE 1-31

FINAL SURVEY BY A.H.A. DATE 1-31

