

INDEX	TO DRAWINGS
SHEET NO.	DESCRIPTION
1	Title Sheet
2	Typical Road Section
3-4	Plan and Profile
5-6	Standard Details
7-8	Culvert Details
9-16	Bridge Details
17-23	Cross Sections

TERRITORY OF HAWAII

TERRITORIAL HIGHWAY DEPARTMENT

HONOLULU, T. H.

PLANS OF

KAUNAKAKAI-KUALAPUU ROAD

MANAWAINUI SECTION

FEDERAL AID PROJECT NO. 19-D

ISLAND OF MOLOKAI


SCALE

PLAN1 IN. = 100 FT.

PROFILEHOR. 1 IN. = 100 FT.

VER. 1 IN. = 10 FT.

CROSS SECTION1 IN. = 10 FT.

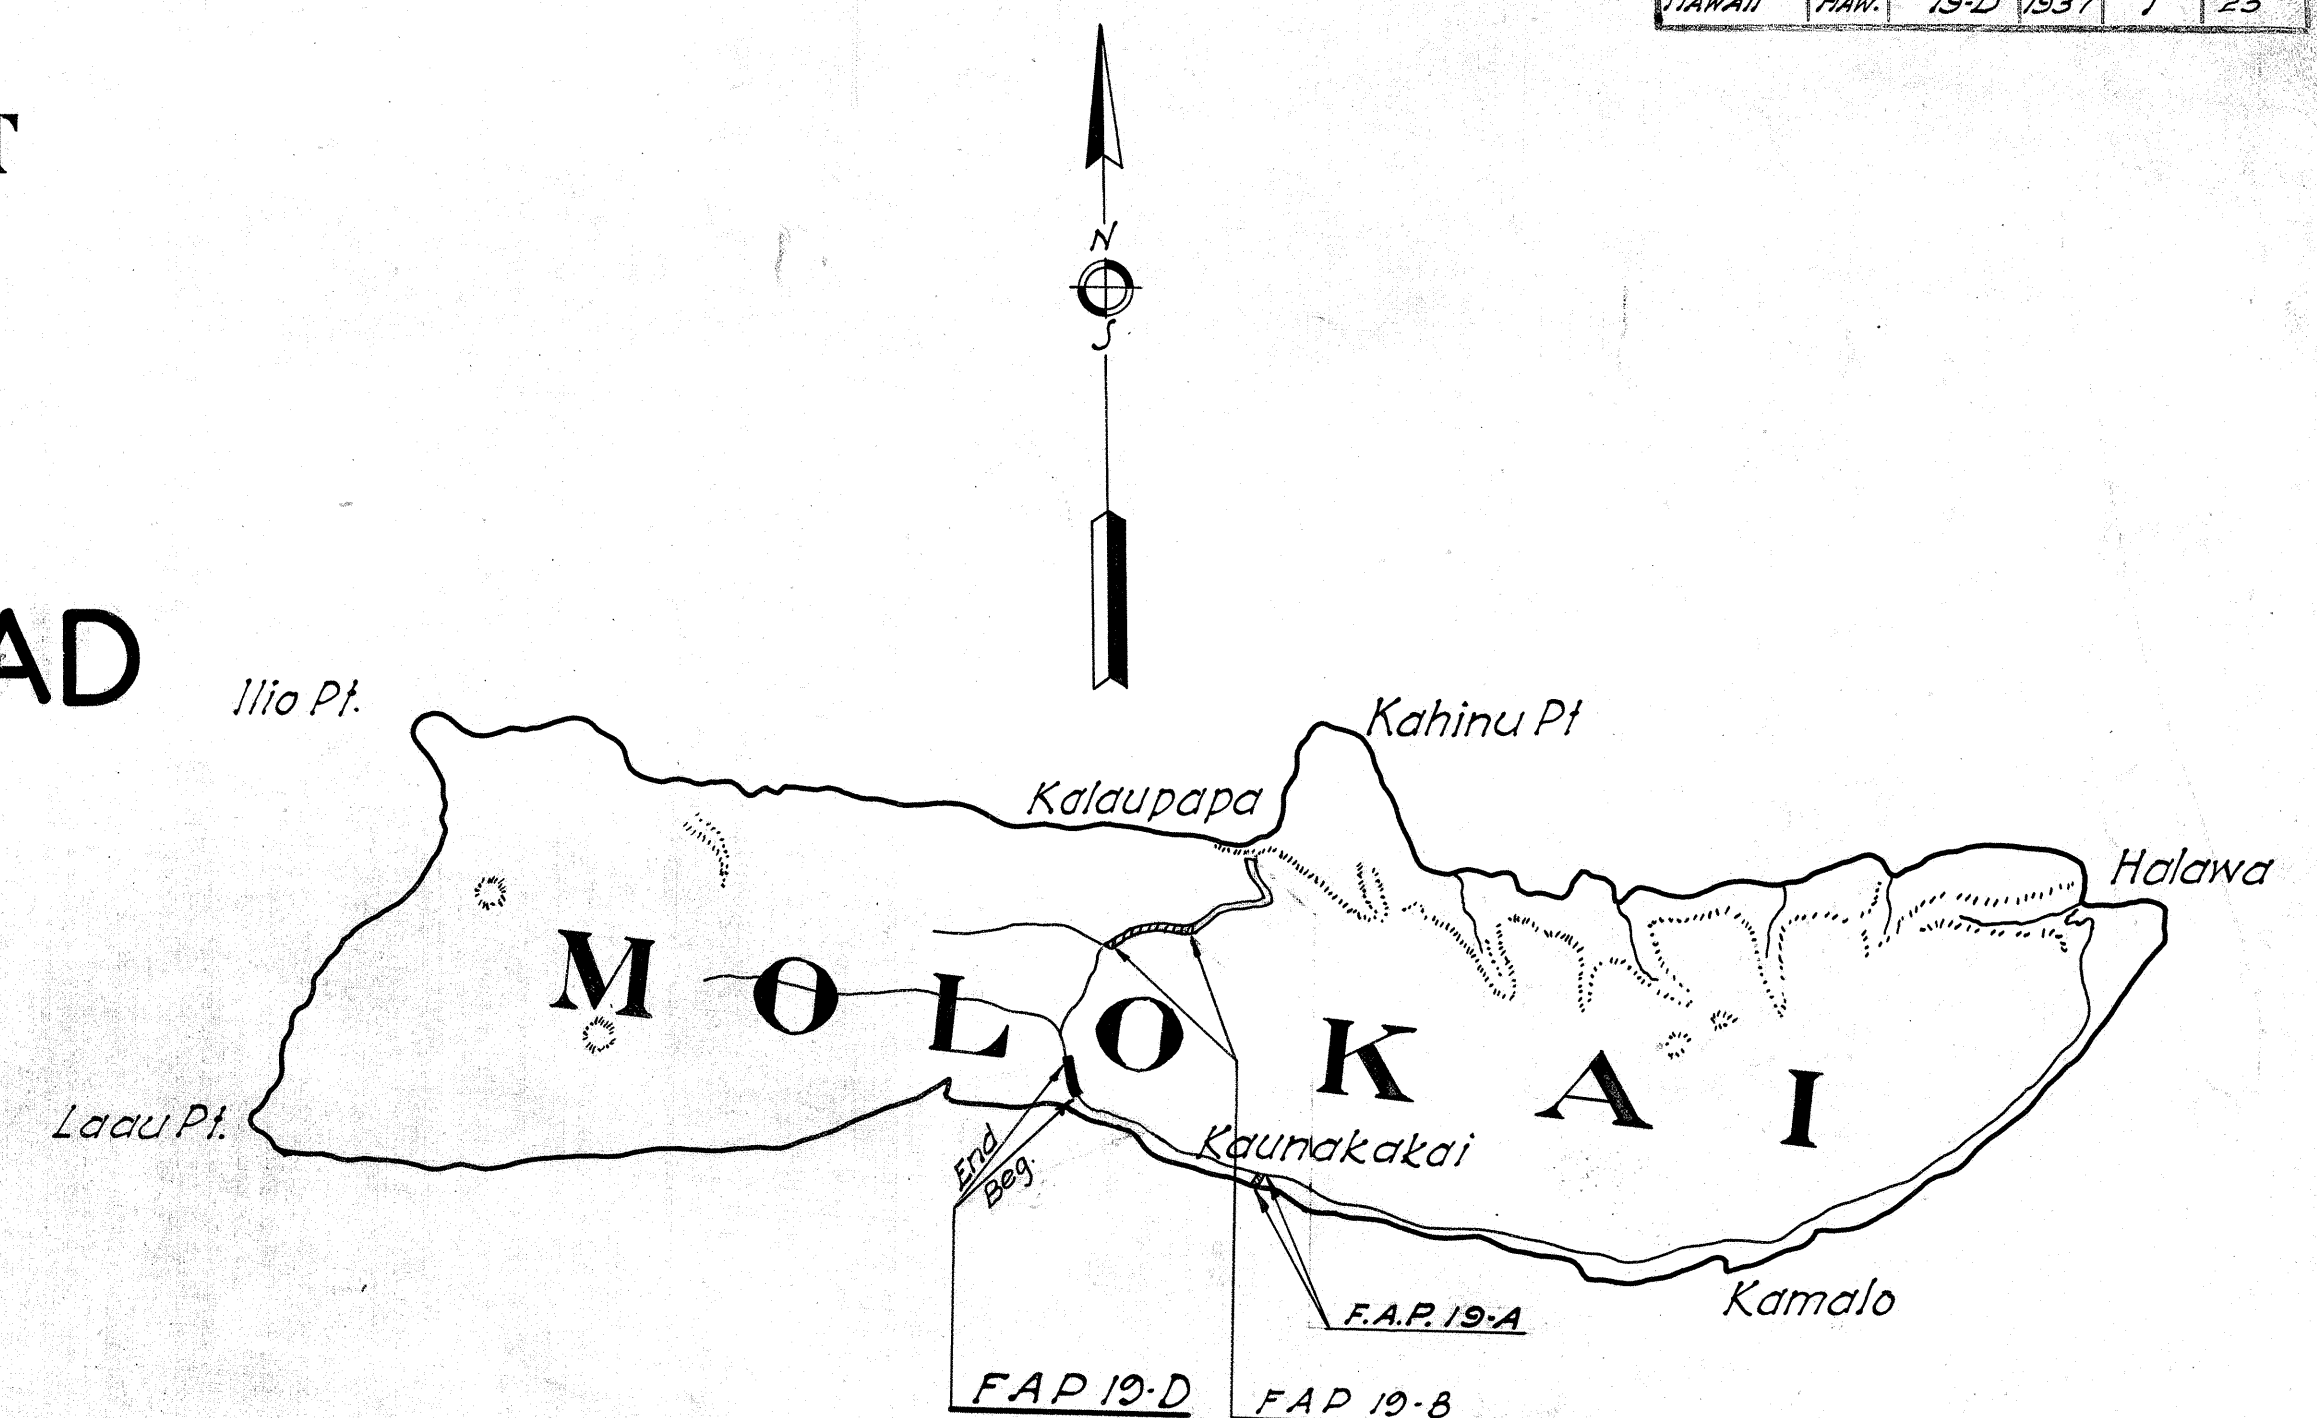

Federal Aid Projects previously constructed or under construction

CONVENTIONAL SIGNS


Present Road

Existing Fence

Center Line

Bridges

Culverts

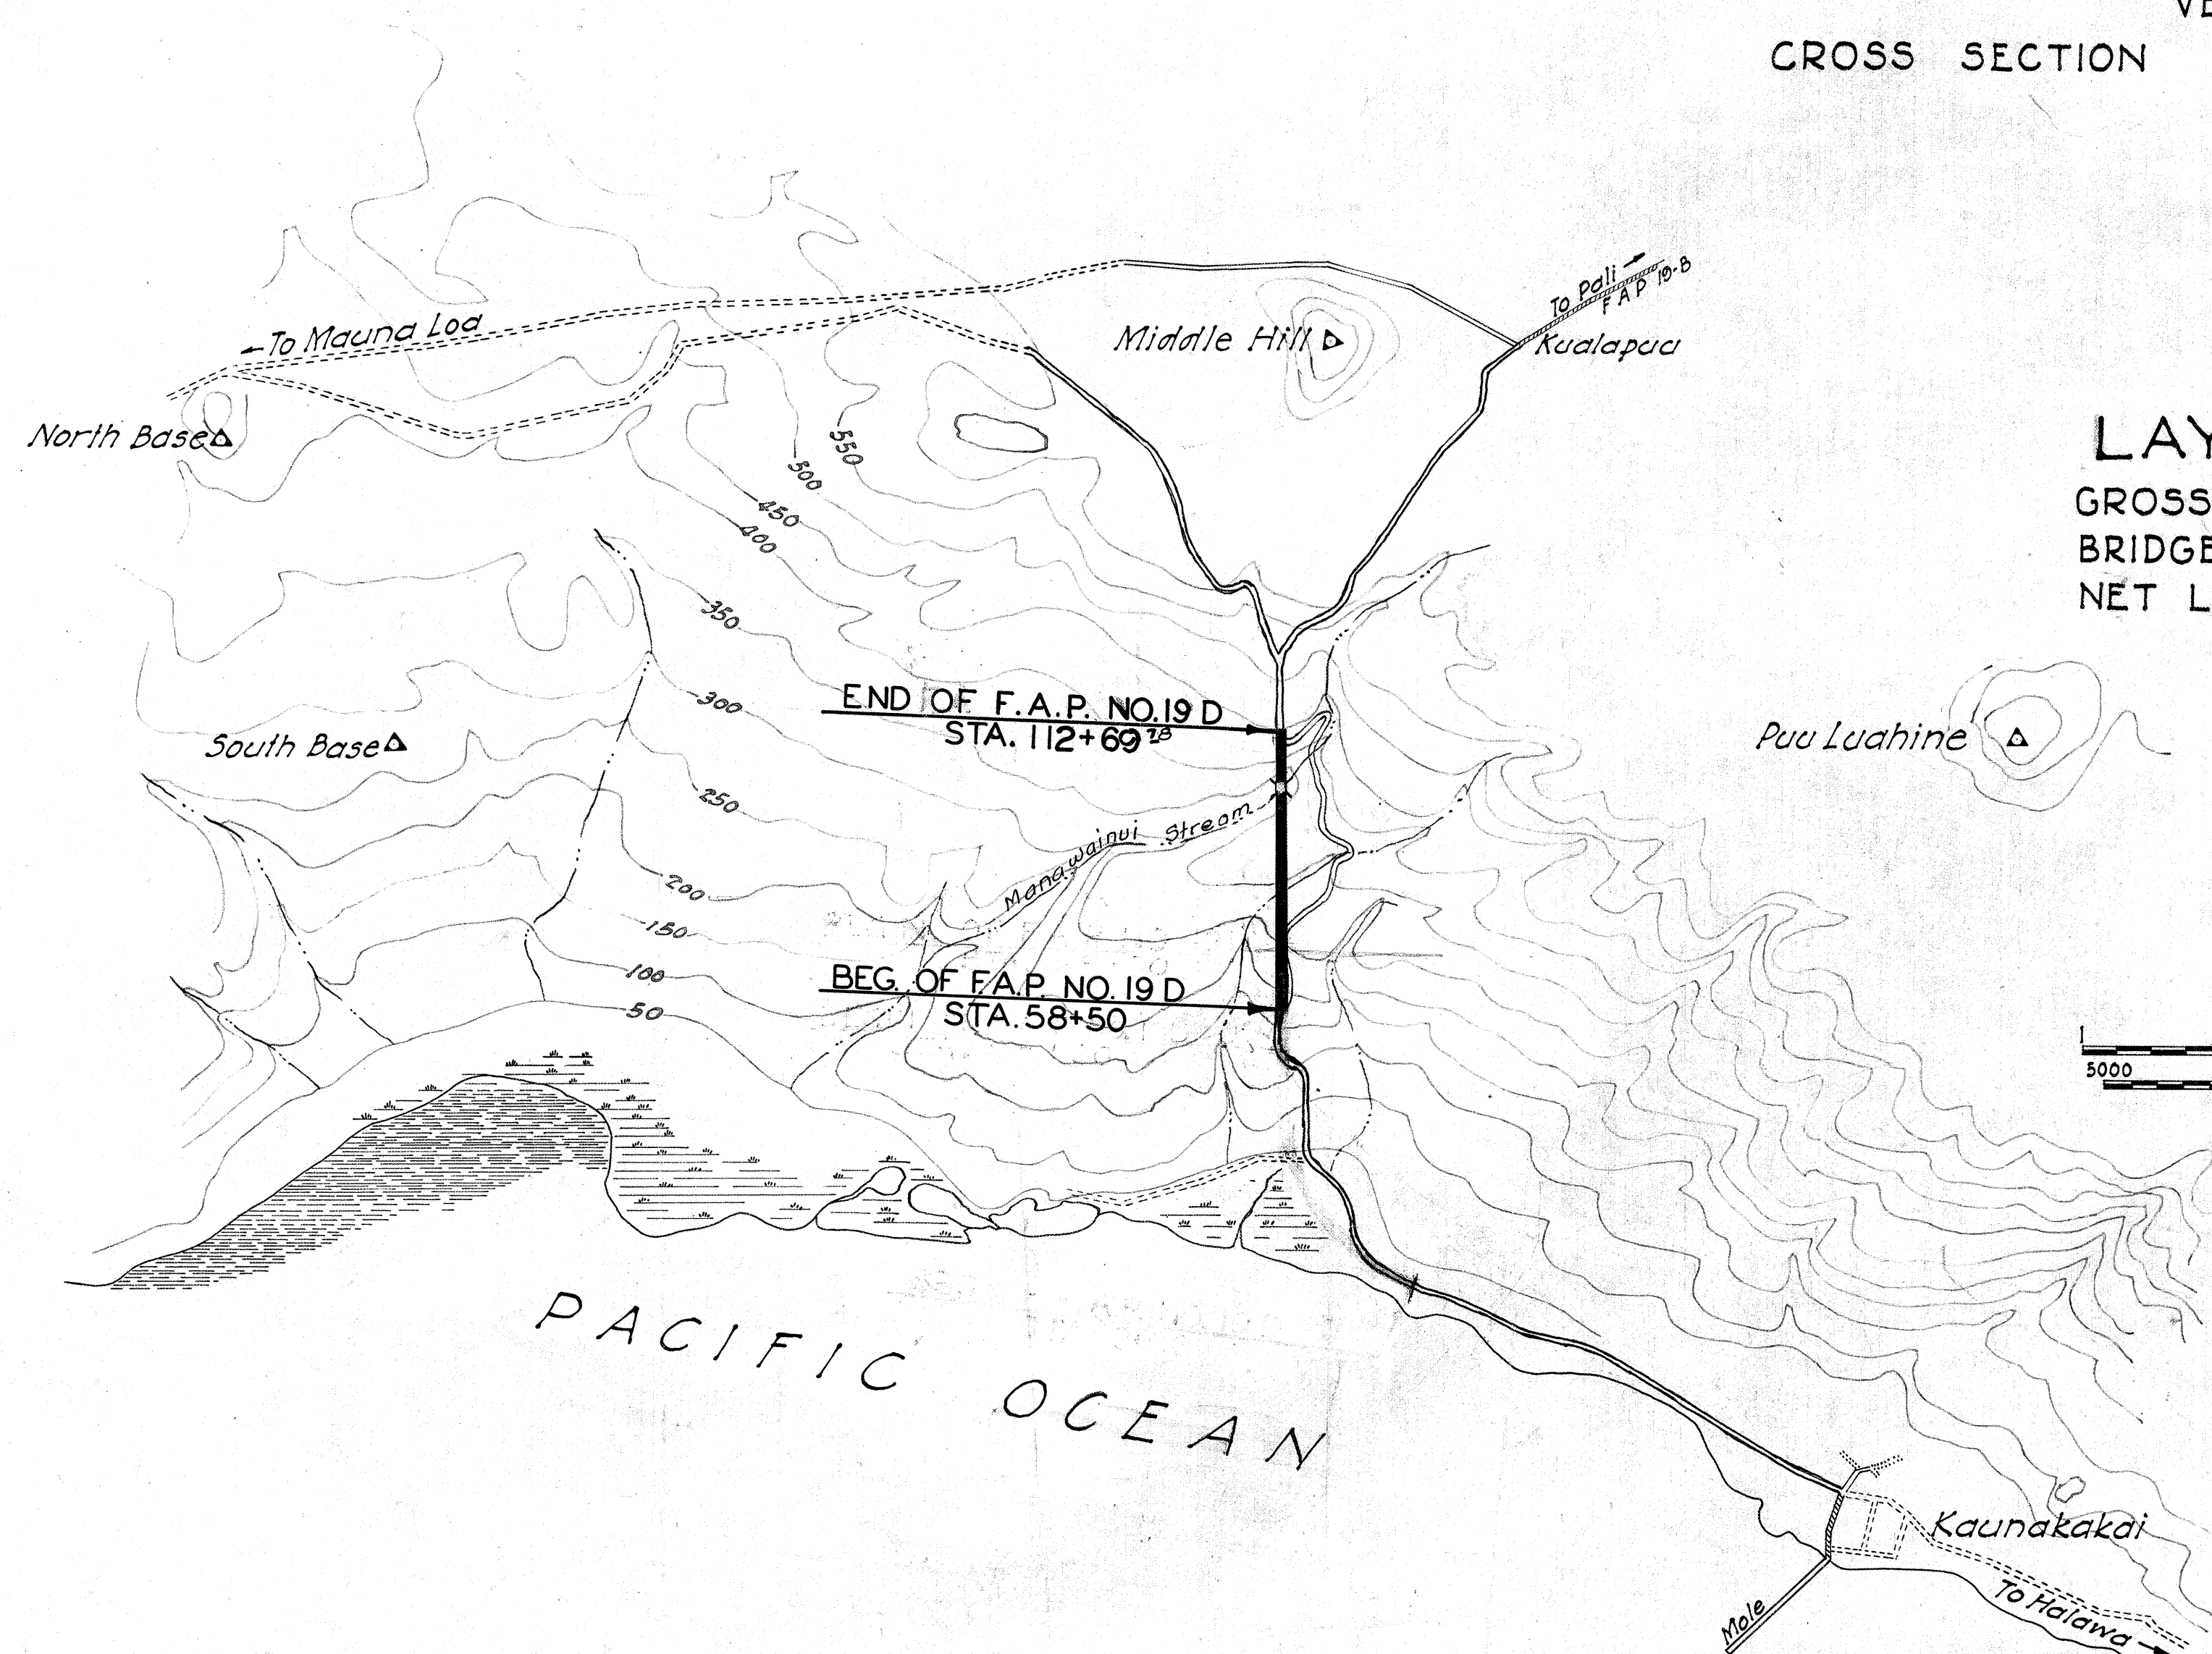


LAYOUT OF PROJECT

GROSS LENGTH PROJECT1.026 MILES

BRIDGE0.062 MILES

NET LENGTH - ROADWAY0.764 MILES

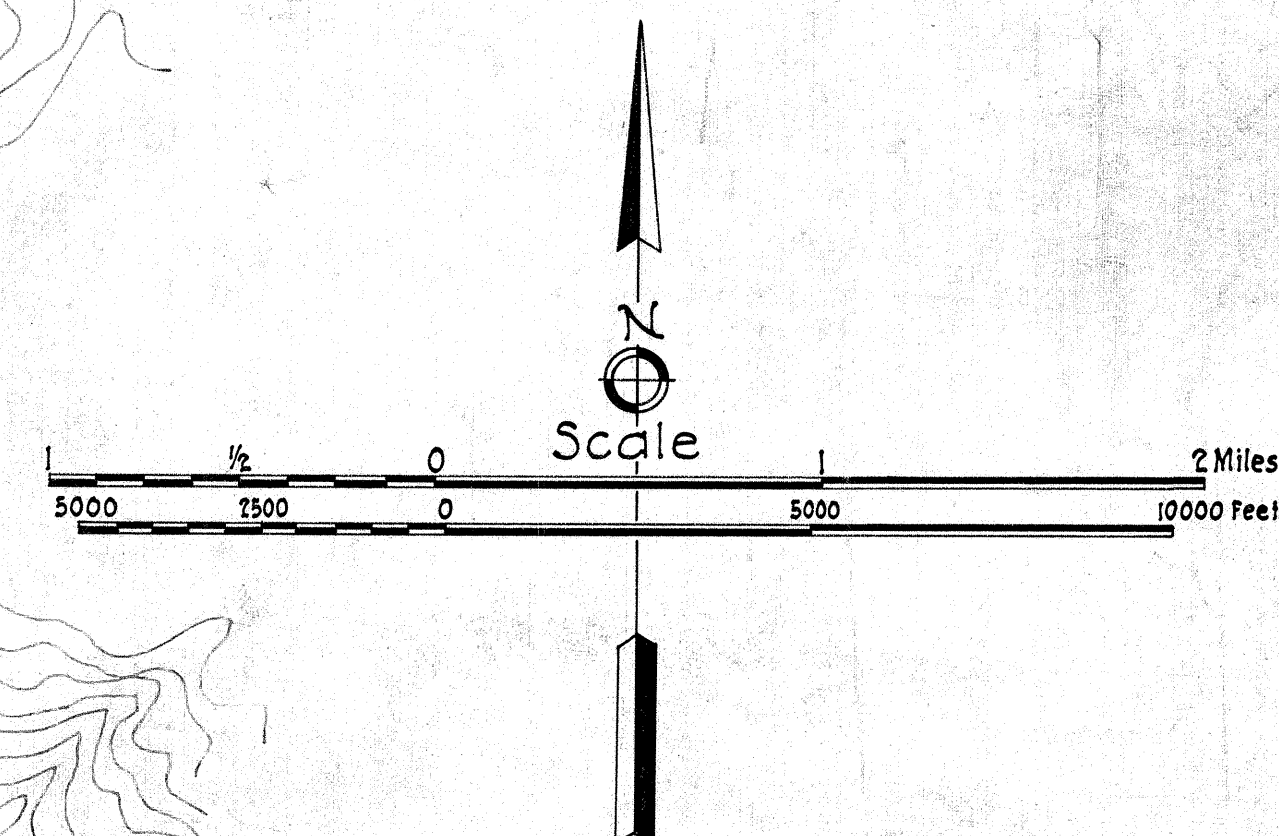

APPROVED

Louis Blaine

TERRITORIAL HIGHWAY ENGINEER

RECOMMENDED FOR APPROVAL

PRINCIPAL HWY ENGR BUREAU of PUB. RDS

RECOMMENDED FOR APPROVAL

CHIEF ENGR BUREAU of PUB. RDS

APPROVED

CHIEF BUREAU of PUBLIC ROADS

DESIGNED BY	8-27
TRACED BY	
QUANTITIES BY	
CHECKED BY	

Revised Terminal limits extended.