


FED. ROAD DIST. NO.	STATE	FED. AID PROJ. NO.	FISCAL YEAR	SHEET NO.	TOTAL SHEETS
HAWAII	HAW.	N.R.H. 344(1)	1939	3	17



Revised Apr. 19, 1939
Aug. 8, 1939

Revision Apr. 19, 1939 Culvert at Sta. 25+00 changed from circ. conc. culvert to 6 x 3 conc. box culvert.

B. Kaimukilani
H. Hayakawa
111

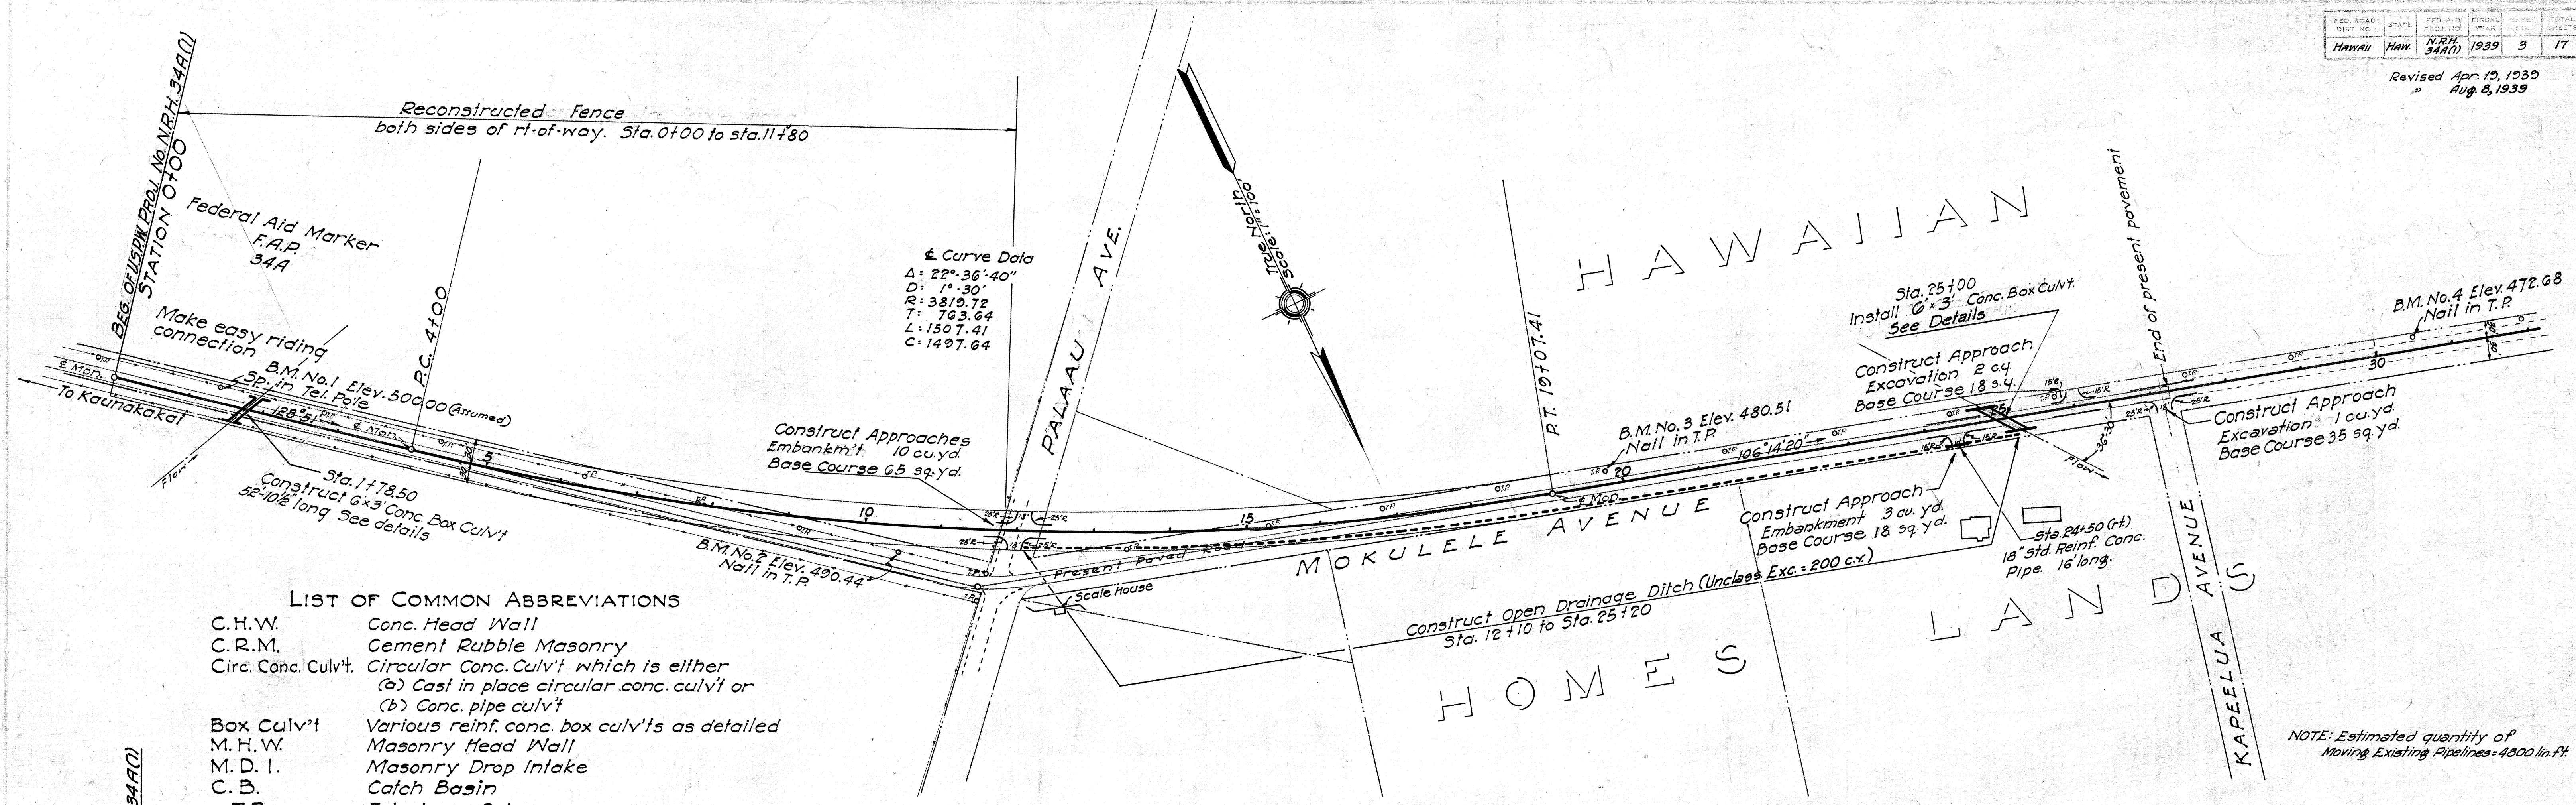

NOTE: Estimated quantity of Moving Existing Pipelines = 4300 lin. ft.


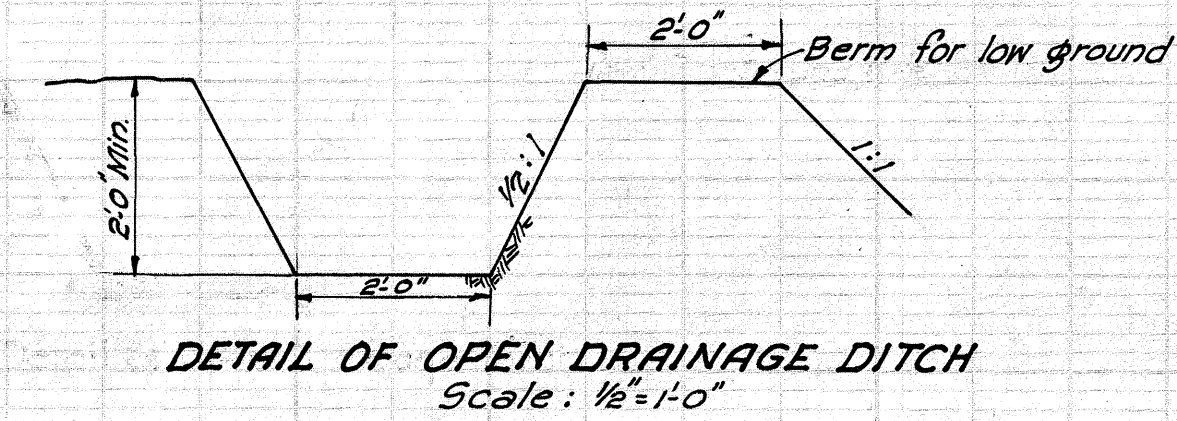
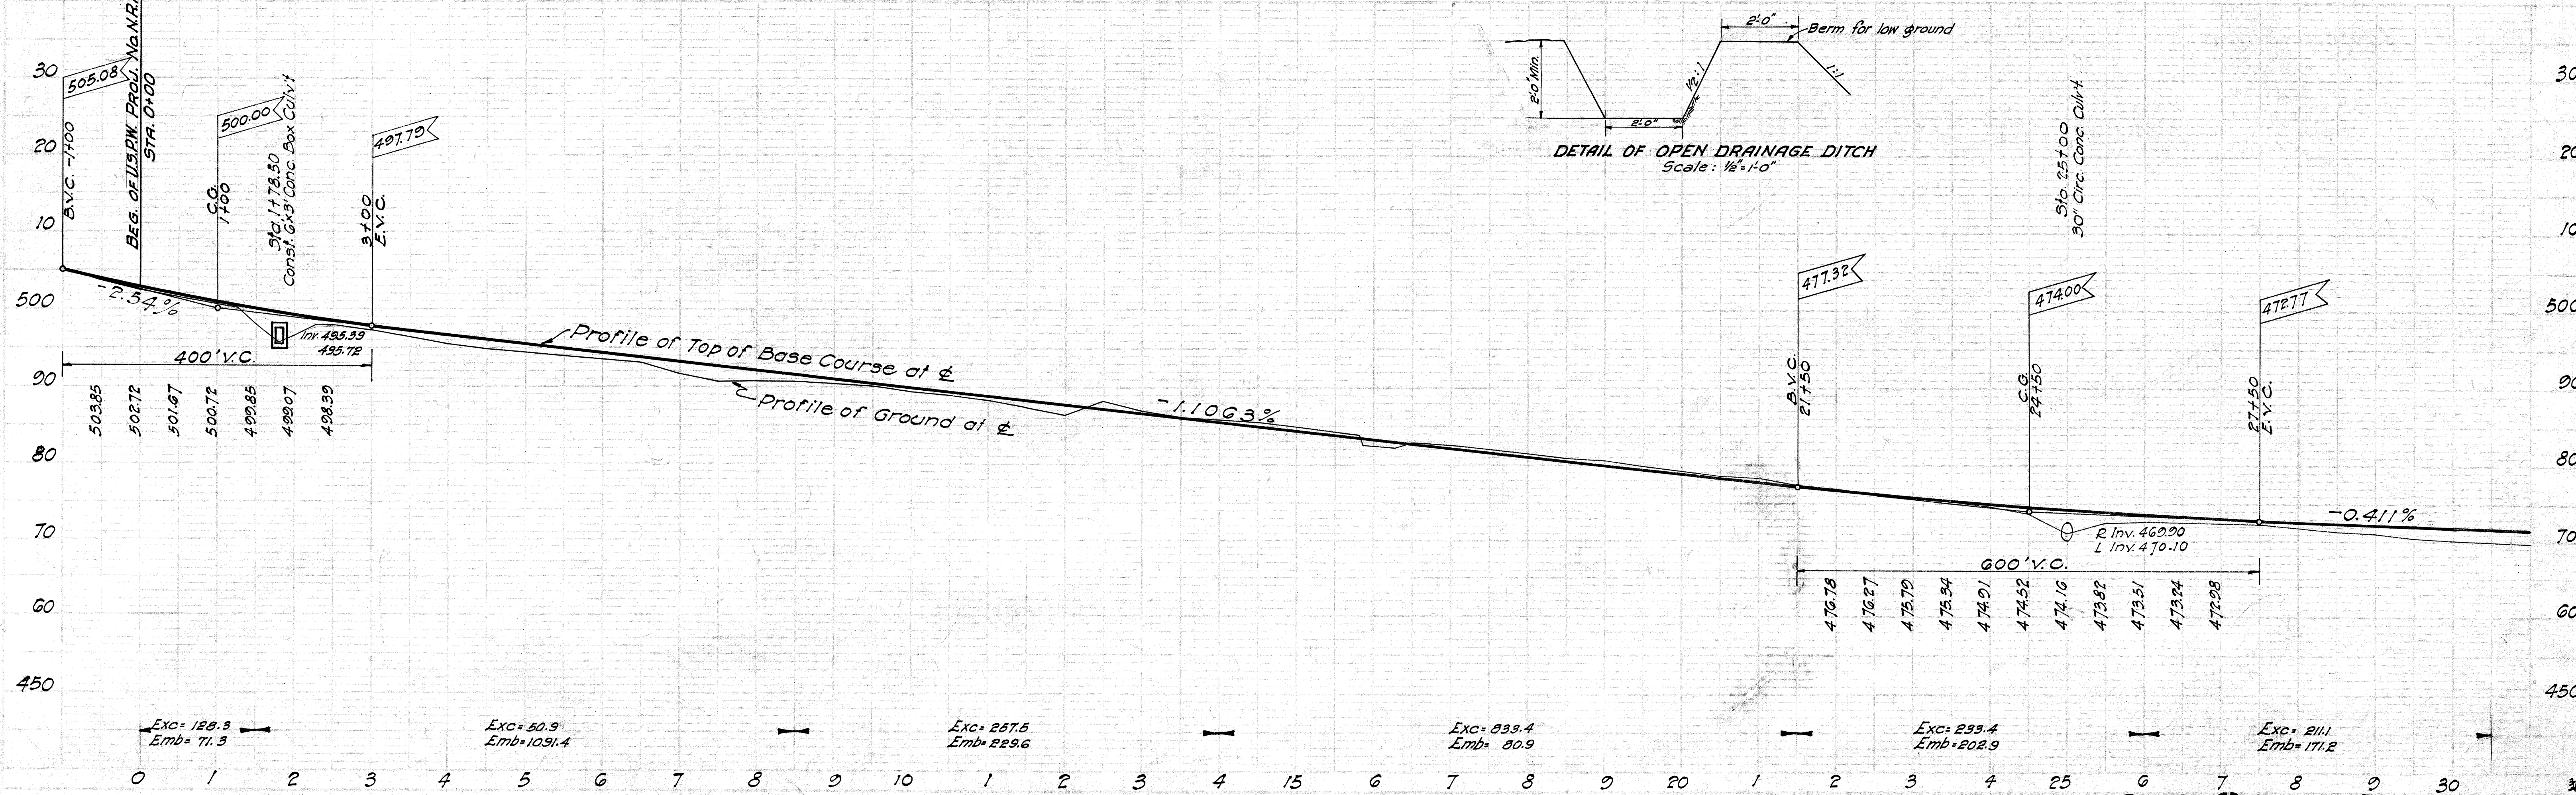


4489.3

FED. ROAD DIST. NO.	STATE	FED. AID PROJ. NO.	FISCAL YEAR	SHEET NO.	TOTAL SHEETS
HAWAII	HAW.	N.R.H. 34A (1)	1939	4	17

Revised Aug. 8, 1939
Oct. 10, 1939



HAWAIIAN HOMES LANDS

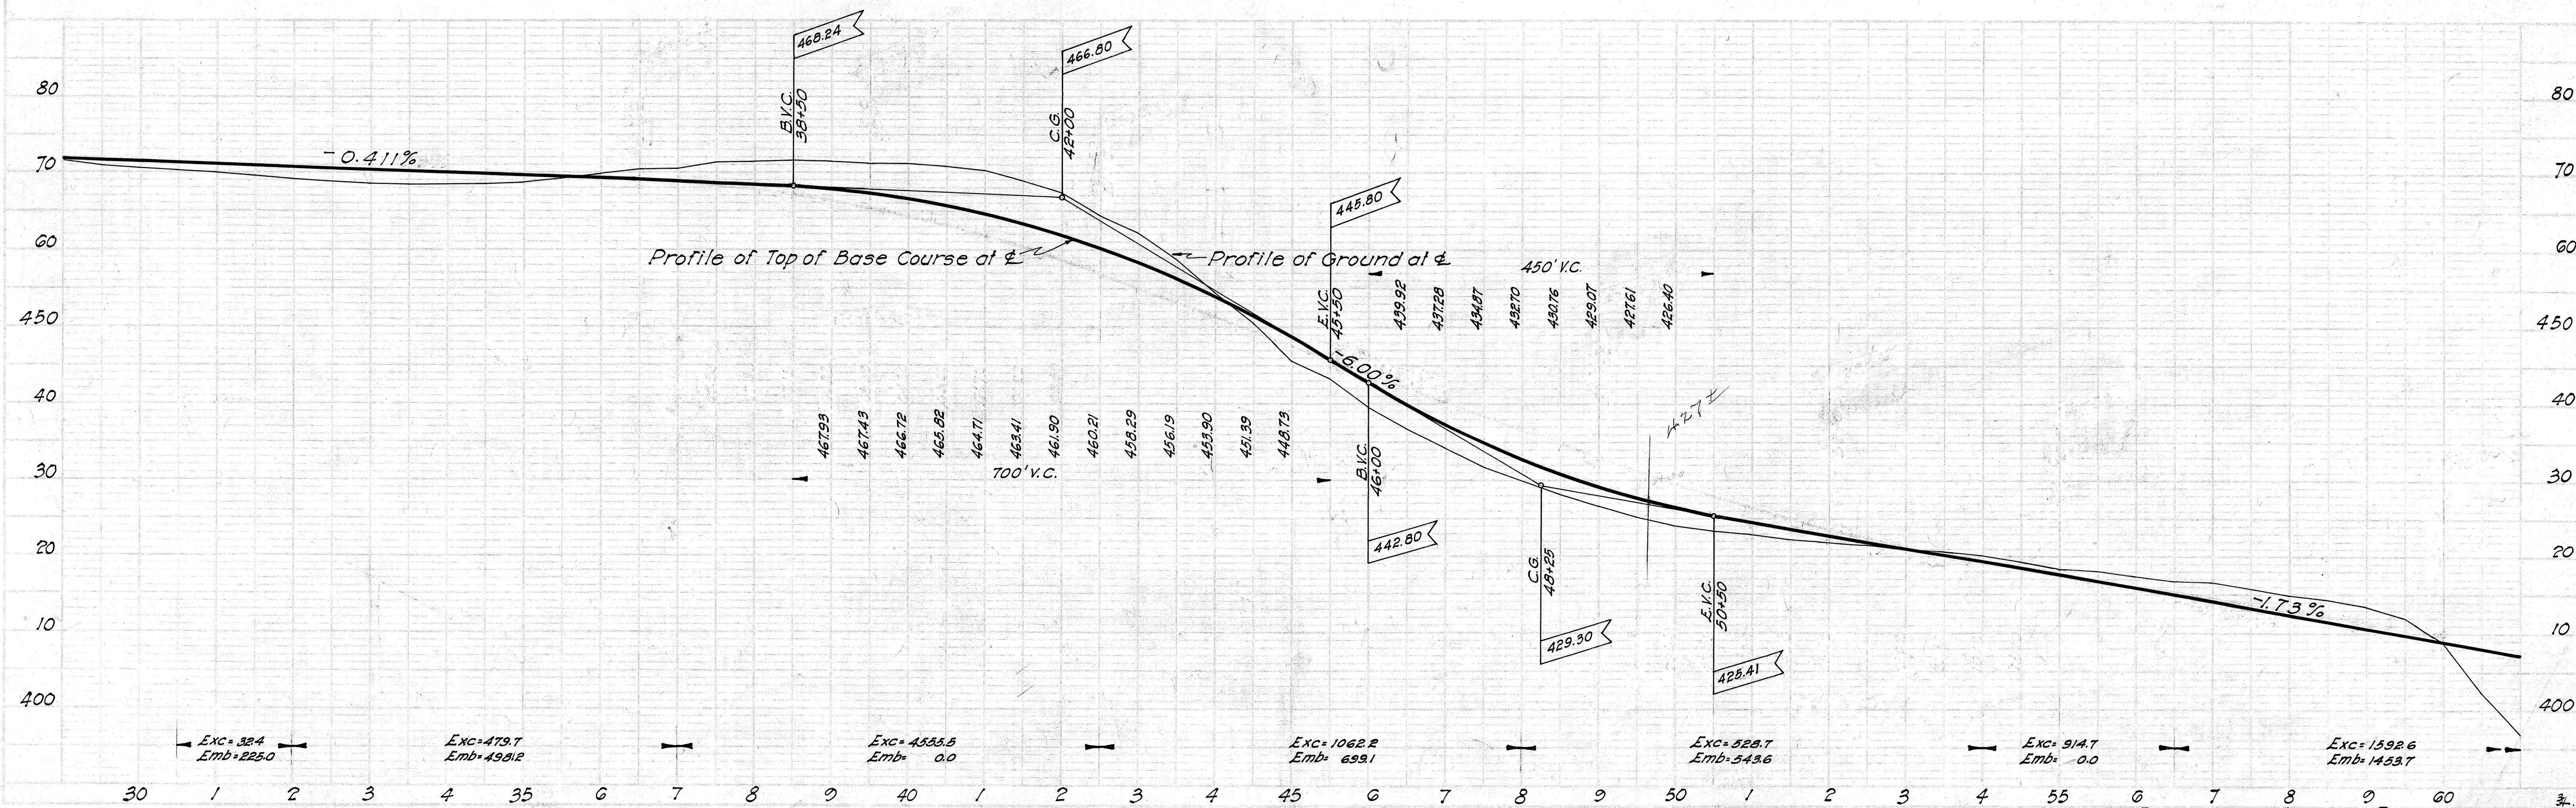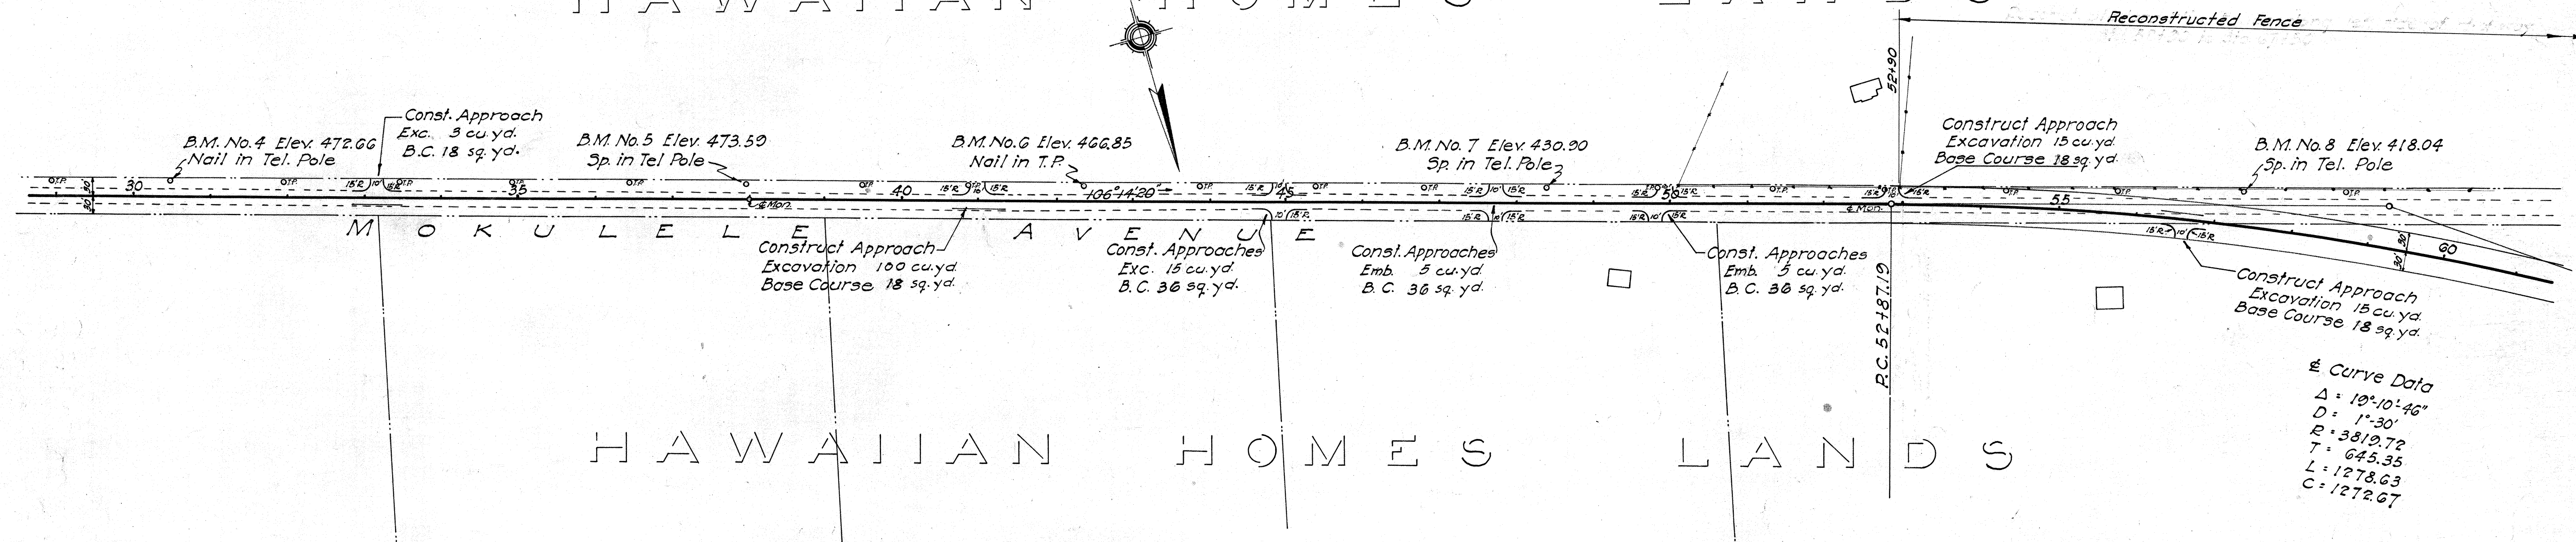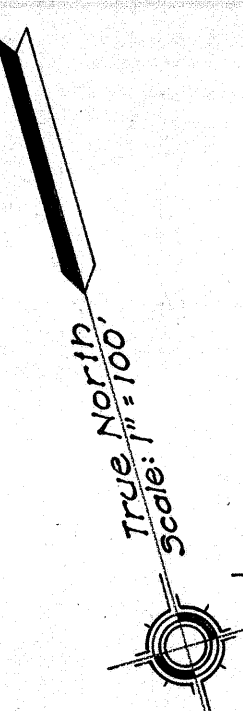

4489.4



Revised Oct. 10, 1939

FED. ROAD DIST. NO.	STATE	FED. AID PROJ. NO.	FISCAL YEAR	SHEET NO.	TOTAL SHEETS
HAWAII	HAW.	N.H. 344(7)	1939	5	17

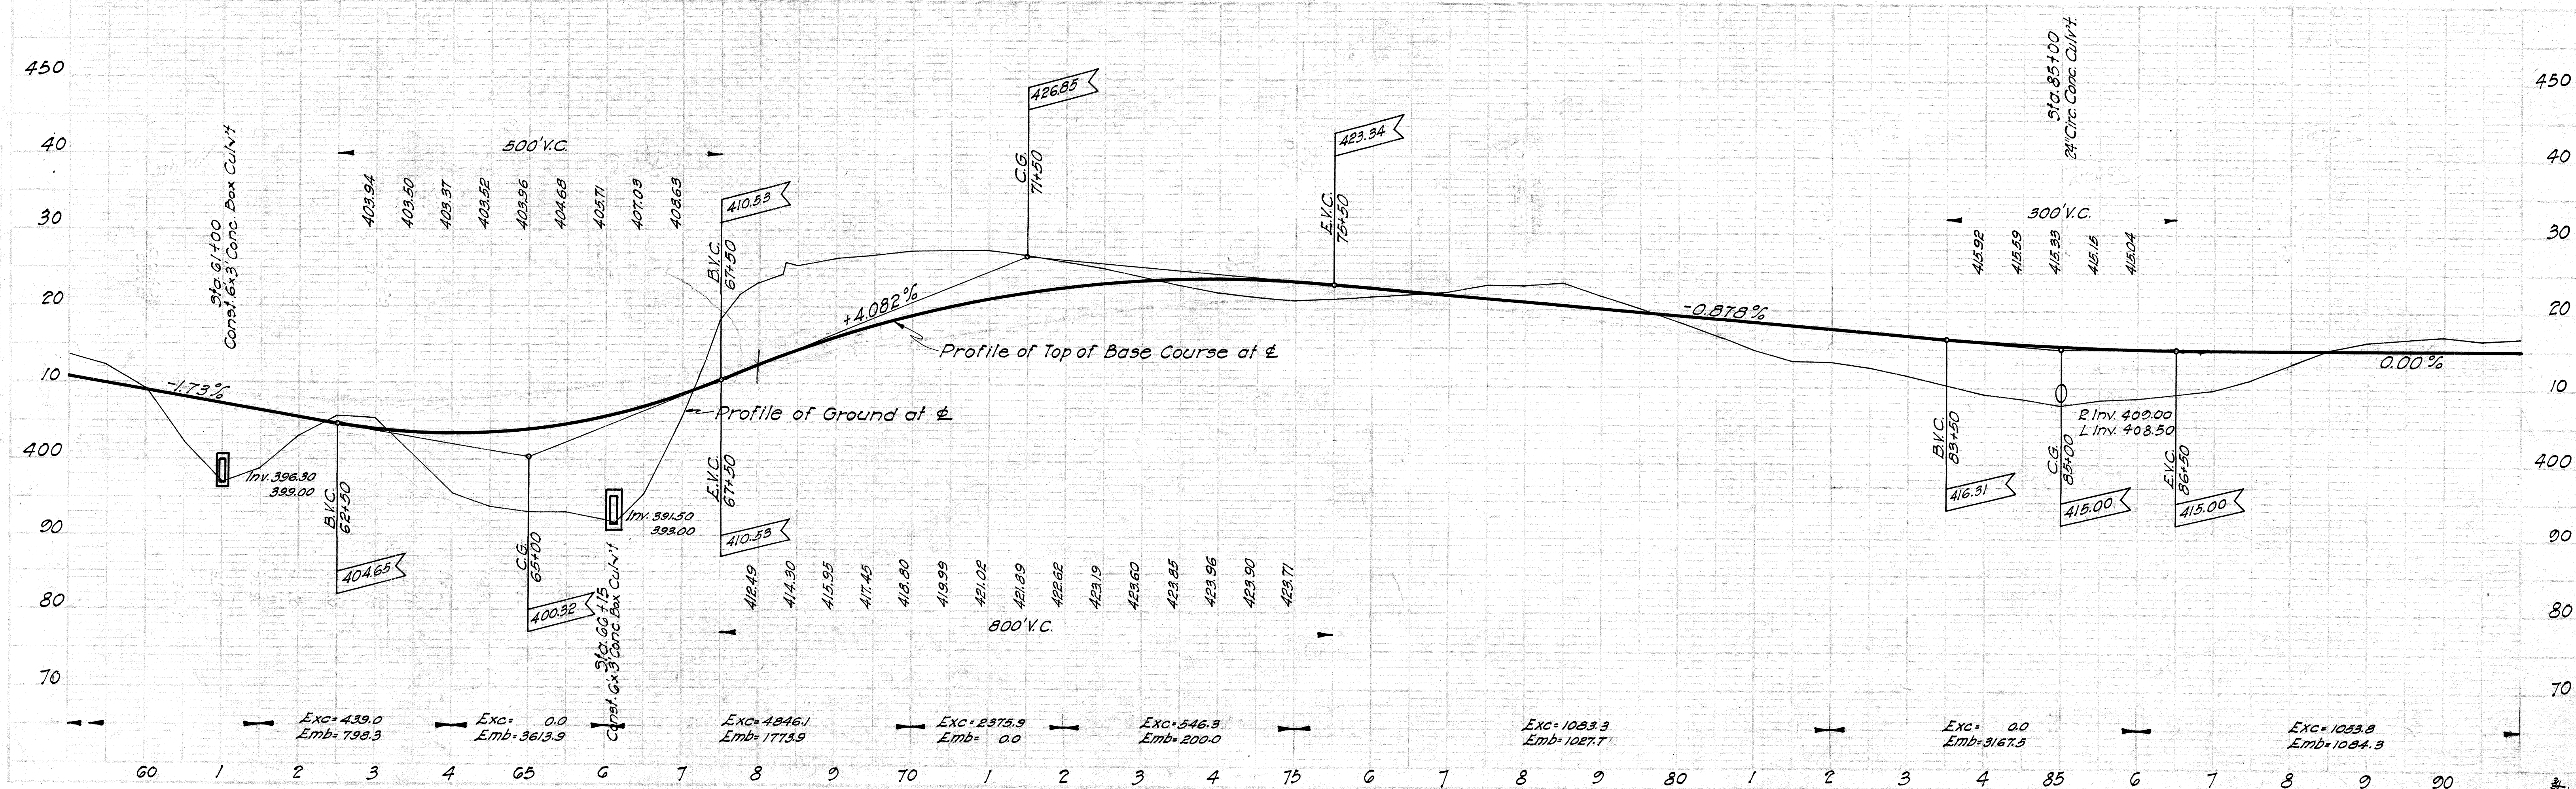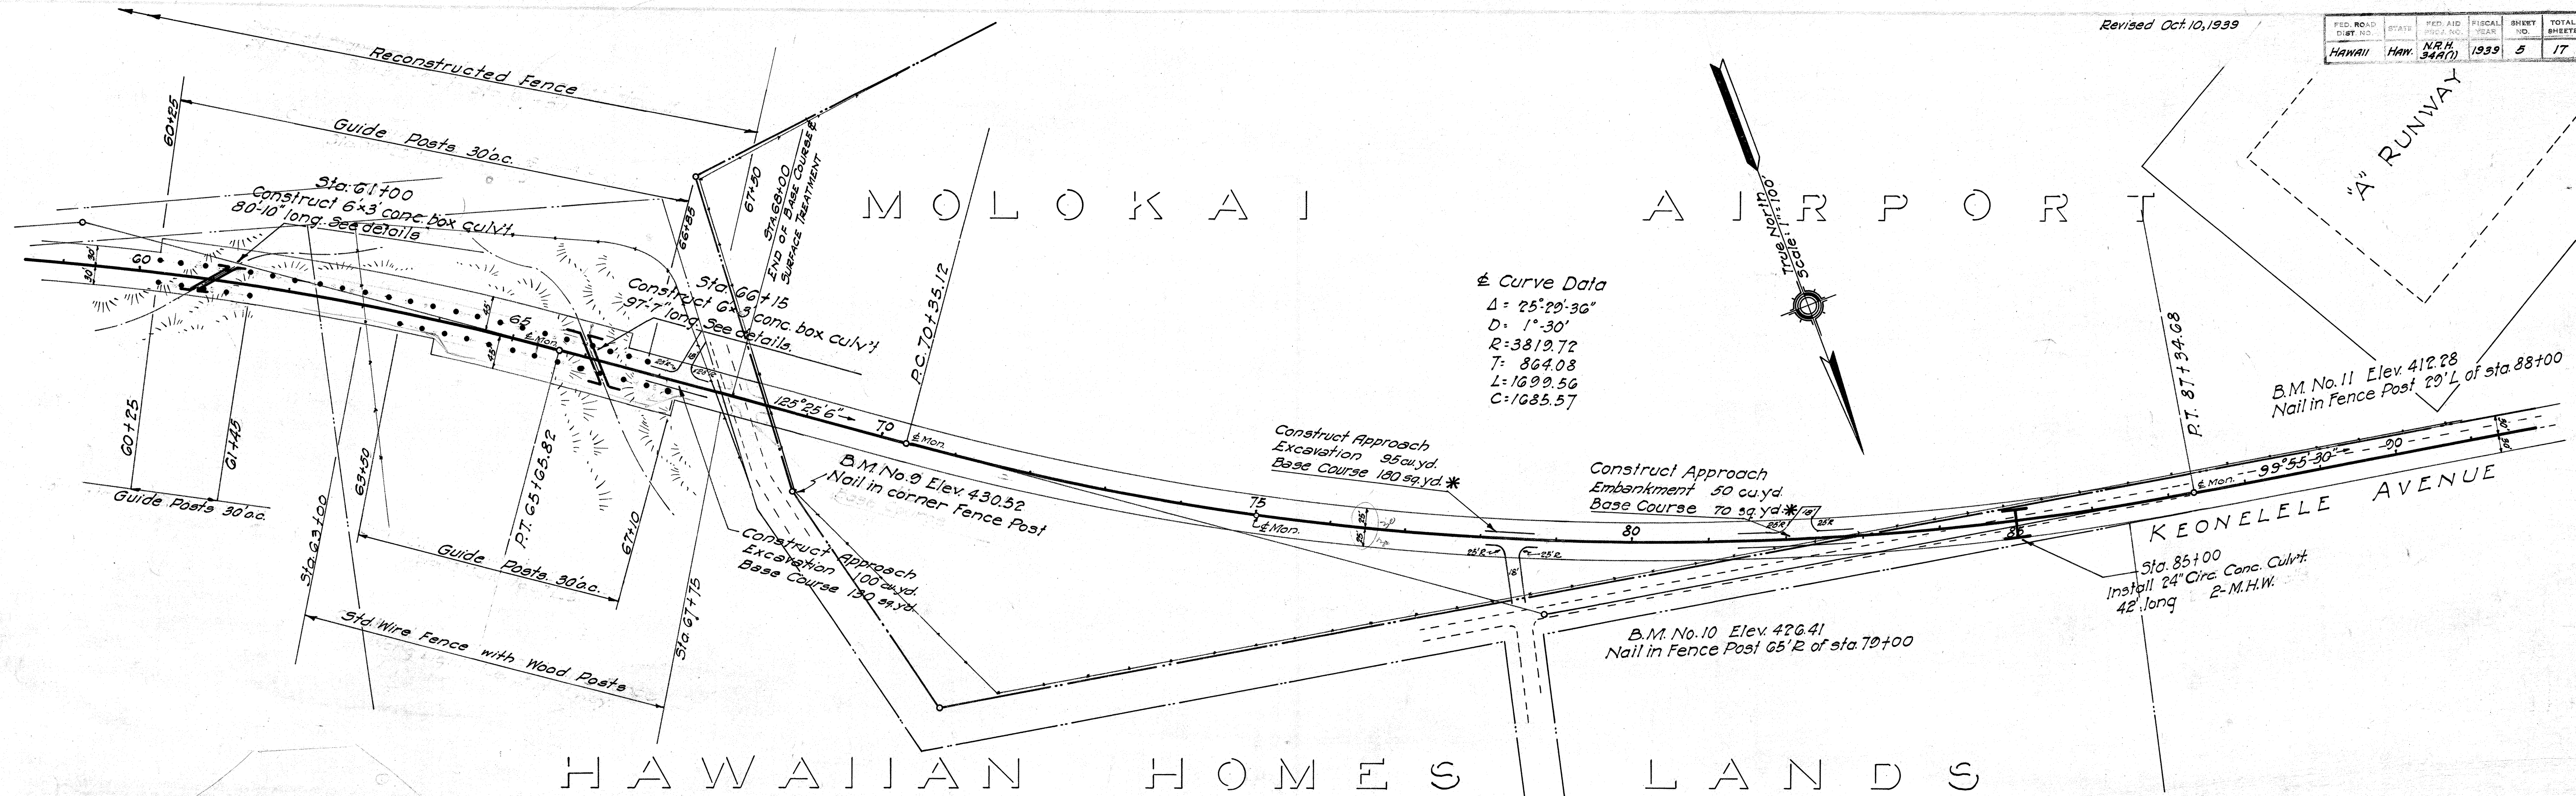

4489.5

FED. ROAD DIST. NO.	STATE	FED. AID PROJ. NO.	FISCAL YEAR	SHEET NO.	TOTAL SHEETS
HAWAII	HAW.	N.R.H. 34A(7)	1999	6	17

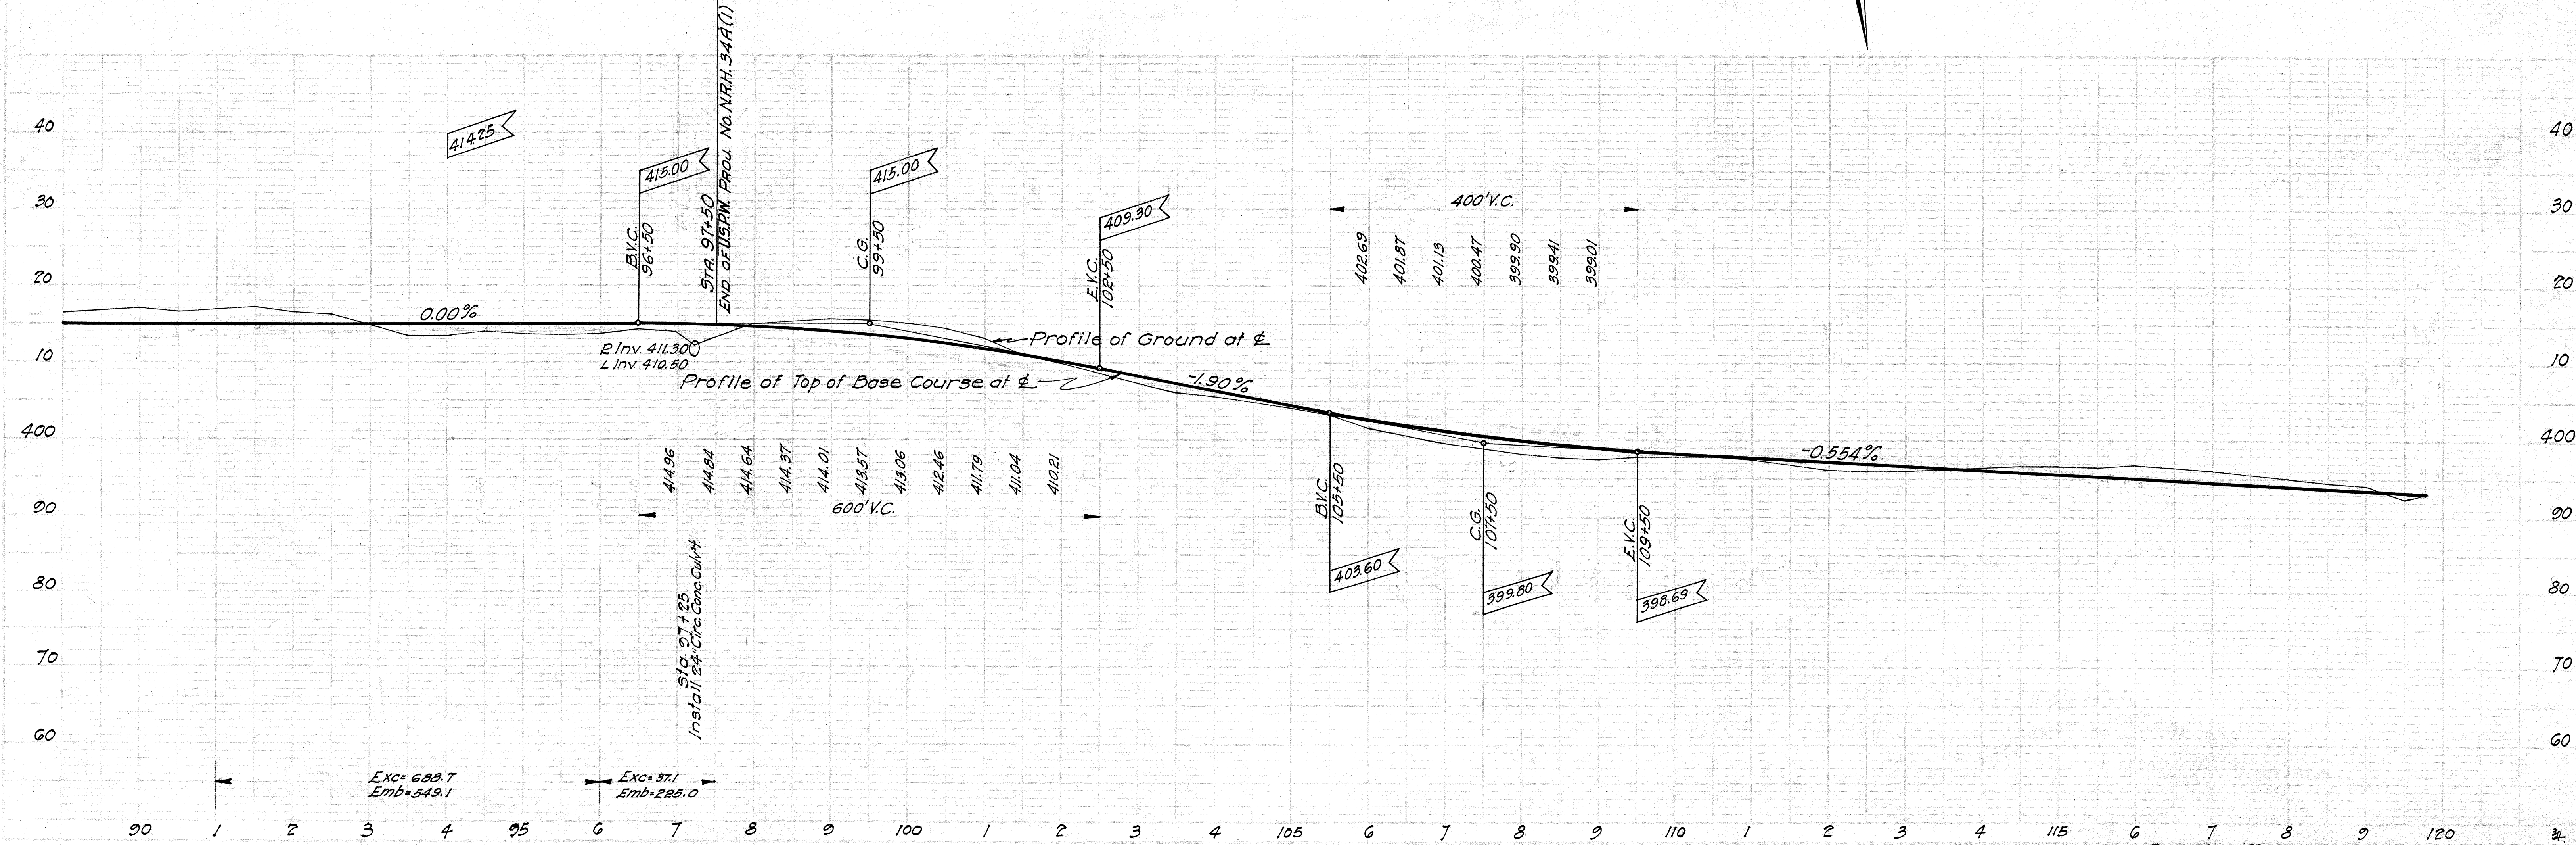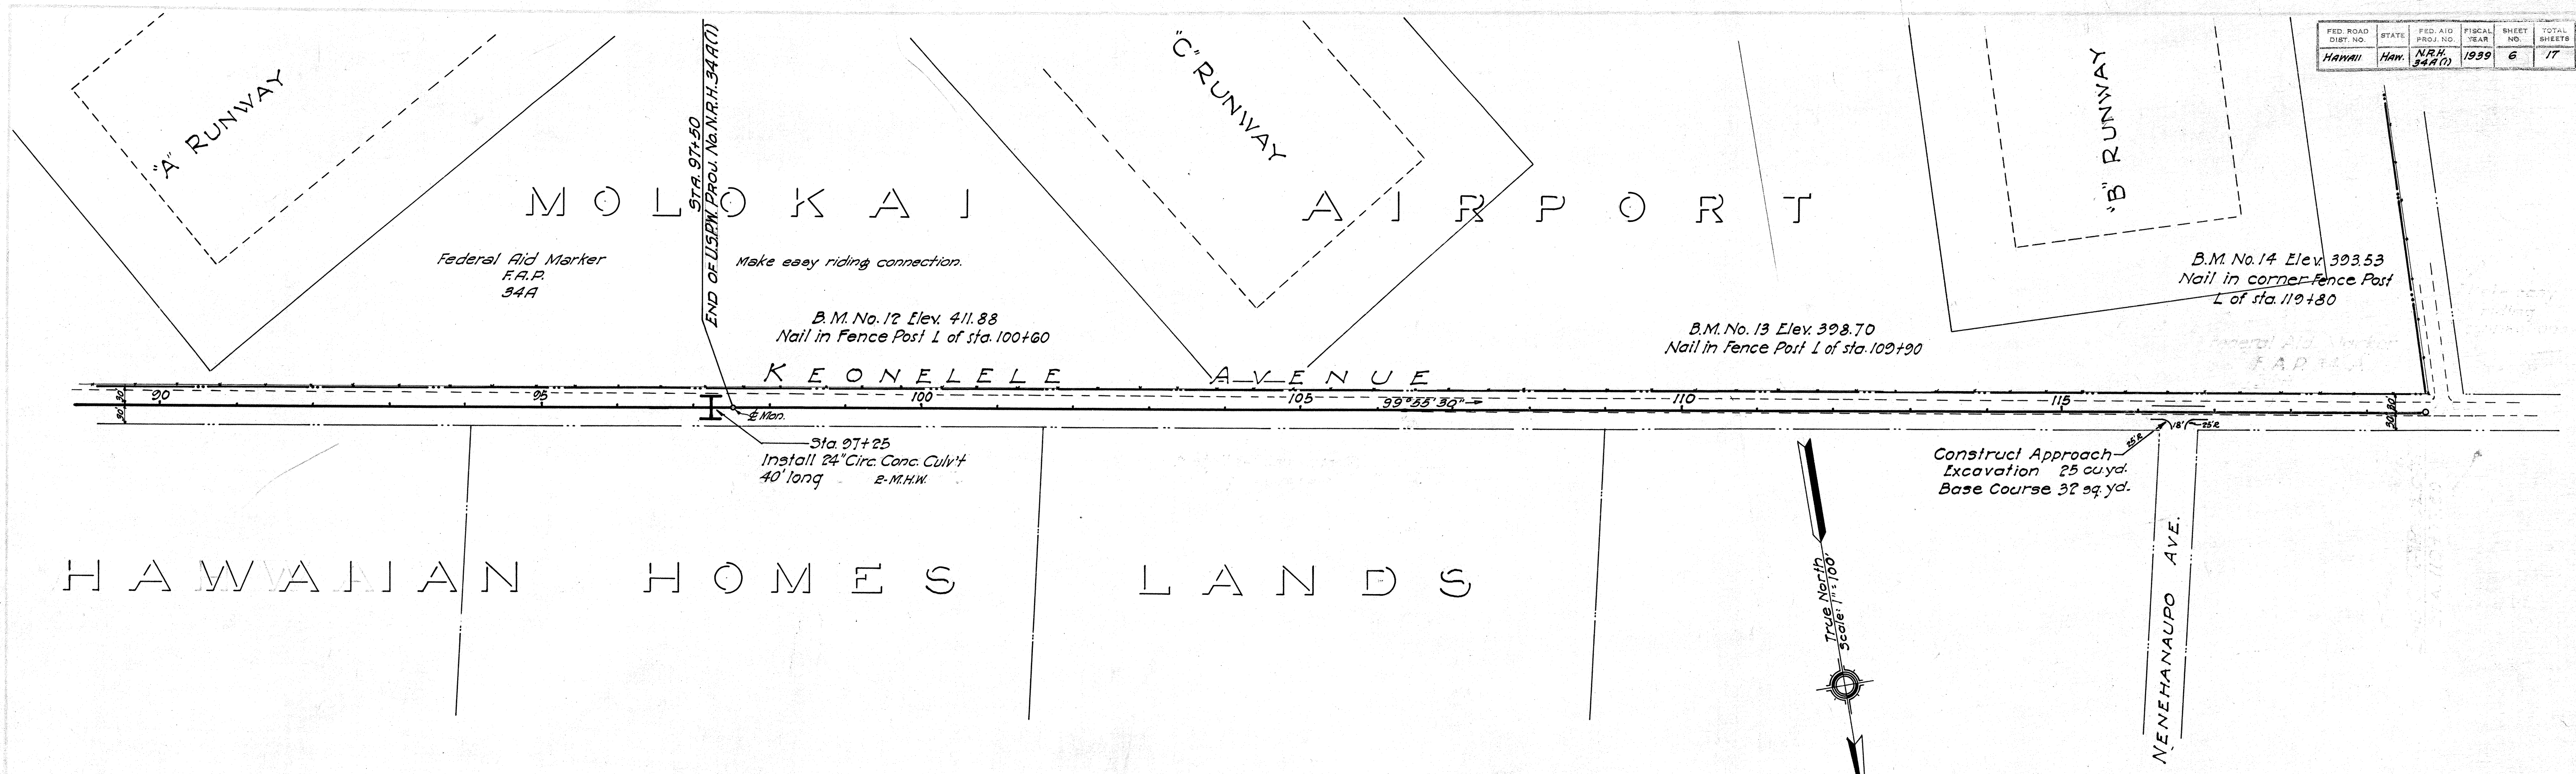

4489.6