
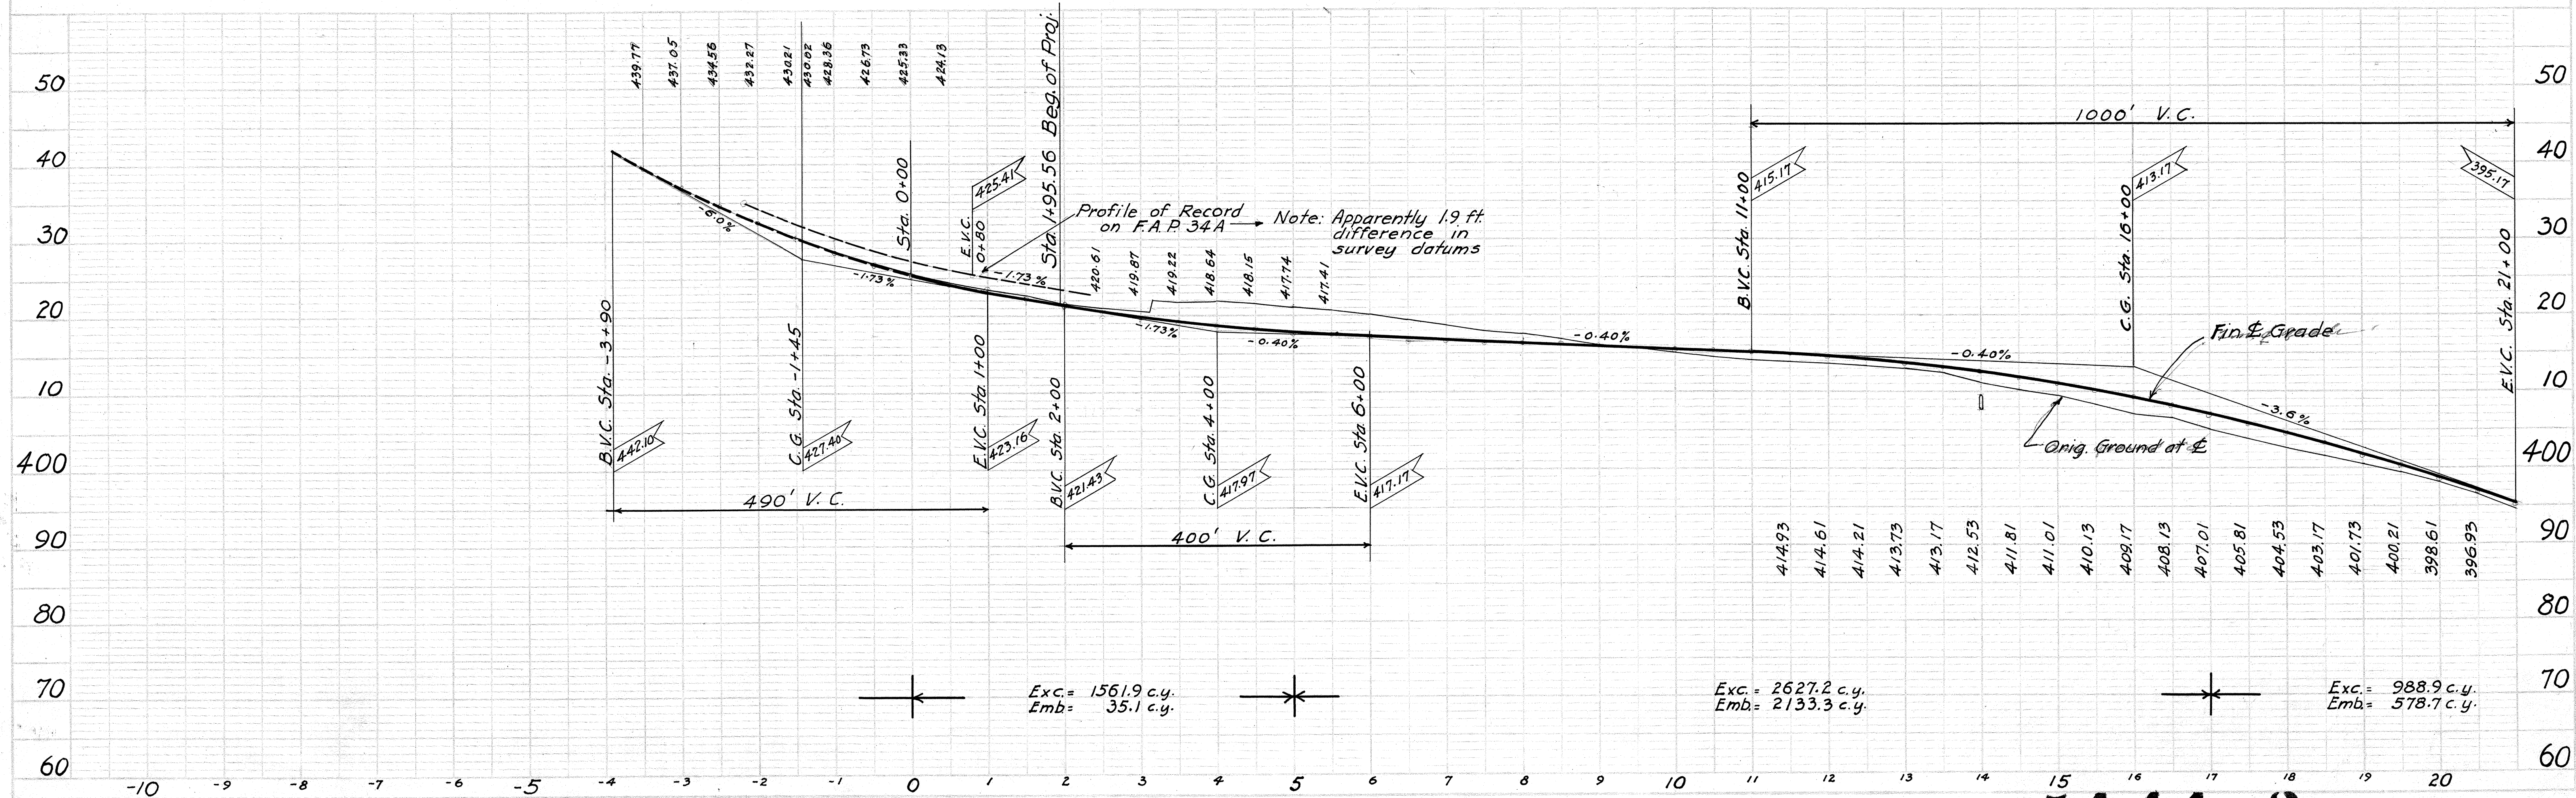


PLAN	DATE
DESIGNED BY	
CHECKED BY	
NOTED BY	
DATE	

PROFILE	DATE
DESIGNED BY	
CHECKED BY	
NOTED BY	
DATE	



FED. ROAD DIST. NO.	STATE	FED. AID PROJ. NO.	FISCAL YEAR	SHEET NO.	TOTAL SHEETS
Hawaii	Haw	DA-WC68	1944	3	16

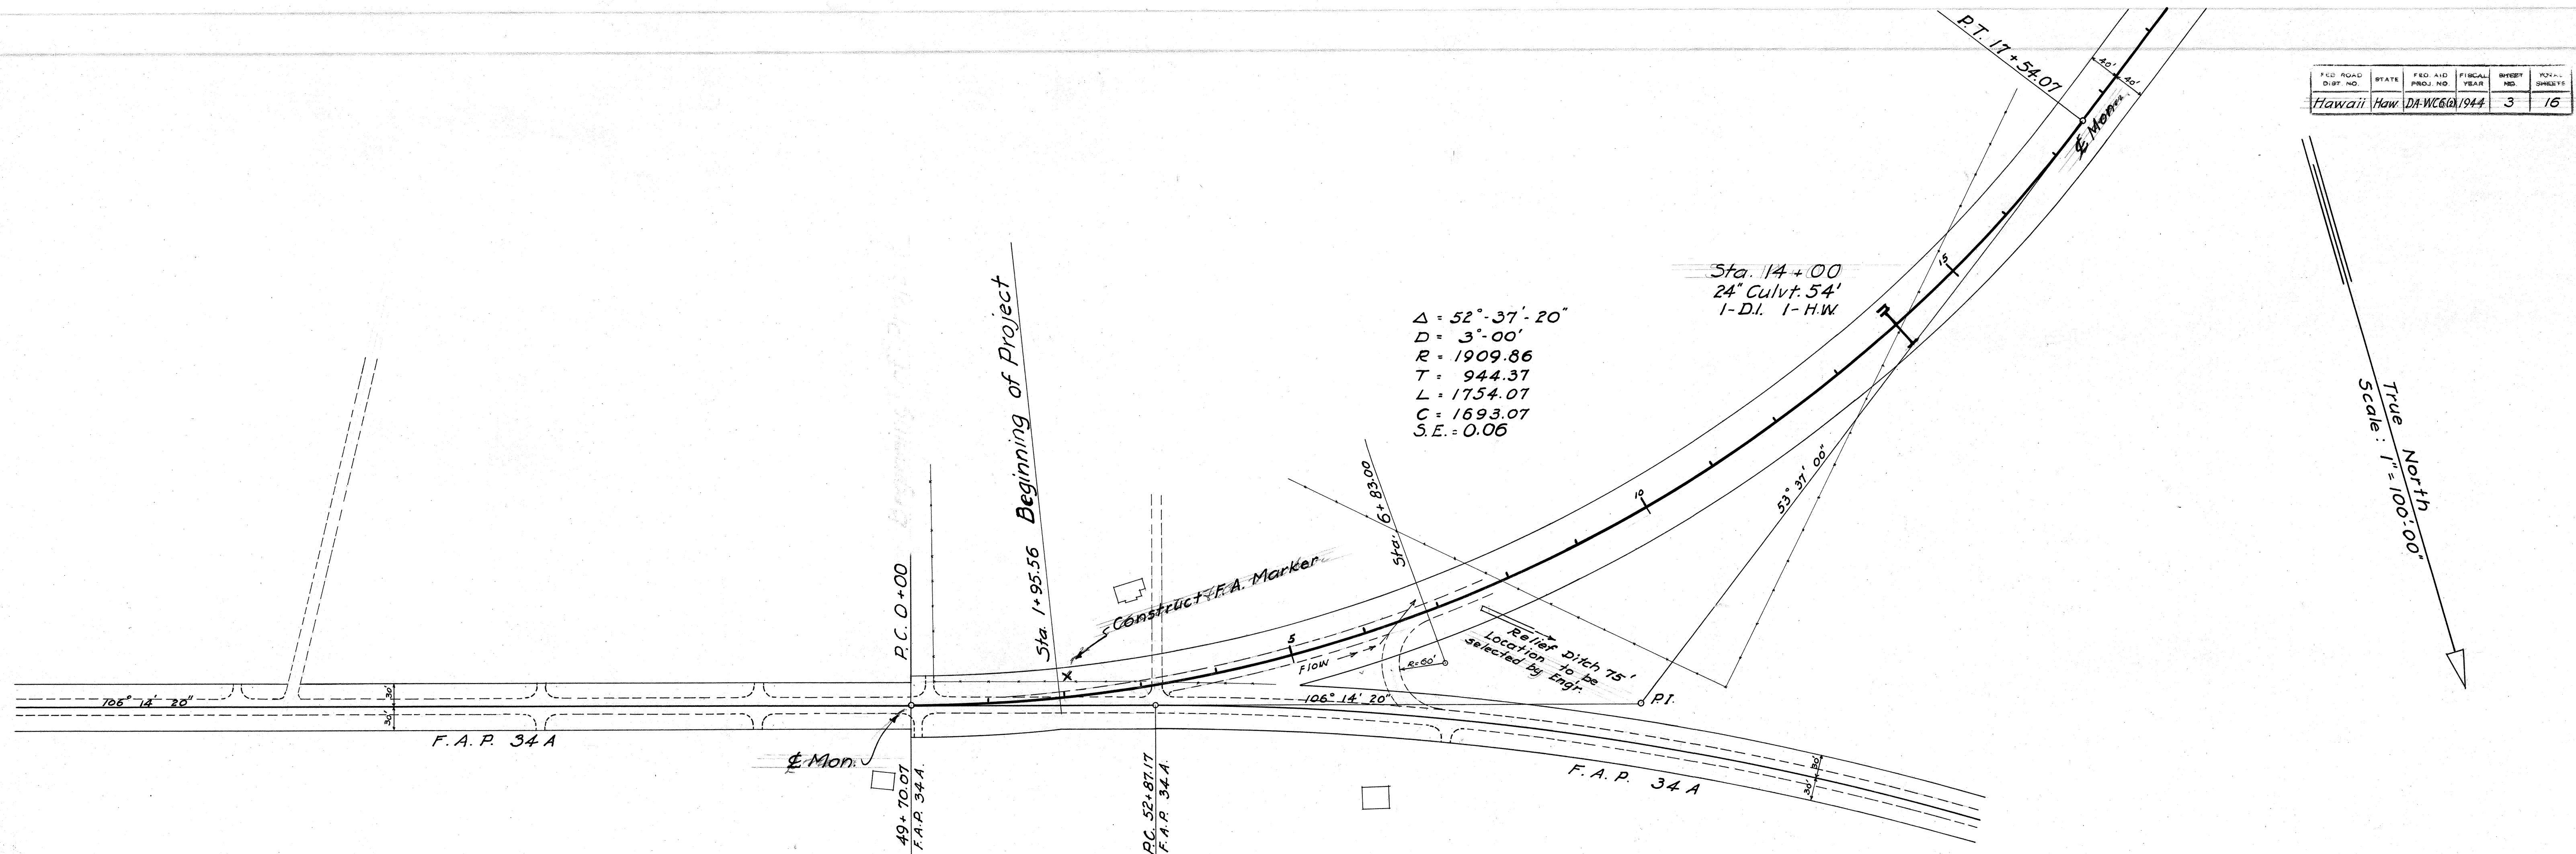

5141.3



PLAN
SURVEYED
PLOTTED
CHECKED
NOTE: 600' SCALE
BY: [Signature]
DATE: [Blank]

PROFILE
SURVEYED
PLOTTED
CHECKED
NOTE: 10' VERT. SCALE
BY: [Signature]
DATE: [Blank]

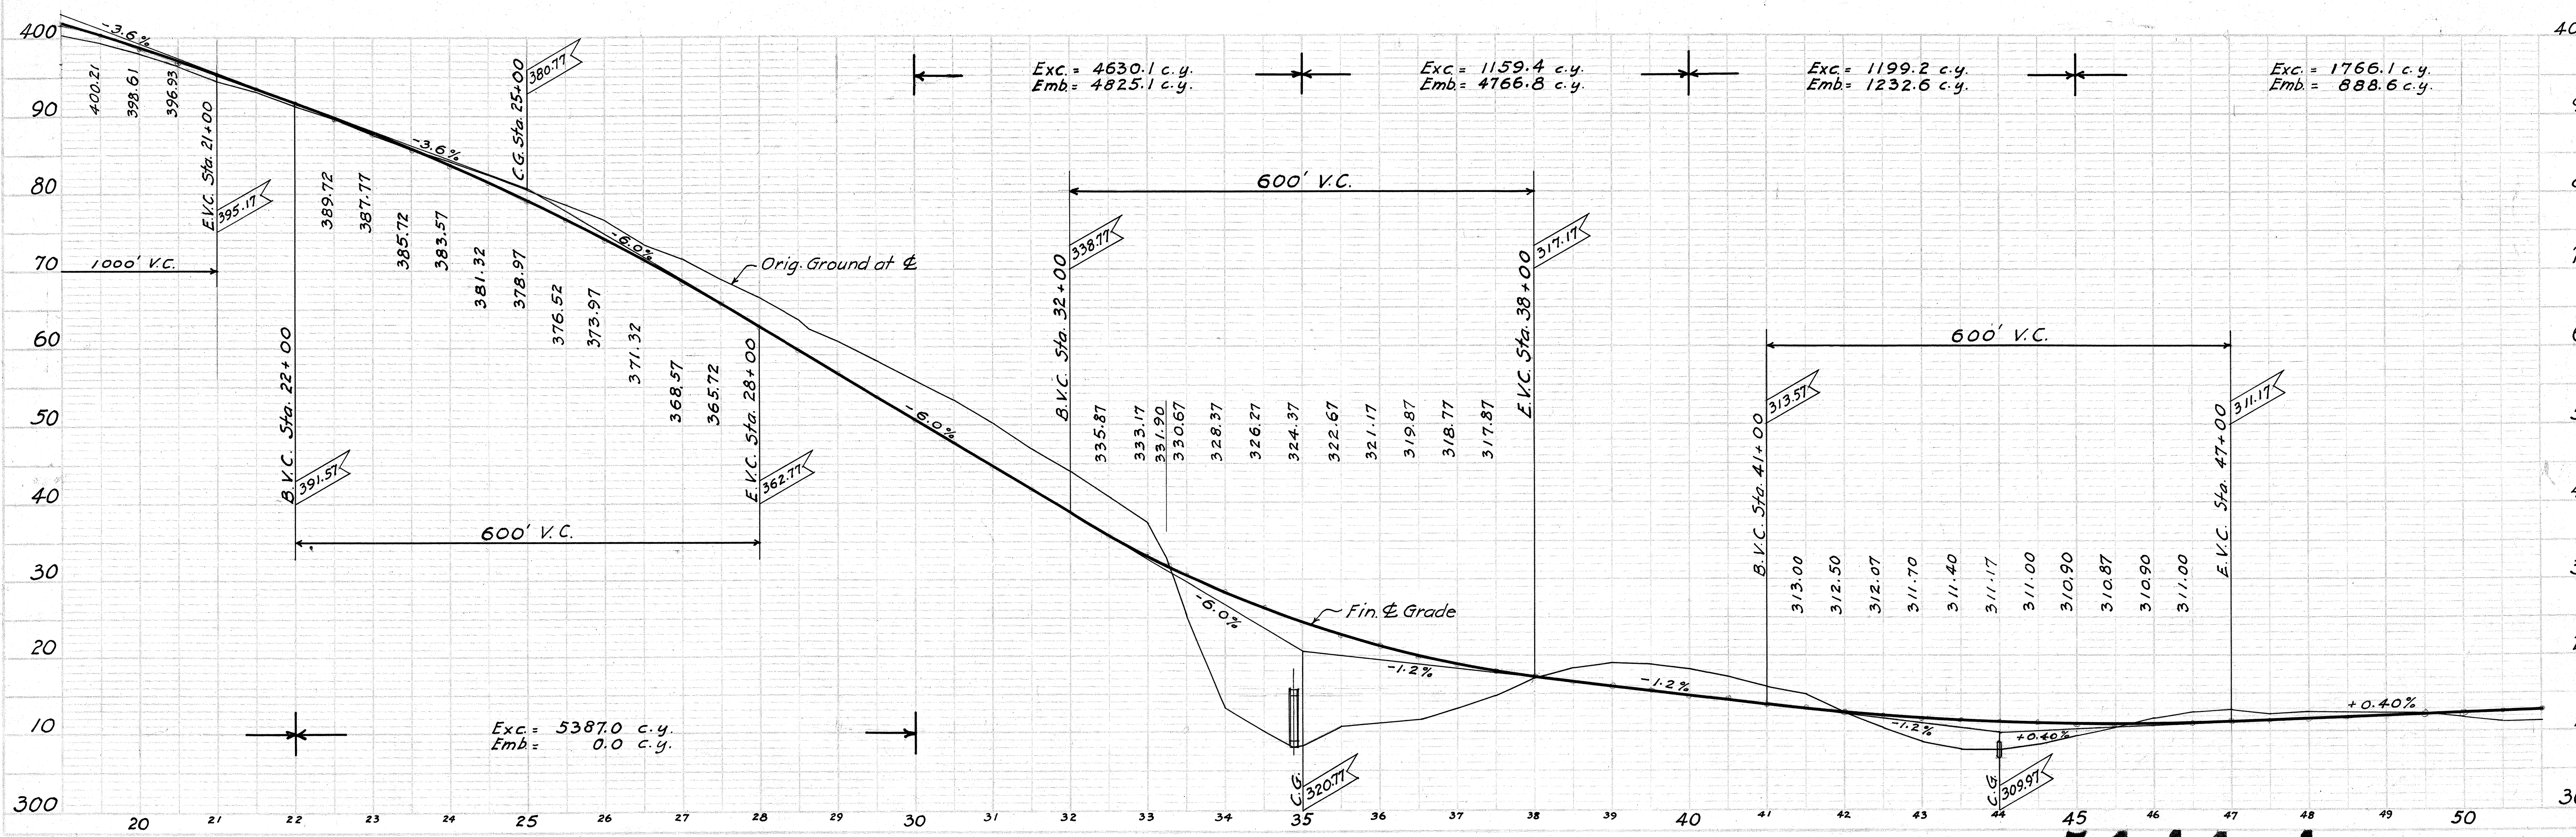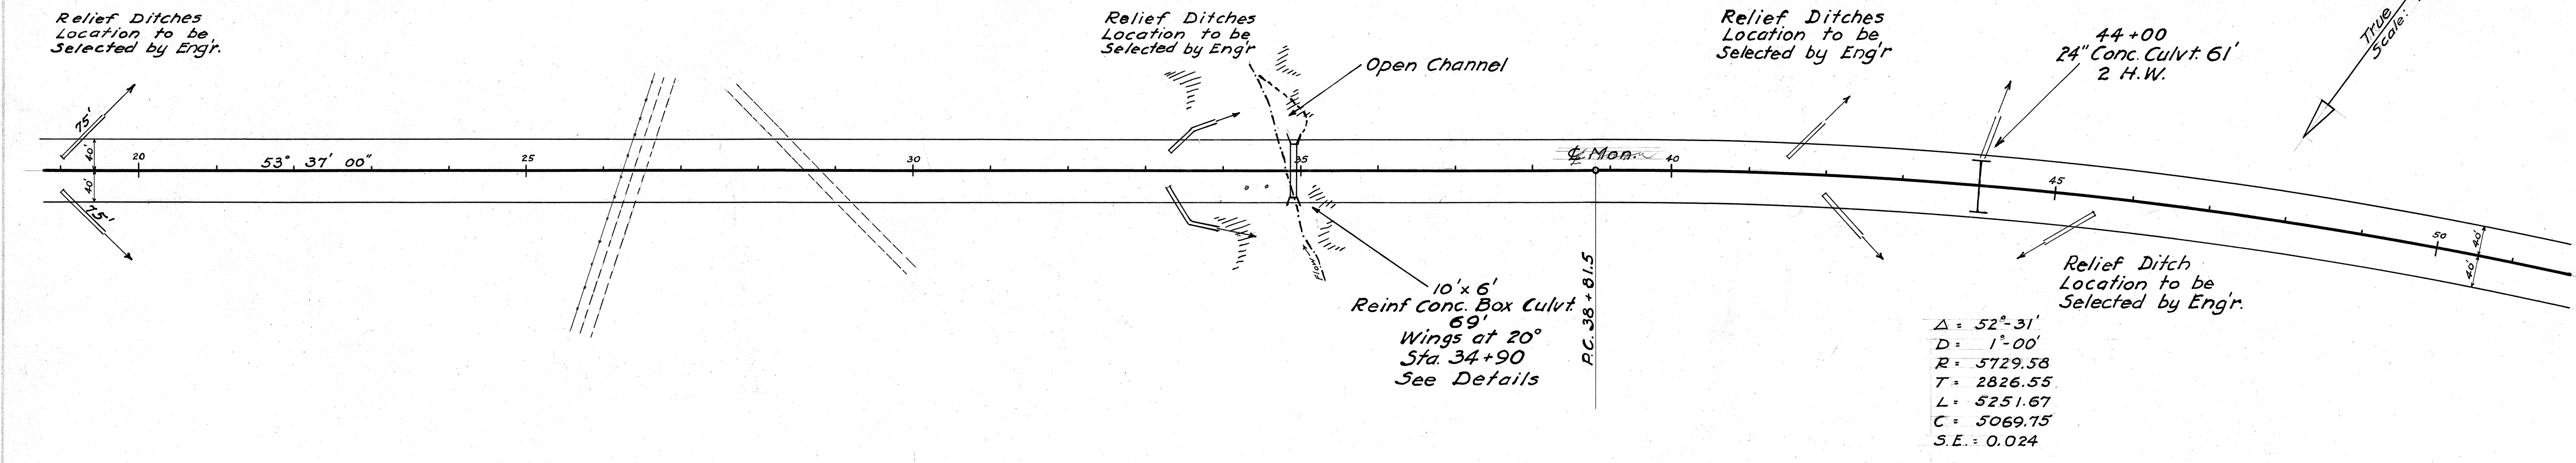


5141.4

PLAN	SURVEYED	BY	DATE
NOTE BOOK	PLOTTED		
NO.	ALIGNMENT CHECKED		
	RT. OF WAY CHECKED		

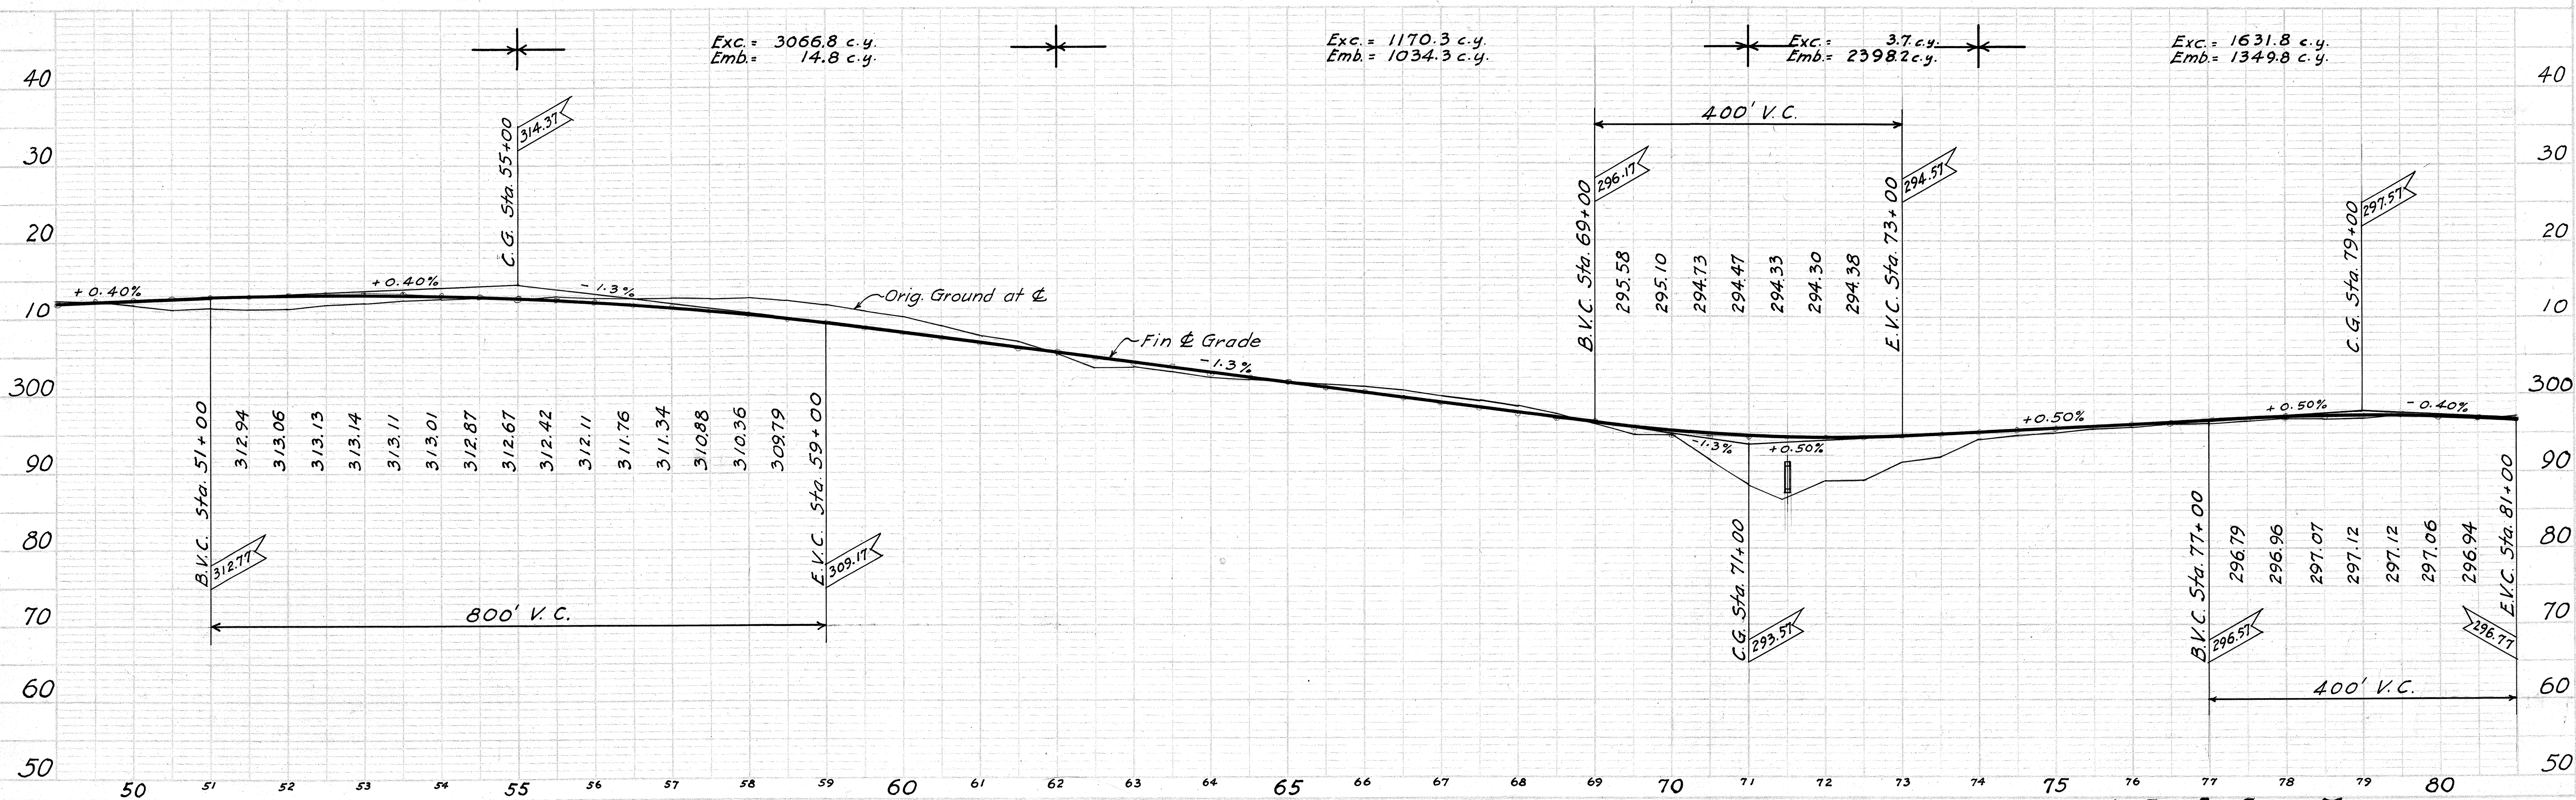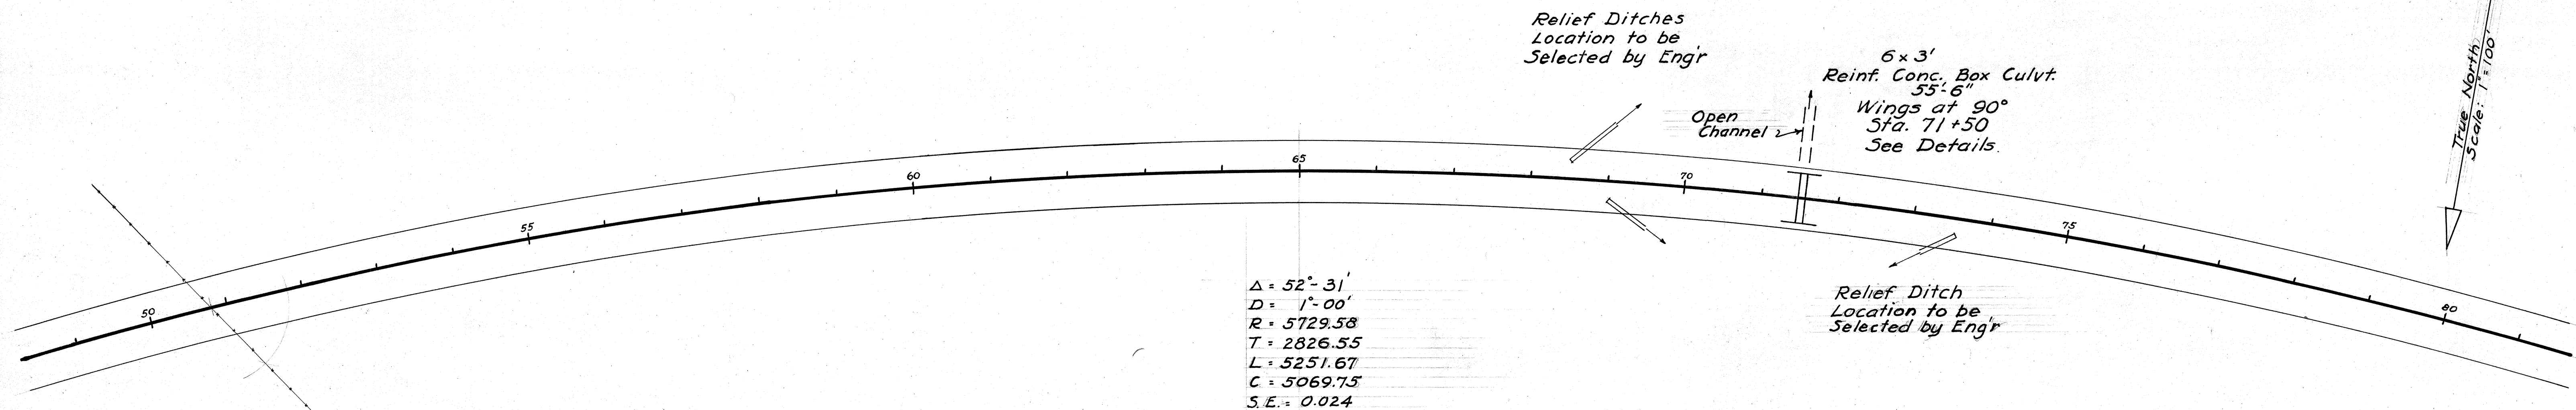

FED. ROAD DIST. NO.	STATE	FED. AID PROJ. NO.	FISCAL YEAR	SHEET NO.	TOTAL SHEETS
Hawaii	Haw.	DAW658	1944	6	16

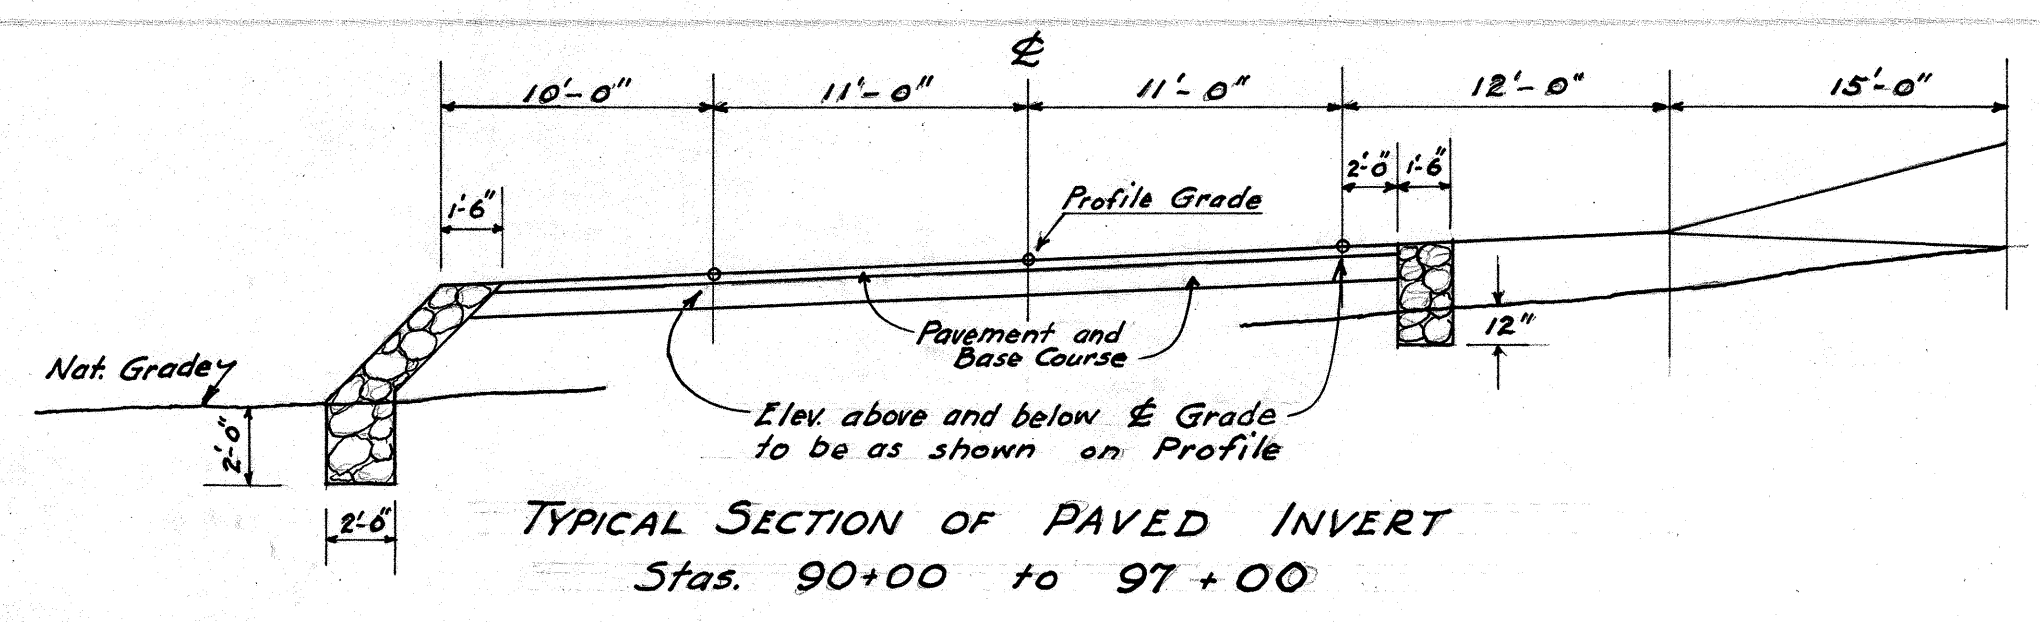

$\Delta = 52^\circ - 31'$
 $D = 1^\circ - 00'$
 $R = 5729.58$
 $T = 2826.55$
 $L = 5251.67$
 $C = 5069.75$
 $S.E. = 0.024$


P.T. 91+33.17

Relief Ditches
Location to be
Selected by Engr


Construct F.A. Marker

Sta. 110+48.28 P.O.T.
Sta. 111+00
End of Project

True North
Scale: 1"=100'

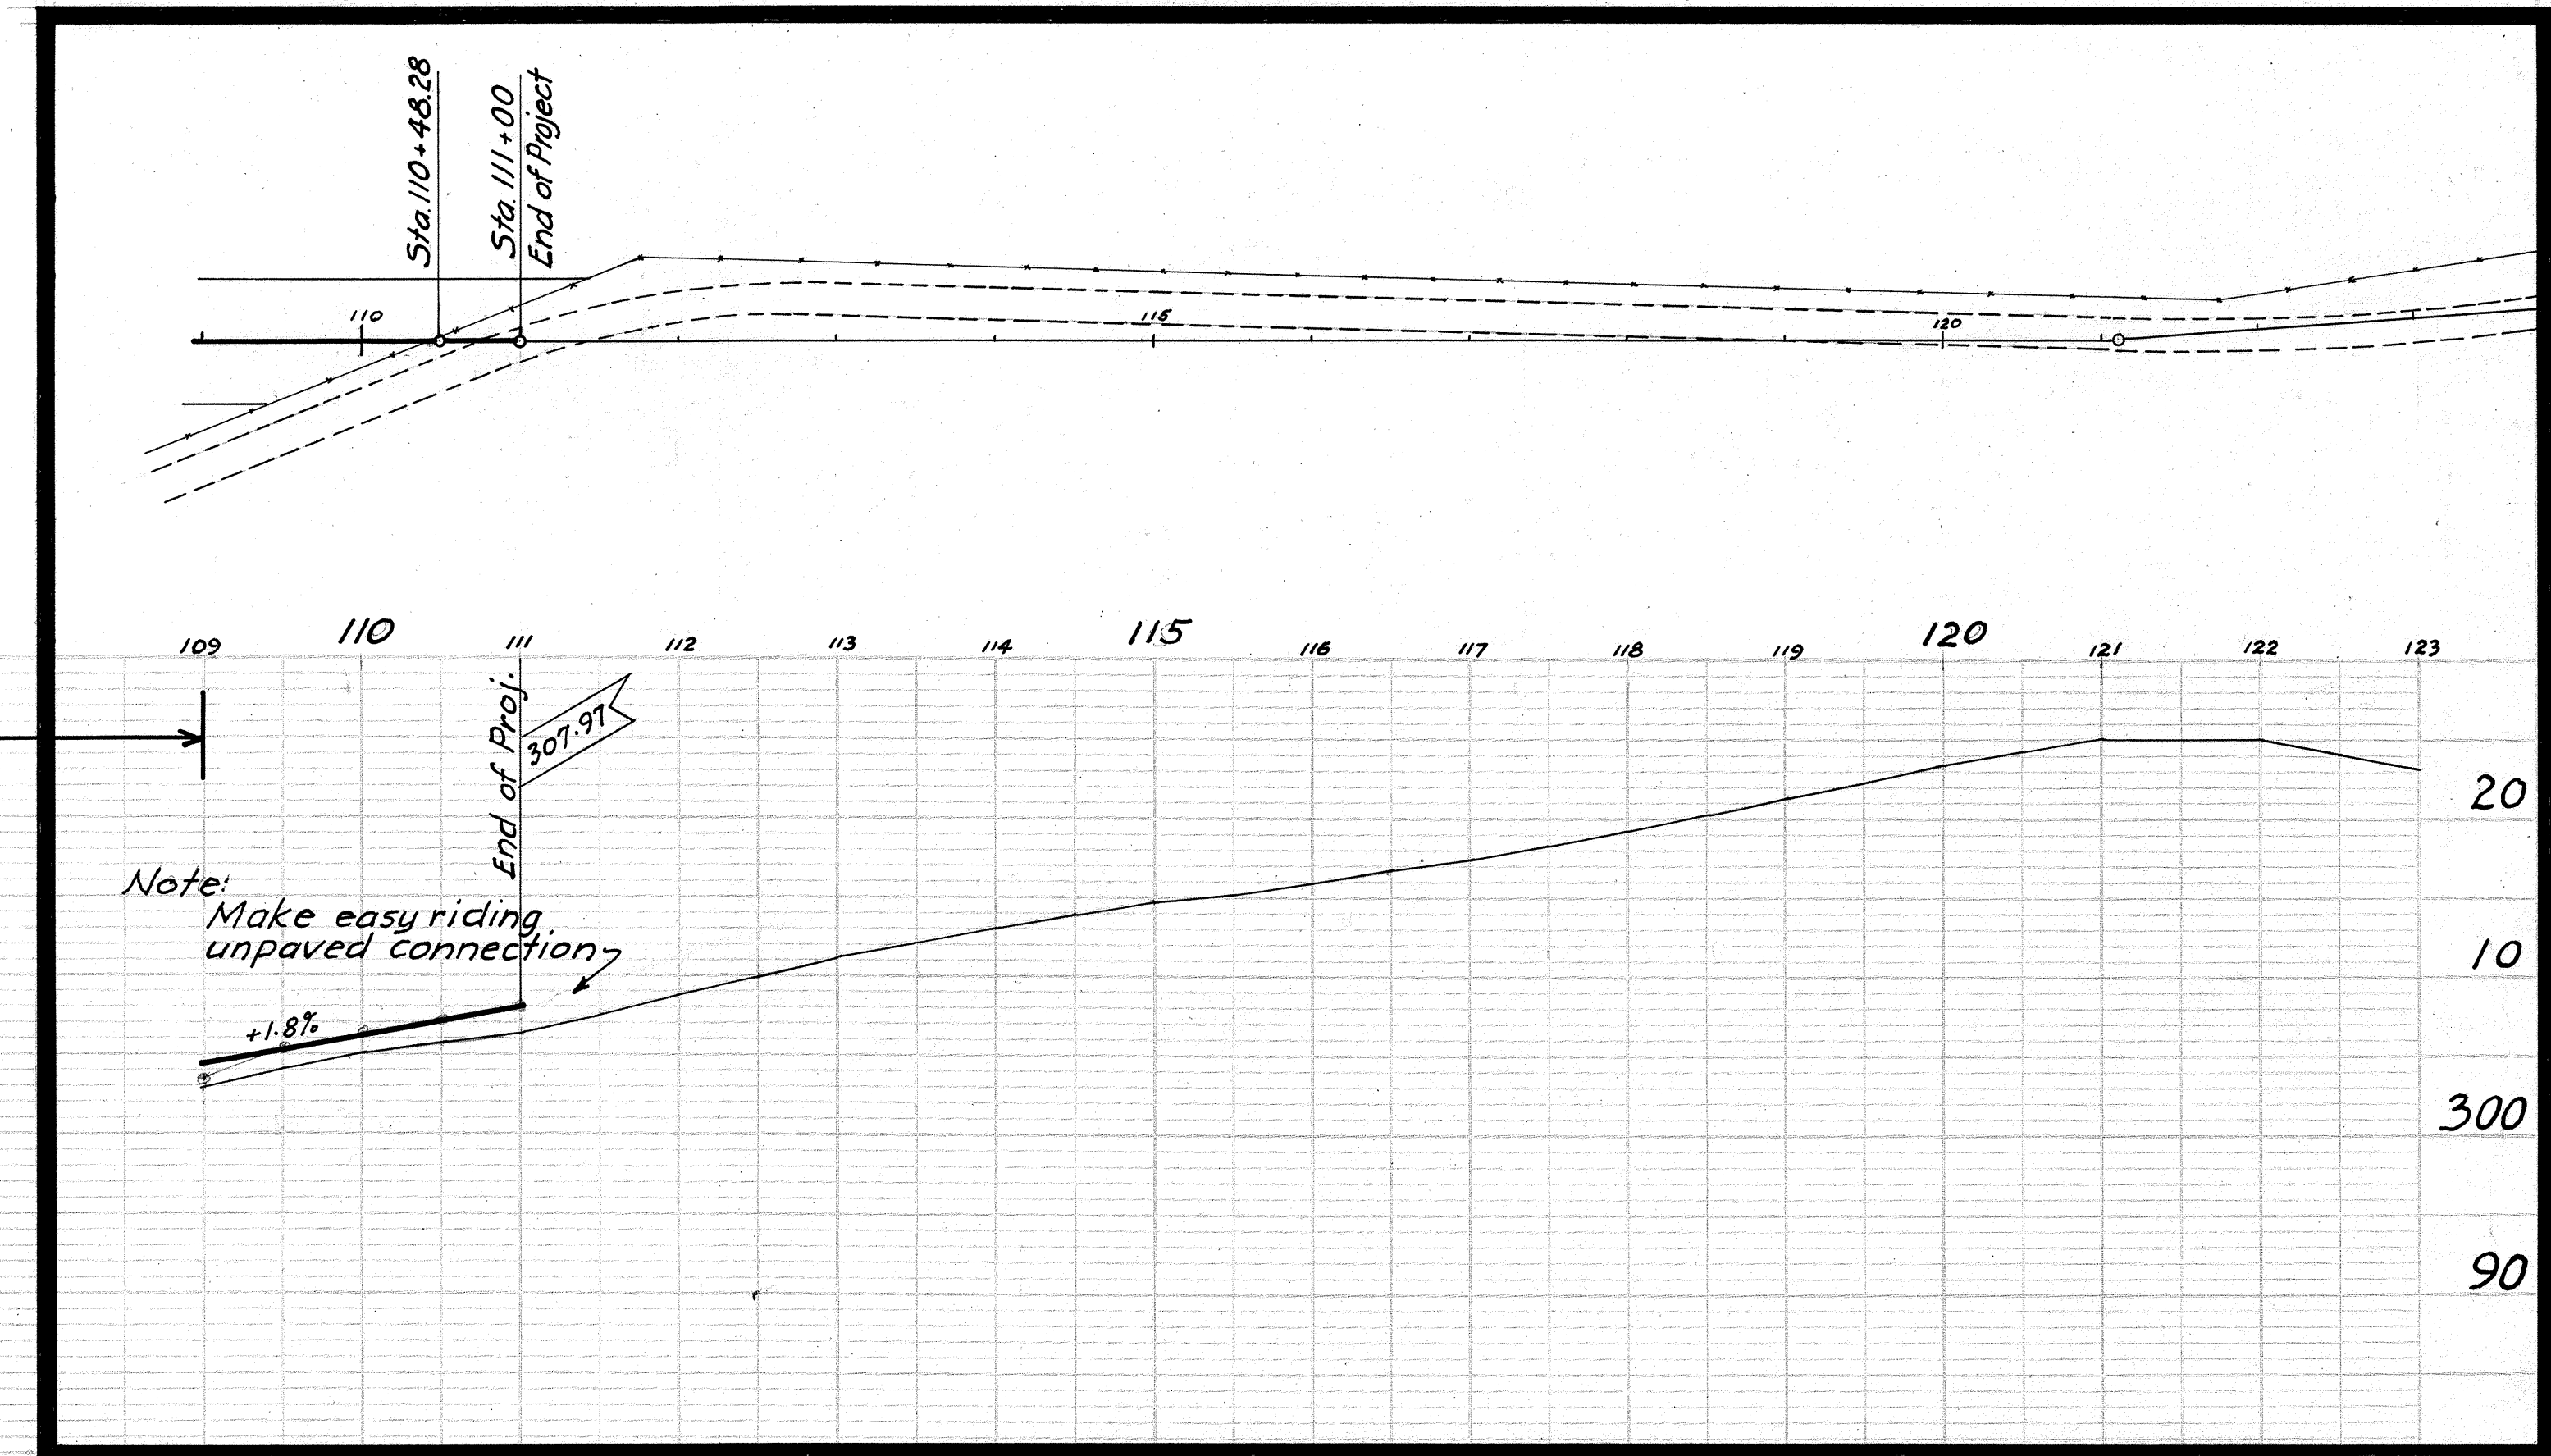

Exc. = 180.8 c.y.
Emb. = 2456.7 c.y.

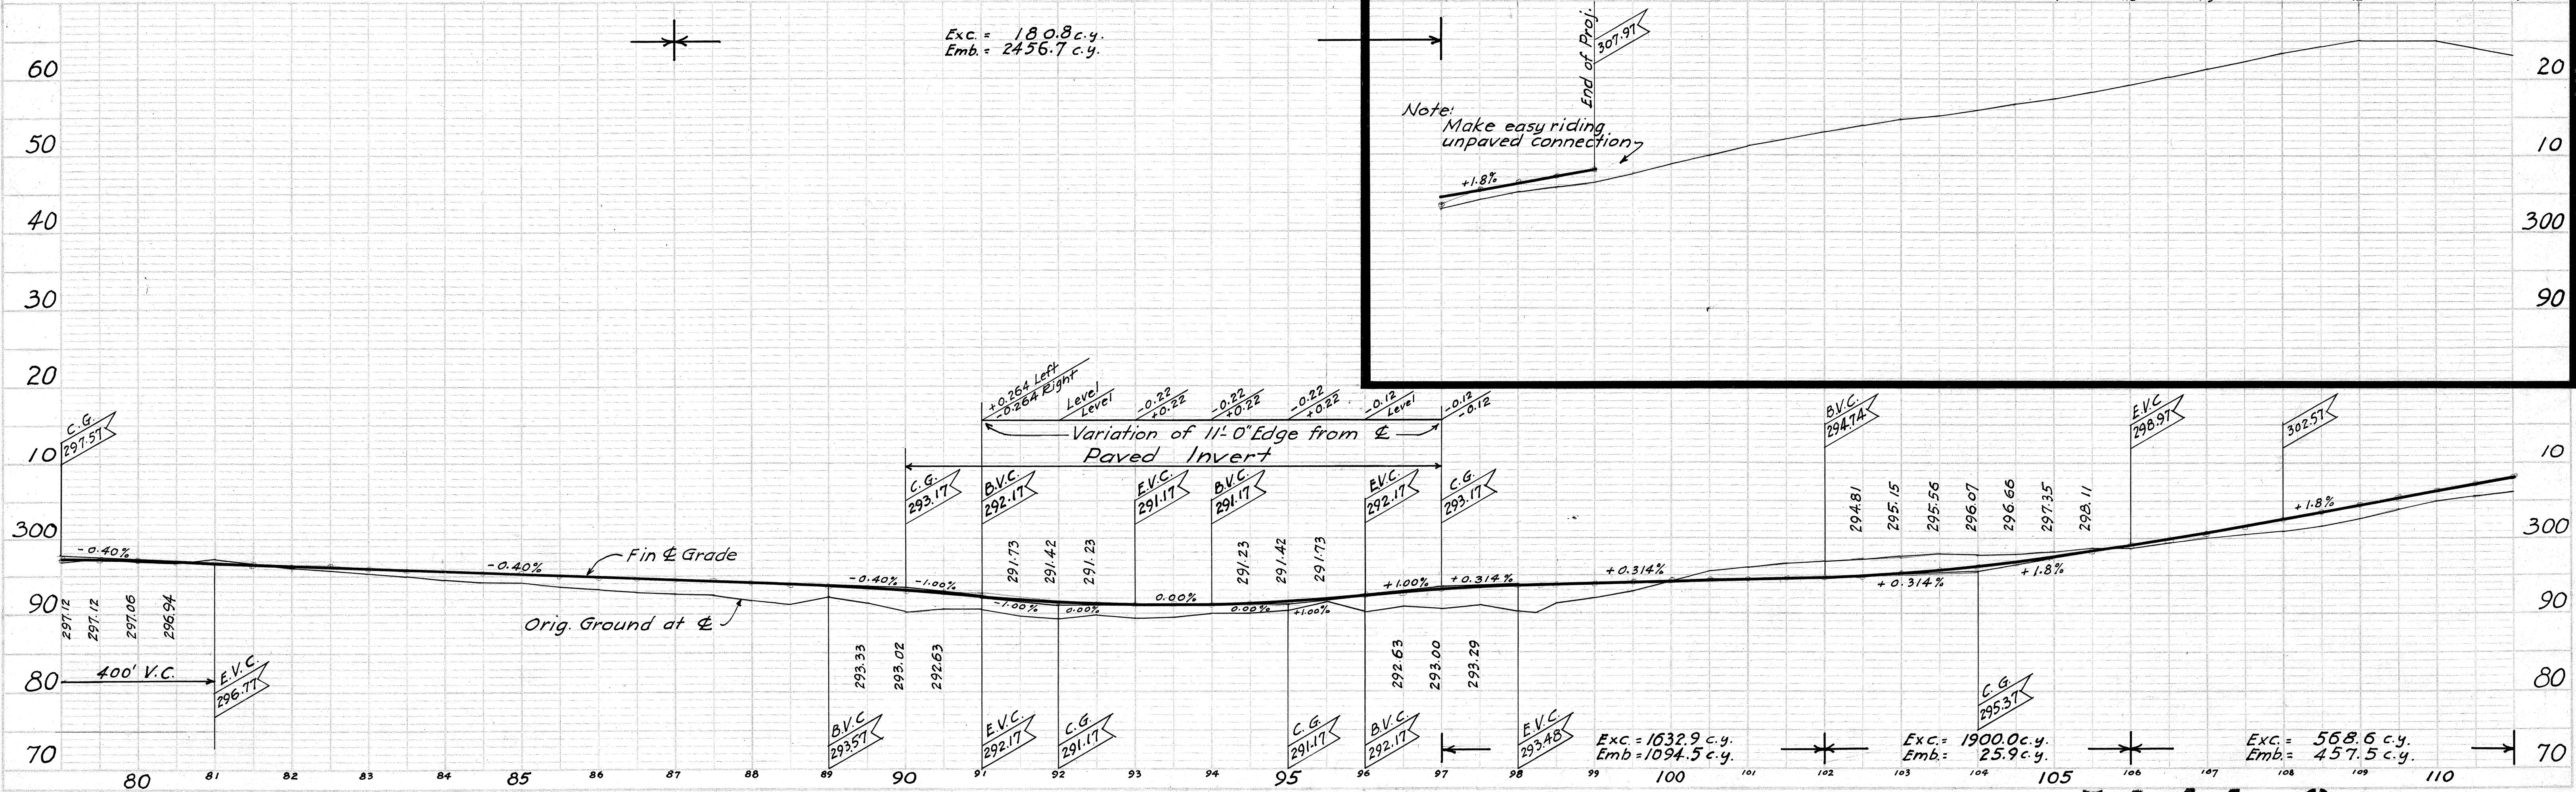

5141.6