
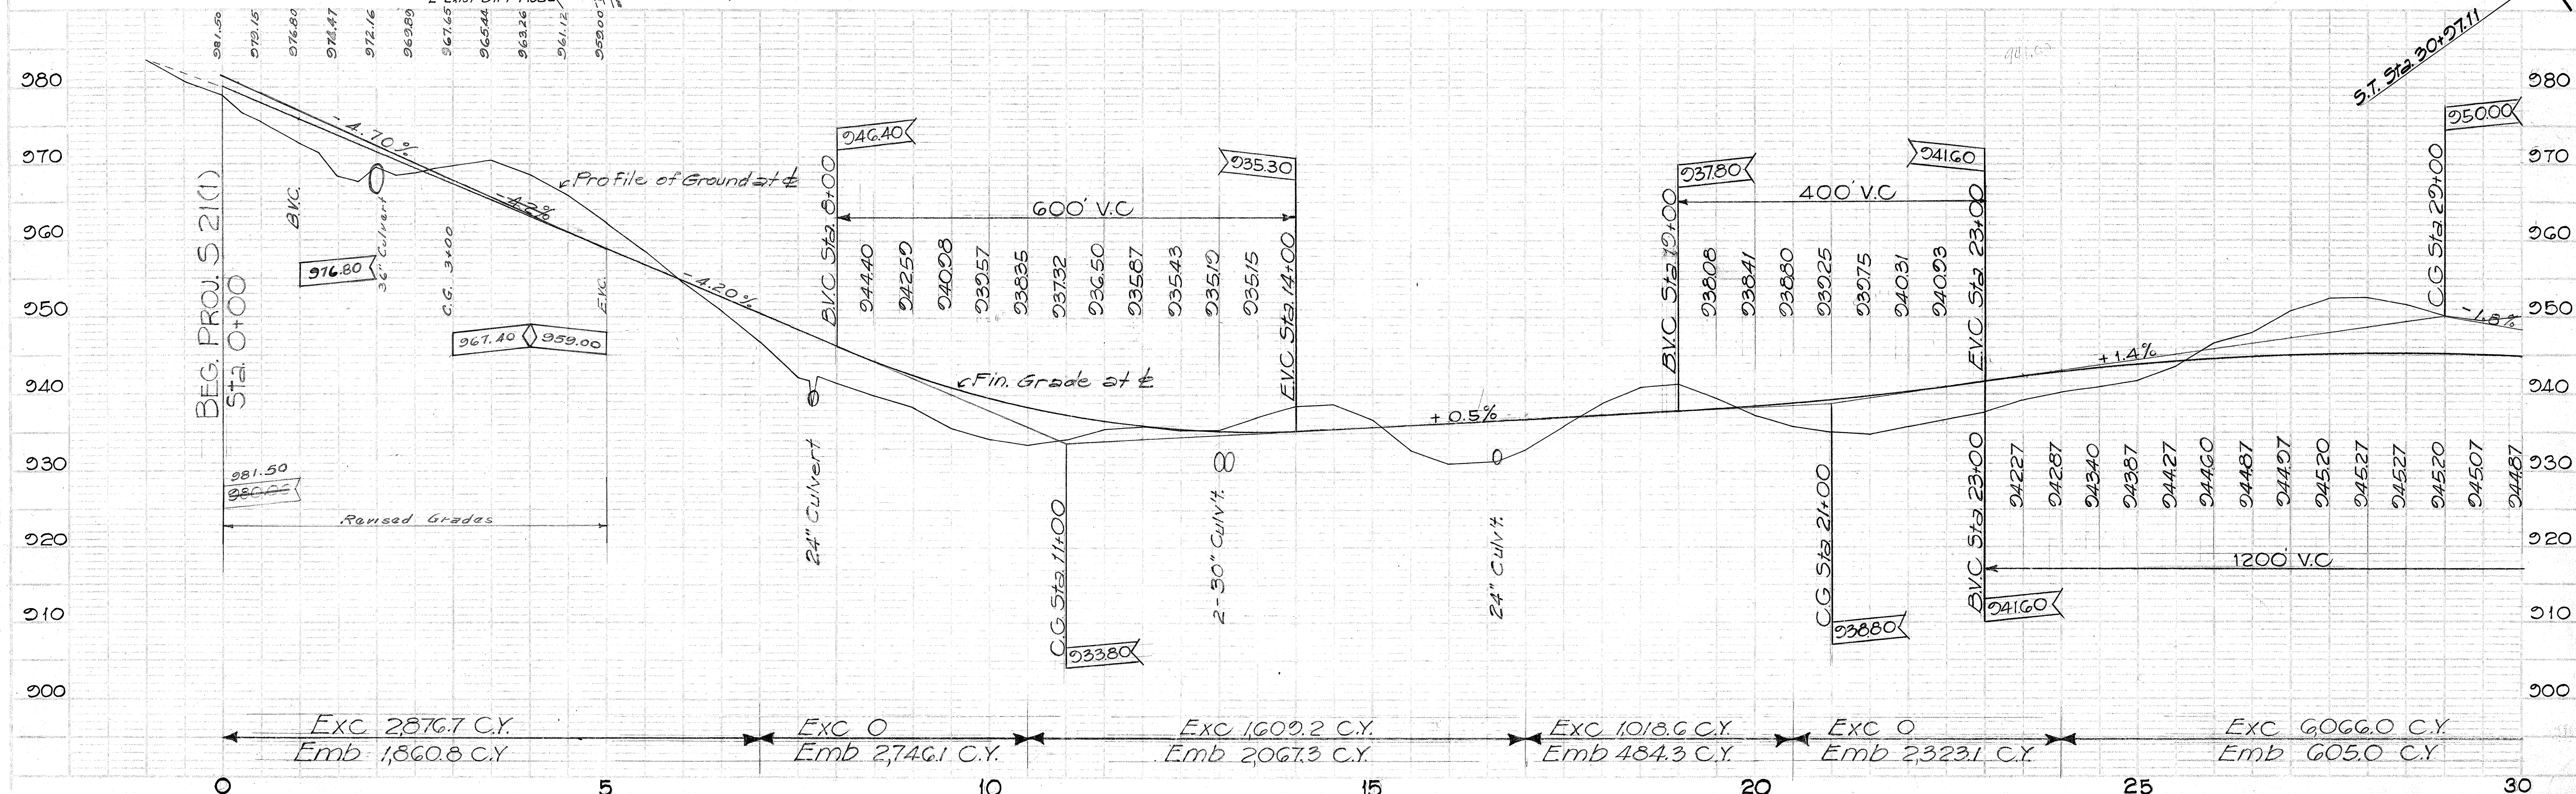




FED. ROAD DIST. NO.	STATE	FED. AID PROJ. NO.	FISCAL YEAR	SHEET NO.	TOTAL SHEETS
HAWAII	HAW	521(1)	1947	3	76

Corrections noted 1-24-50

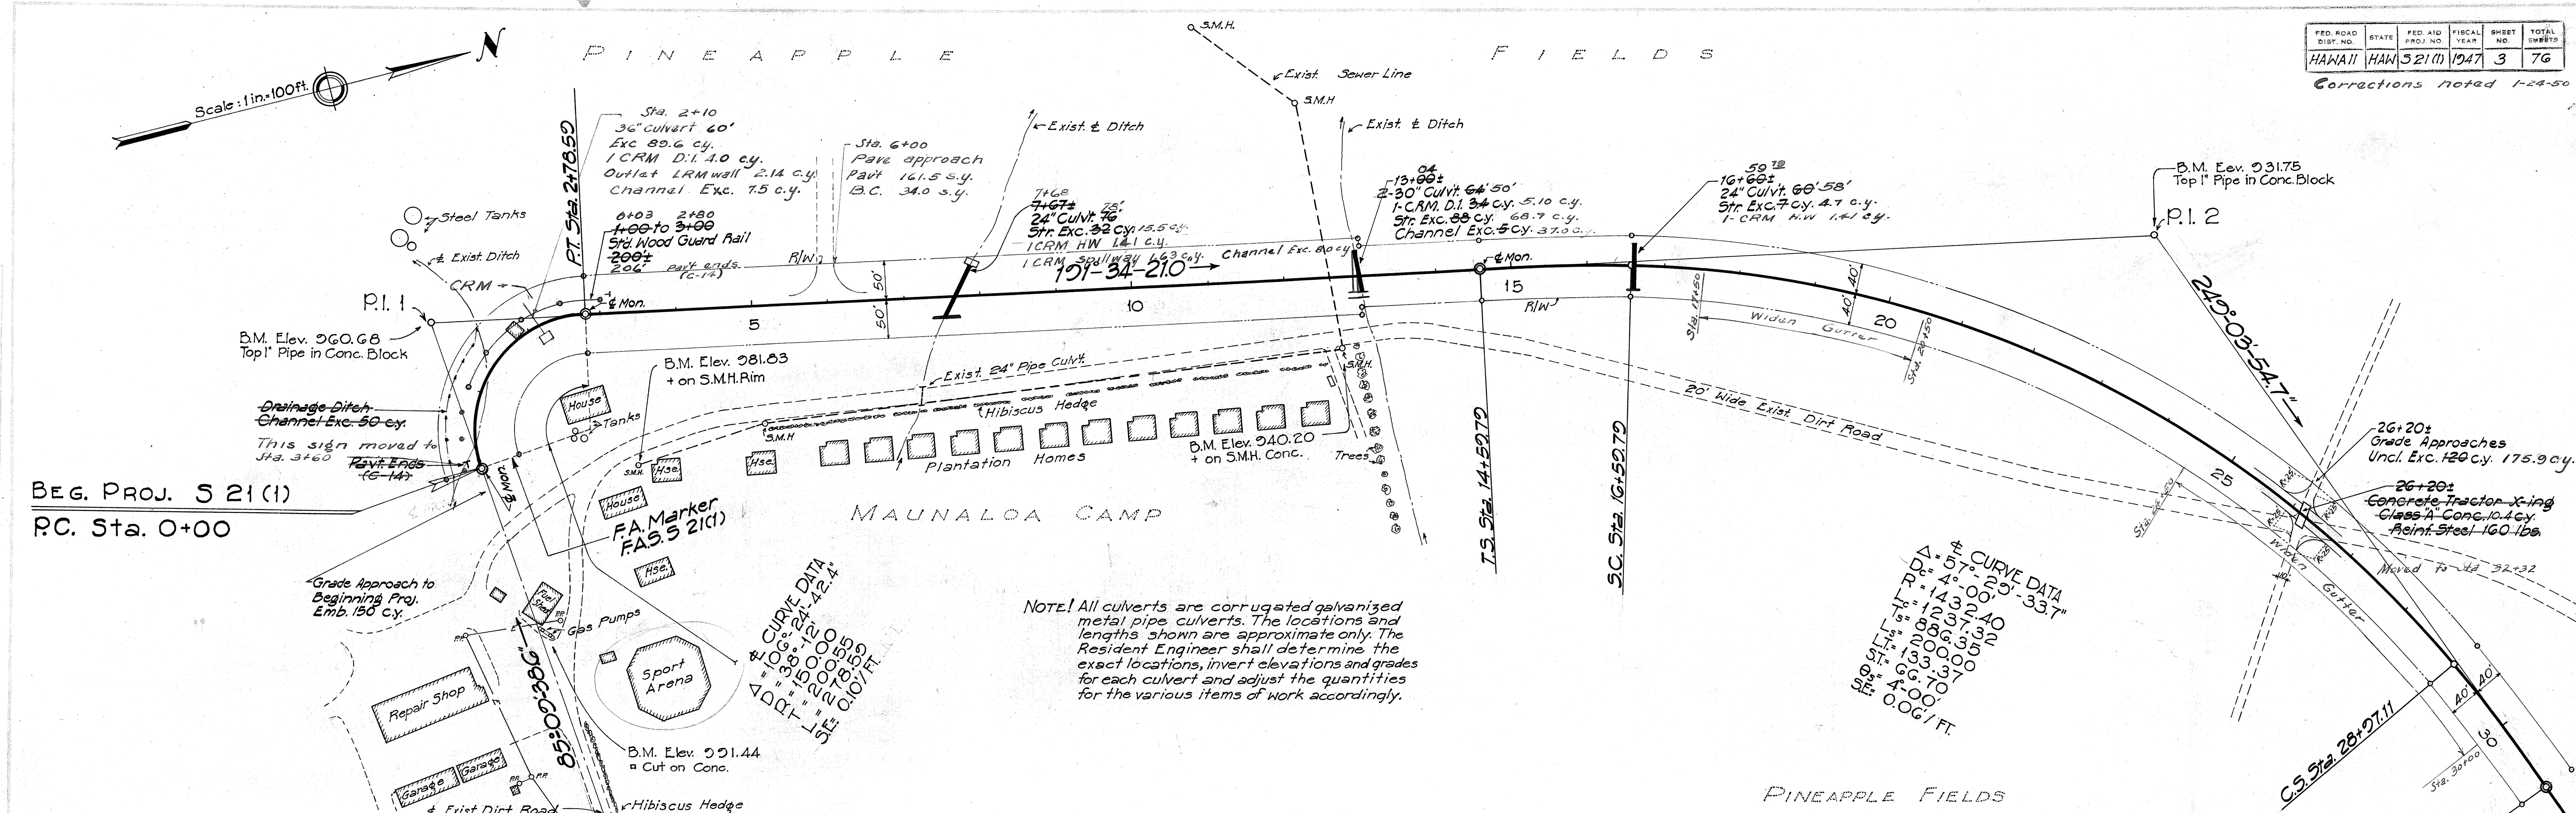

FED. ROAD DIST. NO.	STATE	FED. AID PROJ. NO.	FISCAL YEAR	SHEET NO.	TOTAL SHEETS
HAWAII	HAW	521(1)	1947	4	76

Corrections noted 1-25-50

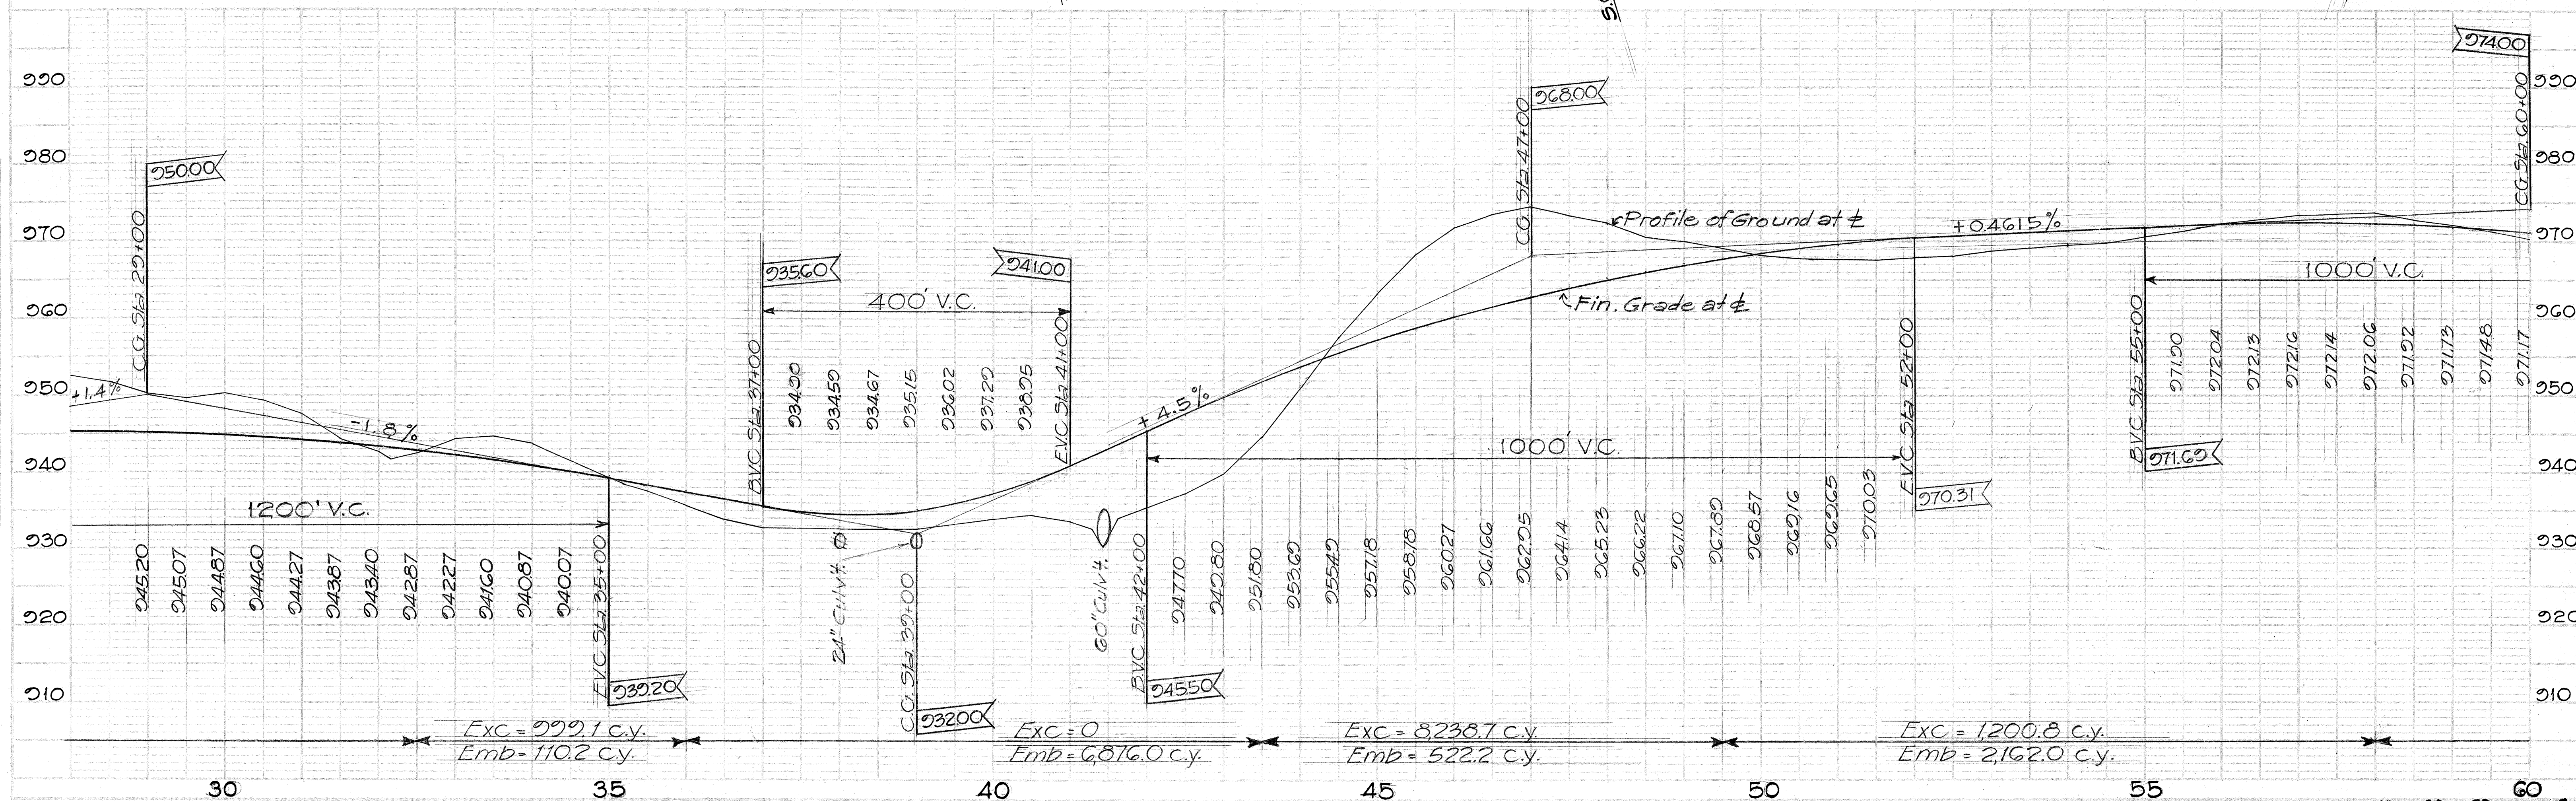
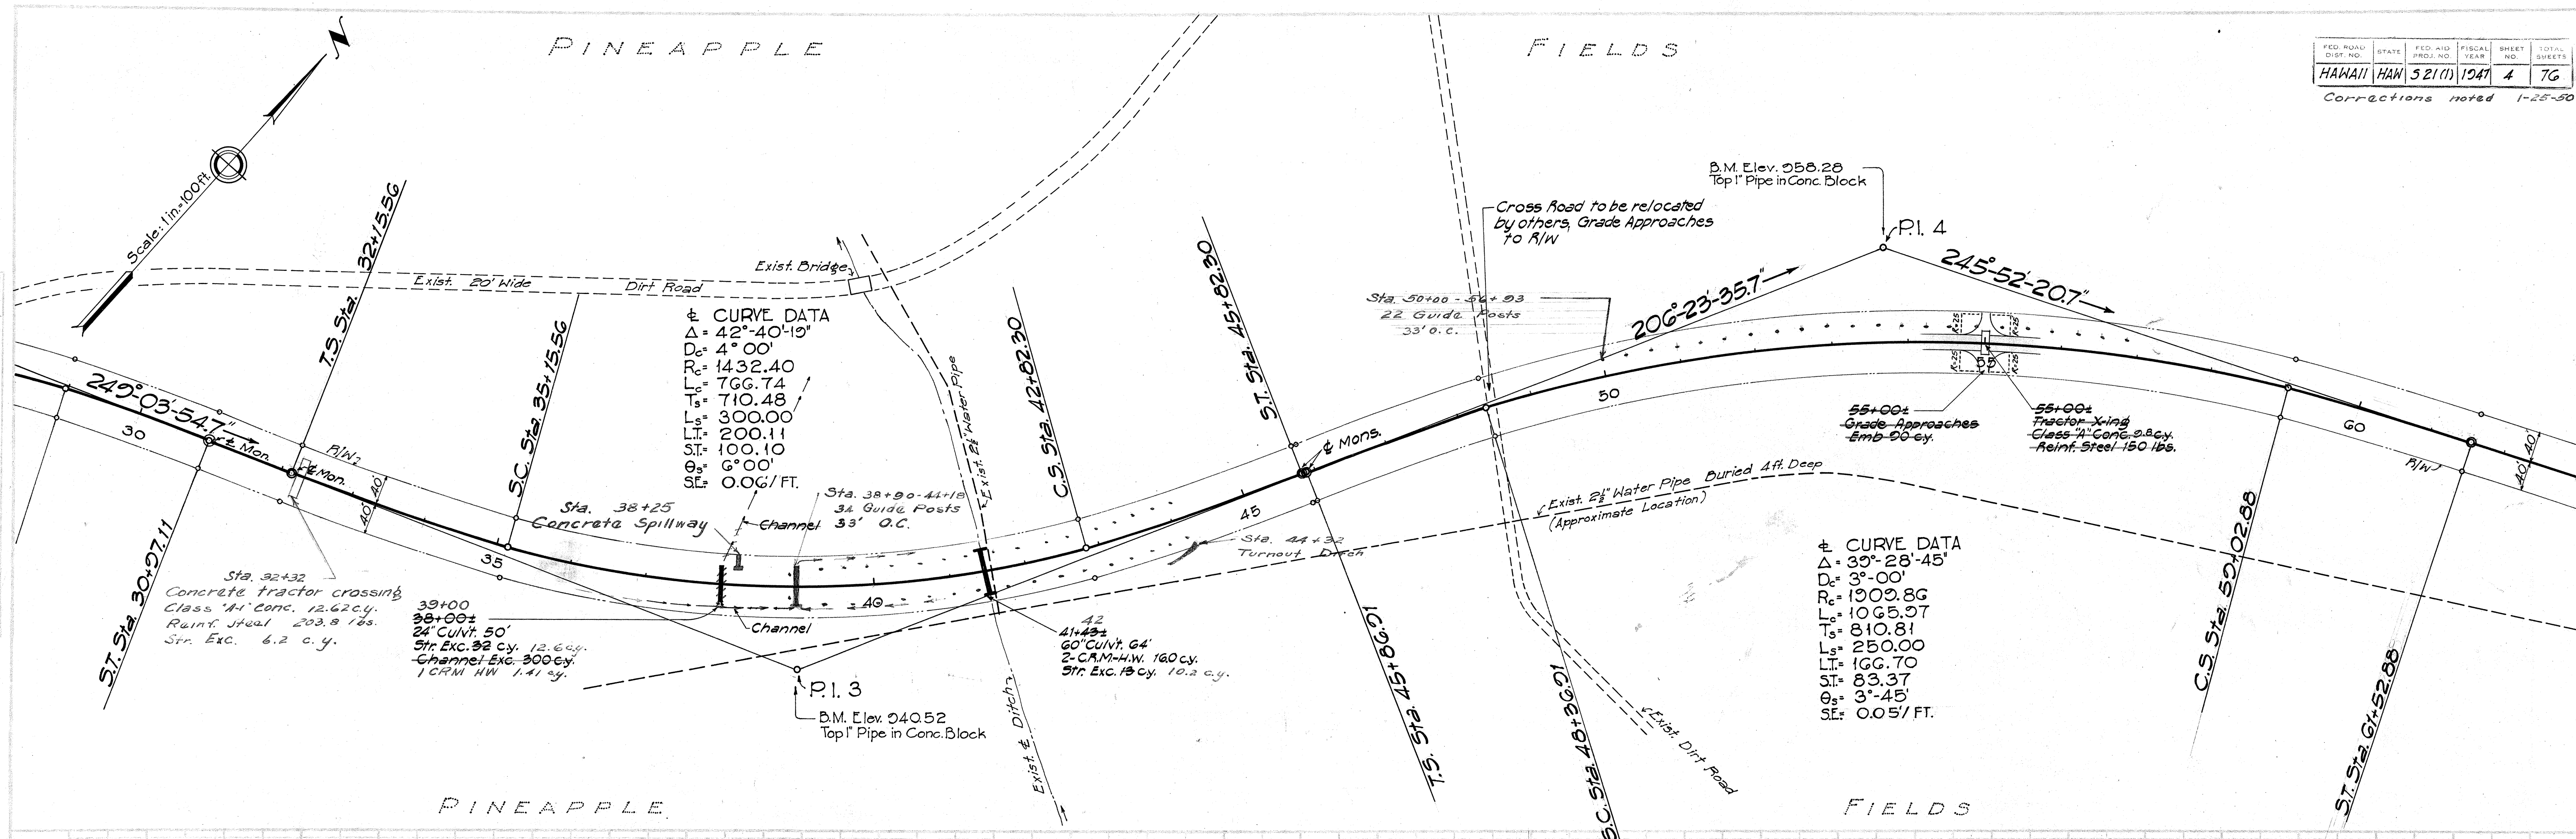


PINEAPPLE

FIELDS

FED. ROAD DIST. NO.	STATE	FED. AID PROJ. NO.	FISCAL YEAR	SHEET NO.	TOTAL SHEETS
HAWAII	HAW	521(1)	1947	5	76



Corrections noted 1-26-50

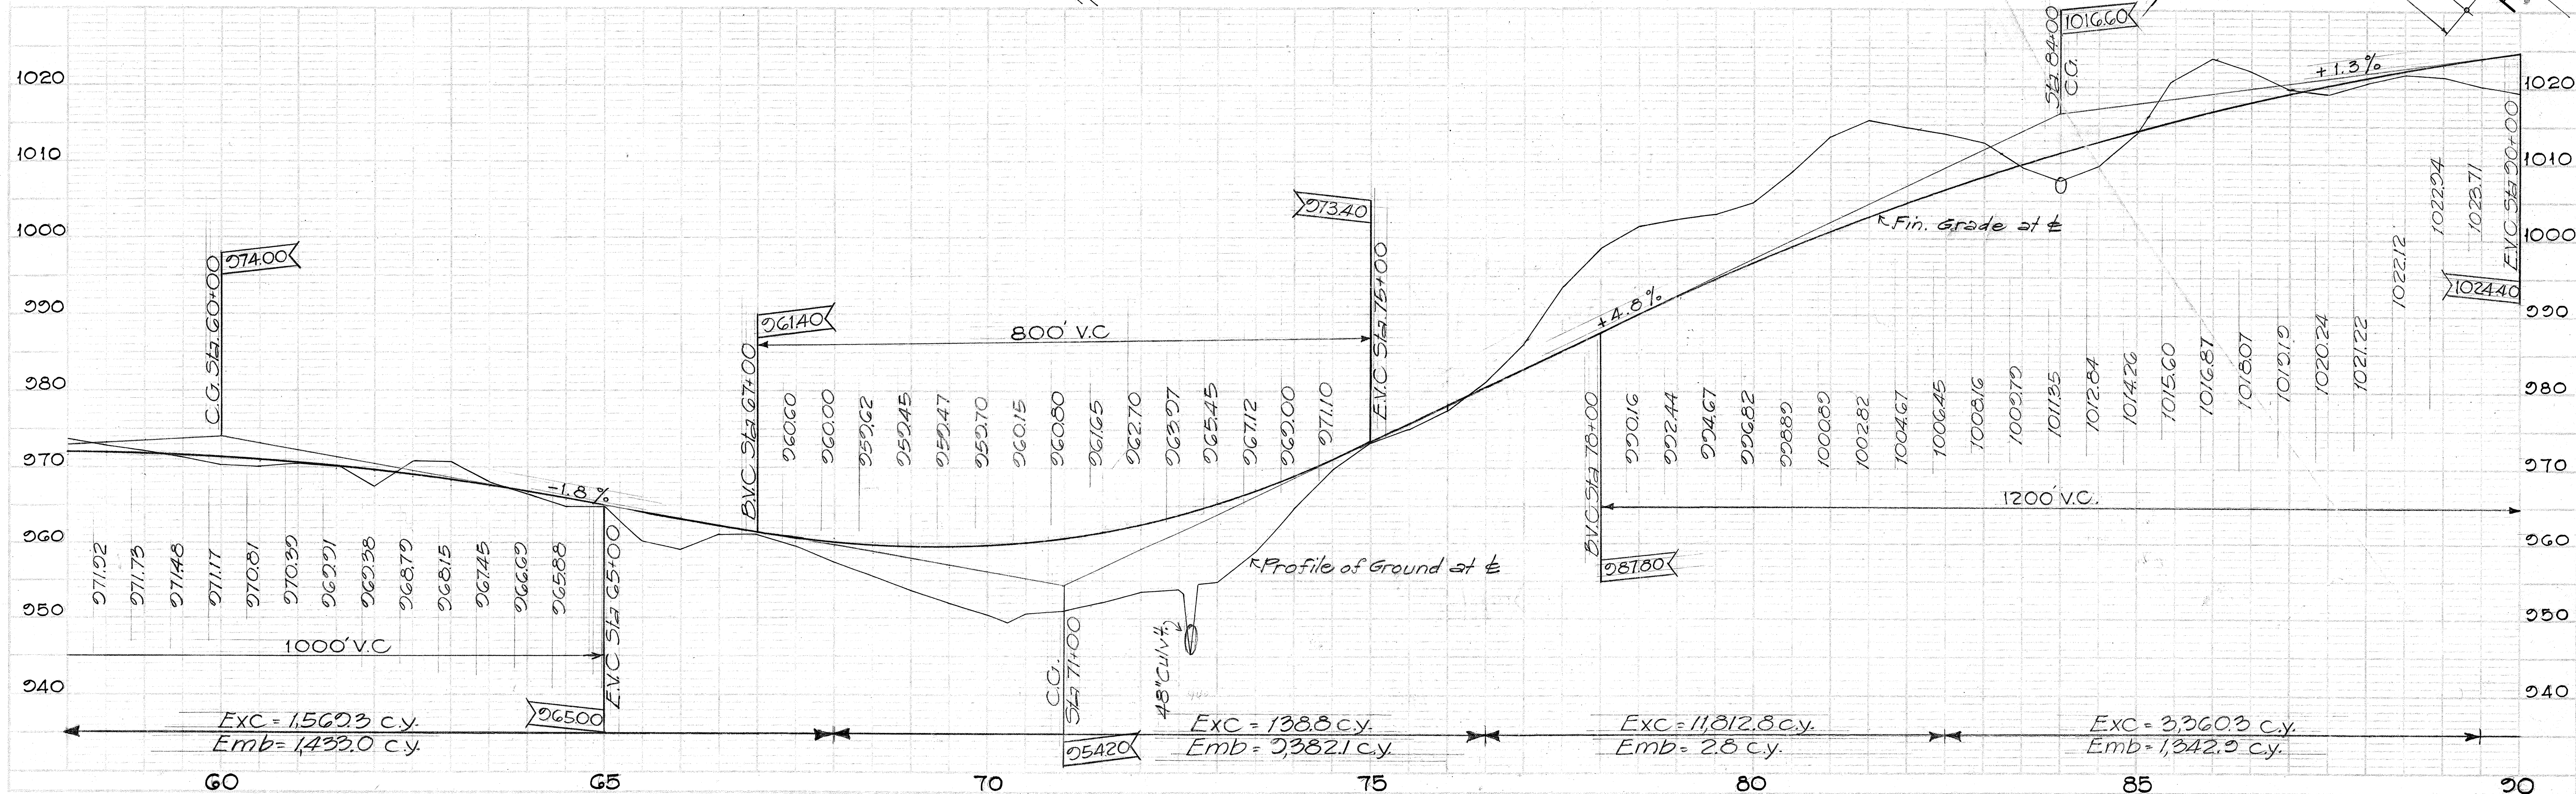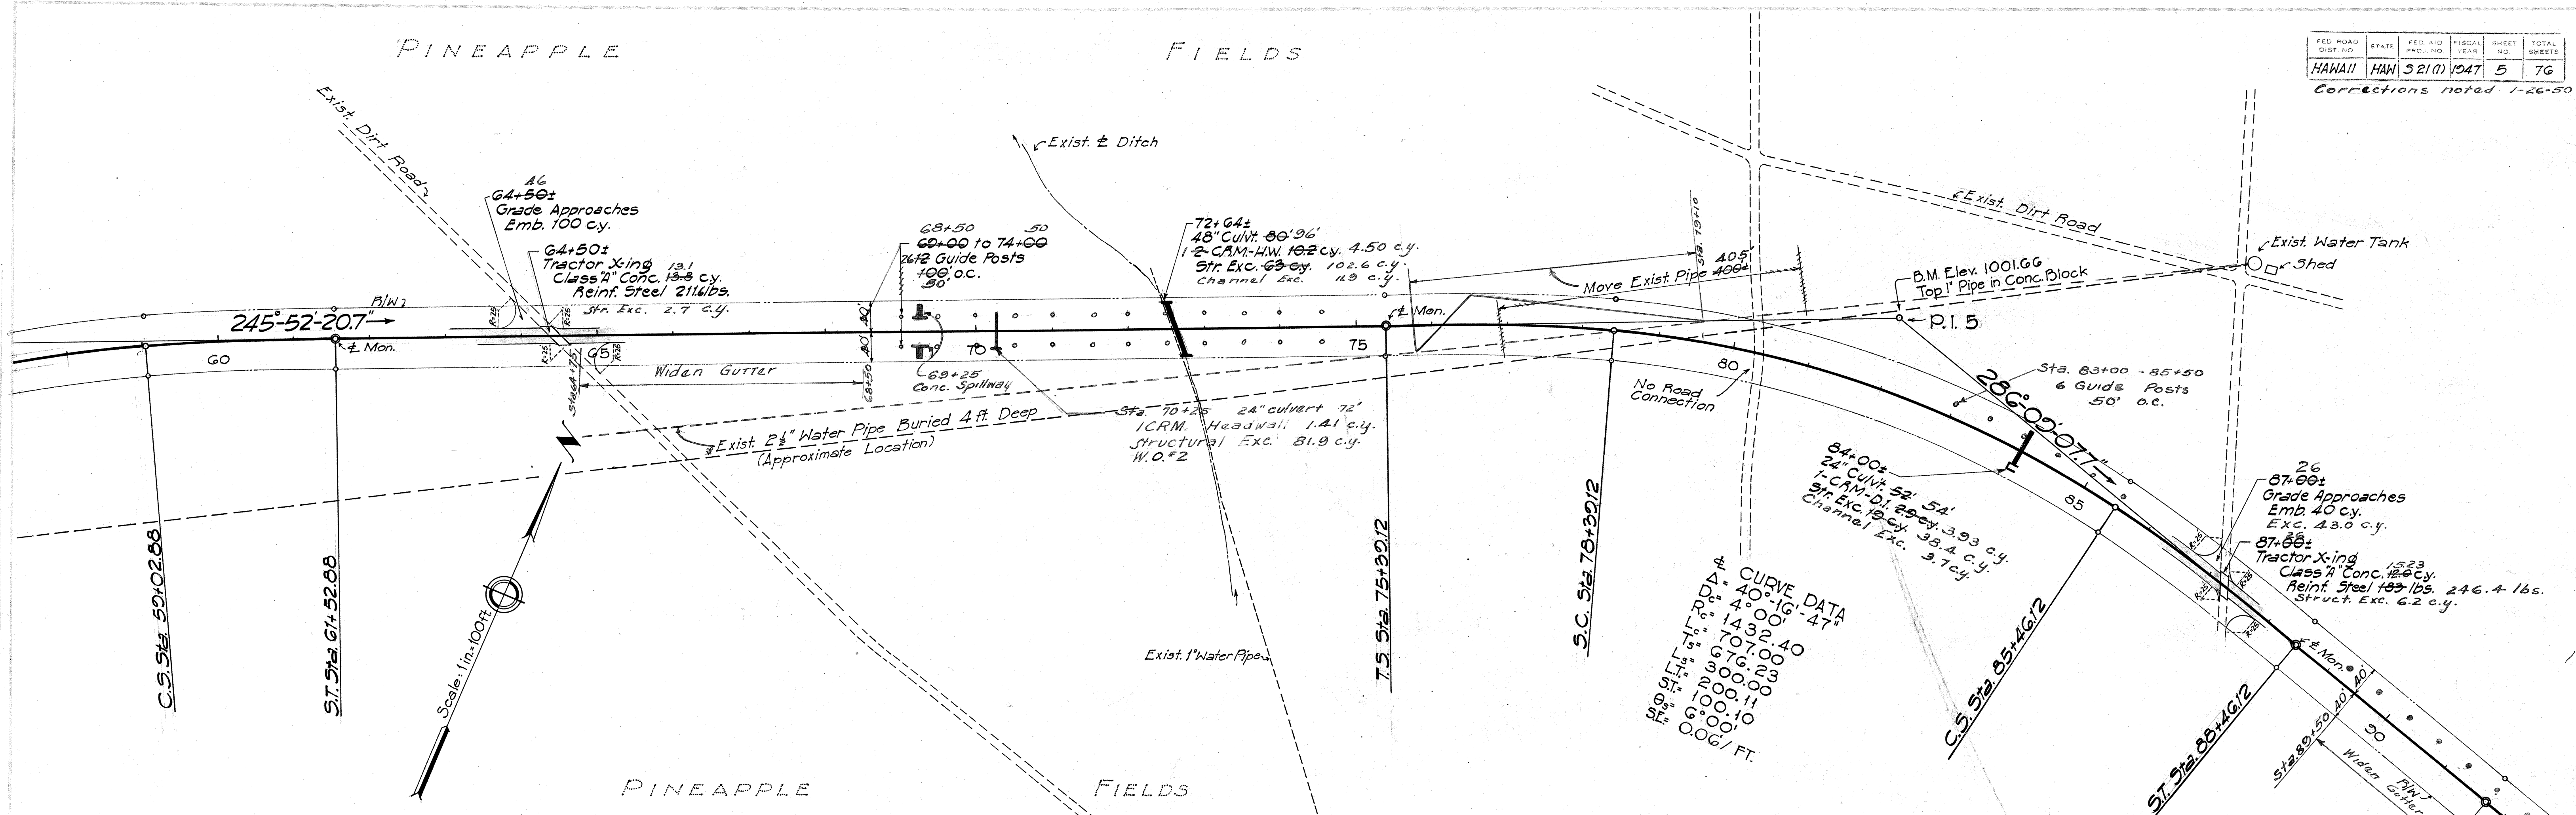

5288.5



FED. ROAD DIST. NO.	STATE	FED. AID PROJ. NO.	FISCAL YEAR	SHEET NO.	TOTAL SHEETS
HAWAII	HAW	521(M)	1947	G	76

Corrections noted 1-26-50

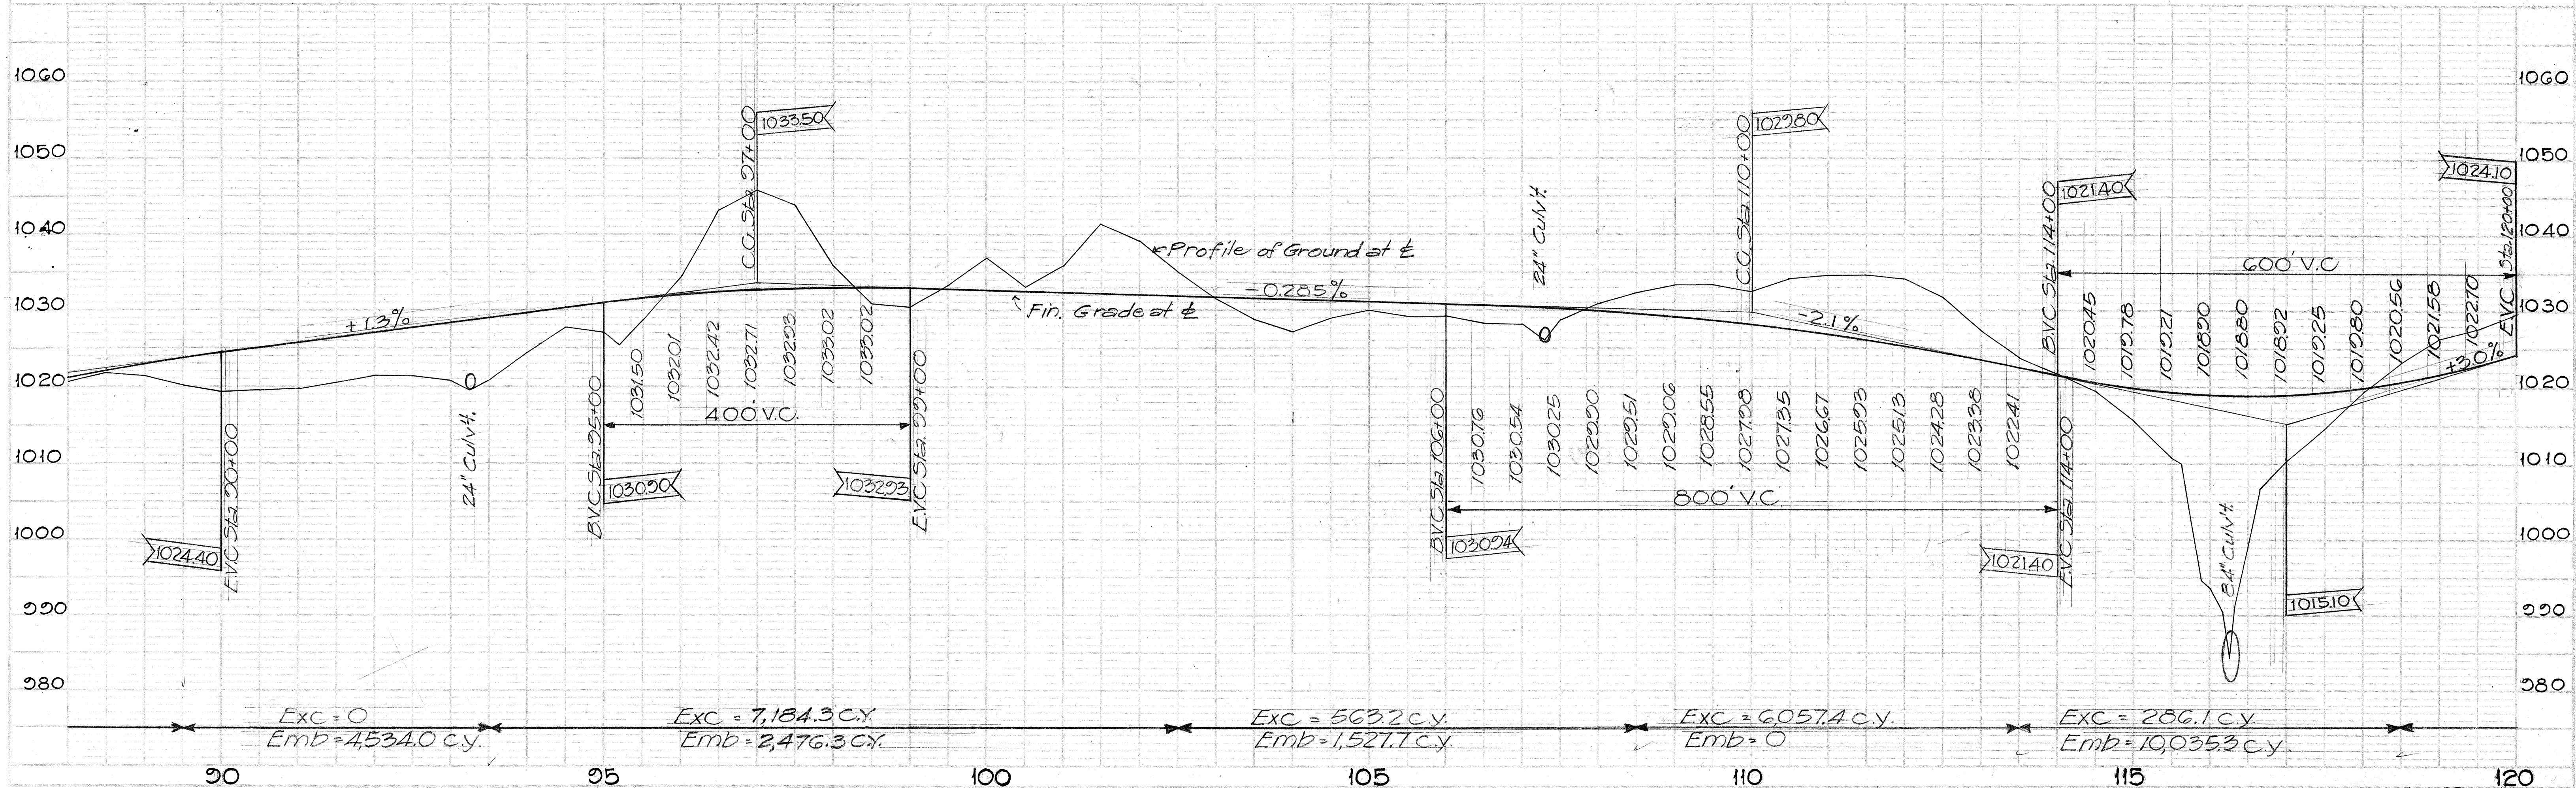
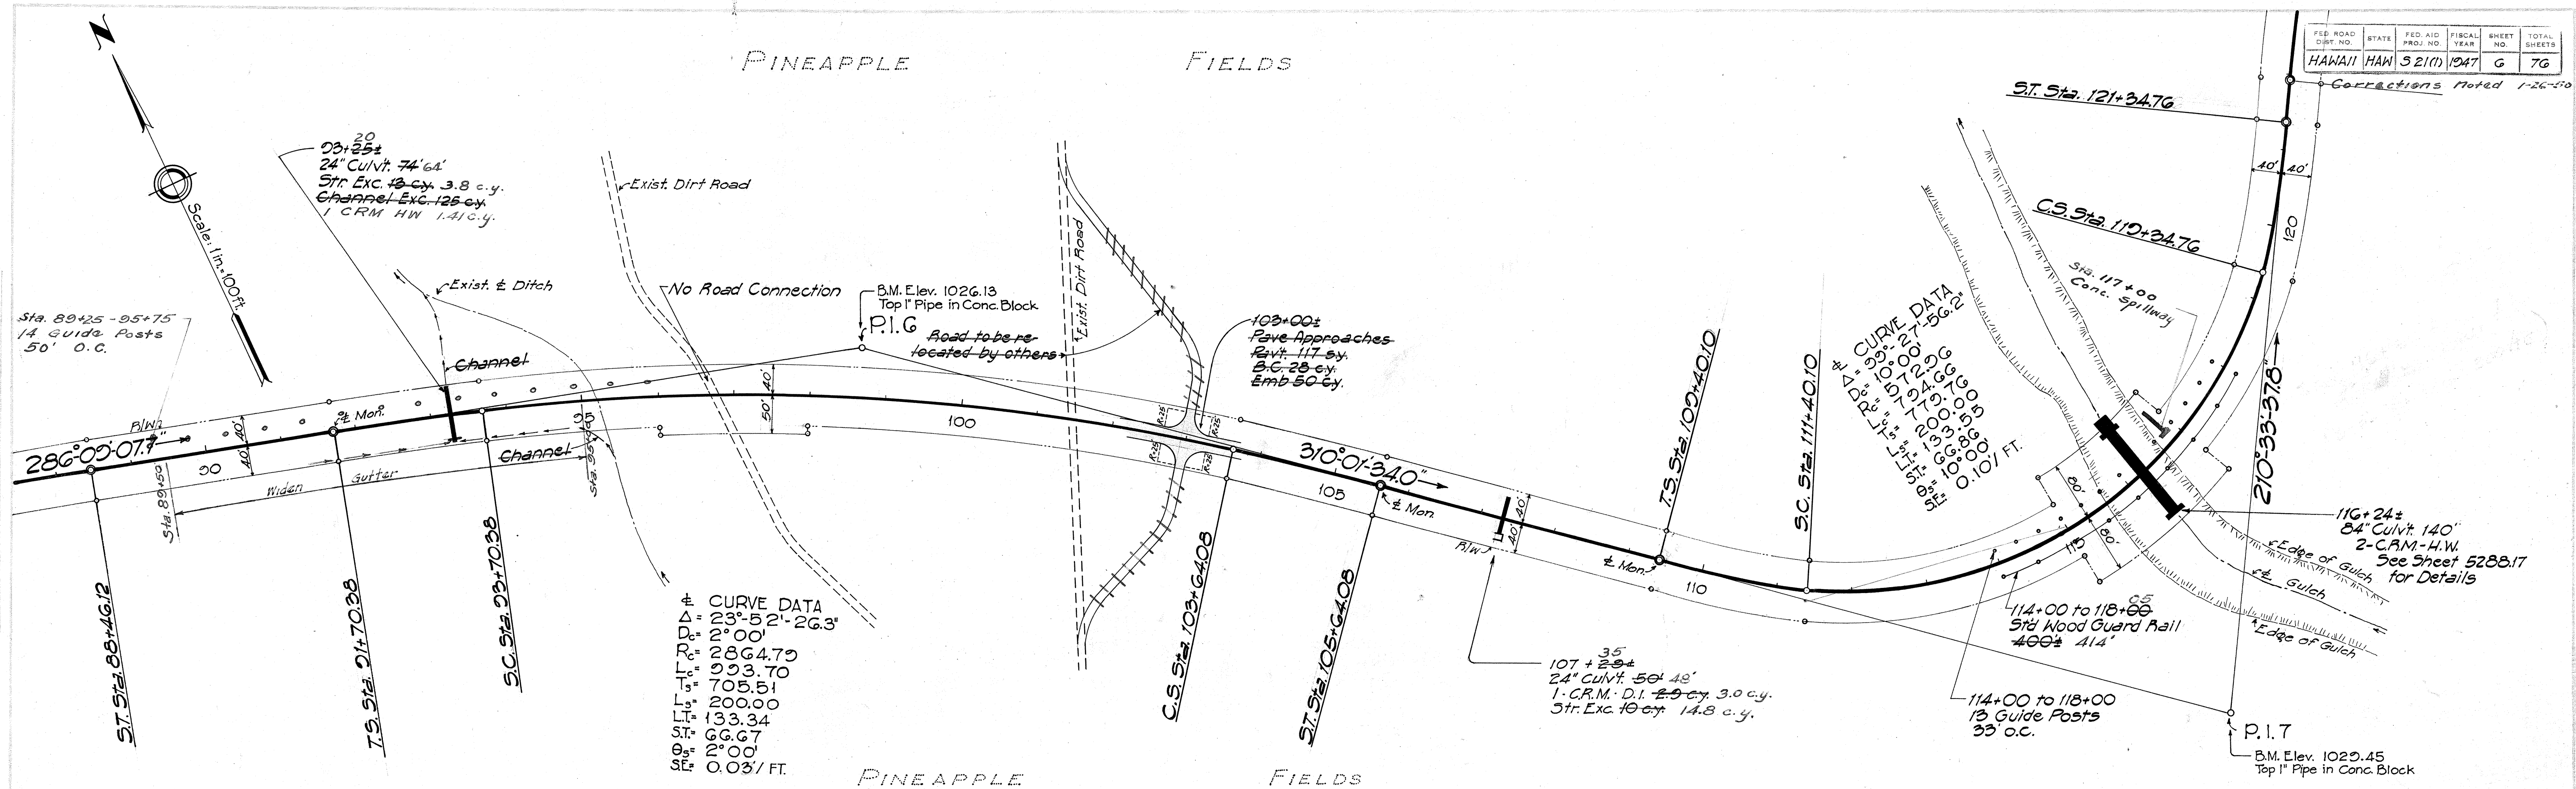


FED. ROAD DIST. NO.	STATE	FED. AID PROJ. NO.	FISCAL YEAR	SHEET NO.	TOTAL SHEETS
HAWAII	HAW	521(C)	1947	8	76

Corrections Noted 1-26-50

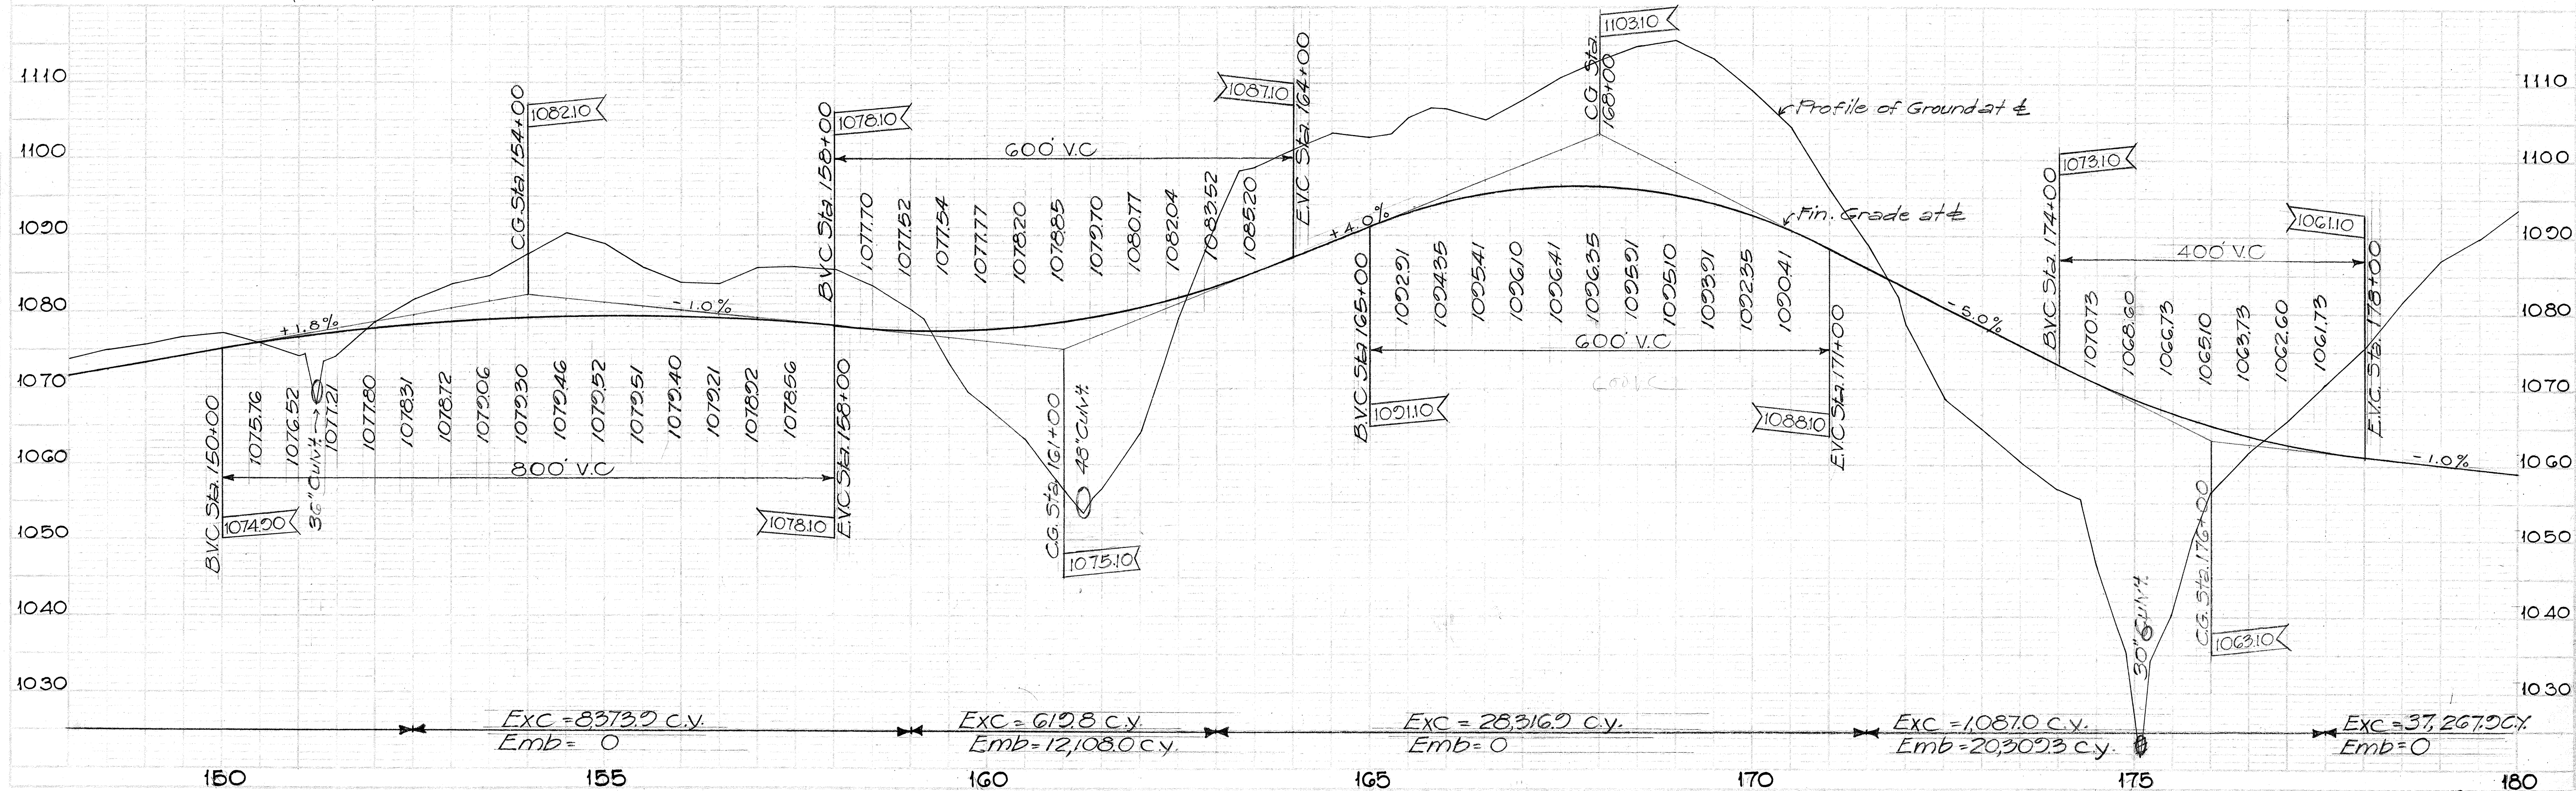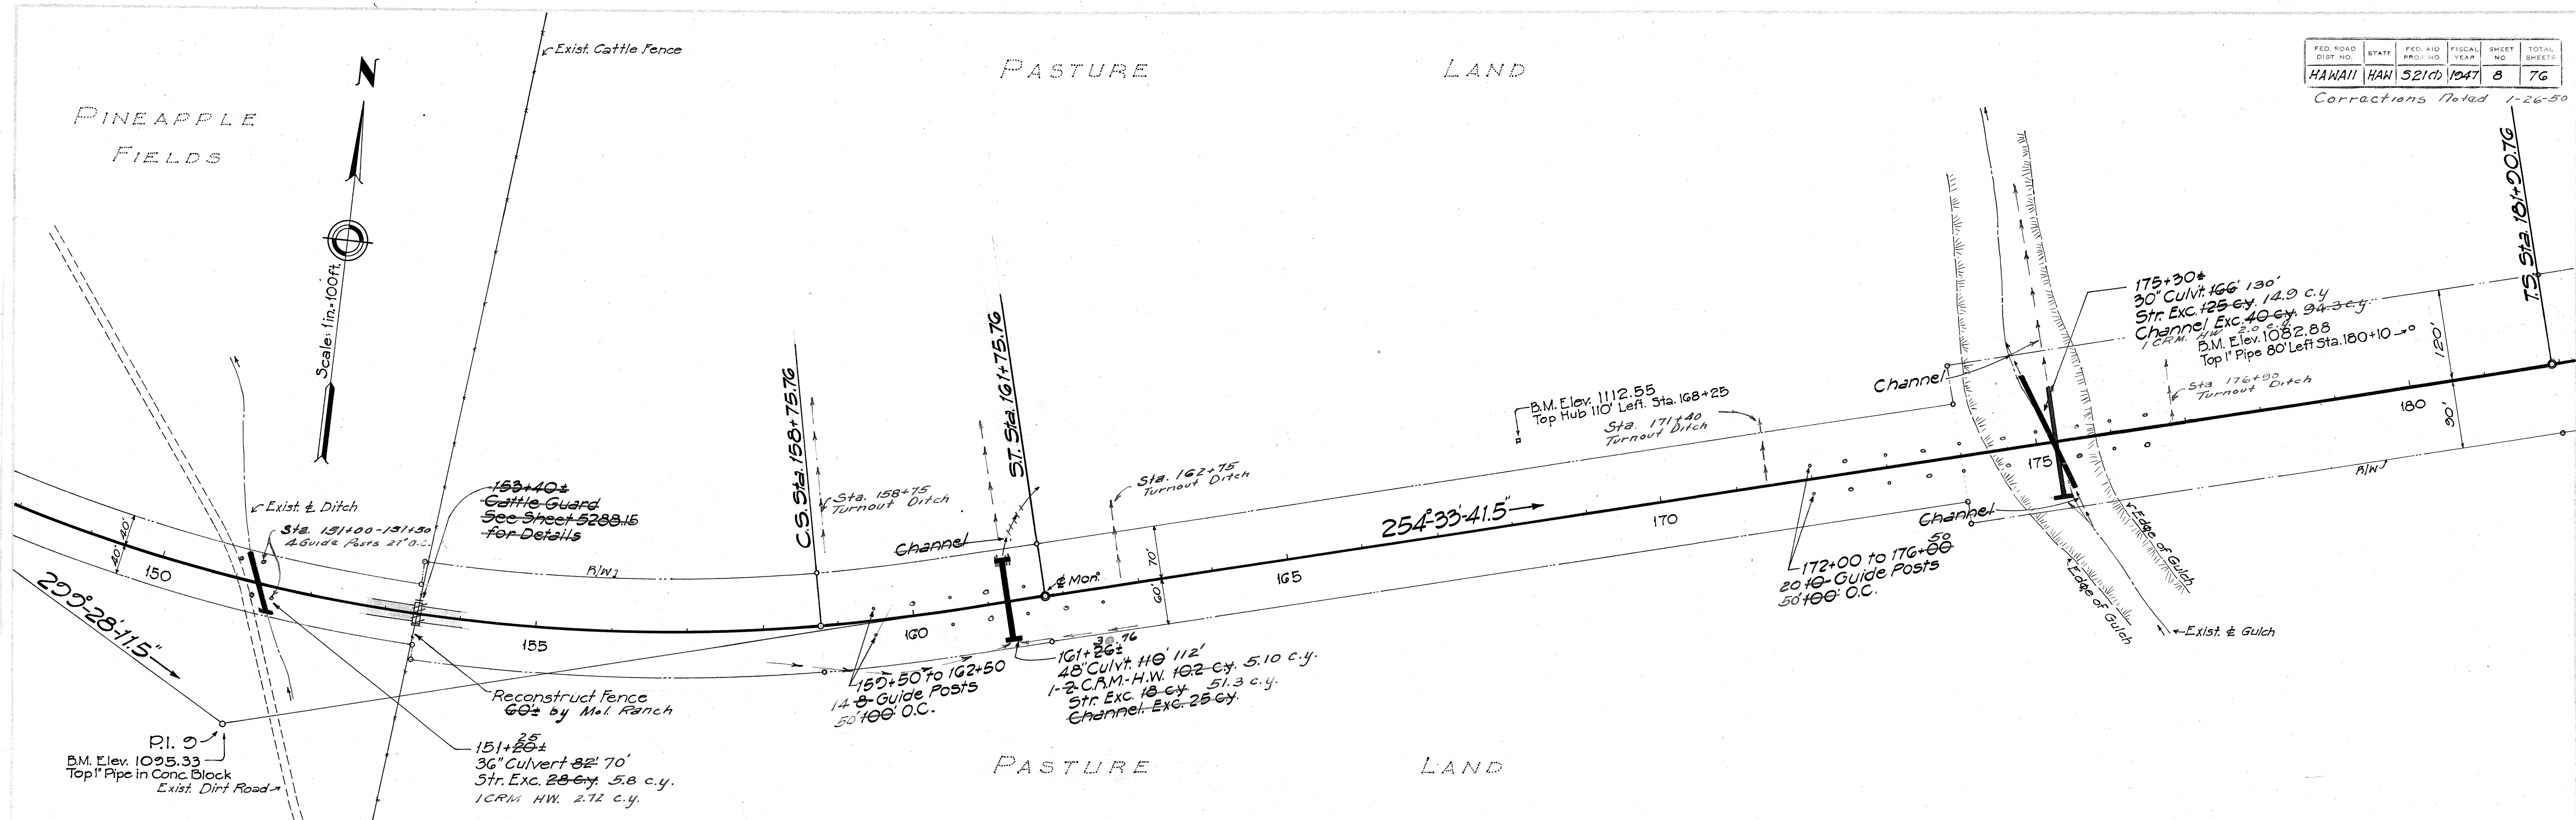

Corrections Noted 1-26-50

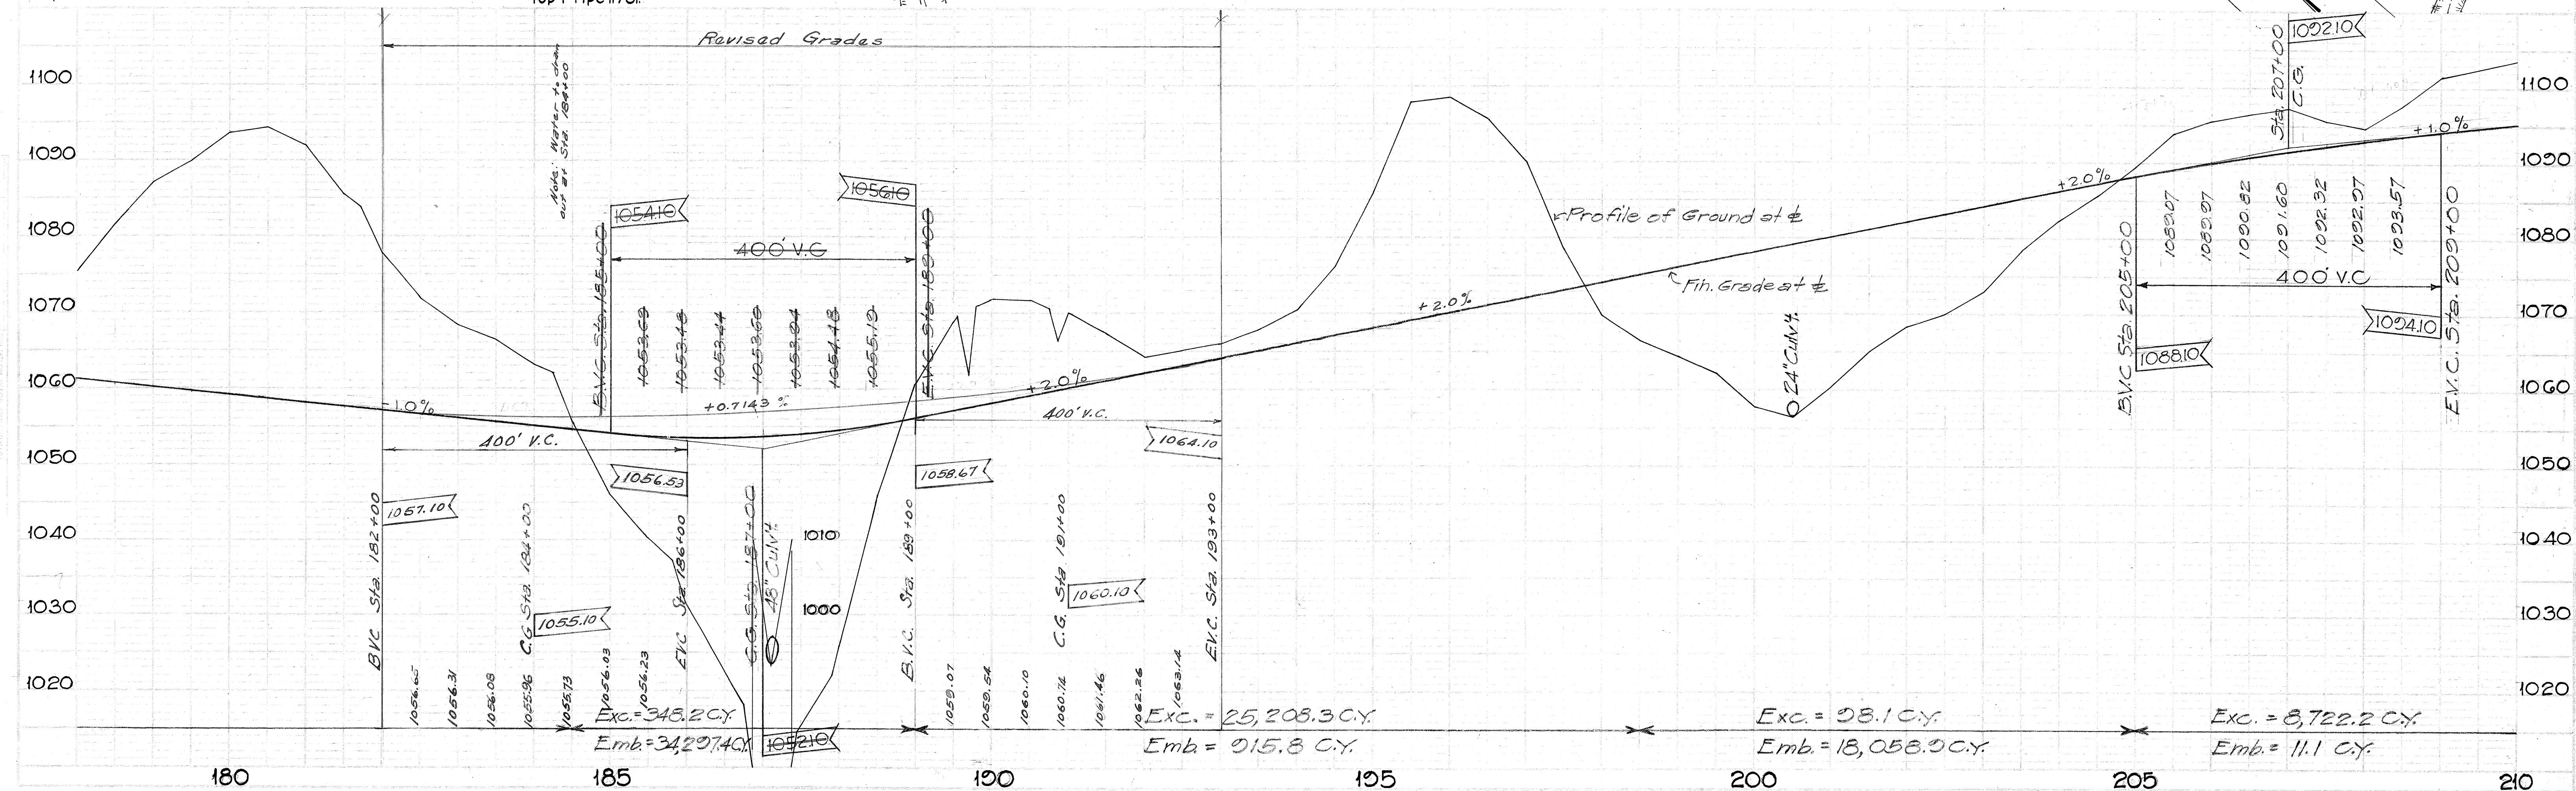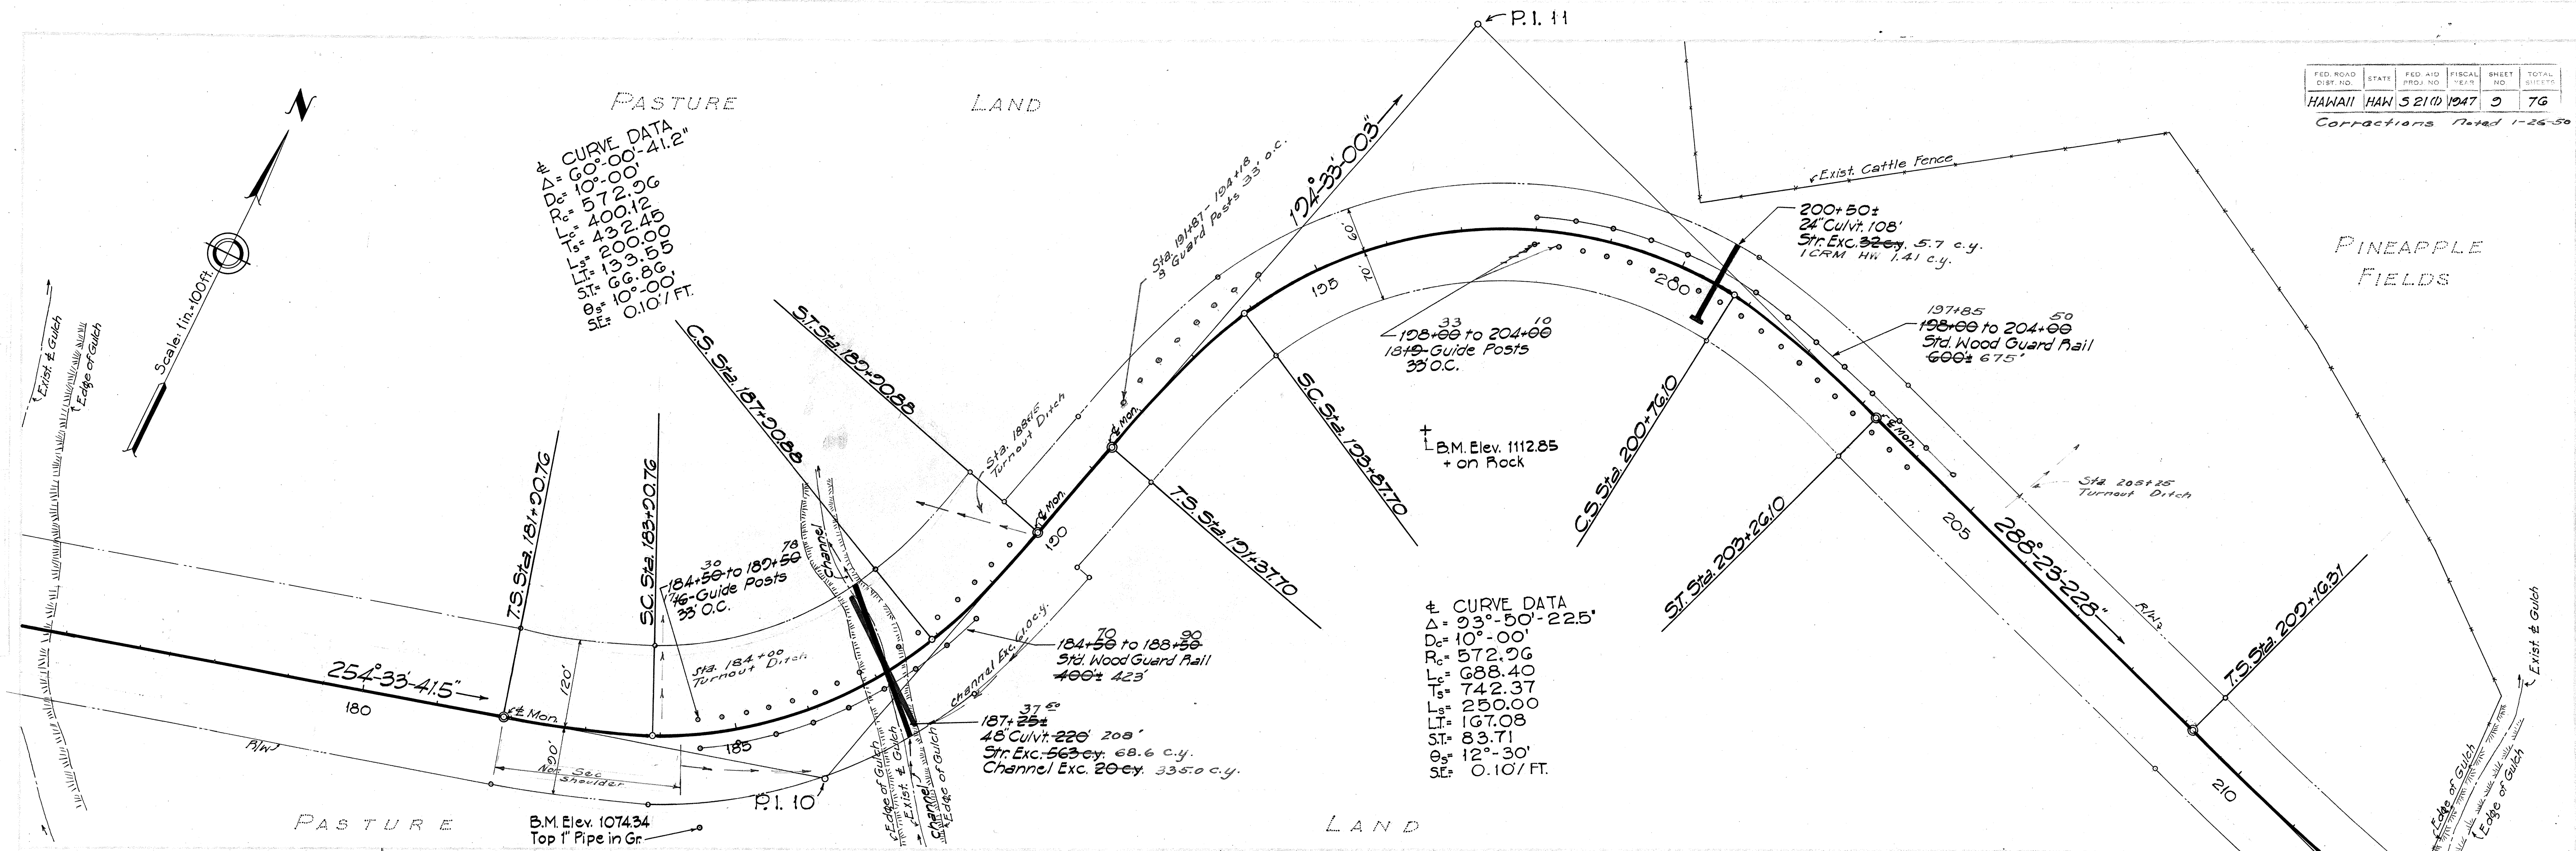

5288.9

