
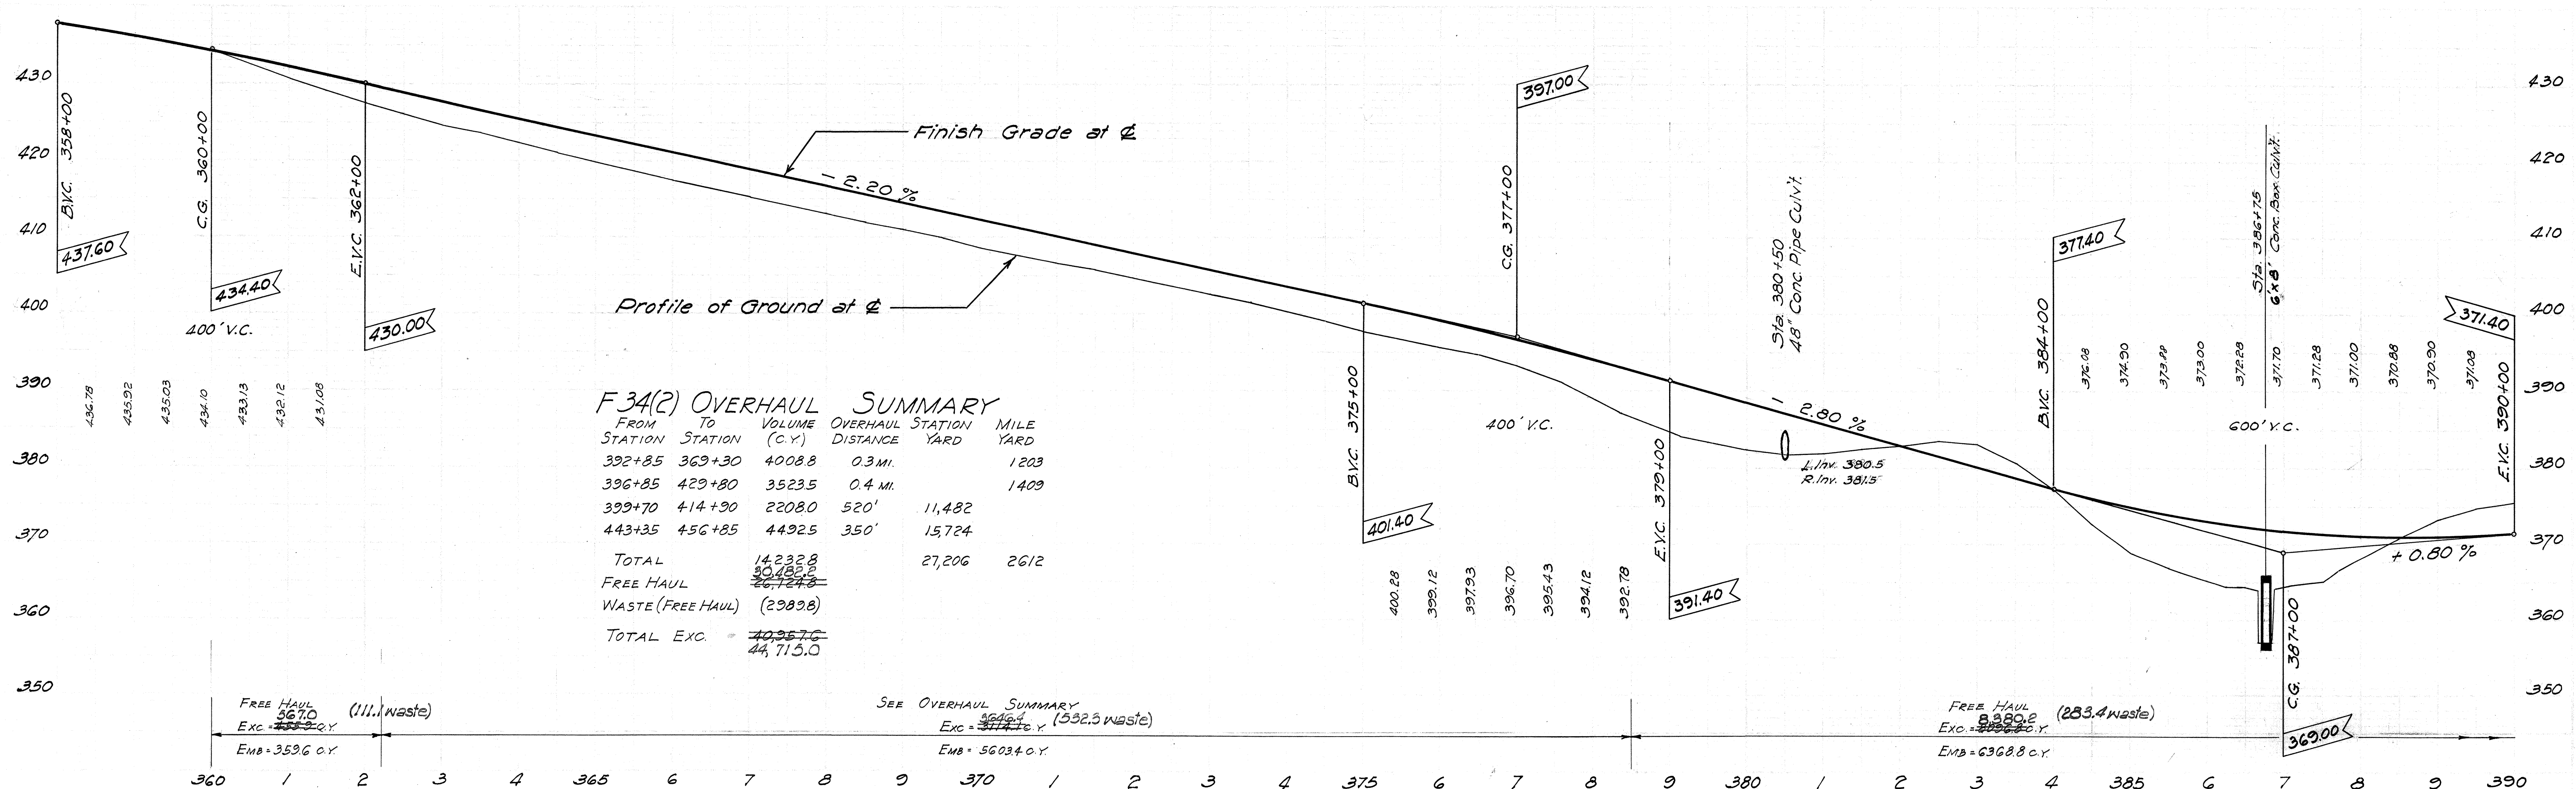


FED. ROAD DIST. NO.	STATE	FED. AID PROJ. NO.	FISCAL YEAR	SHEET NO.	TOTAL SHEETS
HAWAII	HAW.	F34(2)	1951	3	20

8-13-51
1-13-53


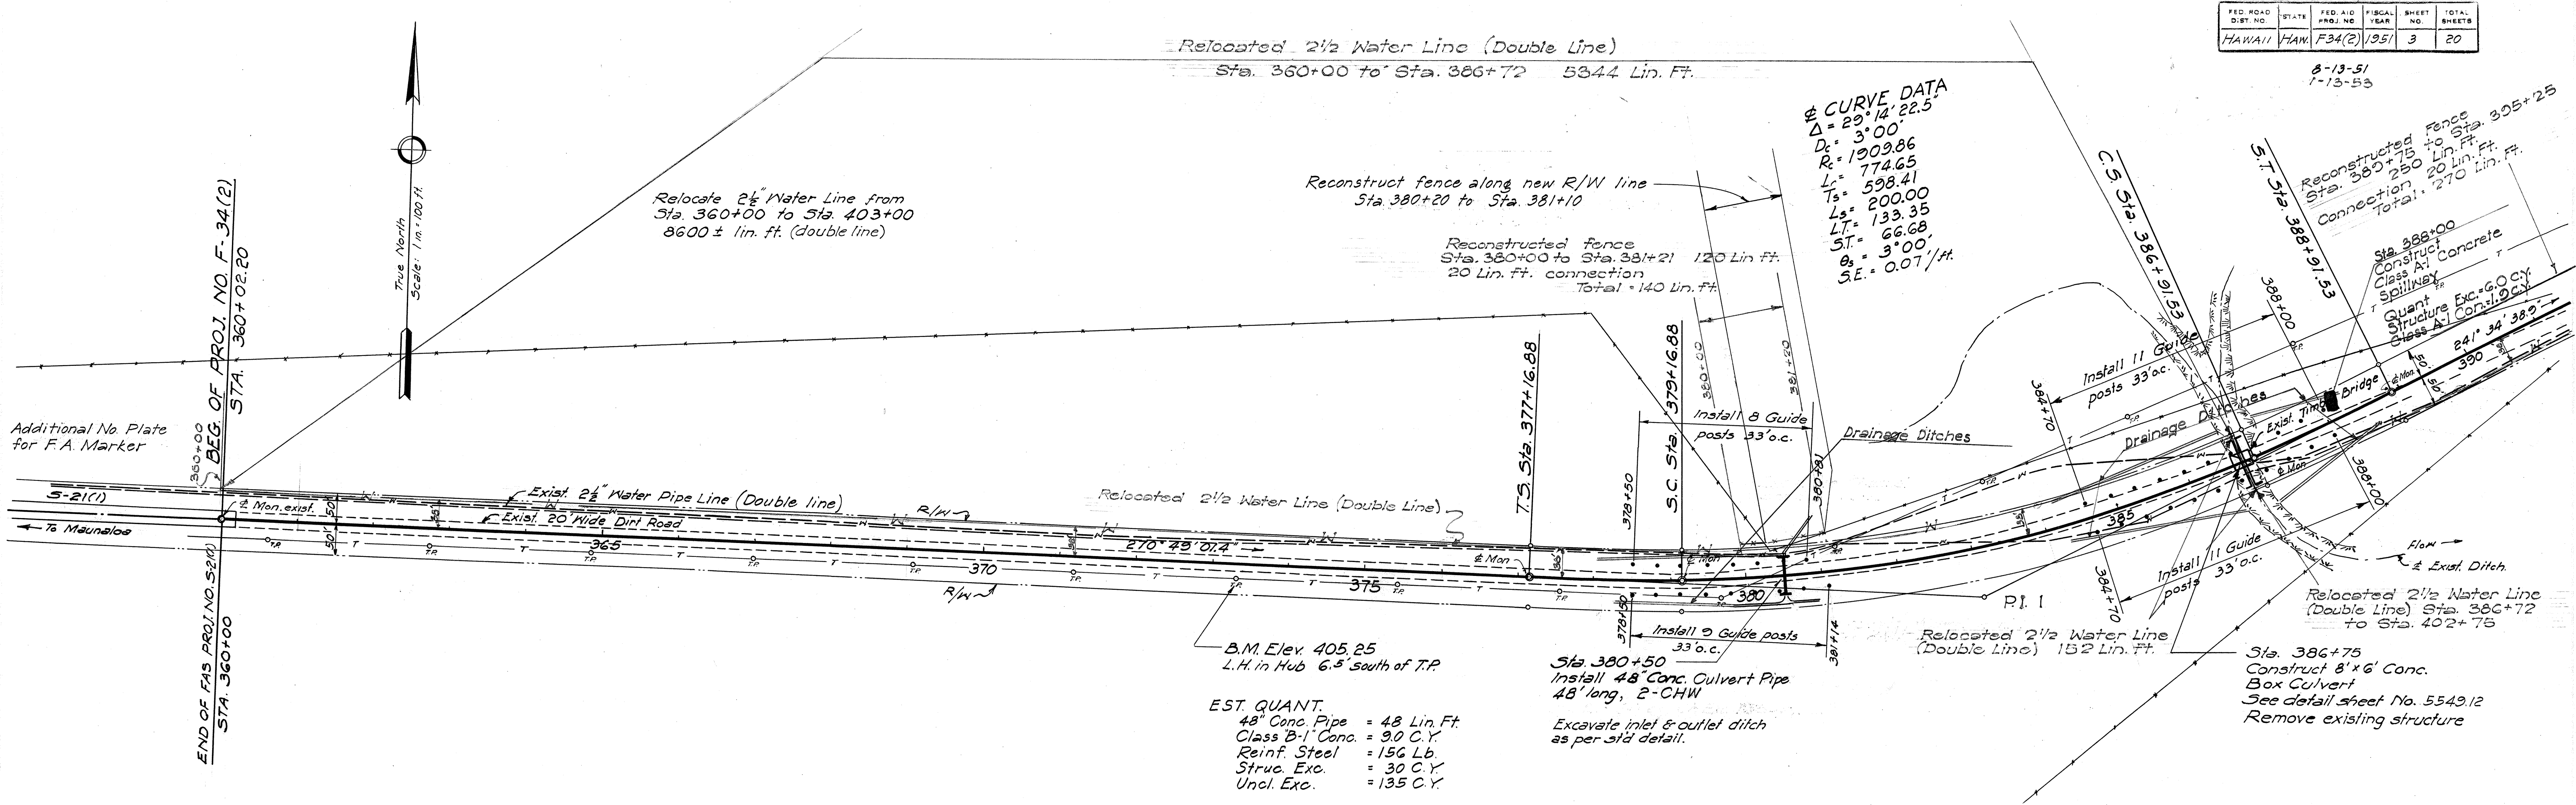


5549.3

PINEAPPLE FIELD



FED. ROAD DIST. NO.	STATE	FED. AID PROJ. NO.	FISCAL YEAR	SHEET NO.	TOTAL SHEETS
HAWAII	HAW.	F34(2)	1951	4	20

8-13-51
1-13-53

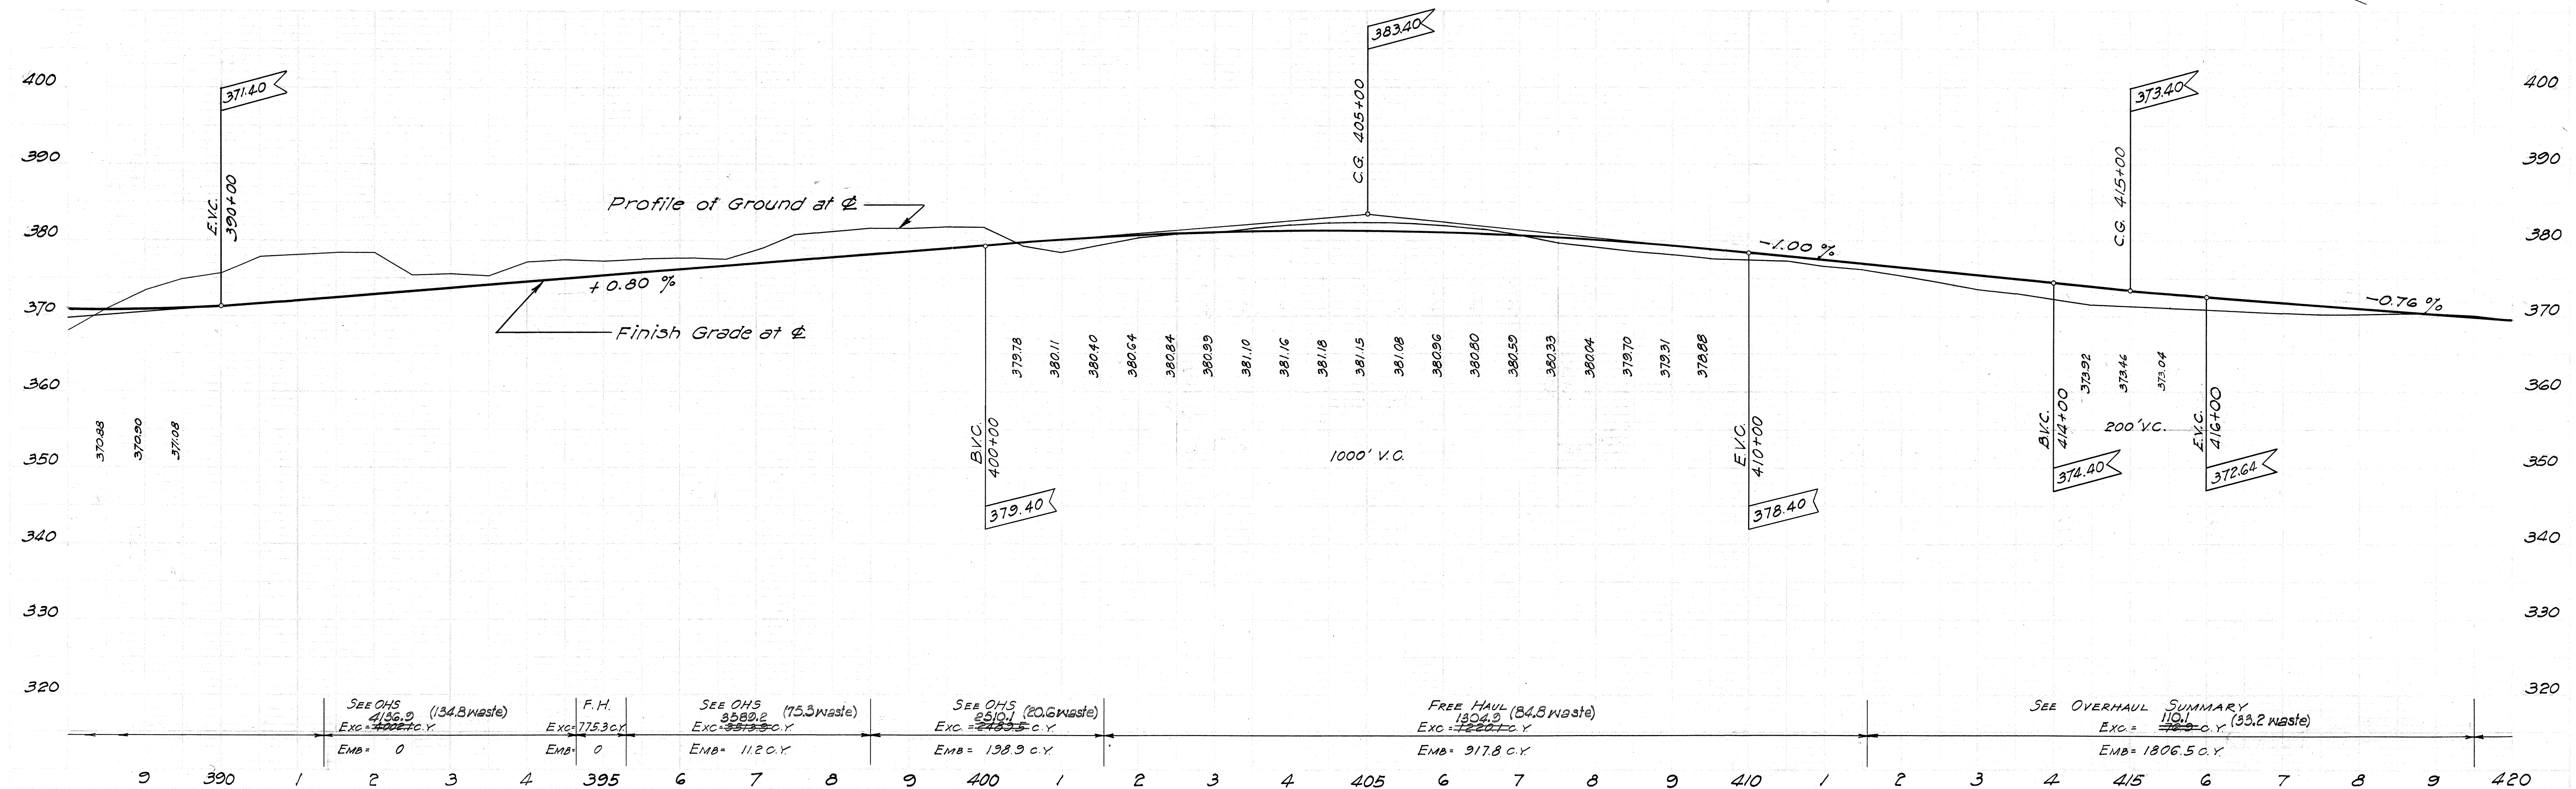
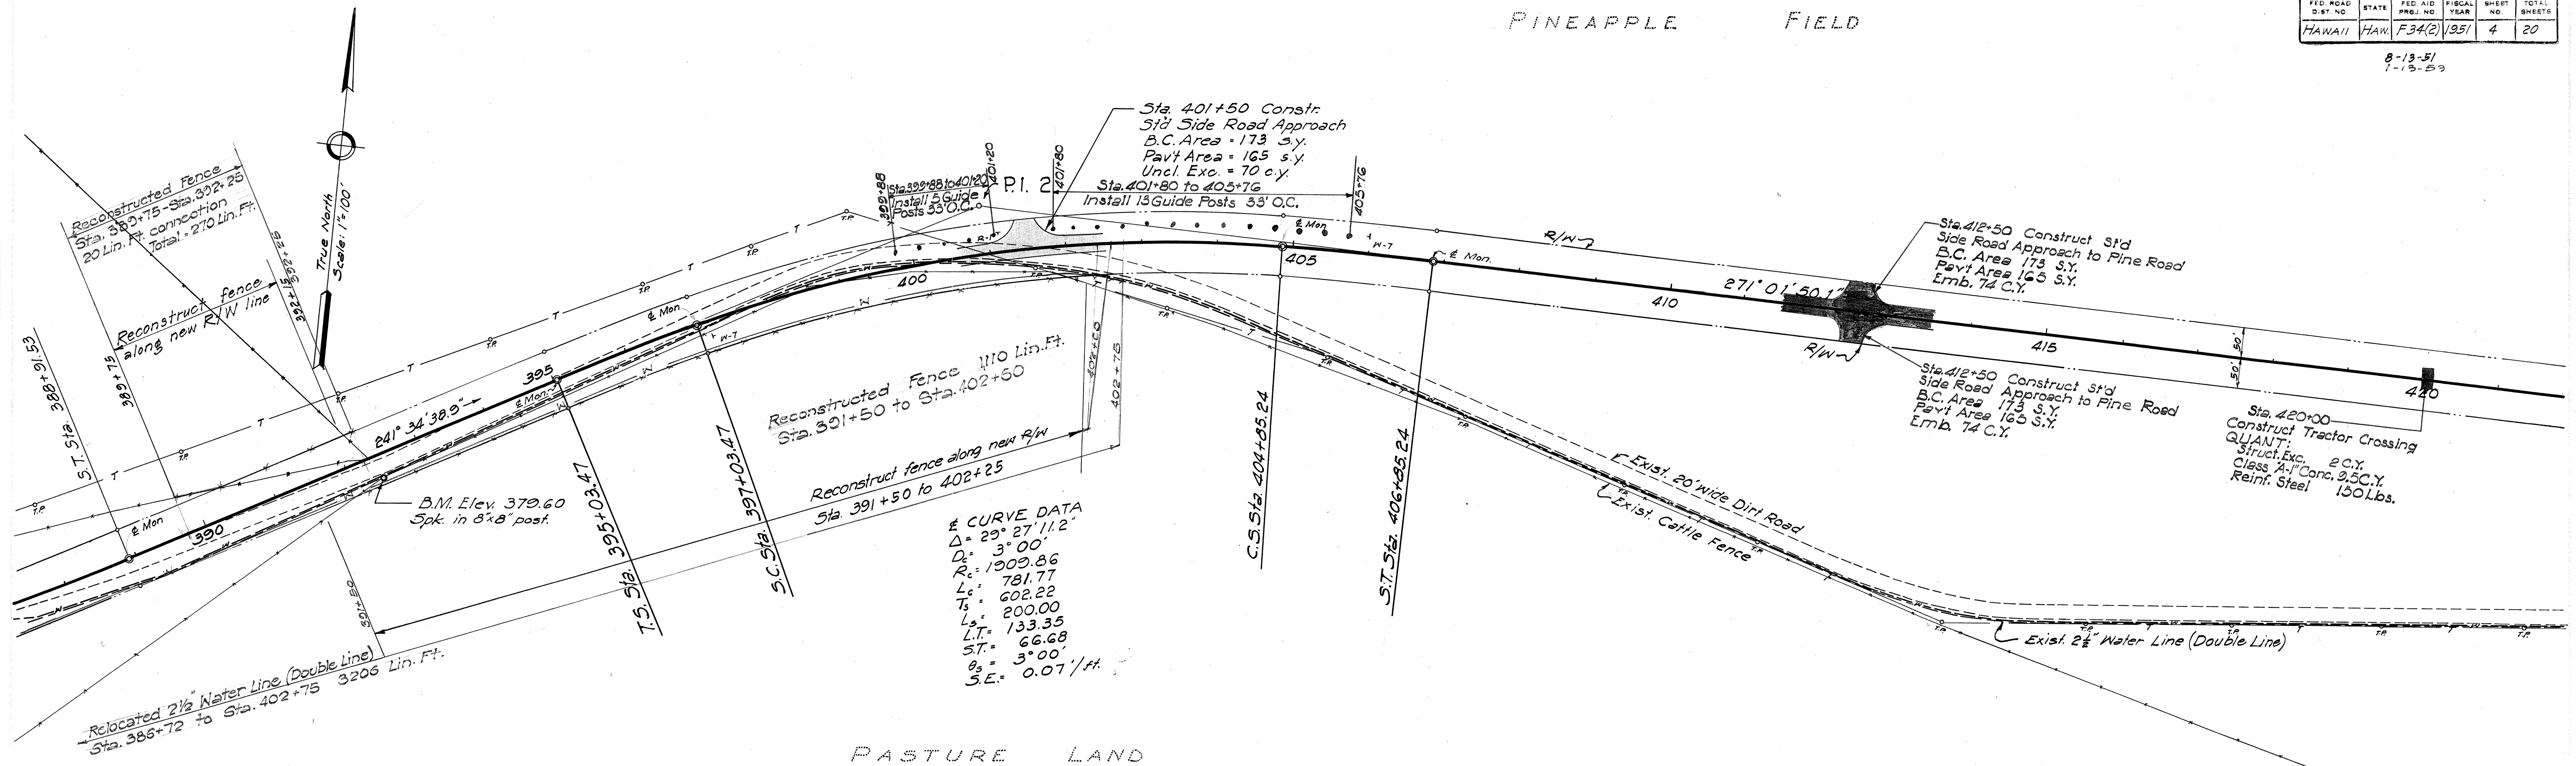


5549.4

8-13-5
1-13-5

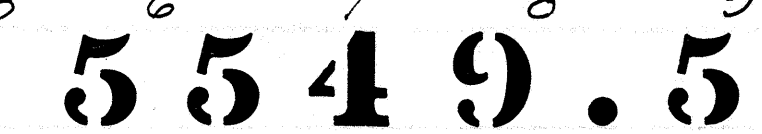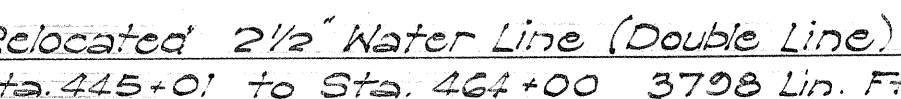

8-13-51
1-13-53

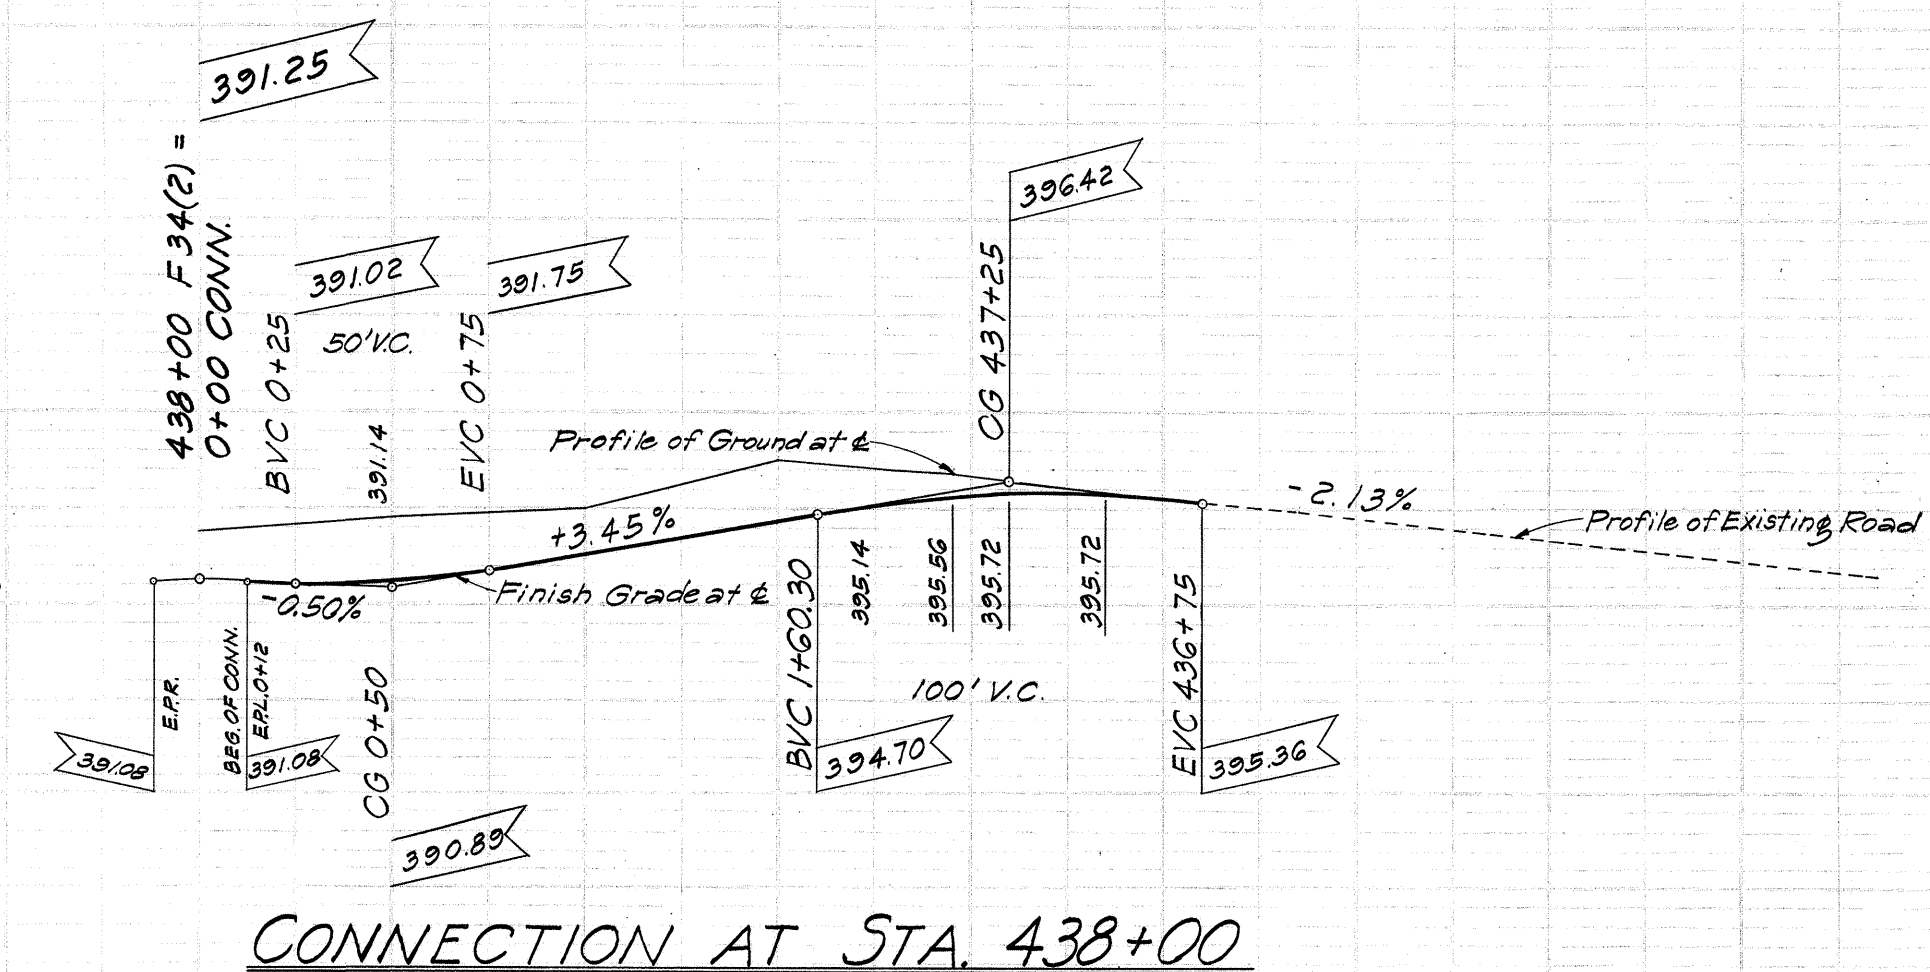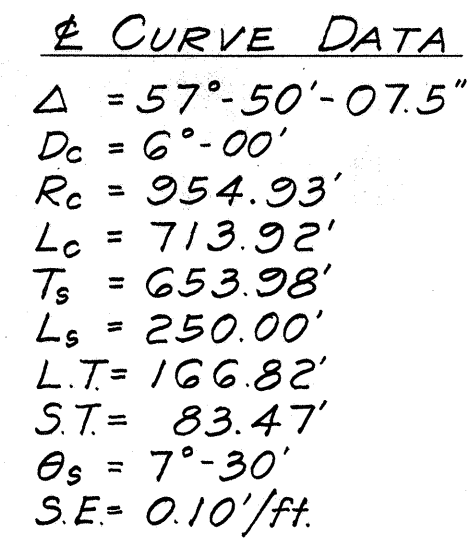

CONNECTION AT STA. 438+00

FREE HAUL
EXC = $\frac{1562.0}{1312.6}$ C.Y.
EMB = 0

5549.6