


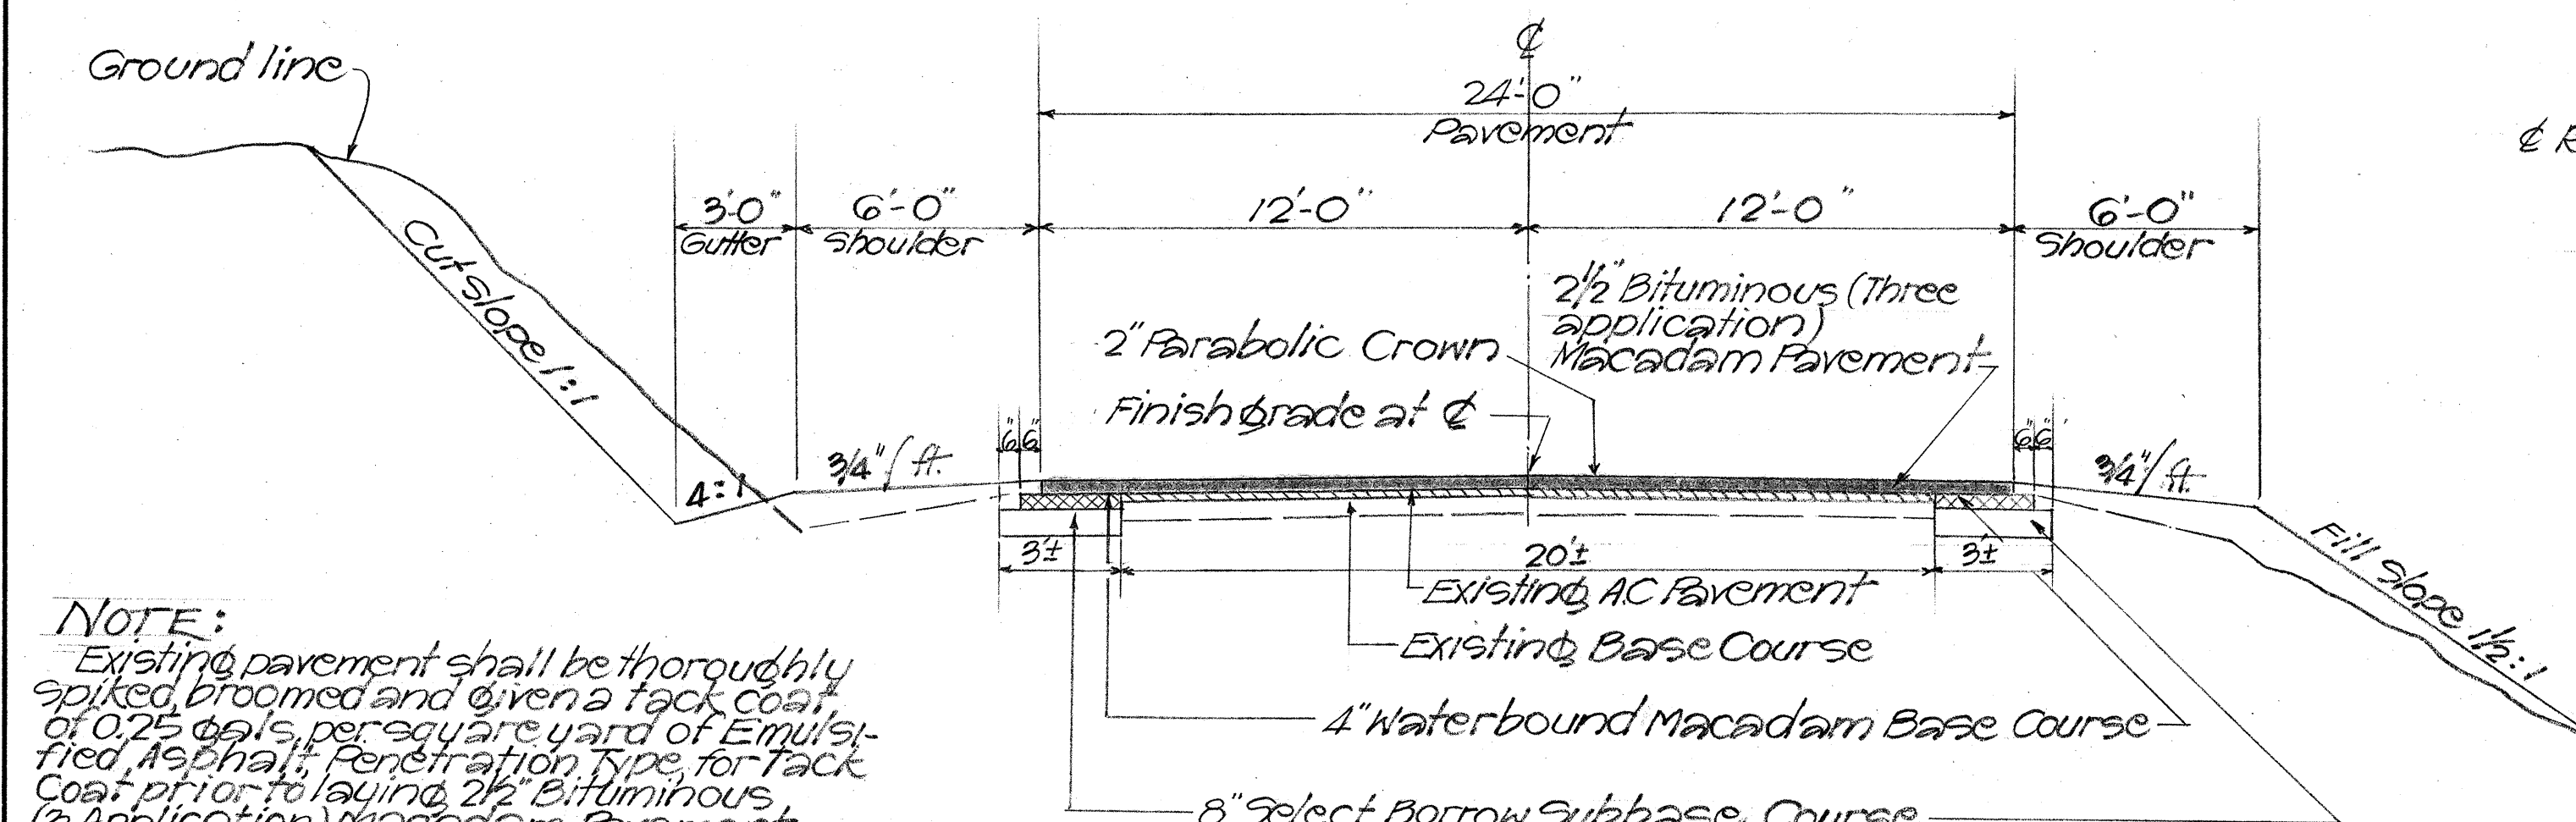


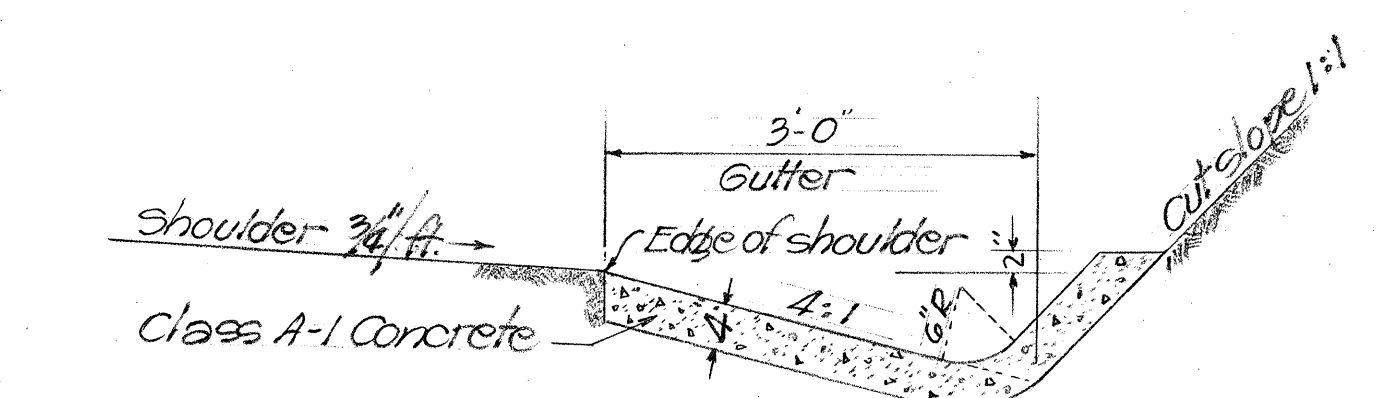



NOTE:
Existing pavement shall be thoroughly spiked, broomed and given a tack coat of 0.25 gals. per square yard of Emulsified Asphalt Penetration Type for Tack Coat prior to laying 2 1/2" Bituminous (3 Application) Macadam Pavement. Spiking shall be incidental to brooming off.

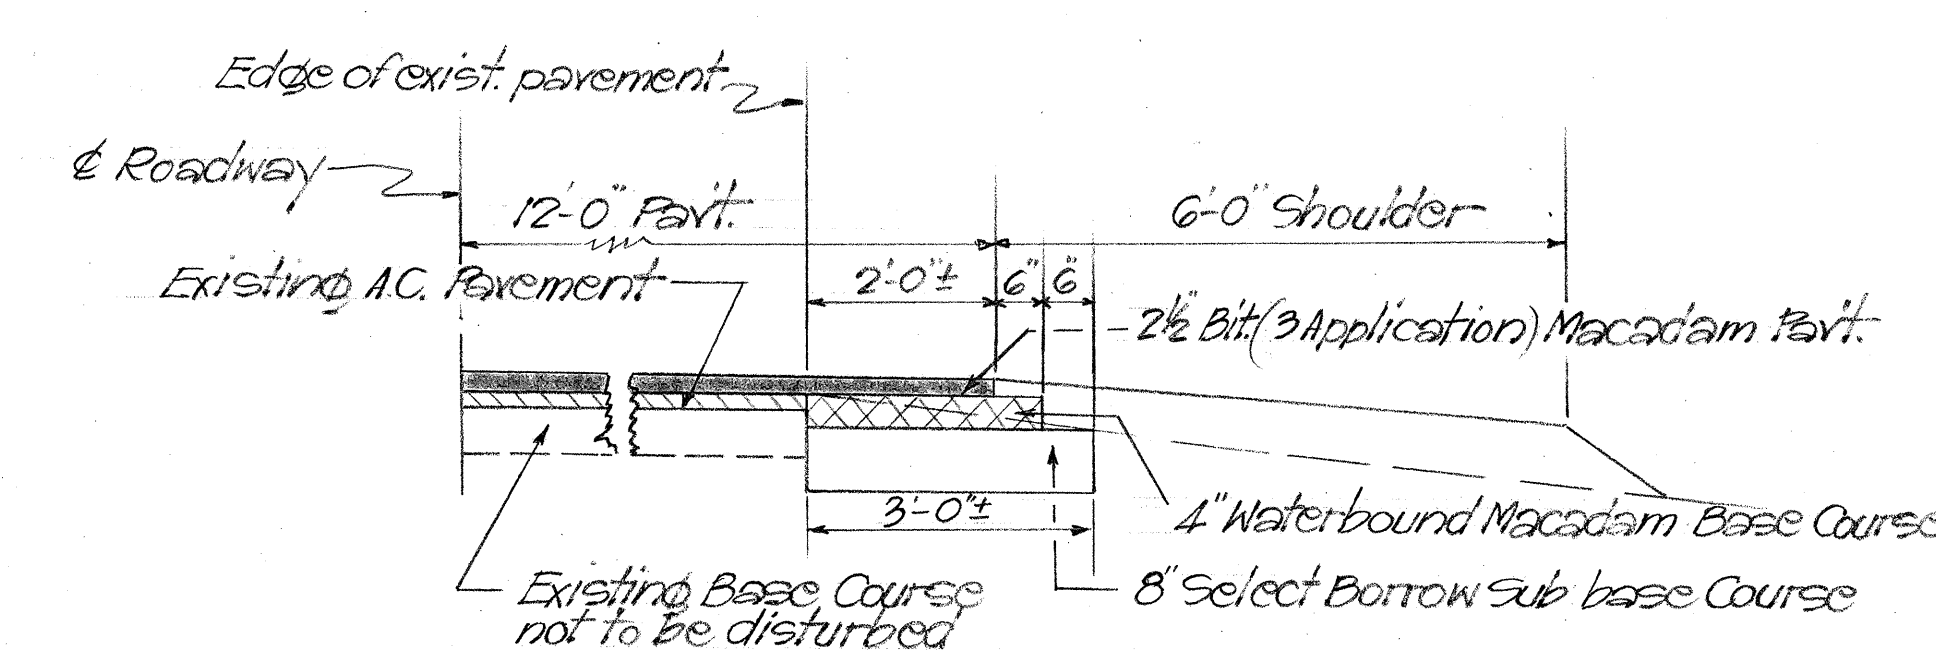


TYPICAL ROAD SECTION - STA. 0+00 TO 11+00 & 19+00 TO 31+00
Scale: 1/4" = 1'-0"

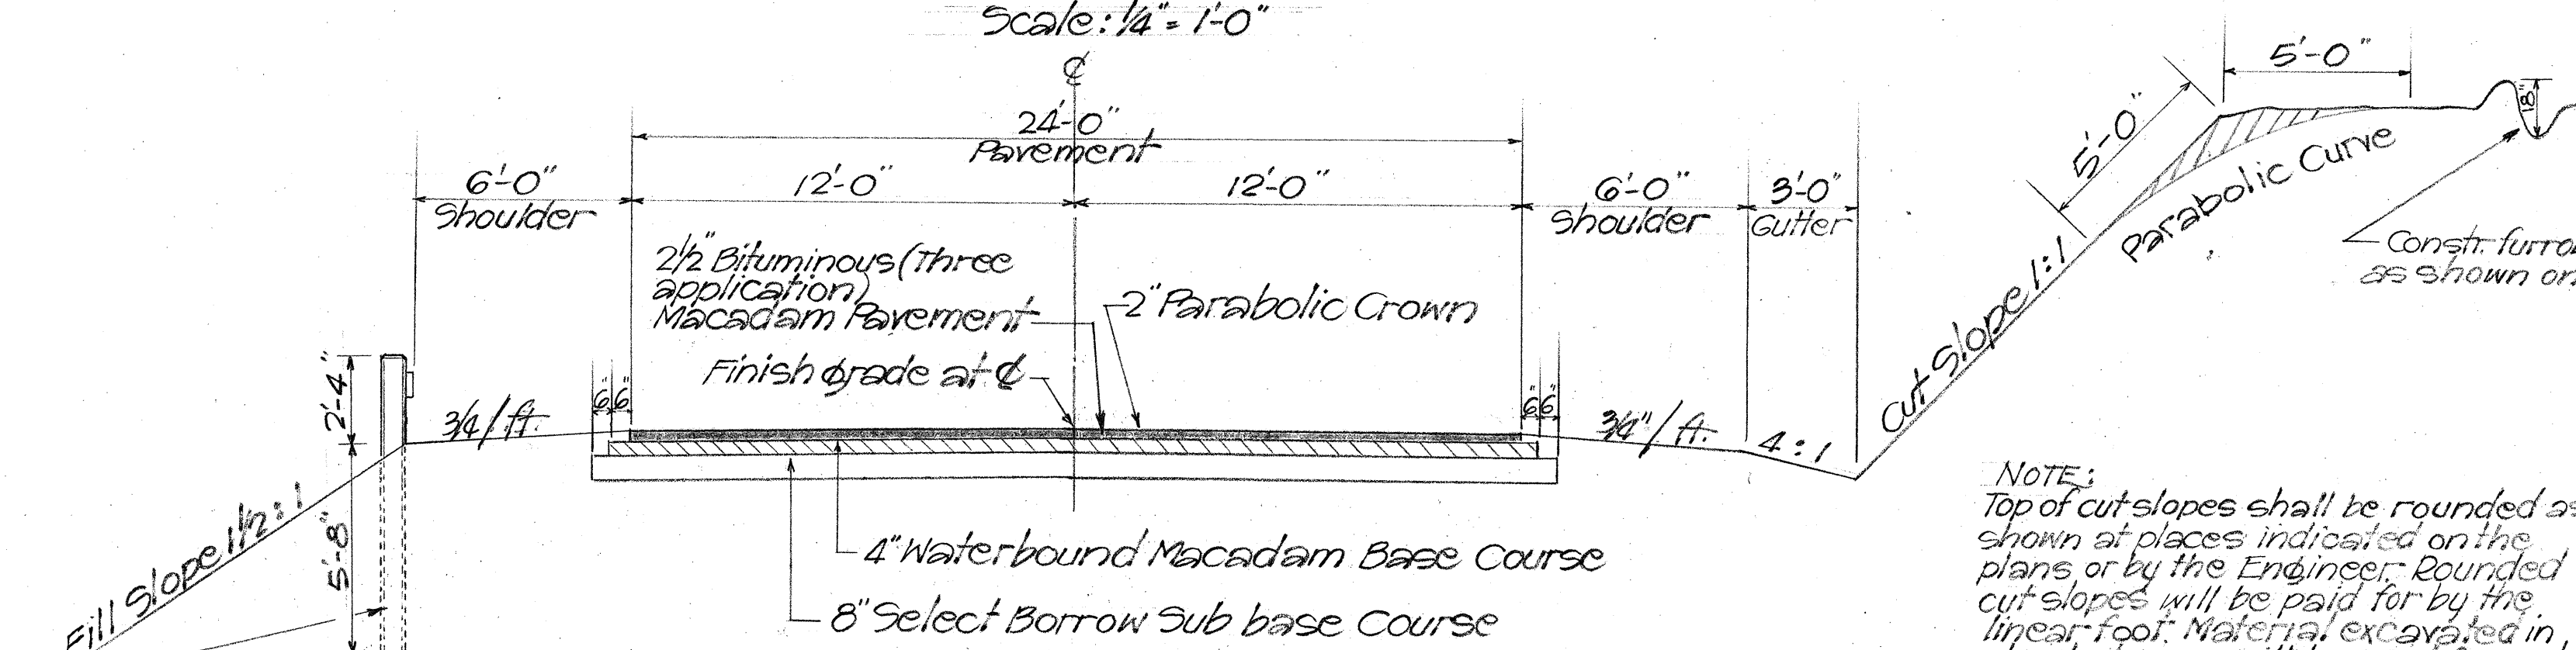

NOTE:
Top of cut slopes shall be rounded as shown at places indicated on the plans or by the Engineer. Rounded cut slopes will be paid for by the linear foot. Material excavated in shaded area will be paid for under the items of Unclassified Excavation and Overhaul.

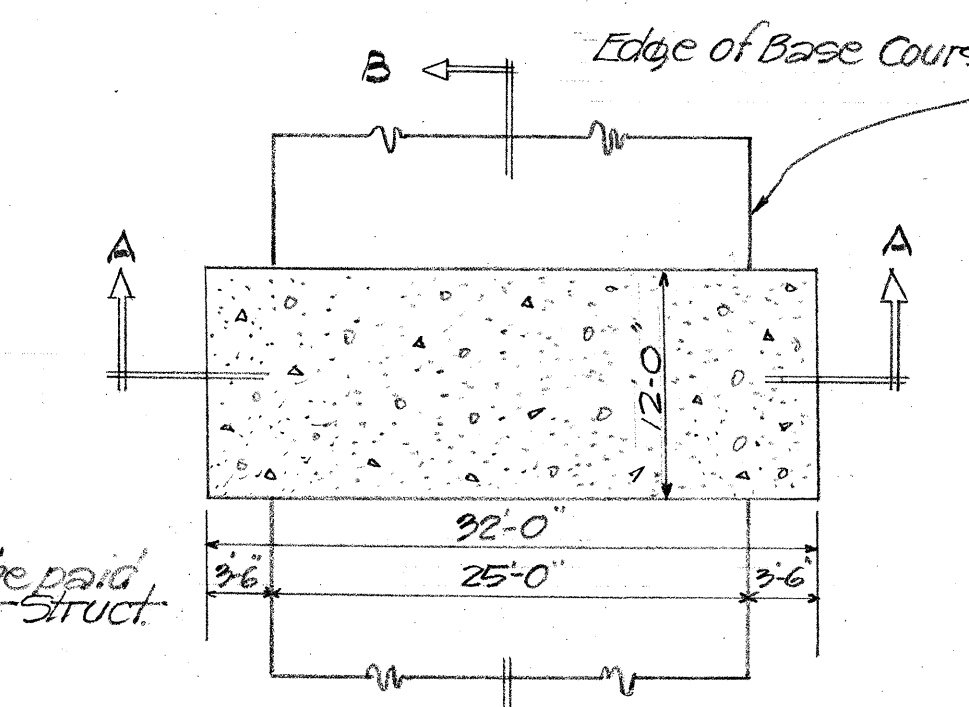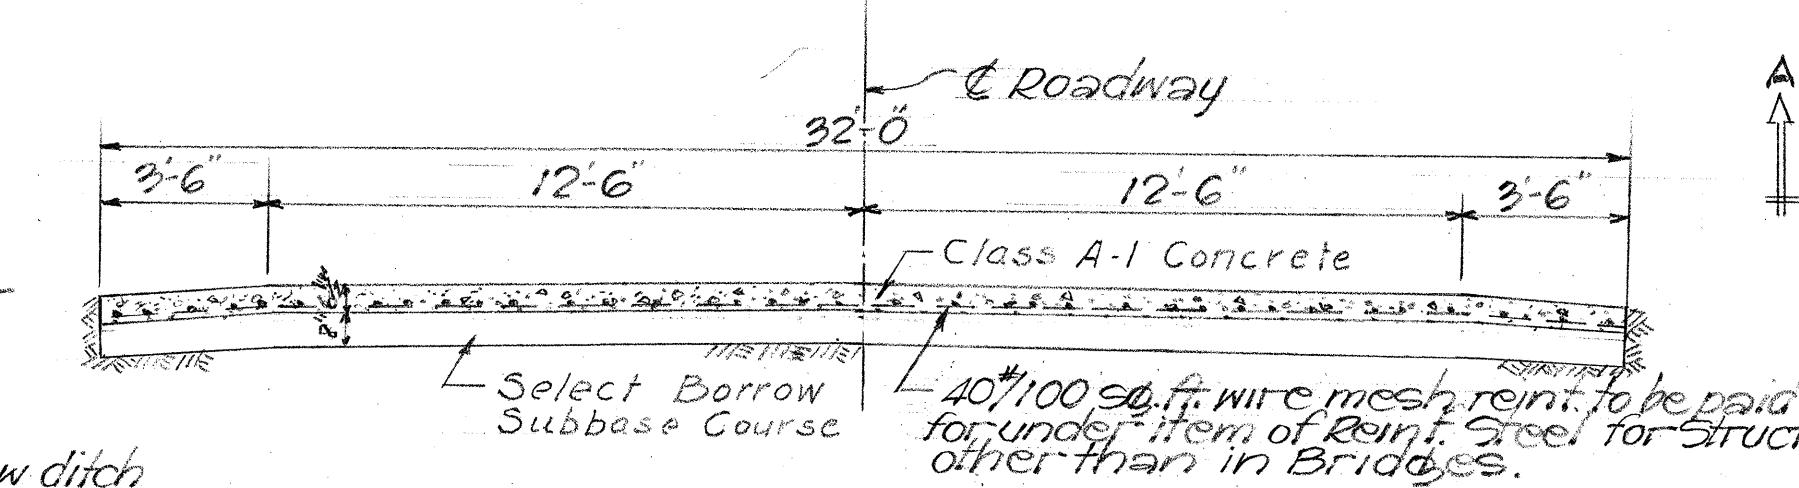

SECTION A-A
Scale: 1/2" = 1'-0"

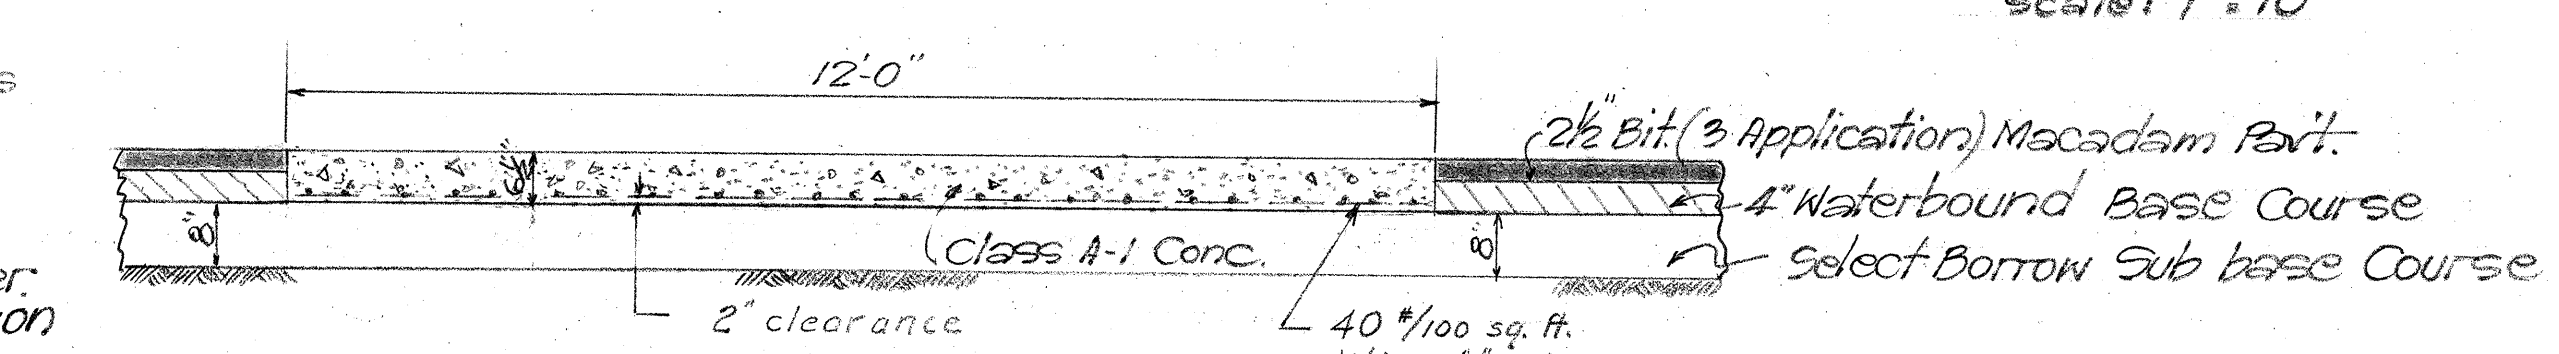


NOTE:
Tractor crossing shall conform with pavement grade, crown and shoulder slope.

SECTION B-B
Scale: 1/2" = 1'-0"


DETAIL OF TRACTOR CROSSING
Scales as noted

NOTE:
When superelevation is less than 0.06% ft. per ft. shoulder slope shall be 3/4" ft. When super is equal to or greater than 0.06% ft. per ft. shoulder slope shall be the same as the rate of super. This note applies only to the shoulder on the lower side of the super.

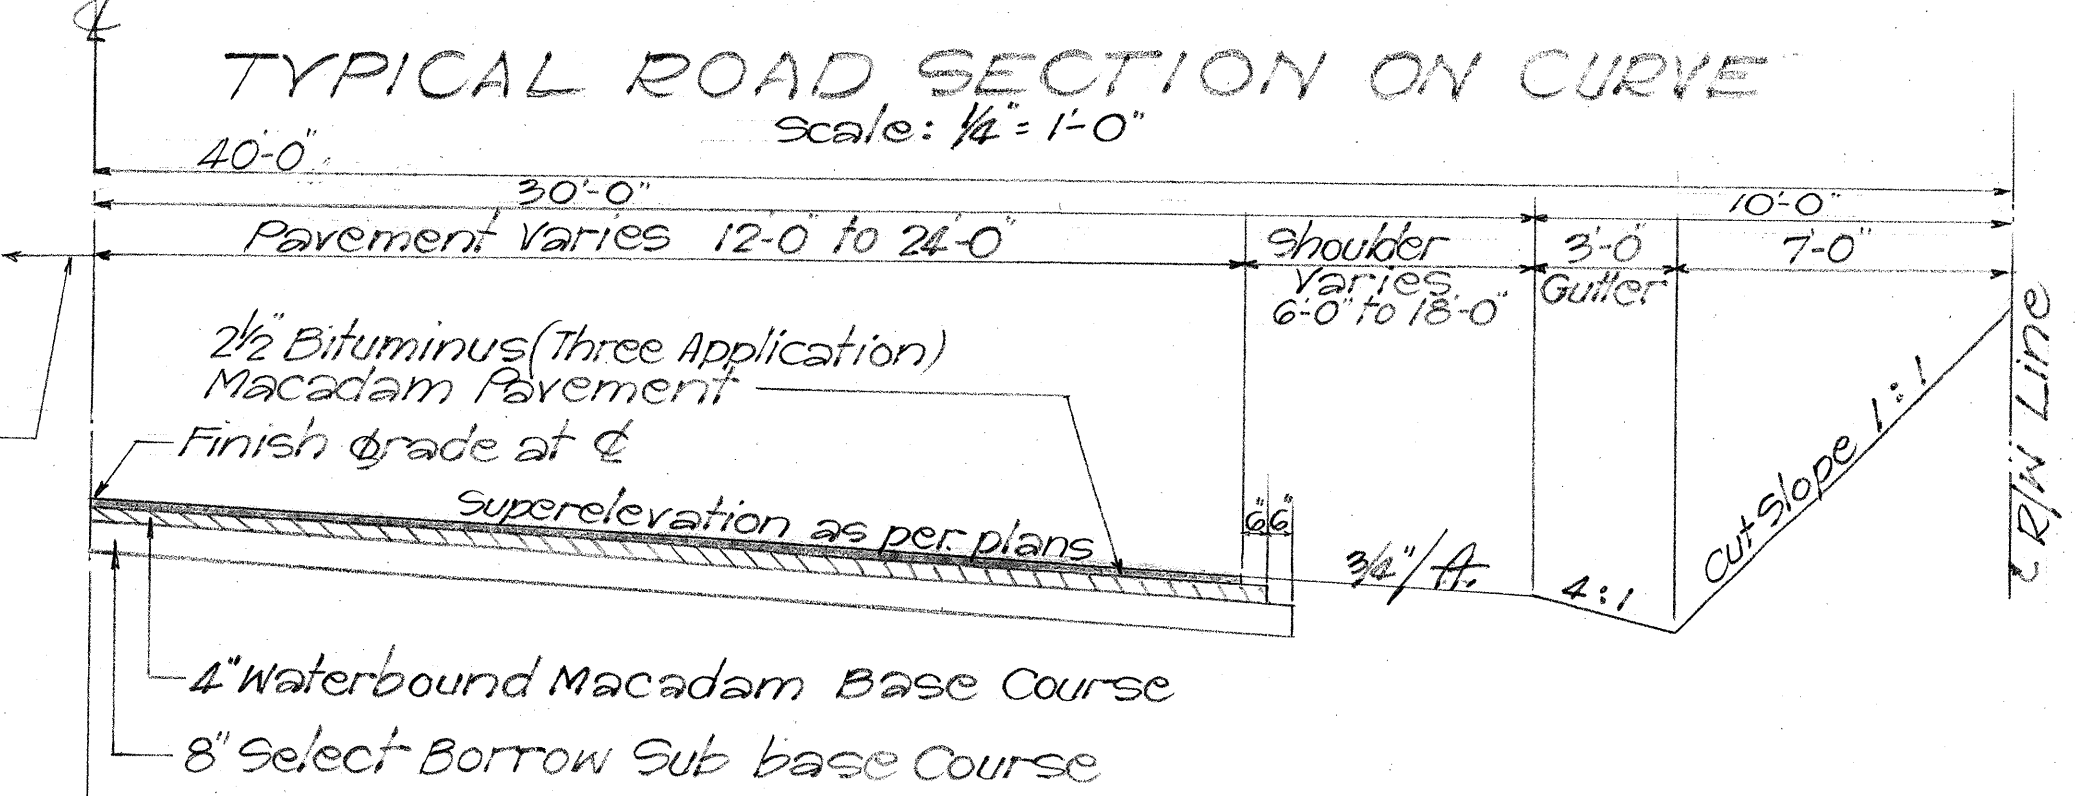

TYPICAL HALF SECTION
Sta 180+00 to Sta 194+50
Scale: 1/4" = 1'-0"

2 1/2" Bituminous Macadam Pavement (Compact thickness):
Coarse Rock (Size No 3-2" to 3/4")
1.25 gal./sq. Bituminous Binder (85-100 Penetration hot Asphalt)
Approx. 0.01 cu./sq. Keystone (Size No. 6-3/4" to 3/8")
0.40 gal./sq. Bituminous Binder
Approx. 0.006 cu./sq. Chips (Size No. 8-3/8" to #4)
0.20 gal./sq. Bituminous Binder
Approx. 0.004 cu./sq. Rock Sand (Size No. 9-4" to #6)
4" Waterbound Macadam Base Course:
To be placed in one layer of 4" compacted thickness consisting of Mineral Aggregate, Coarse Rock Size No. 2-2 1/2" to 3/4")
Filled with Filler - 1/2" to #100
8" Select Borrow Sub base Course
To be placed in one layer of 8" compacted thickness consisting of Select Borrow Material (Cinders) reasonably graded from coarse to fine with maximum size not greater than 6"
All above courses subject to Specifications and Special Provisions

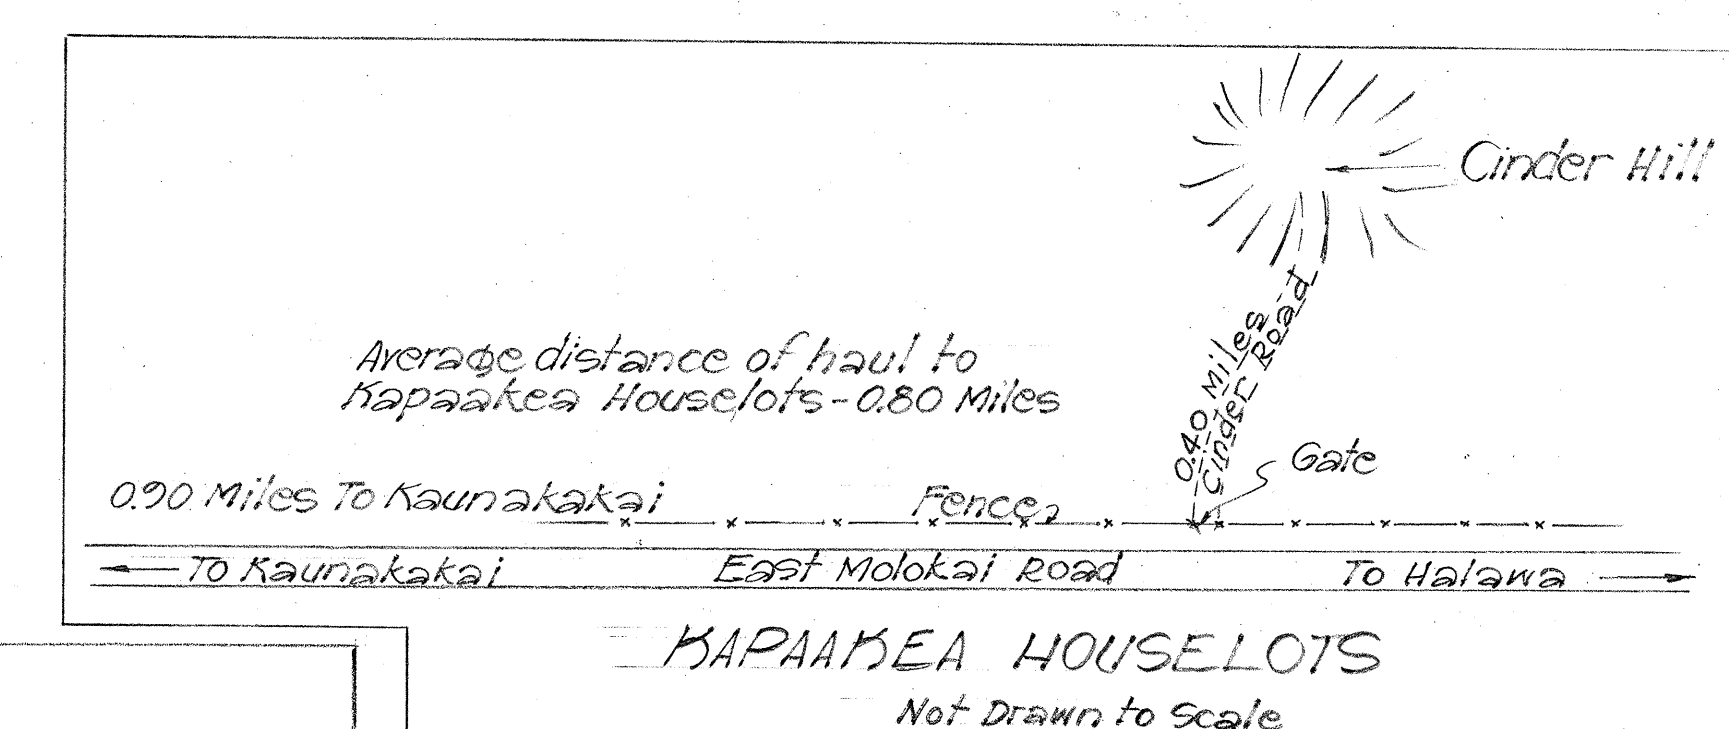

TERRITORIAL HIGHWAY DEPARTMENT
TERRITORY OF HAWAII
TYPICAL SECTIONS
MOLOKAI AIRPORT ROAD
FED AID PROJ. NO. FO46(1)