

INDEX TO DRAWINGS	
SHEET NO.	DESCRIPTION
1	TITLE SHEET
2	TYPICAL SECTION

CONVENTIONAL SIGNS USED	
Boundary Lines	
Bridge	
Centerline	 3.5
Centerline Monument	 2 Mon.
Circular Pipe Culvert	
Electric Pole	 0.22
Existing Road	
Fences	
Telephone Pole	 0.72
Warning & Regulatory Signs	 14-1 14-1 (Type)

TERRITORY OF HAWAII

TERRITORIAL HIGHWAY DEPARTMENT

HONOLULU, T.H.



PLANS FOR

SEAL COATING MAUNALOA ROAD

DISTRICT OF MOLOKAI

COUNTY OF MAUI

ISLAND OF MOLOKAI

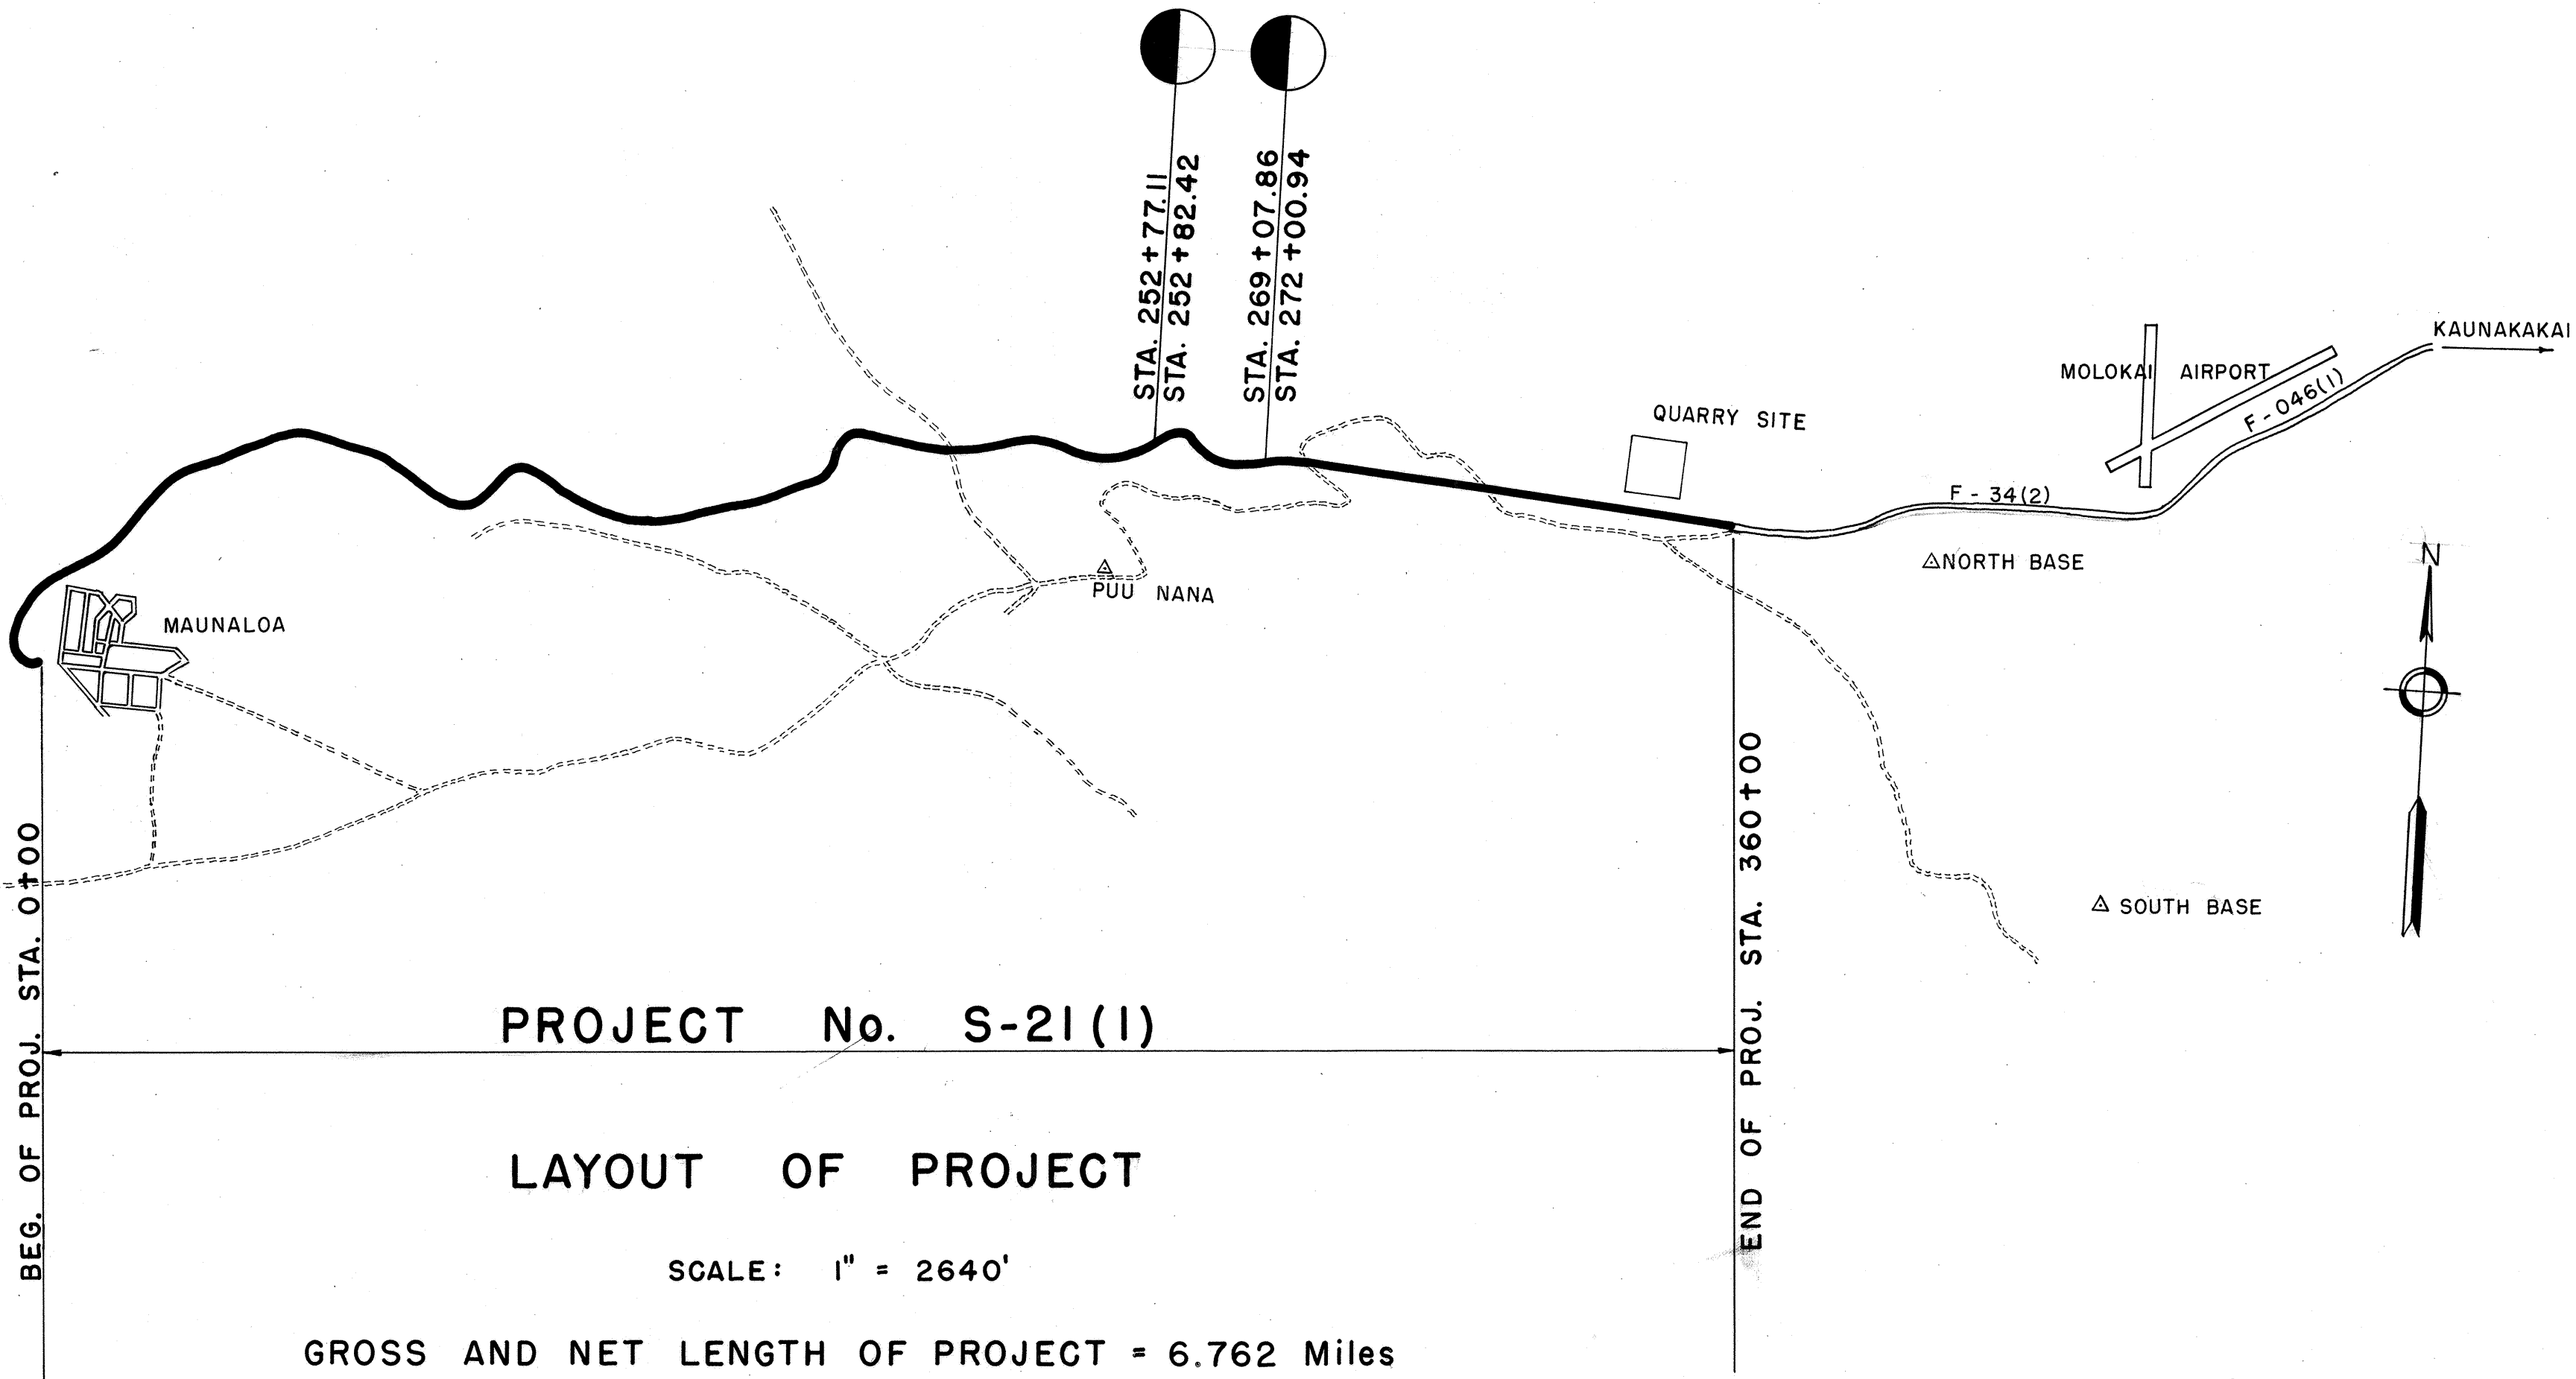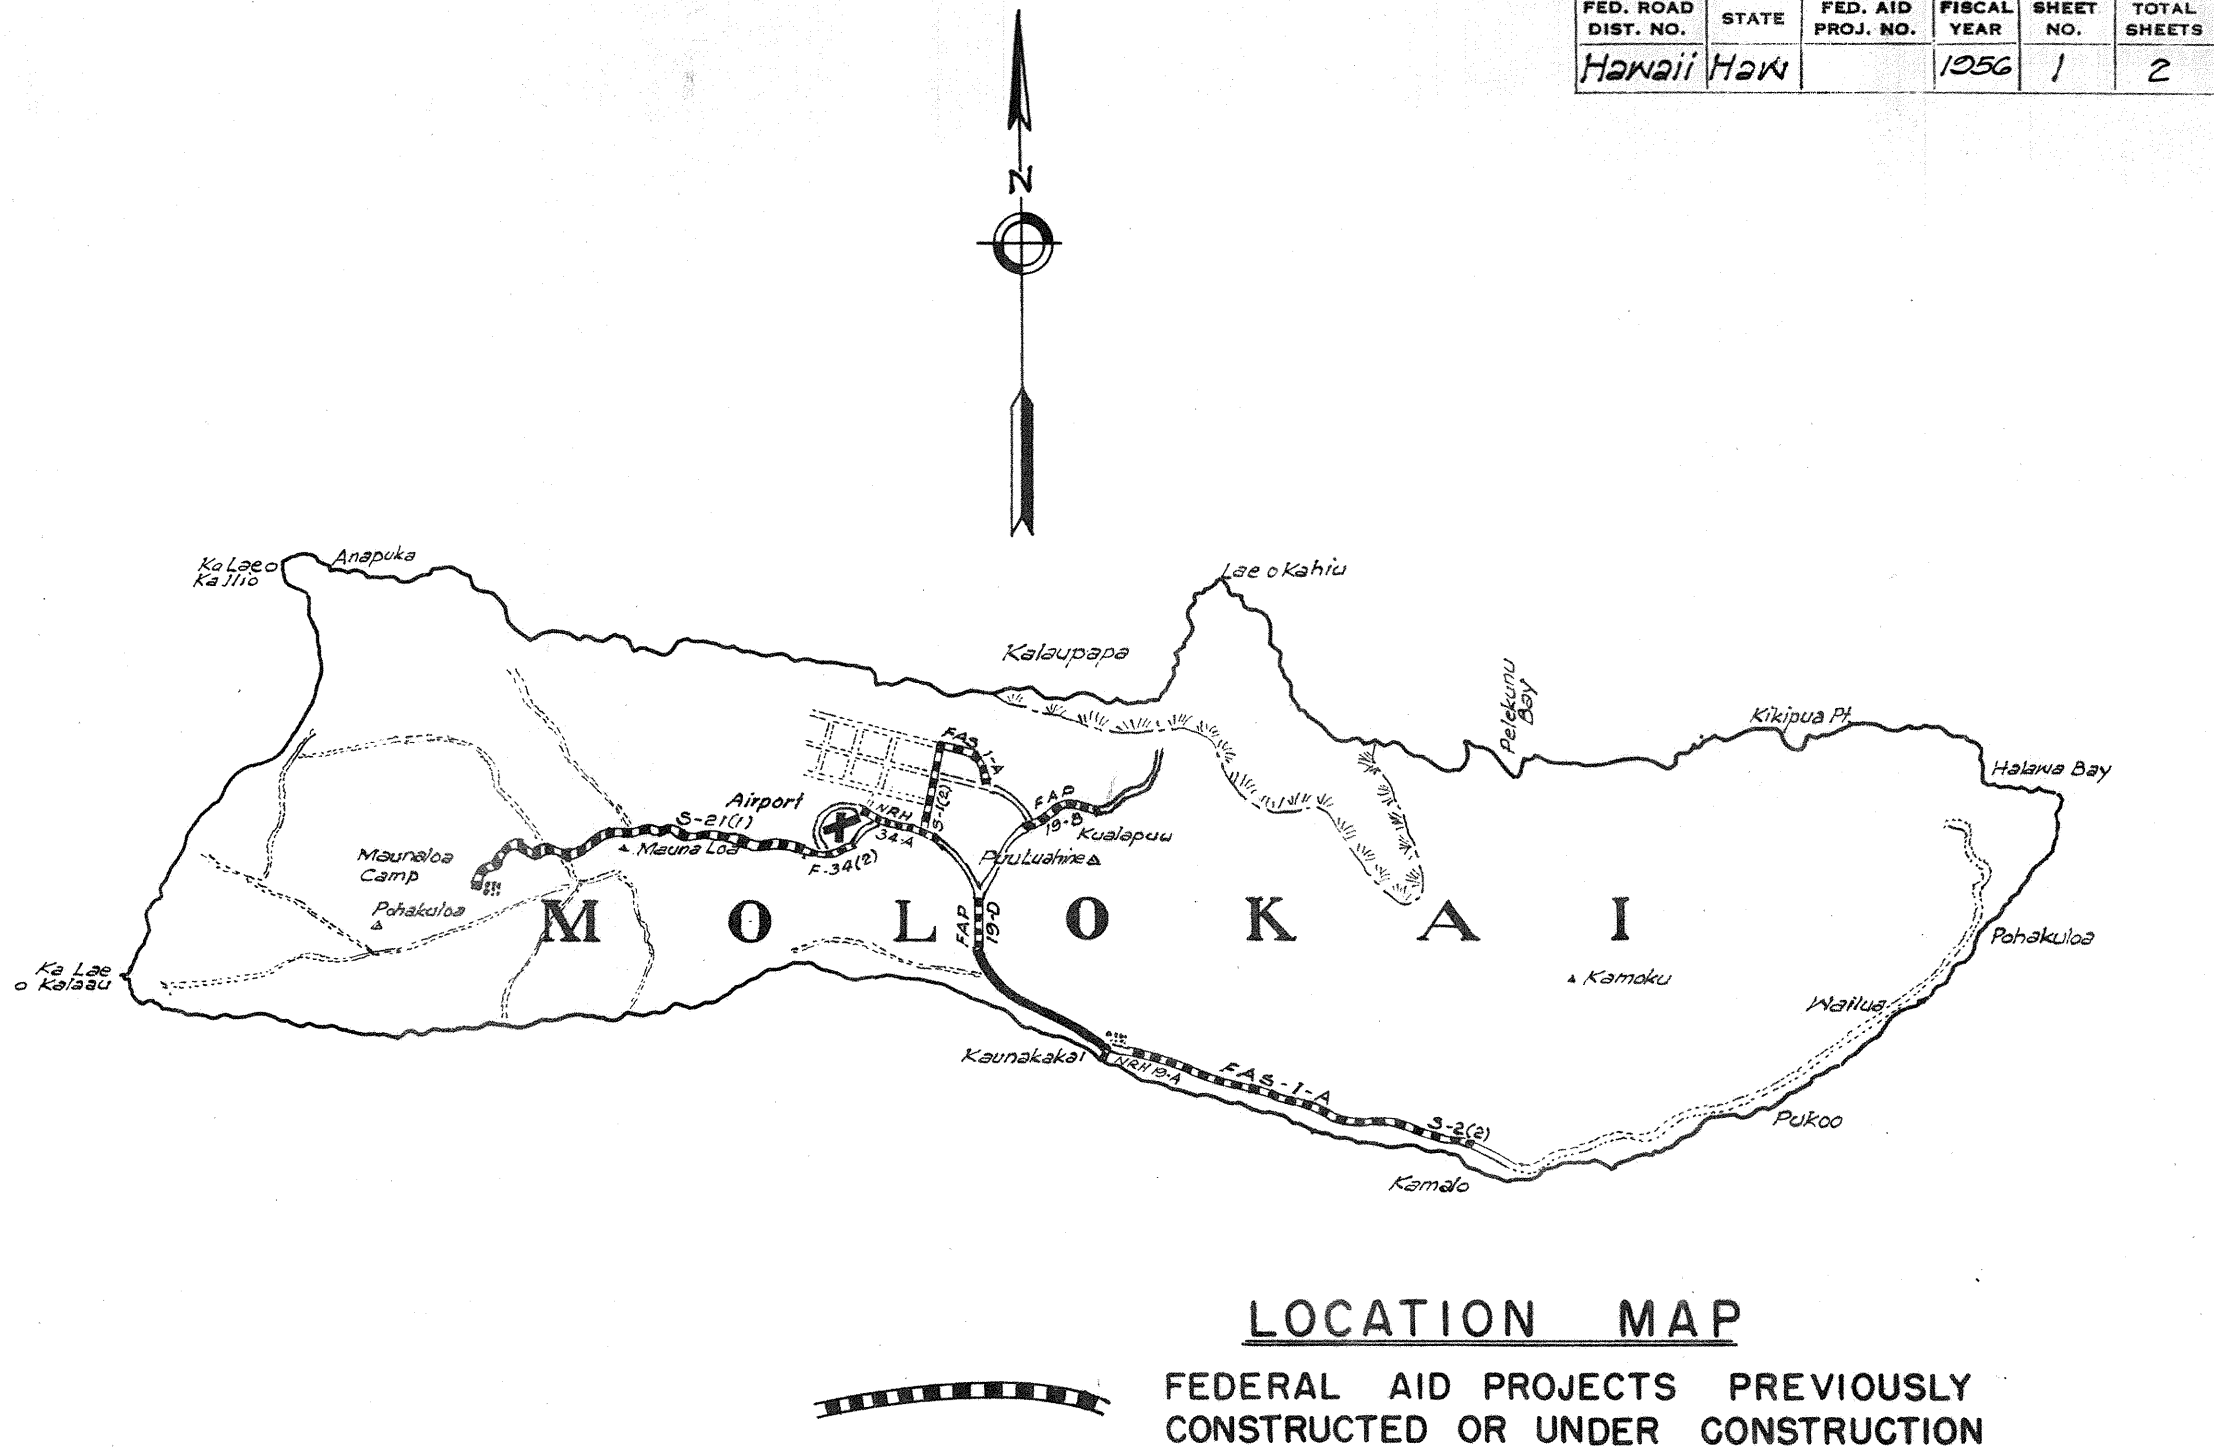

APPROVED: DATE 10/16/56

TERRITORIAL HIGHWAY ENGINEER