
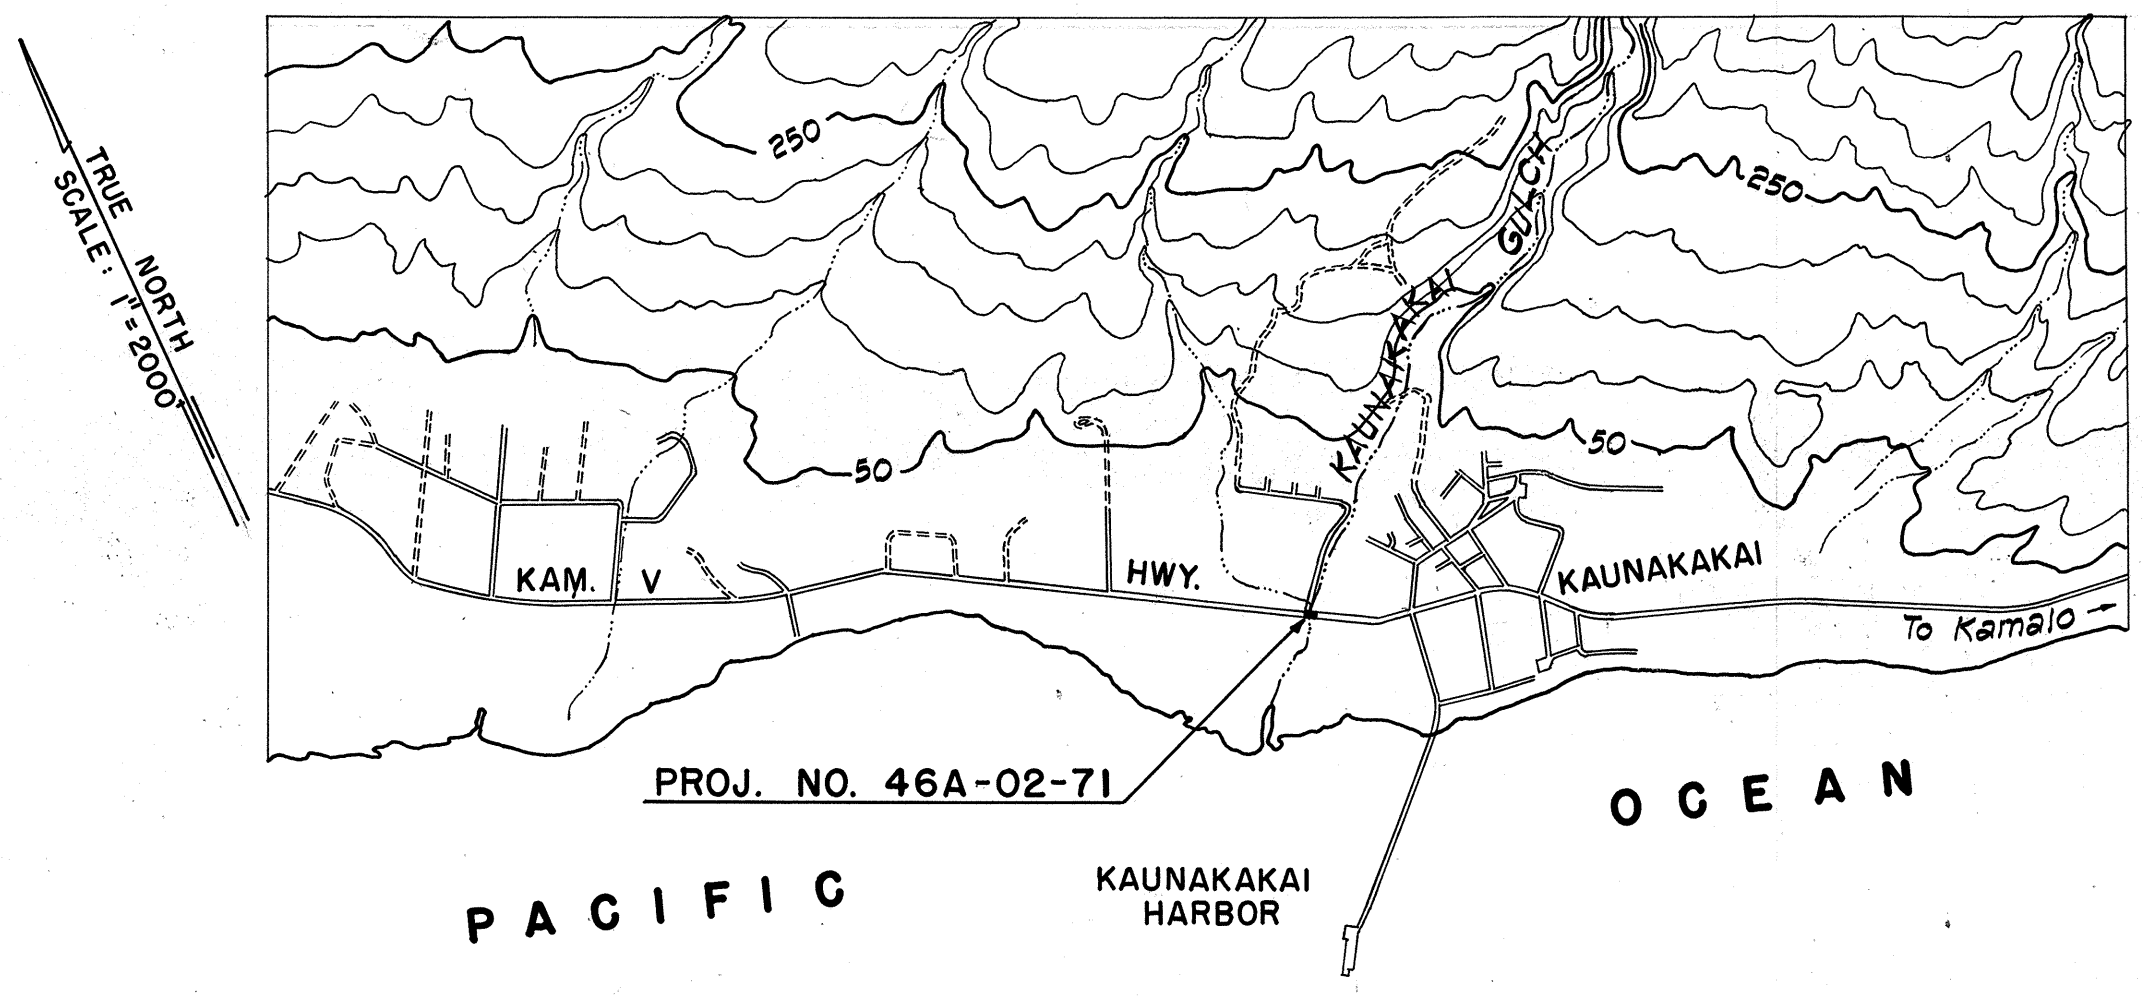


INDEX TO DRAWINGS	
SHEET NO.	DESCRIPTION
1	TITLE SHEET
2	PLAN & PROFILE
3	DETAILS
4	CROSS SECTION
5	PROJECT INFORMATION SIGN

STATE OF HAWAII
DEPARTMENT OF TRANSPORTATION
HIGHWAYS DIVISION
"AS BUILT"
PLANS FOR
KAMEHAMEHA V HIGHWAY, MOLOKAI
INSTALLATION OF CULVERTS AT KAUNAKAKAI STREAM
PROJECT NO. 46A-02-71
DISTRICT OF MOLOKAI
COUNTY OF MAUI
ISLAND OF MOLOKAI

FED. ROAD DIST. NO.	STATE	PROJ. NO.	FISCAL YEAR	SHEET NO.	TOTAL SHEETS
HAWAII	HAW.	46A-02-71	1971	1	5

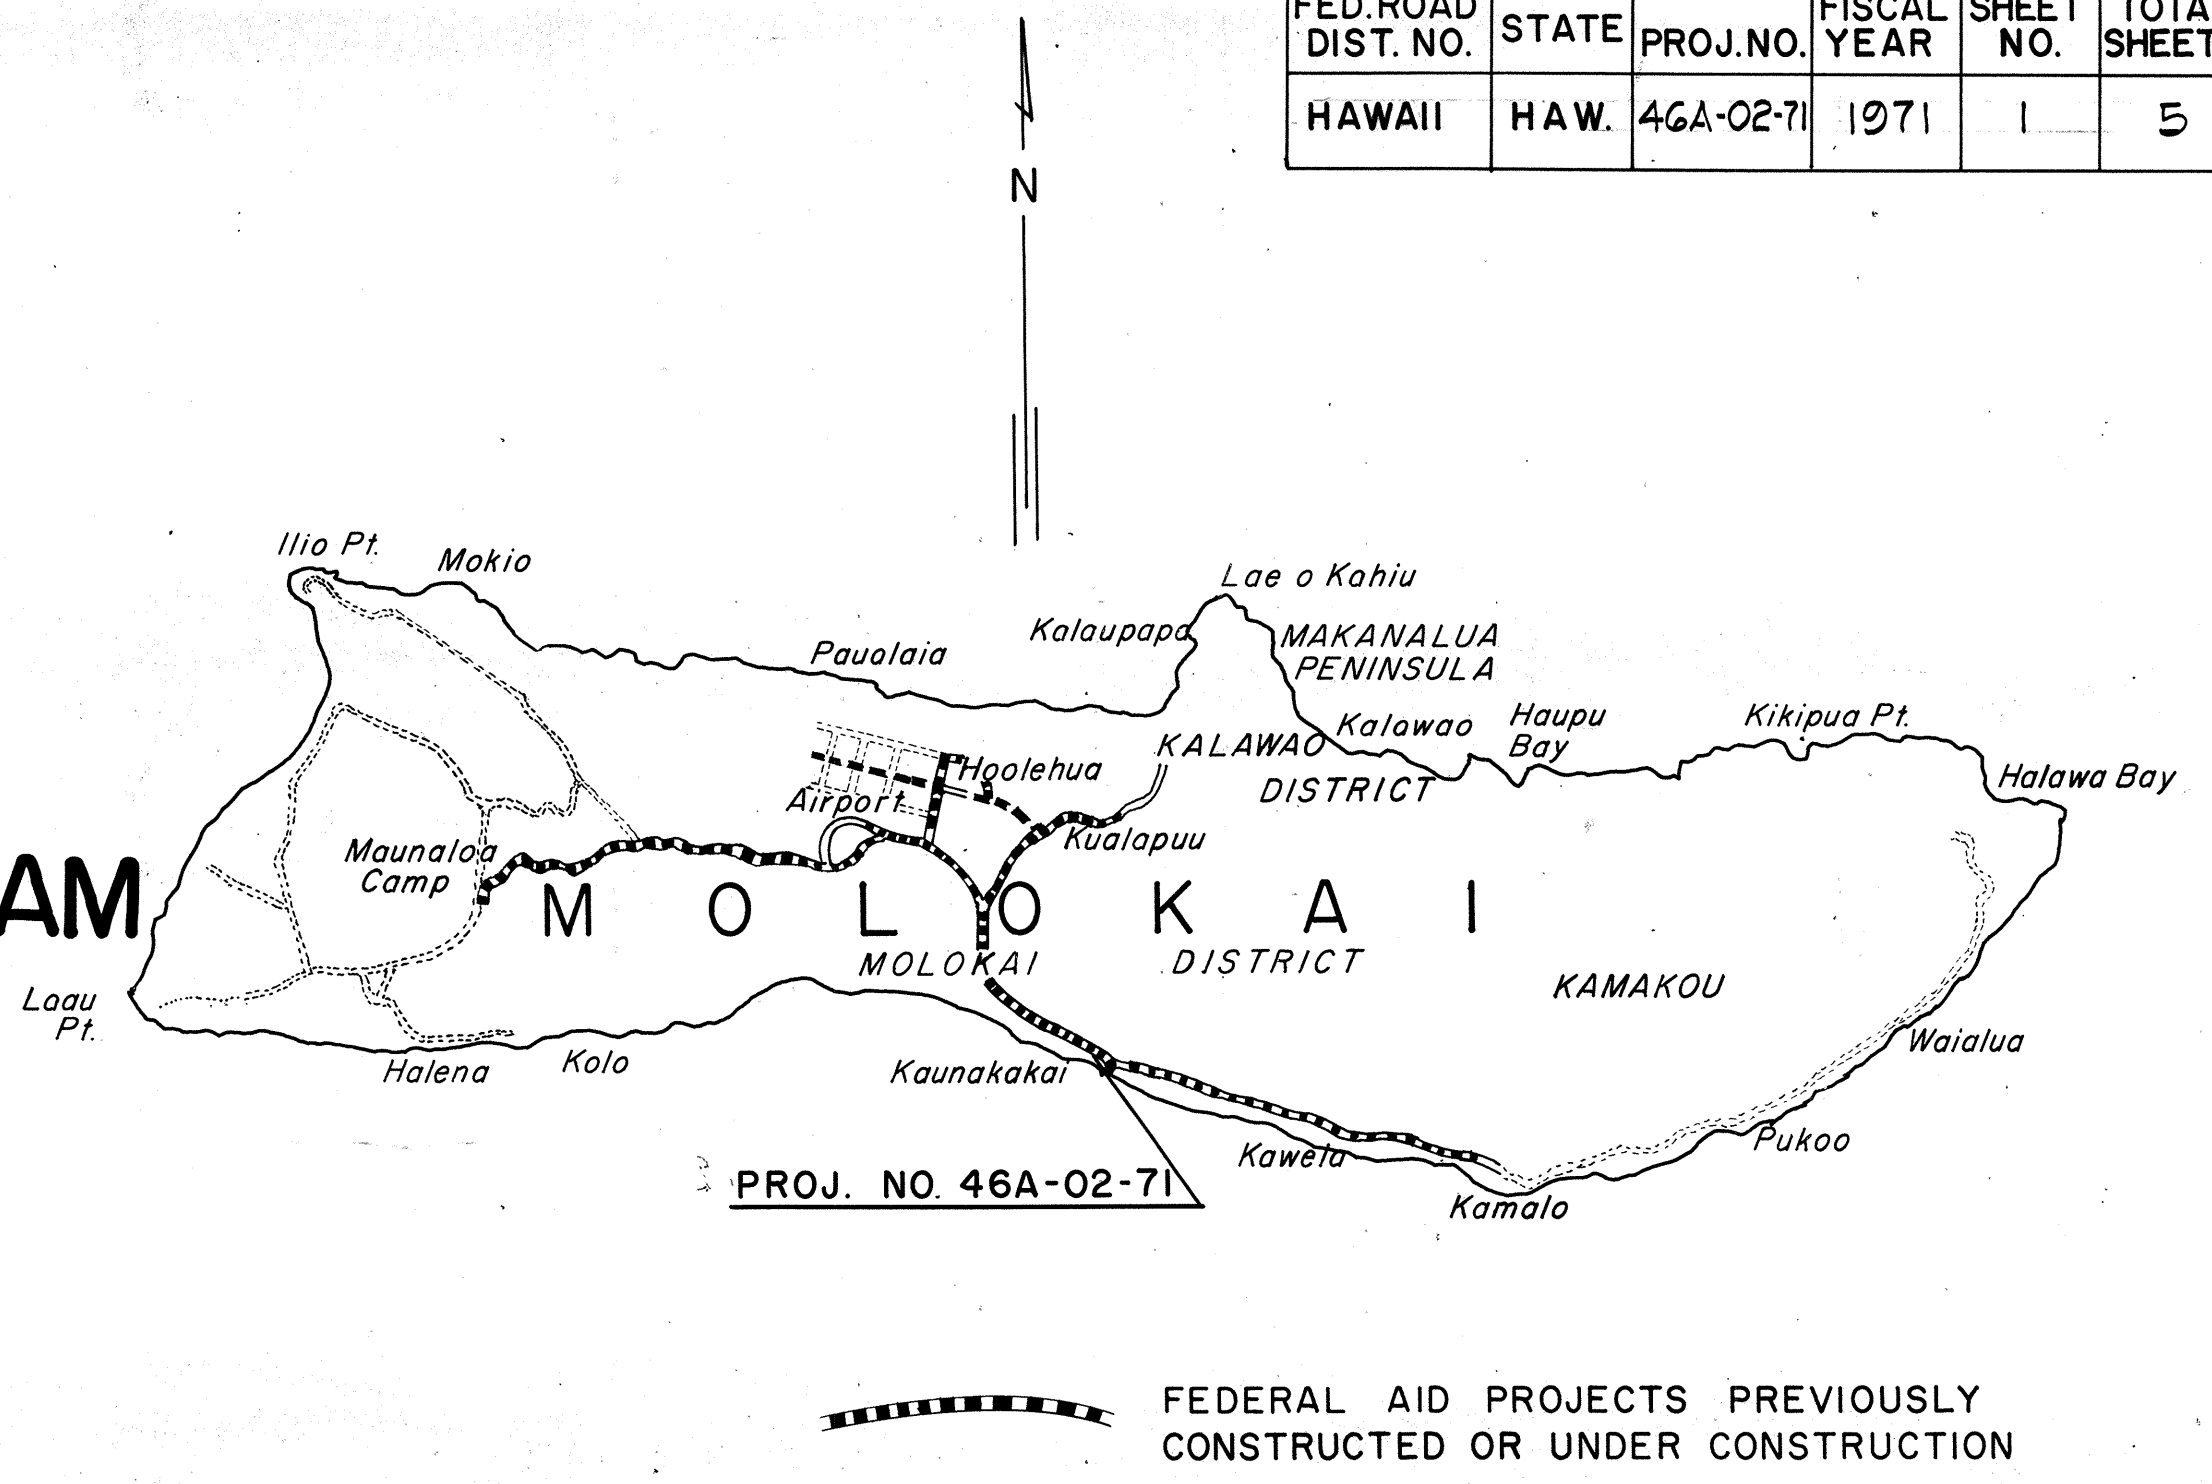

LAYOUT OF PROJECT

NOTE:
ALL CHANGES MADE DURING CONSTRUCTION
HAVE BEEN NOTED IN RED ON THESE TRAC-
INGS AND CHECKED BY:
Katsumi Nakamoto 8/25/71
PROJECT ENGINEER DATE

DEPARTMENT OF TRANSPORTATION STATE OF HAWAII	
APPROVED: <i>E. Alvey Wright</i> for DIR. OF TRANSPORTATION	2/4/71 DATE

DESIGNED BY: MAUI DISTRICT OFFICE
STATE HIGHWAYS DIVISION
DATE: NOV. 1970
P.S. & E. BY: RONALD TSUZUKI
PHONE: 548-7490
DATE: JAN. 1971