


FED. ROAD DIST. NO.	STATE	FED. AID PROJ. NO.	FISCAL YEAR	SHEET NO.	TOTAL SHEETS
HAWAII	HAW.	RS-0460(1)	1978	4	23

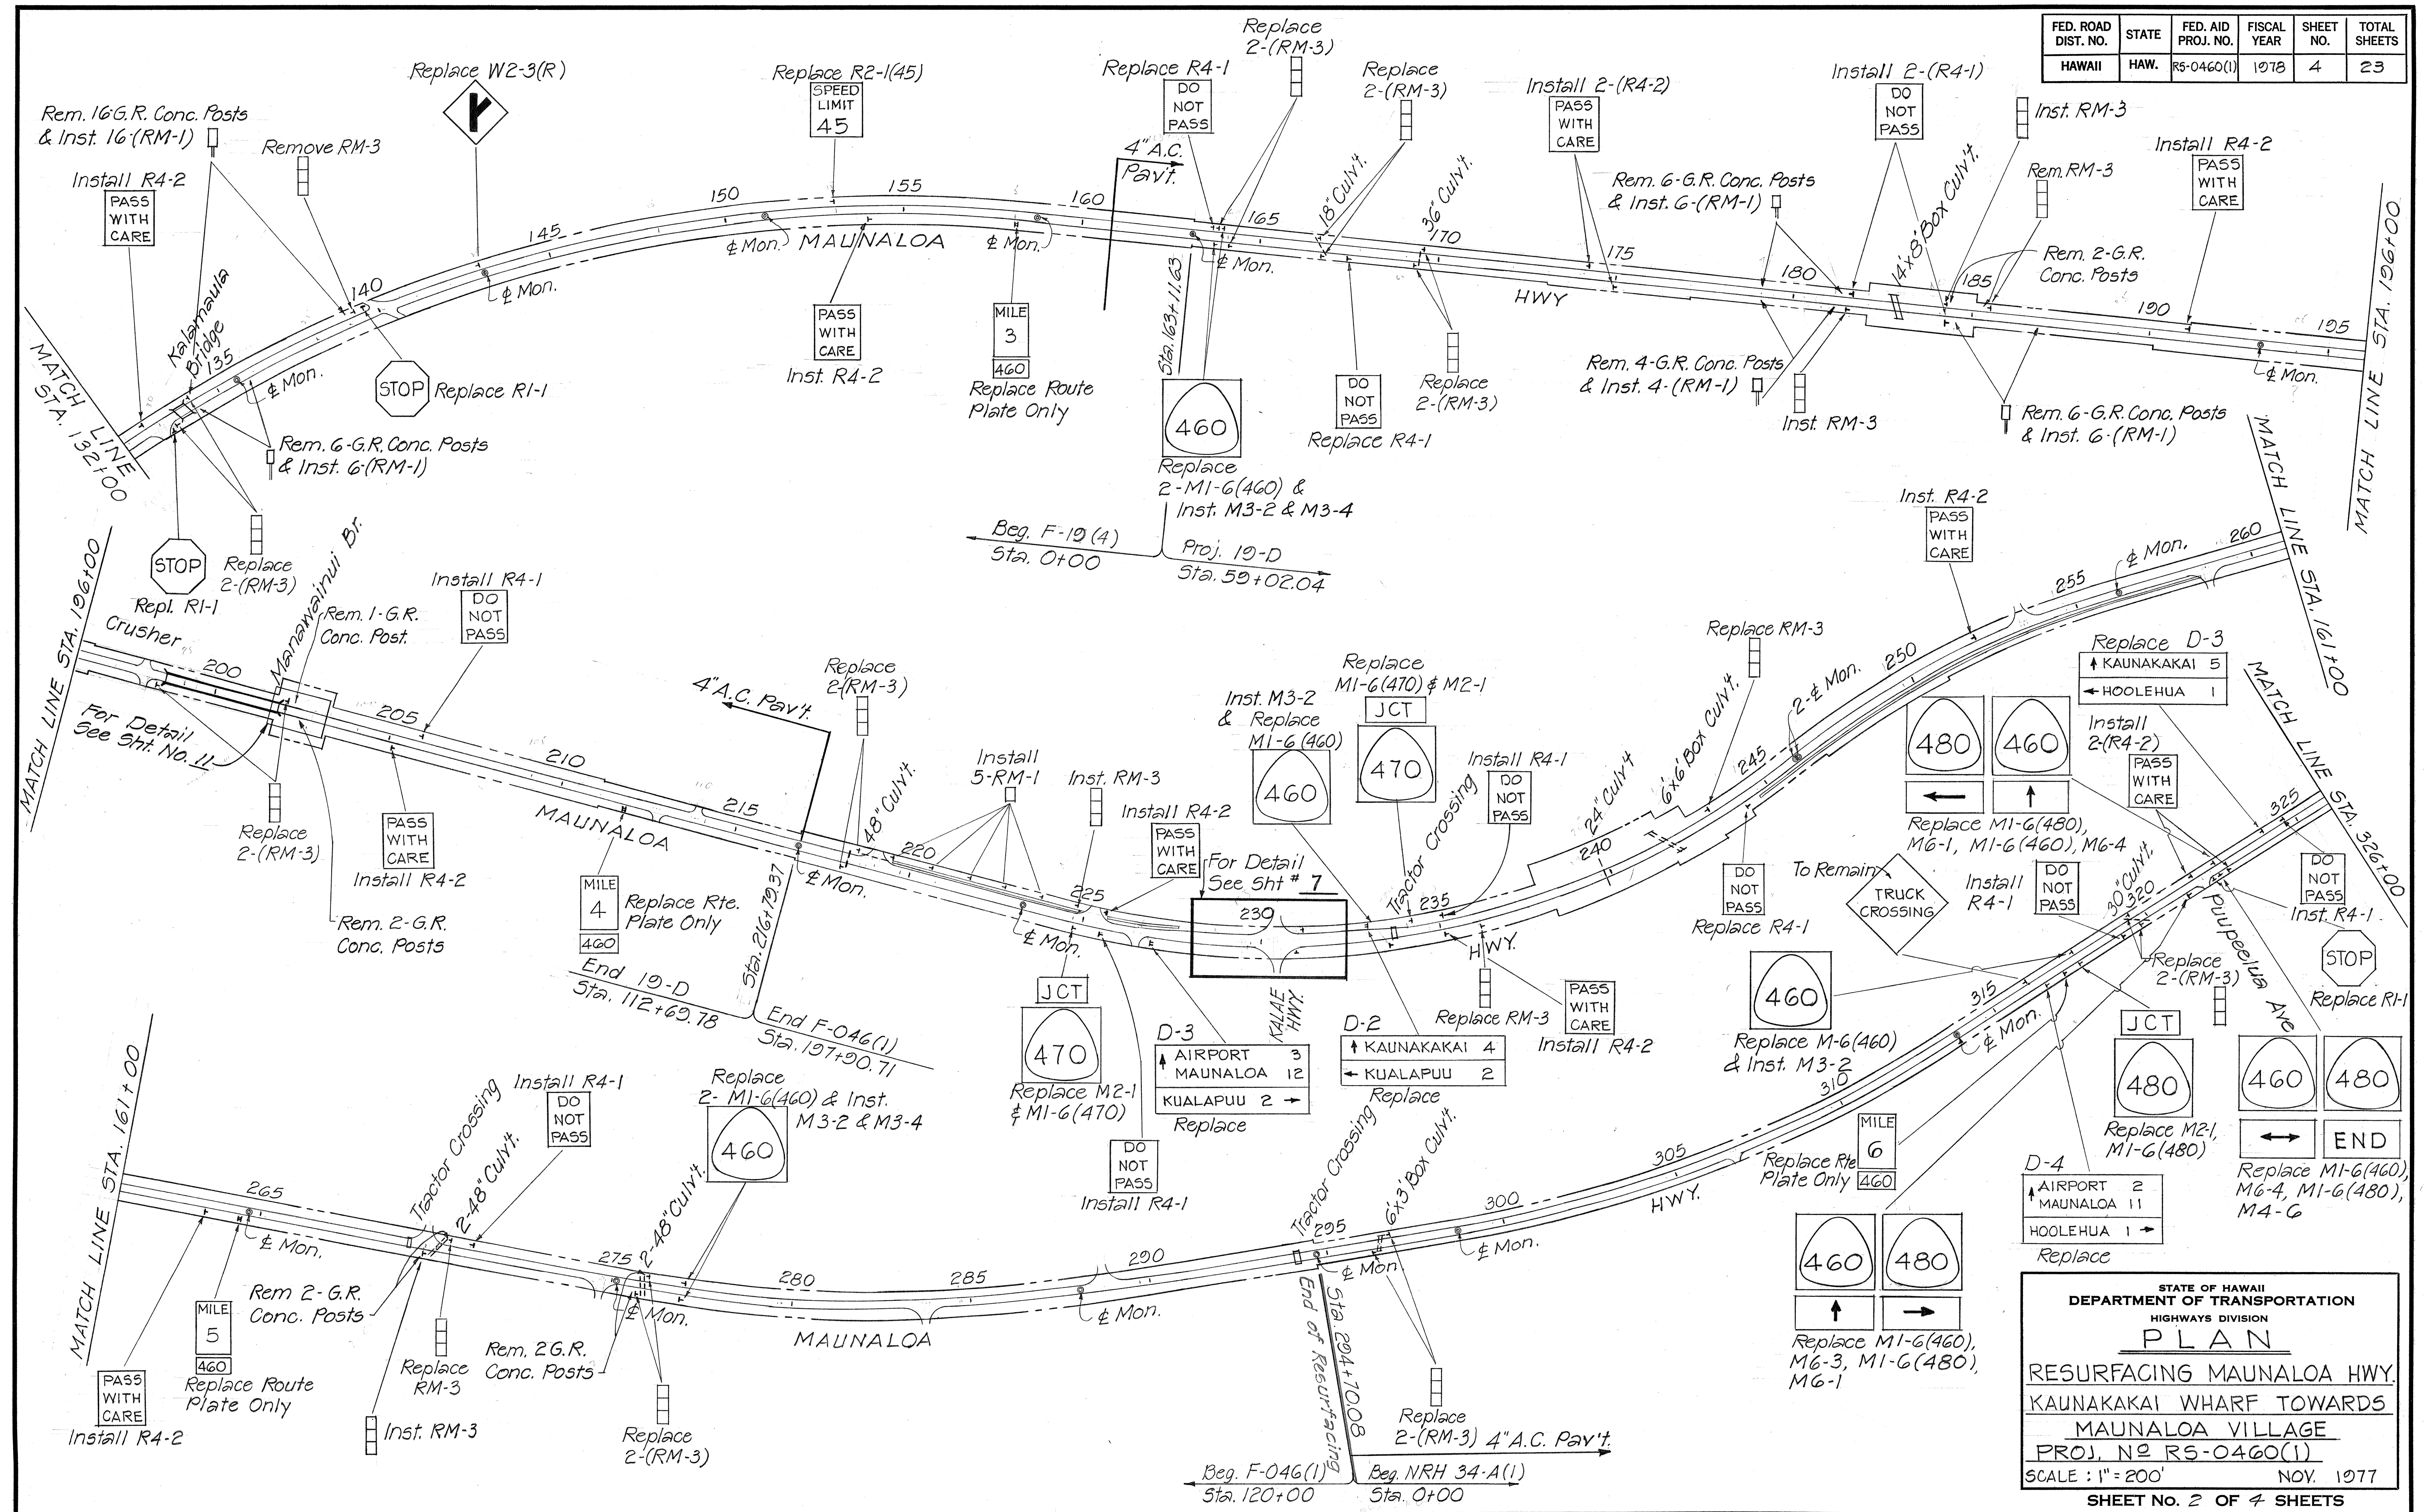

DATE	_____
SURVEY PLOTTED BY	_____
DRAWN BY	_____
CHECKED BY	_____
ORIGINAL PLAN	_____
NOTE BOOK	_____
NO.	_____


STATE OF HAWAII
DEPARTMENT OF TRANSPORTATION
HIGHWAYS DIVISION

PLAN

RESURFACING MAUNALOA HWY.
KAUNAKAKAI WHARF TOWARDS
MAUNALO VILLAGE
PROJ. NO RS-0460(1)
SCALE: 1"=200' NOV. 1977

SHEET NO. 2 OF 4 SHEETS


FED. ROAD DIST. NO.	STATE	FED. AID PROJ. NO.	FISCAL YEAR	SHEET NO.	TOTAL SHEETS
HAWAII	HAW.	RS-0460(1)	1978	5	23

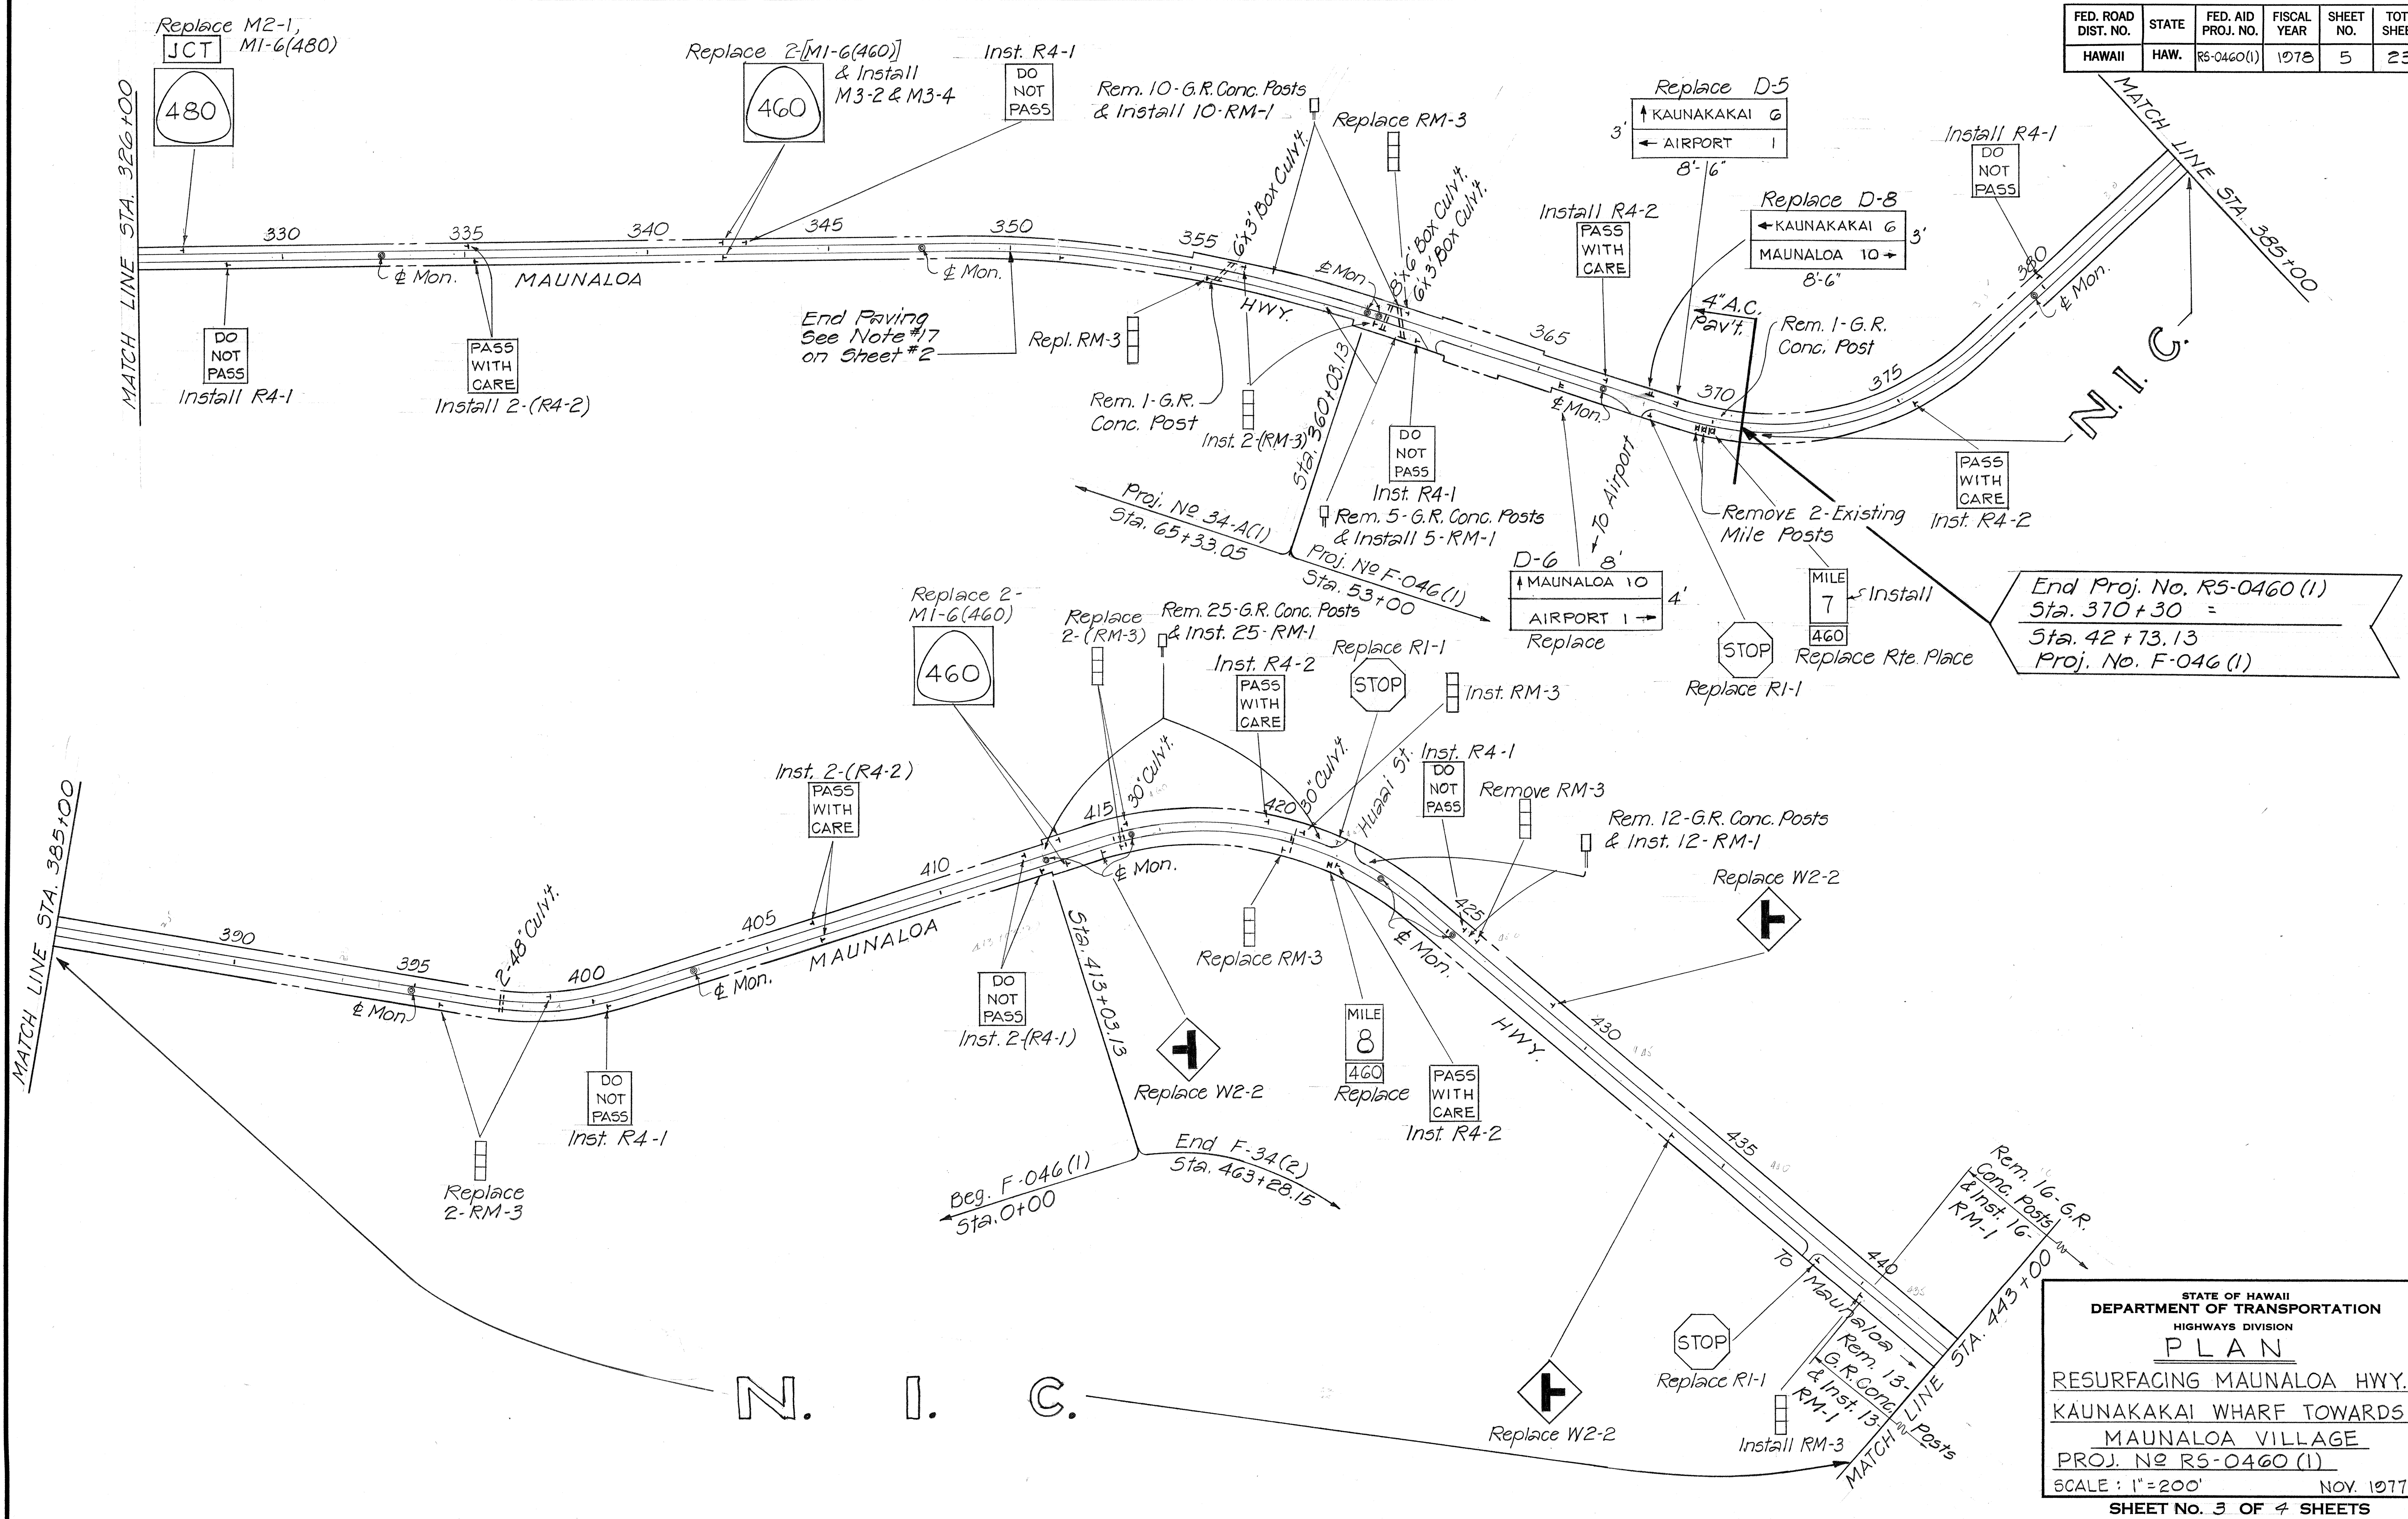

ORIGINAL PLAN	DATE
SURVEY PLOTTED BY	
DRAWN BY	
DESIGNED BY	
QUANTITIES BY	
CHECKED BY	
NO.	

STATE OF HAWAII
DEPARTMENT OF TRANSPORTATION
HIGHWAYS DIVISION
PLAN
RESURFACING MAUNALOA HWY.
KAUNAKAKAI WHARF TOWARDS
MAUNALOA VILLAGE
PROJ. NO R5-0460(1)
SCALE: 1"=200' NOV. 1977
SHEET NO. 3 OF 4 SHEETS

FED. ROAD DIST. NO.	STATE	FED. AID PROJ. NO.	FISCAL YEAR	SHEET NO.	TOTAL SHEETS
HAWAII	HAW.	RS-0460(1)	1978	6	23

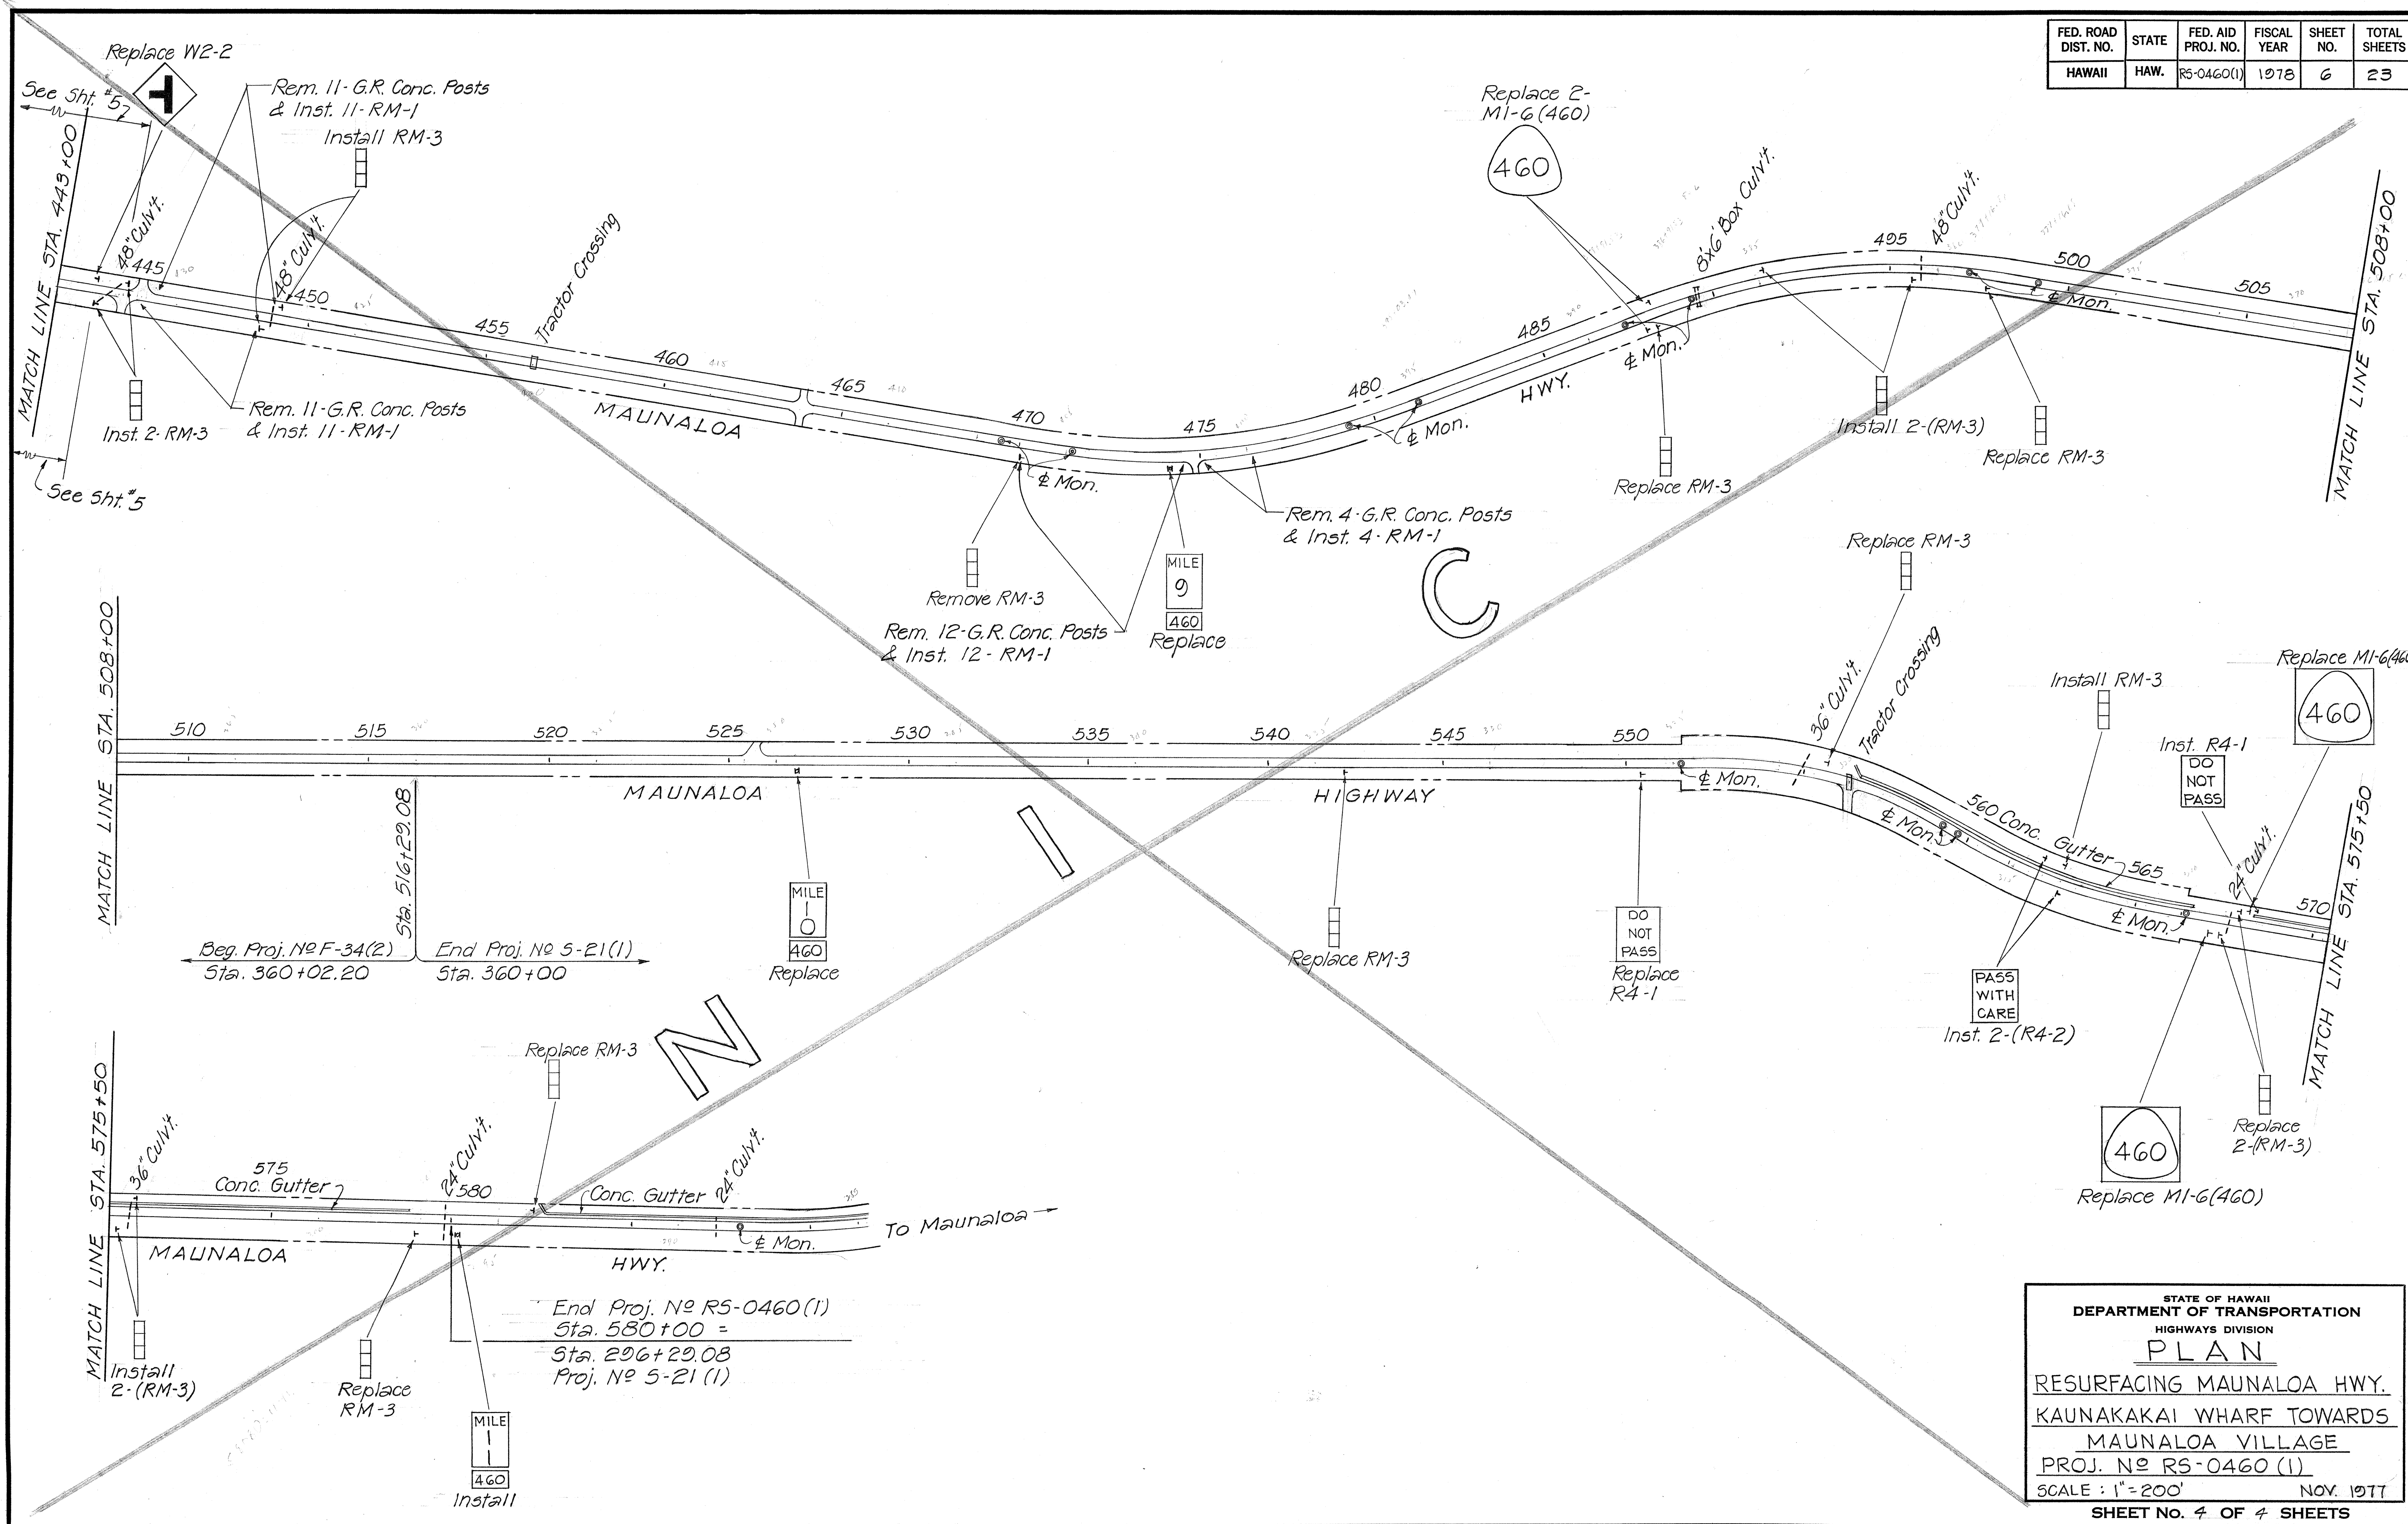

STATE OF HAWAII
DEPARTMENT OF TRANSPORTATION
HIGHWAYS DIVISION
PLAN
RESURFACING MAUNALOA HWY.
KAUNAKAKAI WHARF TOWARDS
MAUNALOA VILLAGE
PROJ. NO RS-0460 (1)
SCALE : 1"=200' NOV. 1977
SHEET No. 4 OF 4 SHEETS

ORIGINAL PLAN	DATE
DESIGNED BY	
TRACED BY	
NOTED BY	
CHECKED BY	