


FED. ROAD DIST. NO.	STATE	FED. AID PROJ. NO.	FISCAL YEAR	SHEET NO.	TOTAL SHEETS
HAWAII	HAW.	RS-0460(1)	1978	9	23


NOTE:
See Plan Sheet No. 95-1 for
"AS-BUILT" postings on "SUMMARY-
RAISED PAVEMENT MARKERS"
Schedule.

SUMMARY - RAISED PAVEMENT MARKERS


STATION TO STATION	EXISTING STRIPE	DISTANCE (Ft.)	ITEM 629.2010 TYPE J - (Ea.)	ITEM 629.2030 TYPE C - (Ea.)	ITEM 629.2040 TYPE D - (Ea.)	ITEM 629.2070 TYPE H - (Ea.)
0+00 - 10+80	Pass	1,080	108	-	28	-
10+80 - 13+30	No Pass	250	-	-	13	-
Gap - Ala Malama Rd.		50	-	-	-	-
13+80 - 17+40	No Pass	360	-	-	19	-
17+40 - 126+90	Pass	10,950	1,096	-	274	-
126+90 - 133+00	One-Way Pass	610	64	-	16	16
133+50 - 153+10	No Pass	2,010	-	-	101	-
153+10 - 161+80	One-Way Pass	870	88	-	22	22
161+80 - 166+50	Pass	470	48	-	12	-
166+50 - 173+15	One-Way Pass	665	68	-	17	17
173+15 - 180+60	One-Way Pass	745	76	-	19	19
180+60 - 183+20	Pass	260	28	-	7	-
183+20 - 190+00	One-Way Pass	680	68	-	17	17
190+00 - 204+00	No Pass	1,400	-	-	70	-
204+00 - 224+00	Pass	2,000	200	-	50	-
224+00 - 229+00	No Pass	500	-	-	25	-
Gap - Kalae Hwy.			-	-	-	-
Accel Lane	Solid	100	-	7	-	-
Decel Lane	Solid	100	-	5	-	-
Decel Lane	Solid	100	-	3	-	-
230+00 - 234+20	No Pass	420	-	-	22	-
234+20 - 243+90	Pass	970	100	-	25	-
243+90 - 251+00	One-Way Pass	710	72	-	18	18
251+00 - 262+00	No Pass	1,100	-	-	55	-
262+00 - 269+50	One-Way Pass	750	76	-	19	19
269+50 - 317+80	Pass	4,830	484	-	121	-
317+80 - 320+30	One-Way Pass	250	28	-	7	7
Gap - Puupeeelua Ave.			-	-	-	-
320+90 - 323+50	One-Way Pass	260	28	-	8	7
323+50 - 327+00	Pass	350	36	-	9	-
327+00 - 333+70	One-Way Pass	670	68	-	17	17
333+70 - 341+95	One-Way Pass	825	84	-	21	21
341+95 - 350+00	Pass	805	80	-	20	-
TOTAL			2900	15	1032	180
350+00 - 360+00	Pass	1,000	100	-	25	-
360+00 - 365+30	One-Way Pass	530	56	-	14	14
Gap - Airport						
365+50 - 373+50	No Pass	850	-	-	41	-
273+50 - 398+40	Pass	2,490	252	-	63	-
398+40 - 404+50	One-Way Pass	610	64	-	16	16
404+50 - 410+80	One-Way Pass	630	64	-	16	16
410+80 - 419+50	One-Way Pass	870	88	-	22	22
Gap - Hualalai St.						
420+00 - 423+50	One-Way Pass	350	36	-	10	9
423+50 - 553+00	Pass	12,950	1,296	-	324	-

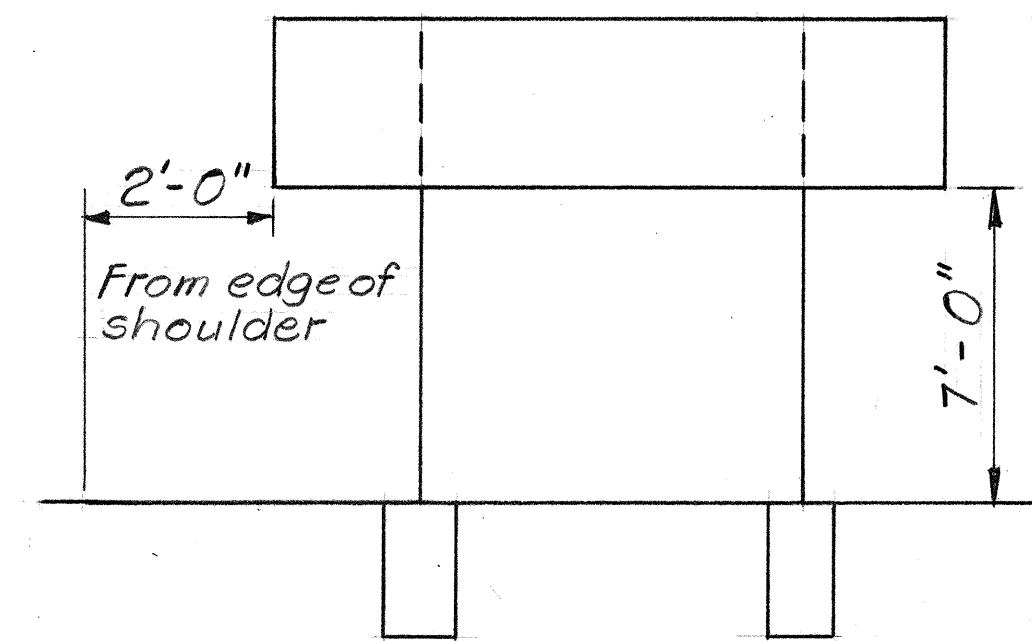


TYPICAL "D" SIGN LAYOUT
No Scale

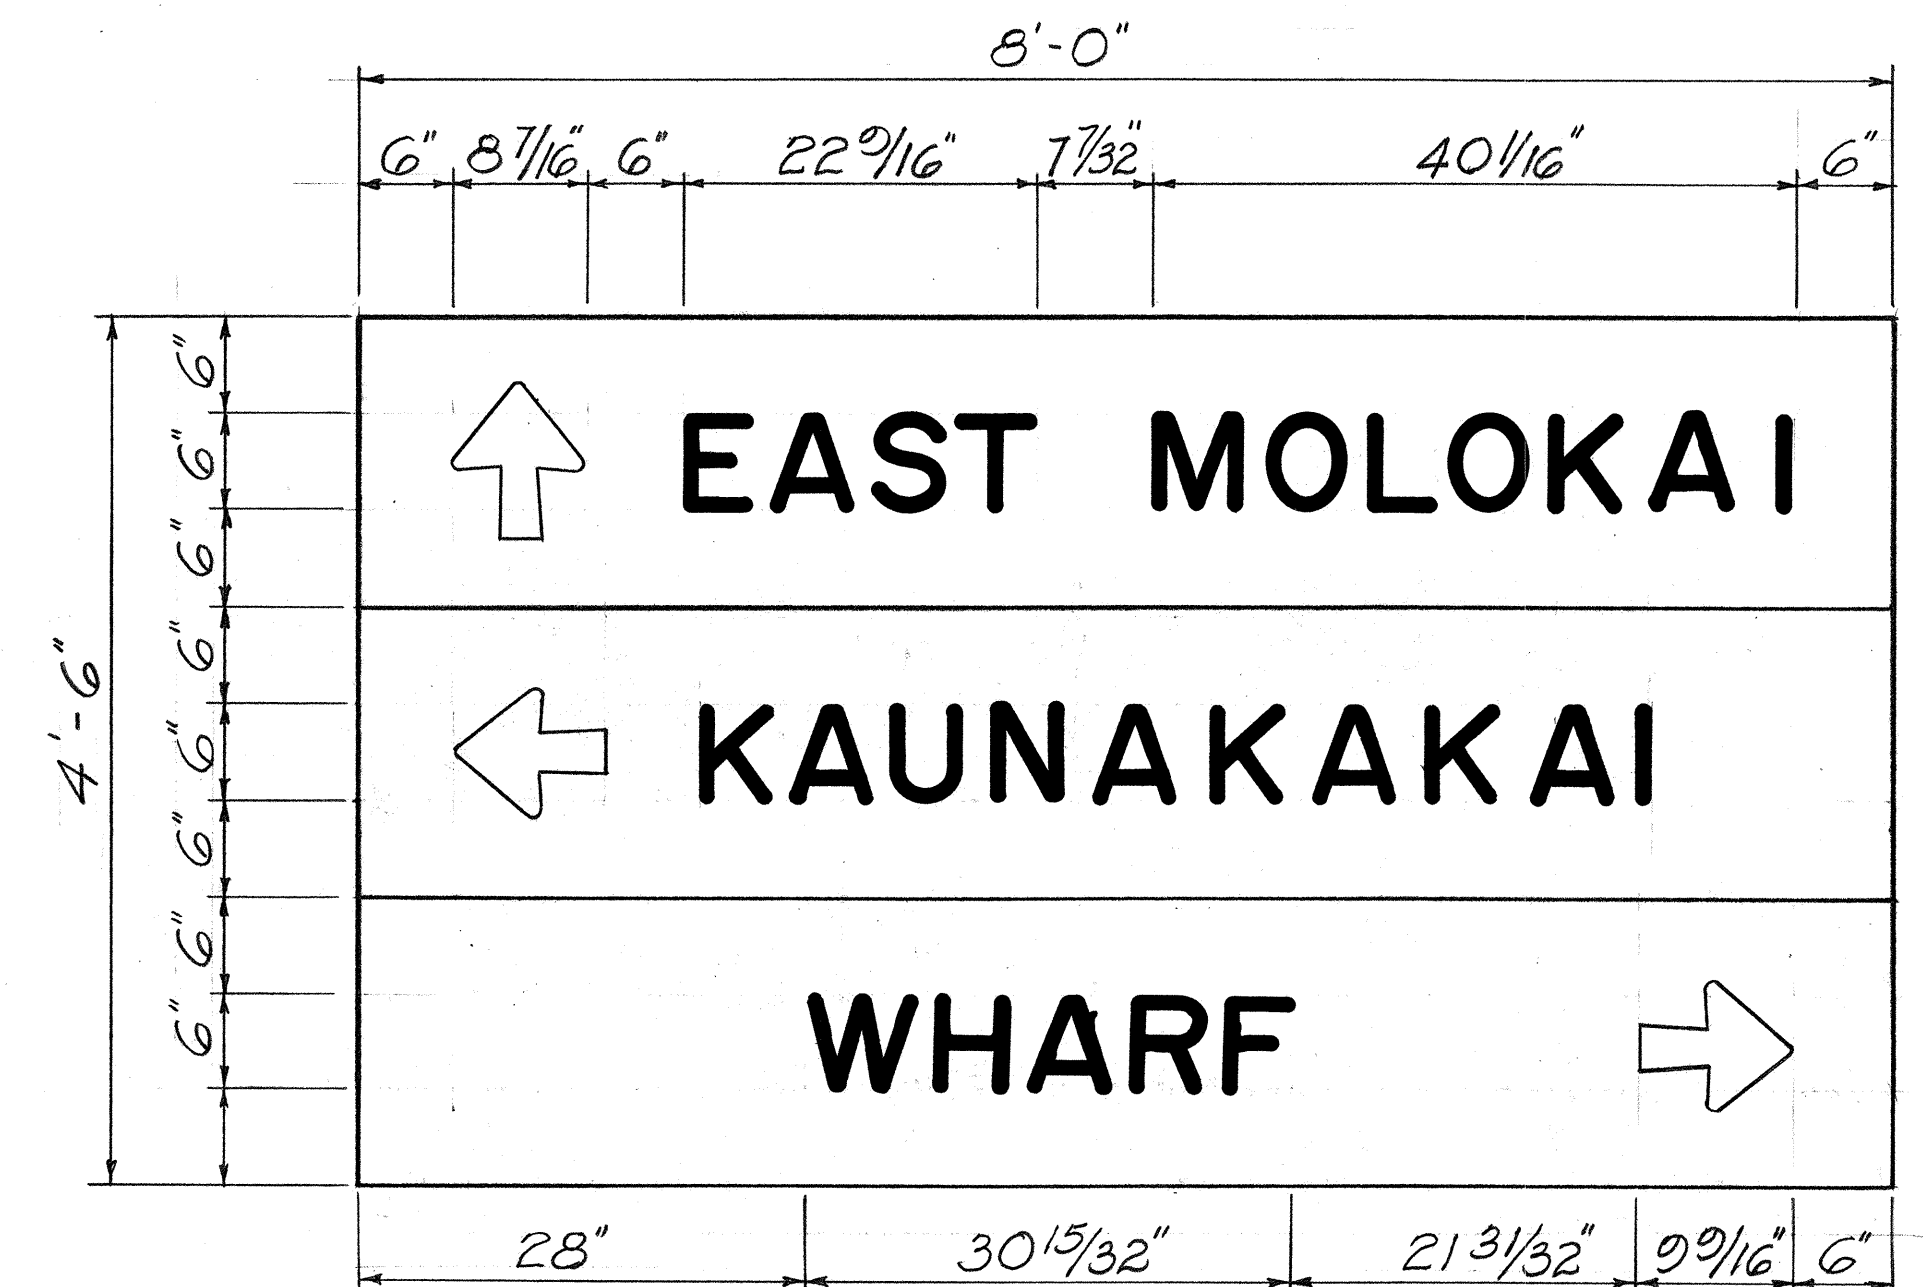

SIGN D-7
No Scale

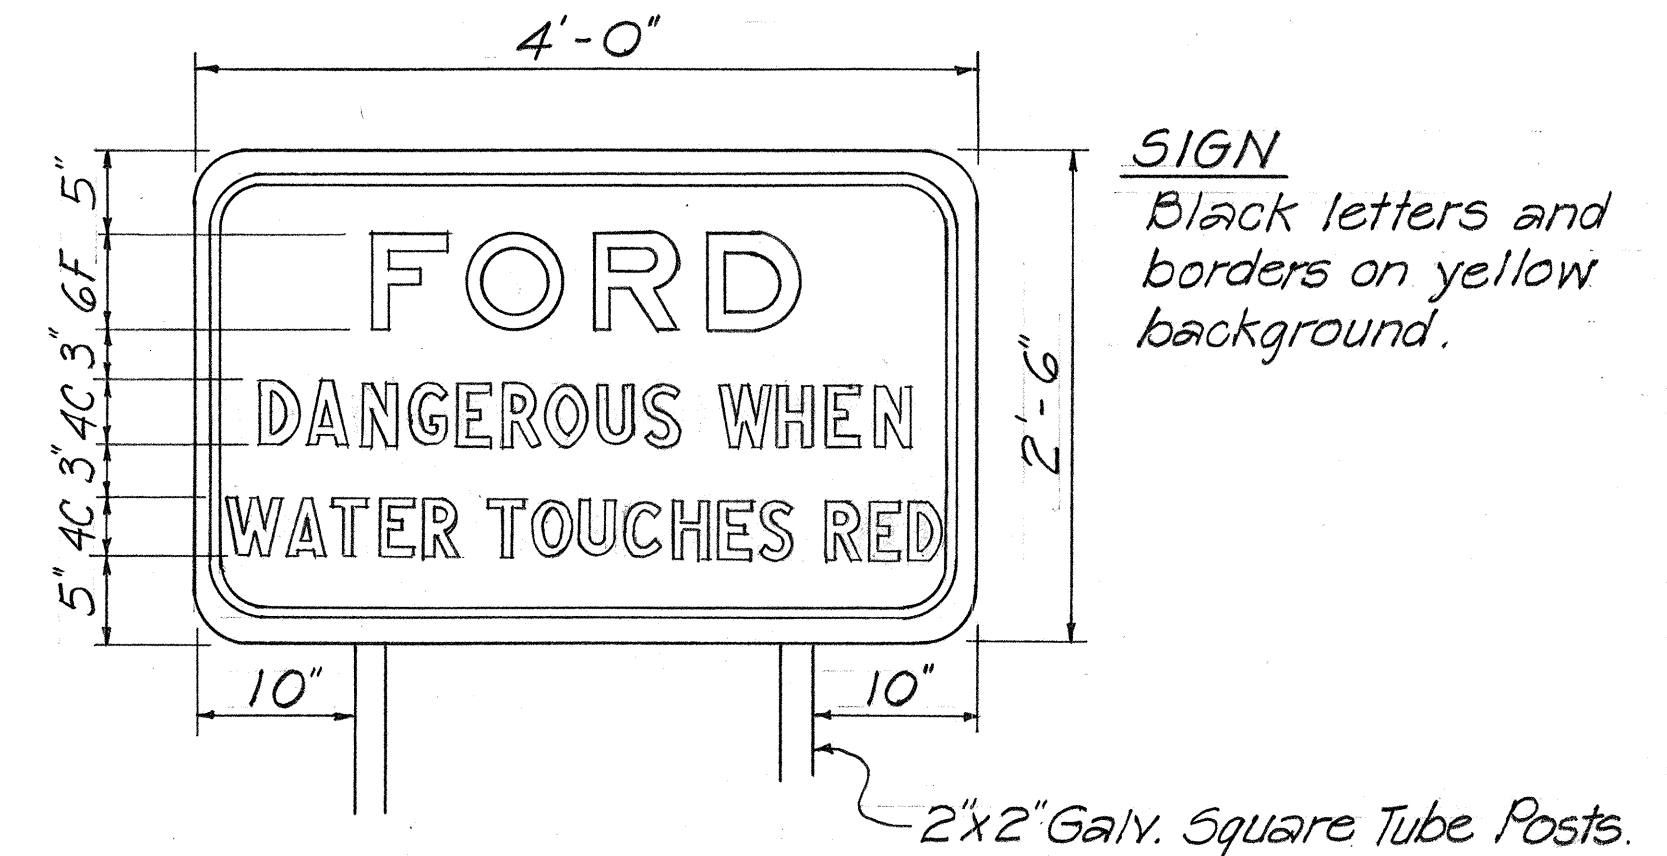

48"x30" WARNING SIGN
Scale: 1" = 1'-0"

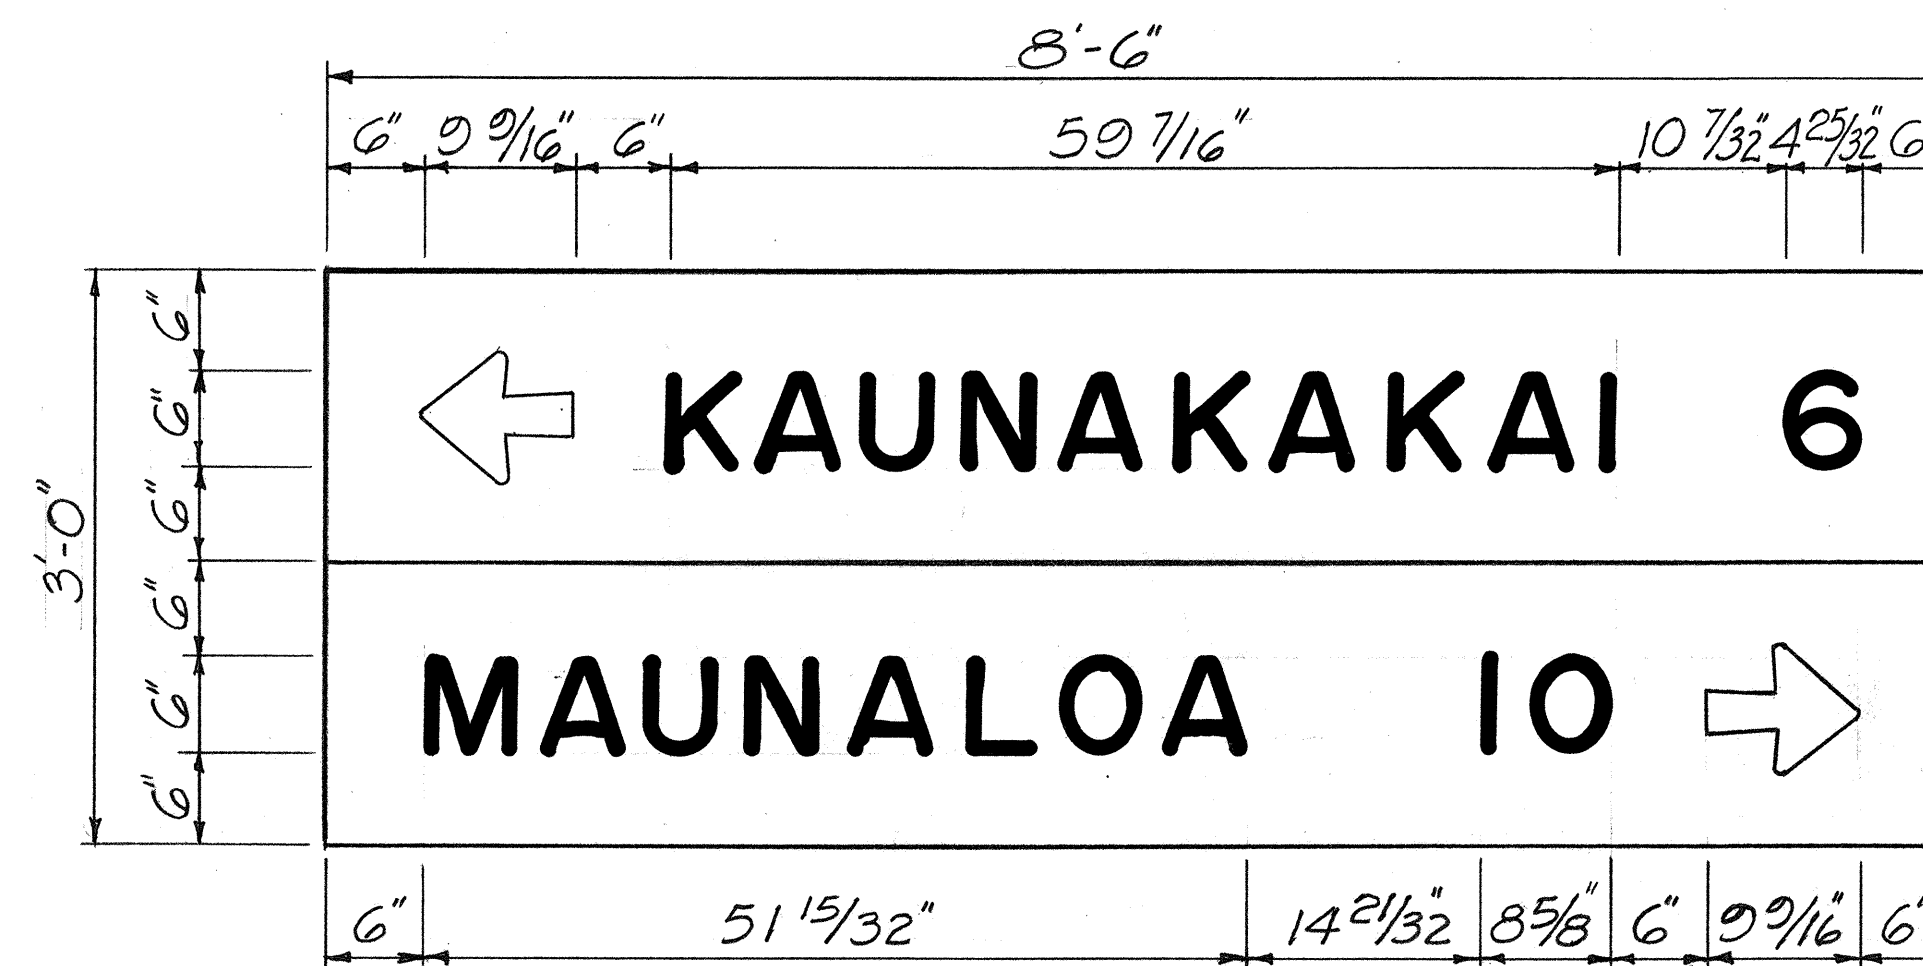

SIGN D-8
No Scale

STATE OF HAWAII	
DEPARTMENT OF TRANSPORTATION	
HIGHWAYS DIVISION	
PAVEMENT MARKINGS	
SUMMARY	
RESURFACING MAUNALOA HWY.	
PROJ. NO. RS-0460 (1)	
SCALE AS SHOWN	JAN. 1978
SHEET No. 1 OF 1 SHEETS	

FED. ROAD DIST. NO.	STATE	FED. AID PROJ. NO.	FISCAL YEAR	SHEET NO.	TOTAL SHEETS
HAWAII	HAW.	RS-0460(1)	1978	95-1	23

SUMMARY-
RAISED PAVEMENT MARKERS

STATION TO STATION	EXISTING STRIPE	DISTANCE (Ft.)	ITEM 629.2010 TYPE J-(Ea.)	ITEM 629.2030 TYPE C-(Ea.)	ITEM 629.2040 TYPE D-(Ea.)	ITEM 629.2070 TYPE H-(Ea.)	ITEM 629.1010 PAVEMENT STRIPING	S=ONE-WAY PASS D=NO PASS
0+00 - 10+80	Pass	1,080	100 ¹³	-	28	-		
10+80 - 13+30	No Pass	250	-	-	13	-	200	D
Gap - Ala Malama Rd.		50	-	-	-	-		
13+30 - 17+40	No Pass	360	-	-	14 ²²	-	425	D
17+40 - 126+40	Pass	10,950	10,950 ⁷²	-	274 ⁶⁷	-		
126+40 - 133+00	One-Way Pass	640 ⁵⁰	64 ⁵³	-	16	16	500	S
132+00 - 133+60	No Pass	660	-	-	34	-	656	D
Gap - Side Road			-	-	-	-		
133+50 - 153+40	No Pass	2,010 ^{1,400}	-	-	104 ⁶⁰	-	1,392	D
153+40 - 167+80	One-Way Pass	870 ⁸⁹	88 ⁹²	-	22	22	917	S
167+80 - 166+30	Pass	470	48	-	12	-		
166+30 - 173+15	One-Way Pass	665 ⁷⁶⁰	66 ⁷⁶	-	17	17	765	S
173+15 - 180+60	One-Way Pass	745 ⁶⁹⁰	76 ⁶⁸	-	14	14	669	S
180+60 - 183+20	Pass	260	28 ⁴	-	7	-		
183+20 - 190+00	One-Way Pass	680	68 ⁷²	-	17	17	692	S
190+00 - 204+00	No Pass	1,400	-	-	70 ⁶⁶	-	1,301	D
203+00 - 205+50	One-Way Pass	250	-	-	6	6	250	S
204+00 - 224+40	Pass	2,000 ^{1,820}	200 ¹⁸⁸	-	50 ⁴⁷	-		
224+00 - 229+00	No Pass	560	-	-	25	-	440	D
Gap - Kalae Hwy.			-	-	-	-		
Accel Lane	Solid	100	-	7	-	-	42	
Decel Lane	Solid	100	-	5	-	-	156	
Decel Lane	Solid	100	-	3	-	-	87	
230+00 - 234+20	No Pass	420	-	-	22	-	421	D
234+20 - 243+90	Pass	970	100	-	25	-		
243+90 - 251+00	One-Way Pass	710	72	-	18	18	711	S
251+00 - 262+00	No Pass	1,100	-	-	55 ⁵⁶	-	1,104	D
262+00 - 269+50	One-Way Pass	750	76	-	14 ¹⁹	19	757	S
269+50 - 317 ²⁹⁴ +80	Pass	4,830 ^{2,520}	484 ²⁵²	-	124 ⁸⁴	-		
CONTRACT C.C.O. #1 (Pave Bridges)			12	-	5	-		
317+80 - 320+30	One-Way Pass	250	28	-	7	7		
Gap - Puupeeua Ave.			-	-	-	-		
320+90 - 323+50	One-Way Pass	260	28	-	8	7		
323+50 - 327+00	Pass	350	36	-	9	-		
327+00 - 333+70	One-Way Pass	670	68	-	17	17		
333+70 - 341+95	One-Way Pass	825	84	-	21	21		
341+95 - 350+00	Pass	805	80	-	20	-		
TOTAL			2,332 2,900	7 15	886 1,032	33 180	11,512	

This sheet prepared
during "AS-BUILT" posting.

STATE OF HAWAII
DEPARTMENT OF TRANSPORTATION
LAND TRANSPORTATION FACILITIES DIVISION
PAVEMENT MARKINGS
SUMMARY
RESURFACING MAUNALO A HWY.
Proj. No. RS-0460(1)
Scale: As Shown Date: Jan. 1978
SHEET NO. 1A OF 1 SHEETS