

INDEX TO DRAWINGS	
SHEET NO.	DESCRIPTION
1	TITLE SHEET
2	TYP. DETAILS, GEN. NOTES
3-6	PLANS
7	INTERSECTION DET.
8	PAV'T. MARKINGS
*9	SIGN DET., PAV'T. MARK.
10	DESTINATION SIGNS
11	MANAWAINUI BR. REPAIR
12-23	STANDARD DETAILS
*9S-1	SUMMARY OF RAISED PAVEMENT MARKERS

New Total Sheet Count = 24 Sheets

STATE OF HAWAII

DEPARTMENT OF TRANSPORTATION

LAND TRANSPORTATION FACILITIES DIVISION

"AS-BUILT" HONOLULU, HAWAII

RESURFACING MAUNALOA HIGHWAY


(KAUNAKAKAI WHARF TOWARDS MAUNALOA VILLAGE)

PROJECT NO. RS-0460(I)


DISTRICT OF MOLOKAI

COUNTY OF MAUI

ISLAND OF MOLOKAI

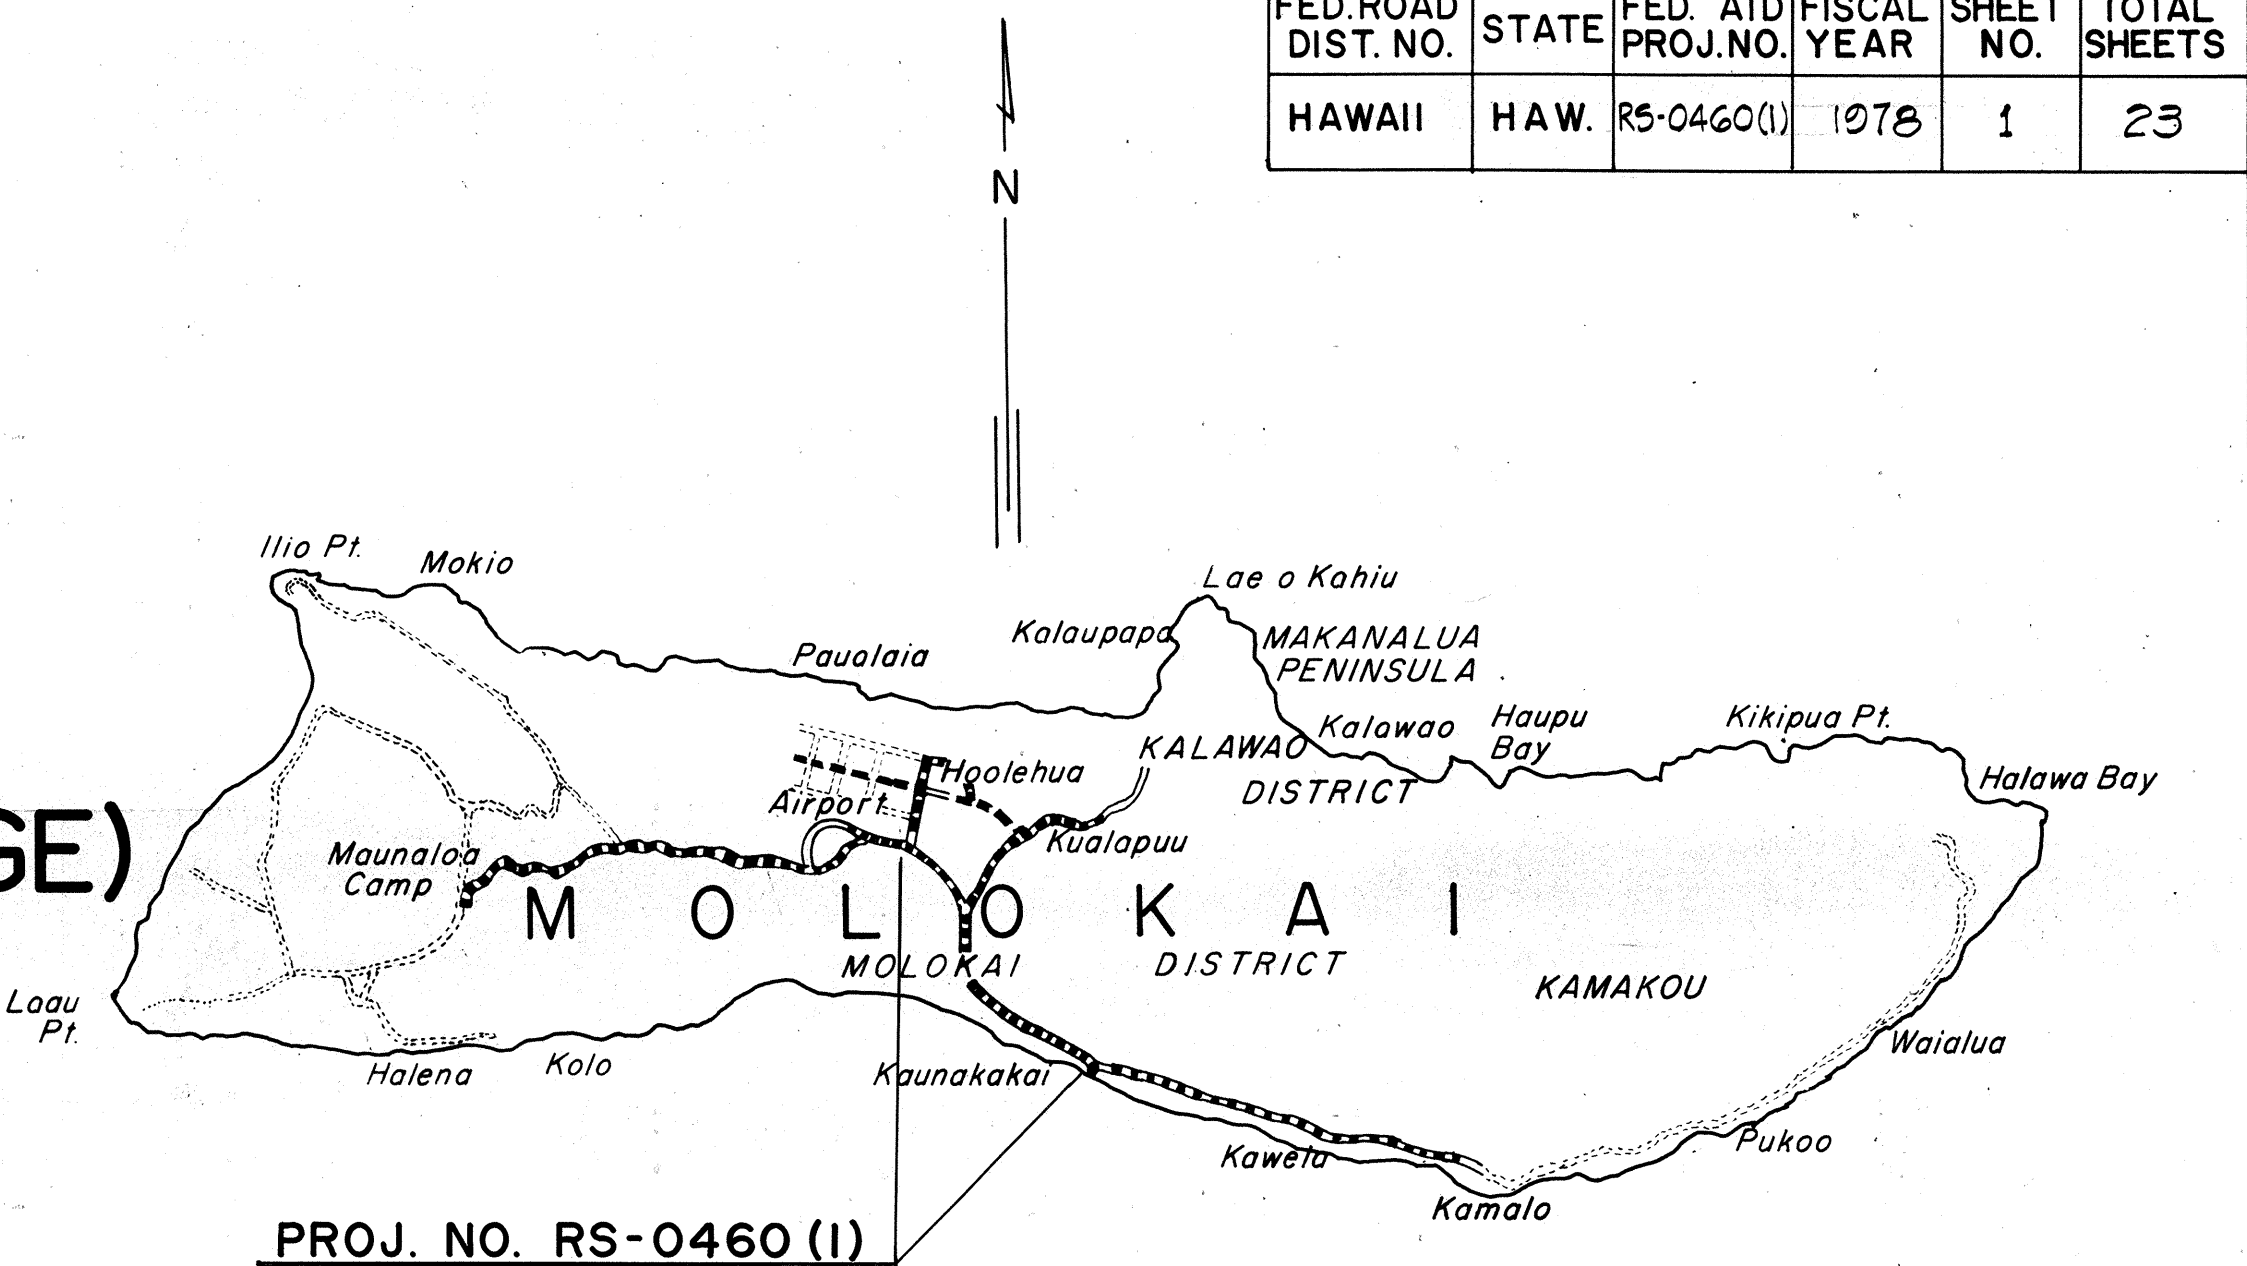

 FEDERAL AID PROJECTS PREVIOUSLY CONSTRUCTED OR UNDER CONSTRUCTION

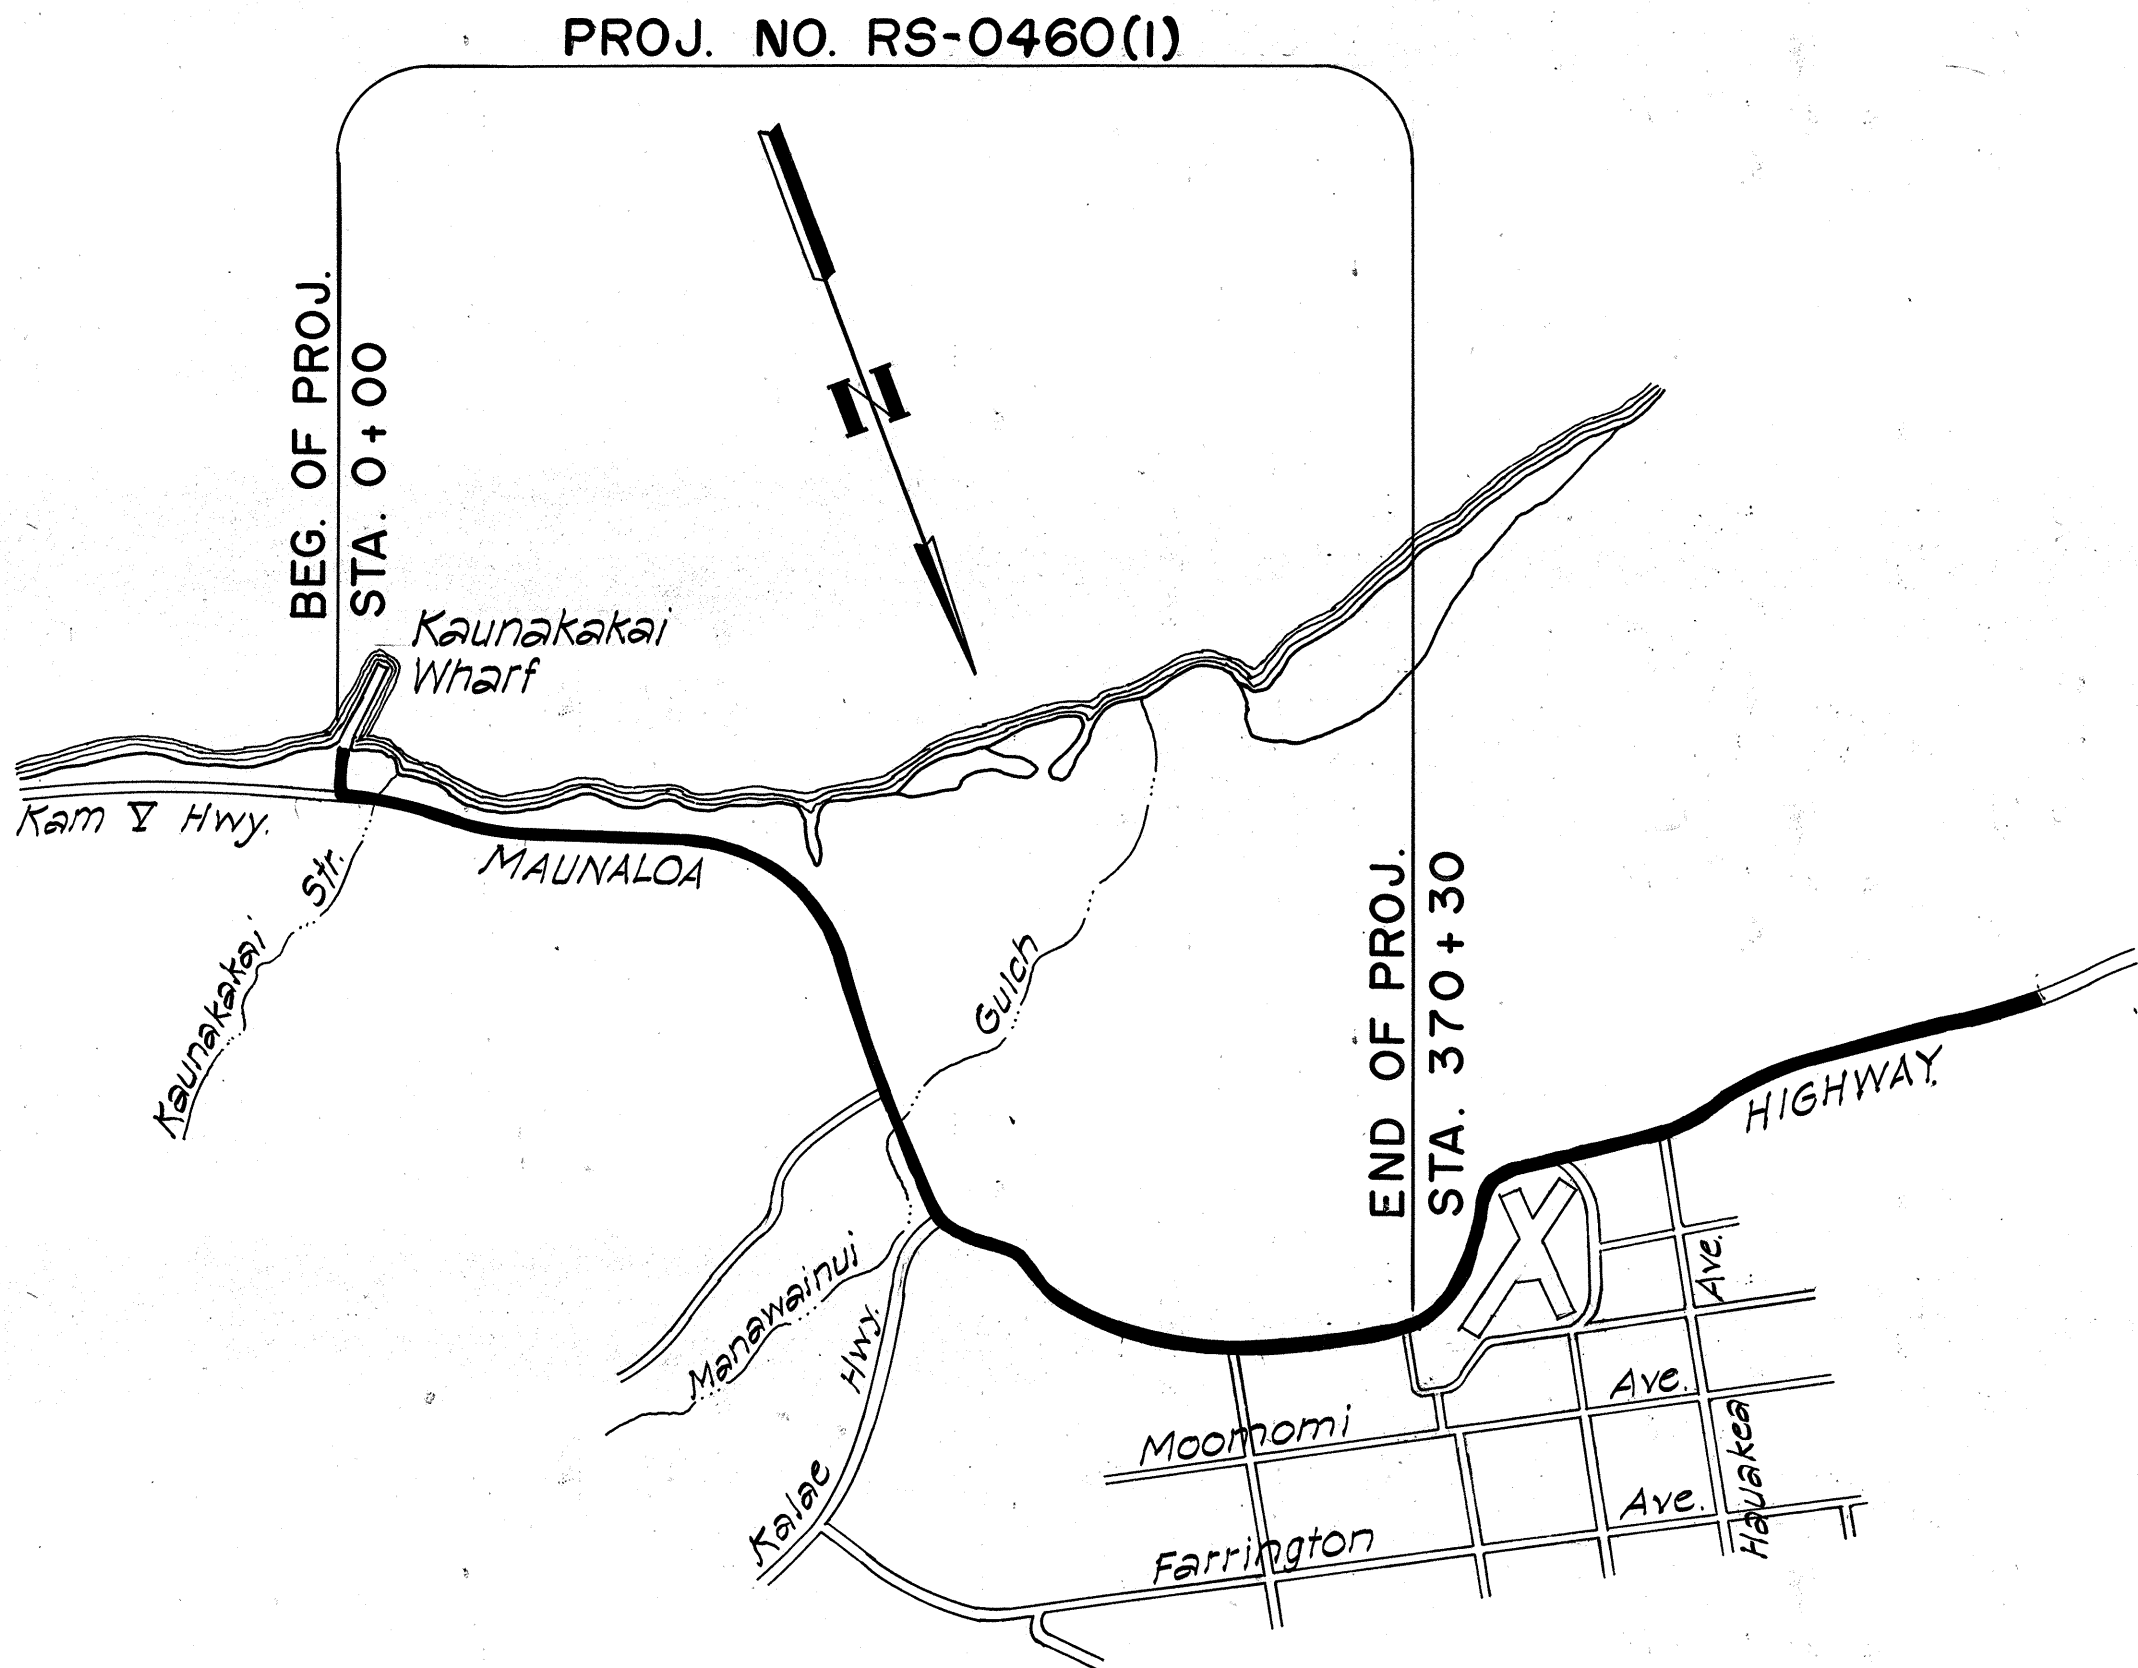

LAYOUT OF PROJECT
SCALE: 1" = 1 MILE

LENGTH OF PROJECT 7.013 MI.
" " " 11.284 KM.

NOTE:
ALL CHANGES MADE DURING CONSTRUCTION
HAVE BEEN NOTED IN RED ON THESE TRACINGS
AND CHECKED BY

George N. Haya 8/15/79
RESIDENT ENGINEER DATE

DEPARTMENT OF TRANSPORTATION
STATE OF HAWAII
APPROVED:
Ryodichi Higashimura 5/11/78
DIR. OF TRANSPORTATION DATE

MAUI DISTRICT OFFICE DESIGNED BY R. TSUZUKI P.S. & E. BY DATE APRIL, 1978 PHONE 548-2456