


FED. ROAD DIST. NO.	STATE	FED. AID PROJ. NO.	FISCAL YEAR	SHEET NO.	TOTAL SHEETS
HAWAII	HAW.	RS-0460(4)	1982	3	25

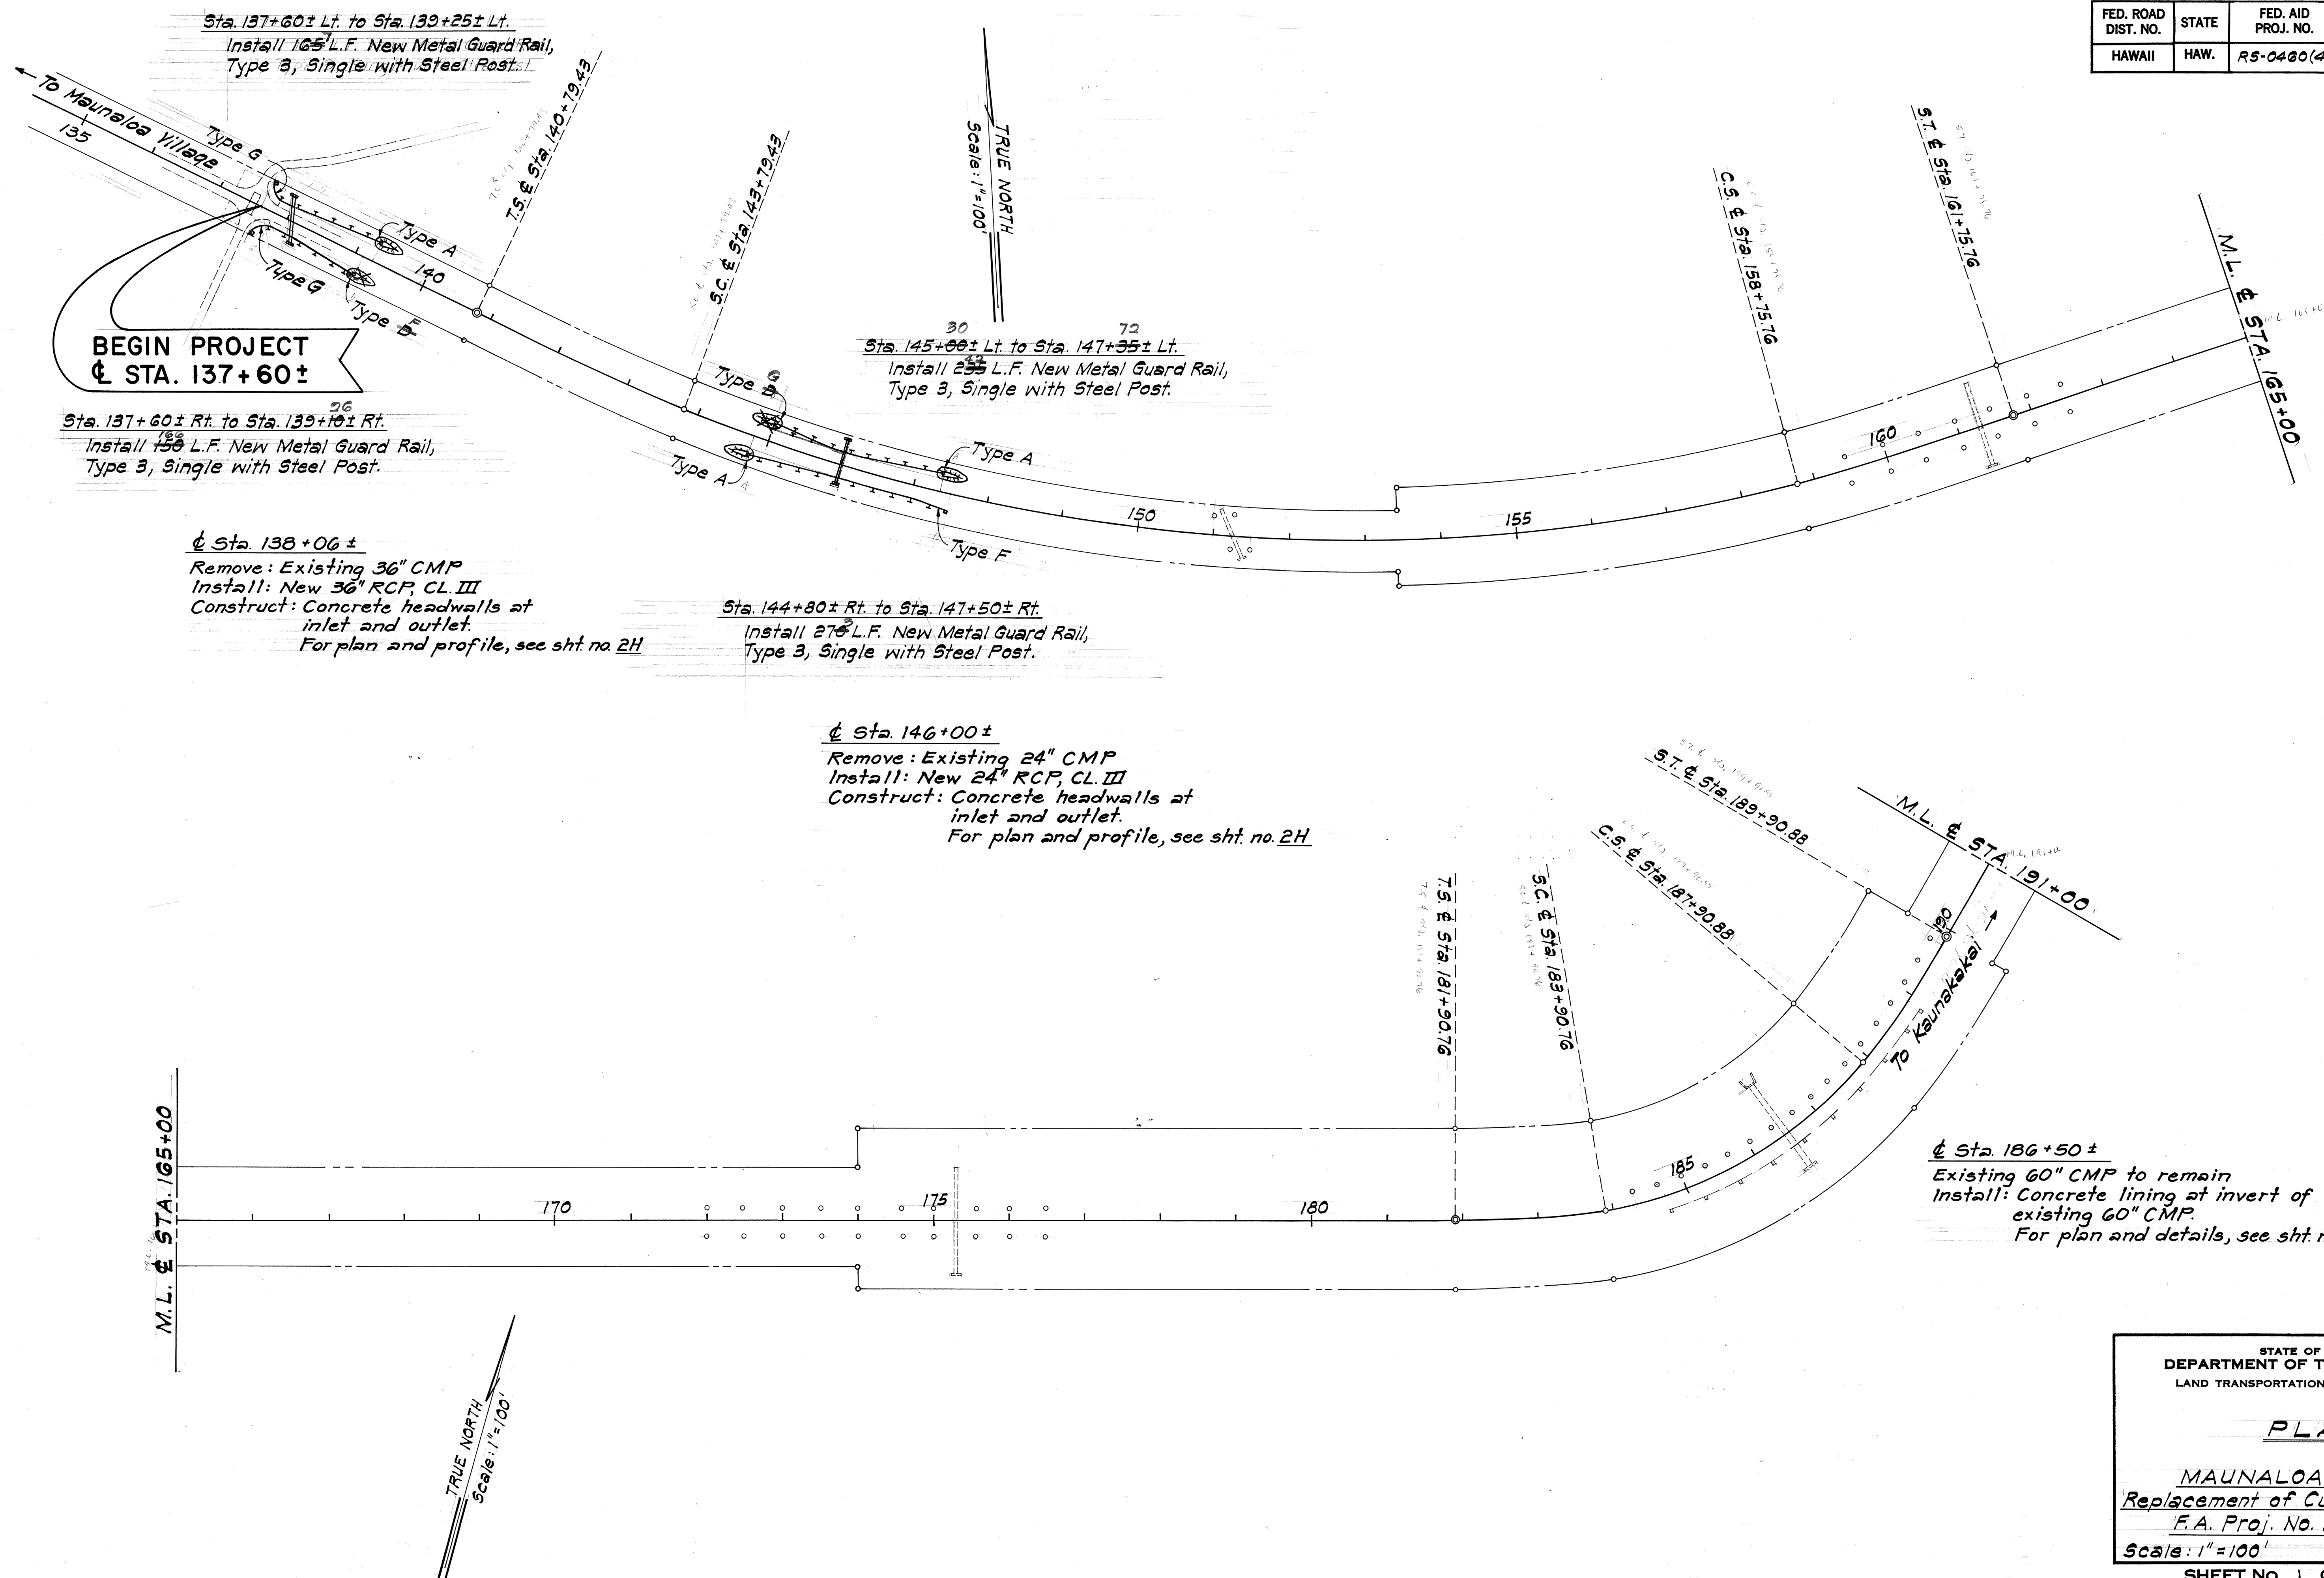


DATE	____
SURVEY PLOTTED BY	____
ORIGINAL PLAN	____
DESIGNED BY	____
NOTED BY	____
CHECKED BY	____

STATE OF HAWAII
DEPARTMENT OF TRANSPORTATION
LAND TRANSPORTATION FACILITIES DIVISION

PLAN

MAUNALOA HIGHWAY
Replacement of Culverts, Phase I
F.A. Proj. No. RS-0460(4)
Scale: 1" = 100' Date: April, 1982
SHEET NO. 1 OF 3 SHEETS

FED. ROAD DIST. NO.	STATE	FED. AID PROJ. NO.	FISCAL YEAR	SHEET NO.	TOTAL SHEETS
HAWAII	HAW.	R5-0460(4)	1982	4	25

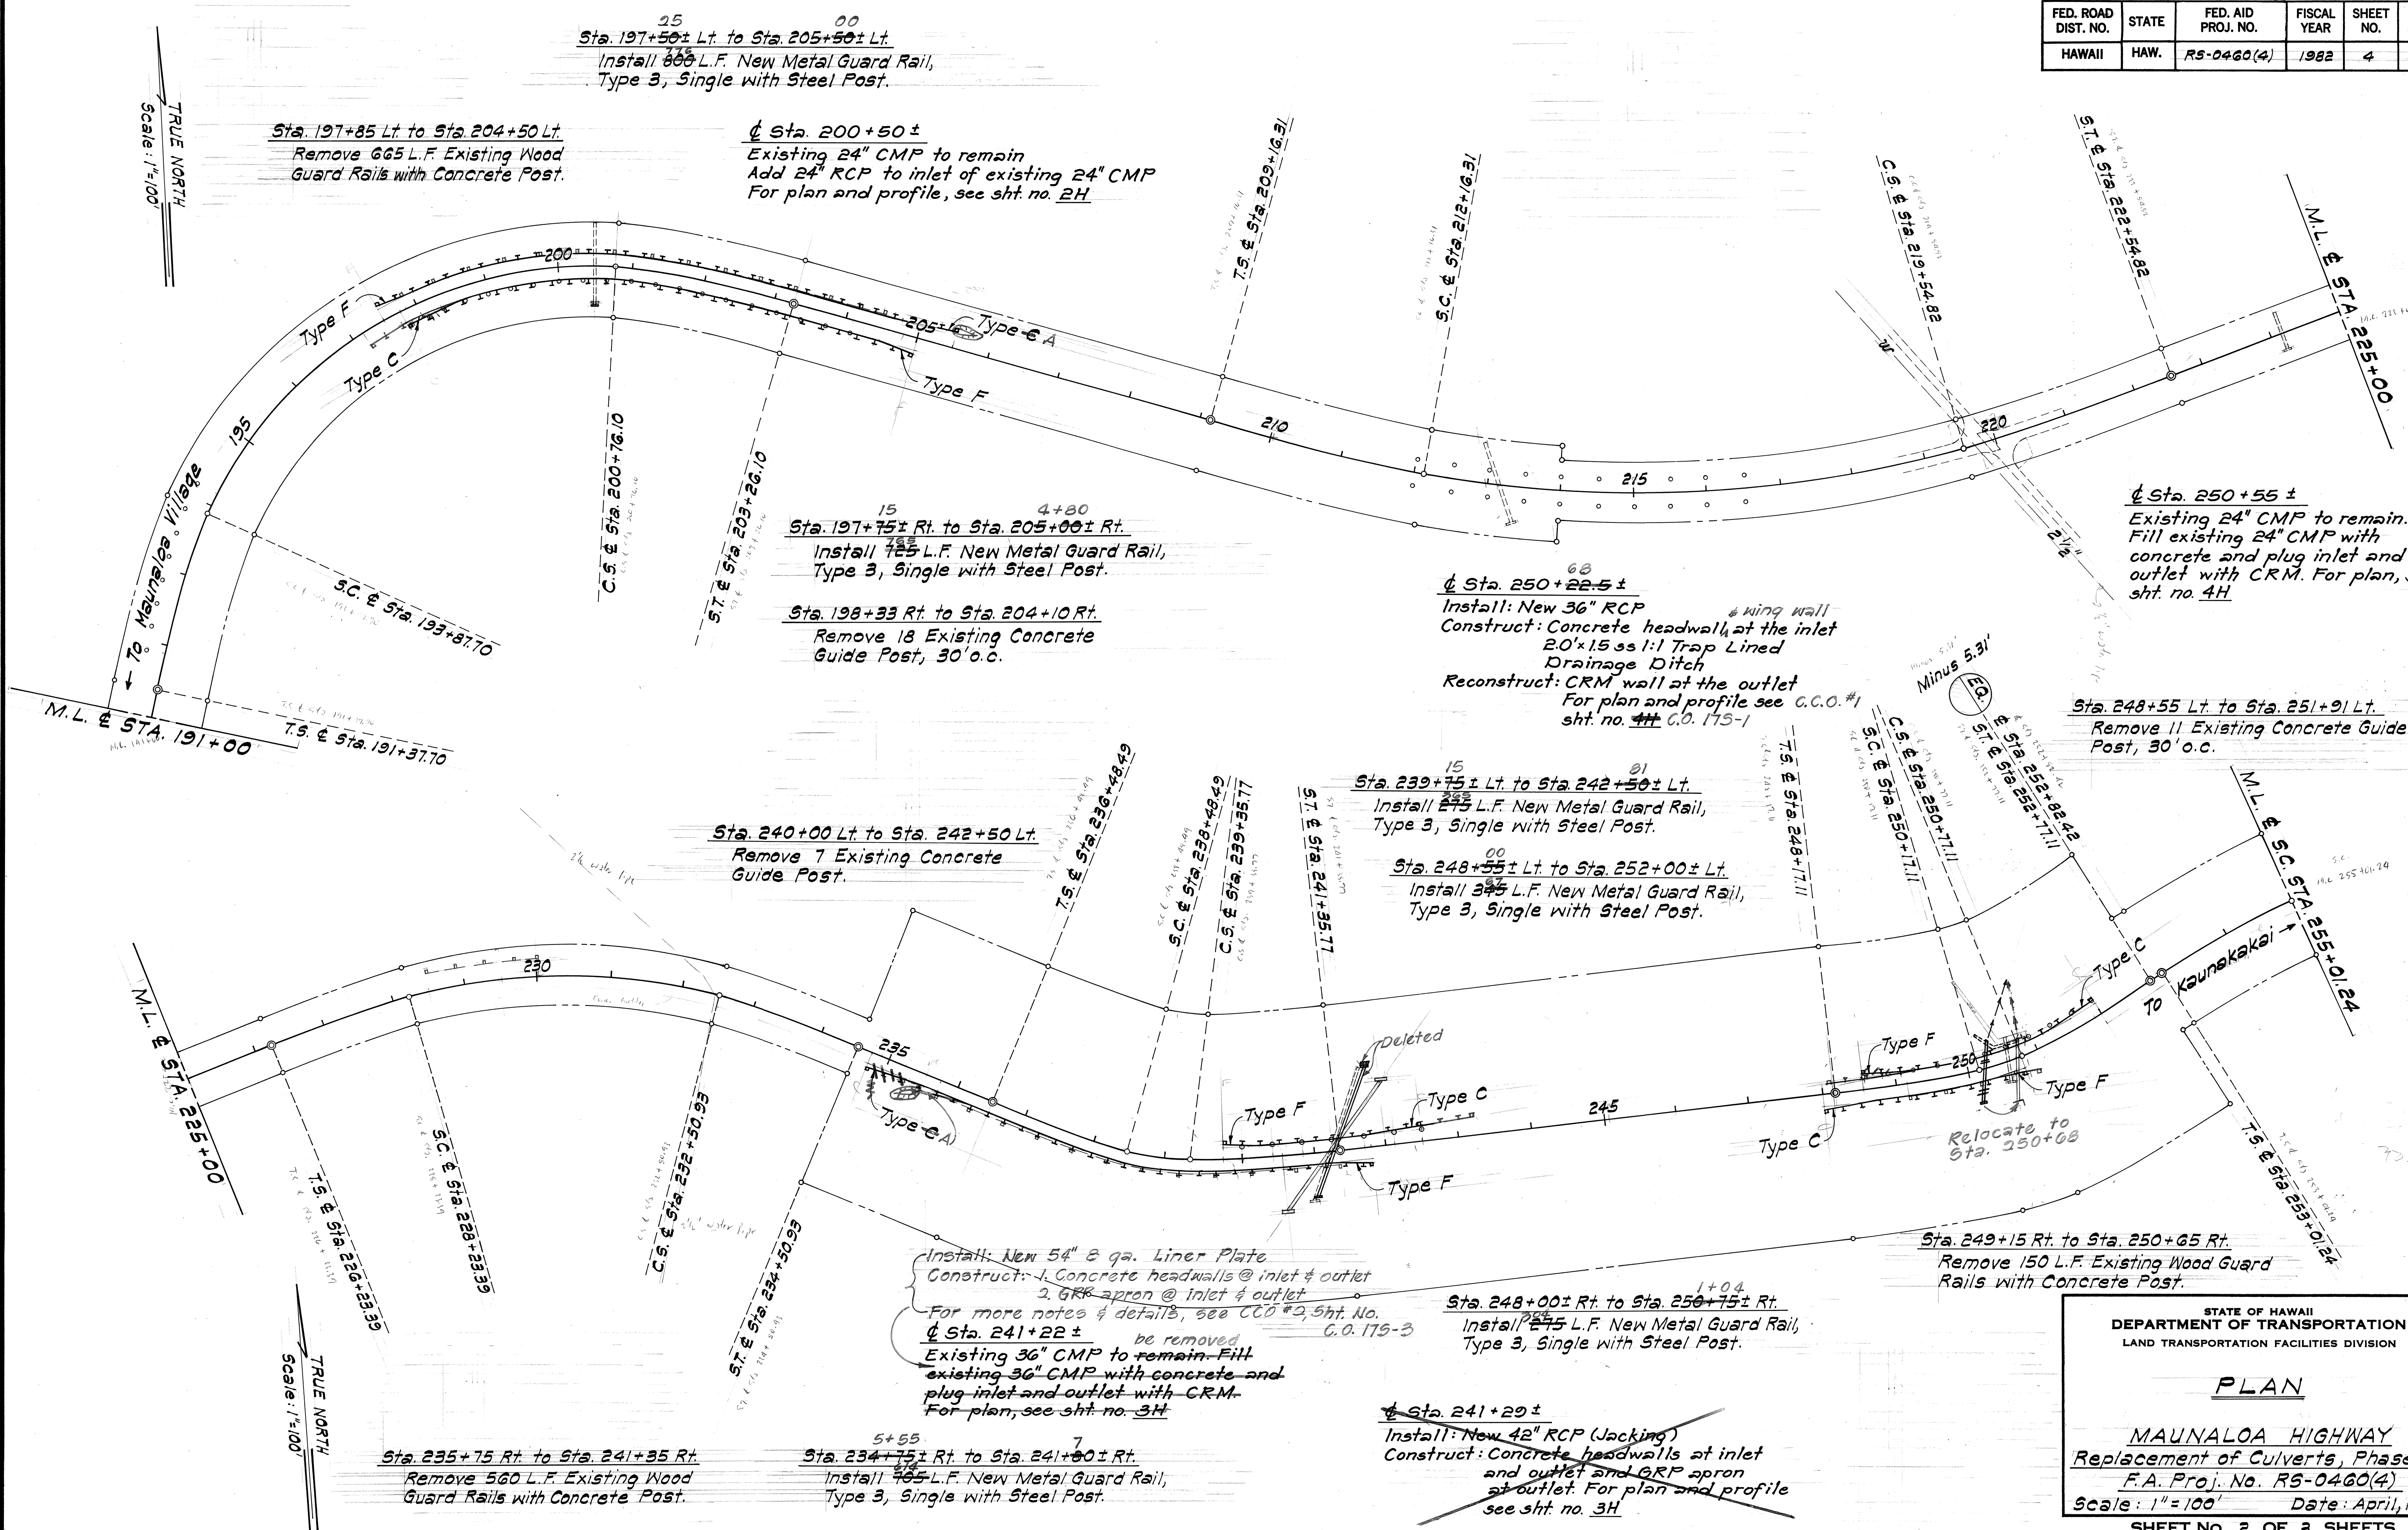


STATE OF HAWAII
DEPARTMENT OF TRANSPORTATION
LAND TRANSPORTATION FACILITIES DIVISION

PLAN

MAUNALO A HIGHWAY
Replacement of Culverts, Phase I
F.A. Proj. No. R5-0460(4)
Scale: 1"=100' Date: April, 1982
SHEET NO. 2 OF 3 SHEETS

FED. ROAD DIST. NO.	STATE	FED. AID PROJ. NO.	FISCAL YEAR	SHEET NO.	TOTAL SHEETS
HAWAII	HAW.	RS-0460(4)	1982	5	25

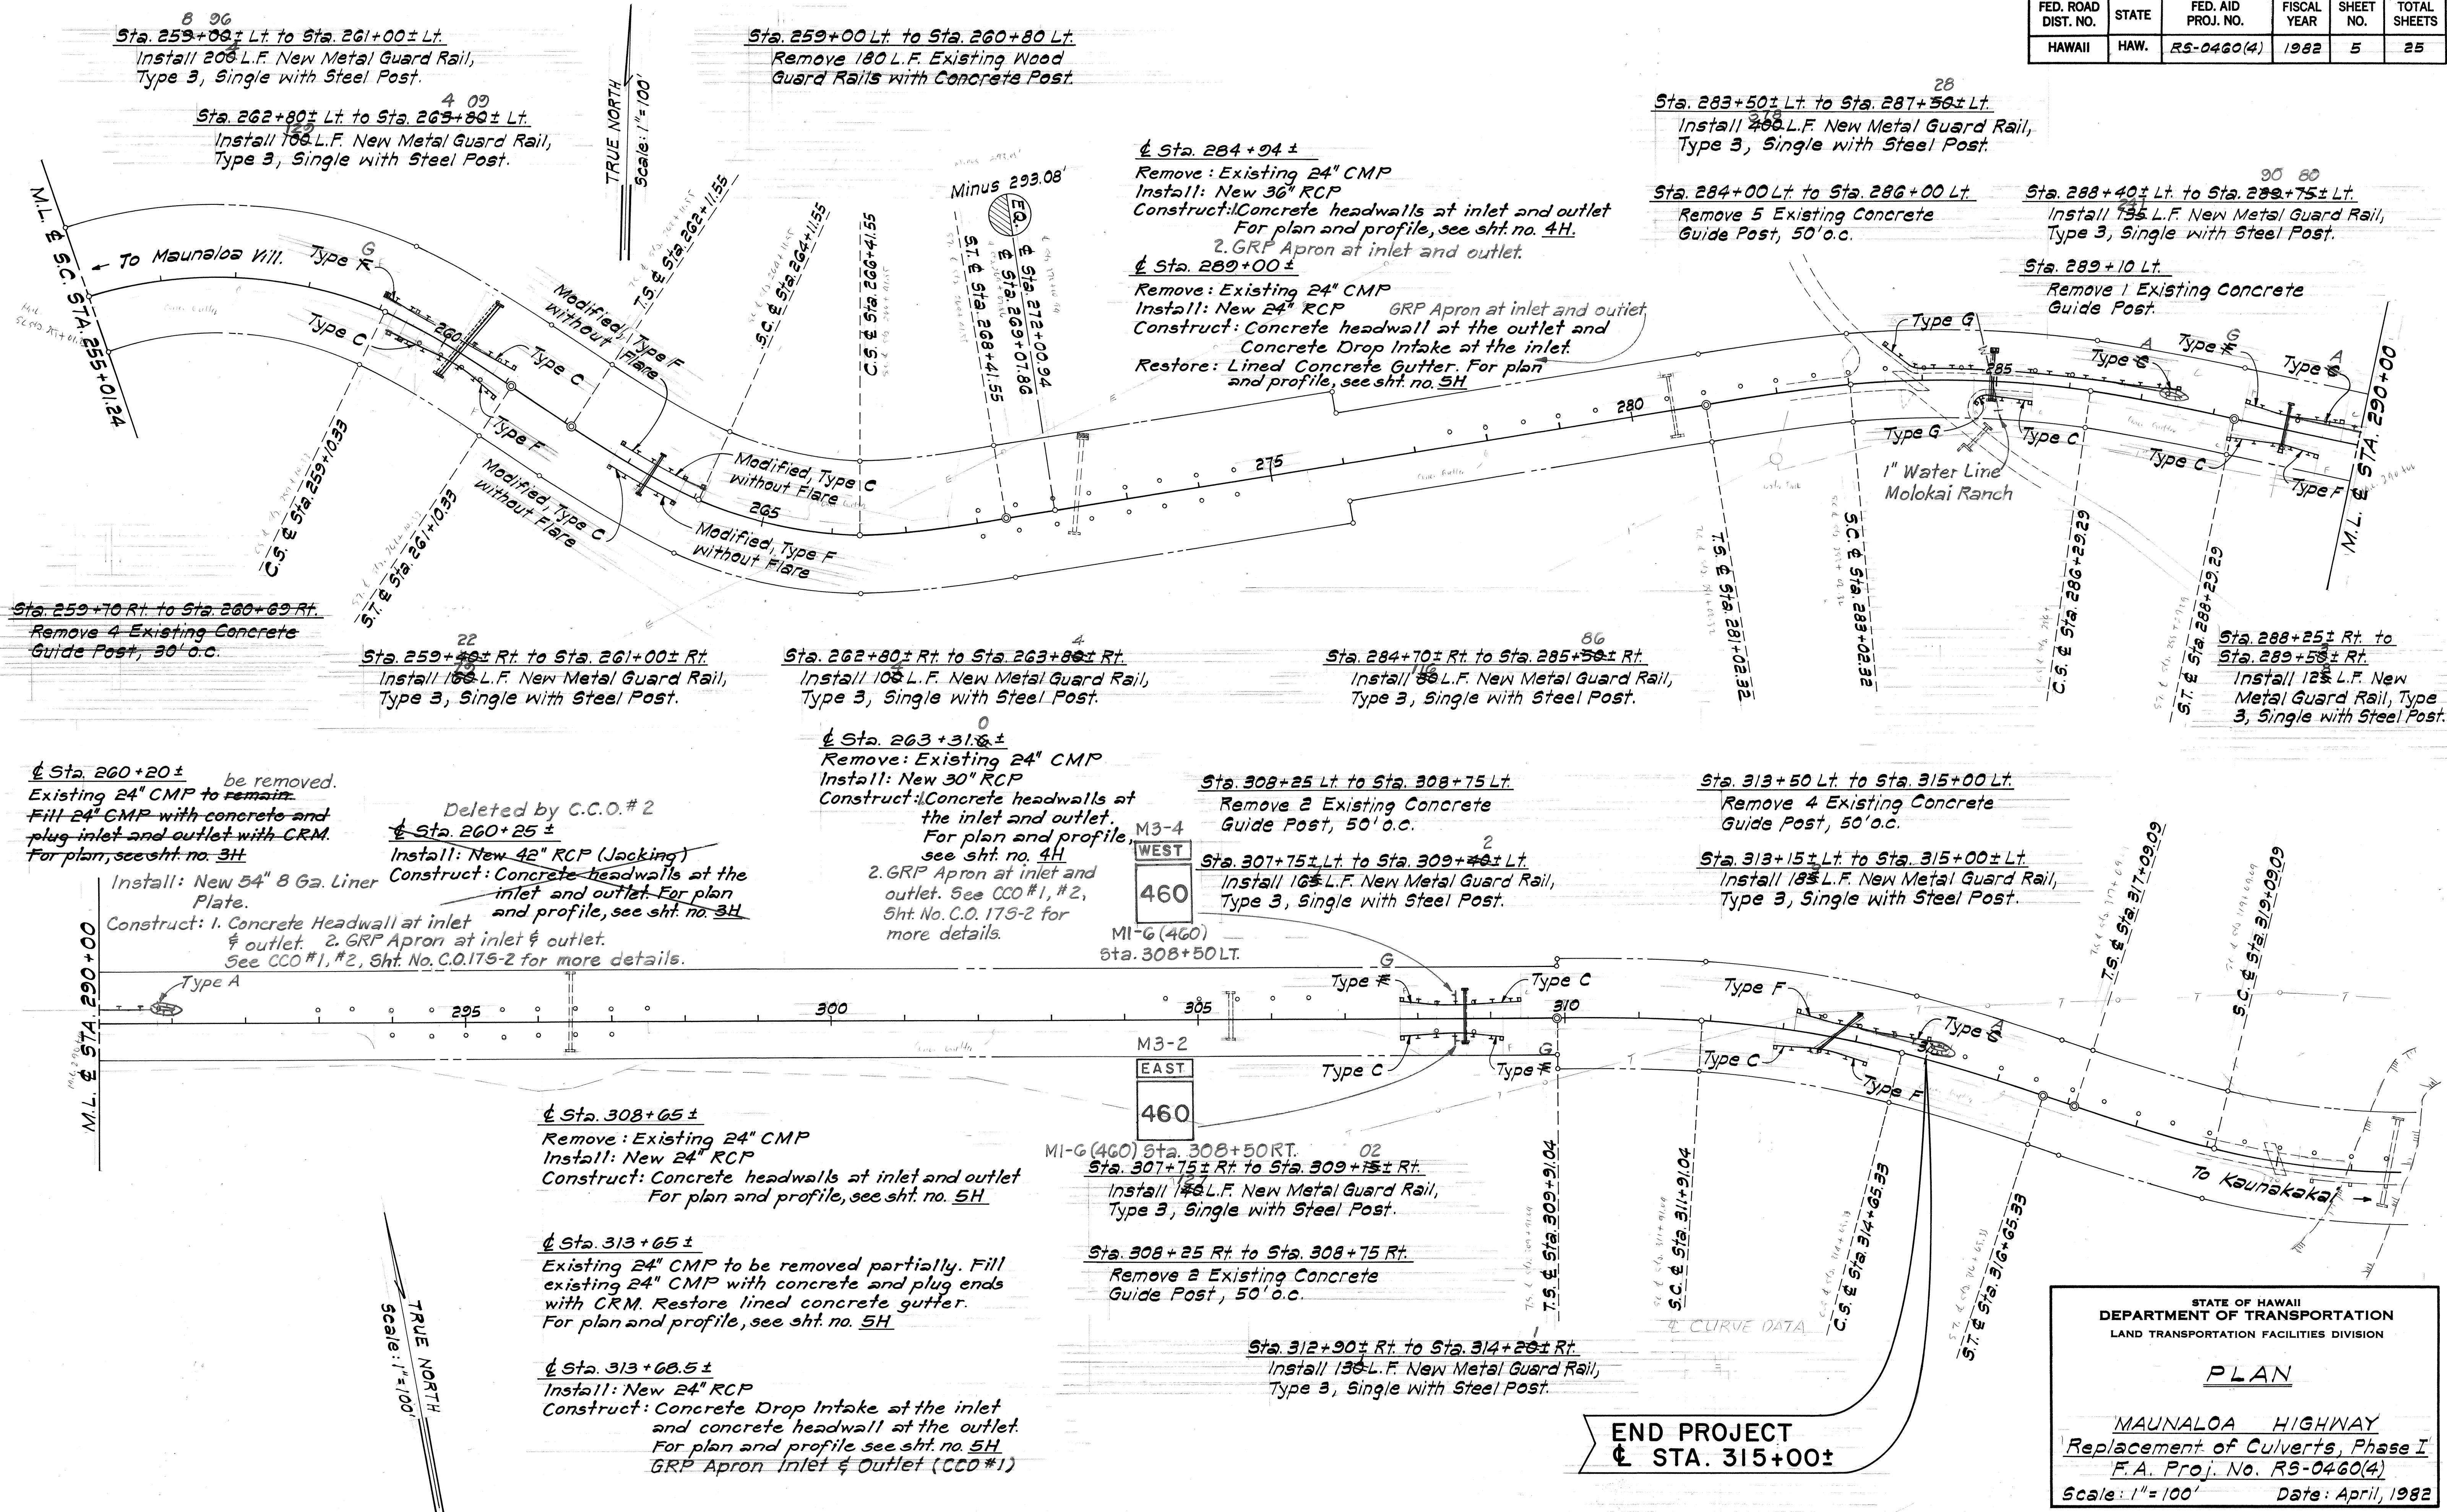

STATE OF HAWAII
DEPARTMENT OF TRANSPORTATION
LAND TRANSPORTATION FACILITIES DIVISION

PLAN

MAUNALOA HIGHWAY
Replacement of Culverts, Phase I
F.A. Proj. No. RS-0460(4)
Scale: 1"=100' Date: April, 1982
SHEET NO. 3 OF 3 SHEETS