

INDEX TO DRAWINGS	
SHEET NO.	DESCRIPTION
1	TITLE SHEET
2	GENERAL NOTES, TYPICAL SECTIONS, AND GUARD RAIL SCHEDULES
3-5	PLANS
6-10	GUARD RAIL STANDARD DETAILS
*11-19	DRAINAGE PLANS AND DETAILS
20-25	SIGNING, STRIPING, MARKERS SCHEDULES AND DETAILS

* C.O.17S-1, C.O.17S-2, C.O.17S-3


TOTAL SHEET COUNT AFTER "AS-BUILT"
POSTINGS : 28 SHEETS

STATE OF HAWAII
DEPARTMENT OF TRANSPORTATION
HIGHWAYS DIVISION

"AS - BUILT"
PLANS FOR
MAUNALOA HIGHWAY
REPLACEMENT OF CULVERTS BETWEEN
MAUNALOA VILLAGE AND KAUNAKAKAI, PHASE I
FEDERAL AID PROJECT NO. RS-0460(4)

DISTRICT OF MOLOKAI
ISLAND OF MOLOKAI

FED. ROAD DIST. NO.	STATE	FED. AID PROJ. NO.	FISCAL YEAR	SHEET NO.	TOTAL SHEETS
HAWAII	HAW.	RS-0460(4)	1982	1	25

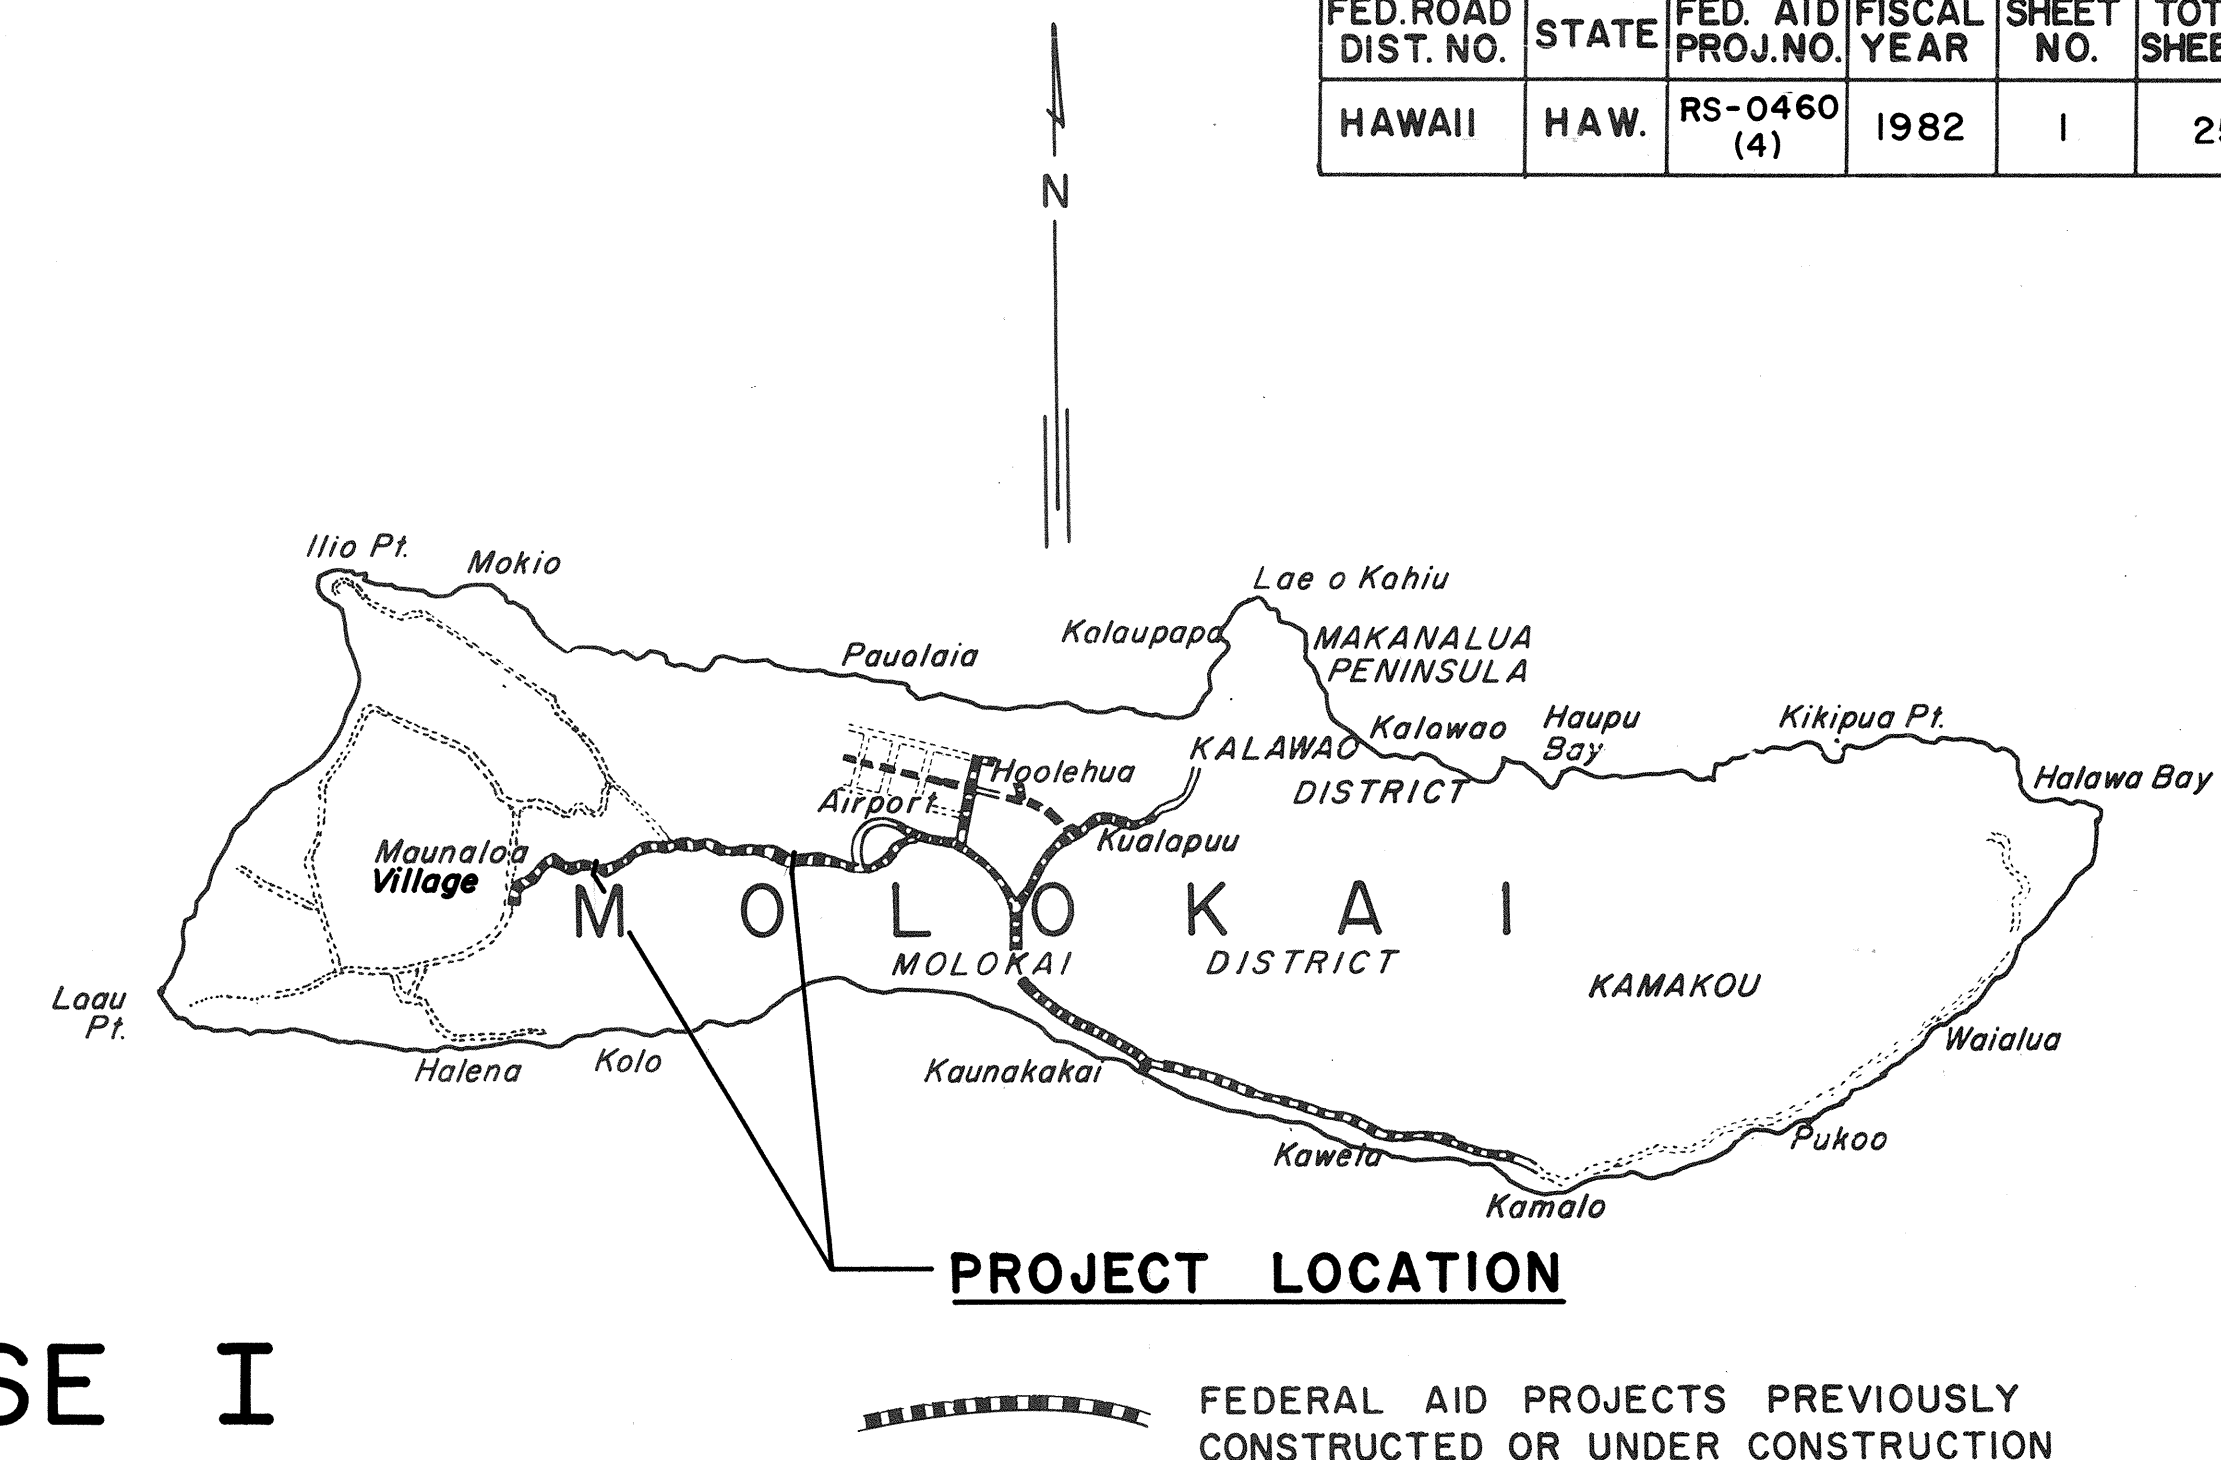



CHANGES MADE DURING CONSTRUCTION HAVE BEEN INCORPORATED ON THESE PLANS EXCEPT CHANGES IN THE ORIGINAL THEORETICAL QUANTITIES. FOR ACTUAL QUANTITIES, REFER TO PROJECT LEDGER AND/OR COMPUTATION BOOK.

William C. Cagle
RESIDENT ENGINEER

9/26/82
DATE

DESIGN DESIGNATION

CURRENT ADT (1982)	1,900
DESIGN ADT (1992)	3,260
DHV	342
T ₂₄	14%

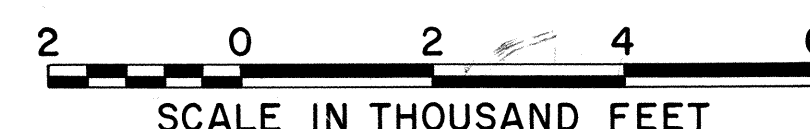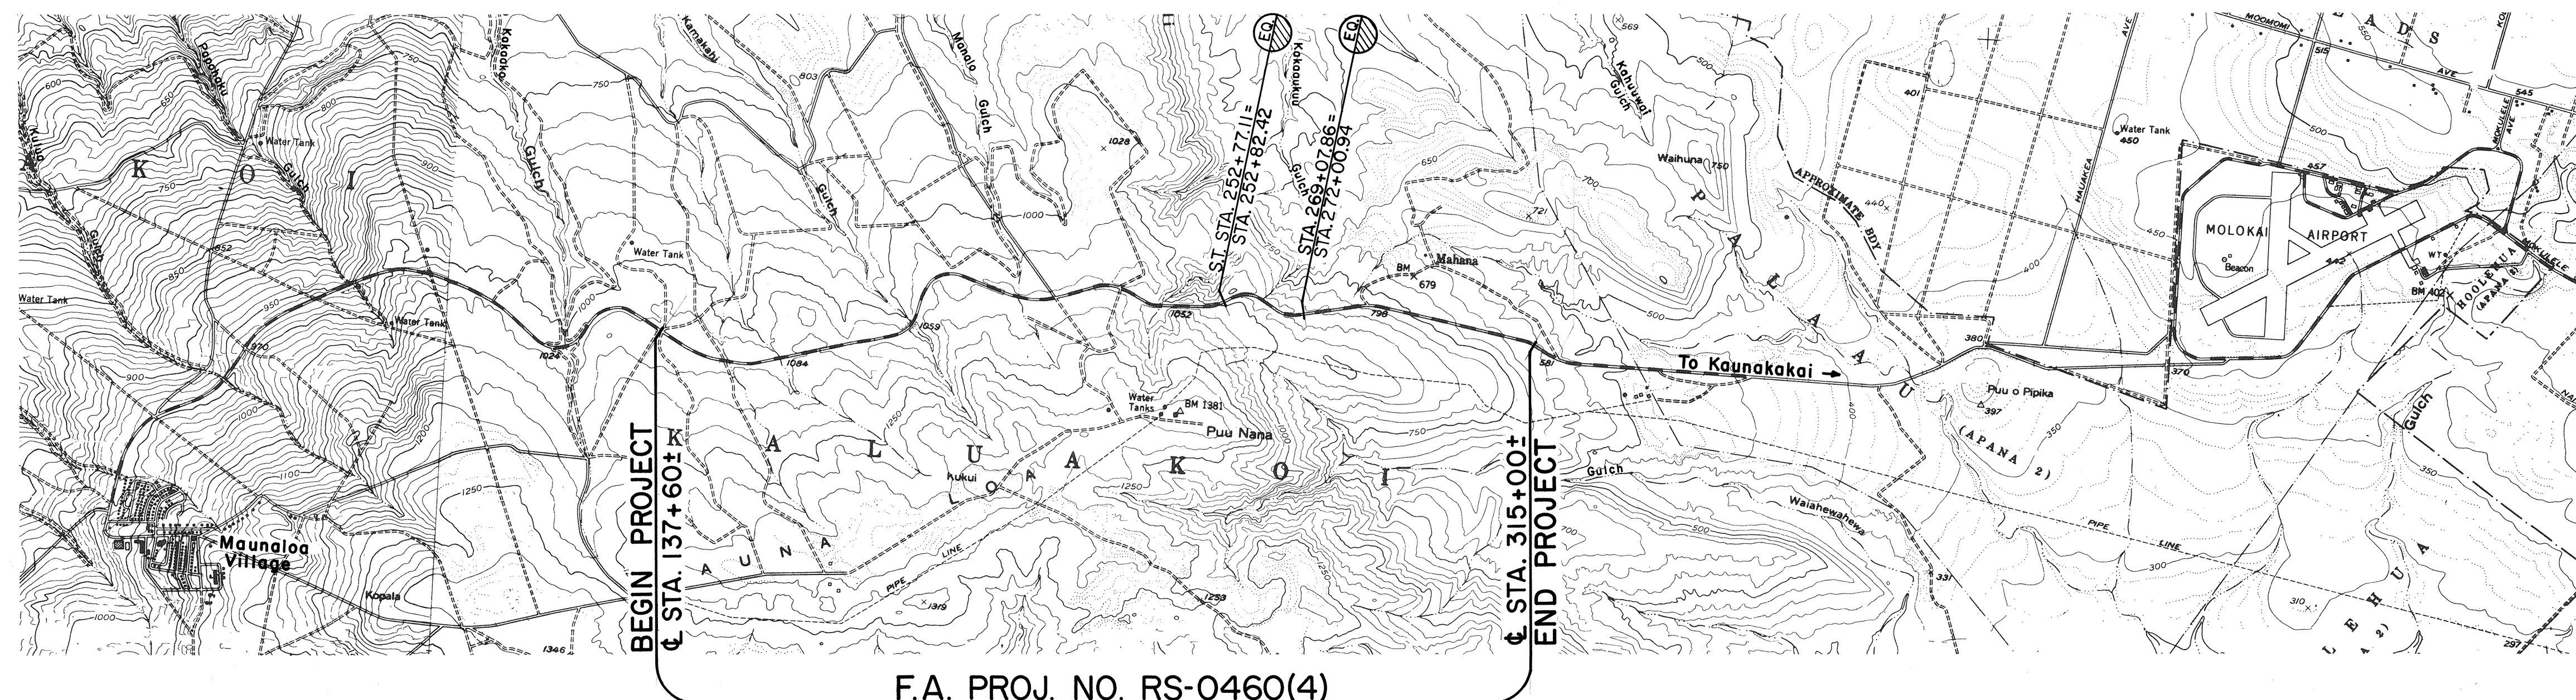

LAYOUT PLAN
LENGTH OF PROJECT 3.30 MI.



DEPARTMENT OF TRANSPORTATION
STATE OF HAWAII
APPROVED:
James R. Carver 5/18/82
DIR. OF TRANSPORTATION DATE

DESIGNED BY
Allan Nishimura
P. S. & E. BY
548-7490 Apr. 1982
PHONE DATE