


| FED. ROAD DIST. NO. | STATE | PROJ. NO.   | FISCAL YEAR | SHEET NO. | TOTAL SHEETS |
|---------------------|-------|-------------|-------------|-----------|--------------|
| HAWAII              | HAW.  | 460B-01-83M | 1983        | 3         | 7            |

|               |                   |      |
|---------------|-------------------|------|
| ORIGINAL PLAN | SURVEY PLOTTED BY | DATE |
| NOTE BOOK     | DRAWN BY          |      |
|               | DESIGNED BY       |      |
|               | QUANTITIES BY     |      |
|               | CHECKED BY        |      |

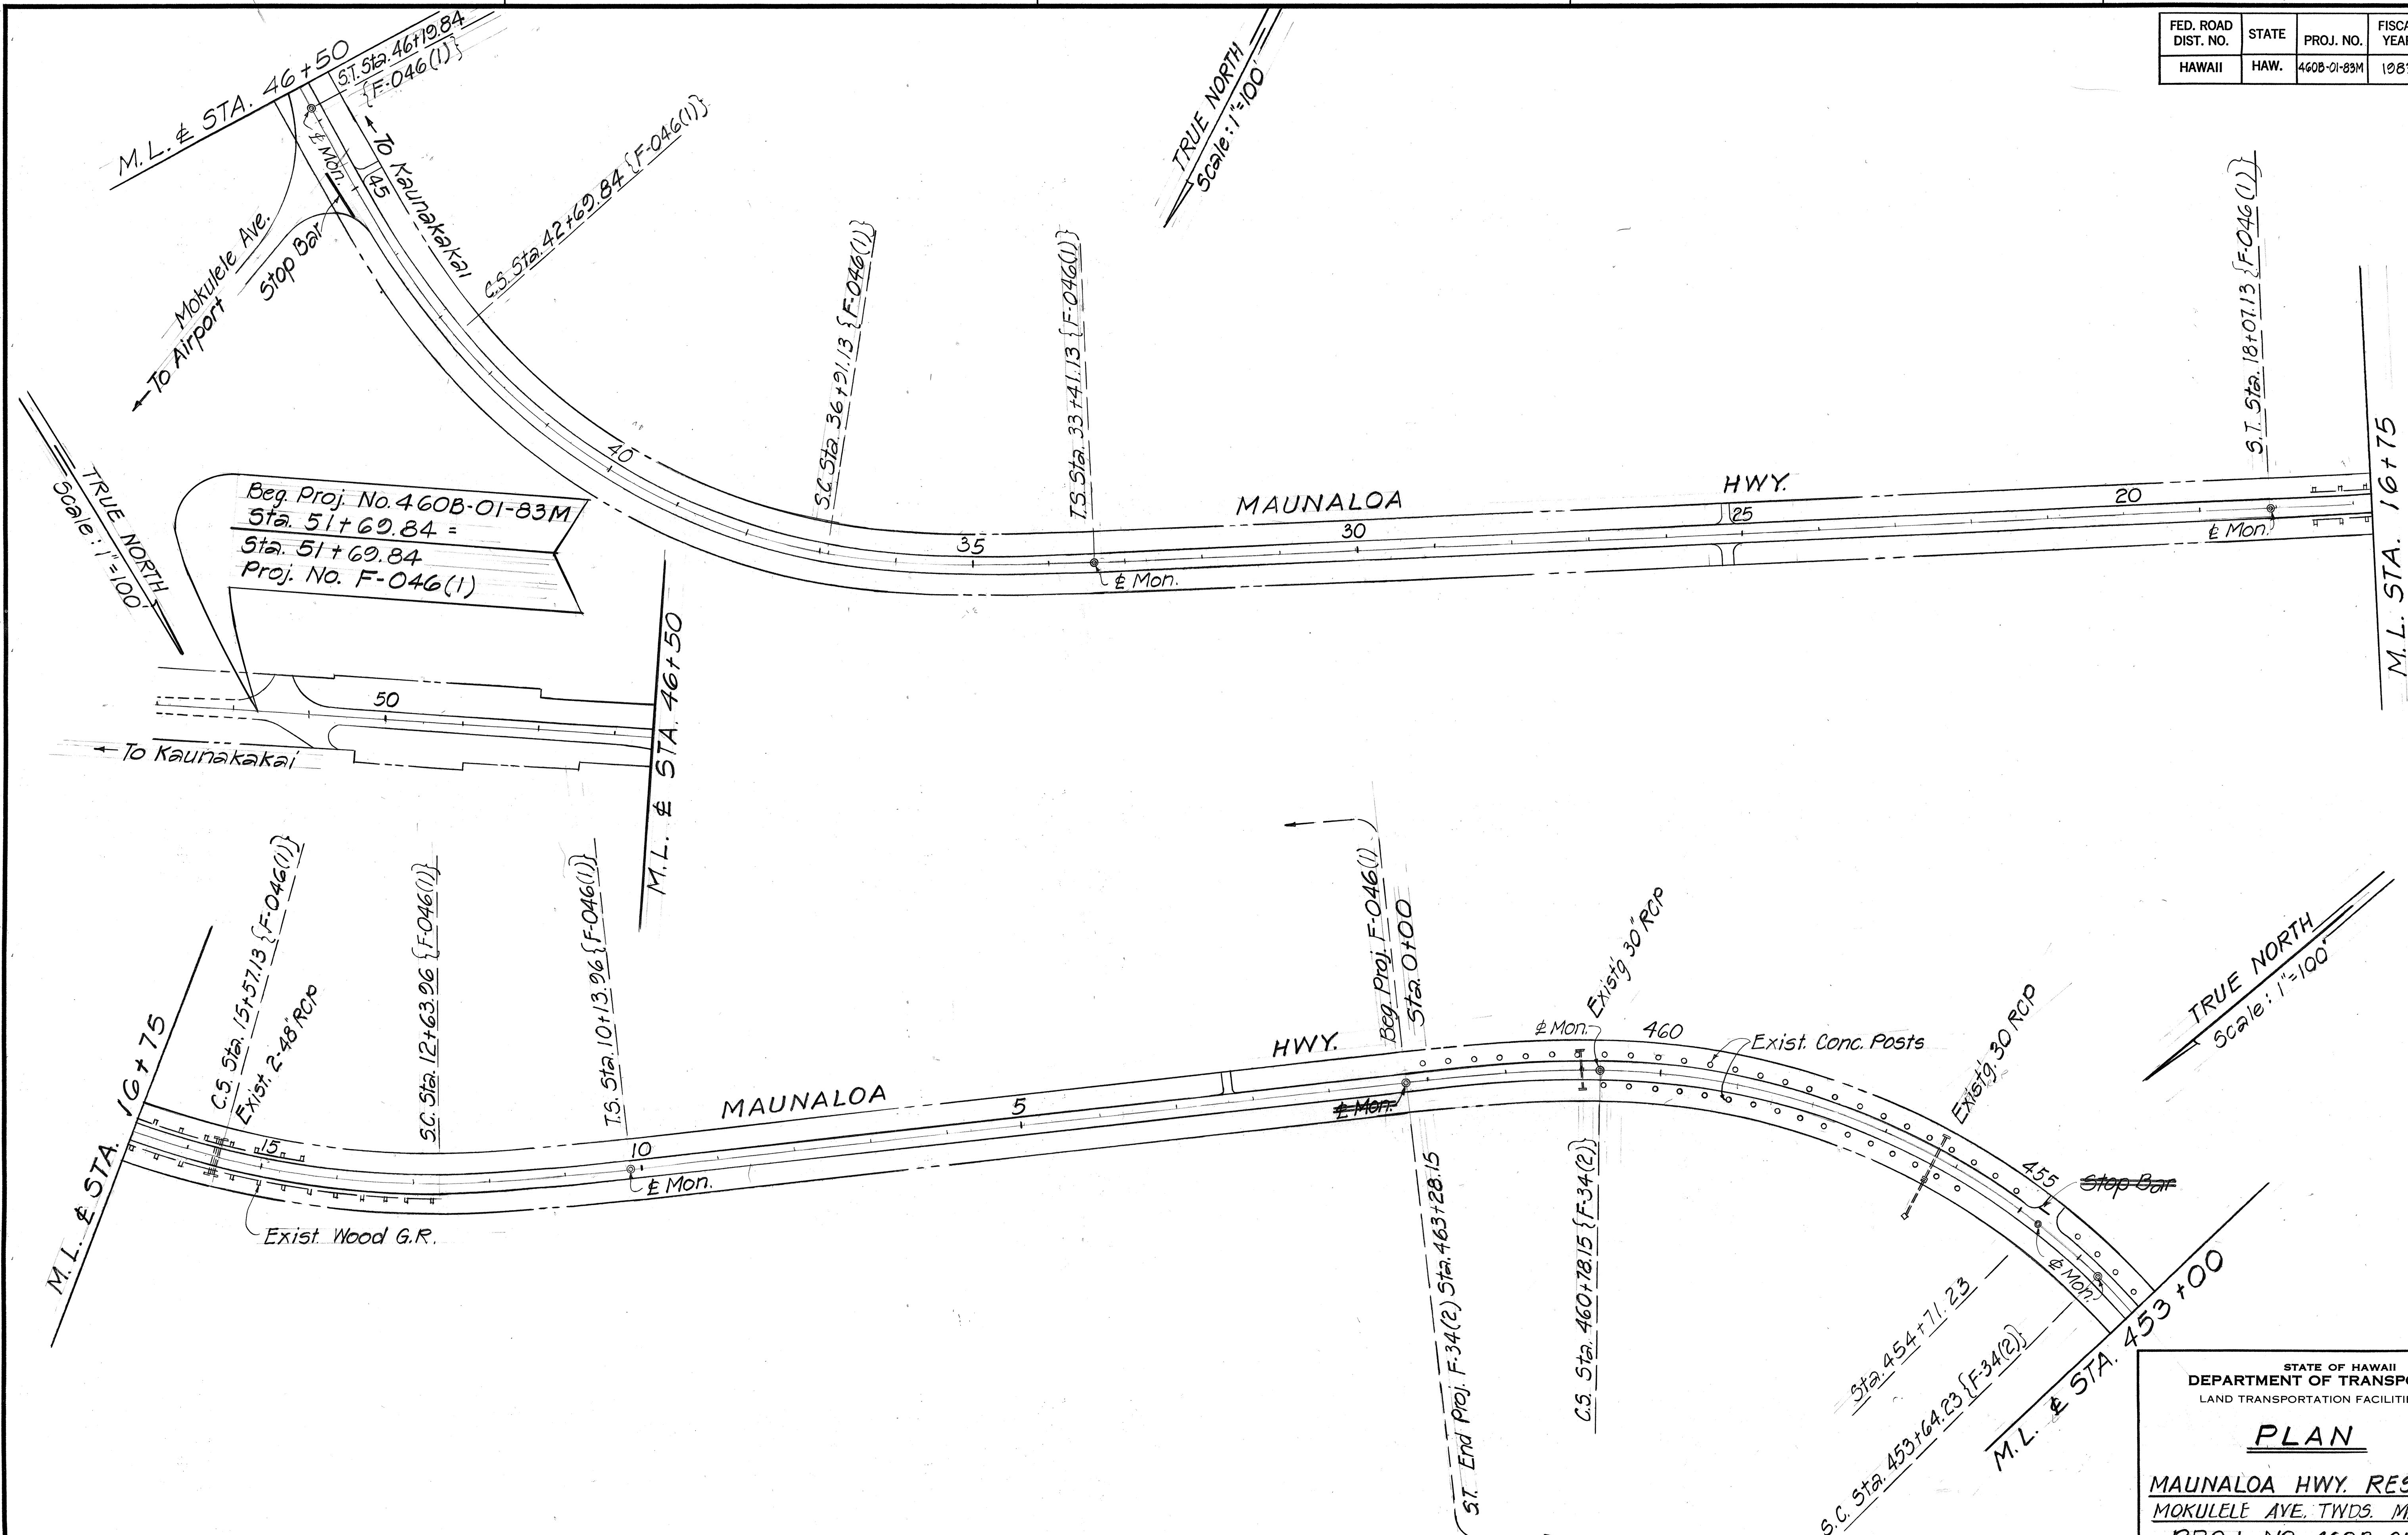


STATE OF HAWAII  
DEPARTMENT OF TRANSPORTATION  
LAND TRANSPORTATION FACILITIES DIVISION

**PLAN**

**MAUNALOA HWY. RESURFACING**  
**MOKULELE AVE. TWDS. MAUNALOA**  
**PROJ. NO. 460B-01-83M**  
**SCALE: AS NOTED** **JUNE 1982**  
**SHEET NO. 1 OF 4 SHEETS**



| FED. ROAD DIST. NO. | STATE | PROJ. NO.   | FISCAL YEAR | SHEET NO. | TOTAL SHEETS |
|---------------------|-------|-------------|-------------|-----------|--------------|
| HAWAII              | HAW.  | 460B-01-83M | 1983        | 4         | 7            |

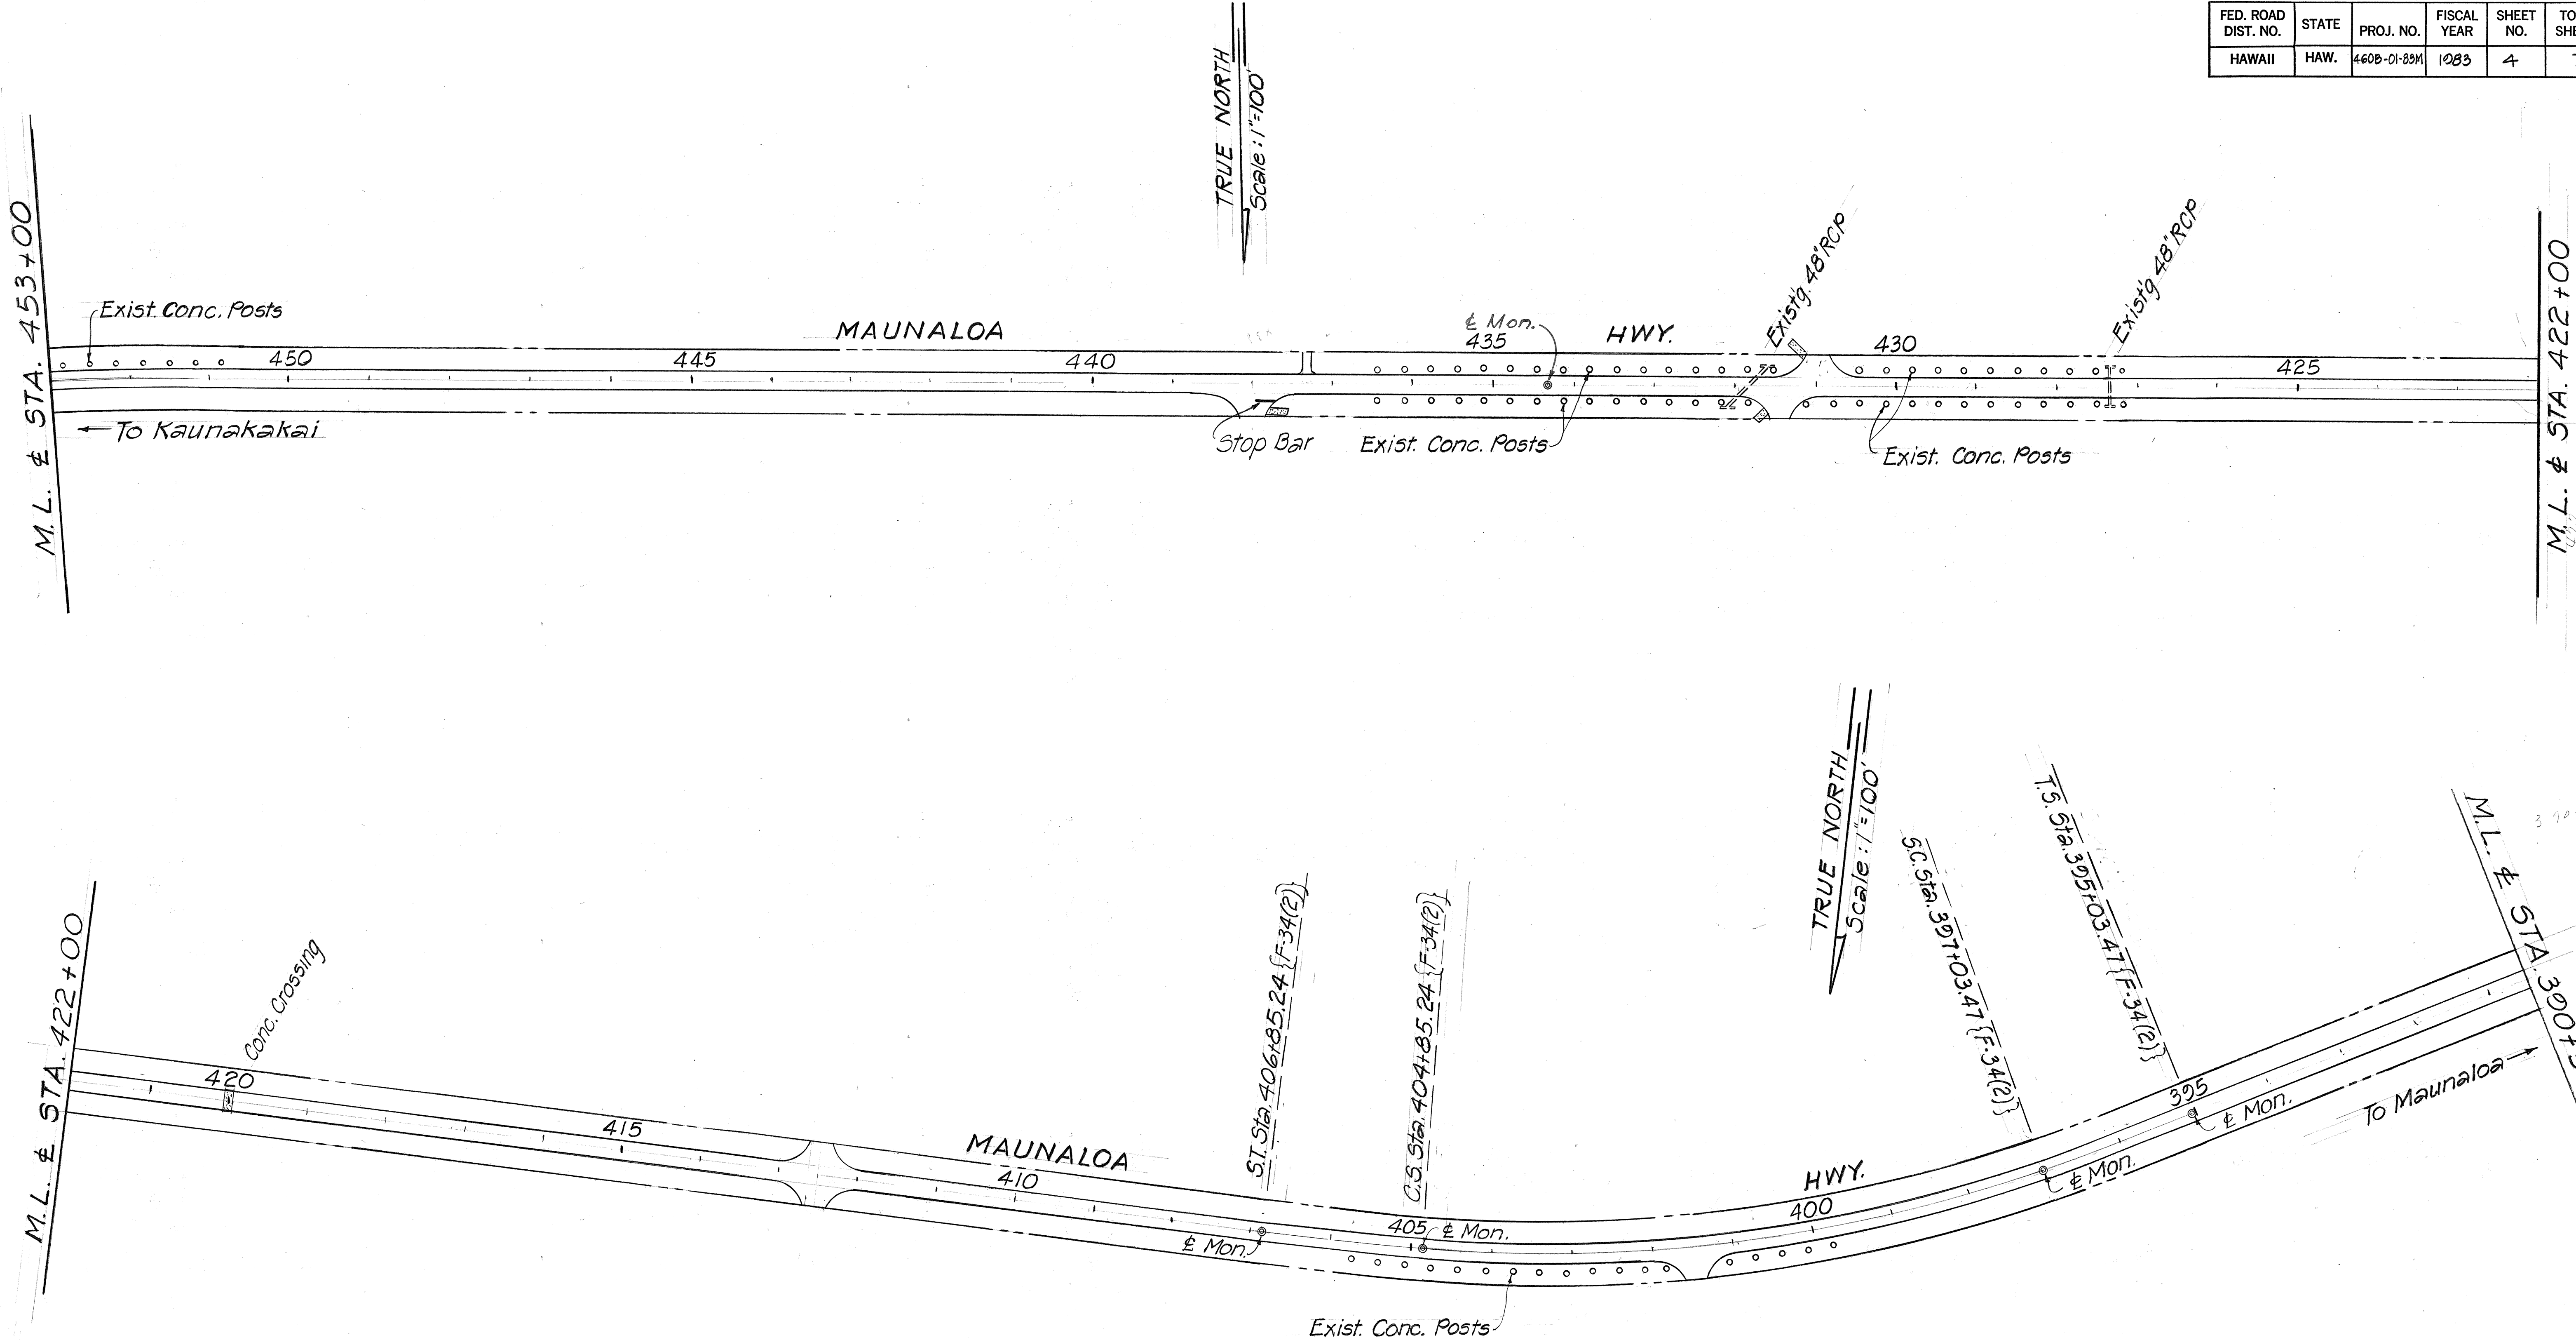

|               |                   |      |
|---------------|-------------------|------|
| ORIGINAL PLAN | SURVEY PLOTTED BY | DATE |
| NOTE BOOK     | DRAWN BY          |      |
| No.           | DESIGNED BY       |      |
|               | CHECKED BY        |      |


STATE OF HAWAII  
DEPARTMENT OF TRANSPORTATION  
LAND TRANSPORTATION FACILITIES DIVISION

### PLAN

**MAUNALOA HWY. RESURFACING**  
MOKULELE AVE. TWD3. MAUNALOA  
PROJ. NO. 460B-01-83M  
SCALE: AS NOTED JUNE 1982  
SHEET NO. 2 OF 4 SHEETS



| FED. ROAD DIST. NO. | STATE | PROJ. NO.   | FISCAL YEAR | SHEET NO. | TOTAL SHEETS |
|---------------------|-------|-------------|-------------|-----------|--------------|
| HAWAII              | HAW.  | 460B-01-83M | 1983        | 5         | 7            |

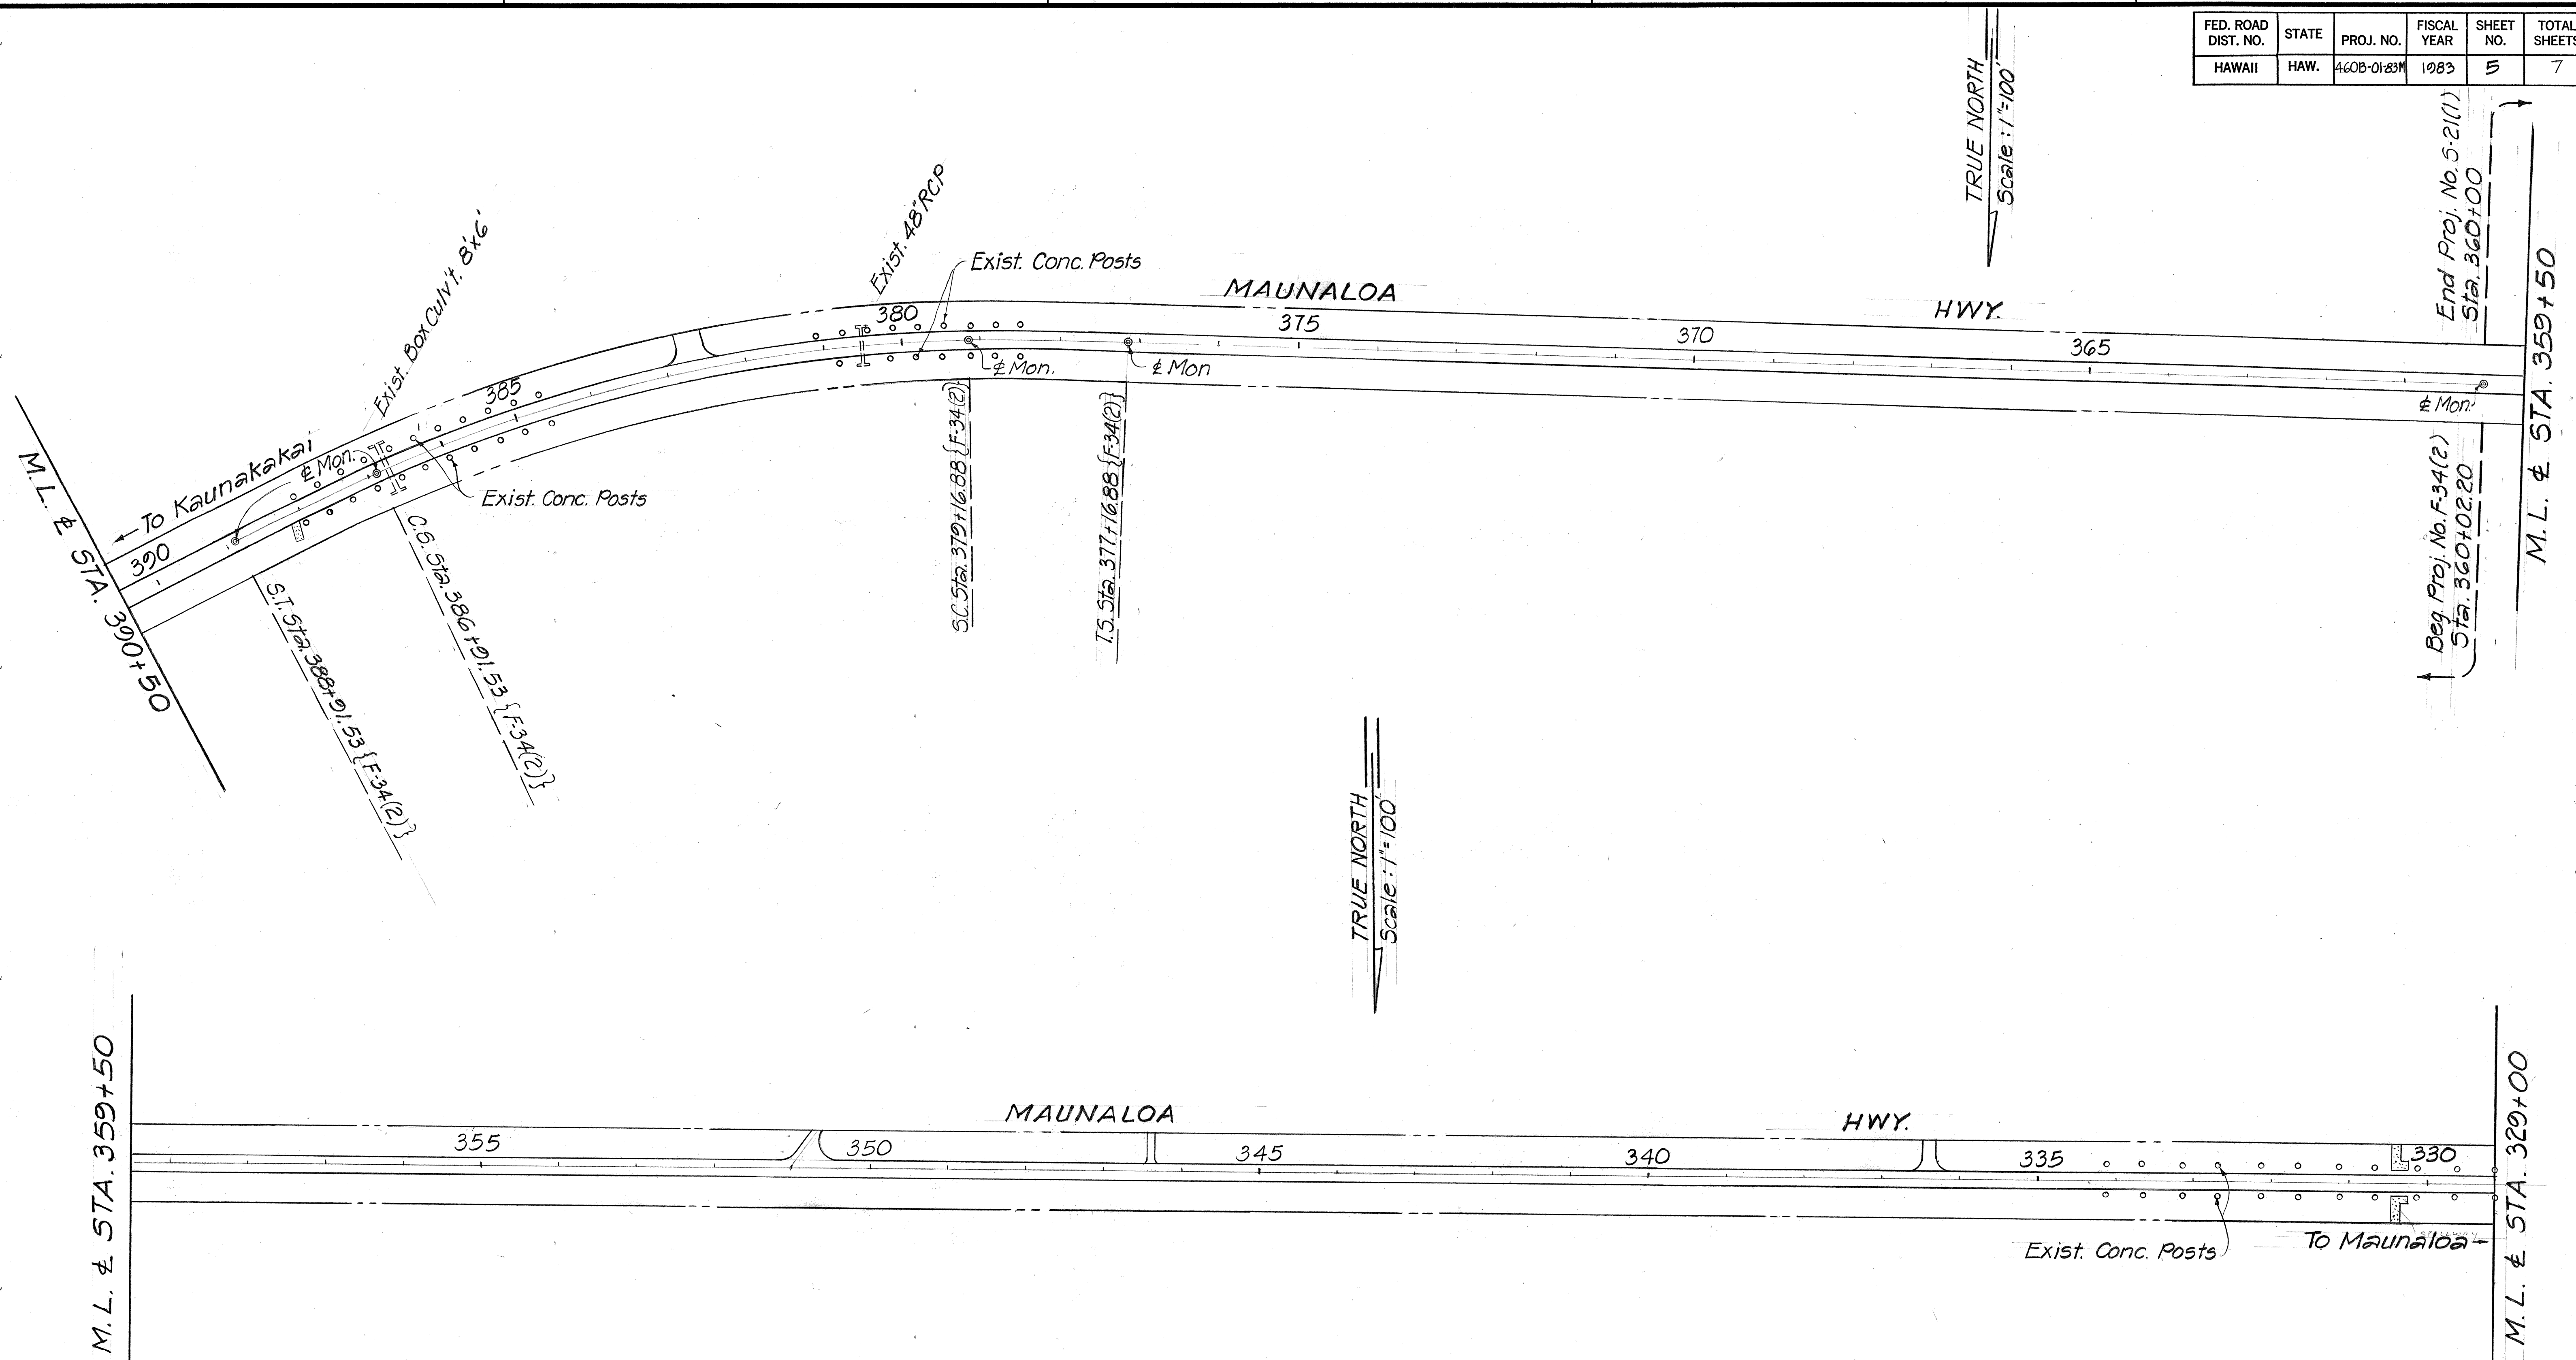

|               |                   |      |
|---------------|-------------------|------|
| ORIGINAL PLAN | SURVEY PLOTTED BY | DATE |
| NOTE BOOK     | DRAWN BY          |      |
| No.           | DESIGNED BY       |      |
|               | CHECKED BY        |      |


STATE OF HAWAII  
DEPARTMENT OF TRANSPORTATION  
LAND TRANSPORTATION FACILITIES DIVISION

**PLAN**

MAUNALOA HWY. RESURFACING  
MOKULELE AVE. TWDS. MAUNALOA  
PROJ. NO. 460B-01-83M  
SCALE: AS NOTED JUNE 1982  
SHEET NO. 3 OF 4 SHEETS



| FED. ROAD DIST. NO. | STATE | PROJ. NO.   | FISCAL YEAR | SHEET NO. | TOTAL SHEETS |
|---------------------|-------|-------------|-------------|-----------|--------------|
| HAWAII              | HAW.  | 460B-01-83M | 1983        | 6         | 7            |

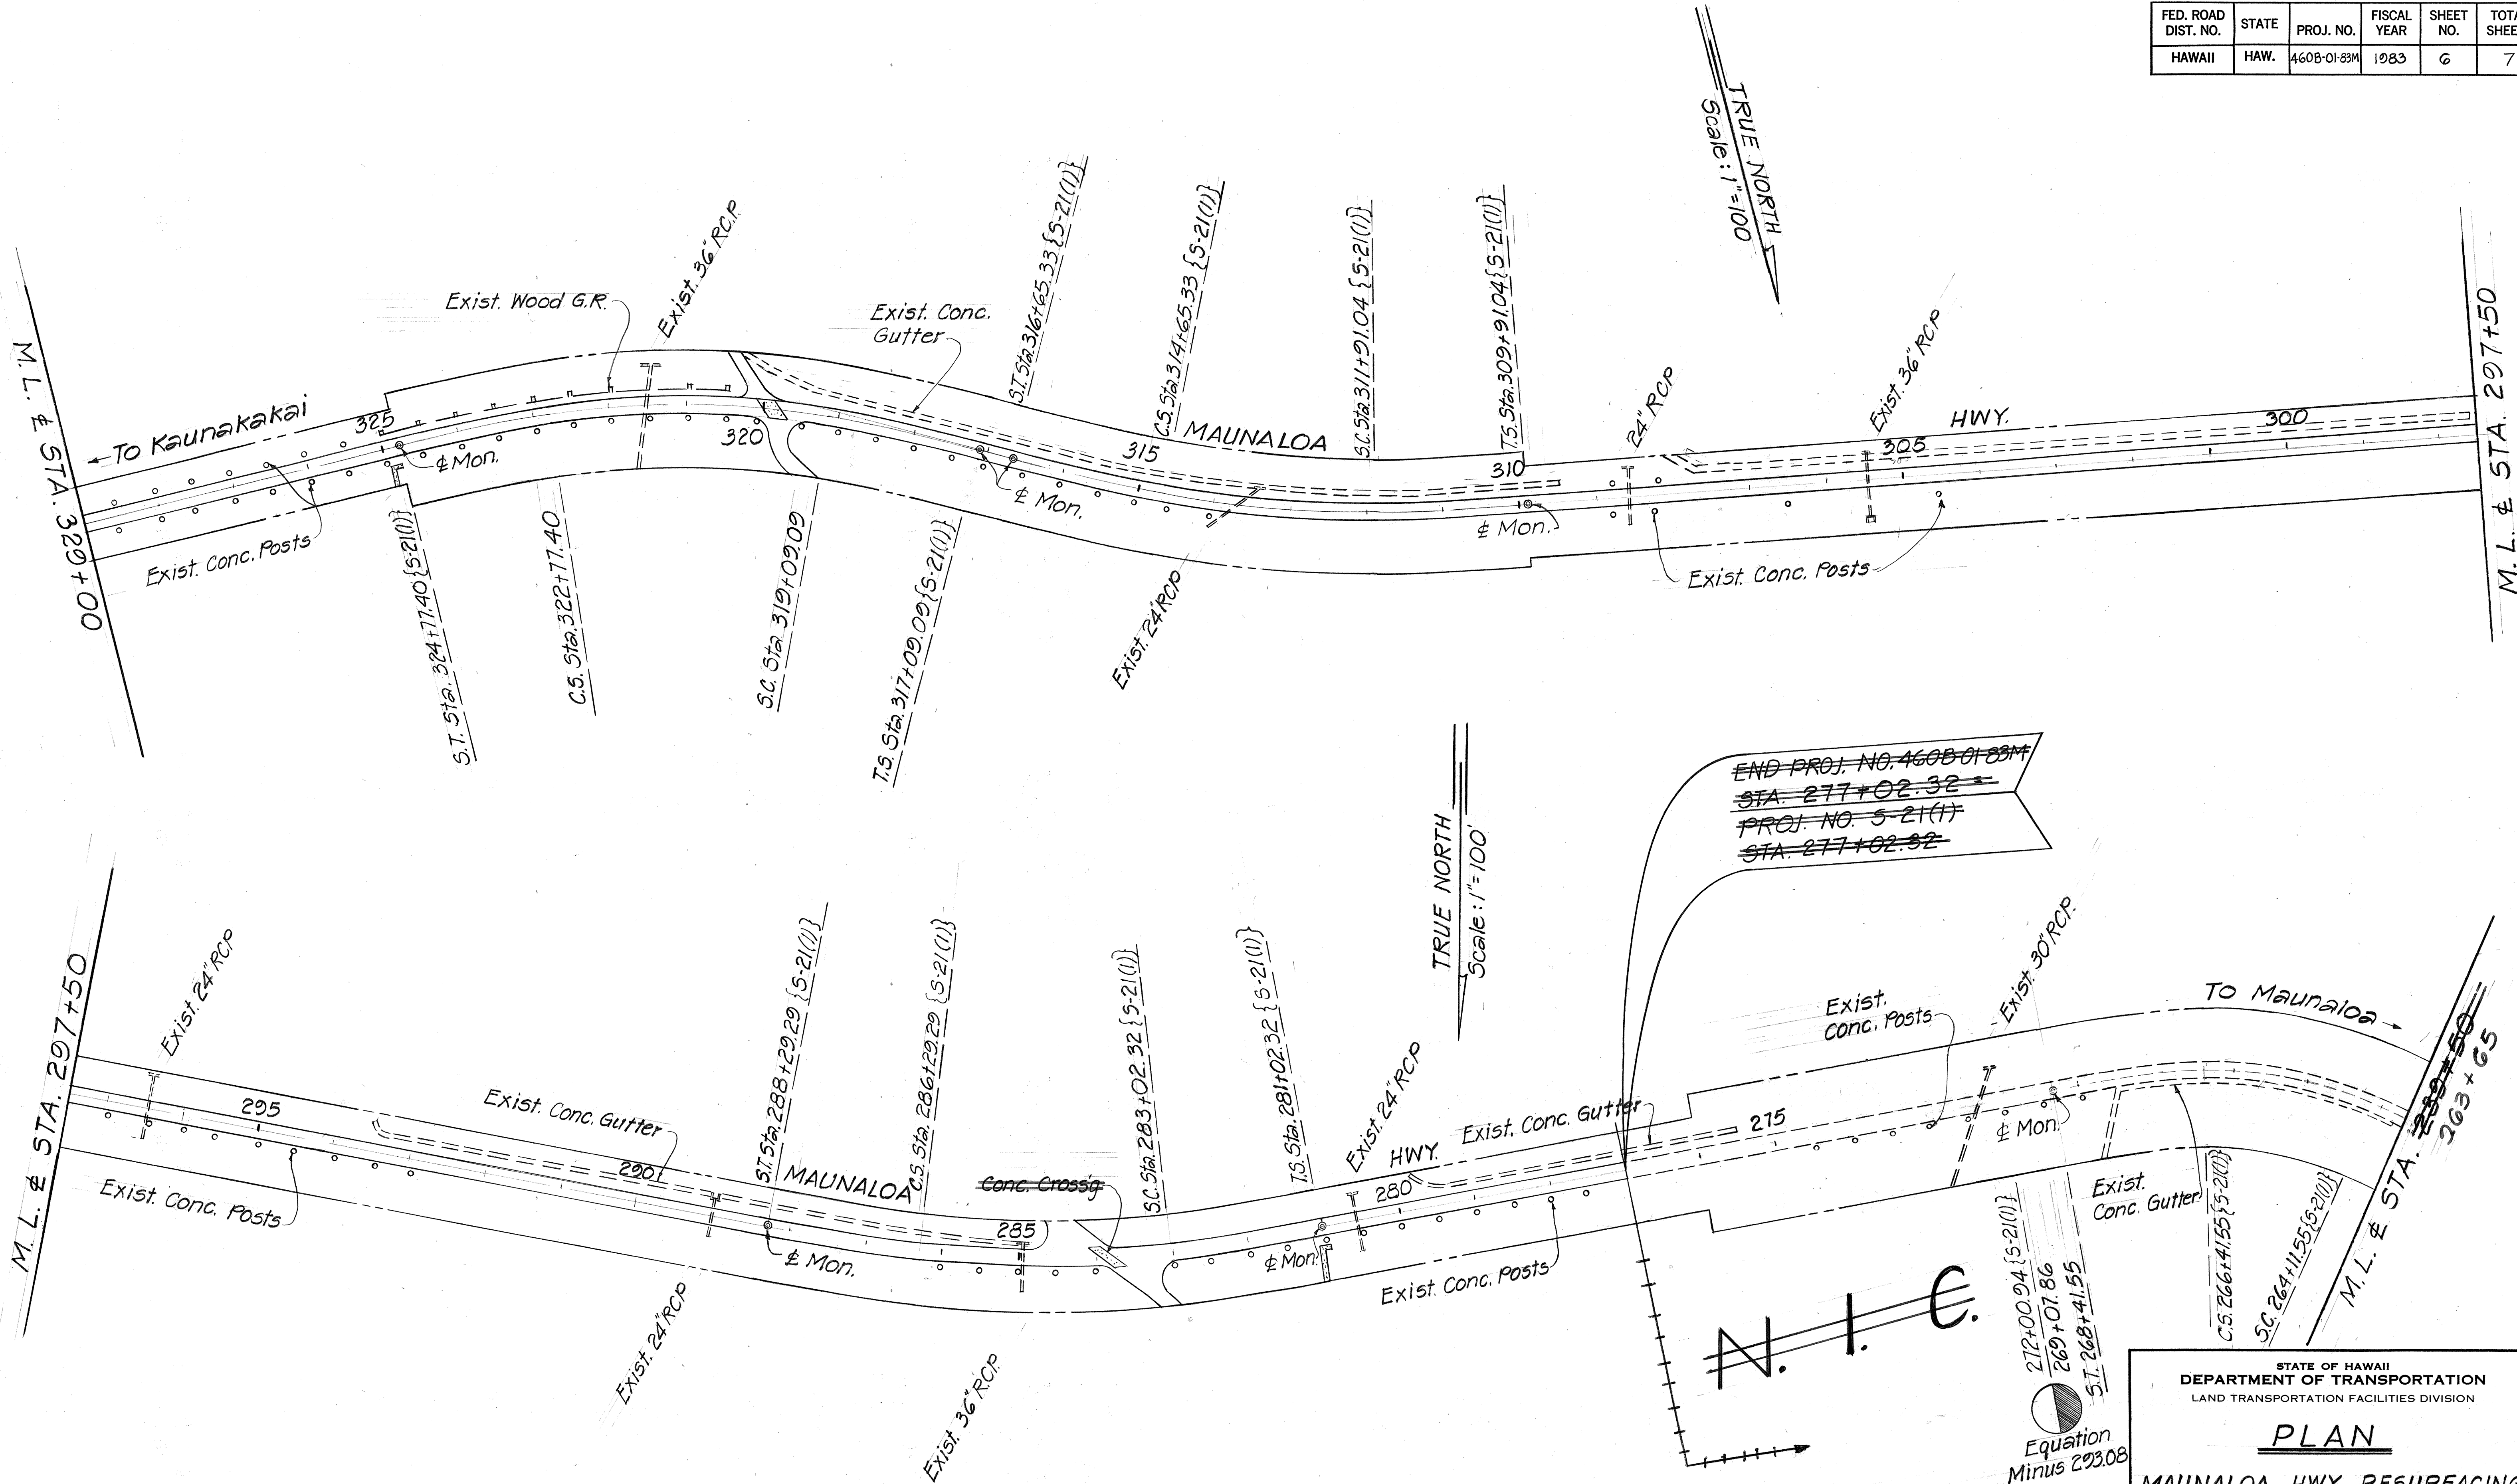

|               |                   |      |
|---------------|-------------------|------|
| ORIGINAL PLAN | SURVEY PLOTTED BY | DATE |
| NOTE BOOK     | DRAWN BY          |      |
| No.           | DESIGNED BY       |      |
|               | CHECKED BY        |      |

STATE OF HAWAII  
DEPARTMENT OF TRANSPORTATION  
LAND TRANSPORTATION FACILITIES DIVISION

**PLAN**

**MAUNALOA HWY. RESURFACING**  
MOKULELE AVE. TWDS. MAUNALOA


PROJ. NO. 460B-01-83M

SCALE: AS NOTED JUNE 1982

SHEET NO. 4 OF 4 SHEETS



| FED. ROAD DIST. NO. | STATE | PROJ. NO.   | FISCAL YEAR | SHEET NO. | TOTAL SHEETS |
|---------------------|-------|-------------|-------------|-----------|--------------|
| HAWAII              | HAW.  | 460B-01-83M | 1983        | CQ 6S-1   | 7            |

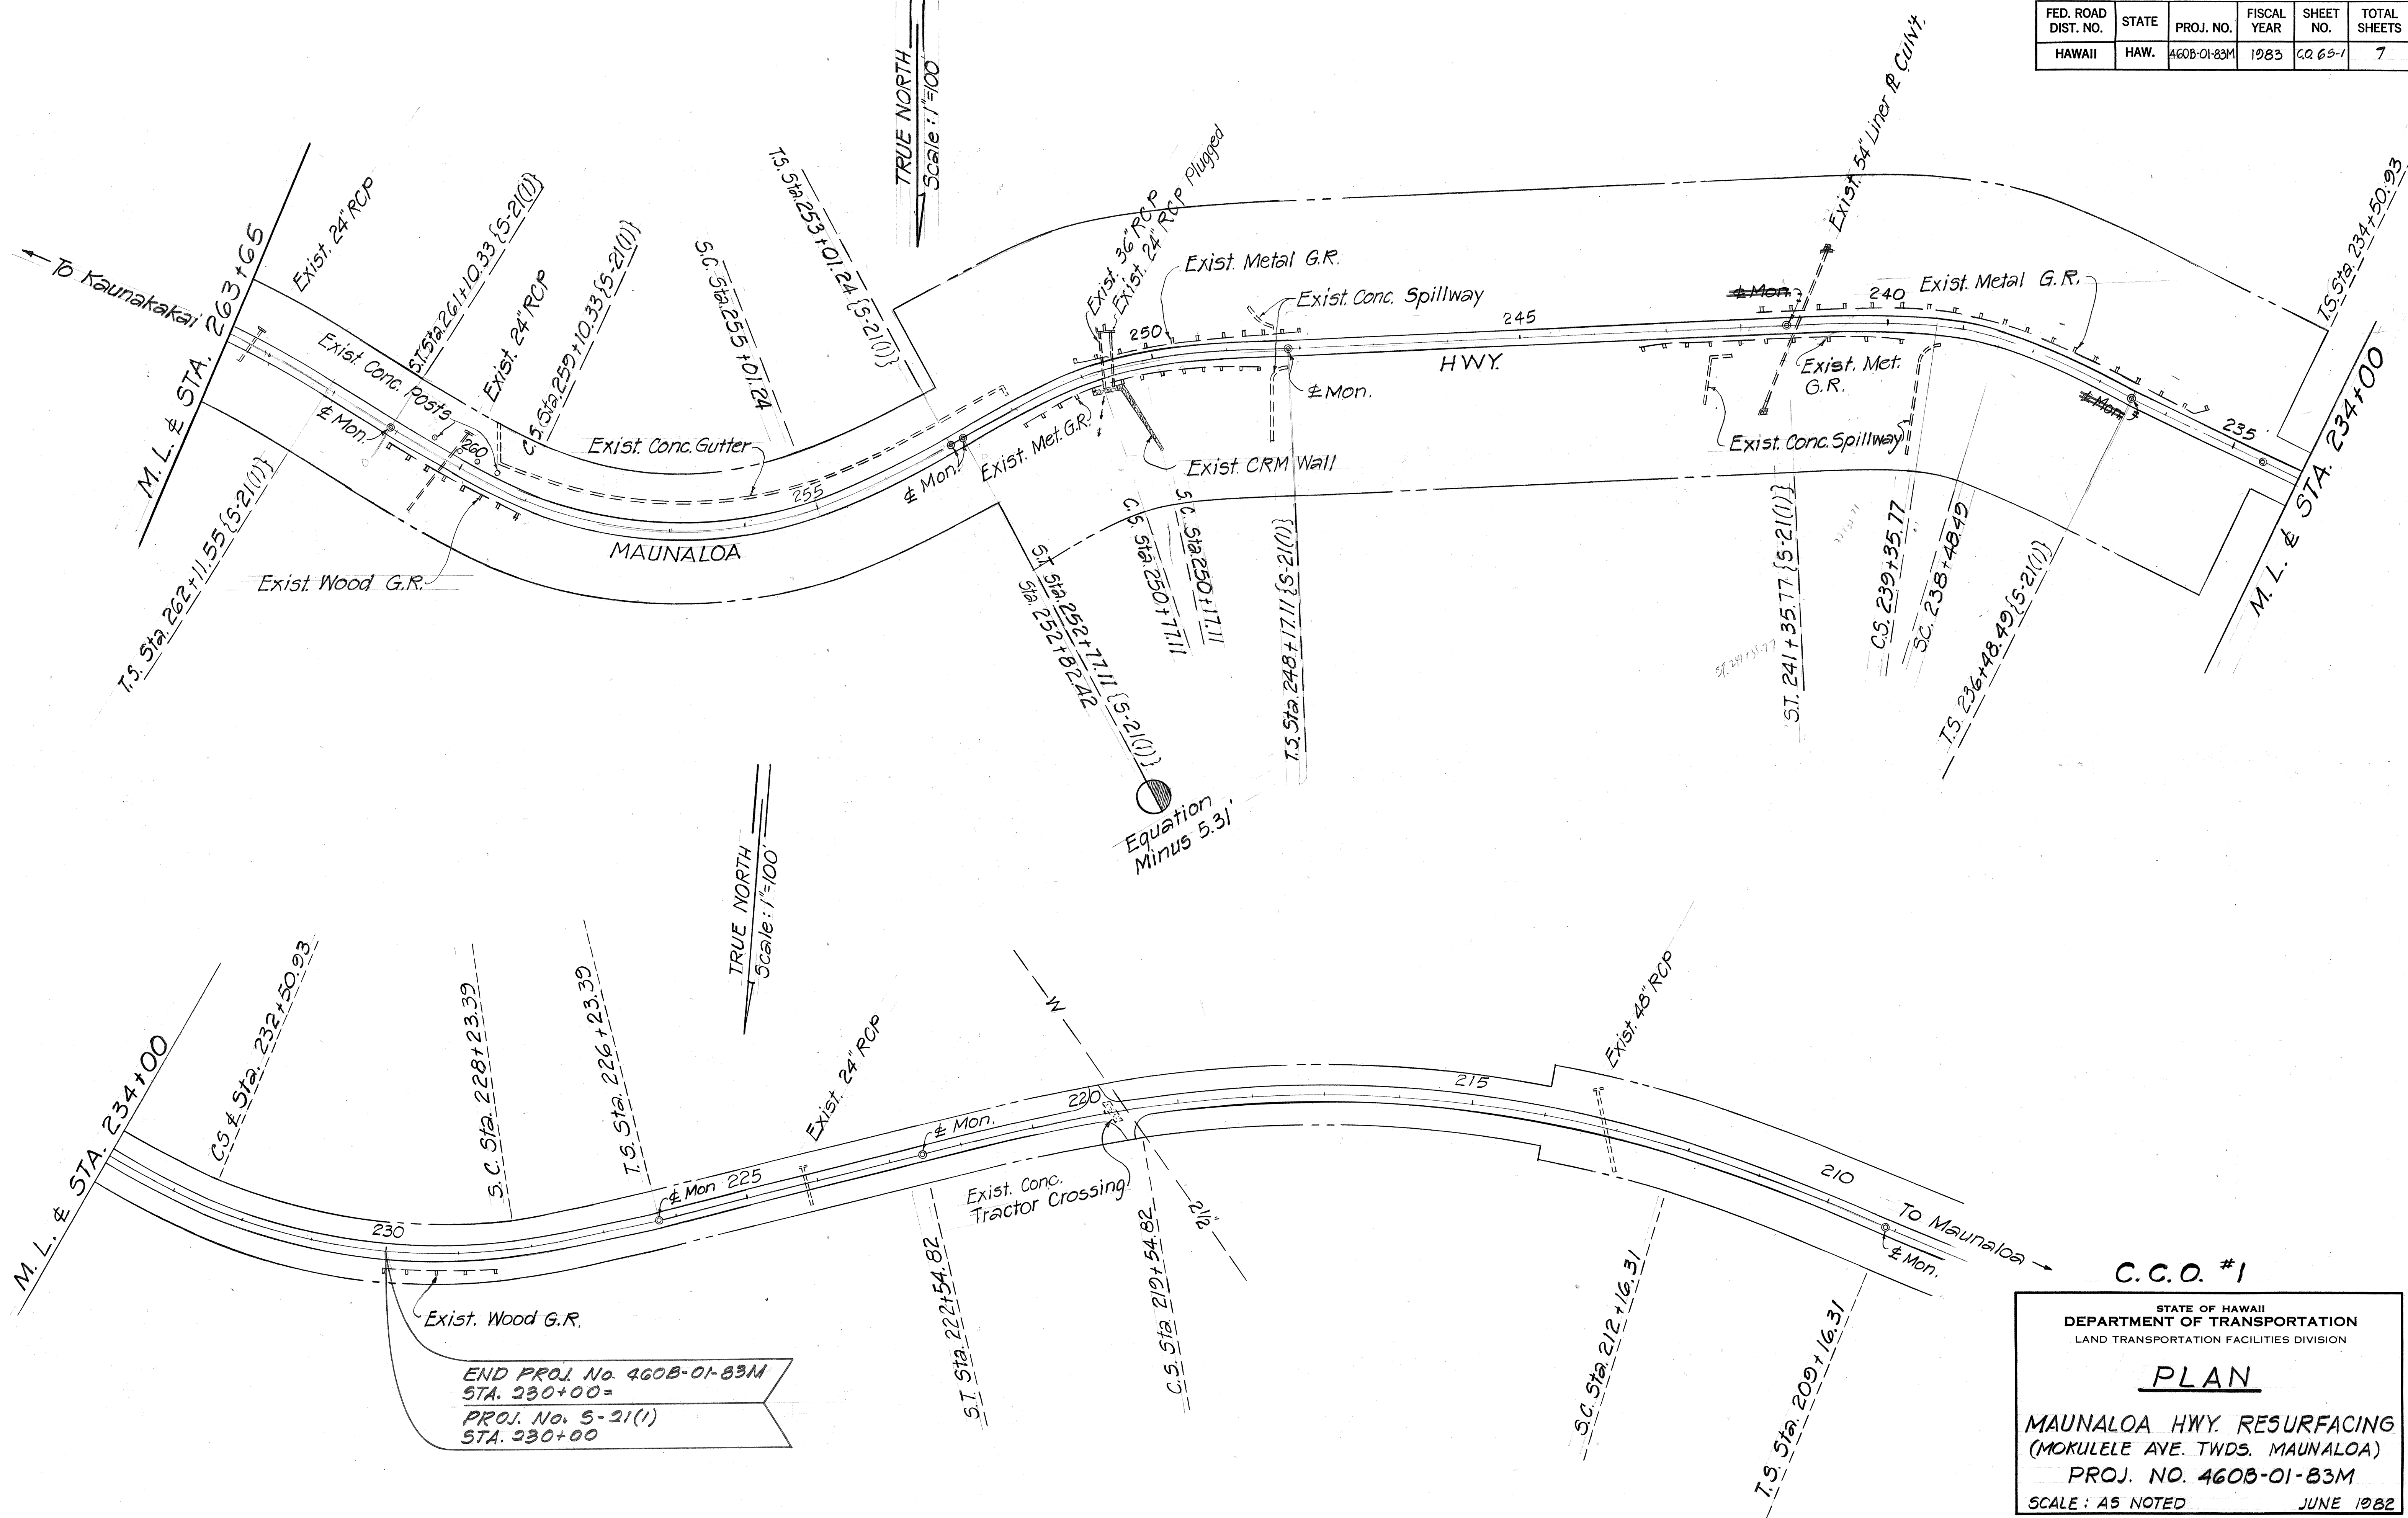

|               |                   |      |
|---------------|-------------------|------|
| ORIGINAL PLAN | SURVEY PLOTTED BY | DATE |
| NO.           | DRAWN BY          |      |
|               | TRACED BY         |      |
|               | DESIGNED BY       |      |
|               | QUANTITIES BY     |      |
|               | CHECKED BY        |      |

END PROJ. No. 460B-01-83M  
STA. 230+00=  
PROJ. No. S-21(1)  
STA. 230+00

C.C.O. #1

STATE OF HAWAII  
DEPARTMENT OF TRANSPORTATION  
LAND TRANSPORTATION FACILITIES DIVISION

**PLAN**

MAUNALOA HWY. RESURFACING  
(MOKULELE AVE. TWDS. MAUNALOA)  
PROJ. NO. 460B-01-83M

SCALE: AS NOTED JUNE 1982  
SHEET NO. 4A OF 4 SHEETS

CQ 6S-1

MAUNALOA HWY RESURF