INDEX	TO DRAWINGS
SHEET NO.	DESCRIPTION
Security of the second of the	TITLE SHEET
2	GENERAL NOTES & ROUTE MARKER SCHEDULE
3	TYPICAL SECTION, DETAILS & GUARD RAIL SCHEDULE
4	MARKER SUMMARY & SIGNING, STRIPING AND MARKER NOTES
5-9	PLANS
10-26	FIELD OFFICE, PROJECT LAB., SIGNING & GUARD RAIL STANDARD DETAILS
27-46 405-18 435-1	DRAINAGE SUMMARY DETAILS & STANDARD DETAILS

TOTAL SHEET COUNT AFTER "AS BUILT" POSTINGS: 48 SHEETS.

AUG., 1984 DATE

548-7490 PHONE

A. NISHIMURA P.S. & E. BY

STATE OF HAWAII

DEPARTMENT OF TRANSPORTATION HIGHWAYS DIVISION

"AS-BUILT"


PLANS FOR

MAUNALOA HIGHWAY

REPLACEMENT OF CULVERTS BETWEEN MAUNALOA VILLAGE AND KAUNAKAKAI - PHASE II

FEDERAL AID PROJECT NO. RS-0460(5)

DISTRICT OF MOLOKAI ISLAND OF MOLOKAI

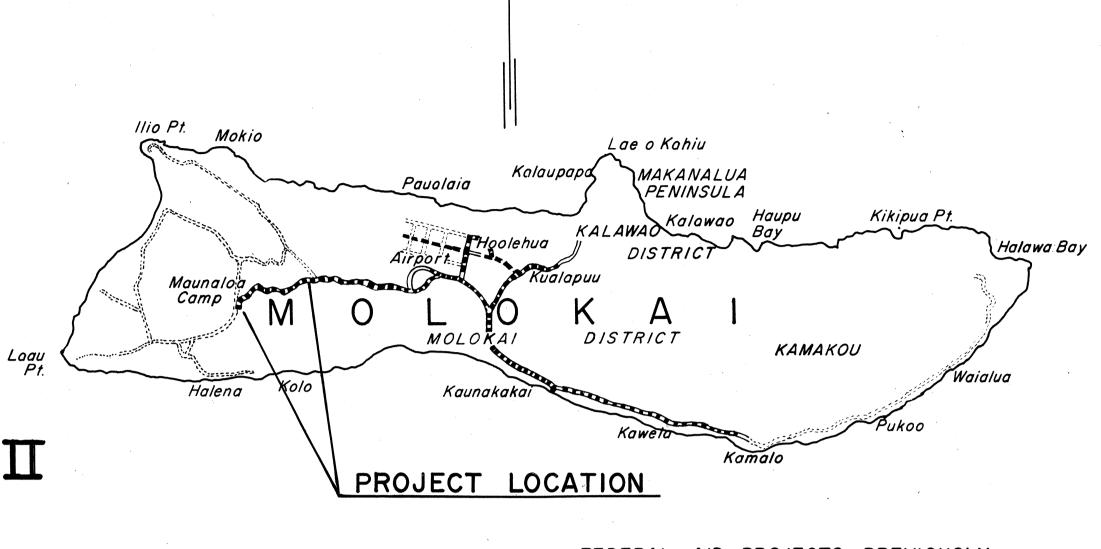

FEDERAL AID PROJECTS PREVIOUSLY CONSTRUCTED OR UNDER CONSTRUCTION

FED. ROAD DIST. NO. STATE PROJ. NO. YEAR NO. SHEETS


HAWAII HAW. RS-0460 1985

DESIGN DESIGNATION

CURRENT ADT (1982) 1,900 DESIGN ADT (1992) 3,260

CHANGES MADE DURING CONSTRUCTION HAVE BEEN INCORPORATED ON THESE PLANS EXCEPT CHANGES IN THE ORIGINAL THEORE-TICAL QUANTITIES. FOR ACTUAL QUANTITIES, REFER TO PROJECT LEDGER AND/OR COMPU-TATION BOOK.

Resident Engineer

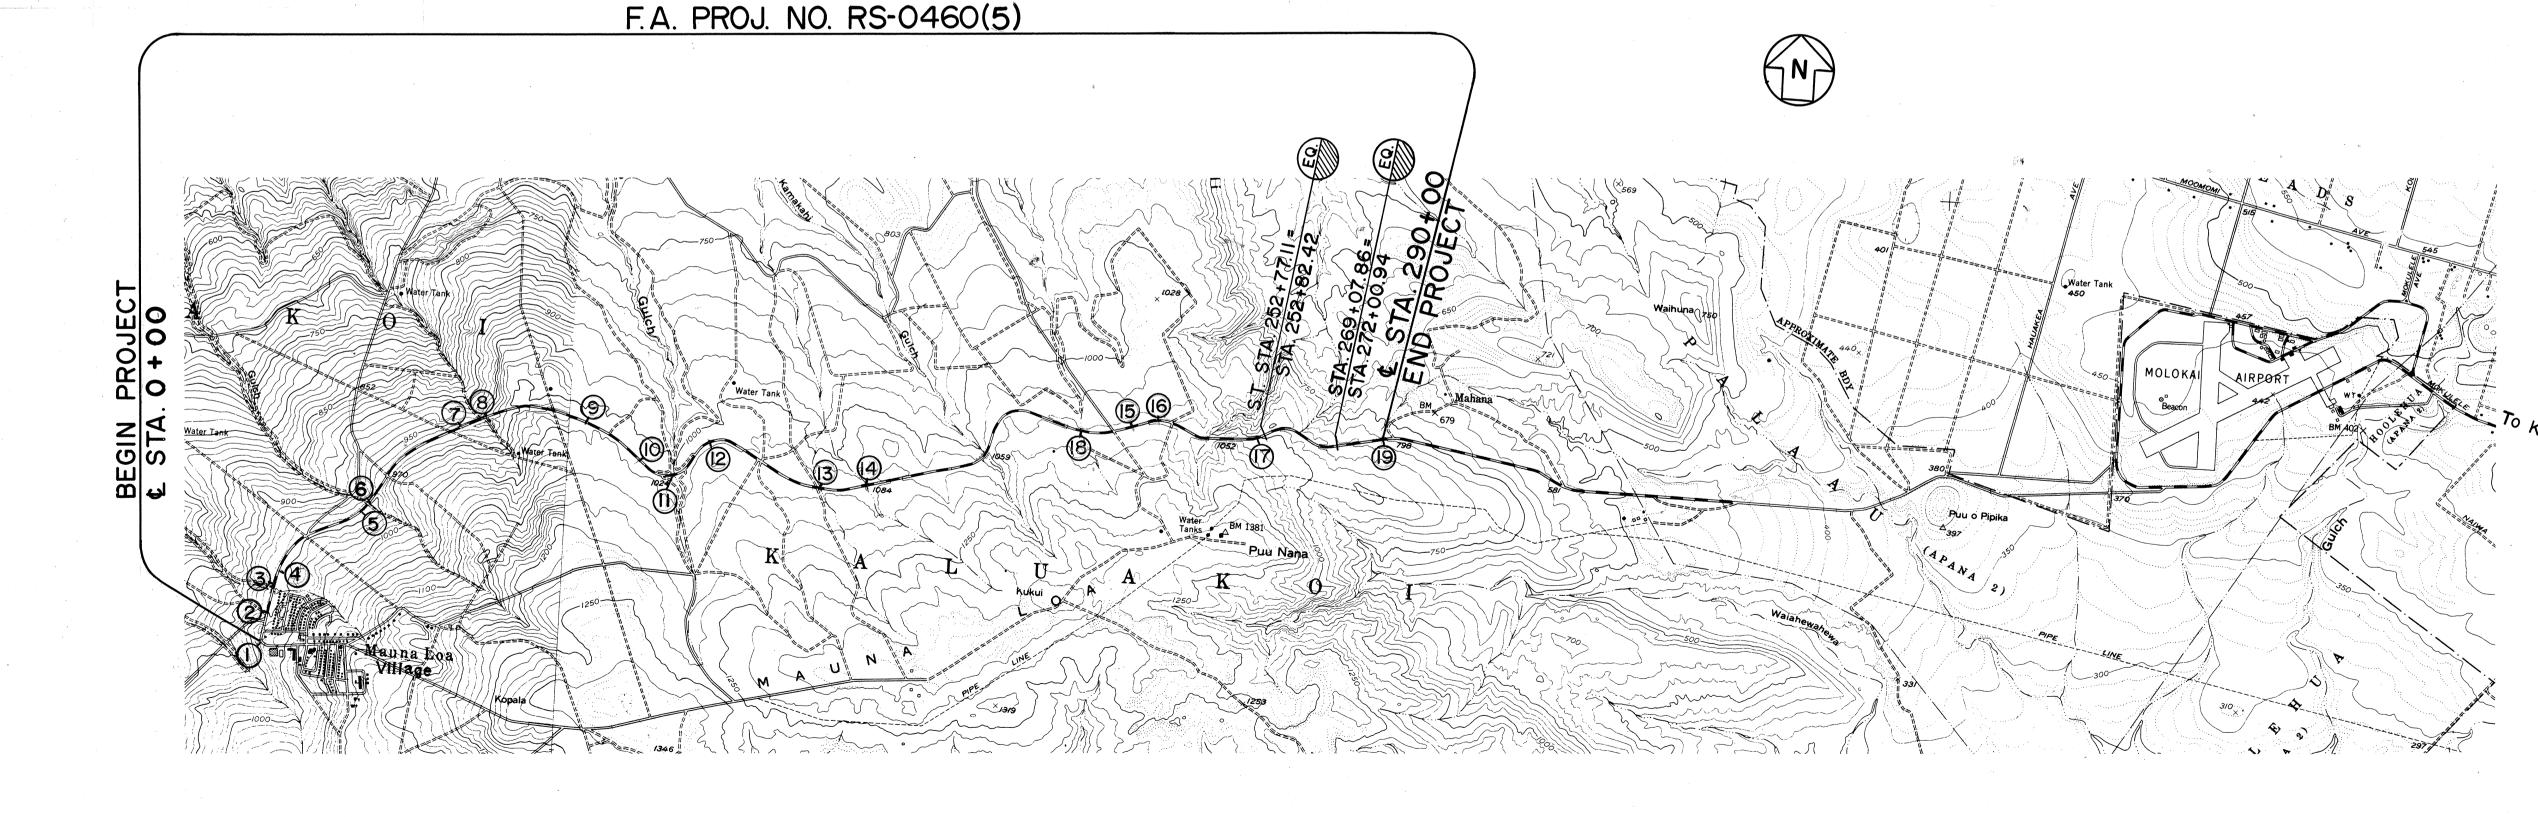

SCALE IN THOUSAND FEET

LAYOUT PLAN LENGTH OF PROJECT 5.436 MI.

DEPARTMENT OF TRANSPORTATION STATE OF HAWAII APPROVED:

DIR OF TRANSPORTATION