


FED. ROAD DIST. NO.	STATE	PROJ. NO.	FISCAL YEAR	SHEET NO.	TOTAL SHEETS
HAWAII	HAW.	460A-01-88	1988	3	6

GENERAL NOTES

1. The scope of work consists of installing metal guardrail and constructing concrete bridge rail build-up and end posts.
2. The Contractor's attention is directed to Subsection 102.05 - Examination of Plans, Specifications, Special Provisions, Site of Work, etc., Subsection 107.13 - Public Convenience and Safety, and Section 645 - Traffic Control of the Special Provisions.
3. Any fences, mailboxes or other public or private property adjacent to the roadway that is disturbed, removed or damaged by the Contractor during his construction operations shall be replaced or repaired by the Contractor at his expense.
4. The Contractor shall remove and dispose of all existing concrete posts and guardrail as directed by the Engineer. This work shall be considered incidental to new guardrail.

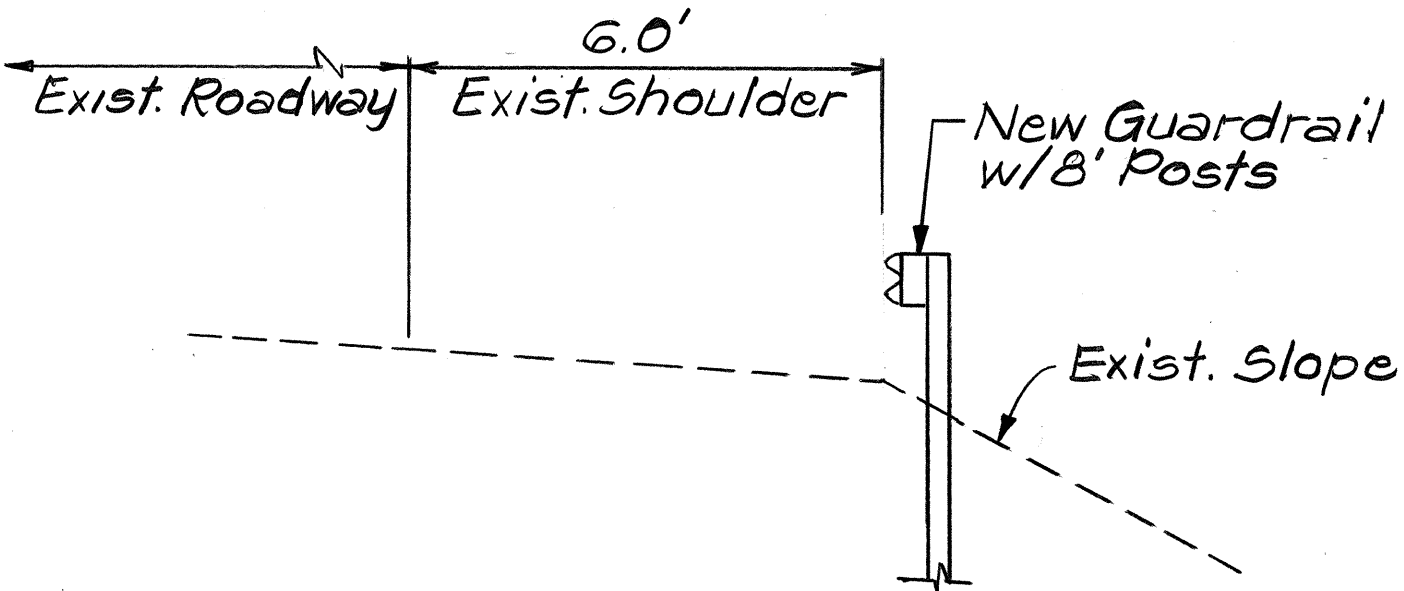

TYPICAL SECTION
WORKSITE NO. 1

SURVEY PLOTTED BY	DATE
DRAWN BY	
DESIGNED BY	
CHECKED BY	
ORIGINAL PLAN	
NOTE BOOK	
No.	

STATE OF HAWAII
DEPARTMENT OF TRANSPORTATION
HIGHWAYS DIVISION

GENERAL NOTES
AND TYPICAL SECTION

MAUNALO A HIGHWAY
GUARDRAIL IMPROVEMENTS
Proj. No. 460A-01-88

Scale: As Noted Date: Apr, 1988

SHEET No. 1 OF 1 SHEETS