
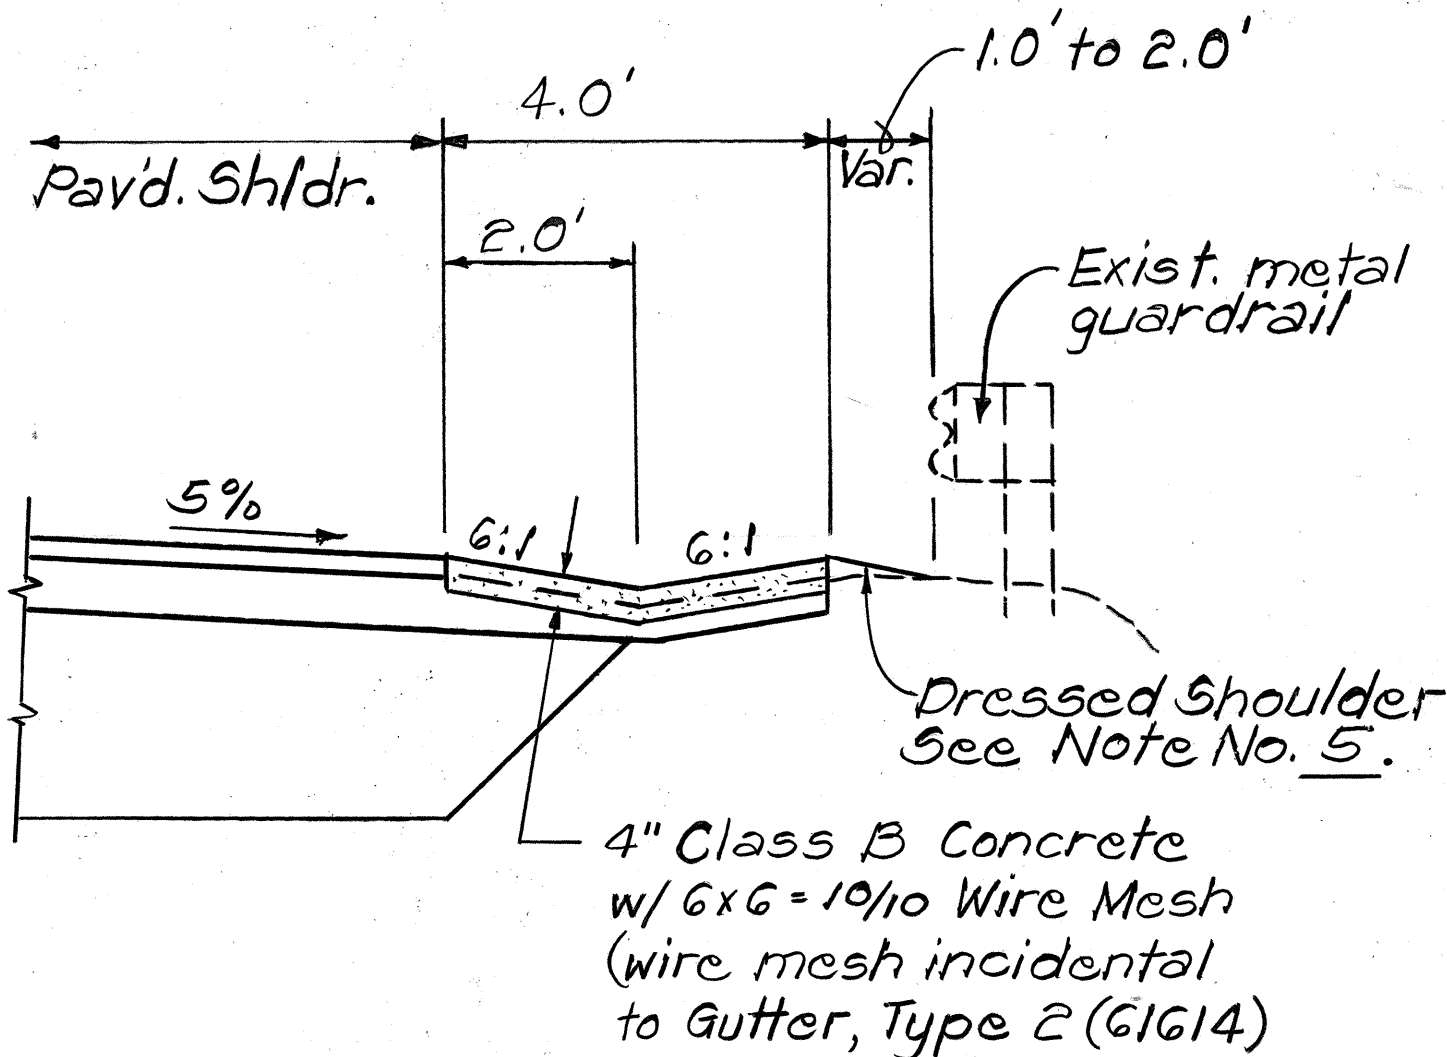


FED. ROAD DIST. NO.	STATE	PROJ. NO.	FISCAL YEAR	SHEET NO.	TOTAL SHEETS
HAWAII	HAW.	460A-01-00M	1980	3	23

GENERAL NOTES

- The Project begins on Kaunakakai Wharf Road at M.P. 0.0 in Kaunakakai and proceeds on Maunaloa Highway, towards Maunaloa Village, ending at Keonelele Avenue at M.P. 6.06. Improvements consists of constructing paved shoulders, concrete gutter, concrete channel, and edge striping.
- The Contractor's attention is directed to Sub-Sections 104.04, 107.13, 107.21, Section 645 of the Standard Specifications and the Special Provisions.
- The existence and location of underground utilities, manholes, monuments and structures as shown on the plans are from the latest available data, but the accuracy is not guaranteed. The encountering of other obstacles during the course of the work is possible. The Contractor shall be held liable for any damages incurred to the existing facilities and/or improvements as a result of his operations.
- Saw-cutting of existing pavement shall not be measured or paid for separately but shall be considered incidental to Paved Shoulder.
- Dressed shoulders shall consist of cleaning, grubbing, grading, reshaping and compacting the unpaved shoulders with suitable excavation material as shown on the plans and/or as directed by the Engineer. This work shall be considered incidental to the various contract items.
- The Contractor shall notify the State, in writing, two weeks prior to starting paving operations.
- All construction signs shall be left in place until all construction items have been completed. Contractor shall obtain prior approval from the Engineer to remove construction signs.
- Smooth riding connections shall be constructed at the beginning and end of the project, and at all connecting approaches as directed by the Engineer. This work shall be considered incidental to Paved Shoulder.
- The Contractor shall construct shoulder only one side at a time.
- The Contractor shall not leave more than a 1/2" drop-off at the edge of pavement, at the end of each work day. Whenever the Contractor leaves a 1/2" drop-off, the Contractor shall install delineators at 80 feet on center along the edge of the pavement. This work, which includes furnishing, installing, cleaning, maintaining correct placement and removing when required, shall be considered incidental to Paved Shoulder.
- Resurfacing of side roads as shown on the plans and/or as directed by the Engineer shall be considered incidental to the various contract items.

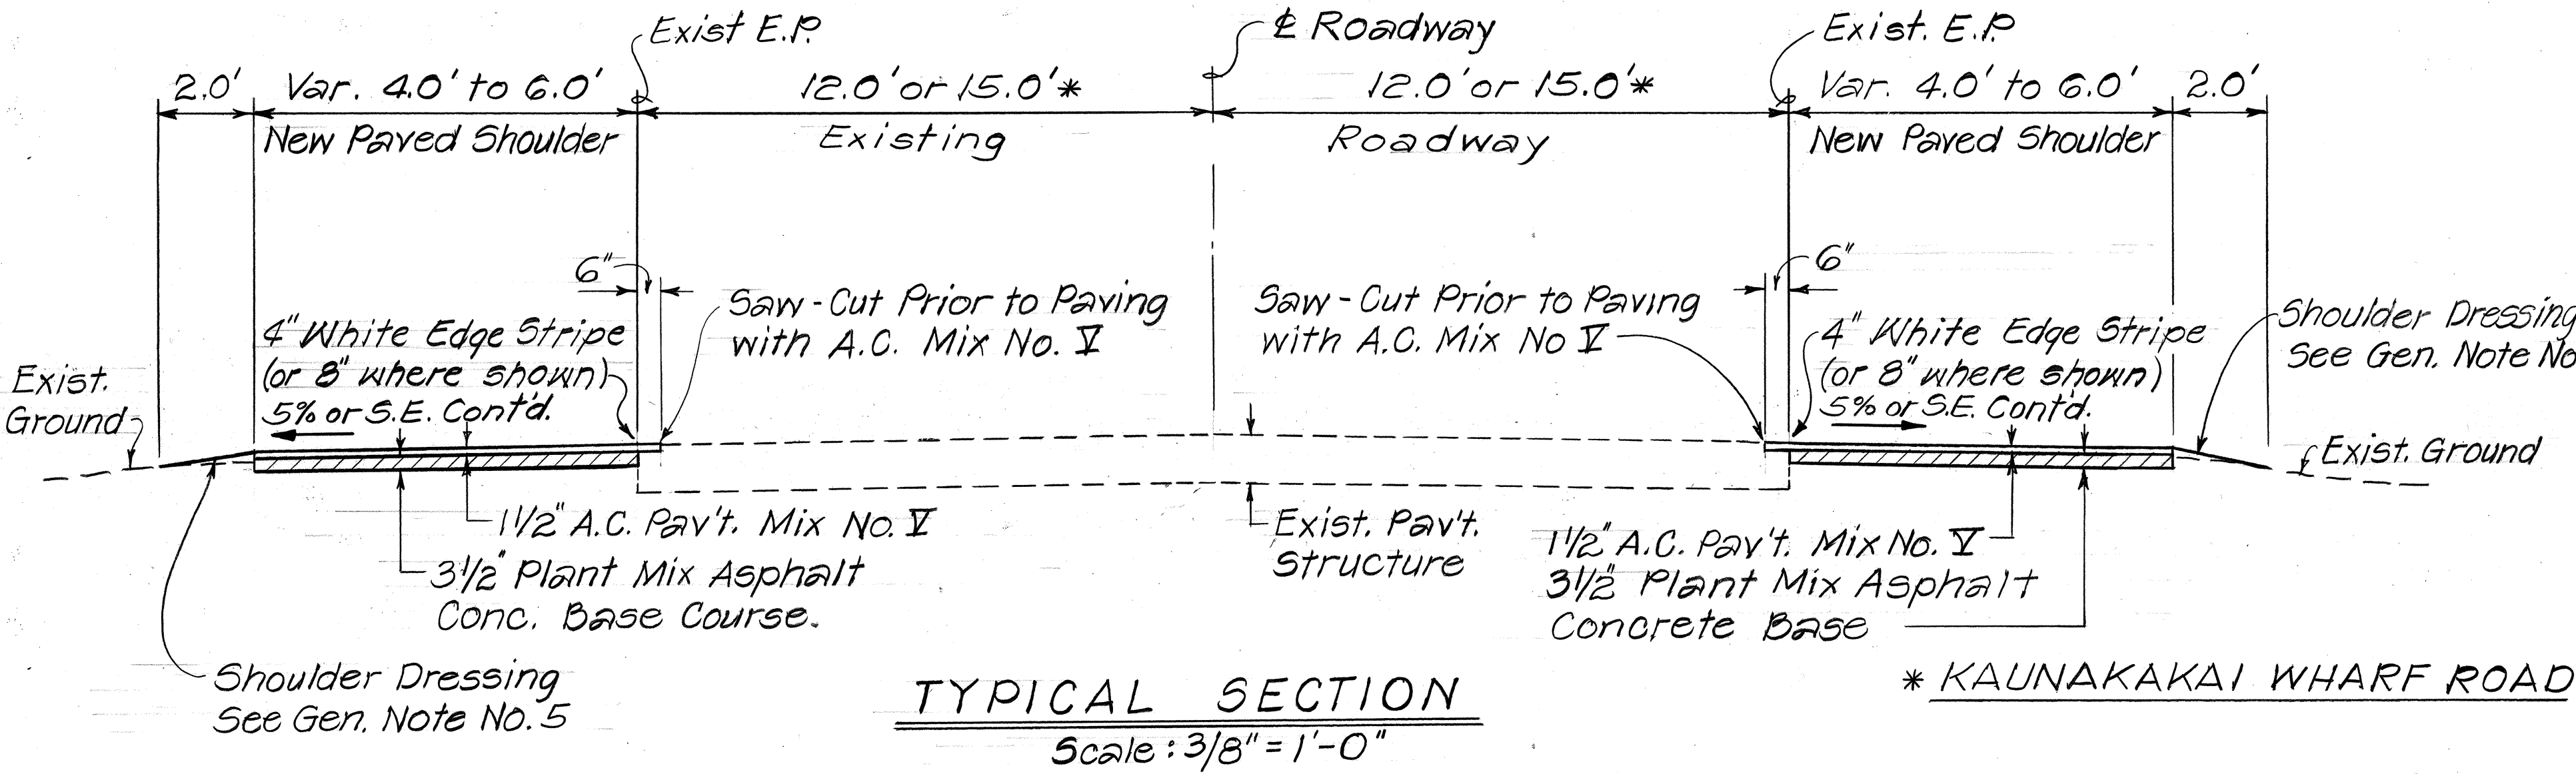

GUTTER DETAIL TYPE 2 (6/6/4)

Scale: 1/2" = 1'-0"

SURVEY PLOTTED BY	DATE
DRAWN BY	
CHECKED BY	
NOTED BY	
QUANTITIES BY	
CHECKED BY	
ORIGINAL PLAN	
NO.	

STATE OF HAWAII DEPARTMENT OF TRANSPORTATION HIGHWAYS DIVISION	
GENERAL NOTES, TYPICAL SECTION & DETAIL	
MAUNALOA HIGHWAY Kaunakakai to Keonelele Avenue Project No. 460A-01-00M	
SCALE: AS SHOWN	DATE: NOV. 1980
SHEET NO. 1 OF 1 SHEETS	