	INDEX TO DRAWINGS
SHEET NO.	DESCRIPTION
	TITLE SHEET
2	STANDARD PLANS SUMMARY
3	GENERAL NOTES, TYPICAL SECTION & DETAIL
4-19	ROADWAY PLANS
20-22	DRAINAGE DETAILS
23	PAVEMENT MARKING SCHEDULE
·	
	·
,	
*	

**05-11-90** DATE

**548-7490**PHONE

A. NISHIMURA
P. S. & E. BY

HWY DD UNIT D
DESIGNED BY

STATE OF HAWAII

DEPARTMENT OF TRANSPORTATION
HIGHWAYS DIVISION

HONOLULU, HAWAII


"AS-BUILT"
PLANS FOR

MAUNALOA HIGHWAY SHOULDER PAVING

KAUNAKAKAI TO KEONELELE AVENUE

PROJECT NO. 460A-01-90M

DISTRICT OF MOLOKAI ISLAND OF MOLOKAI

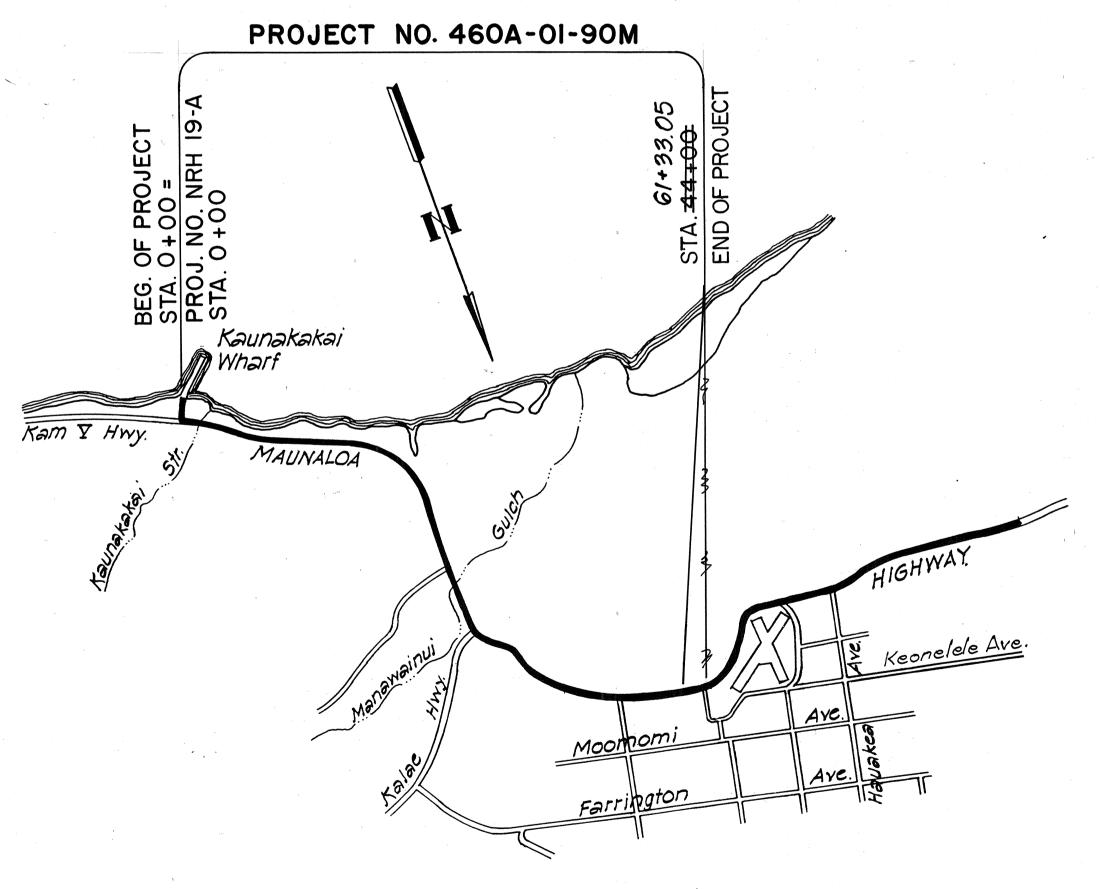

LAYOUT OF PROJECT


SCALE: I" = I MILE


LENGTH OF PROJECT.....<del>6.97</del> MILES *6.72* 

FED. ROAD DIST. NO. STATE PROJ. NO. FISCAL SHEET NO. SHEETS

HAWAII HAW. 460A-01-90M 1990 1 23



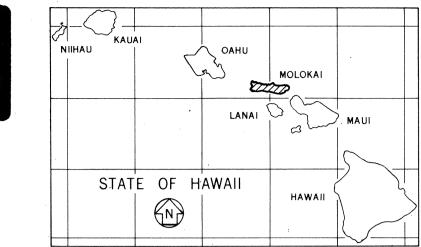

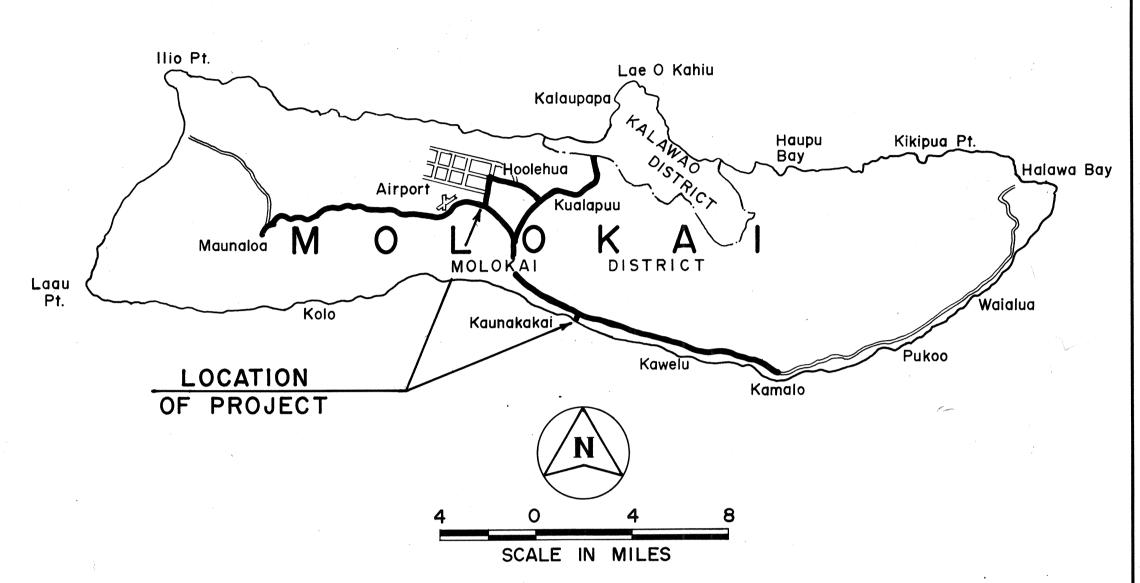

FEDERAL AID PROJECTS PREVIOUSLY CONSTRUCTED OR UNDER CONSTRUCTION

72

MILE POST 0.0 TO MILE POST 6.97

ALL CHANGES MADE DURING CONSTRUCTION HAVE BEEN NOTED IN RED ON THESE TRACINGS AND CHECKED BY

RESIDENT ENGINEER DATE

DEPARTMENT OF TRANSPORTATION
STATE OF HAWAII

APPROVED:

Live fransportation DATE