




FED. ROAD DIST. NO.	STATE	HIGHWAY PROJ. NO.	FISCAL YEAR	SHEET NO.	TOTAL SHEETS
HAWAII	HAW.	460A-02-06	2010	10	16

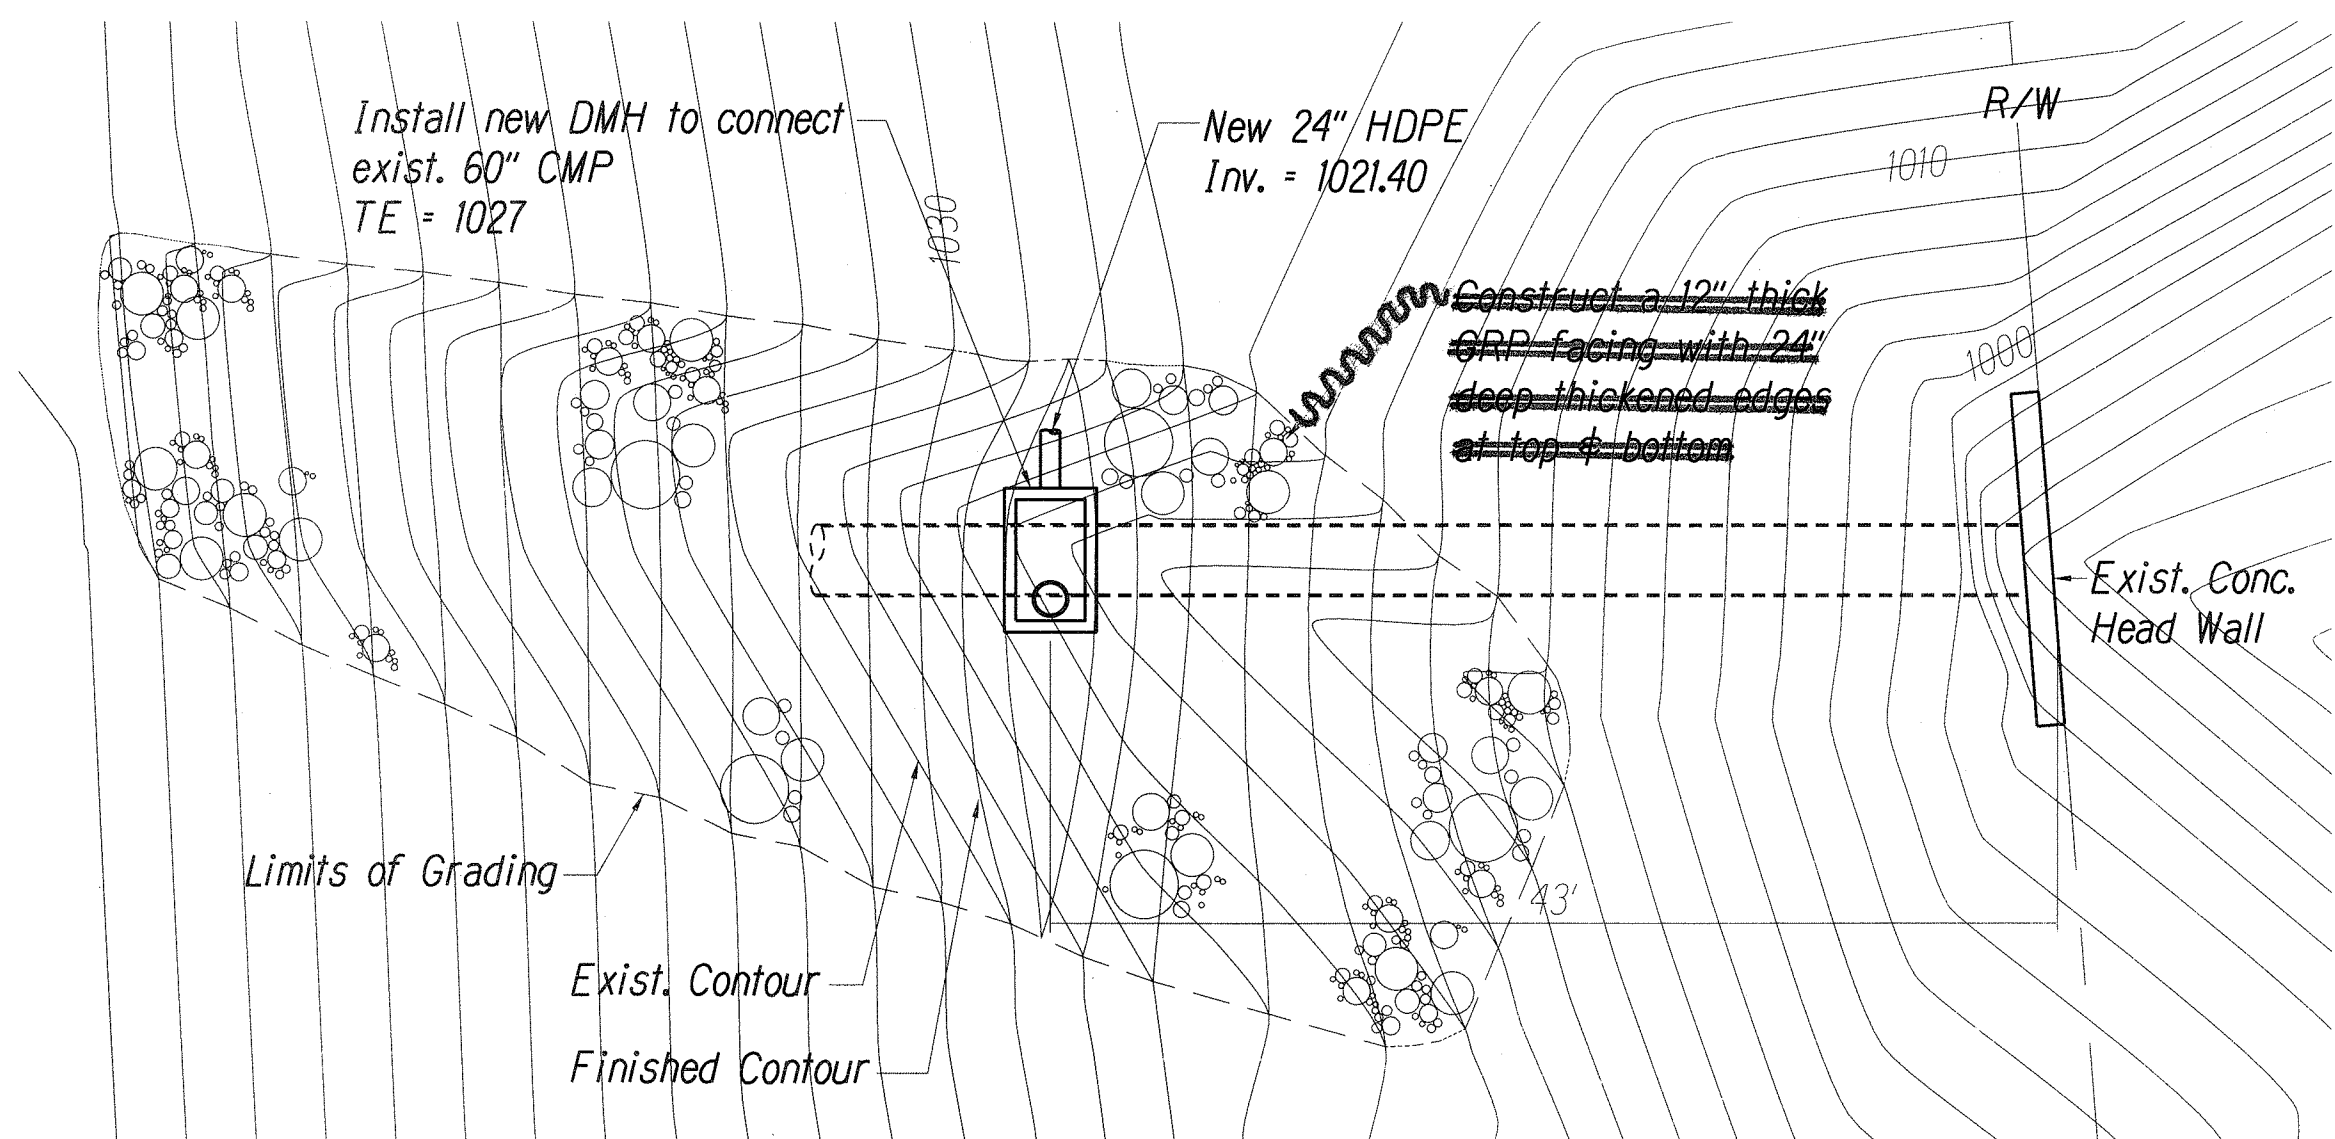

PLAN
Scale: 1"=10'-0" 1

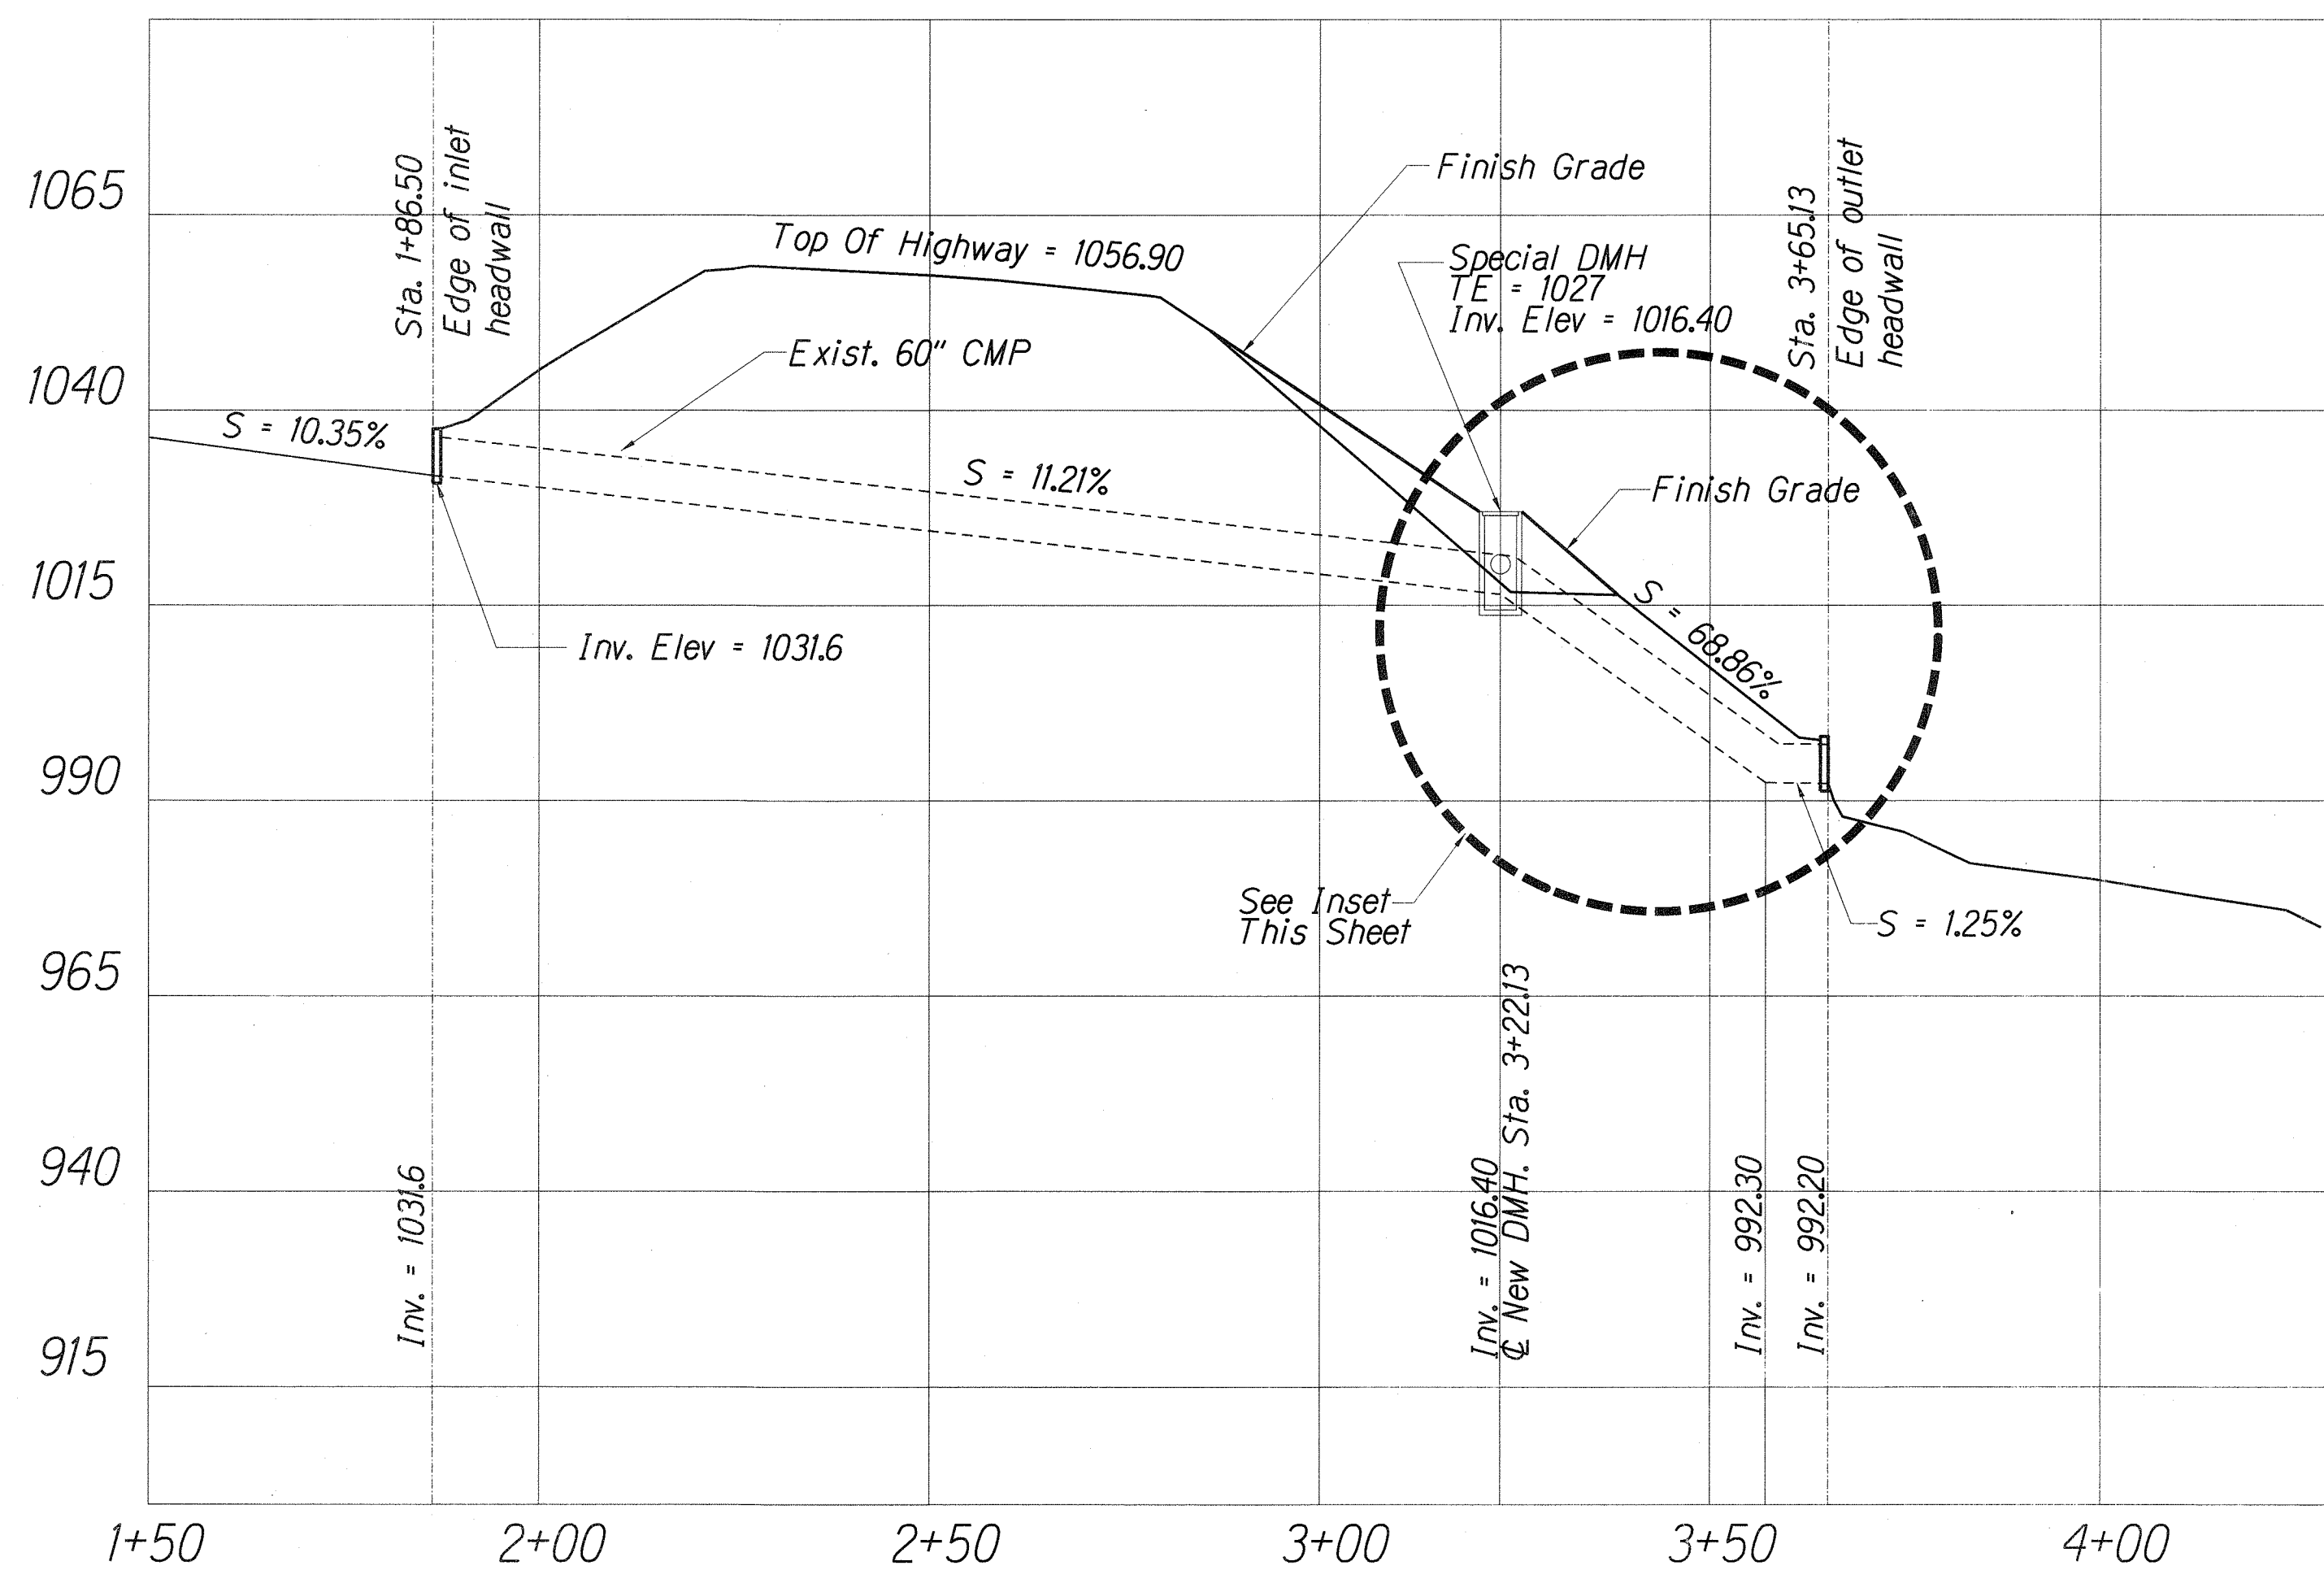


PROFILE
Scale: Horiz: 1"=20'-0" Vert: 1"=1'-0" 2

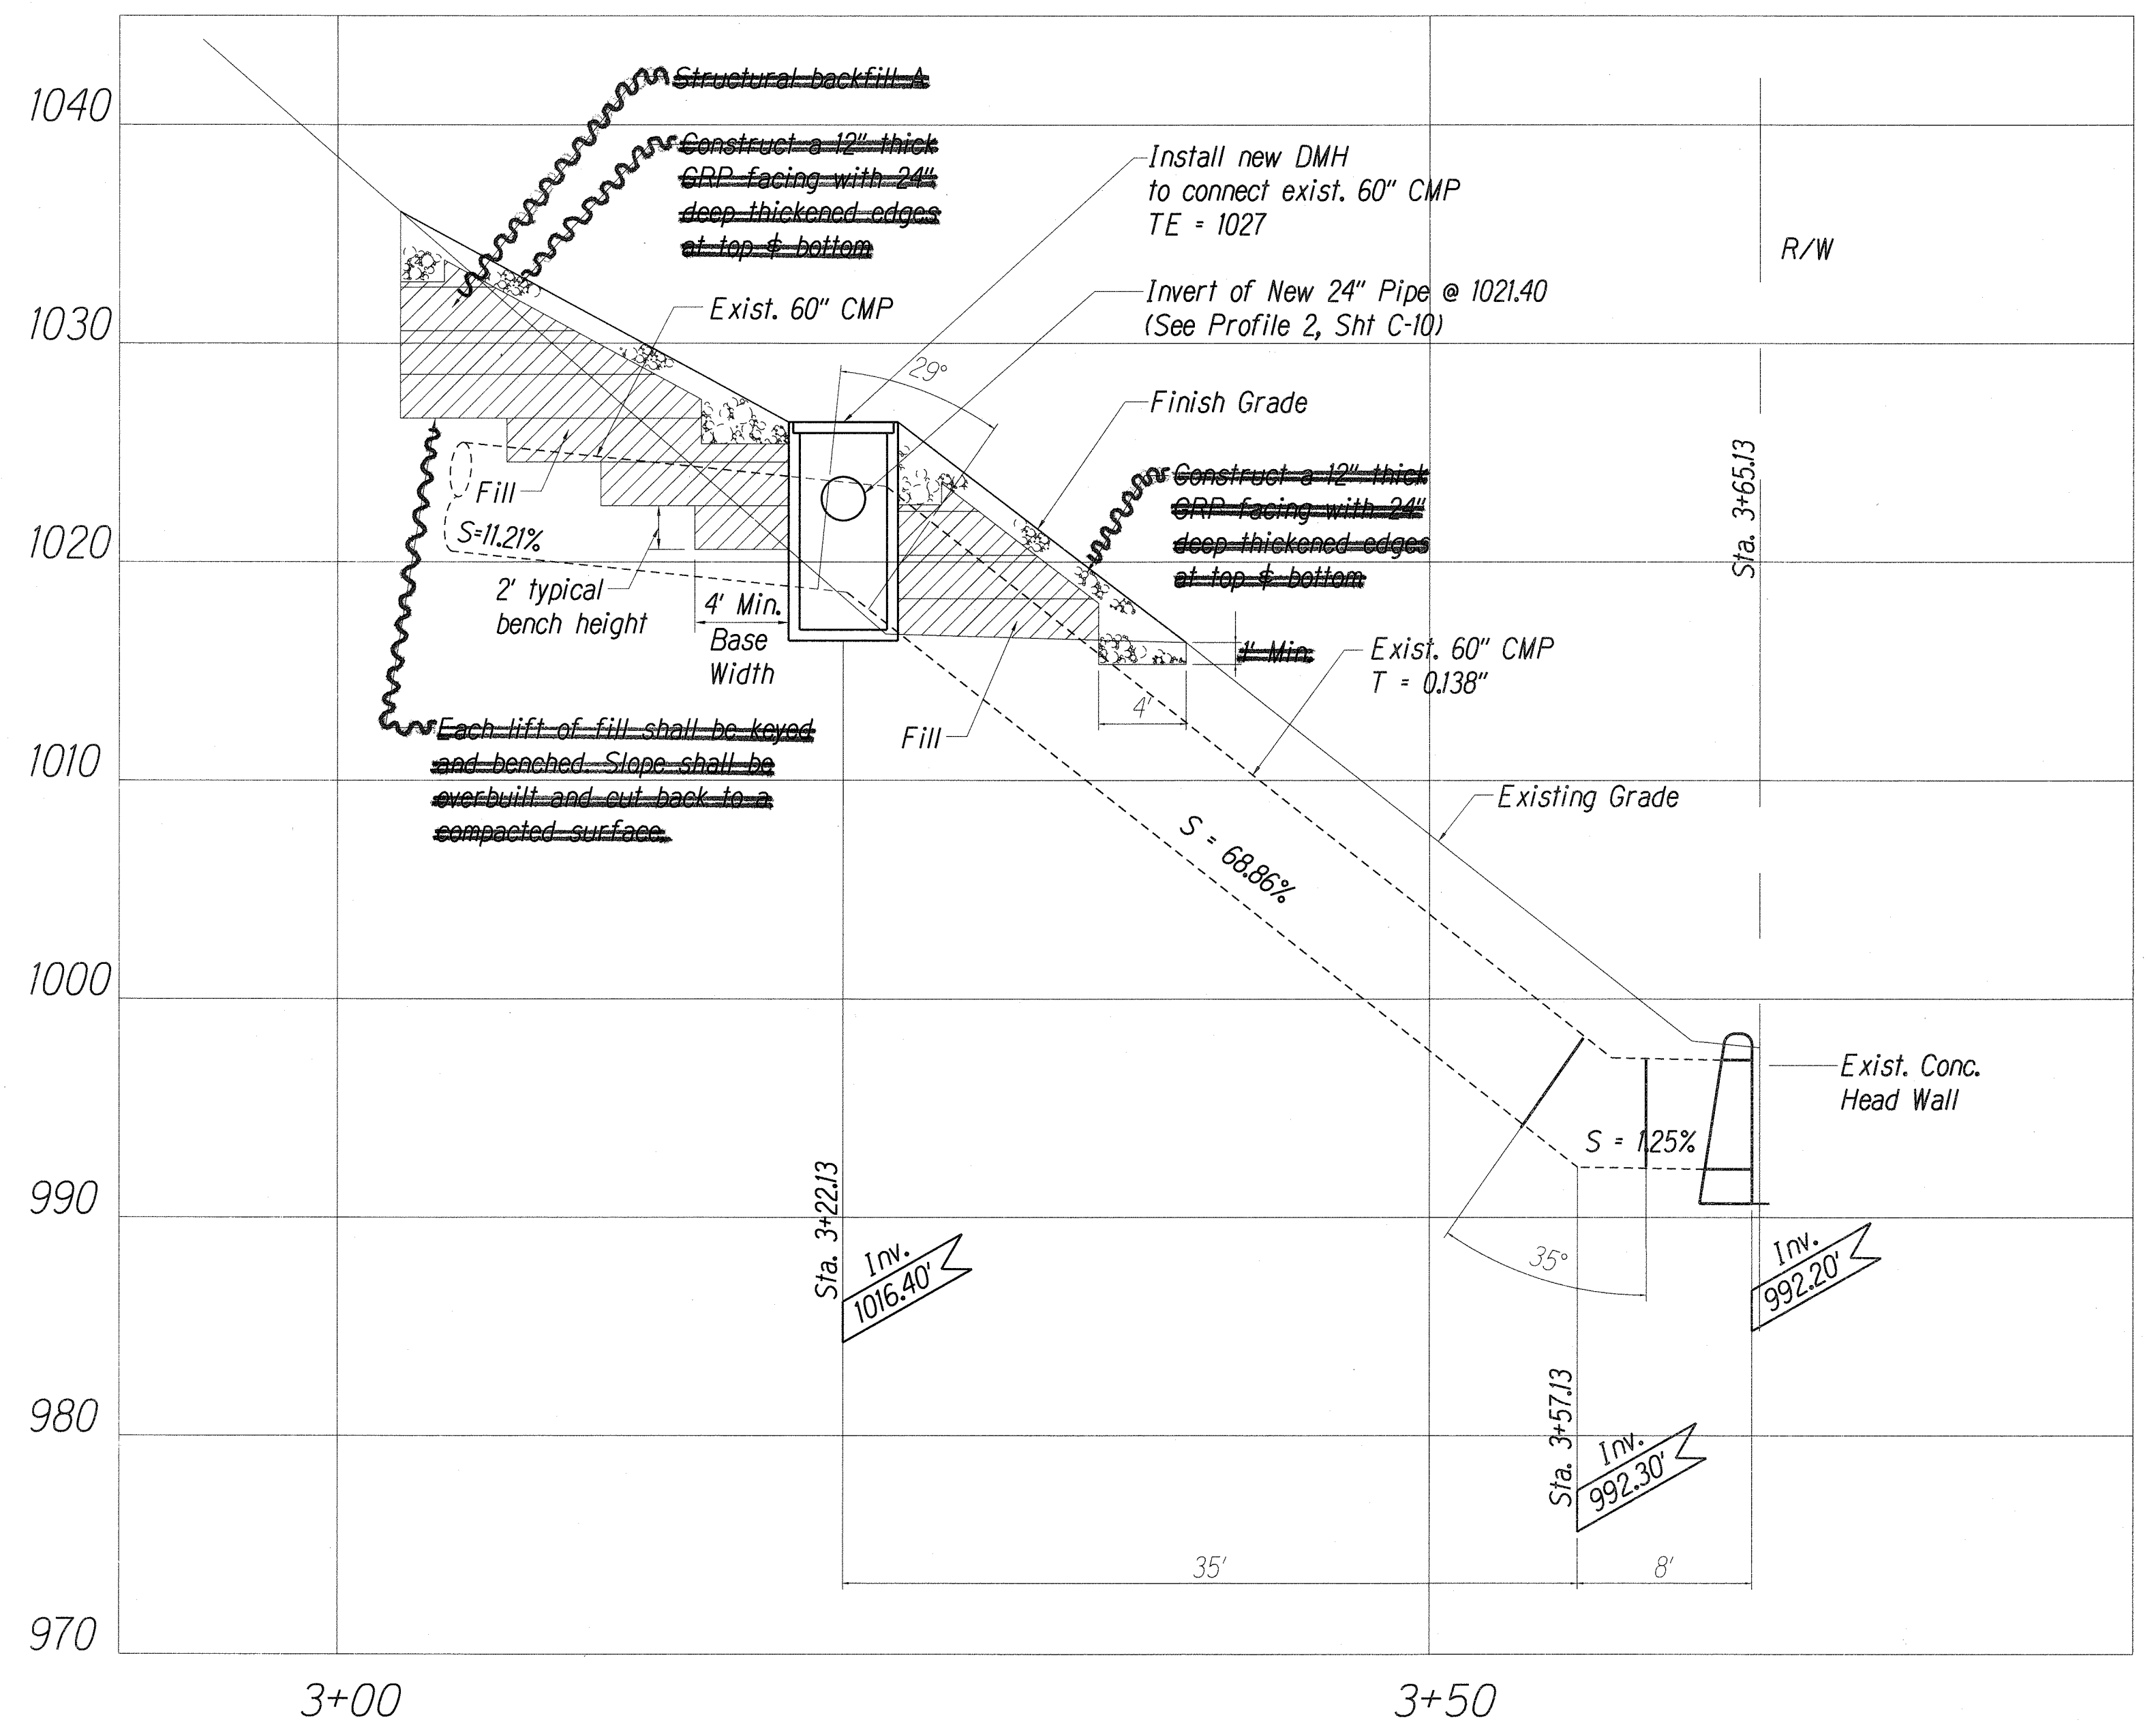

INSET
Scale: Horiz: 1"=6'-0" 3

DETAILS OF 60" CULVERT CONNECTION AT & STA. 186+50

Scale: 1"=20'-0"
Vert: 1"=1'-0"

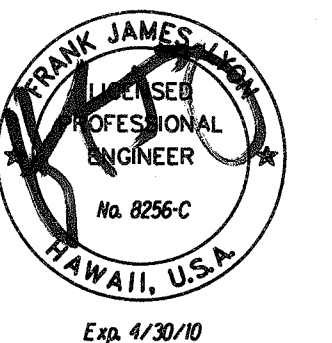

THIS WORK WAS PREPARED BY ME
OR UNDER MY SUPERVISION

STATE OF HAWAII
DEPARTMENT OF TRANSPORTATION
HIGHWAYS DIVISION

PROFILE - 1

MAUNALO A HIGHWAY
Slope Stabilization at Milepost 13
Highway Project No. 460A-02-06


Scale: AS NOTED Date: JAN 2010

SHEET No. 10 OF 16 SHEETS


"AS-BUILT"

ADD. 10


FED. ROAD DIST. NO.	STATE	HIGHWAY PROJ. NO.	FISCAL YEAR	SHEET NO.	TOTAL SHEETS
HAWAII	HAW.	460A-02-06	2010	11	16

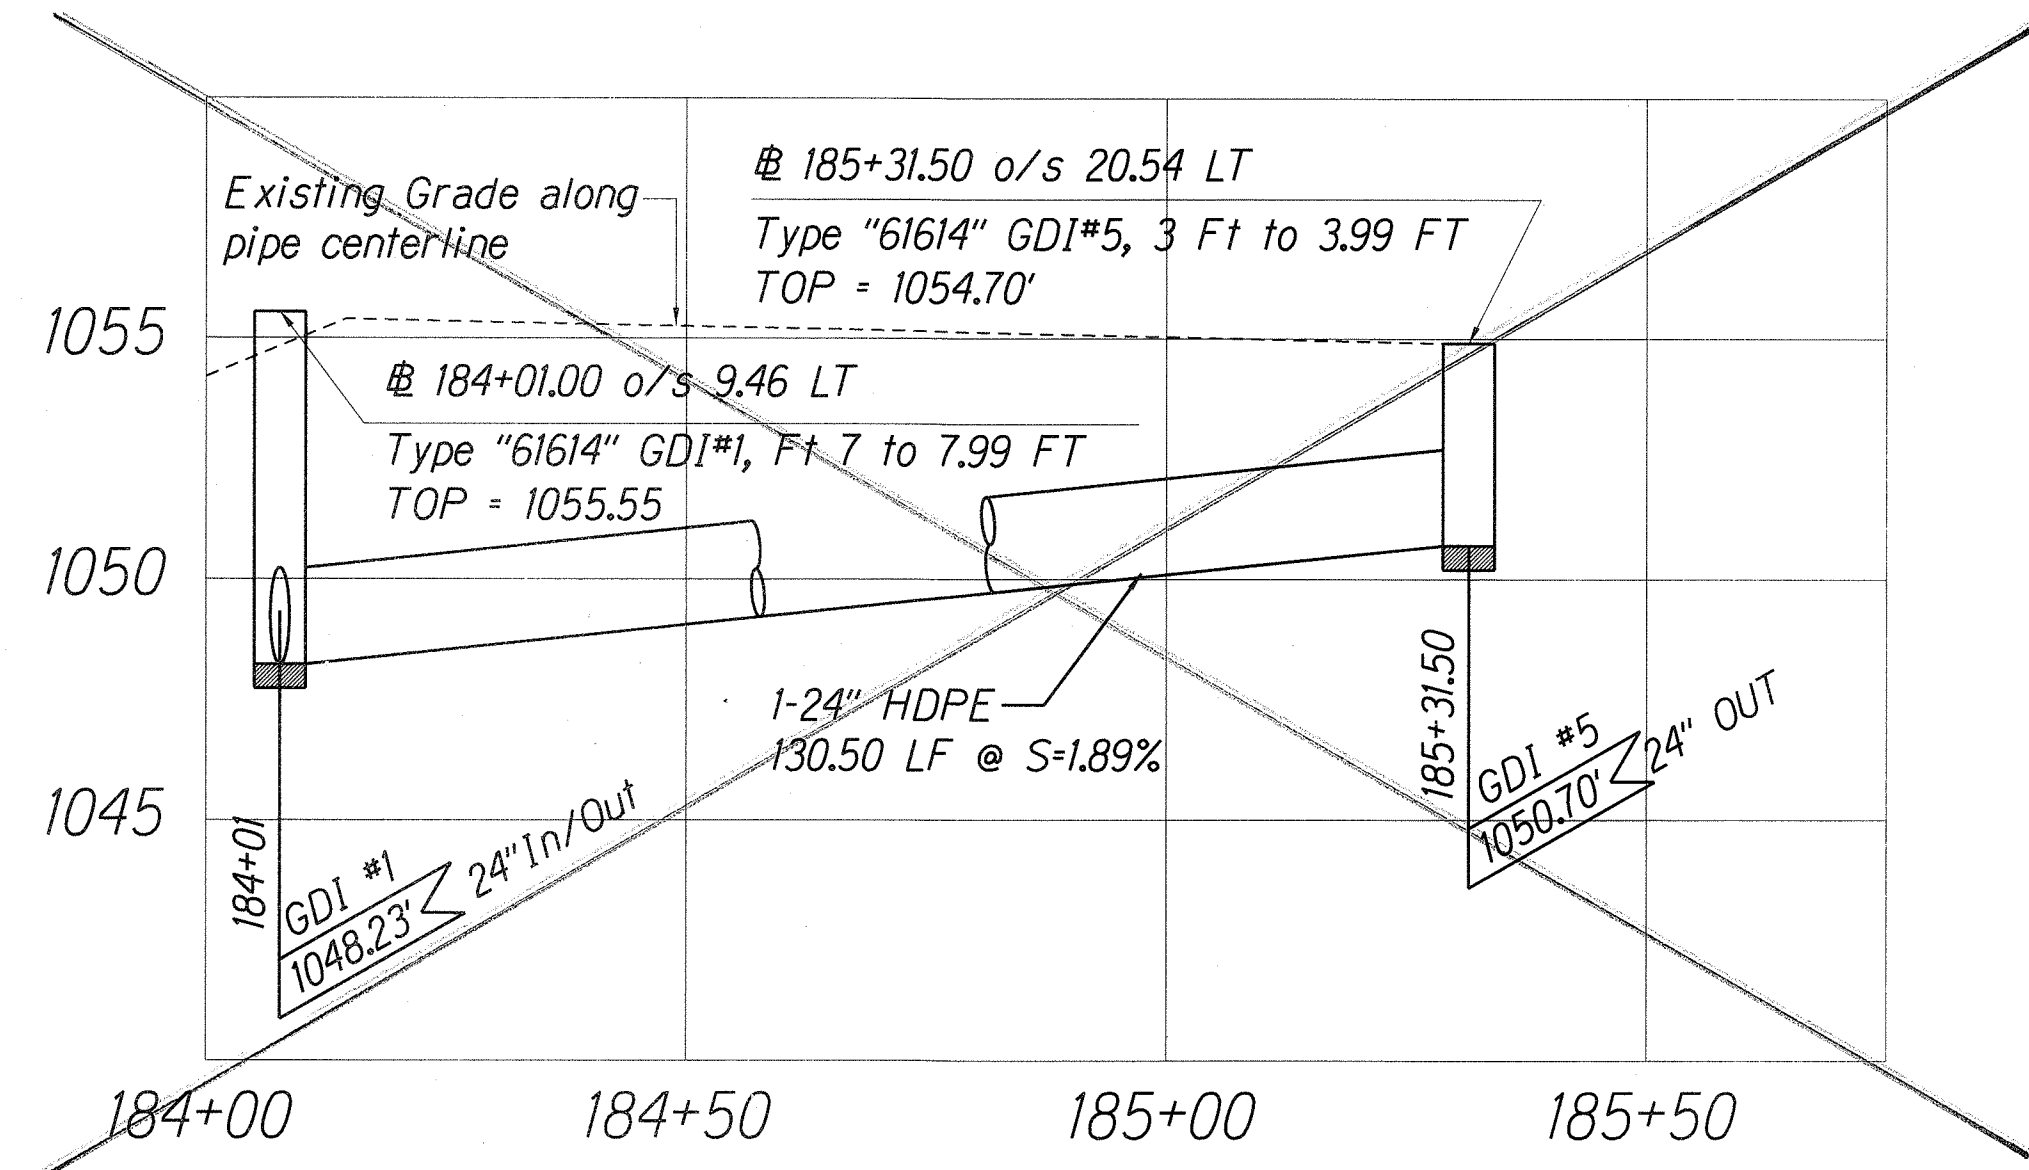


PROFILE ALONG CENTERLINE
Scale: Horiz: 1"=20'-0"
Vert: 1"=4'-0"
N.I.C.

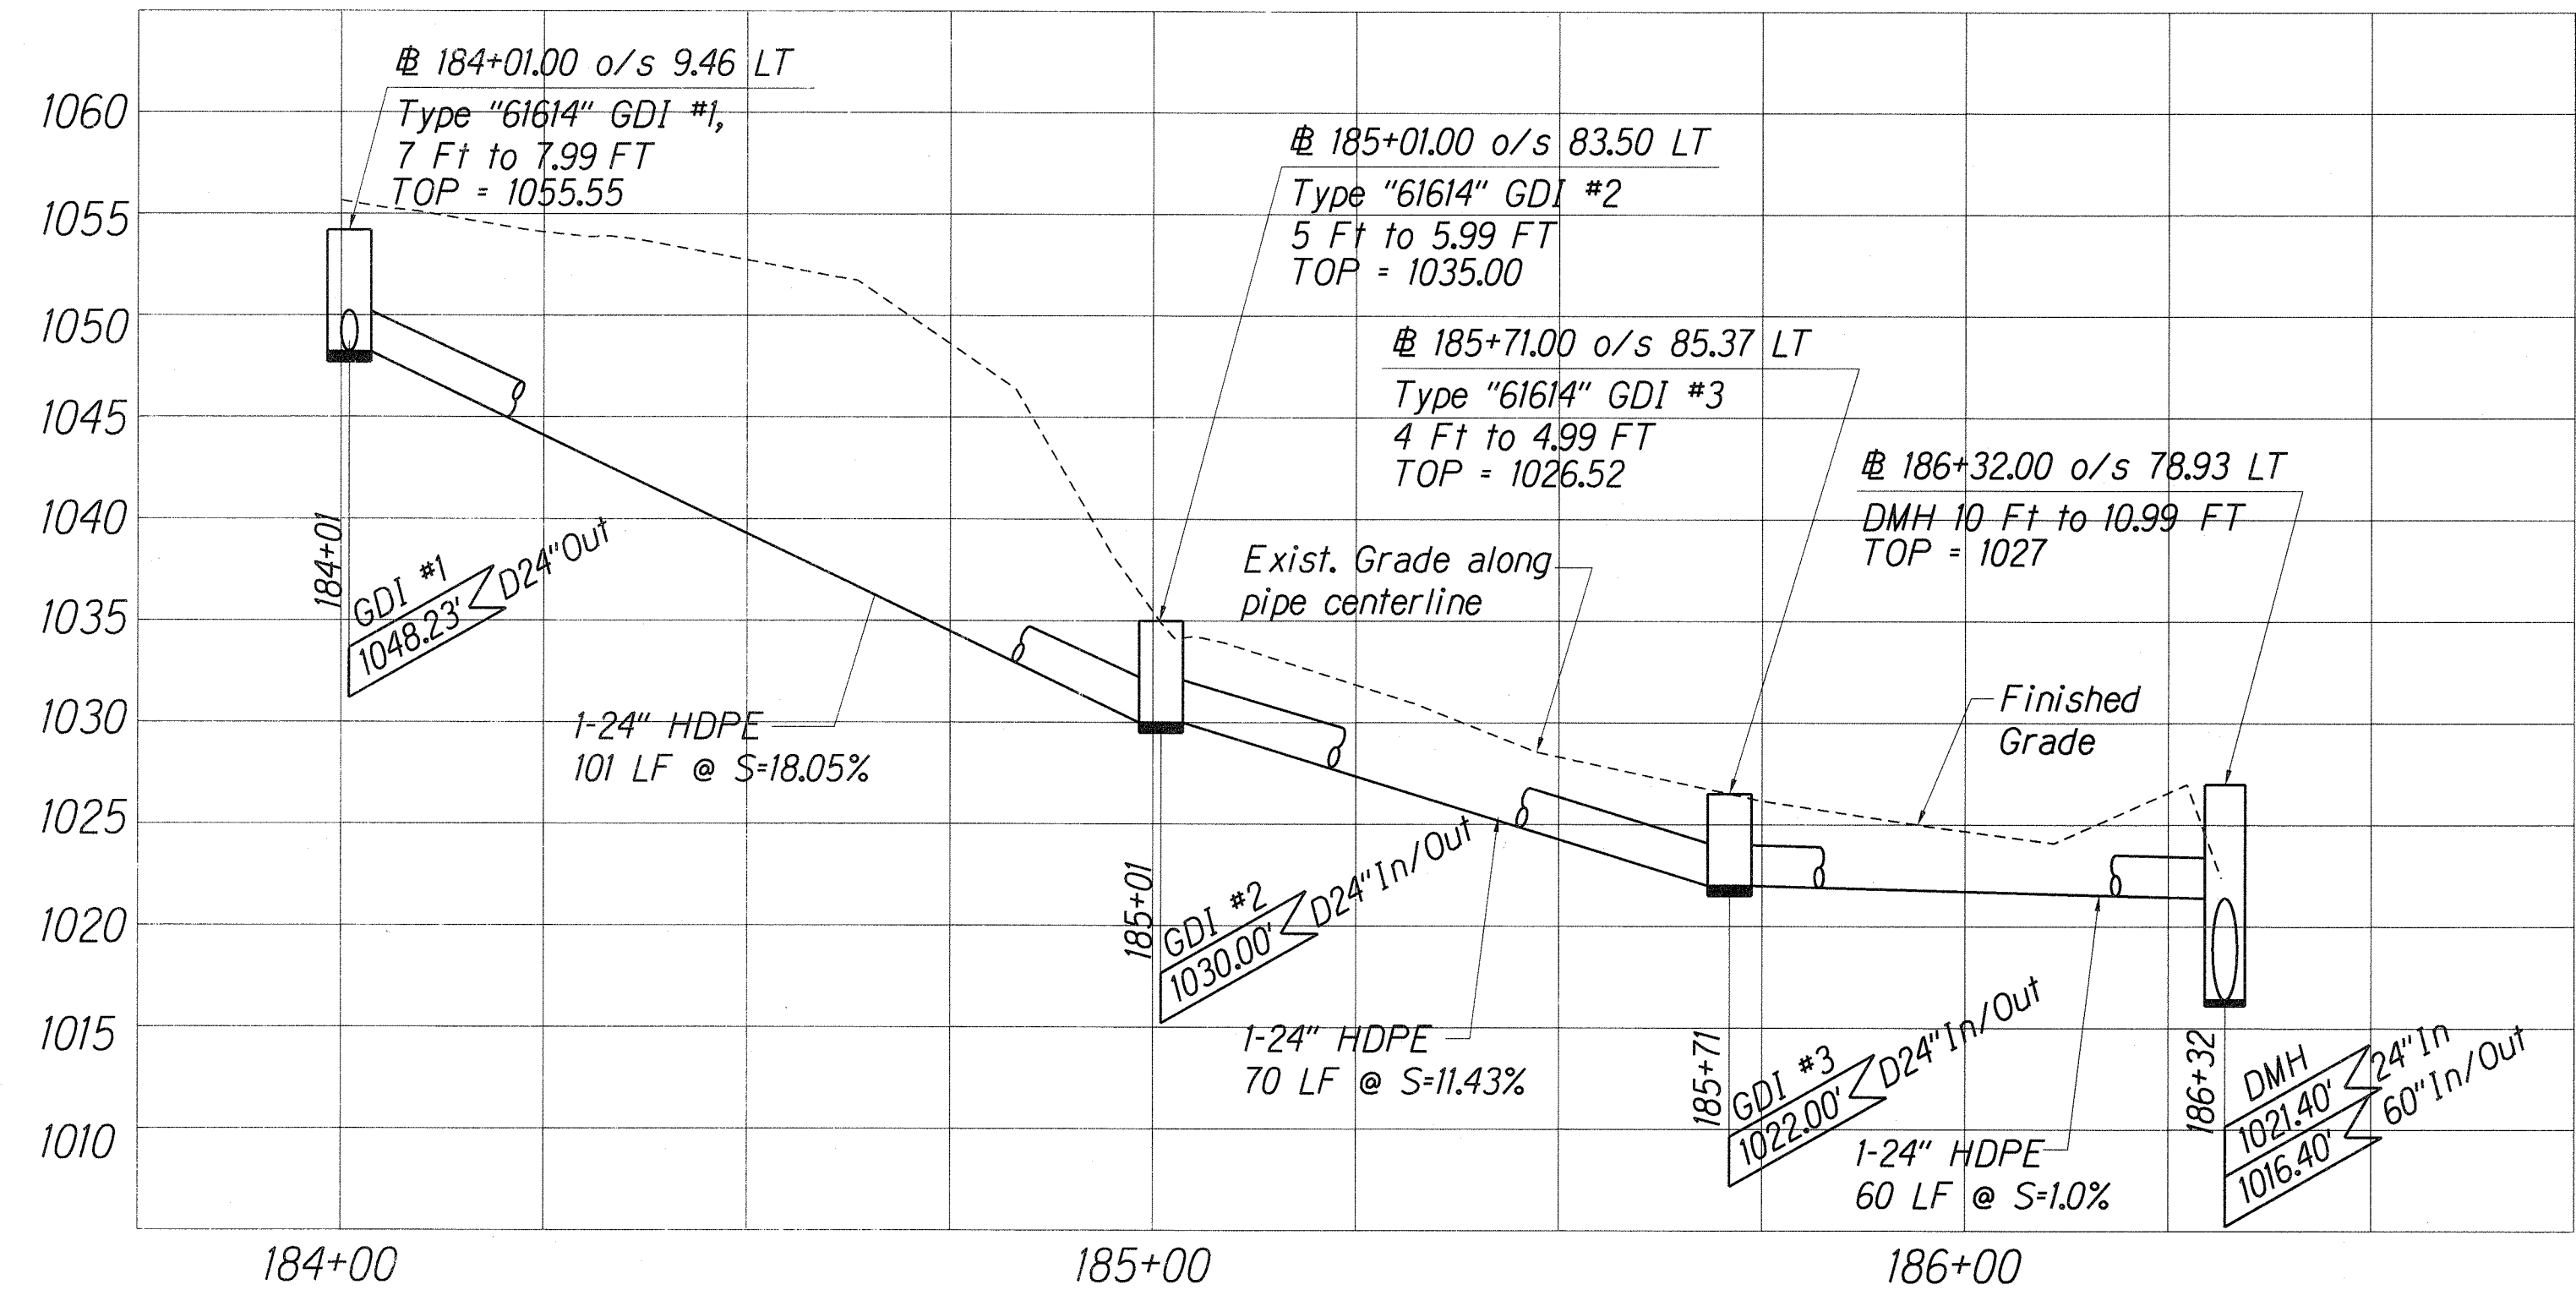



PROFILE 2
Scale: Horiz: 1"=40'-0"
Vert: 1"=8'-0"

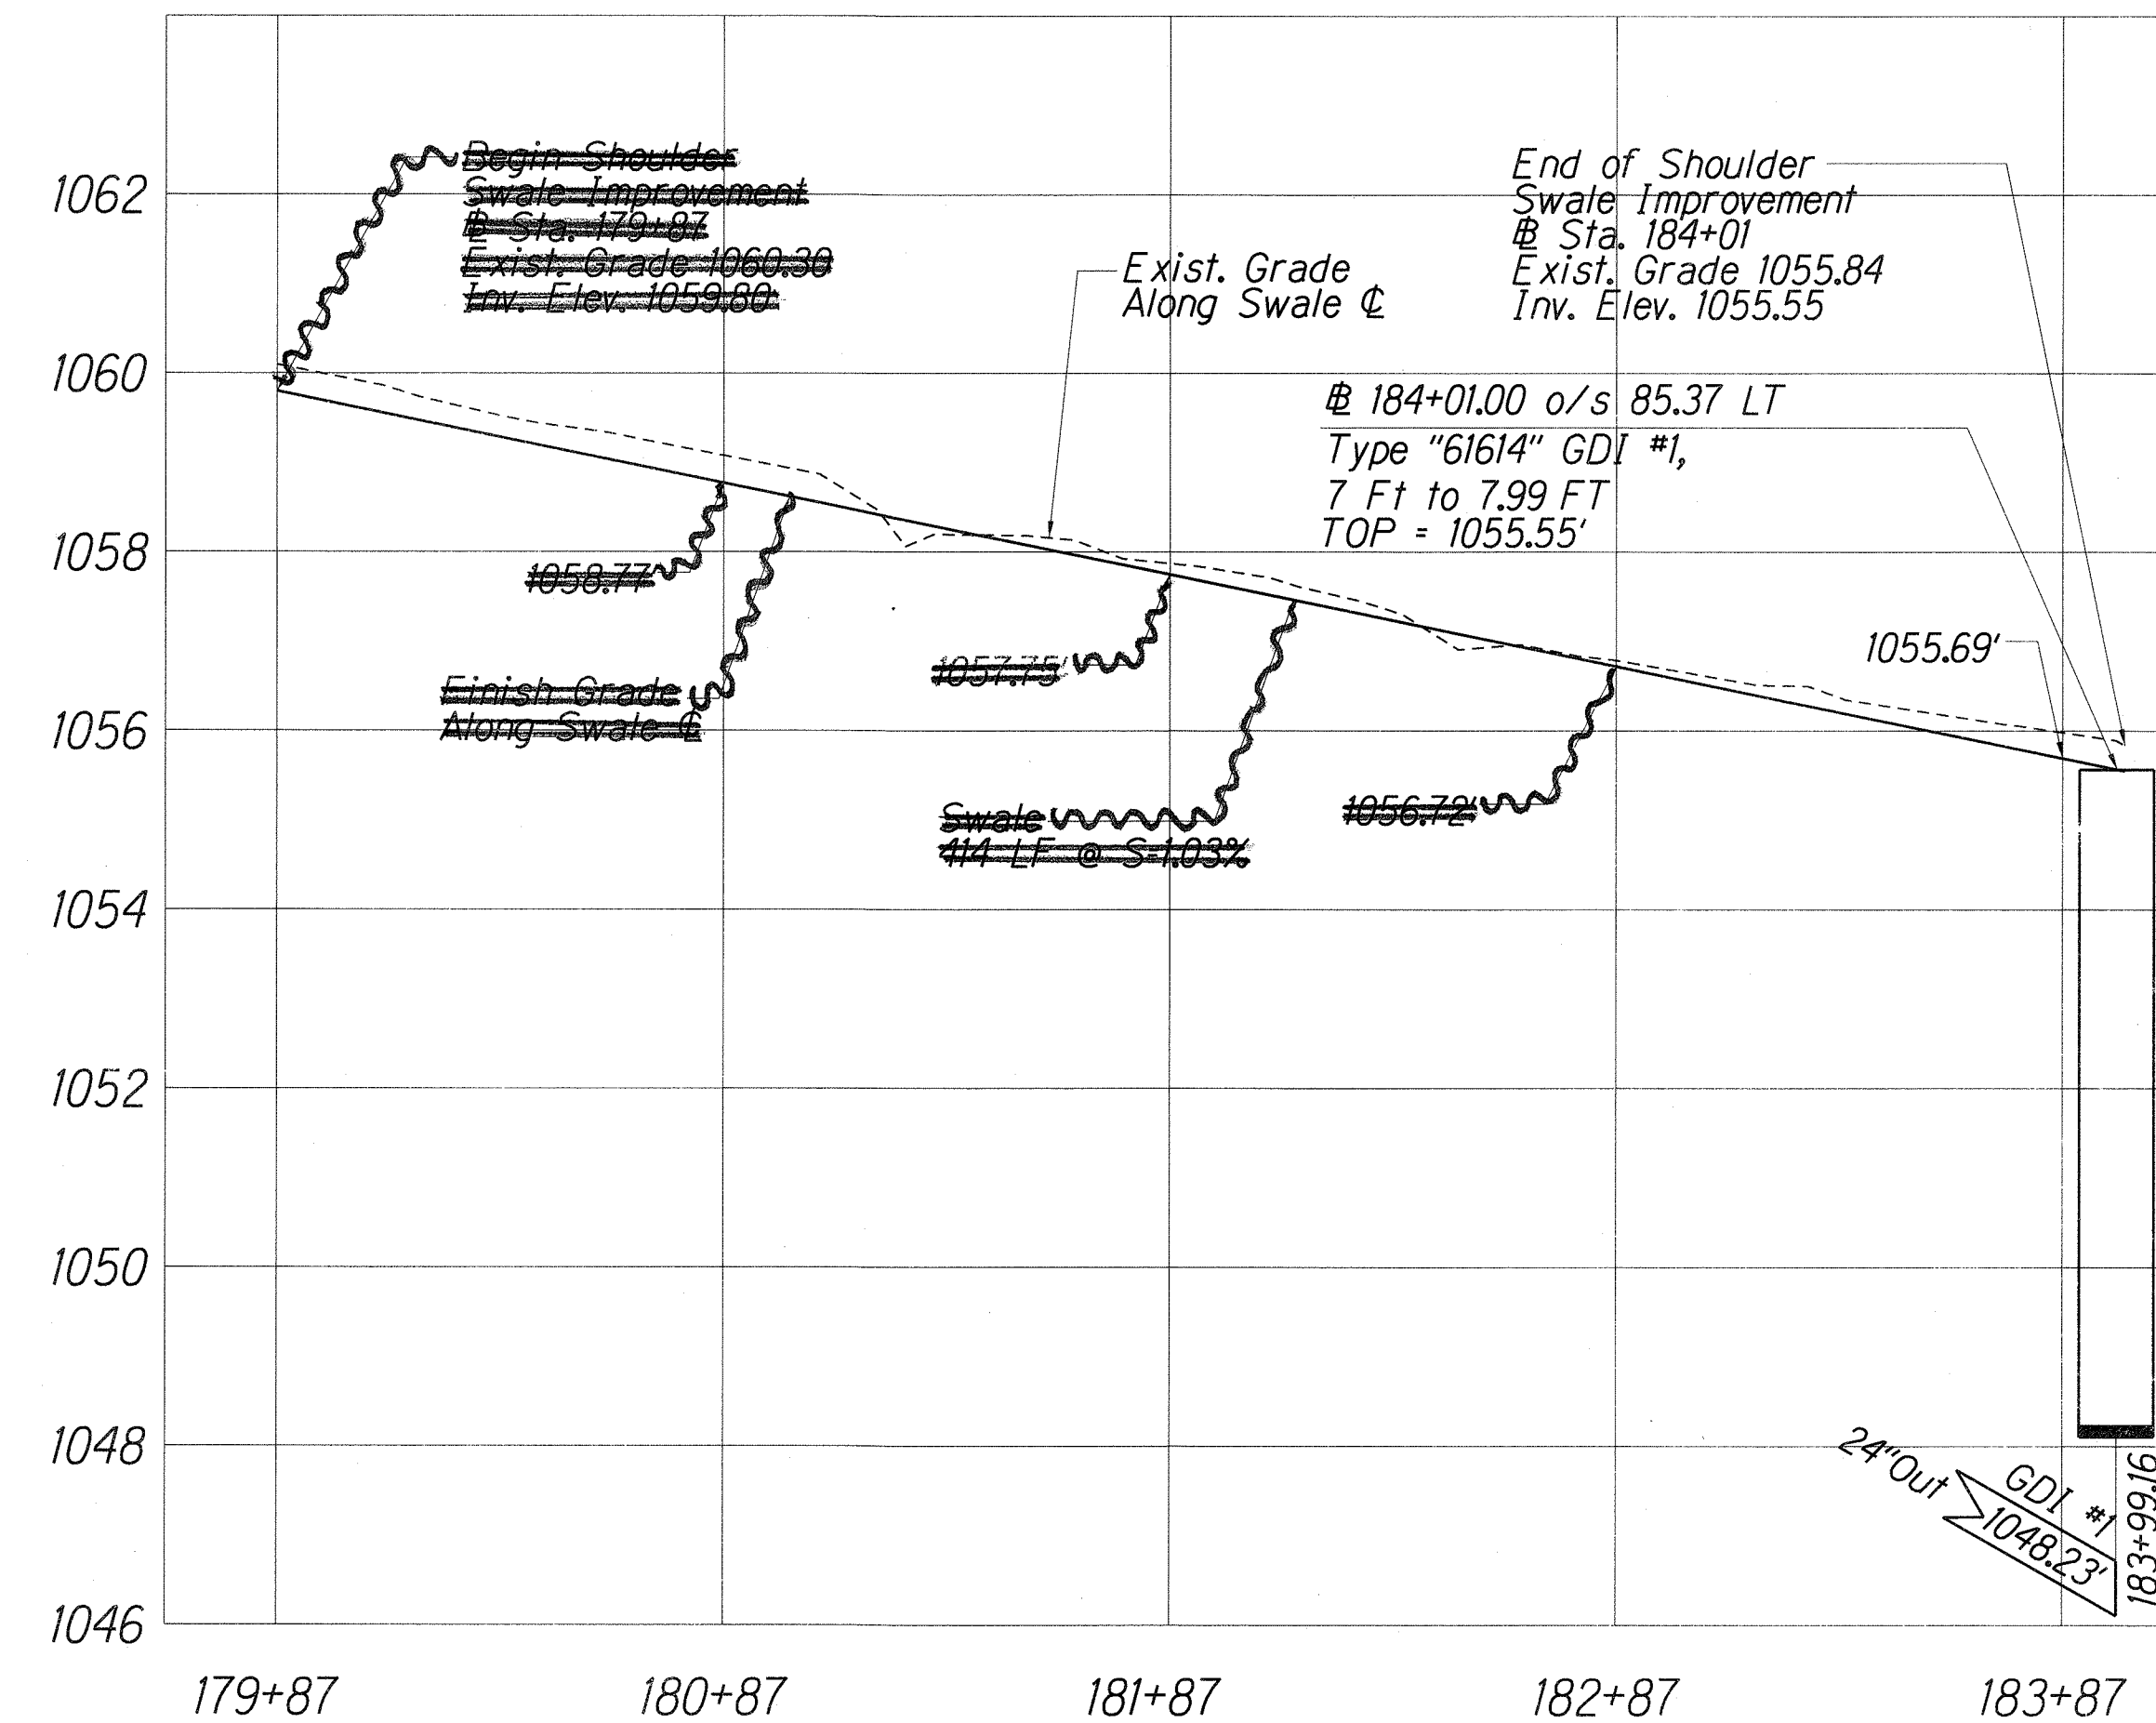

SWALE PROFILE 1
Scale: Horiz: 1"=40'-0"
Vert: 1"=2'-0"

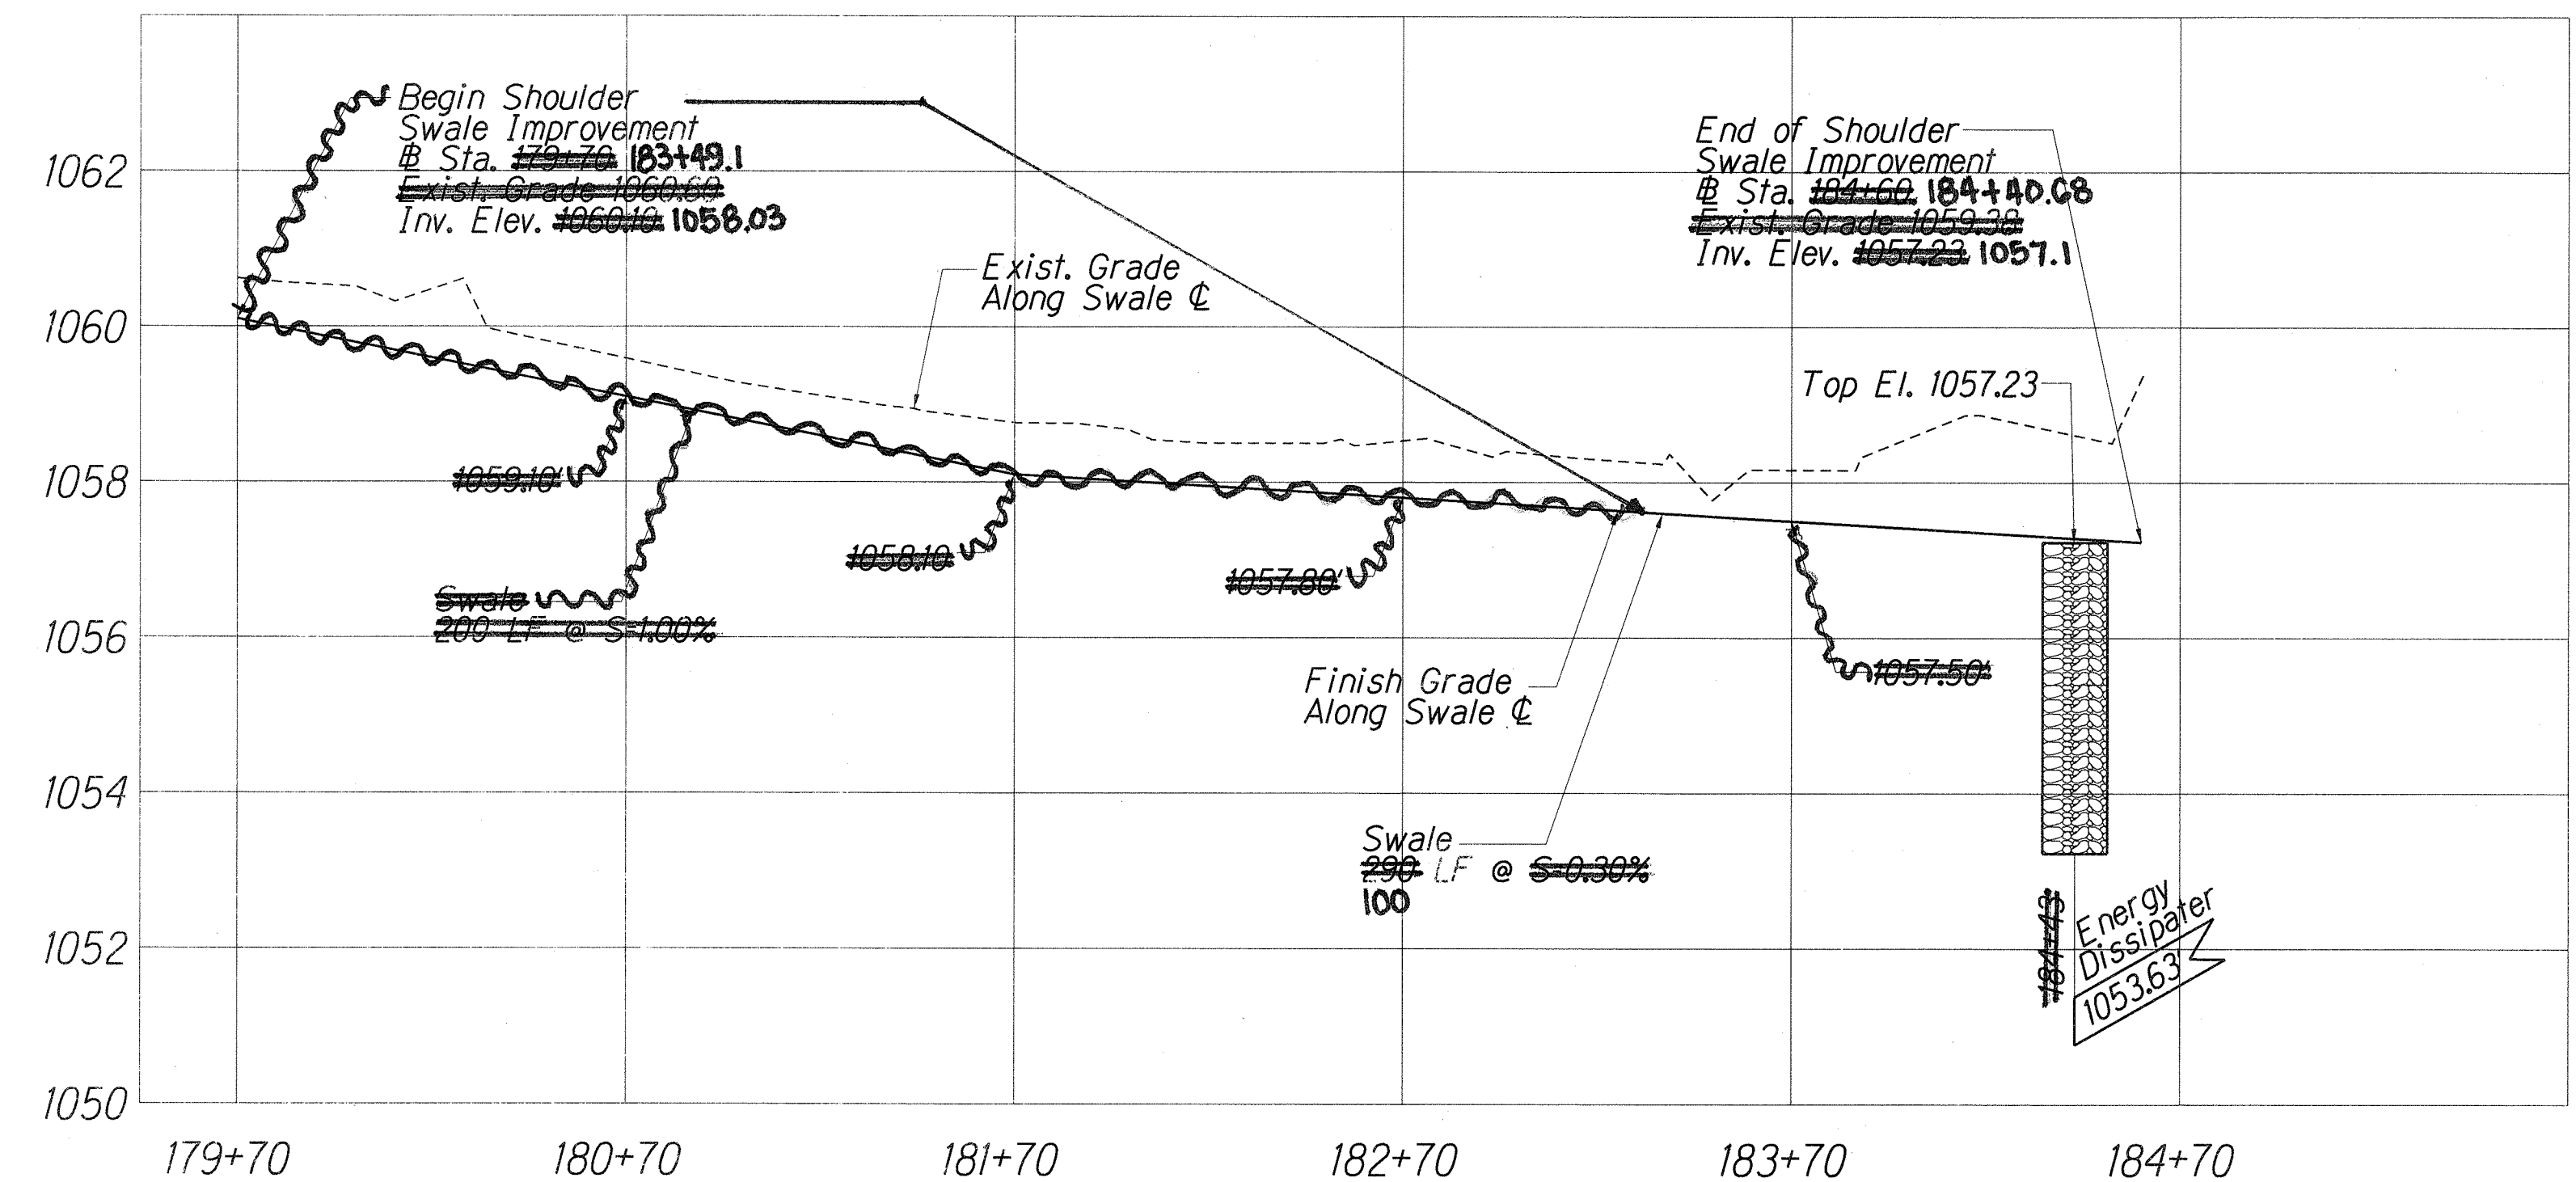

SWALE PROFILE 2
Scale: Horiz: 1"=40'-0"
Vert: 1"=2'-0"

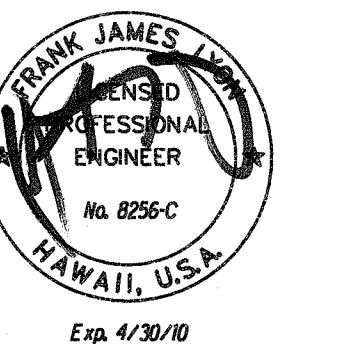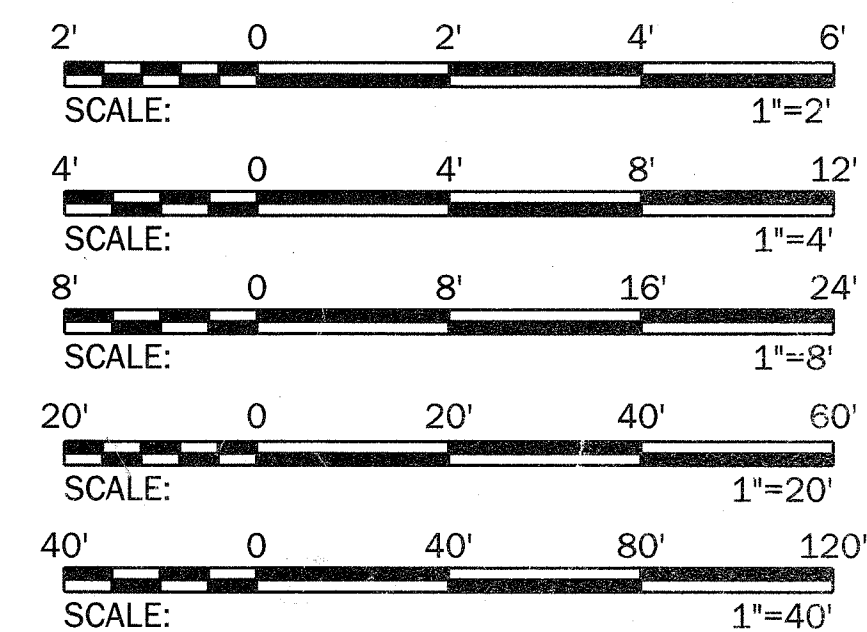

Exp. 4/30/10
THIS WORK WAS PREPARED BY ME
OR UNDER MY SUPERVISION

STATE OF HAWAII
DEPARTMENT OF TRANSPORTATION
HIGHWAYS DIVISION

PROFILE - 2

MAUNALOA HIGHWAY
Slope Stabilization at Milepost 13
Highway Project No. 460A-02-06
Scale: AS NOTED Date: JAN 2010

SHEET No. 11 OF 16 SHEETS

2' 0 2' 4' 6'

SCALE: 1"=2'

4' 0 4' 8' 12'

SCALE: 1"=4'

8' 0 8' 16' 24'

SCALE: 1"=8'

20' 0 20' 40' 60'

SCALE: 1"=20'



40' 0 40' 80' 120'

SCALE: 1"=40'

"AS-BUILT"




ADD. 11

FED. ROAD DIST. NO.	STATE	HIGHWAY PROJ. NO.	FISCAL YEAR	SHEET NO.	TOTAL SHEETS
HAWAII	HAW.	460A-02-06	2010	C.O. ADD. 11S-1	16

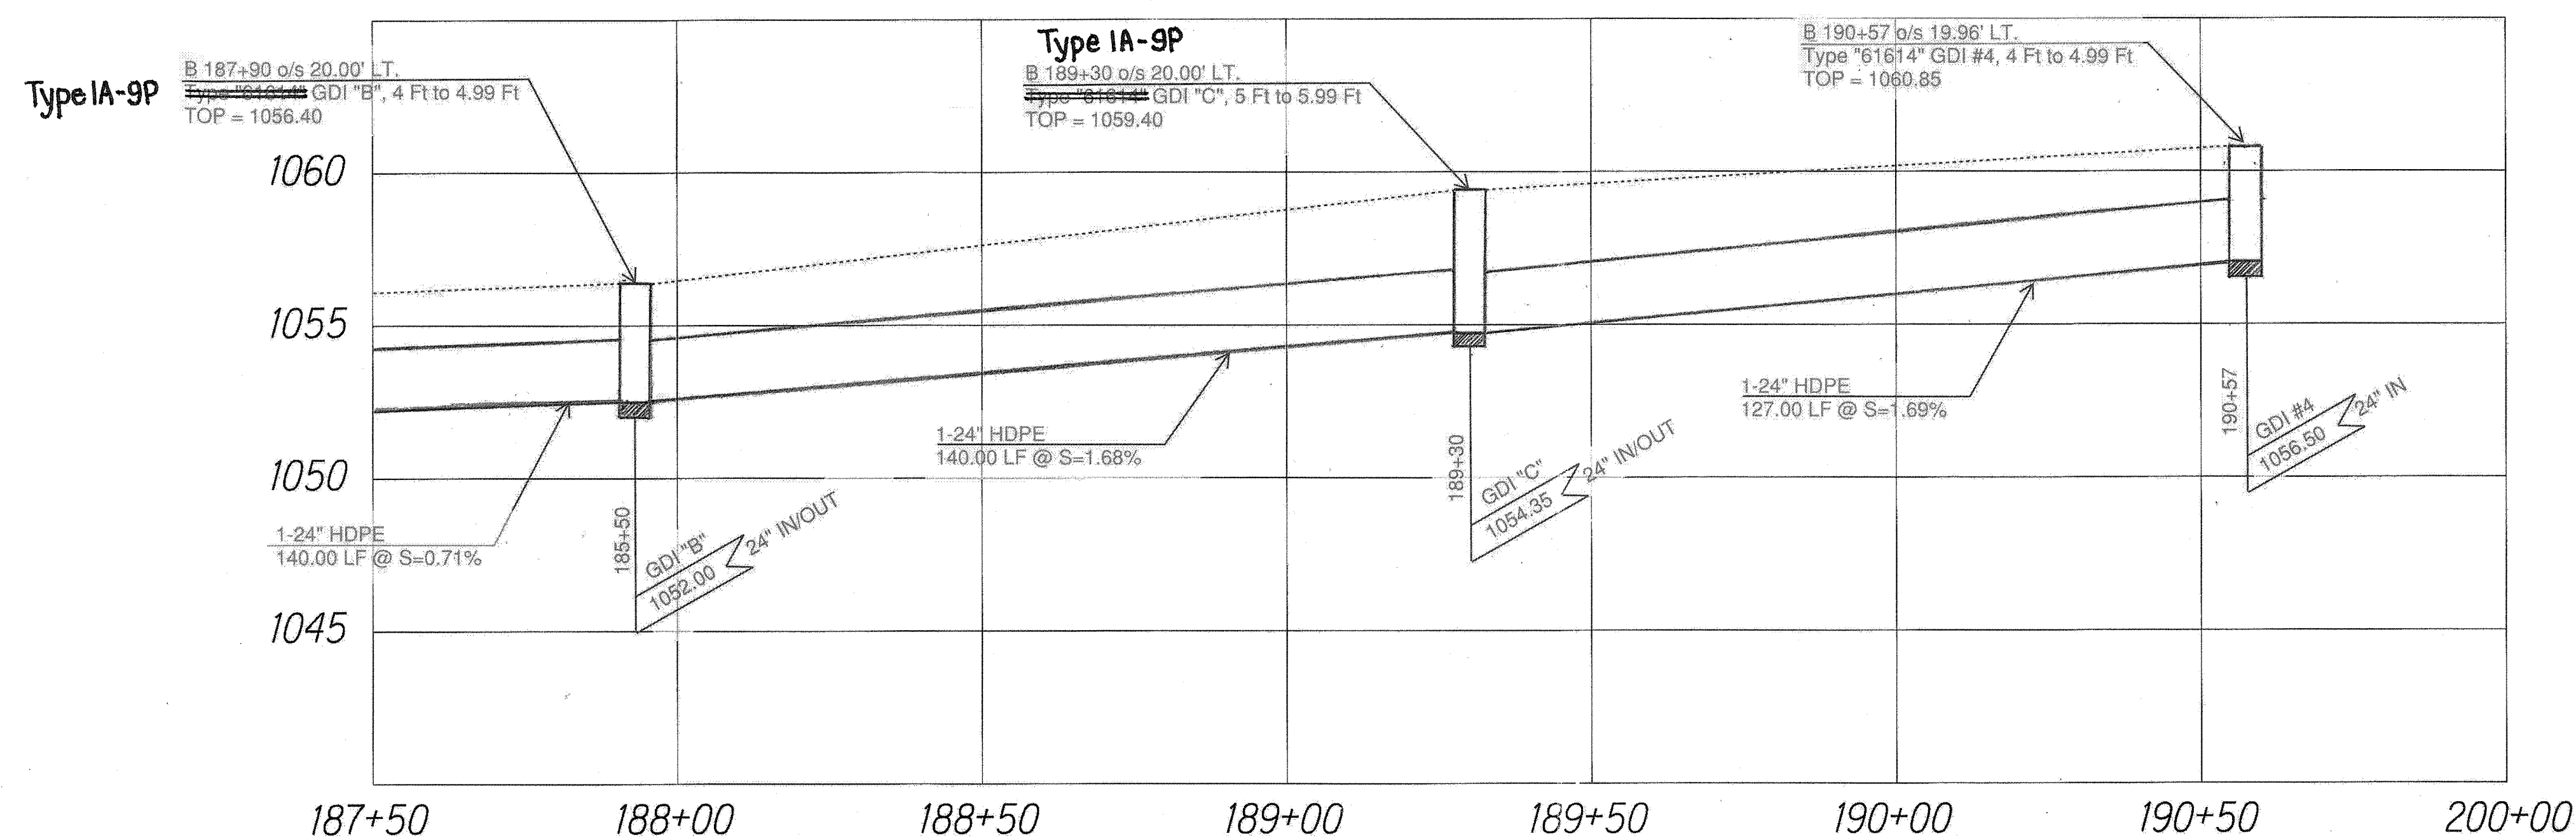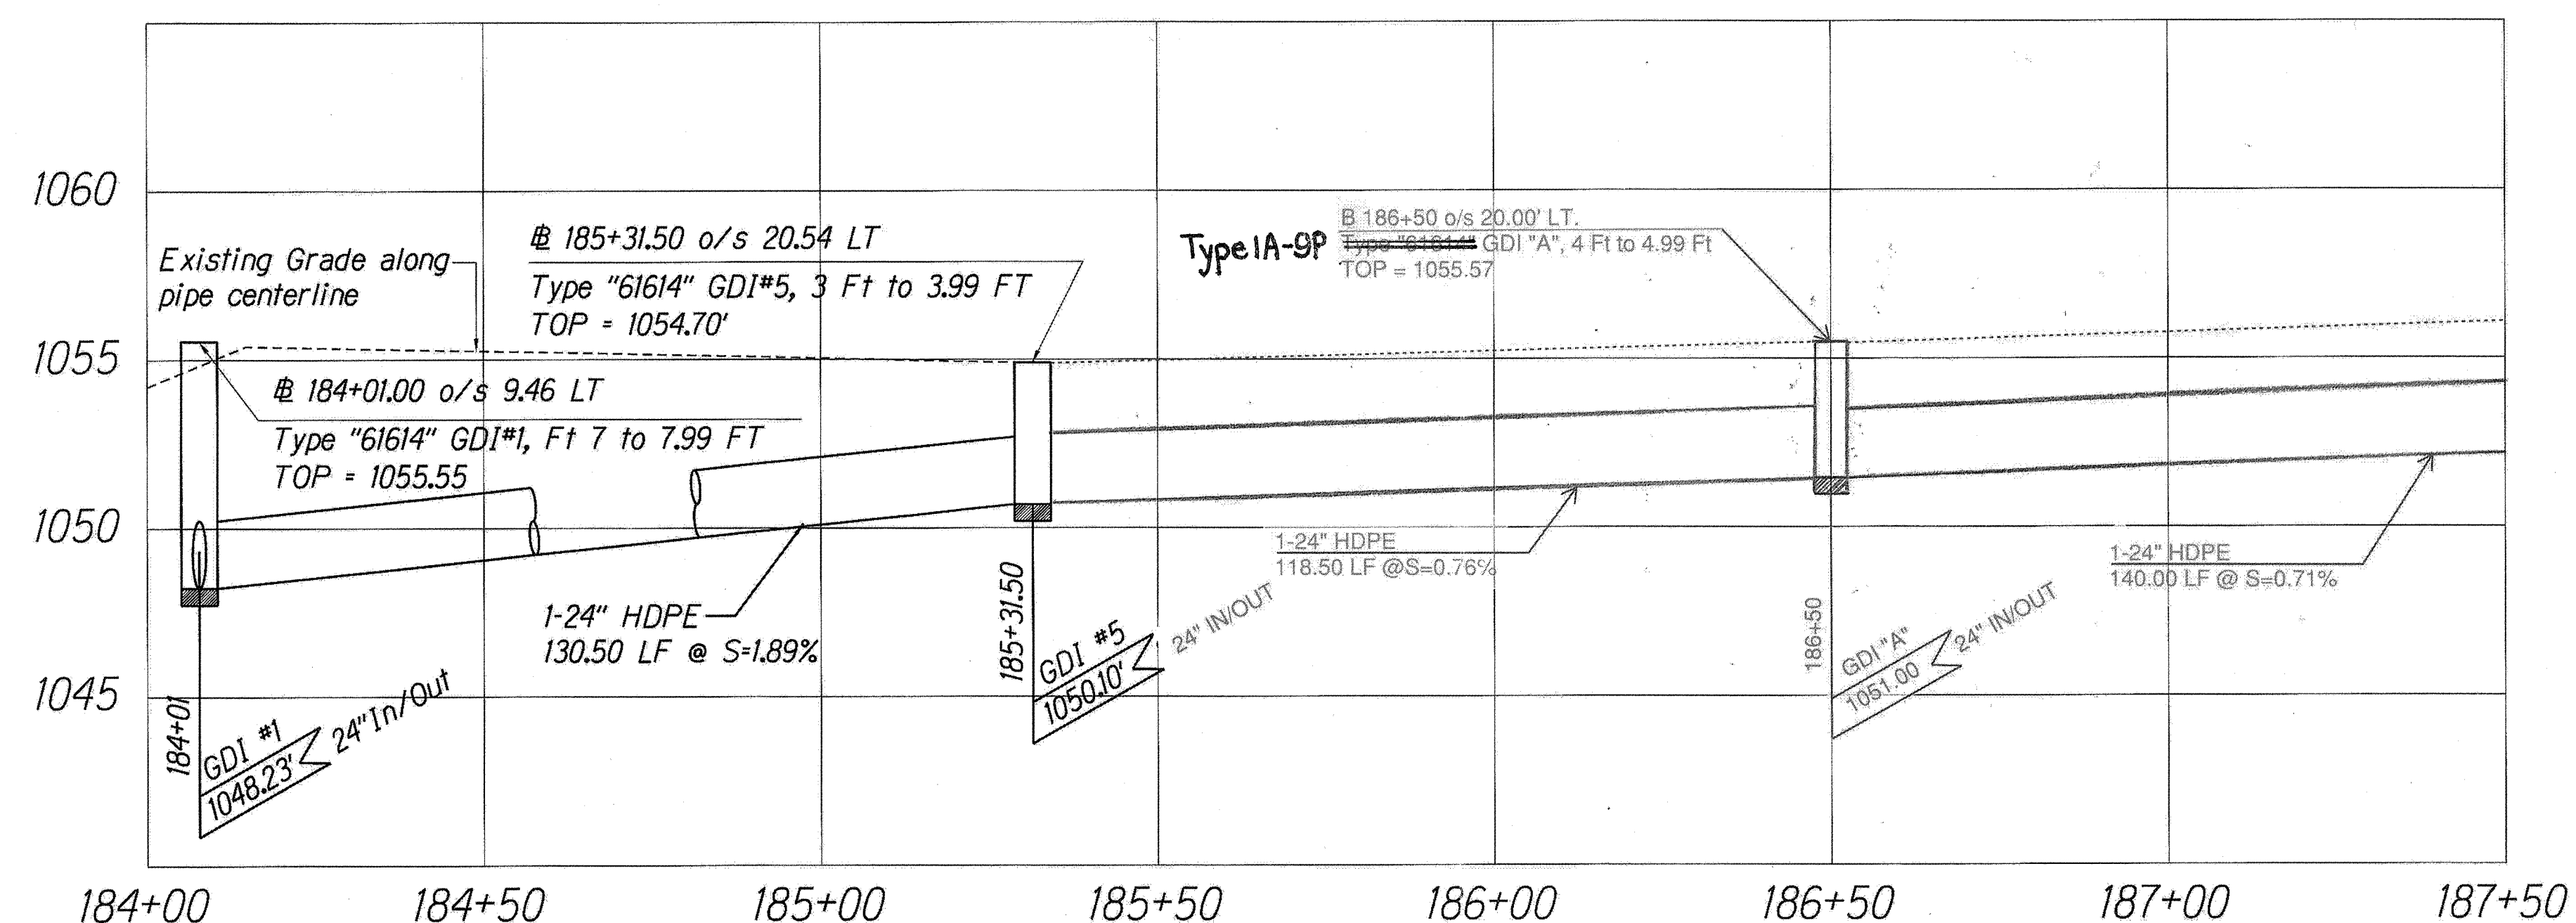

PROFILE ALONG CENTERLINE

Scale: Horiz: 1"=20'-0"
Vert: 1"=4'-0"

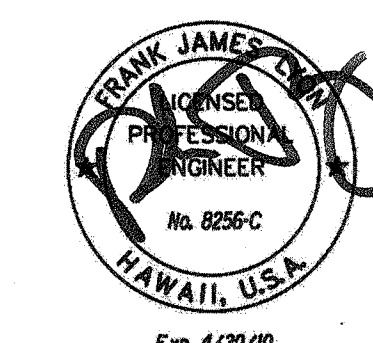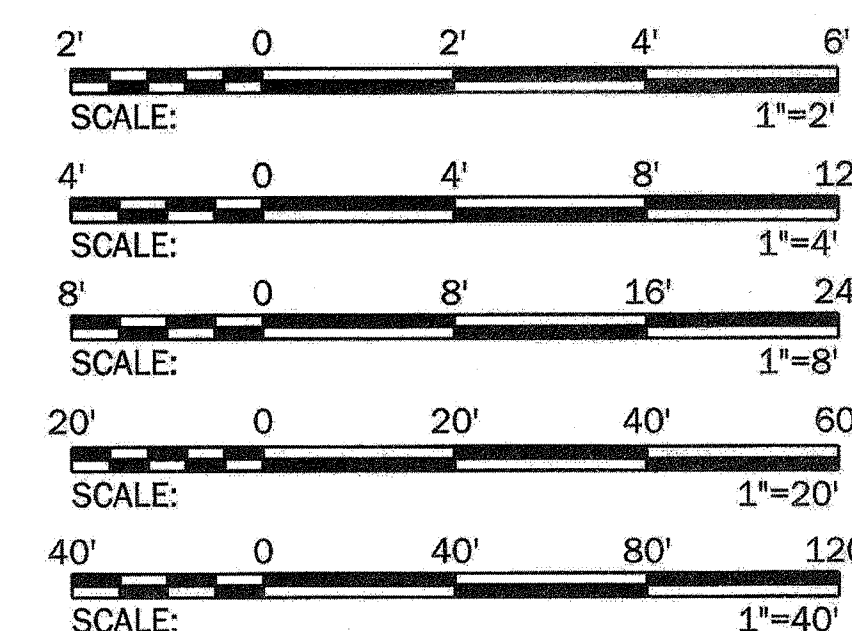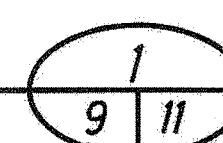

THIS WORK WAS PREPARED BY ME
OR UNDER MY SUPERVISION

STATE OF HAWAII
DEPARTMENT OF TRANSPORTATION
HIGHWAYS DIVISION

PROFILE - 2

MAUNALO A HIGHWAY
Slope Stabilization at Milepost 13
Highway Project No. 460A-02-06

Scale: AS NOTED Date: JAN 2010

SHEET No. 11 OF 16 SHEETS

"AS-BUILT"

C.O. ADD. 11S-1

DATE	7-7-10
DESIGNED BY	7-7-10
CHECKED BY	7-7-10
APPROVED BY	7-7-10
DATE	2-19-10
DESIGNED BY	2-19-10
CHECKED BY	2-19-10
APPROVED BY	2-19-10

DATE	7-7-10	Corrected Profile Along Centerline
DATE	2-19-10	Revised Sheet Reference Numbers
DATE		REVISION

