

| INDEX TO DRAWINGS | |
|-------------------|--|
| SHEET NO. | DESCRIPTION |
| 1 | TITLE SHEET |
| 2 | STANDARD PLANS SUMMARY |
| 3 | GENERAL NOTES AND LEGEND |
| 4 - 5 | WATER POLLUTION & EROSION CONTROL NOTES |
| 6 - 7 | TYPICAL SECTIONS AND DETAILS |
| 8 - 9 | GUARDRAIL DETAILS |
| 10 - 14 | ROADWAY PLANS |
| 15 | PAVEMENT MARKING LEGEND, DETAILS AND NOTES |
| 16 - 18 | RUMBLE STRIP DETAILS & NOTES |
| 19 | WORK ZONE SIGNING PLAN, NOTES & DETAILS |
| 20 - 21 | SIGN PANEL LAYOUT & NOTES |
| 22 - 26 | SIGNING AND PAVEMENT MARKING PLANS |
| | |
| | |

STATE OF HAWAII

DEPARTMENT OF TRANSPORTATION

HIGHWAYS DIVISION

HONOLULU, HAWAII

"AS-BUILT"

PLANS FOR



MAUNALOA HIGHWAY RESURFACING

HOOLEHUA TO VICINITY OF KEONELELE AVENUE

FEDERAL-AID PROJECT NO. ARR-0460(14)

DISTRICT OF MOLOKAI

ISLAND OF MOLOKAI

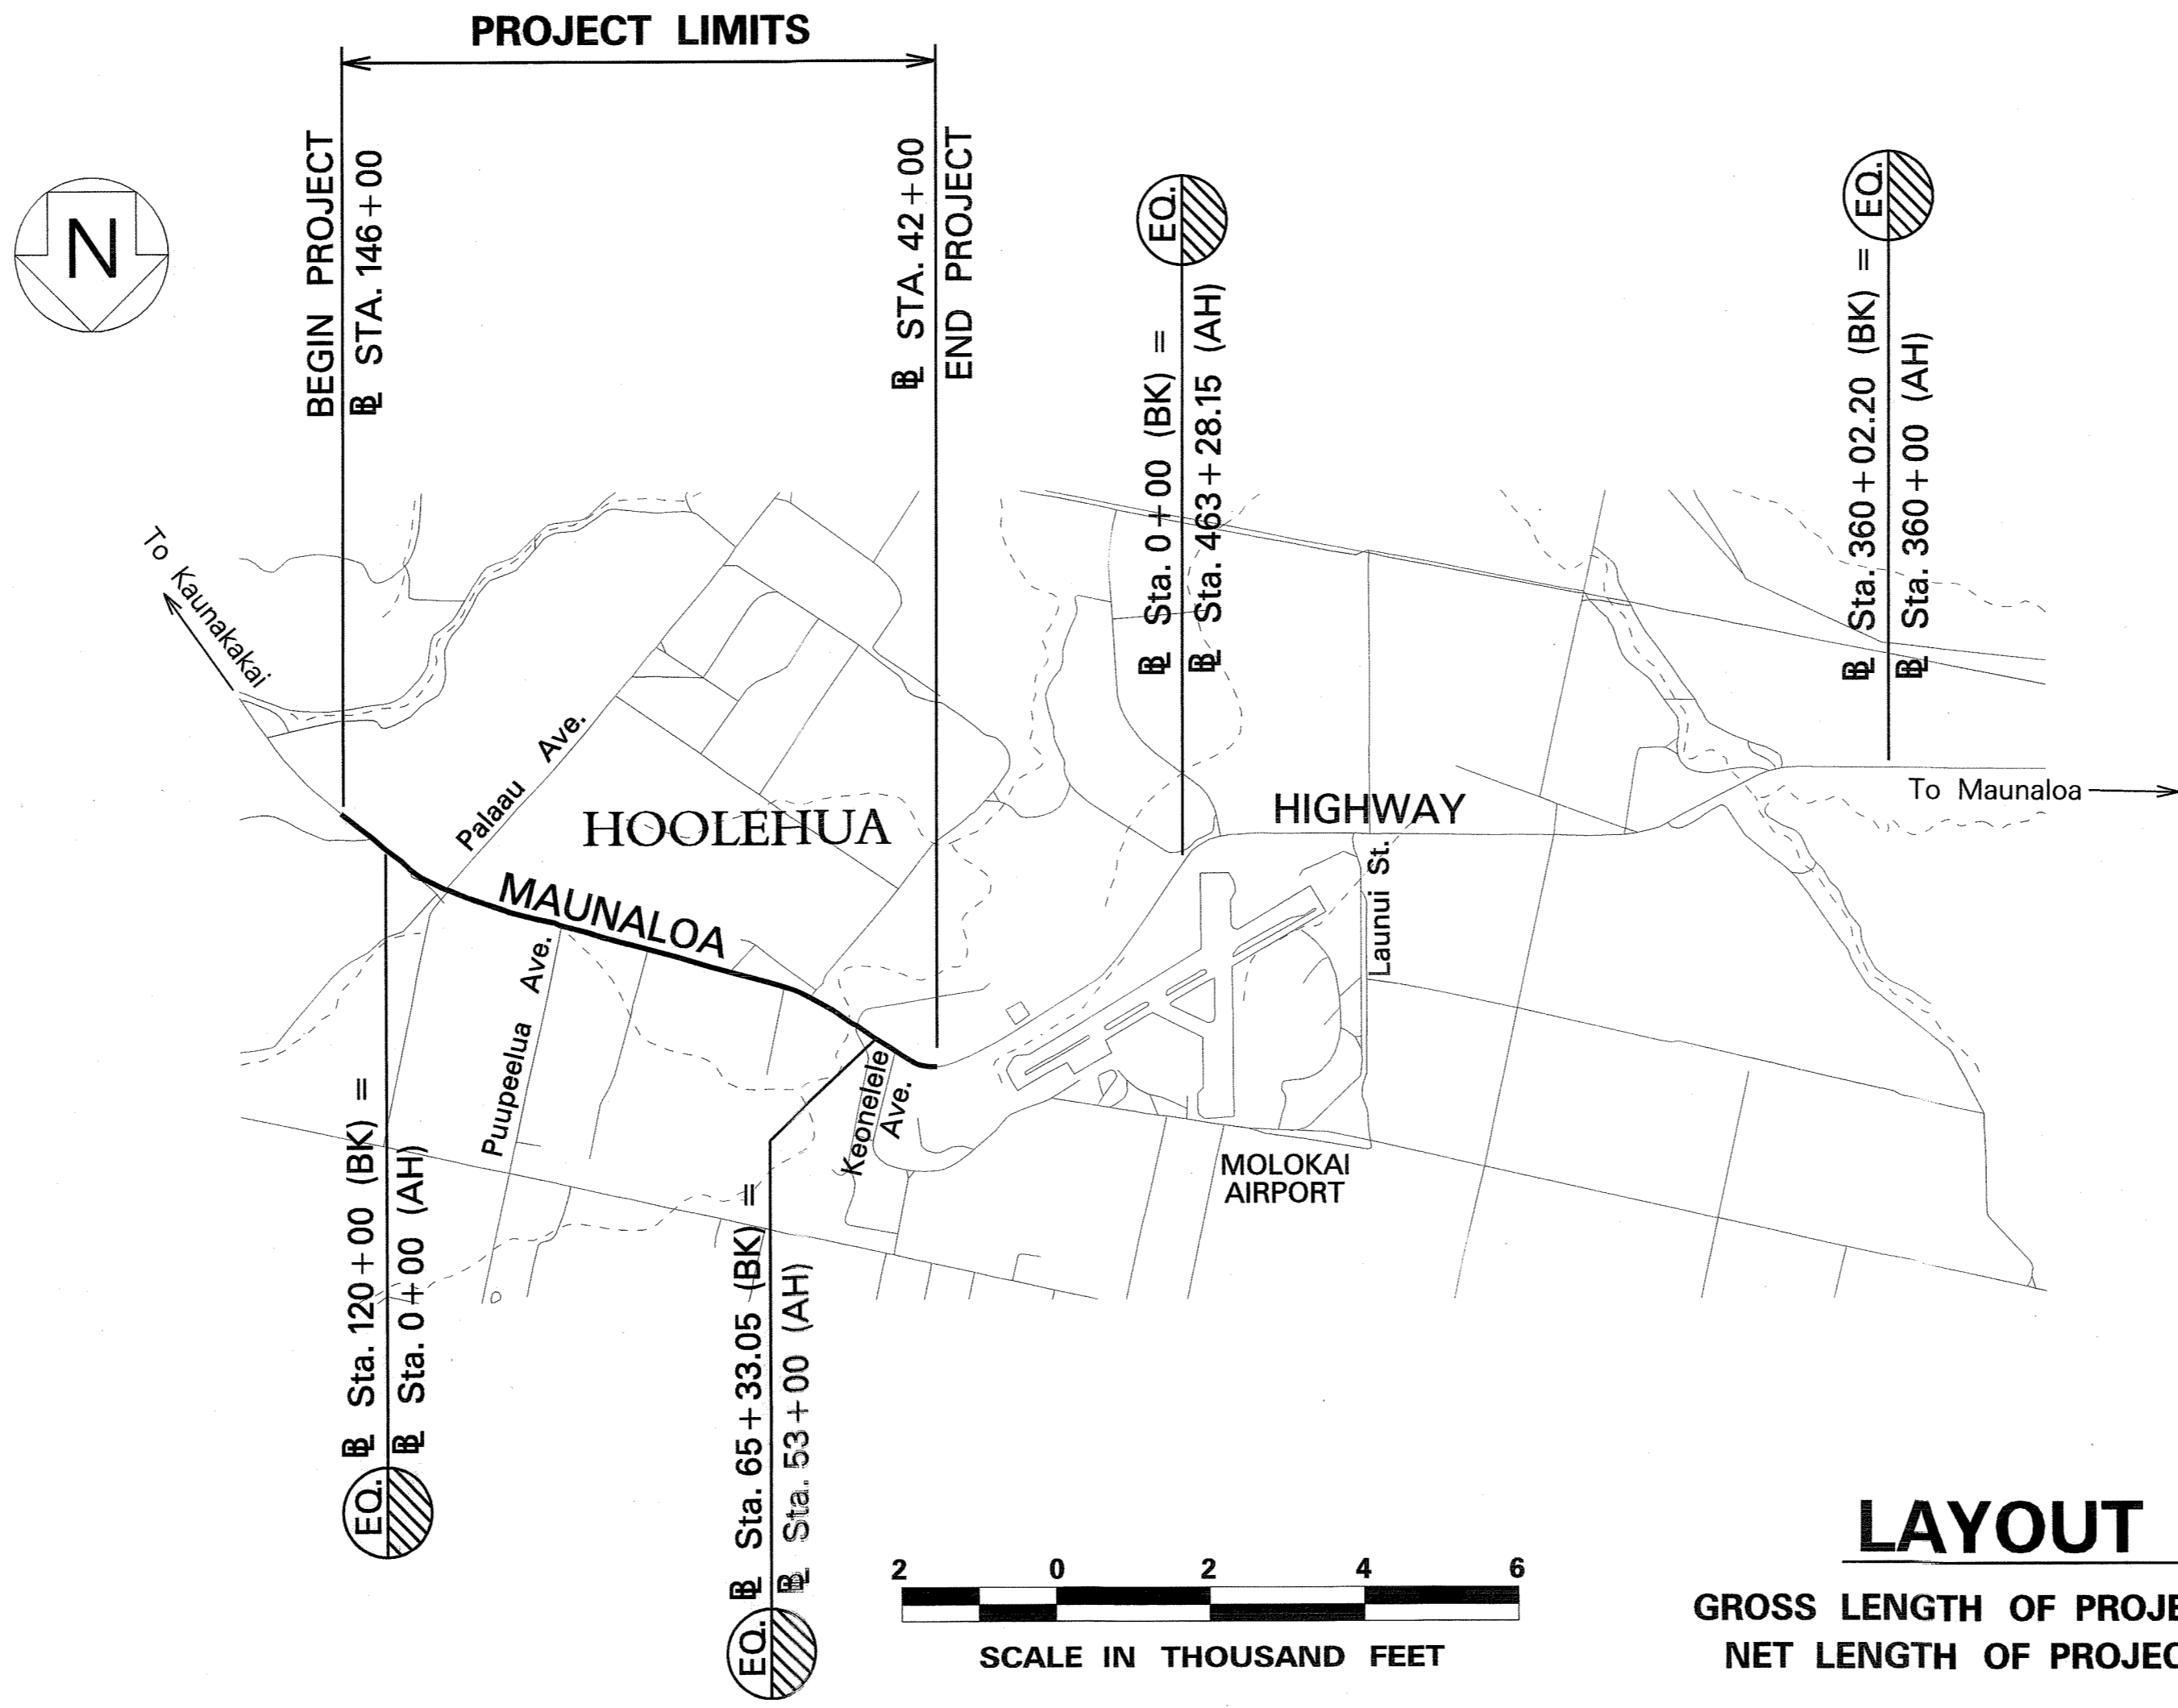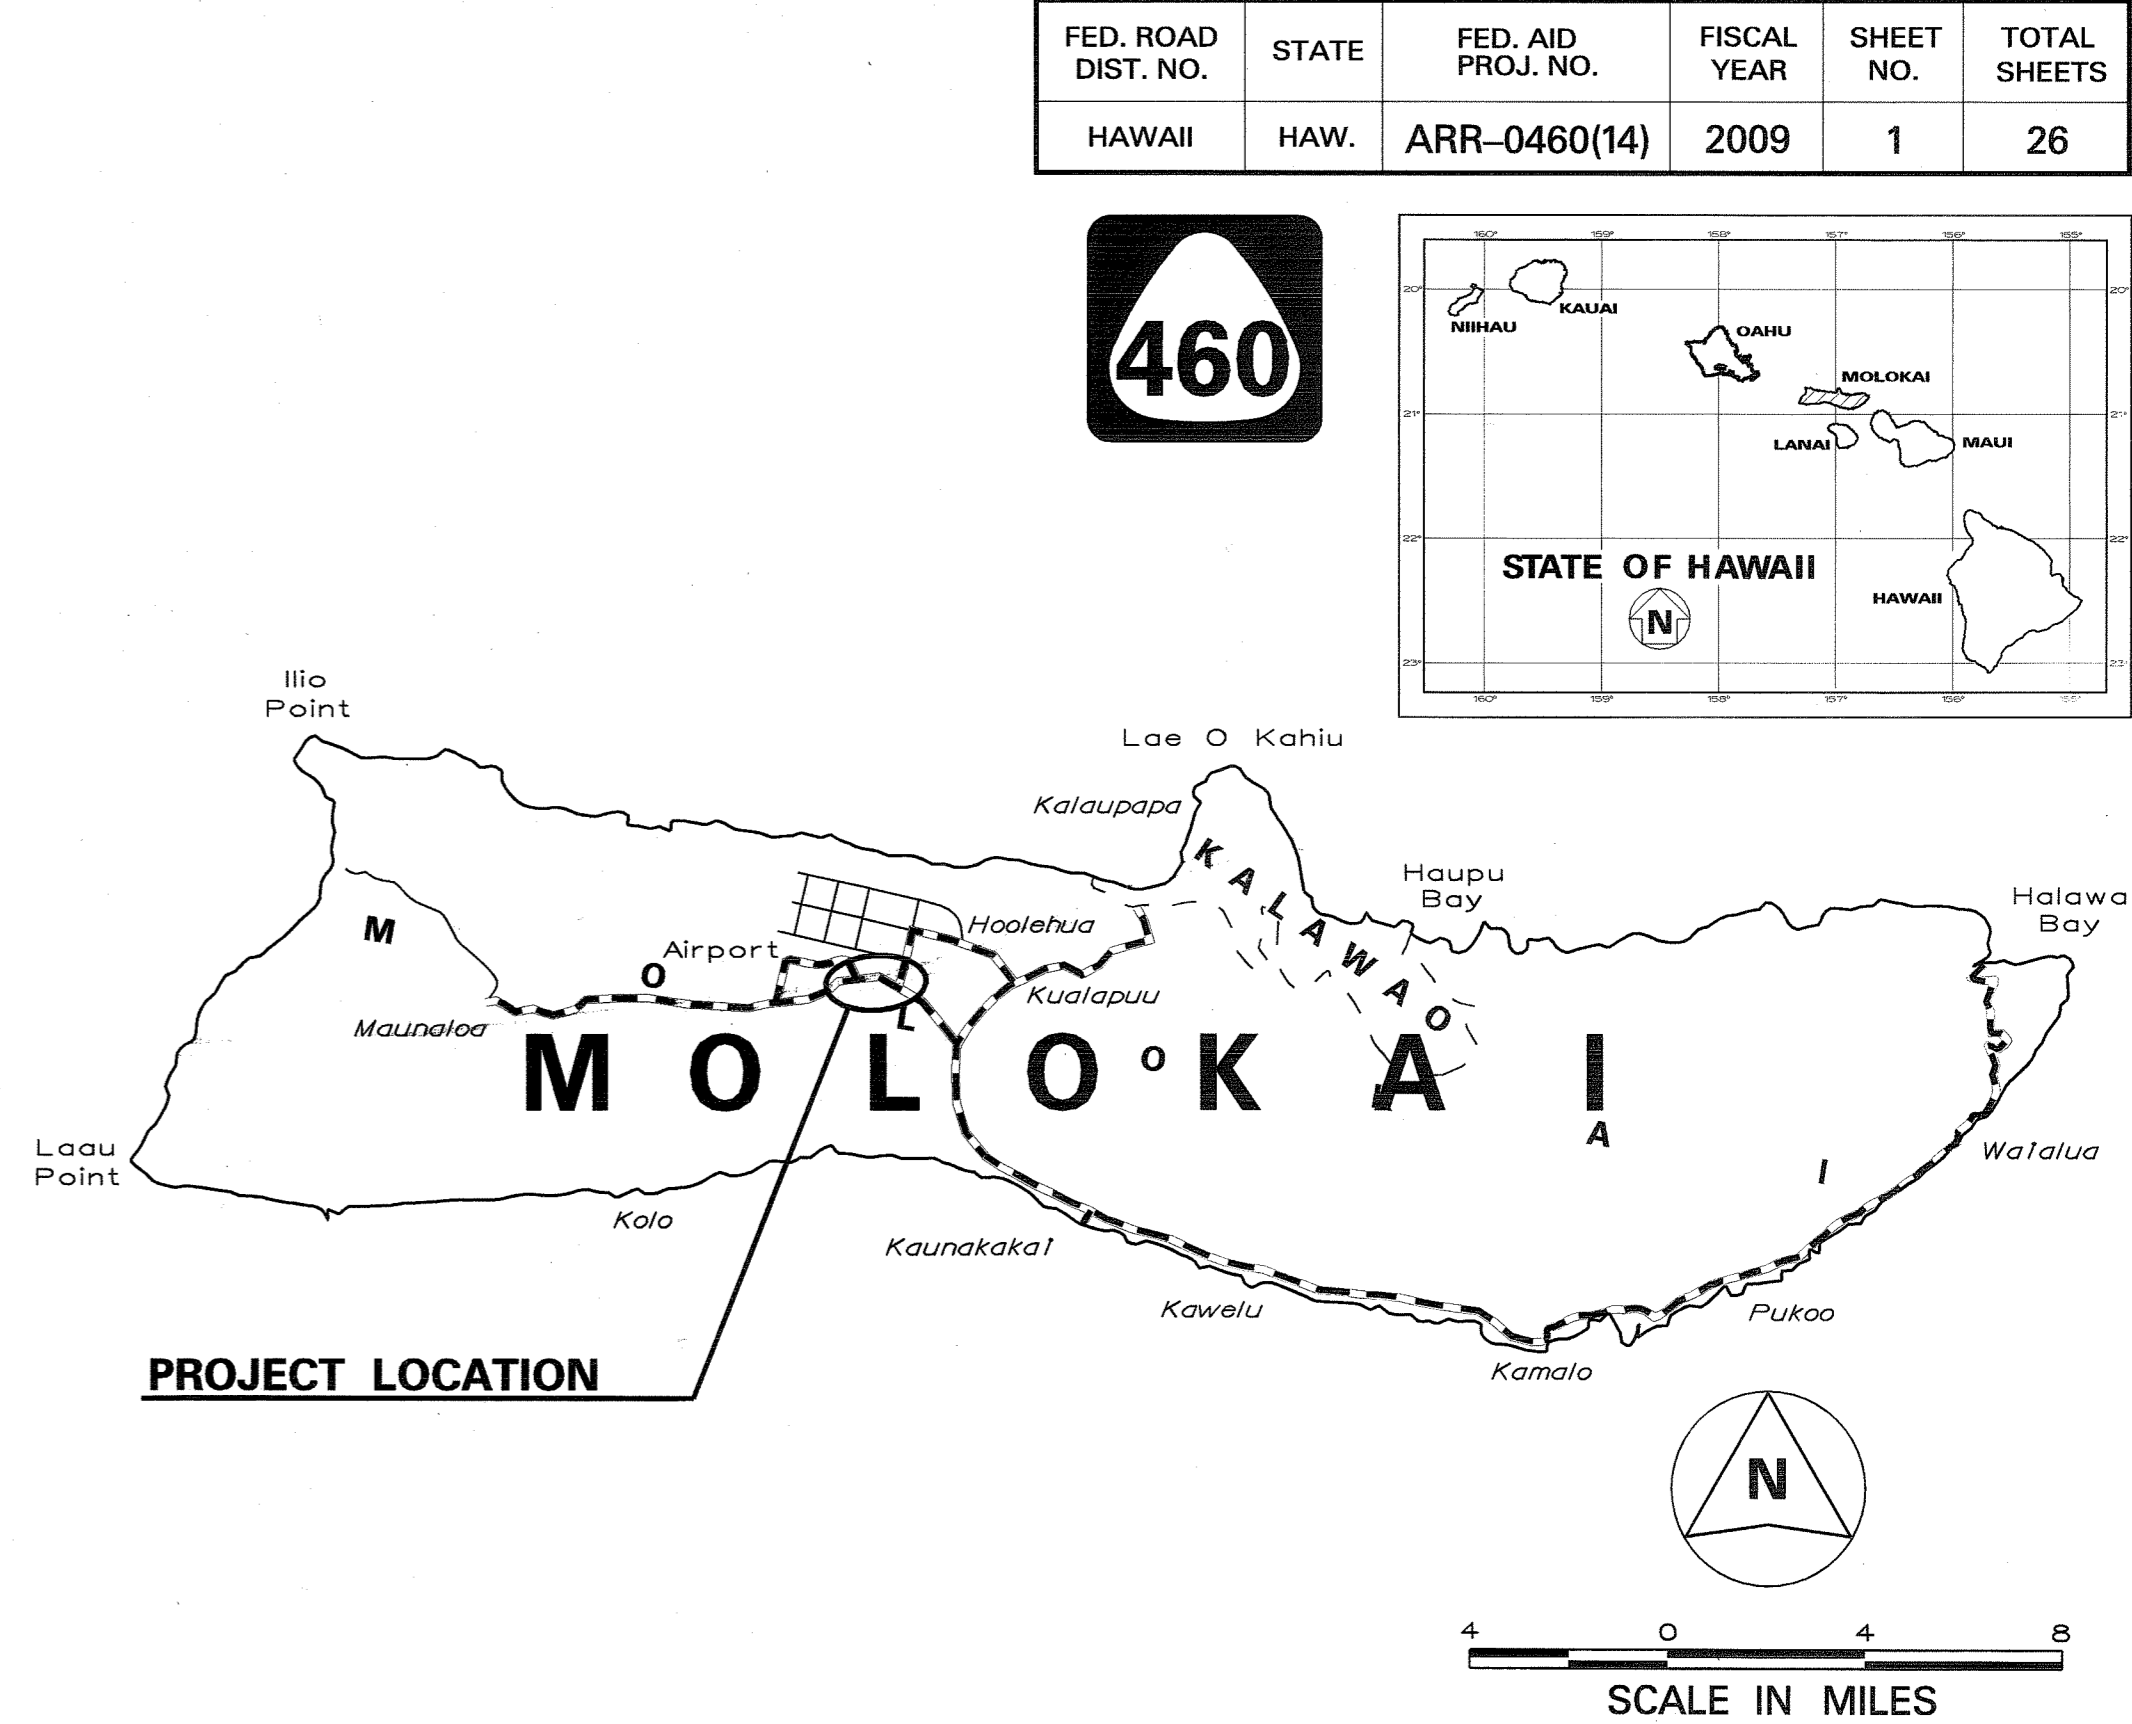

FEDERAL AID PROJECTS PREVIOUSLY CONSTRUCTED OR UNDER CONSTRUCTION

MILE POST 5.13 TO MILE POST 7.0

| TRAFFIC DATA | KALAE HWY. TO AIRPORT LP. (HOOLEHUA) | AIRPORT LP. TO KALUA KOI RD. (MAHANA) |
|--------------|--------------------------------------|---------------------------------------|
| | ADT (2009) | ADT (2019) |
| DHV | 300 | 170 |
| DESIGN K | 9.5 | 10.0 |
| DESIGN D | 55/45 | 65/35 |
| DESIGN T | 4.0 | 2.5 |
| T24 | 3.0 | 4.0 |

CHANGES MADE DURING CONSTRUCTION HAVE BEEN INCORPORATED ON THESE PLANS EXCEPT CHANGES IN THE ORIGINAL THEORETICAL QUANTITIES. FOR ACTUAL QUANTITIES, REFER TO PROJECT LEDGER AND/OR COMPUTATION BOOK.

RESIDENT ENGINEER

9/2/10

DATE

LAYOUT PLAN

GROSS LENGTH OF PROJECT.....1.87 MILES

NET LENGTH OF PROJECT.....1.87 MILES

DEPARTMENT OF TRANSPORTATION

STATE OF HAWAII

APPROVED:

4-17-09

DATE

DESIGNED BY

HWY-M

MANAGED BY

HWY-ME

PHONE

873-3535

DATE

FEB., 2009