
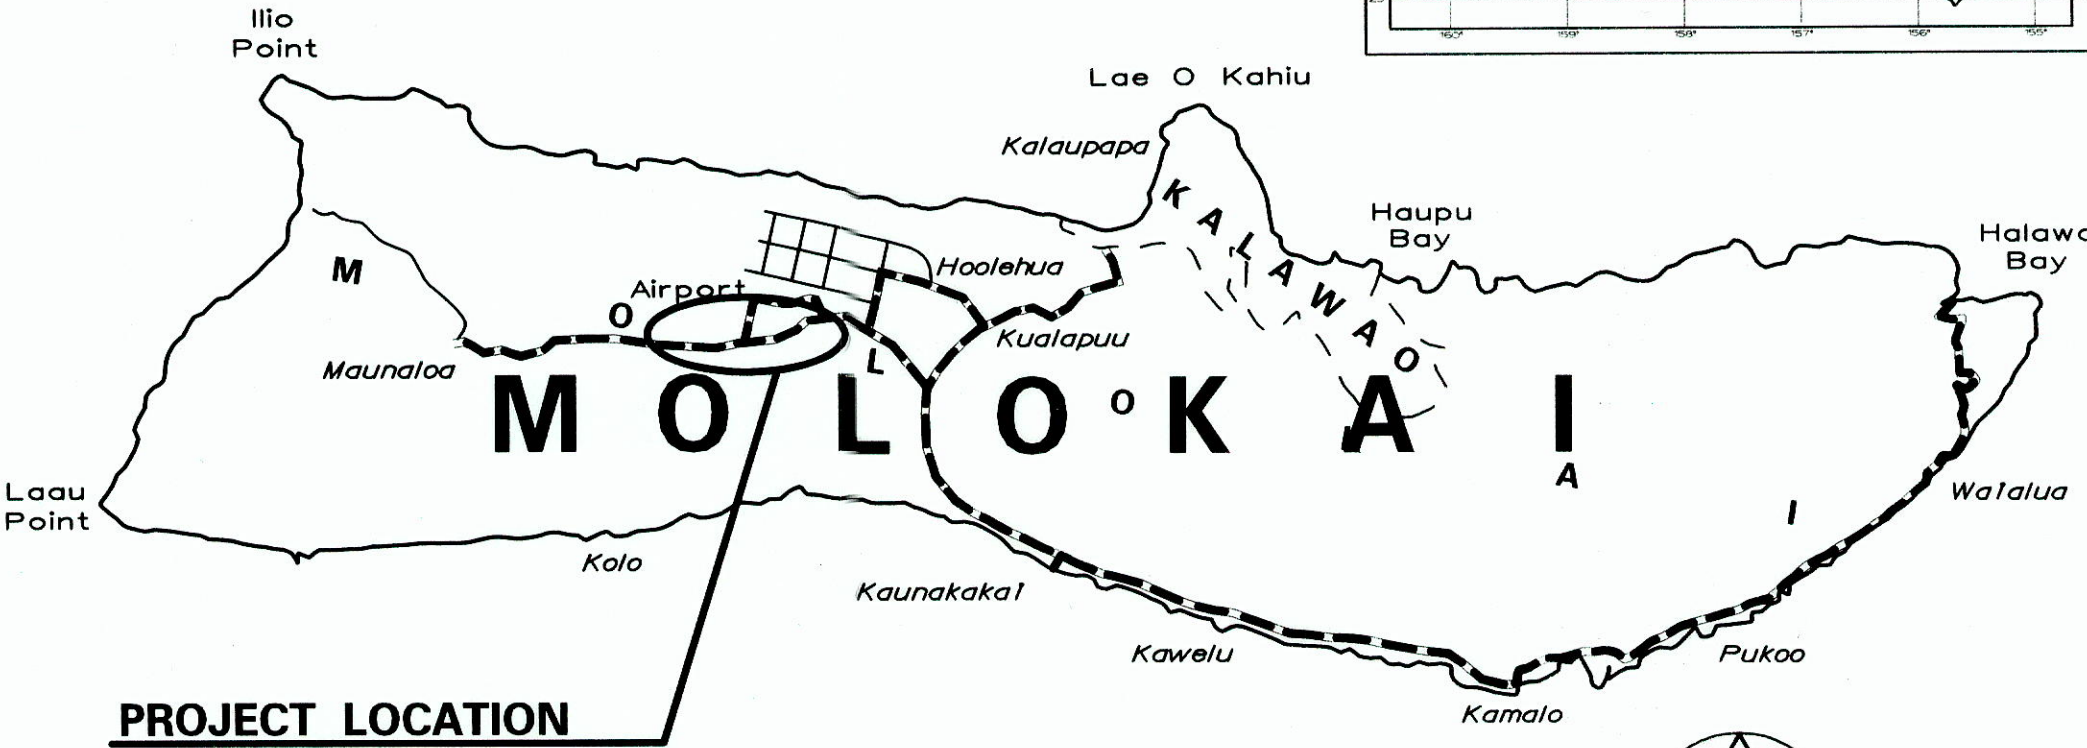


| INDEX TO DRAWINGS |                                            |
|-------------------|--------------------------------------------|
| SHEET NO.         | DESCRIPTION                                |
| 1                 | TITLE SHEET                                |
| 2                 | STANDARD PLANS SUMMARY                     |
| 3                 | GENERAL NOTES AND LEGEND                   |
| 4 - 5             | WATER POLLUTION & EROSION CONTROL NOTES    |
| 6 - 7             | TYPICAL SECTIONS AND DETAILS               |
| 8                 | GUARDRAIL DETAILS                          |
| 9 - 13            | ROADWAY PLANS                              |
| 14                | PAVEMENT MARKING LEGEND, DETAILS AND NOTES |
| 15 - 17           | RUMBLE STRIP DETAILS, SIGN DETAILS & NOTES |
| 18                | WORK ZONE SIGNING PLAN, NOTES & DETAILS    |
| 19                | SIGN PANEL LAYOUT & NOTES                  |
| 20 - 24           | SIGNING AND PAVEMENT MARKING PLANS         |

STATE OF HAWAII  
DEPARTMENT OF TRANSPORTATION  
HIGHWAYS DIVISION  
HONOLULU, HAWAII  
**"AS-BUILT"**  
PLANS FOR  
**MAUNALOA HIGHWAY RESURFACING**  
VICINITY OF KEONELELE AVENUE TO MAHANA  
**PROJECT NO. 460A-01-10M**

DISTRICT OF MOLOKAI  
ISLAND OF MOLOKAI

| FED. ROAD DIST. NO. | STATE | PROJ. NO.   | FISCAL YEAR | SHEET NO. | TOTAL SHEETS |
|---------------------|-------|-------------|-------------|-----------|--------------|
| HAWAII              | HAW.  | 460A-01-10M | 2010        | 1         | 24           |

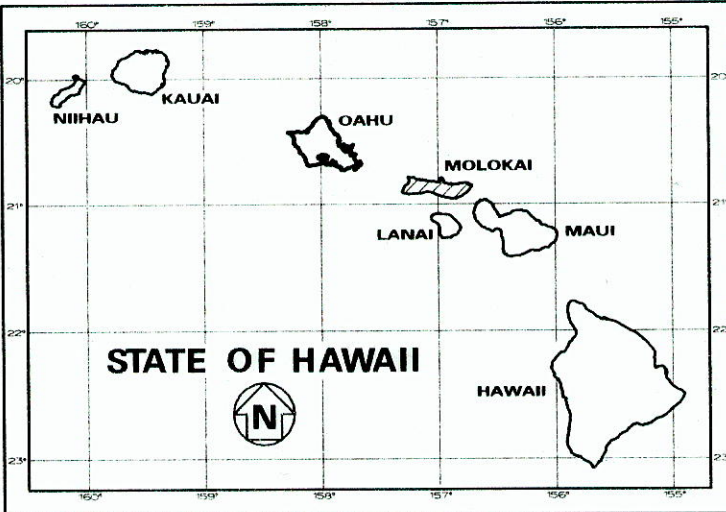

4 0 4 8  
SCALE IN MILES

--- FEDERAL AID PROJECTS PREVIOUSLY CONSTRUCTED OR UNDER CONSTRUCTION


MILE POST 7.25 TO MILE POST 9.25

APRIL, 2010  
DATE

873-3535  
PHONE

HWY-ME  
MANAGED BY

HWY-M  
DESIGNED BY

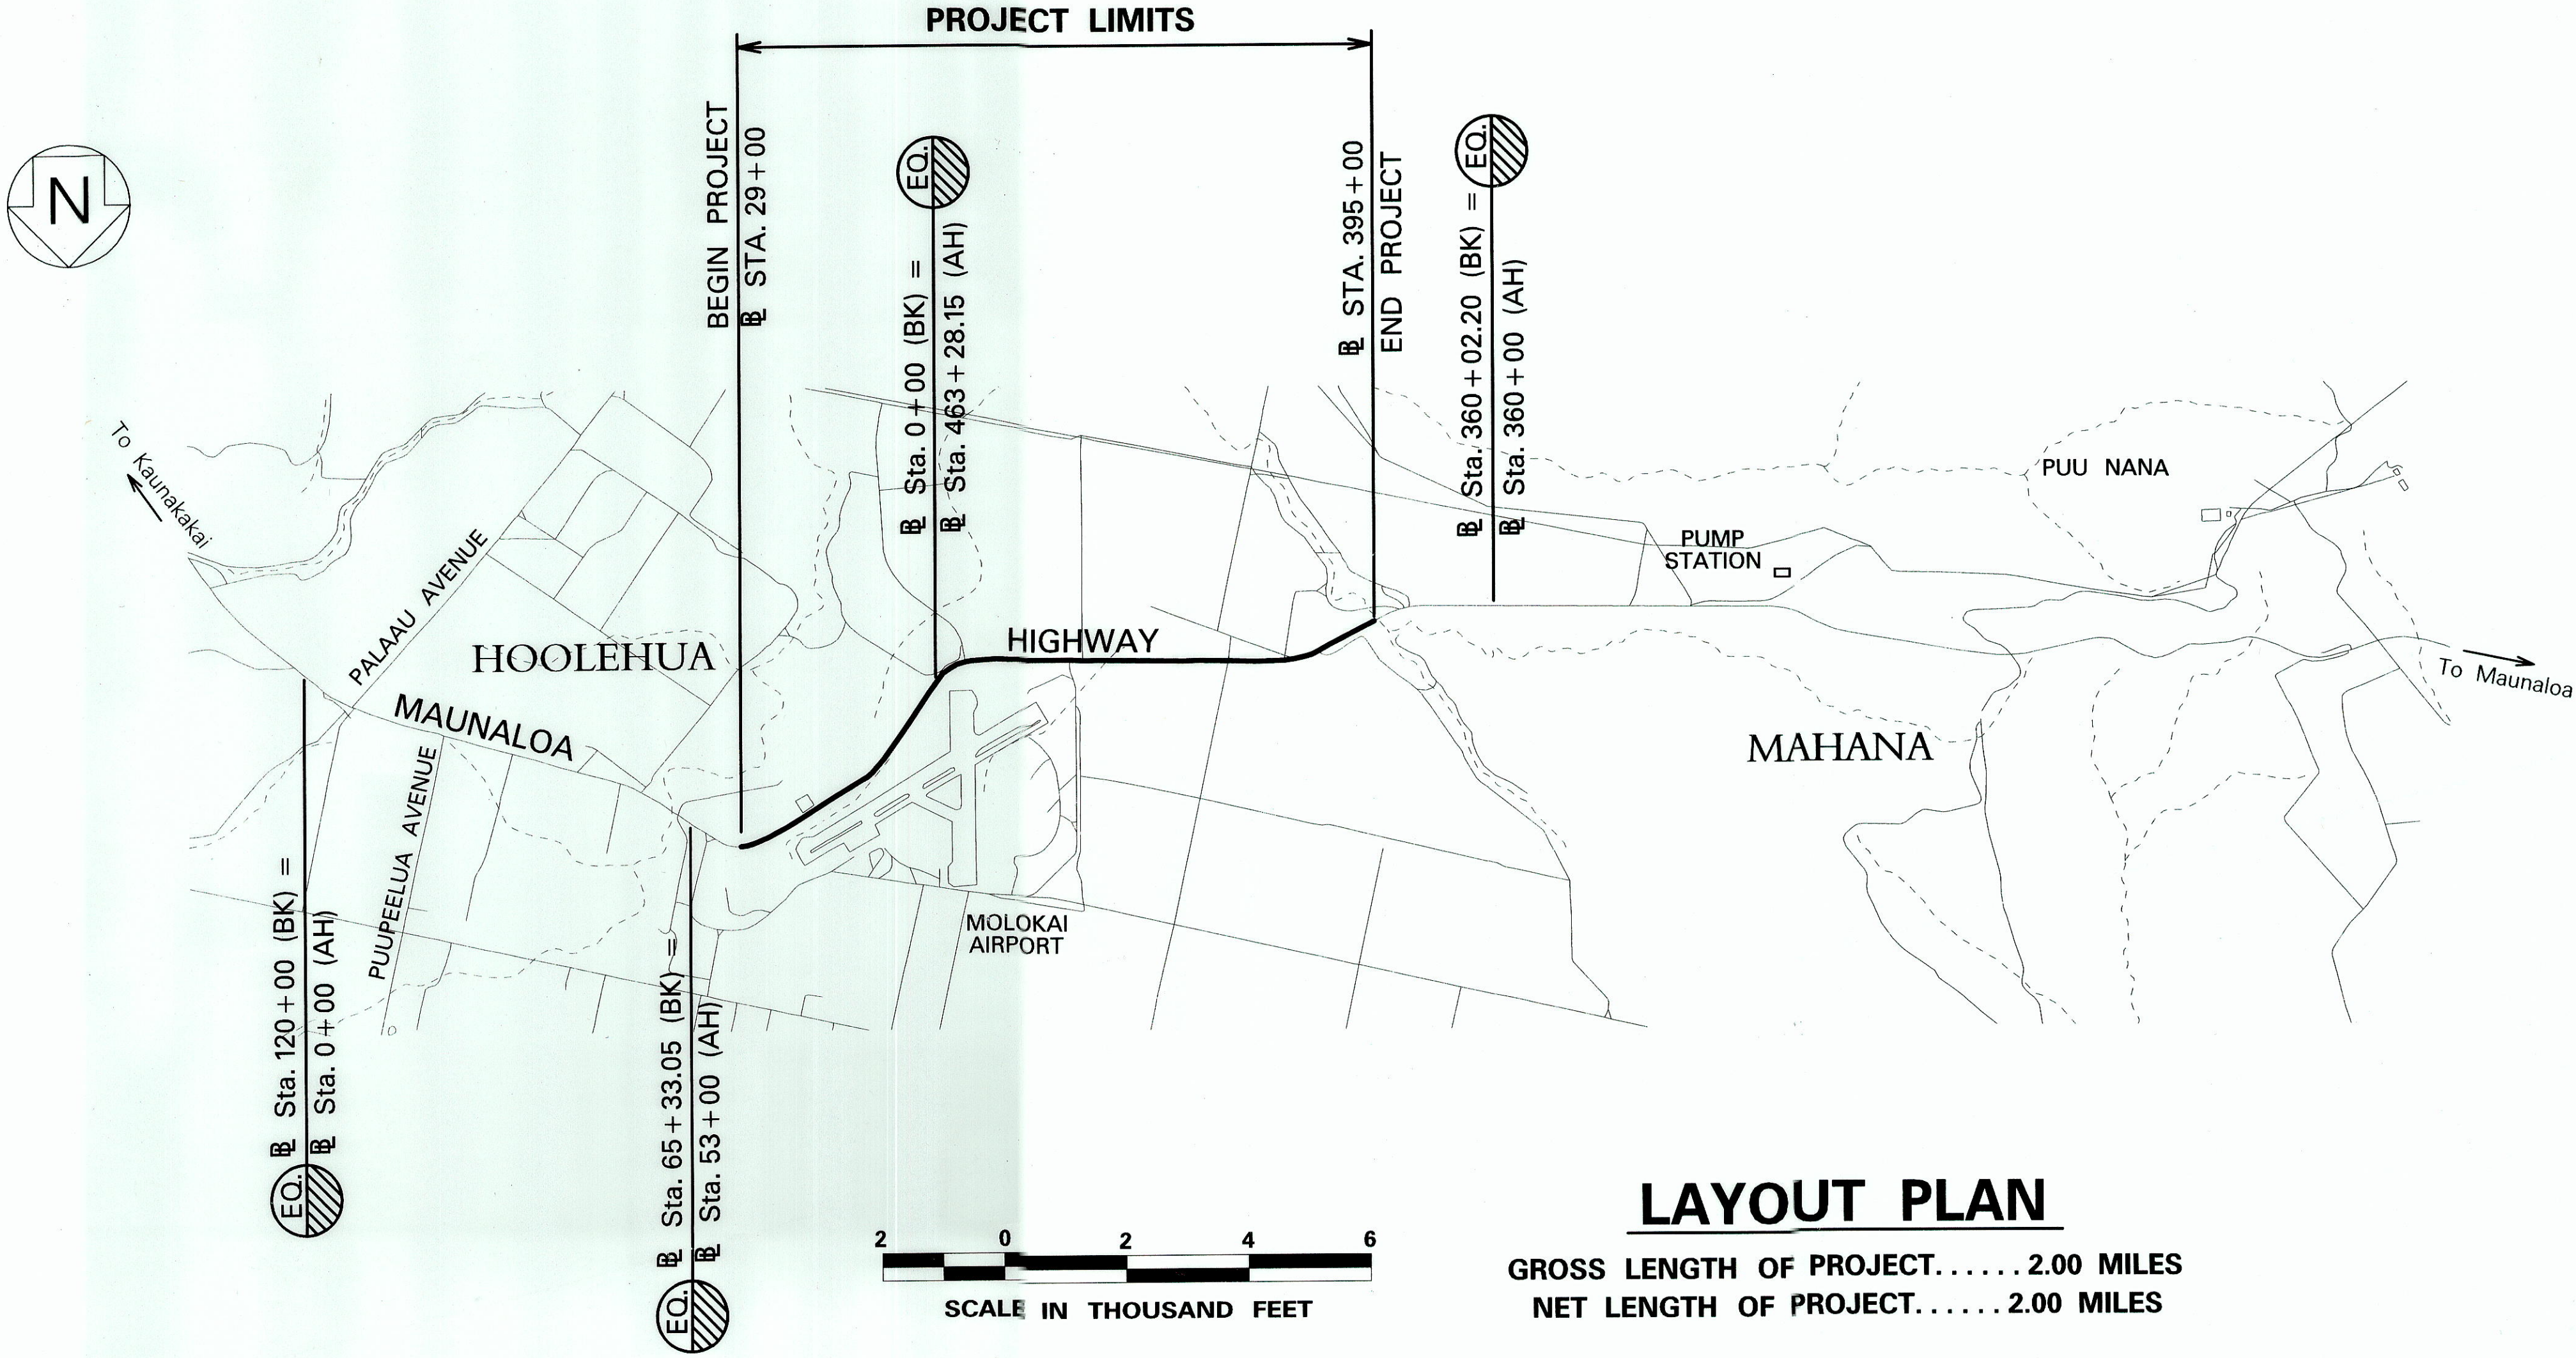

LAYOUT PLAN

GROSS LENGTH OF PROJECT.....2.00 MILES  
NET LENGTH OF PROJECT.....2.00 MILES

CHANGES MADE DURING CONSTRUCTION HAVE BEEN INCORPORATED ON THESE PLANS EXCEPT CHANGES IN THE ORIGINAL THEORETICAL QUANTITIES. FOR ACTUAL QUANTITIES, REFER TO PROJECT LEDGER AND/OR COMPUTATION BOOK.

RESIDENT ENGINEER

10/16/15  
DATE

| DEPARTMENT OF TRANSPORTATION<br>STATE OF HAWAII |                 |
|-------------------------------------------------|-----------------|
| APPROVED:                                       |                 |
| DIR. OF TRANSPORTATION                          | 5/25/10<br>DATE |