
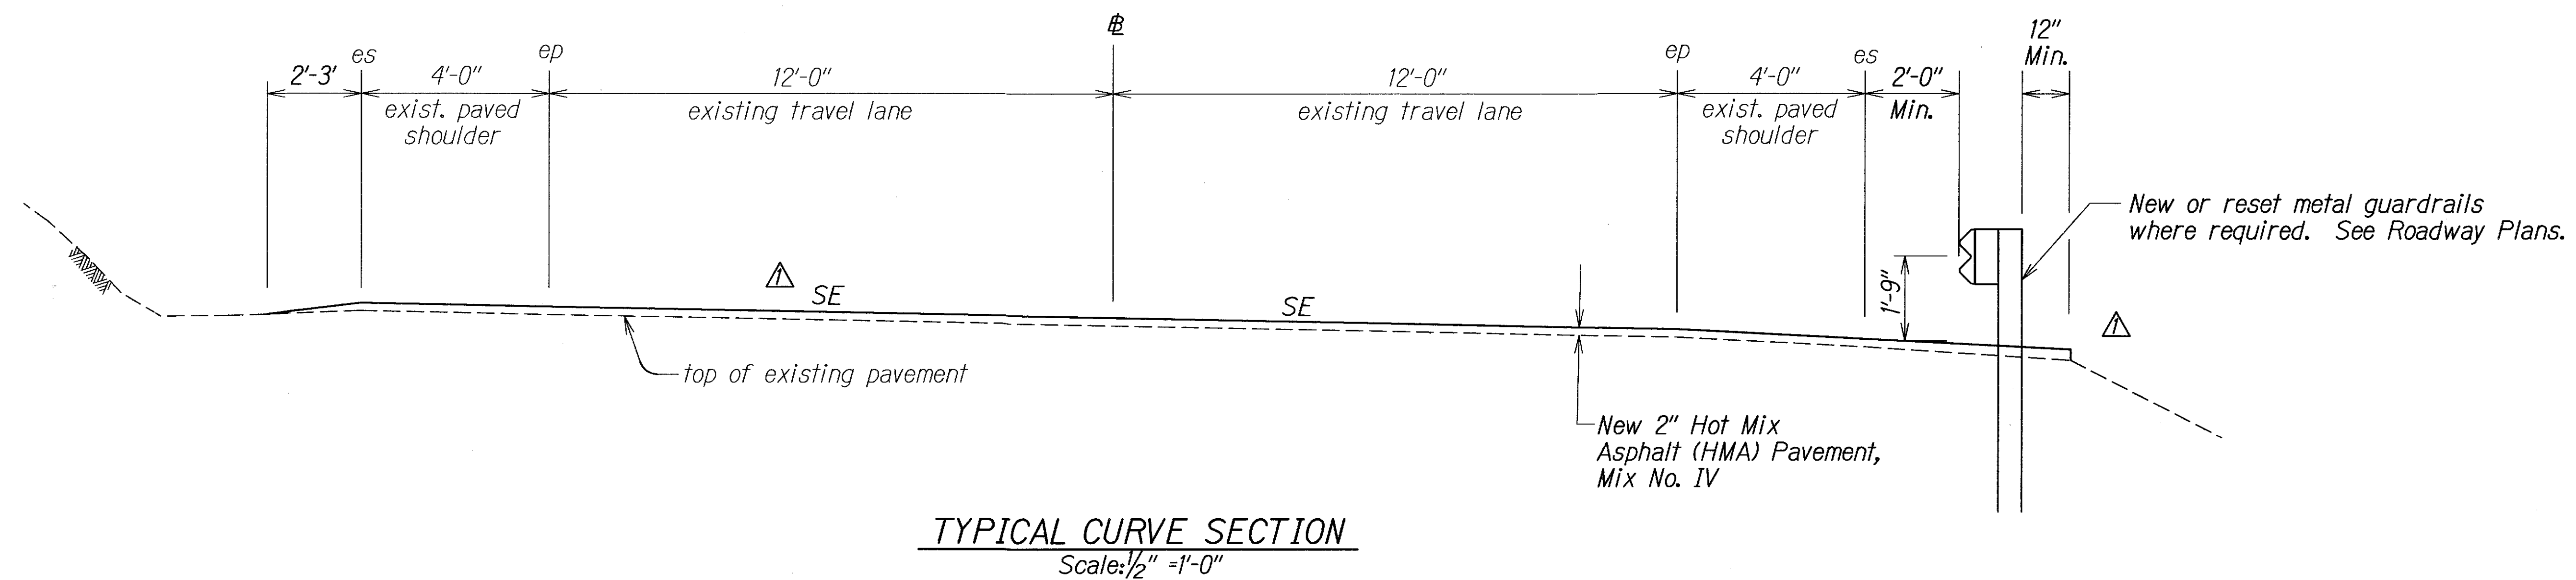


FED. ROAD DIST. NO.	STATE	PROJ. NO.	FISCAL YEAR	SHEET NO.	TOTAL SHEETS
HAWAII	HAW.	460A-01-10M	2010	ADD.6	24

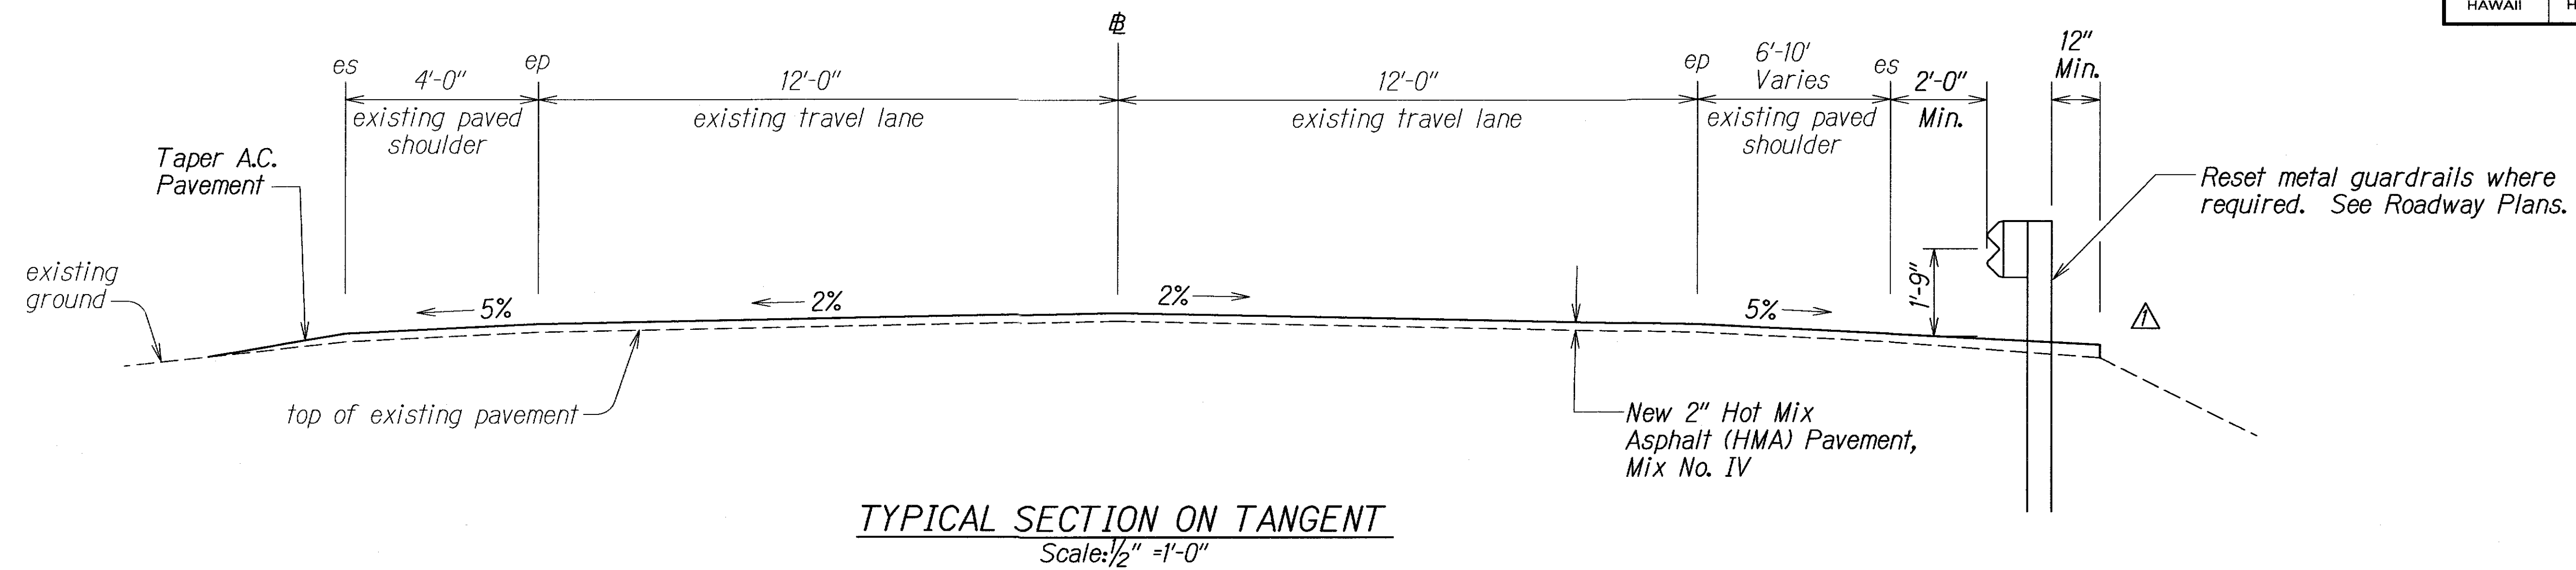

ORIGINAL PLAN	DATE
SURVEY PLOTTED BY	4/10
DRAWN BY	
TRACED BY	
NOTED BY	
CHECKED BY	


6-14-10	Delete Leveling Course.
6-14-10	Delete existing concrete gutter and cold planing detail.
6-14-10	Revised paving detail behind guardrail.
6-14-10	Revised Superelevation.

DATE	REVISION
STATE OF HAWAII DEPARTMENT OF TRANSPORTATION HIGHWAYS DIVISION	
TYPICAL SECTIONS & DETAILS	
MAUNALO A HIGHWAY RESURFACING	
Vicinity of Keonelele Avenue to Mahana	
Project No. 460A-01-10M	
Scale: As Shown	Date: April, 2010


SHEET No. 1 OF 2 SHEETS

ADD. 6


FED. ROAD DIST. NO.	STATE	PROJ. NO.	FISCAL YEAR	SHEET NO.	TOTAL SHEETS
HAWAII	HAW.	460A-01-10M	2010	7	24

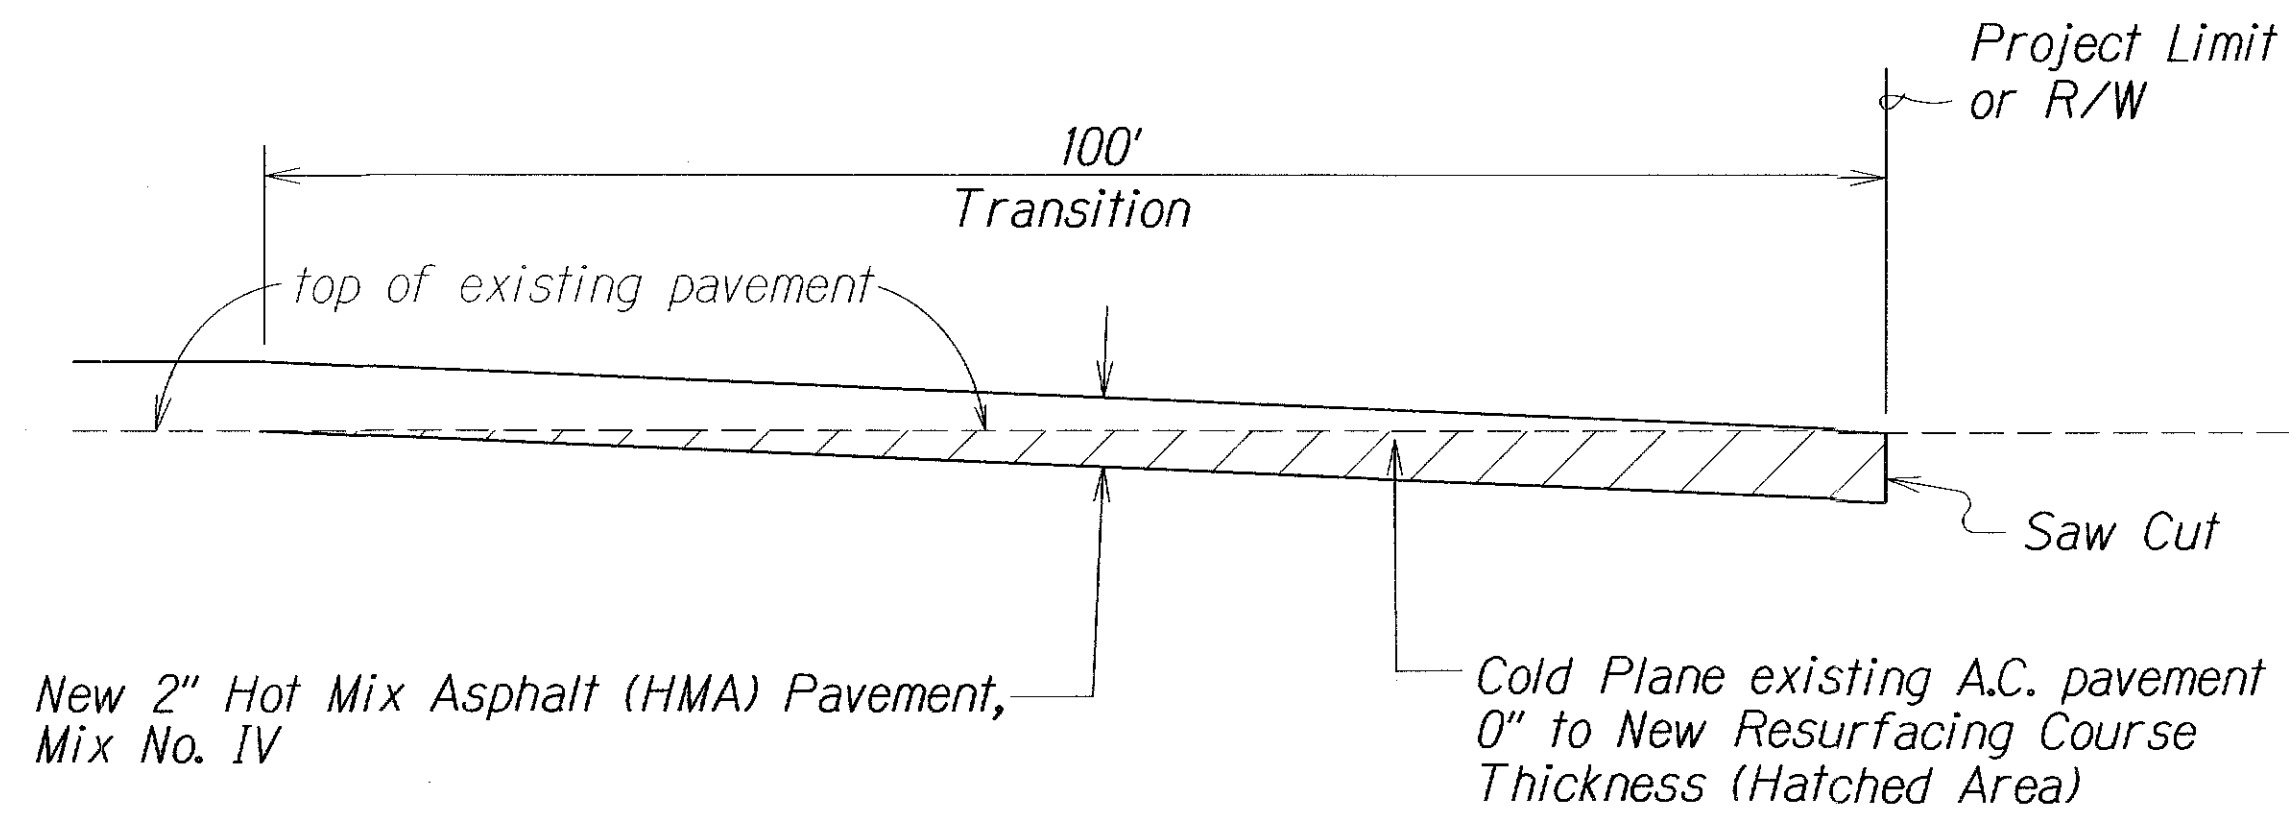


COLD PLANED TRANSITION TO EXISTING A.C. PAVEMENT DETAIL
BEGIN AND END OF PROJECT
 Not To Scale

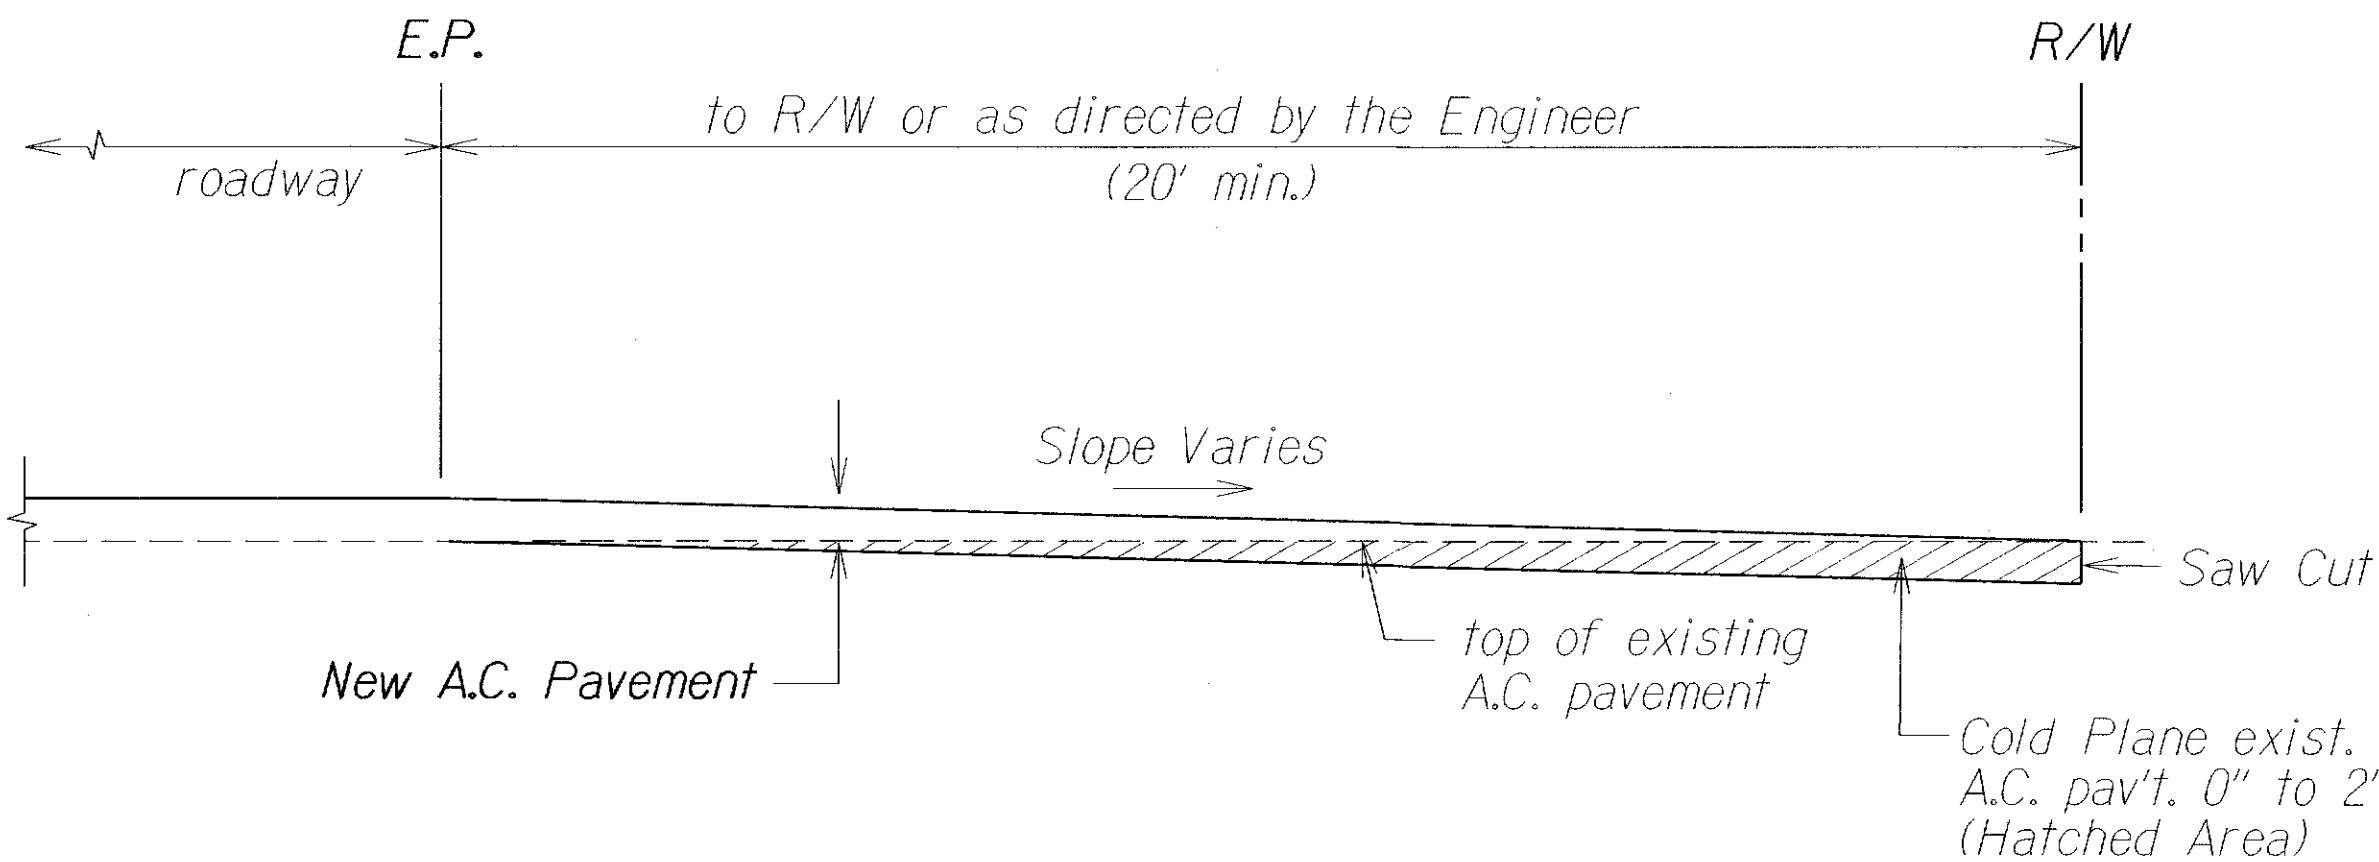

COLD PLANED TRANSITION TO EXISTING
PAVED SIDE ROAD DETAIL
 Not To Scale

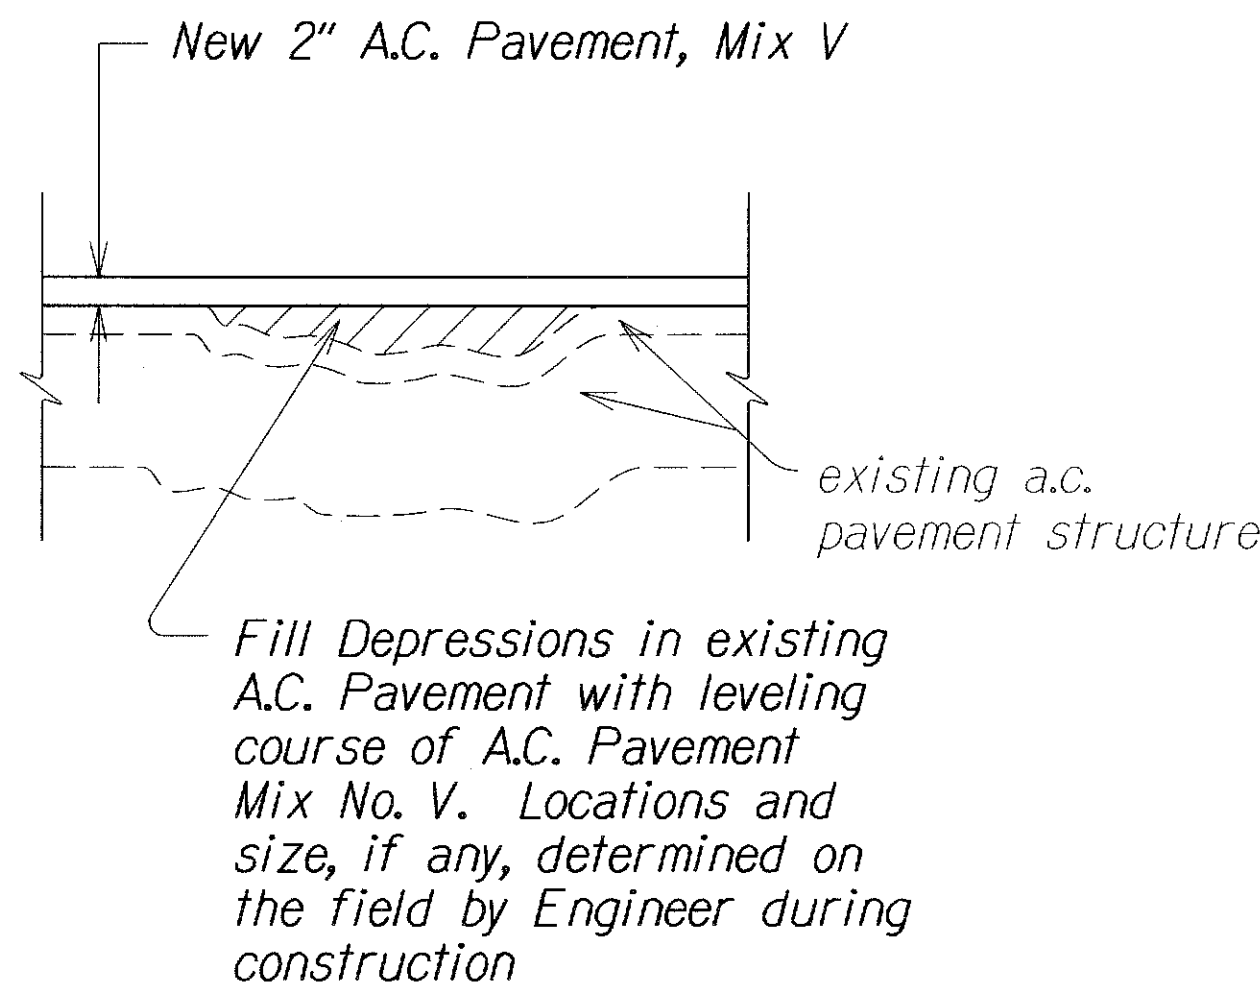

LEVELING COURSE DETAIL
 Not To Scale

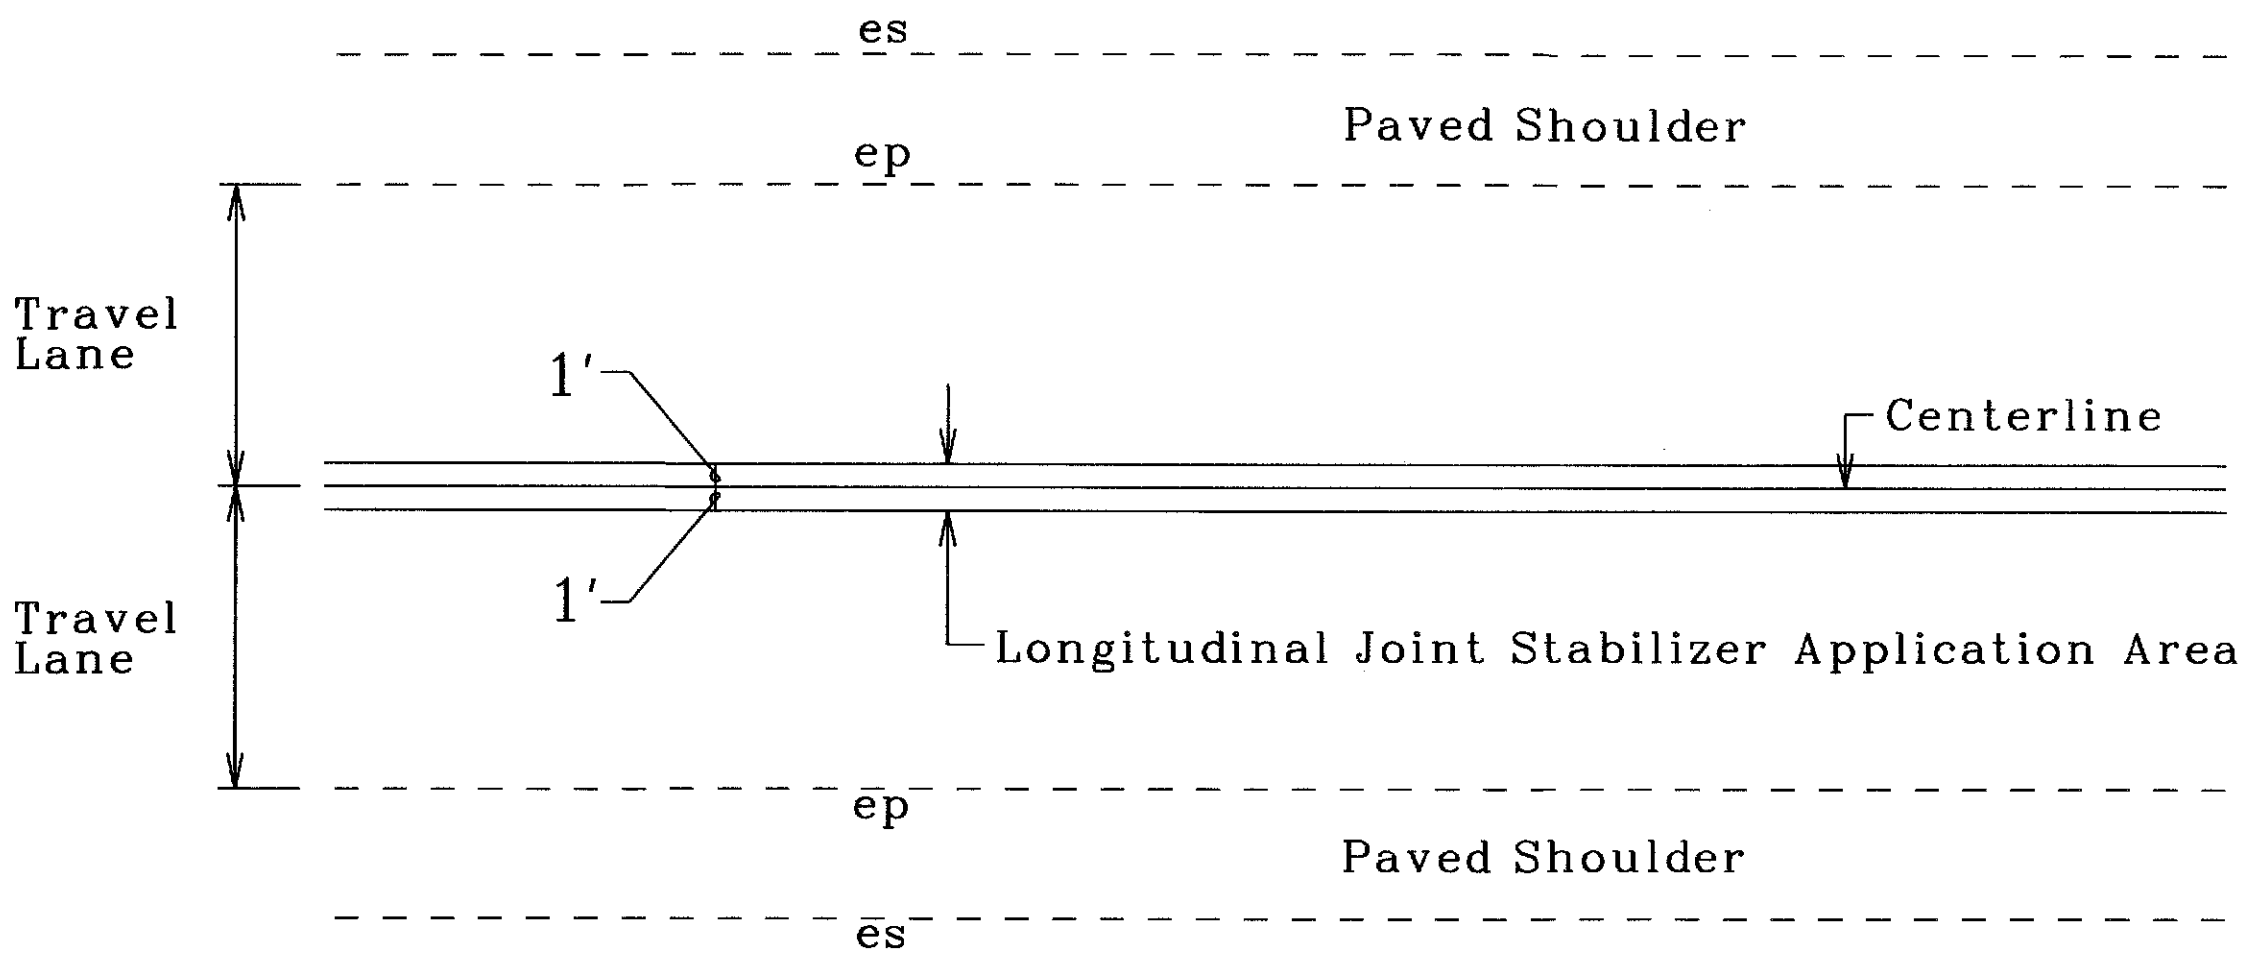

TYPICAL SECTION FOR
LONGITUDINAL JOINT STABILIZER
 Not to Scale

ORIGINAL PLAN	SURVEY PLOTTED BY	DATE
NOTED BOOK	DRAWN BY	DATE
DESIGNED BY	TRACED BY	DATE
CHECKED BY	CHECKED BY	DATE

LEGEND FOR AS-BUILT POSTINGS	
	Squiggly line for as-built deletion
	Double line for as-built deletion
Roadway	Text for as-built posting

STATE OF HAWAII DEPARTMENT OF TRANSPORTATION HIGHWAYS DIVISION	
TYPICAL SECTIONS & DETAILS	
<u>MAUNALOA HIGHWAY RESURFACING</u> <u>Vicinity of Keonelele Avenue to Mahana</u> <u>Project No. 460A-01-10M</u>	
Scale: As Shown	Date: April, 2010
SHEET No. 2 OF 2 SHEETS	