

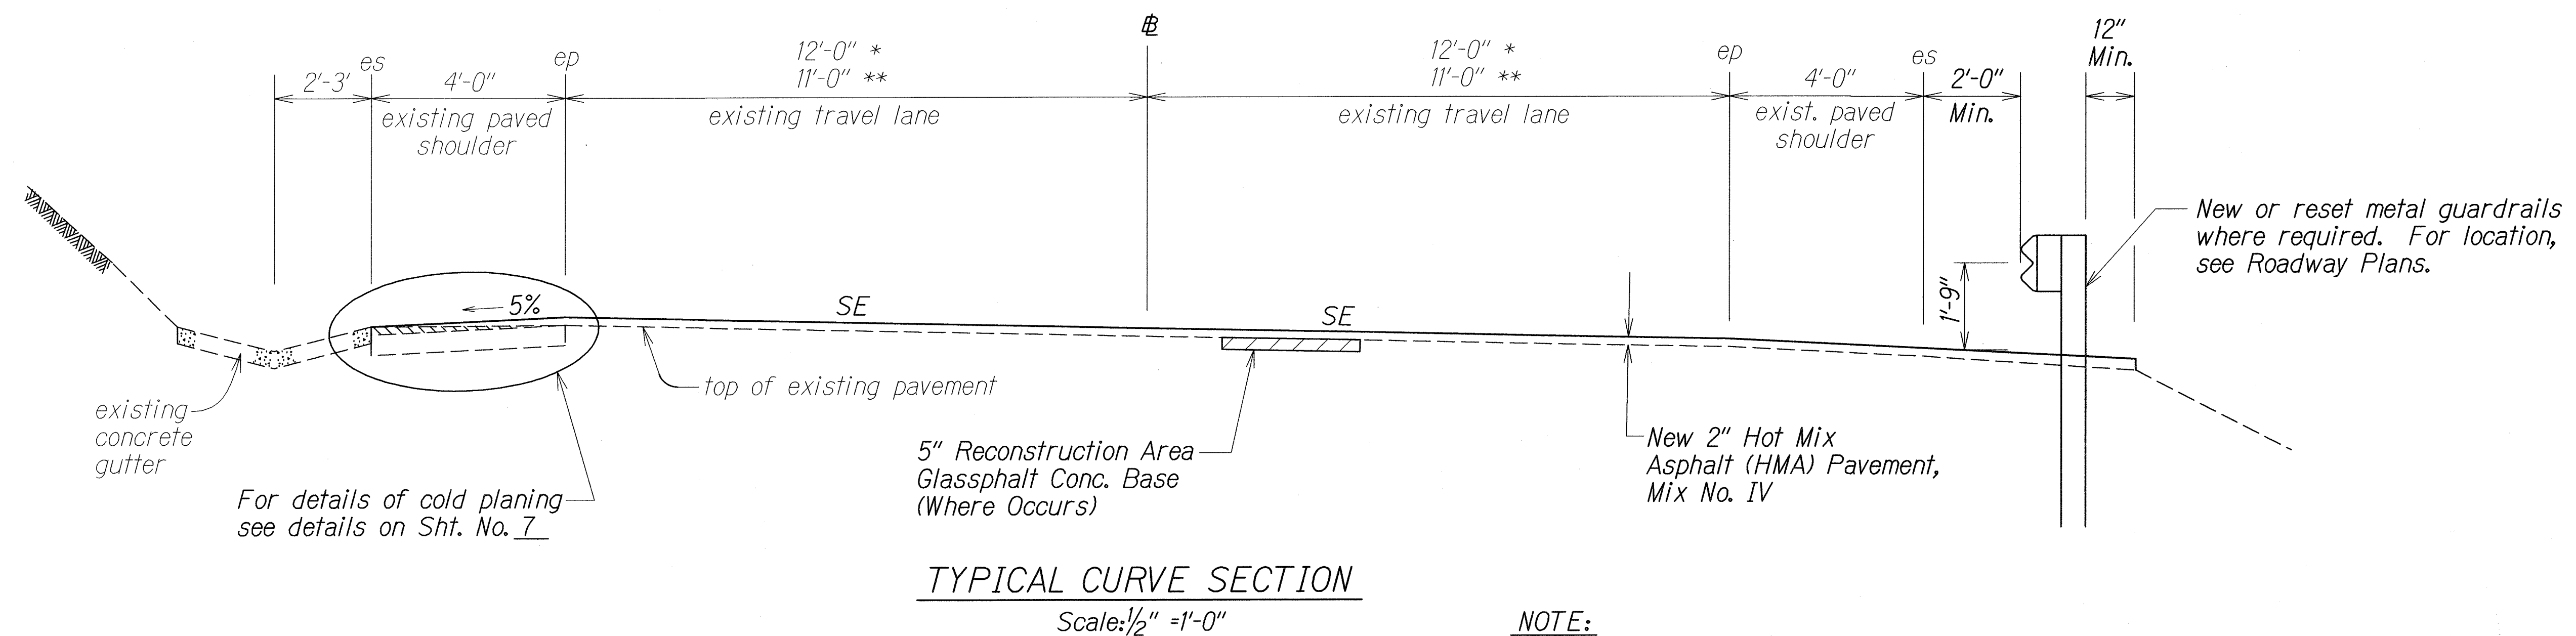


FED. ROAD DIST. NO.	STATE	PROJ. NO.	FISCAL YEAR	SHEET NO.	TOTAL SHEETS
HAWAII	HAW.	460A-01-11MR	2011	ADD.6	29

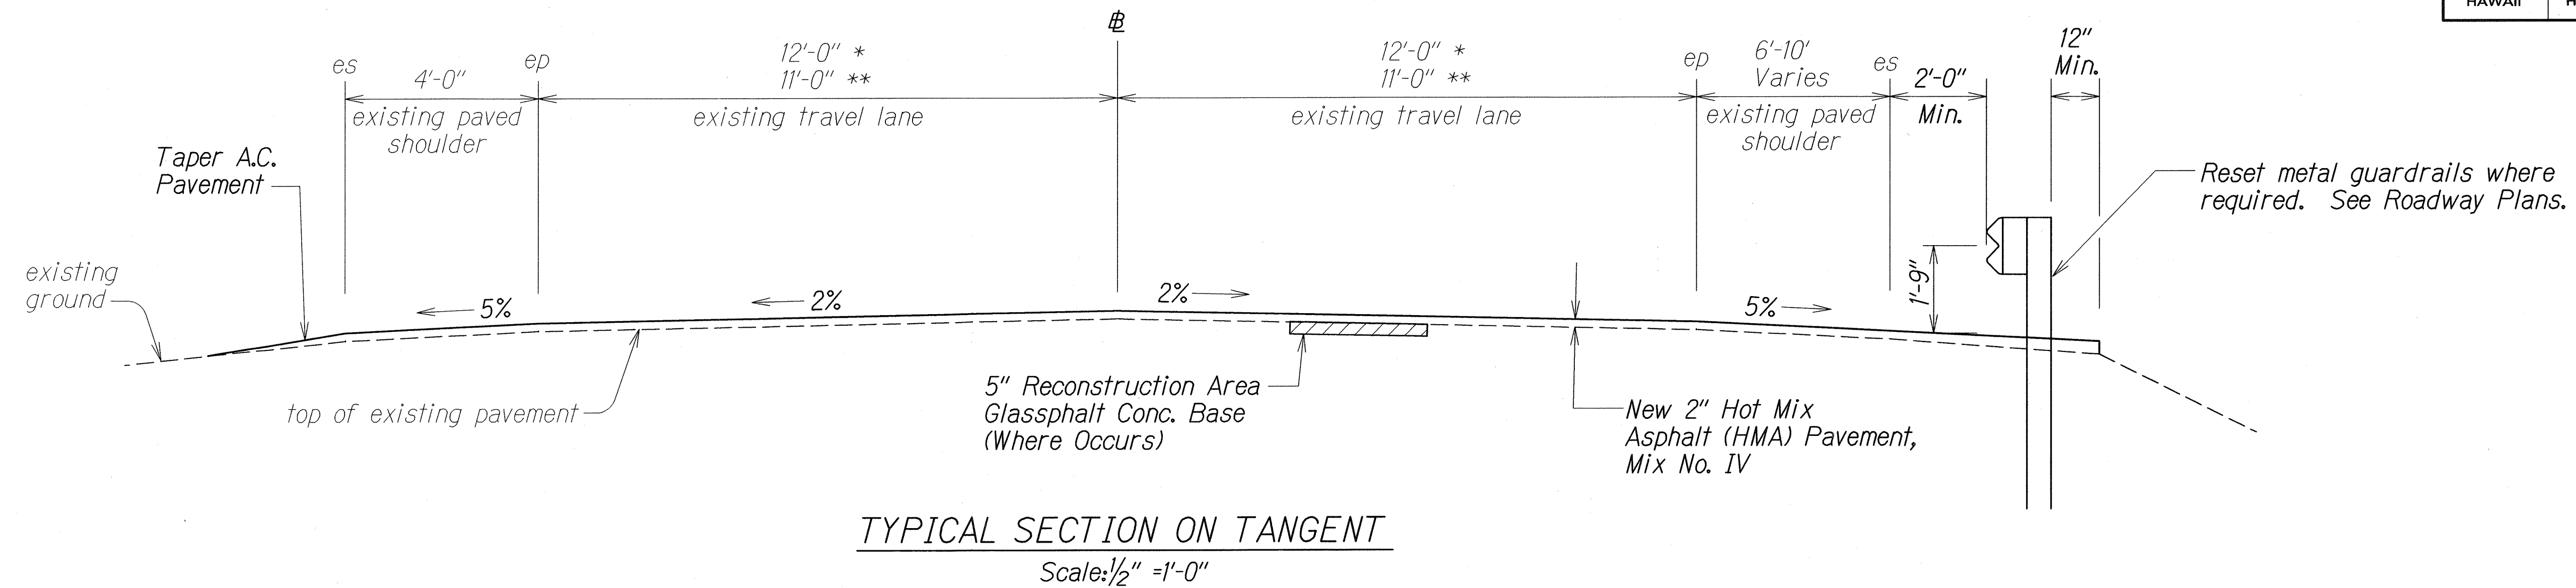

NOTE:
 * 12'-0" Lane width from Sta. 395+00± to Sta. 360+00±
 ** 11'-0" Lane width from Sta. 360+00± to Sta. 290+00±

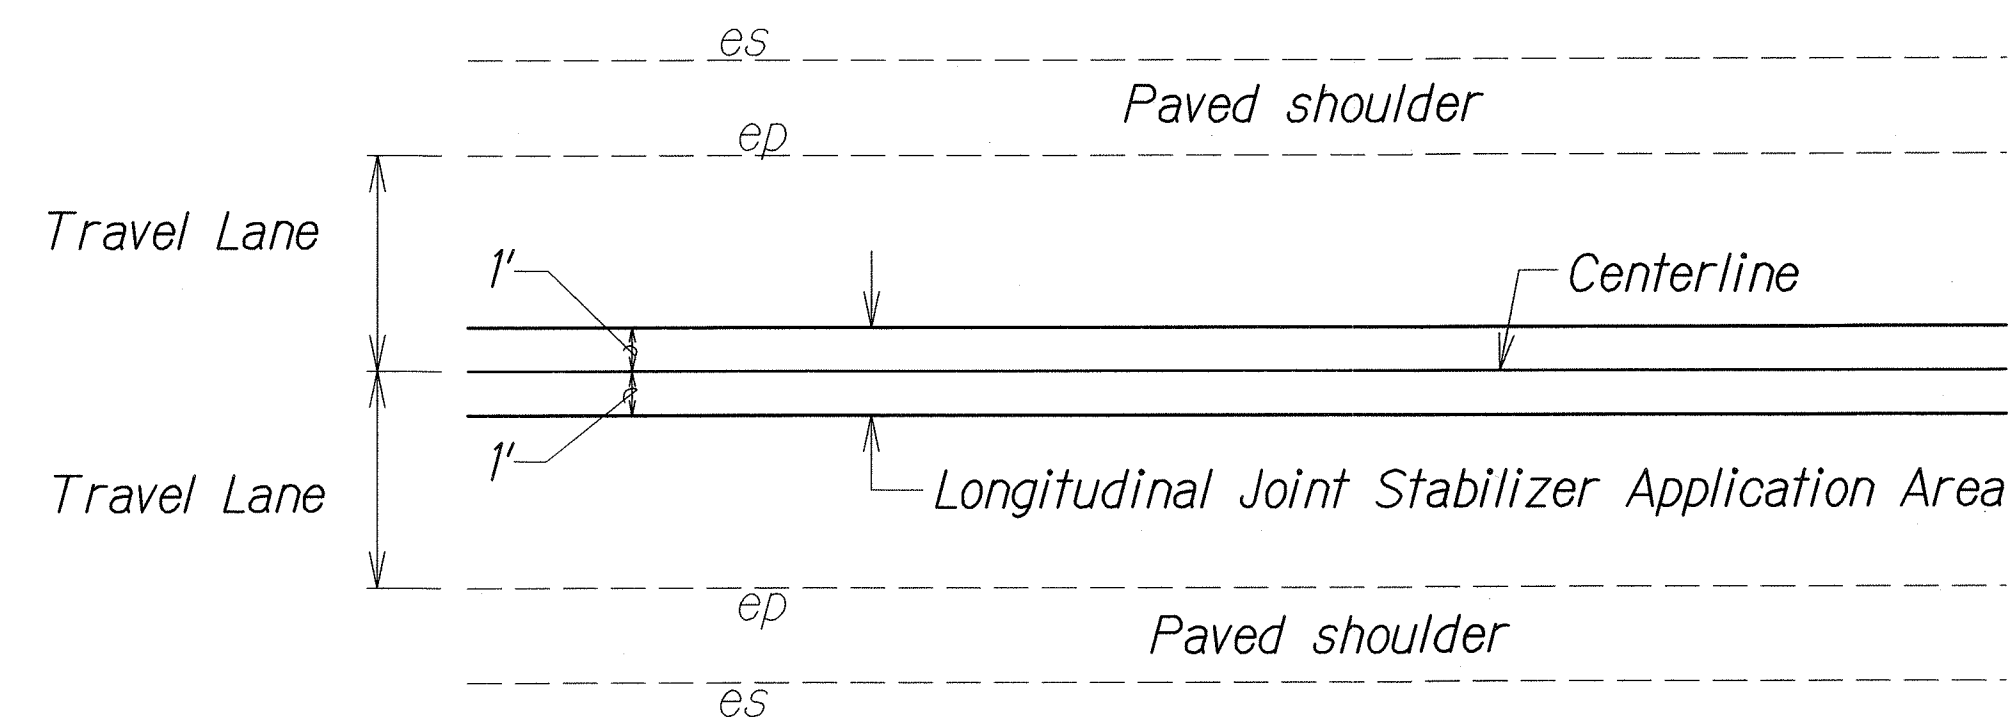

3-12-12	Add Typical Section for Longitudinal Joint Stabilizer.
DATE	REVISION

STATE OF HAWAII DEPARTMENT OF TRANSPORTATION HIGHWAYS DIVISION	
TYPICAL SECTIONS & DETAILS	
MAUNALOA HIGHWAY RESURFACING Vicinity of Keonelele Avenue to Mahana Project No. 460A-01-11MR	
Scale: As Shown	Date: August, 2010
SHEET No. 1 OF 2 SHEETS	