

INDEX TO DRAWINGS	
SHEET NO.	DESCRIPTION
1	TITLE SHEET
2	STANDARD PLANS SUMMARY
3	GENERAL NOTES AND LEGEND
4 - 5	WATER POLLUTION & EROSION CONTROL NOTES
6 - 7	TYPICAL SECTIONS AND DETAILS
8 - 12	GUARDRAIL DETAILS
13 - 18	ROADWAY PLANS
19	PAVEMENT MARKING LEGEND, DETAILS AND NOTES
20 - 22	RUMBLE STRIP DETAILS, SIGN DETAILS & NOTES
23	WORK ZONE SIGNING PLAN, NOTES & DETAILS
24 - 29	SIGNING AND PAVEMENT MARKING PLANS

STATE OF HAWAII

DEPARTMENT OF TRANSPORTATION

HIGHWAYS DIVISION

HONOLULU, HAWAII

"AS-BUILT"

PLANS FOR

MAUNALOA HIGHWAY RESURFACING




VICINITY OF KEONELELE AVENUE TO MAHANA

PROJECT NO. 460A-01-11MR

DISTRICT OF MOLOKAI

ISLAND OF MOLOKAI

FED. ROAD DIST. NO.	STATE	PROJ. NO.	FISCAL YEAR	SHEET NO.	TOTAL SHEETS
HAWAII	HAW.	460A-01-11MR	2011	1	29

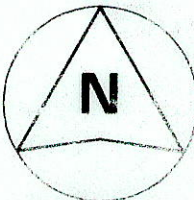
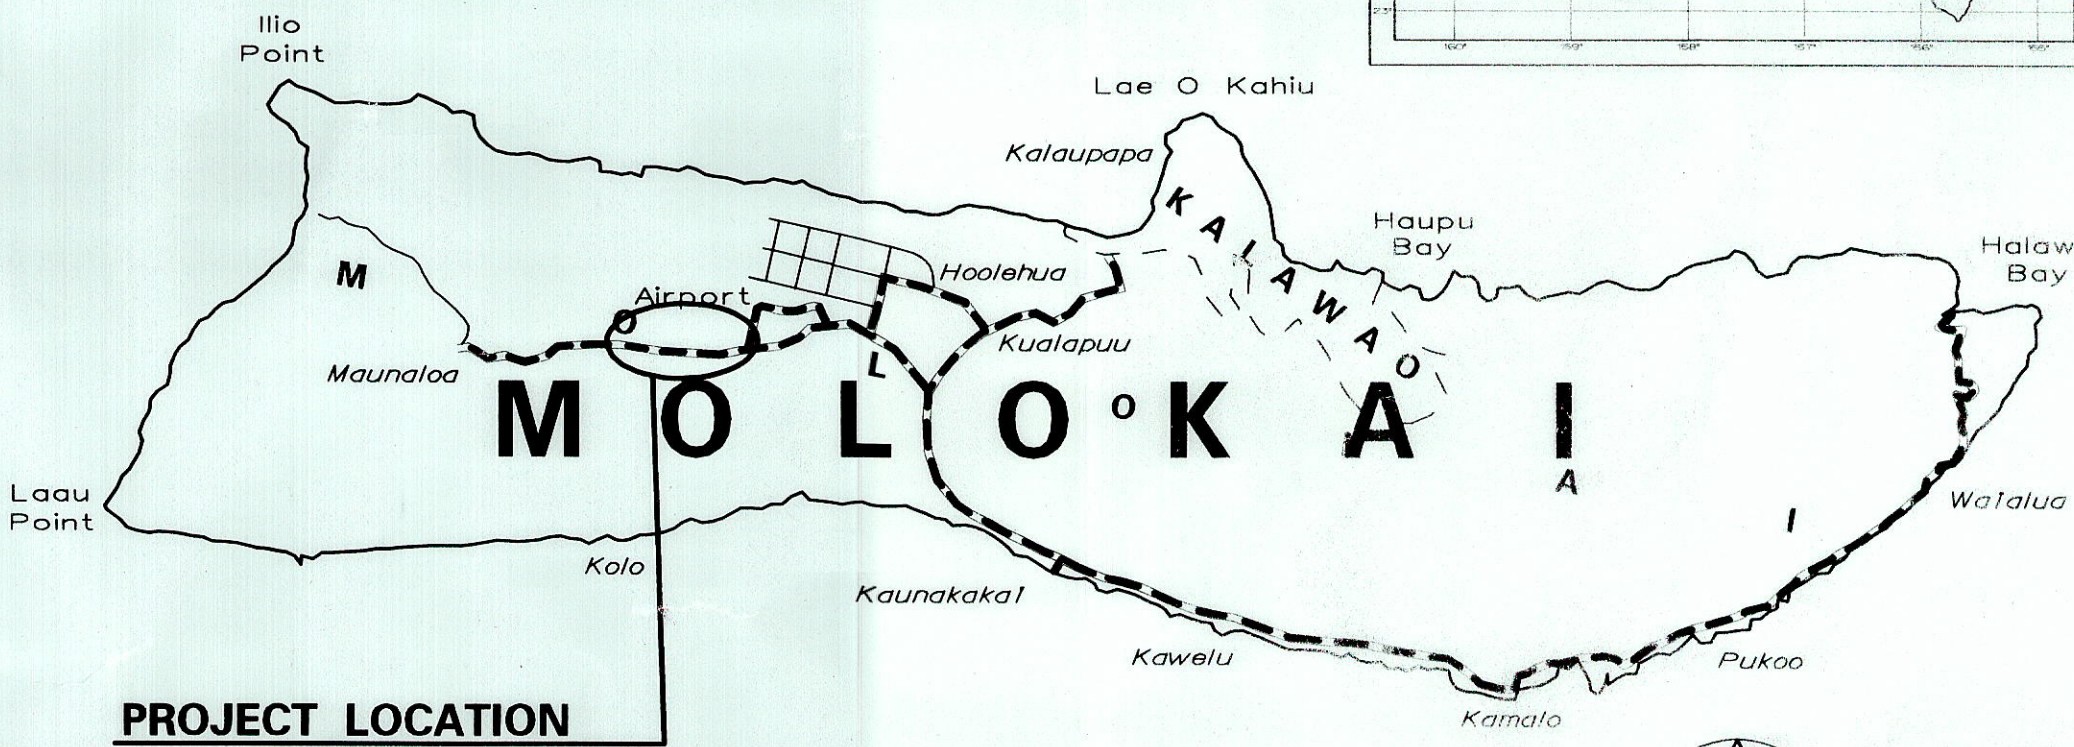
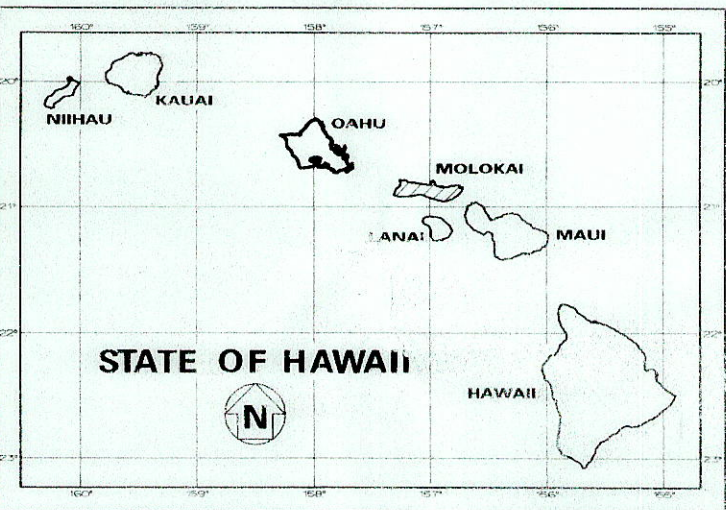


4048

SCALE IN MILES

FEDERAL AID PROJECTS PREVIOUSLY CONSTRUCTED OR UNDER CONSTRUCTION

MILE POST 9.25 TO MILE POST 11.0

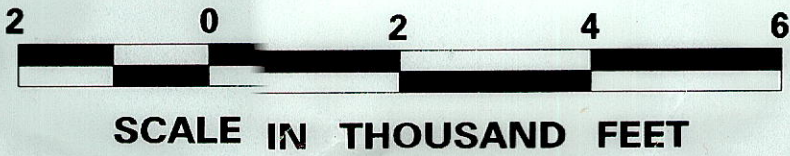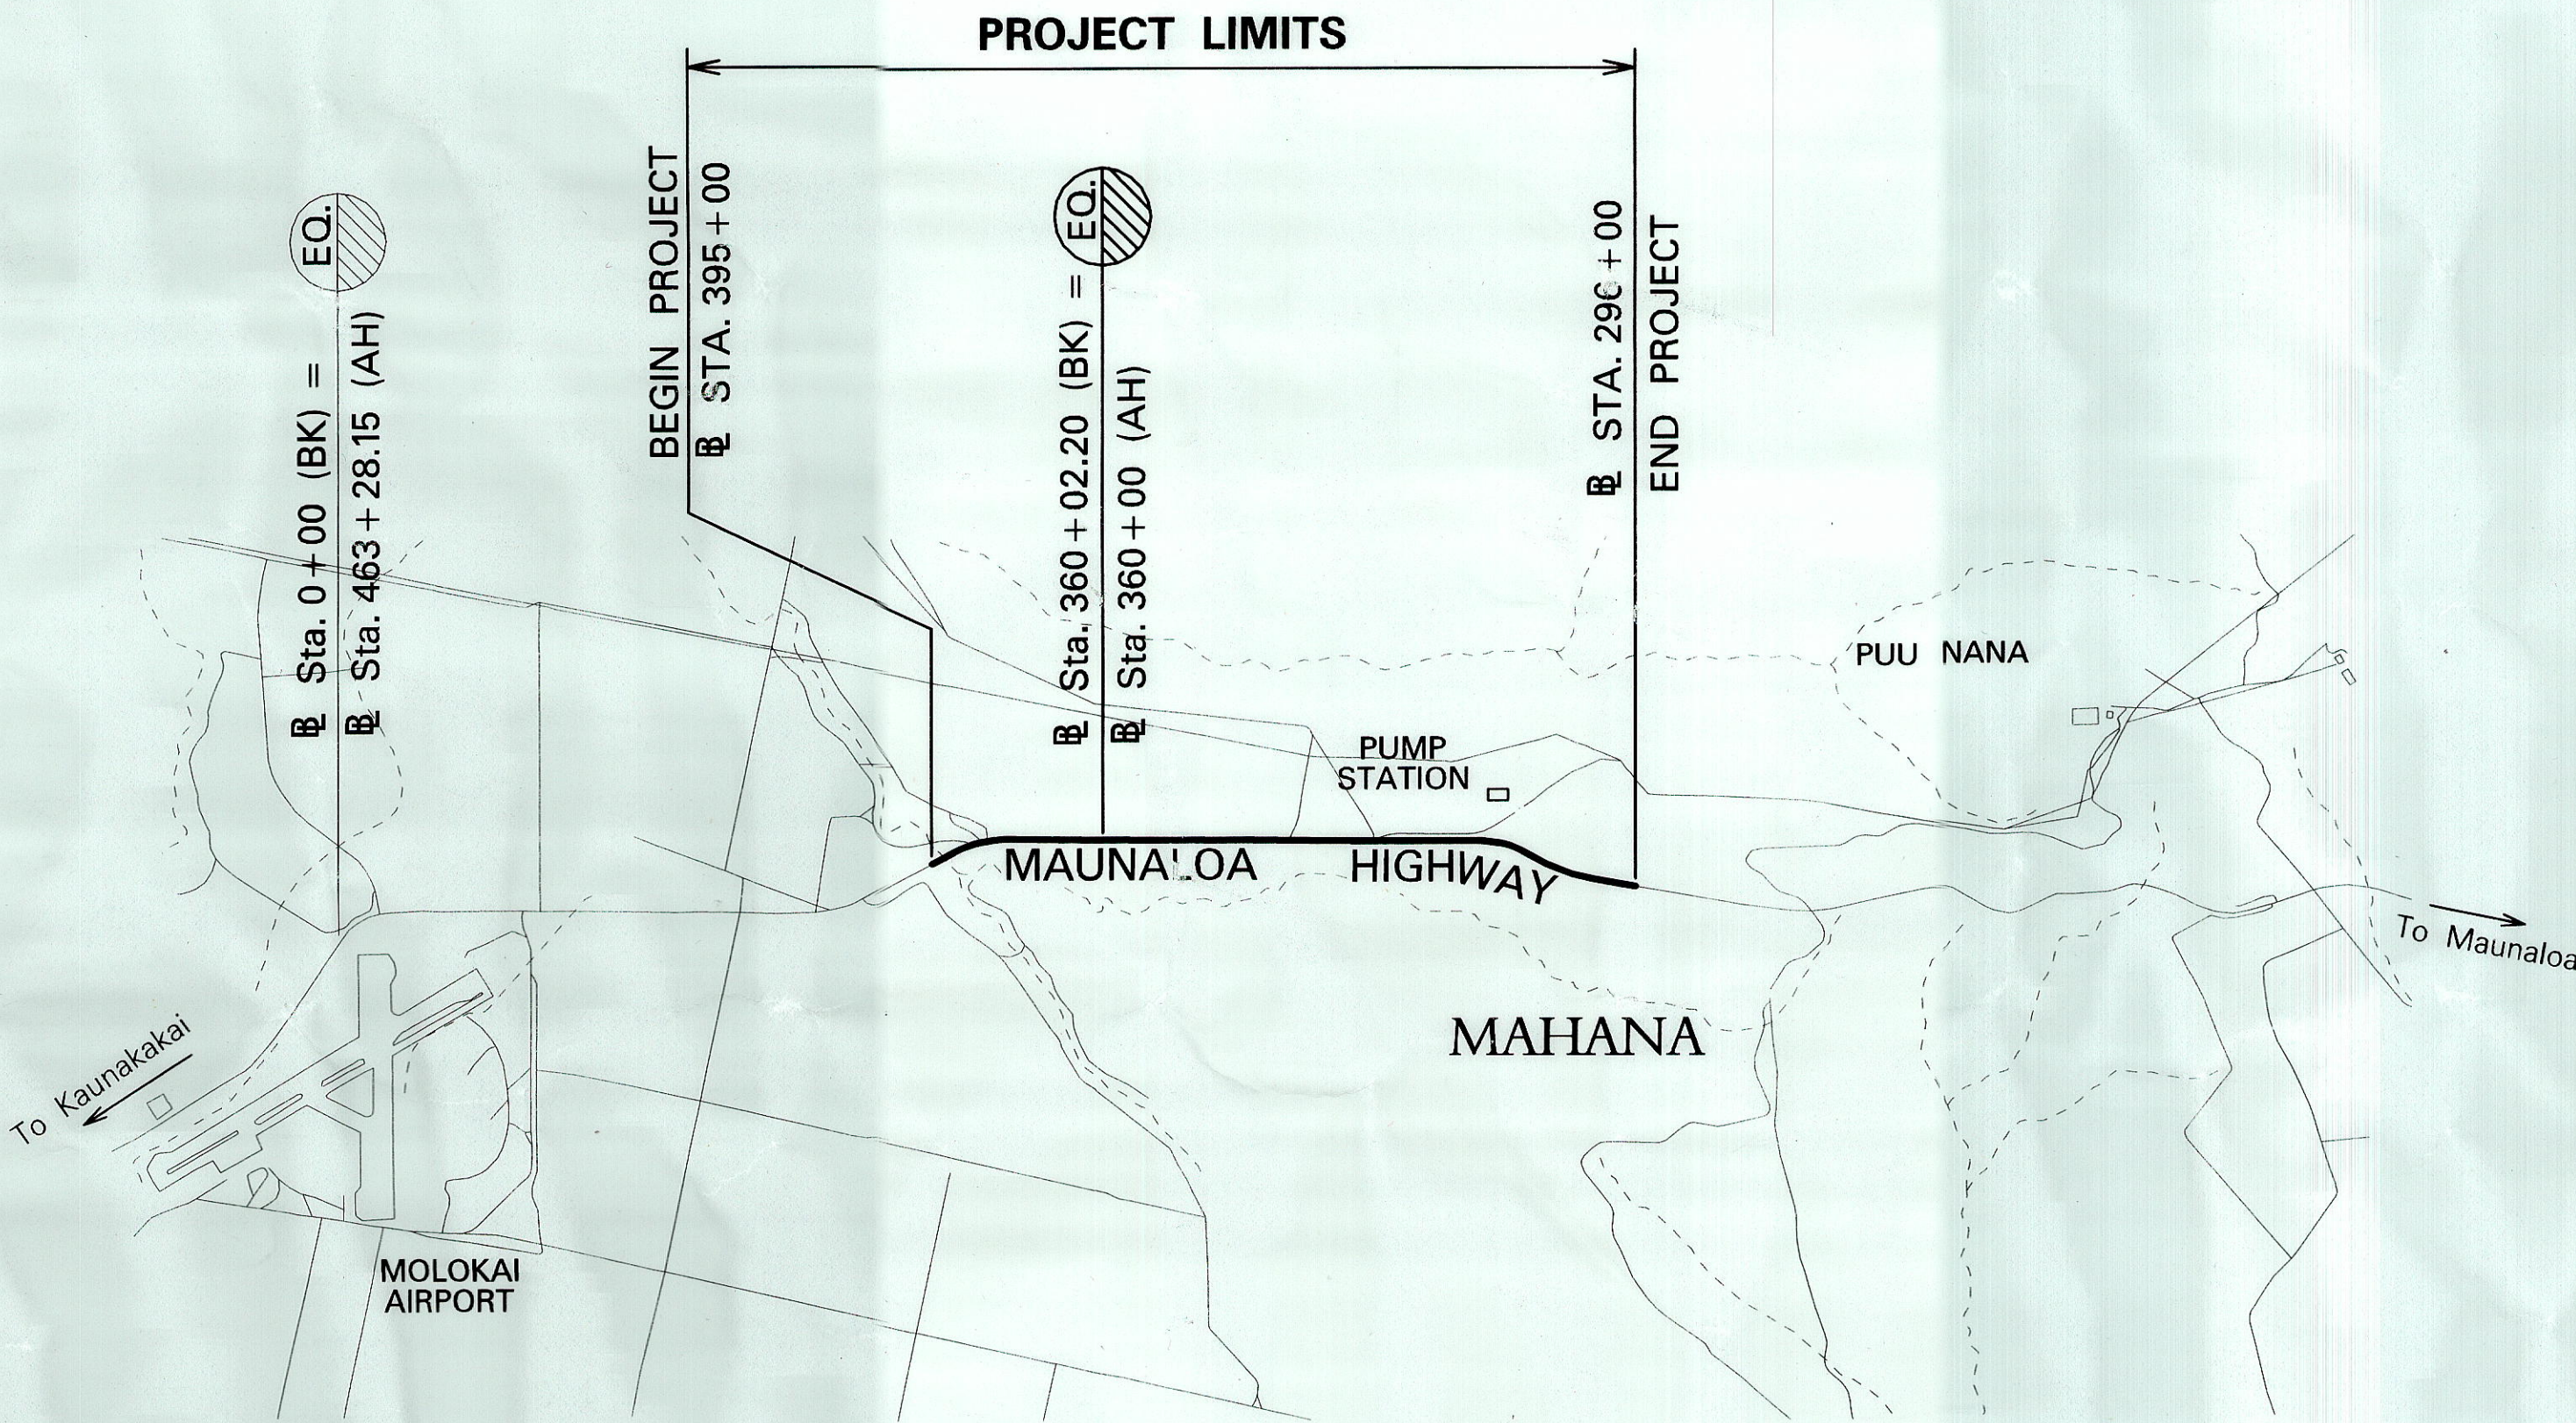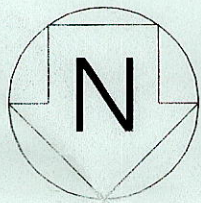

LAYOUT PLAN

GROSS LENGTH OF PROJECT.....1.75 MILES

NET LENGTH OF PROJECT.....1.75 MILES

CHANGES MADE DURING CONSTRUCTION HAVE BEEN INCORPORATED ON THESE PLANS EXCEPT CHANGES IN THE ORIGINAL THEORETICAL QUANTITIES. FOR ACTUAL QUANTITIES, REFER TO PROJECT LEDGER AND/OR COMPUTATION BOOK.

8/20/15

DATE

DEPARTMENT OF TRANSPORTATION

STATE OF HAWAII

APPROVED:

2/06/12

DATE

SEPT., 2010

DATE

873-3535

PHONE

HWY-ME

MANAGED BY

HWY-M

DESIGNED BY