

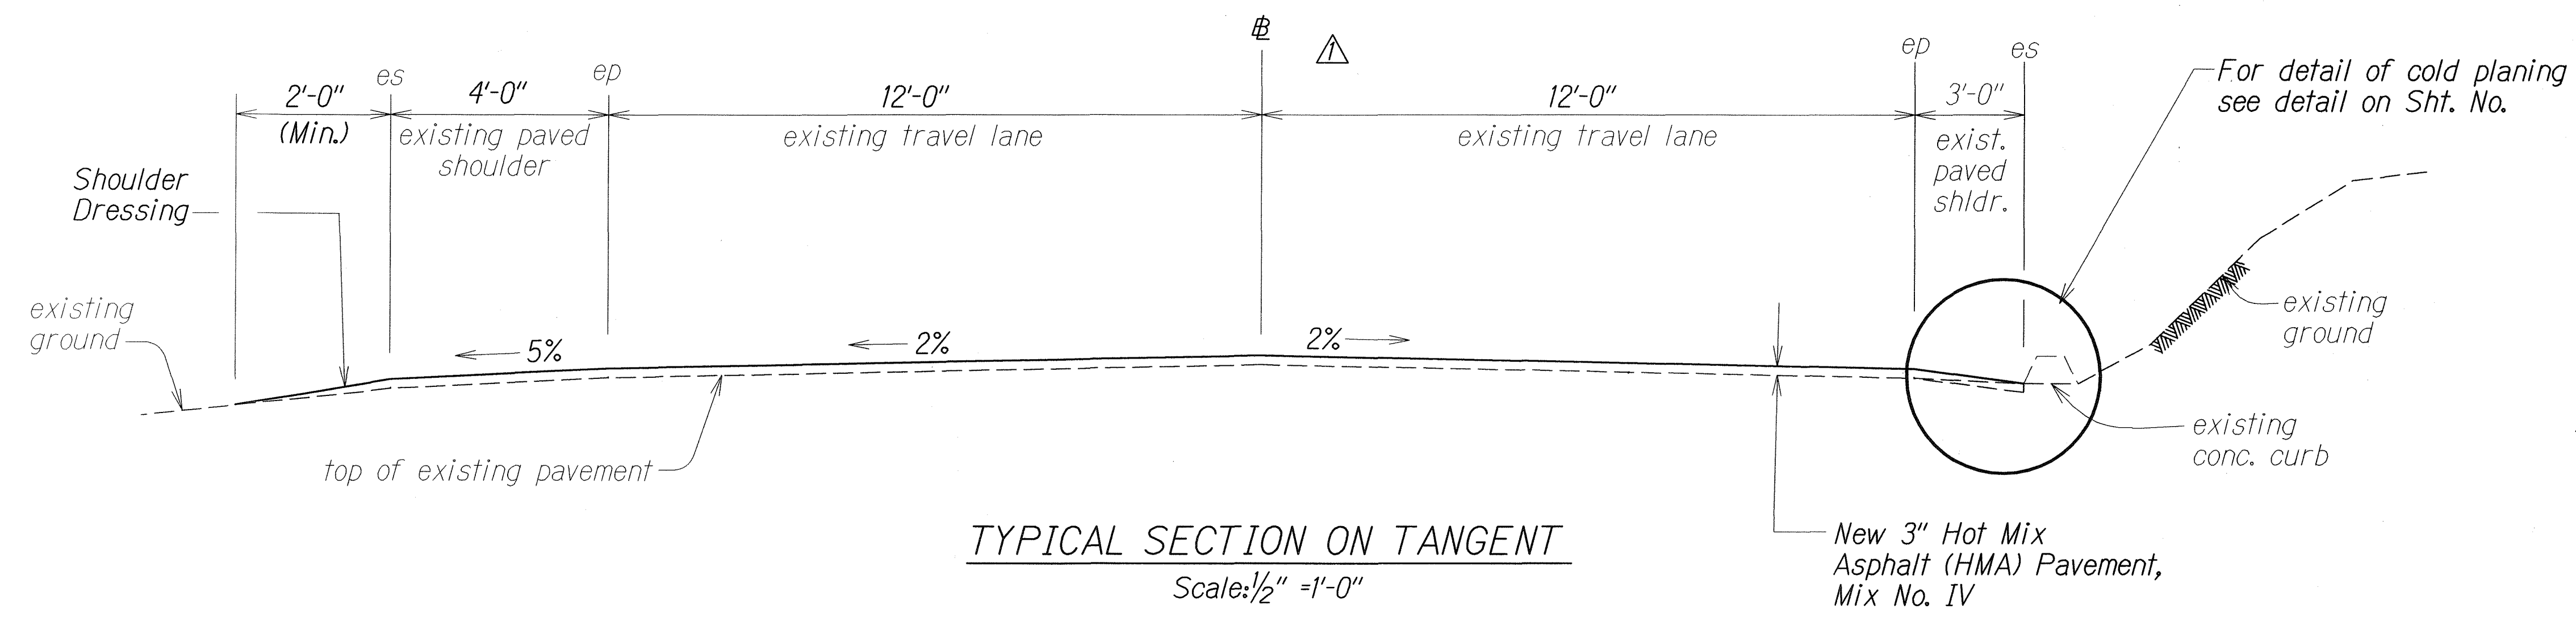



FED. ROAD DIST. NO.	STATE	FED. AID PROJ. NO.	FISCAL YEAR	SHEET NO.	TOTAL SHEETS
HAWAII	HAW.	STP-0460(016)	2013	ADD.6	40

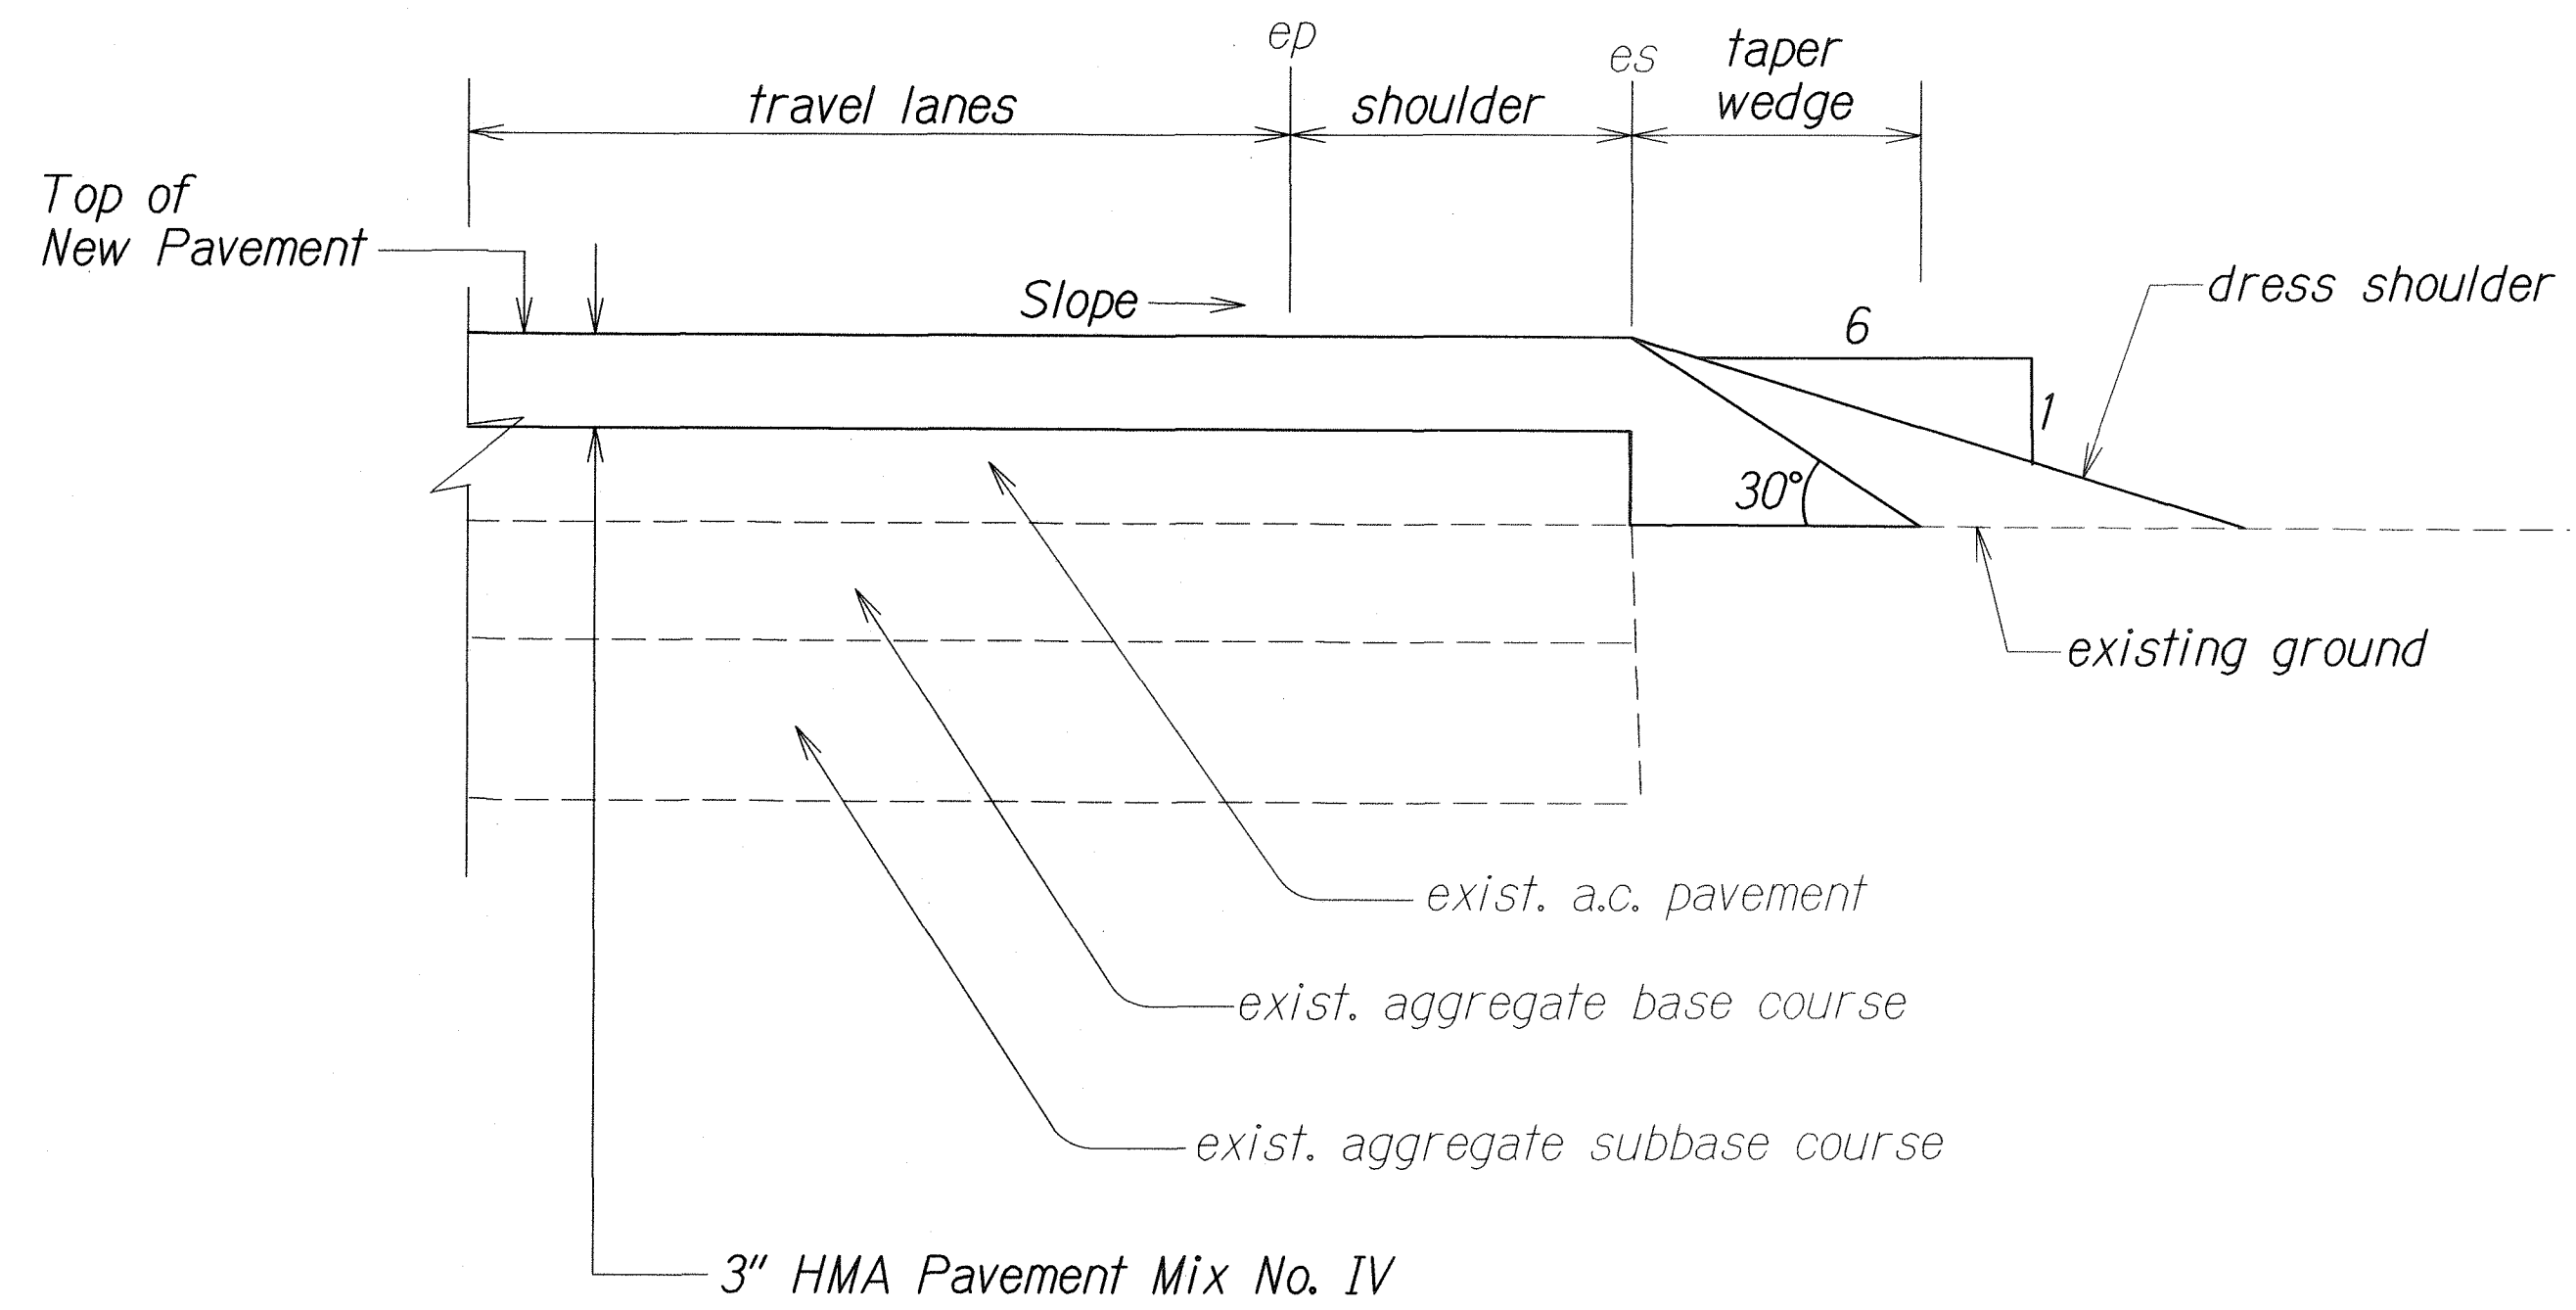

NOTE:
 *Surface area must be cleaned and grubbed of vegetation and organic matters shaped graded compacted prior to resurfacing. Payment shall be considered incidental to Hot Mix Asphalt (HMA) Pavement, Mix No. IV.
 **Prior to resurfacing clear and grub the vegetation and other materials. Payment under Item No. 401.0500 Hot Mix Asphalt (HMA) Pavement, Mix No. IV (Under and Behind Guardrail).

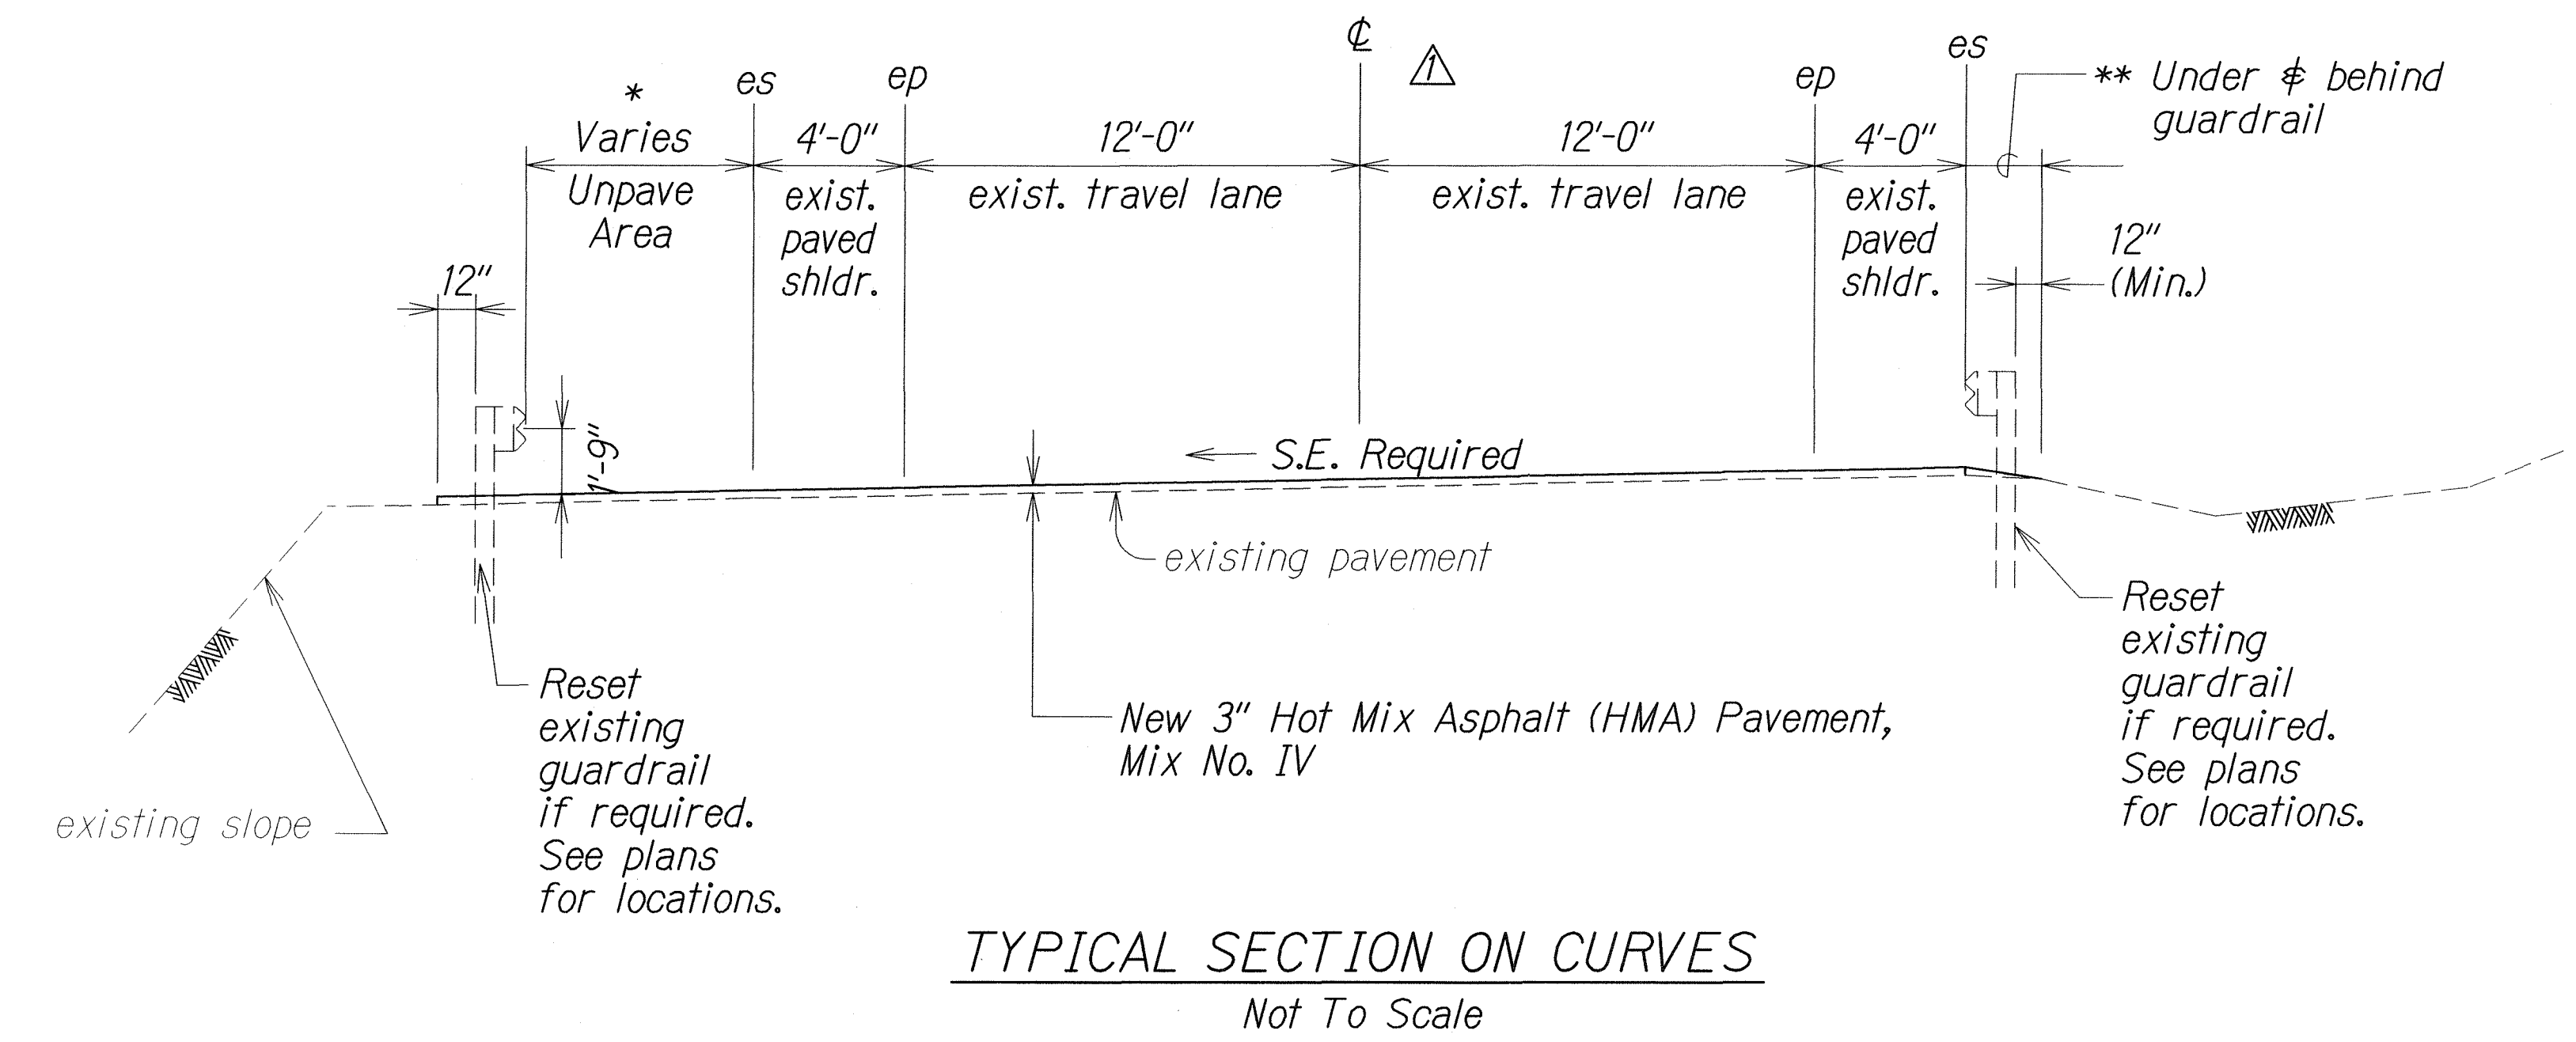

Note: Contractor shall mount a device directly on the paver screed extension to provide a 30° beveled shoulder edge.

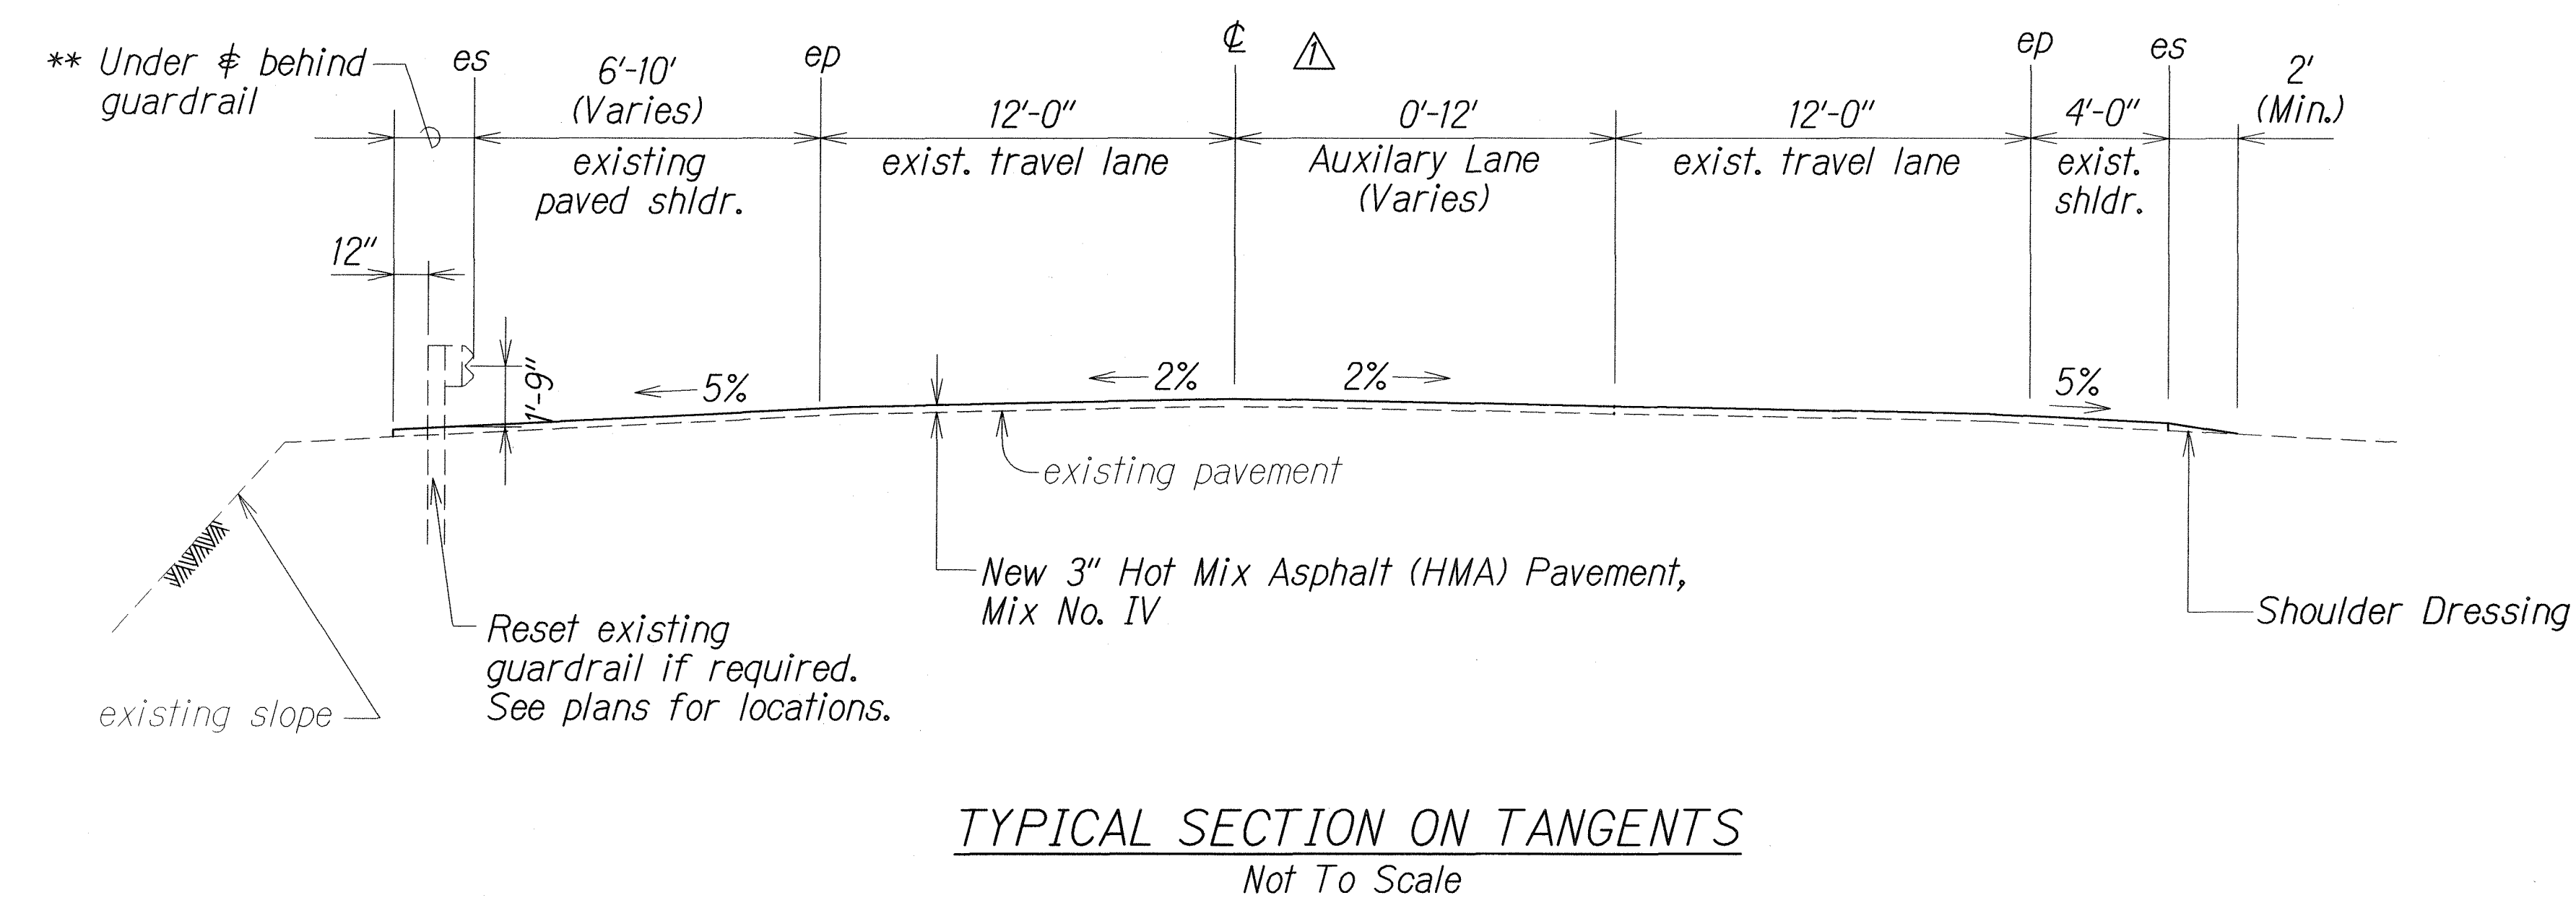

△ 2-15-13 Revise lane width.

DATE	REVISION
------	----------

STATE OF HAWAII
DEPARTMENT OF TRANSPORTATION
HIGHWAYS DIVISION

TYPICAL SECTIONS & DETAILS

MAUNALOA HIGHWAY RESURFACING
Maunaloa Village to Mahana
Federal-Aid Project No. STP-0460(016)
Scale: As Shown Date: July, 2012
SHEET No. 1 OF 2 SHEETS