
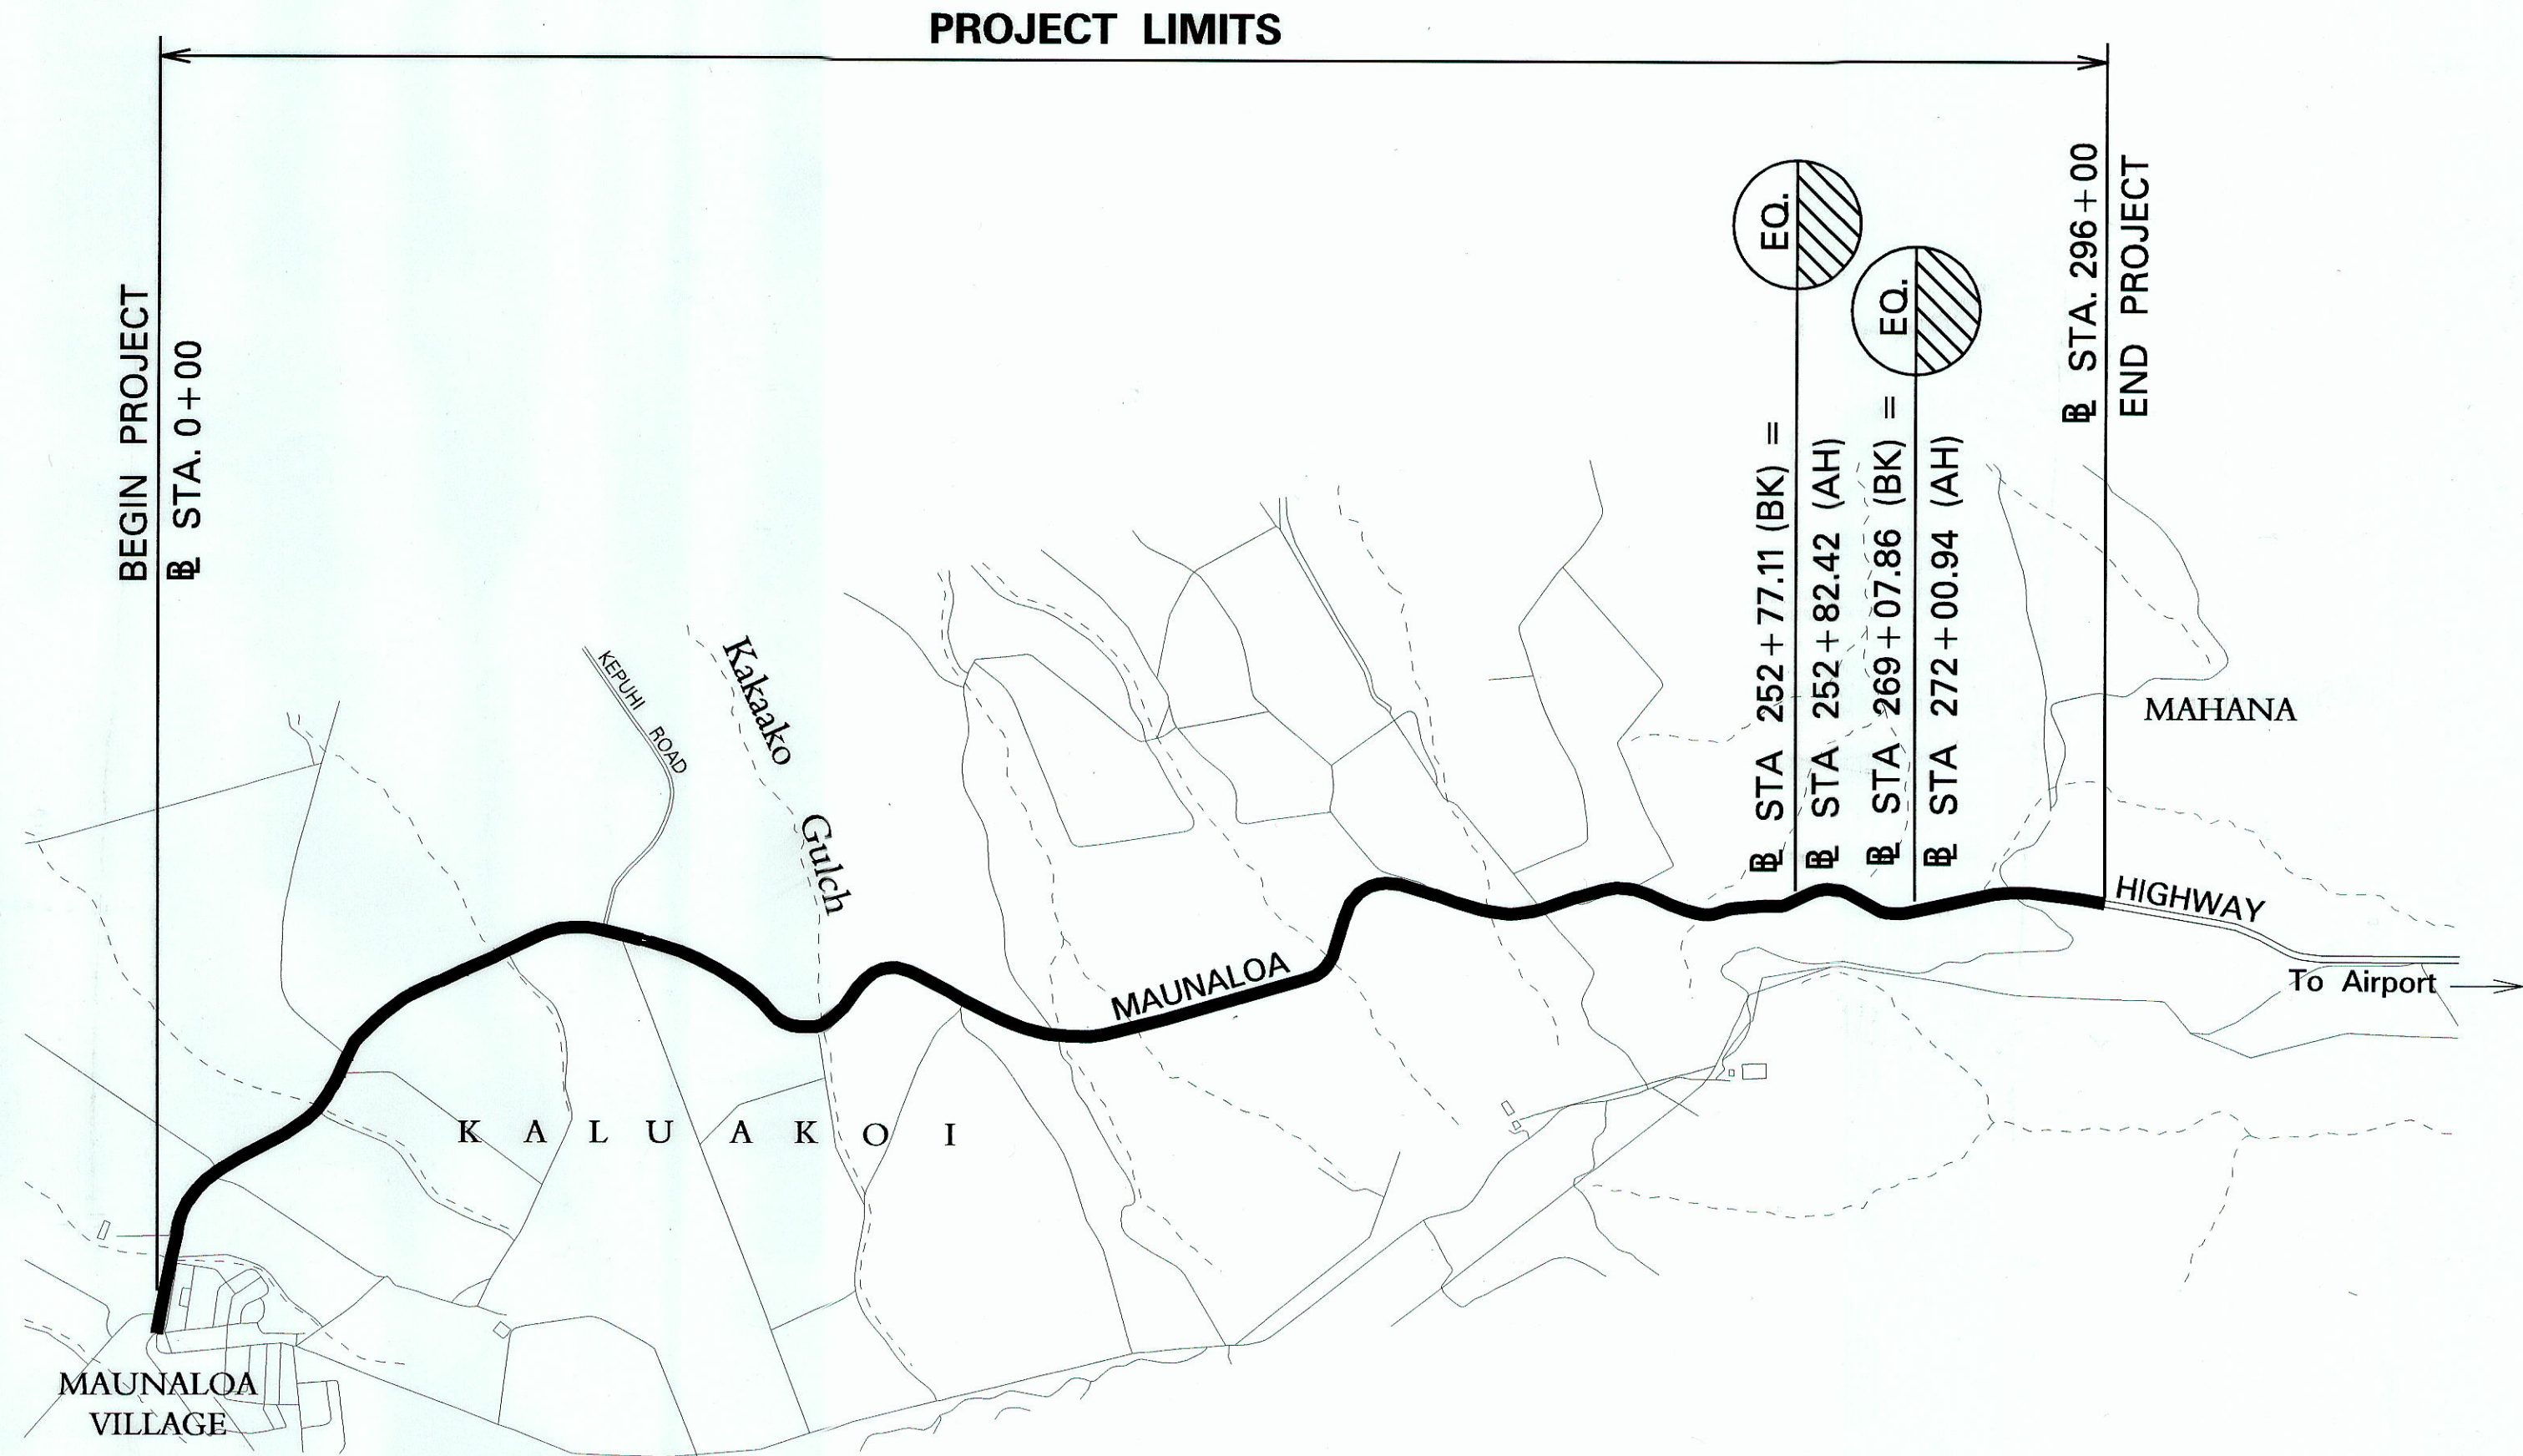
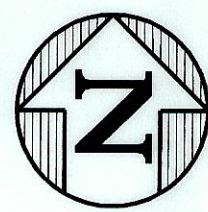
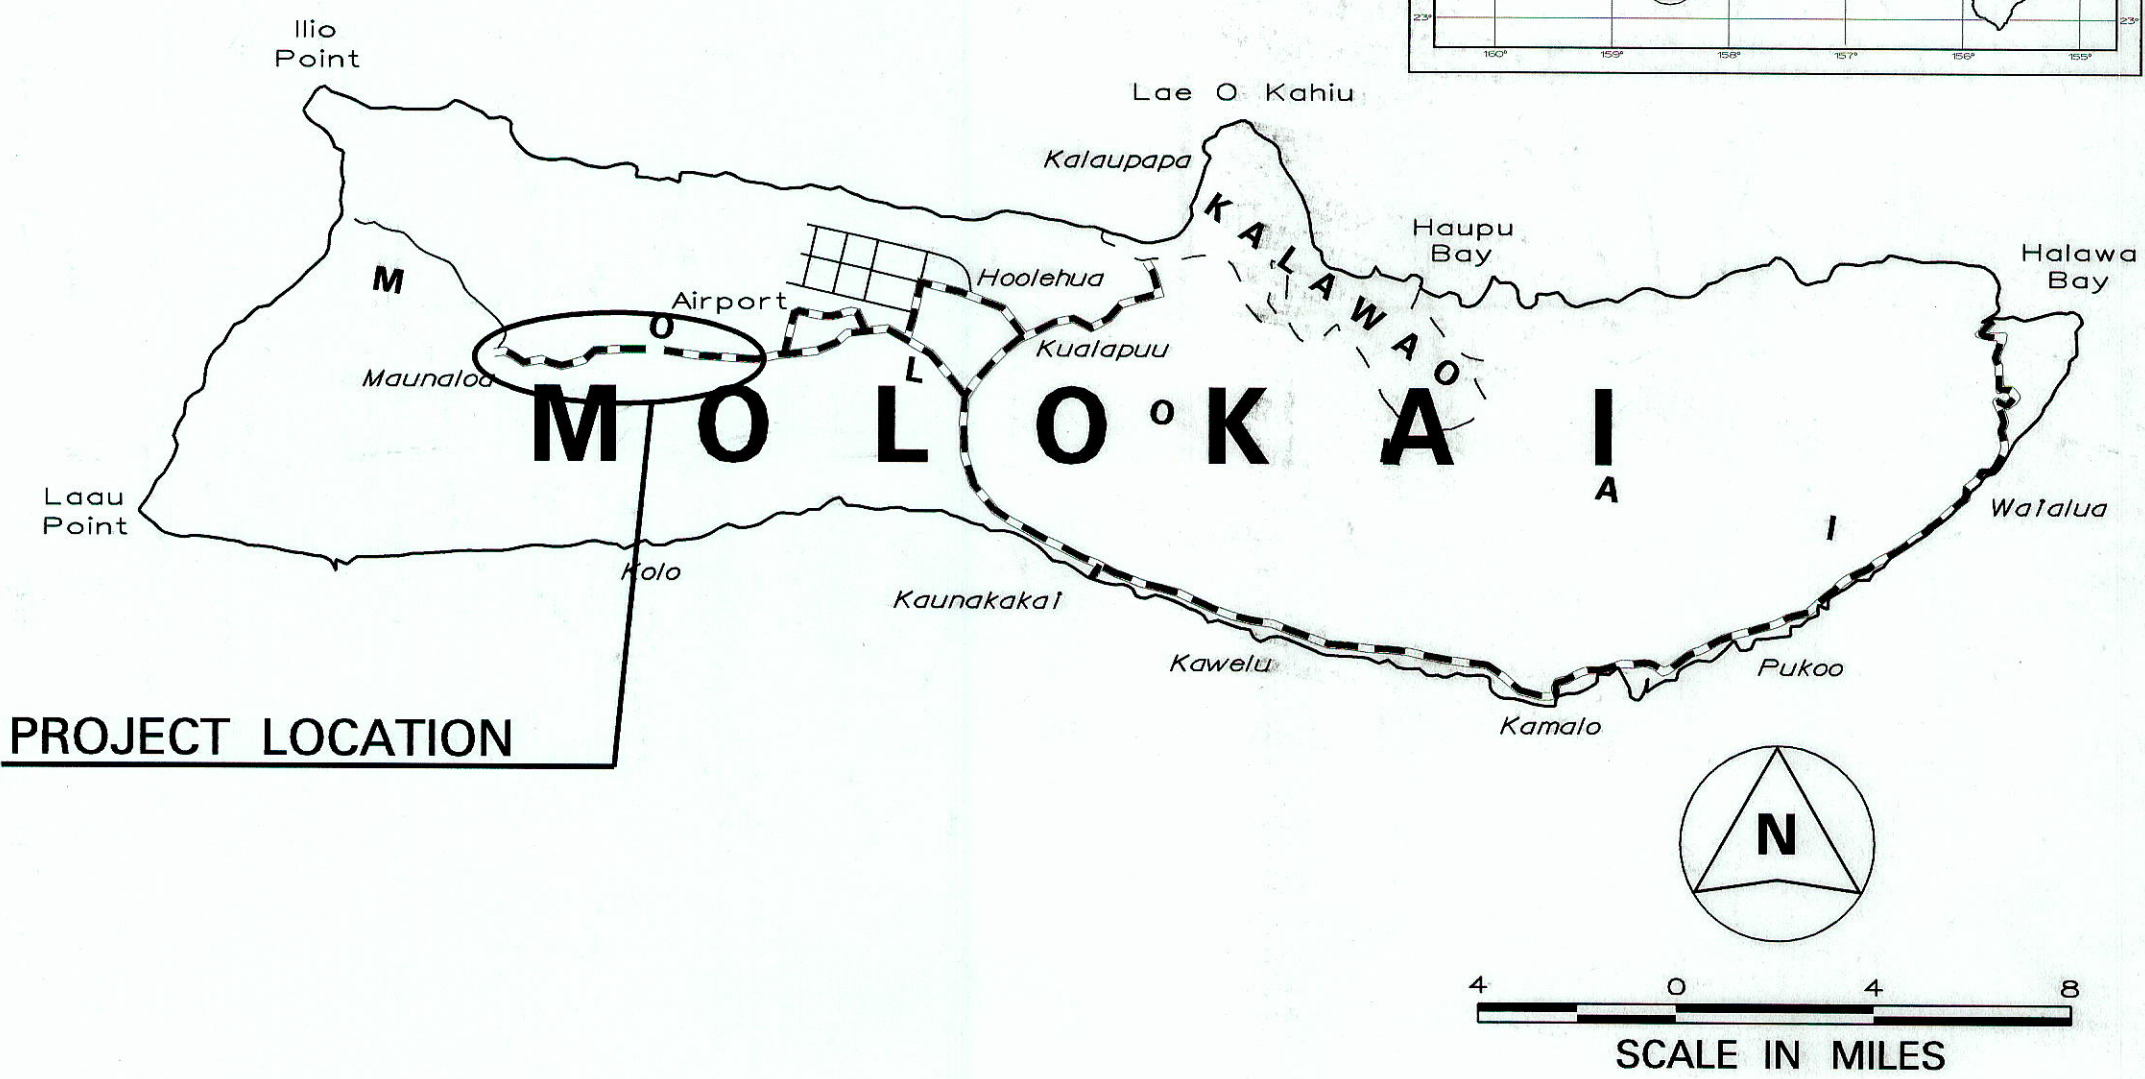


INDEX TO DRAWINGS	
SHEET NO.	DESCRIPTION
1	TITLE SHEET
2	STANDARD PLANS SUMMARY
3	GENERAL NOTES AND LEGEND
4 - 5	WATER POLLUTION & EROSION CONTROL NOTES
6 - 7	TYPICAL SECTIONS & DETAILS
8 - 21	ROADWAY PLANS
22	PAVEMENT MARKING LEGEND, DETAILS AND NOTES
23 - 25	RUMBLE STRIP DETAILS & NOTES
26	WORK ZONE SIGNING PLAN, NOTES & DETAILS
27 - 40	SIGNING AND PAVEMENT MARKING PLANS

STATE OF HAWAII
DEPARTMENT OF TRANSPORTATION
HIGHWAYS DIVISION
HONOLULU, HAWAII
"AS-BUILT"
PLANS FOR
MAUNALOA HIGHWAY RESURFACING
MAUNALOA VILLAGE TO MAHANA
FEDERAL-AID PROJECT NO. STP-0460(016)
DISTRICT OF MOLOKAI
ISLAND OF MOLOKAI

FED. ROAD DIST. NO.	STATE	FED. AID PROJ. NO.	FISCAL YEAR	SHEET NO.	TOTAL SHEETS
HAWAII	HAW.	STP-0460(016)	2013	1	40

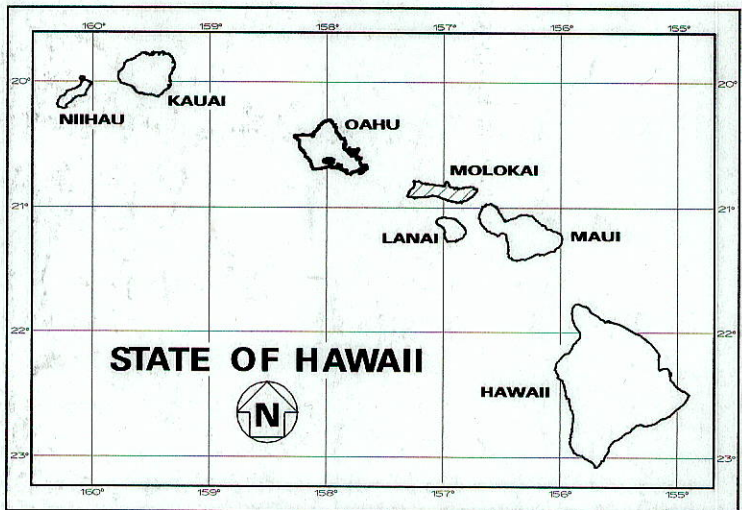

--- FEDERAL AID PROJECTS PREVIOUSLY CONSTRUCTED OR UNDER CONSTRUCTION

MILE POST 16.56 TO MILE POST 11.00

DESIGN DESIGNATION MAUNALOA HIGHWAY		
TRAFFIC DATA	MAHANA TO KALUA KOI ROAD (11.00 M.P. TO 14.94 M.P.)	KALUA KOI ROAD TO MAUNALOA CAMP BOUNDARY (14.94 M.P. TO 16.56 M.P.)
ADT (2011)	1,500	1,400
ADT (2021)	1,700	1,600
DHV	170	160
DESIGN K	10.0	10.0
DESIGN D	60/40	55/45
DESIGN T	3.0	3.0
T24	3.5	3.0

LAYOUT PLAN

GROSS LENGTH OF PROJECT.....5.56 MILES
NET LENGTH OF PROJECT.....5.56 MILES

CHANGES MADE DURING CONSTRUCTION HAVE BEEN INCORPORATED ON THESE PLANS EXCEPT CHANGES IN THE ORIGINAL THEORETICAL QUANTITIES. FOR ACTUAL QUANTITIES, REFER TO PROJECT LEDGER AND/OR COMPUTATION BOOK.
[Signature] 8/25/15
RESIDENT ENGINEER DATE

DEPARTMENT OF TRANSPORTATION
STATE OF HAWAII
APPROVED:
[Signature] 8/27/12
for DIR. OF TRANSPORTATION DATE

HWY-M DESIGNED BY
HWY-ME MANAGED BY
873-3535 PHONE
JULY, 2012 DATE