


FED. ROAD DIST. NO.	STATE	FED. AID PROJ. NO.	FISCAL YEAR	SHEET NO.	TOTAL SHEETS
HAWAII	HAWAII	W.P.H. 19-B	1936	8	12

FINAL SURVEY
DATE: 10/18/35
BY: D.K.
CHECKED: W.P.H.
NO. 7/30

ORIGINAL SURVEY
DATE: 10/18/35
BY: D.K.
CHECKED: W.P.H.
NO. 7/30

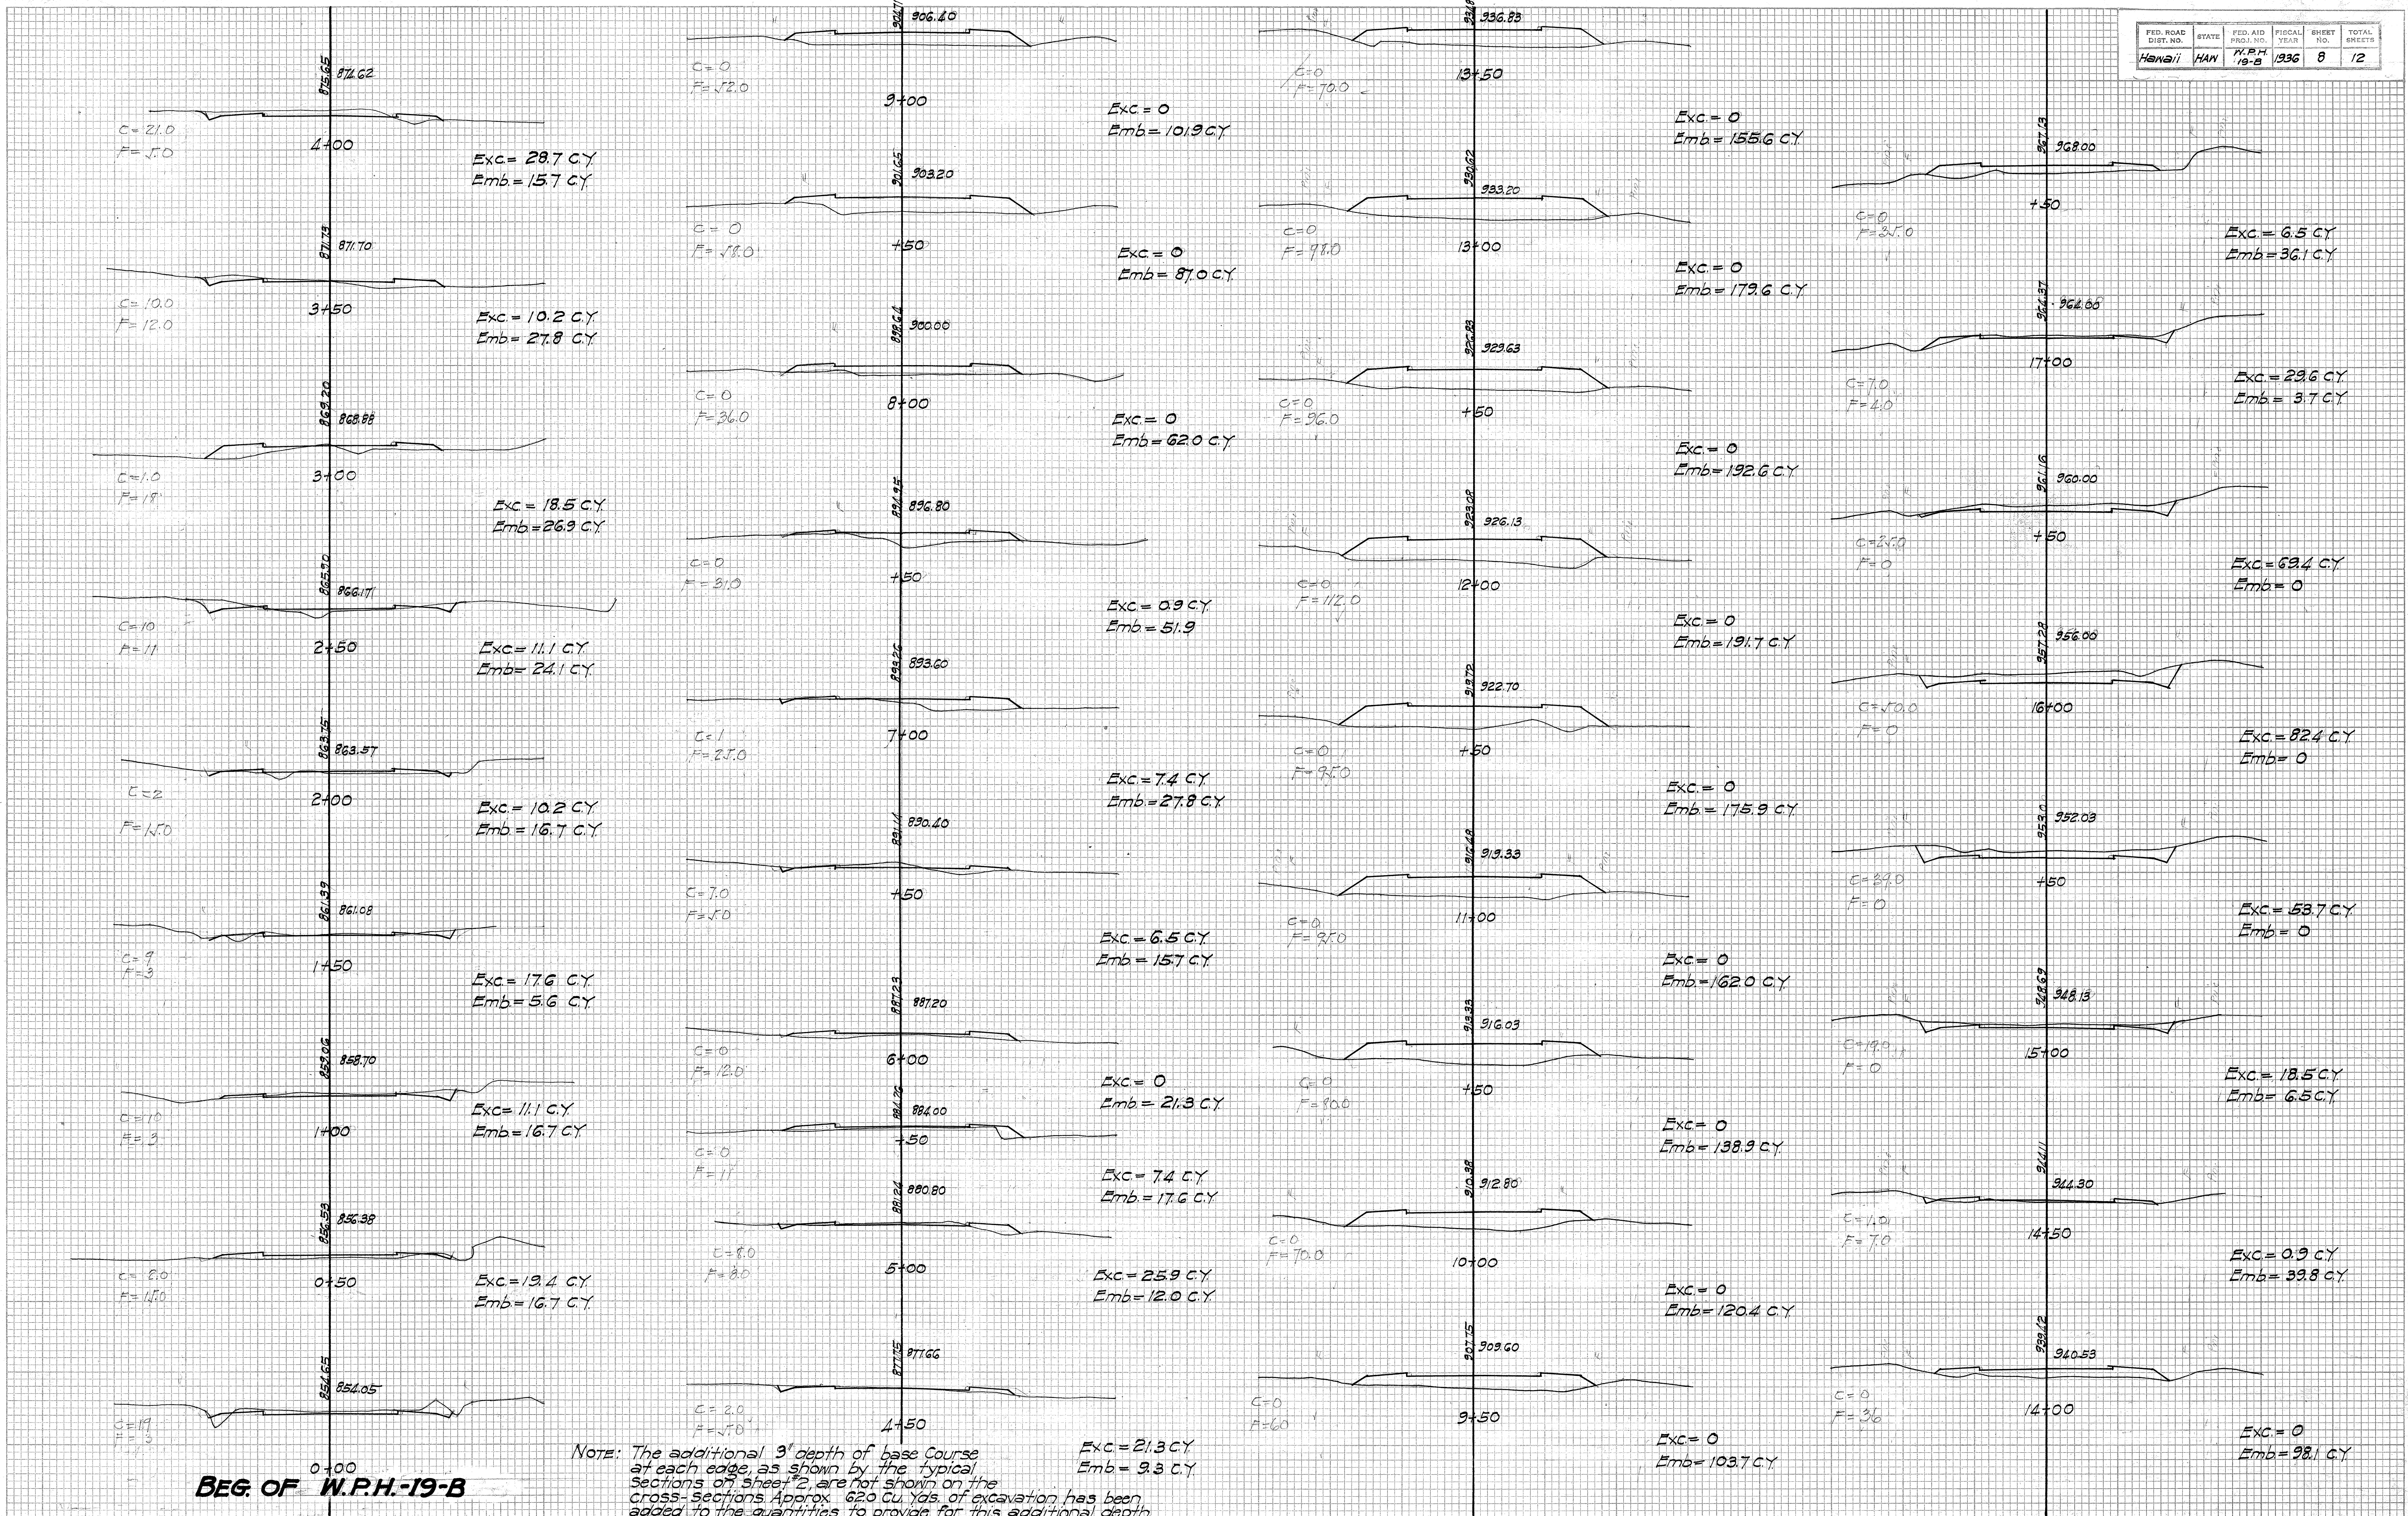


BEG. OF W.P.H.-19-B


NOTE: The additional 3" depth of base course at each edge, as shown by the typical sections on sheet 12, are not shown on the cross-sections. Approx. 620 Cu. Yds. of excavation has been added to the quantities to provide for this additional depth.

PLATE 3-CROSS SECTION C.F.R.R.E. STANDARD
SCUFFEL & ESSER CO., NEW YORK


4378.8

FED. ROAD DIST. NO.	STATE	FED. AID PROJ. NO.	FISCAL YEAR	SHEET NO.	TOTAL SHEETS
Hawaii	HAW.	W.P.H. 19-8	1936	9	12

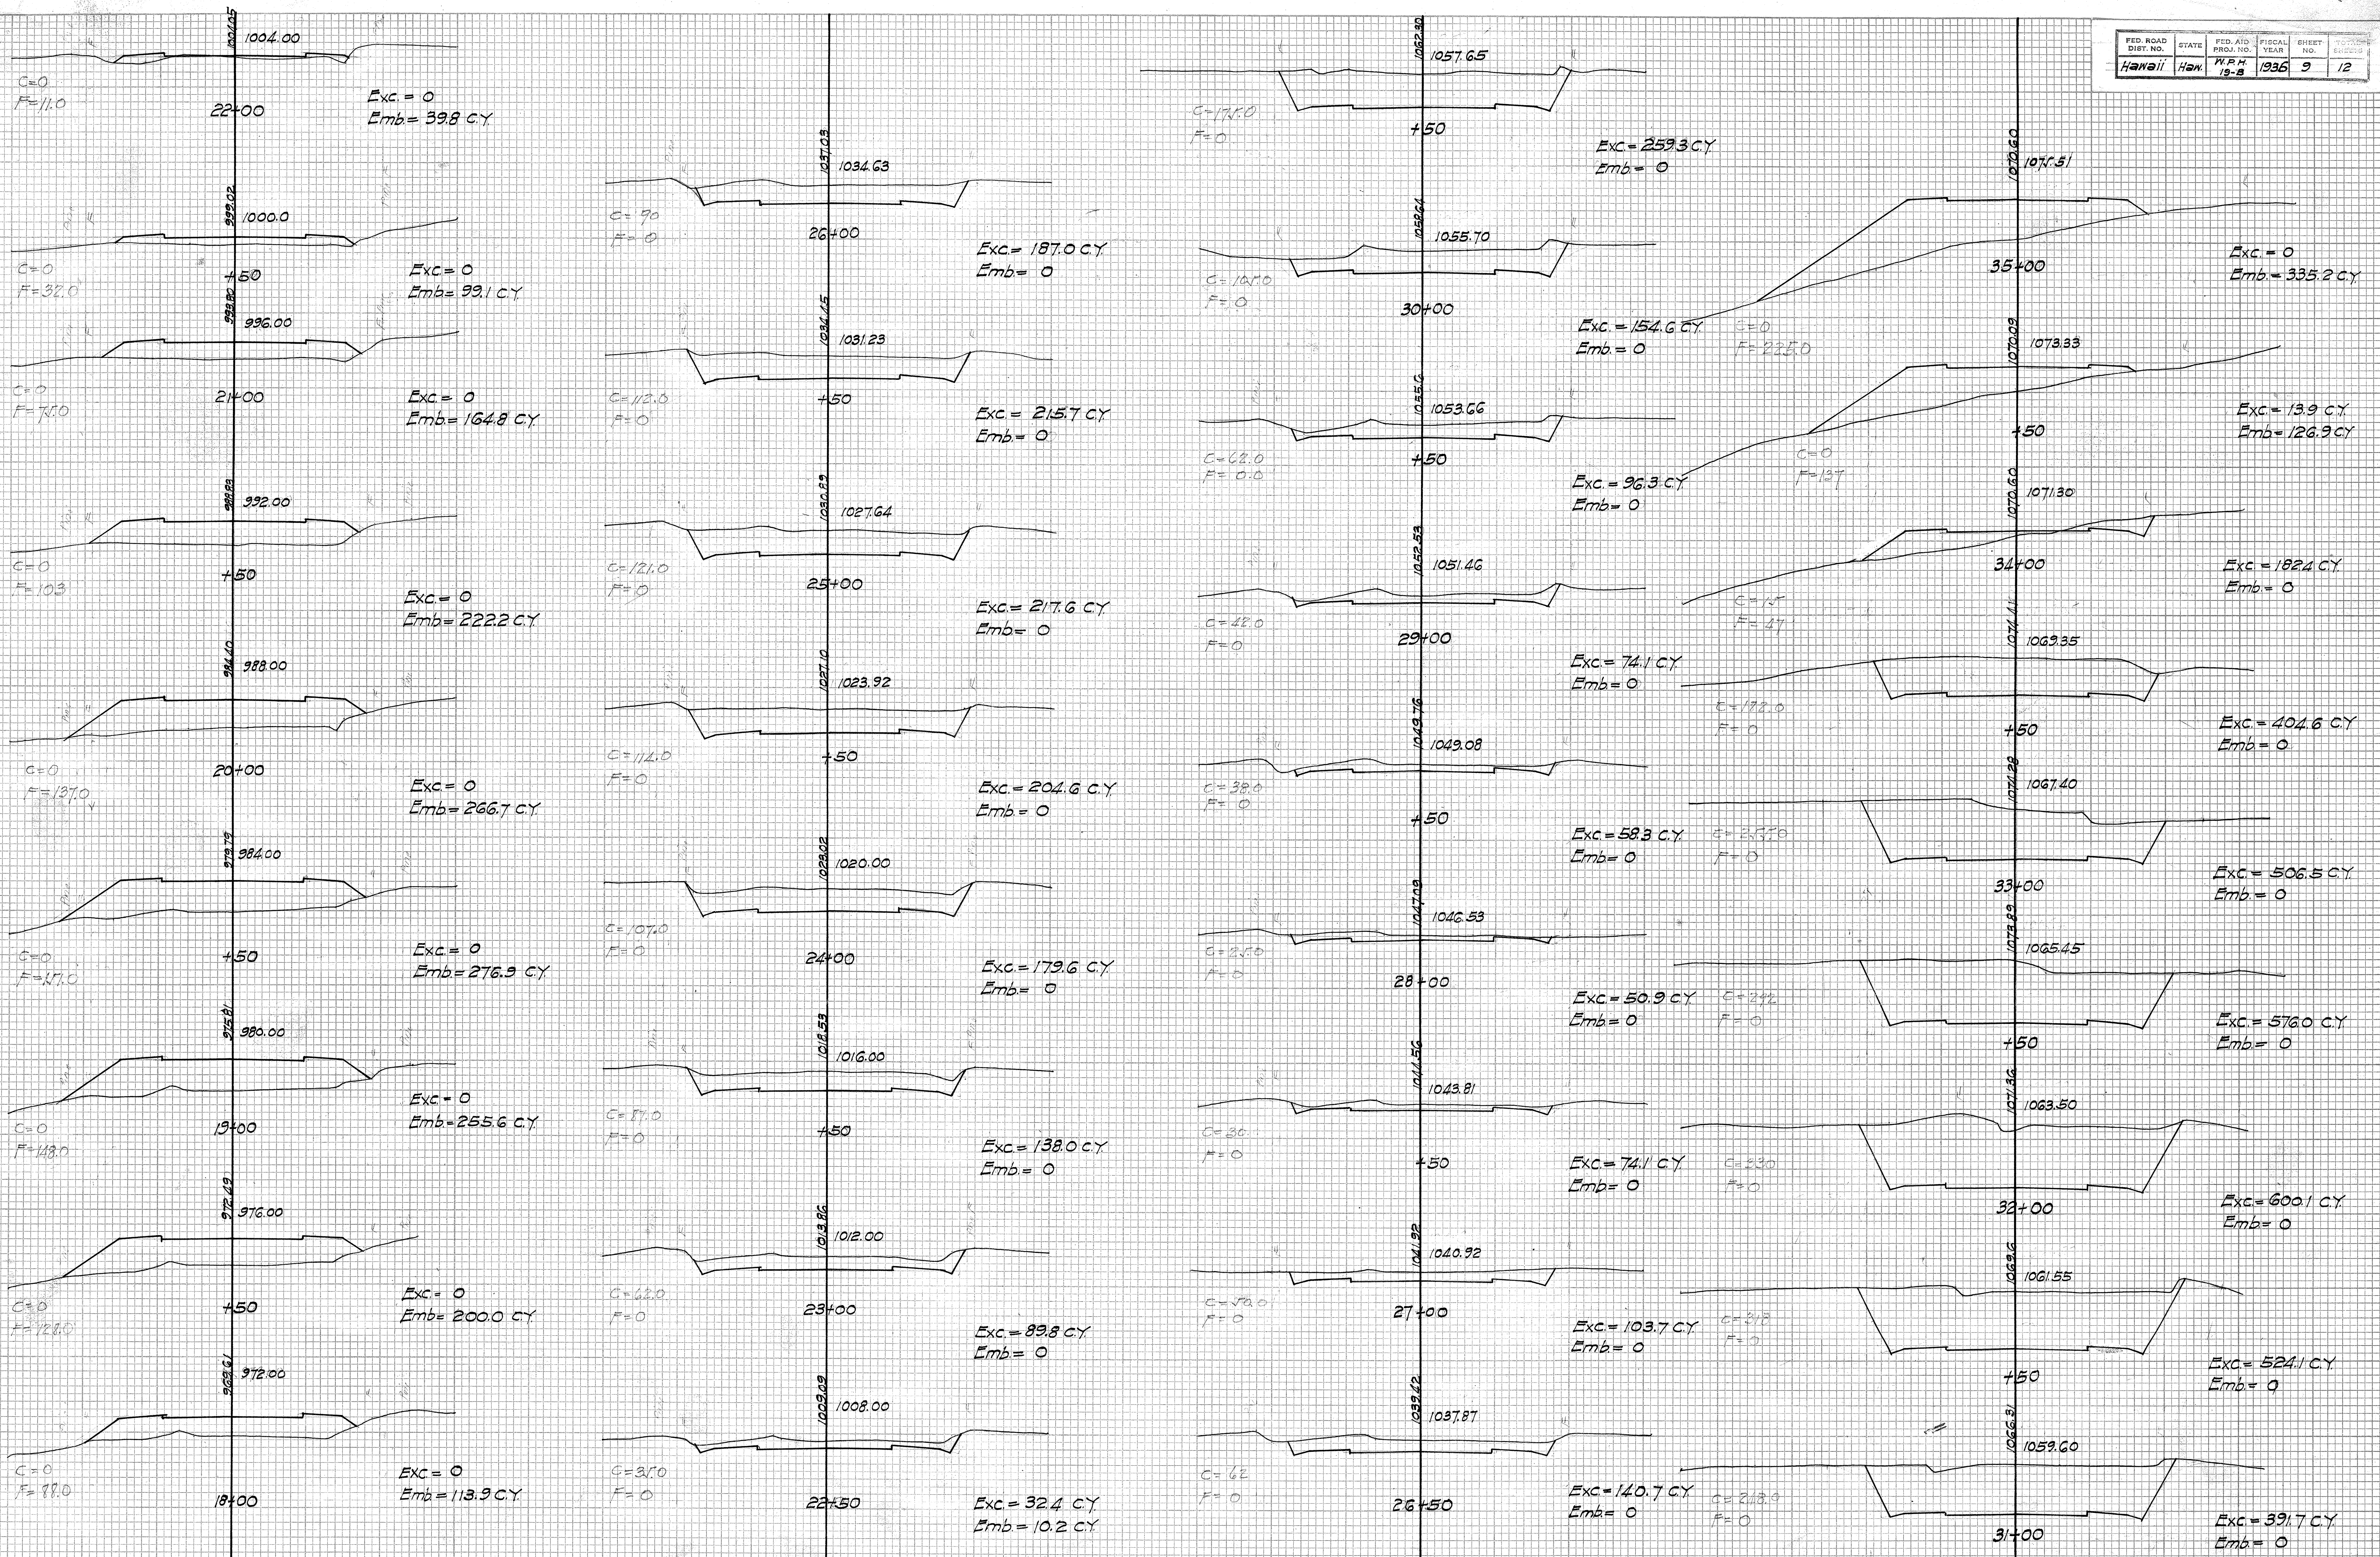

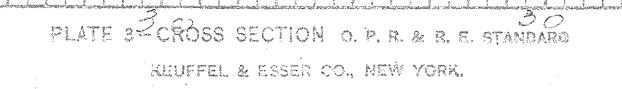

ORIGINAL	SURVEYED	BY	DATE
SURVEY	PLOTTED	B.K. & D.K.	10/18/85
NOTE BOOK	TEMPLE...	B.K. & D.K.	10/29/85
NO.	AREAS	New Vennatta	7/85
	AREAS CHECKED	"	"

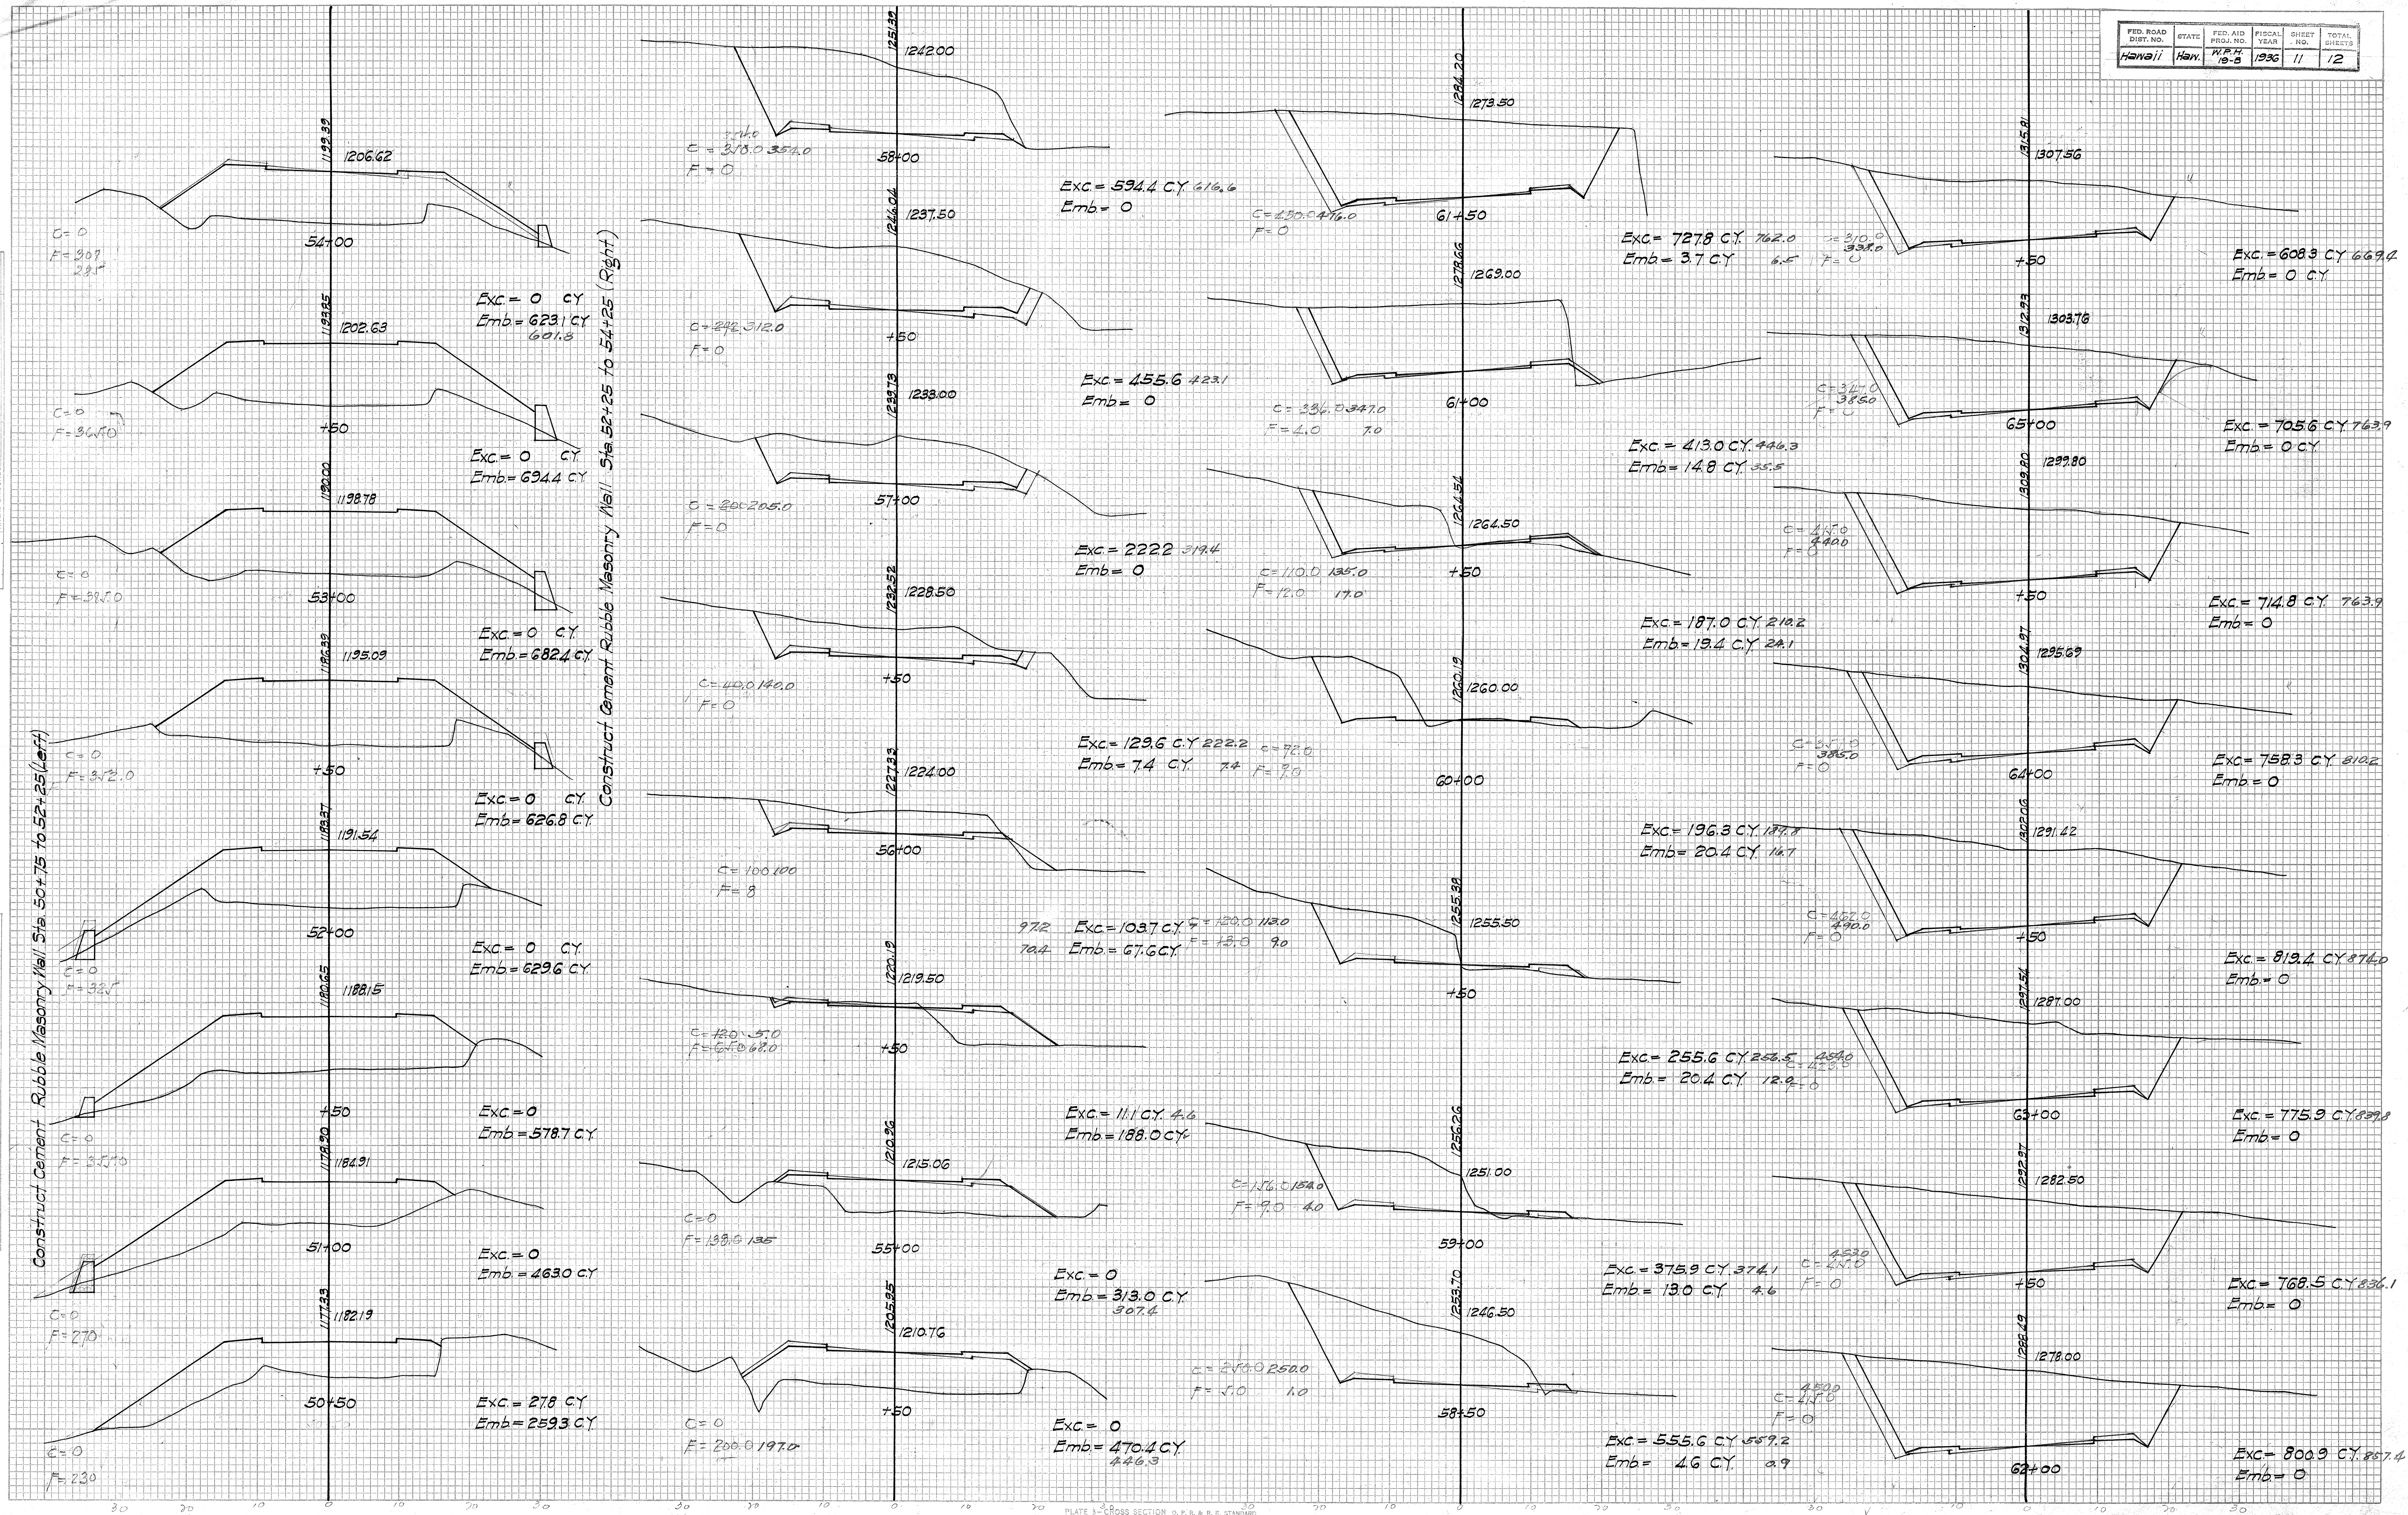

FED. ROAD DIST. NO.	STATE	FED. AID PROJ. NO.	FISCAL YEAR	SHEET NO.	TOTAL SHEETS
HAWAII	HAW.	W.F.H. 19-B	1936	12	12

DATE 10/25/35
BY B.S.D.K.
PLOTTED BY B.S.D.K.
NOTE BOOK NO. 110
AREAS CHECKED

DATE 10/25/35
BY B.S.D.K.
PLOTTED BY B.S.D.K.
NOTE BOOK NO. 110
AREAS CHECKED

