



B.K. DK 12/35

B.K. DK 12/35

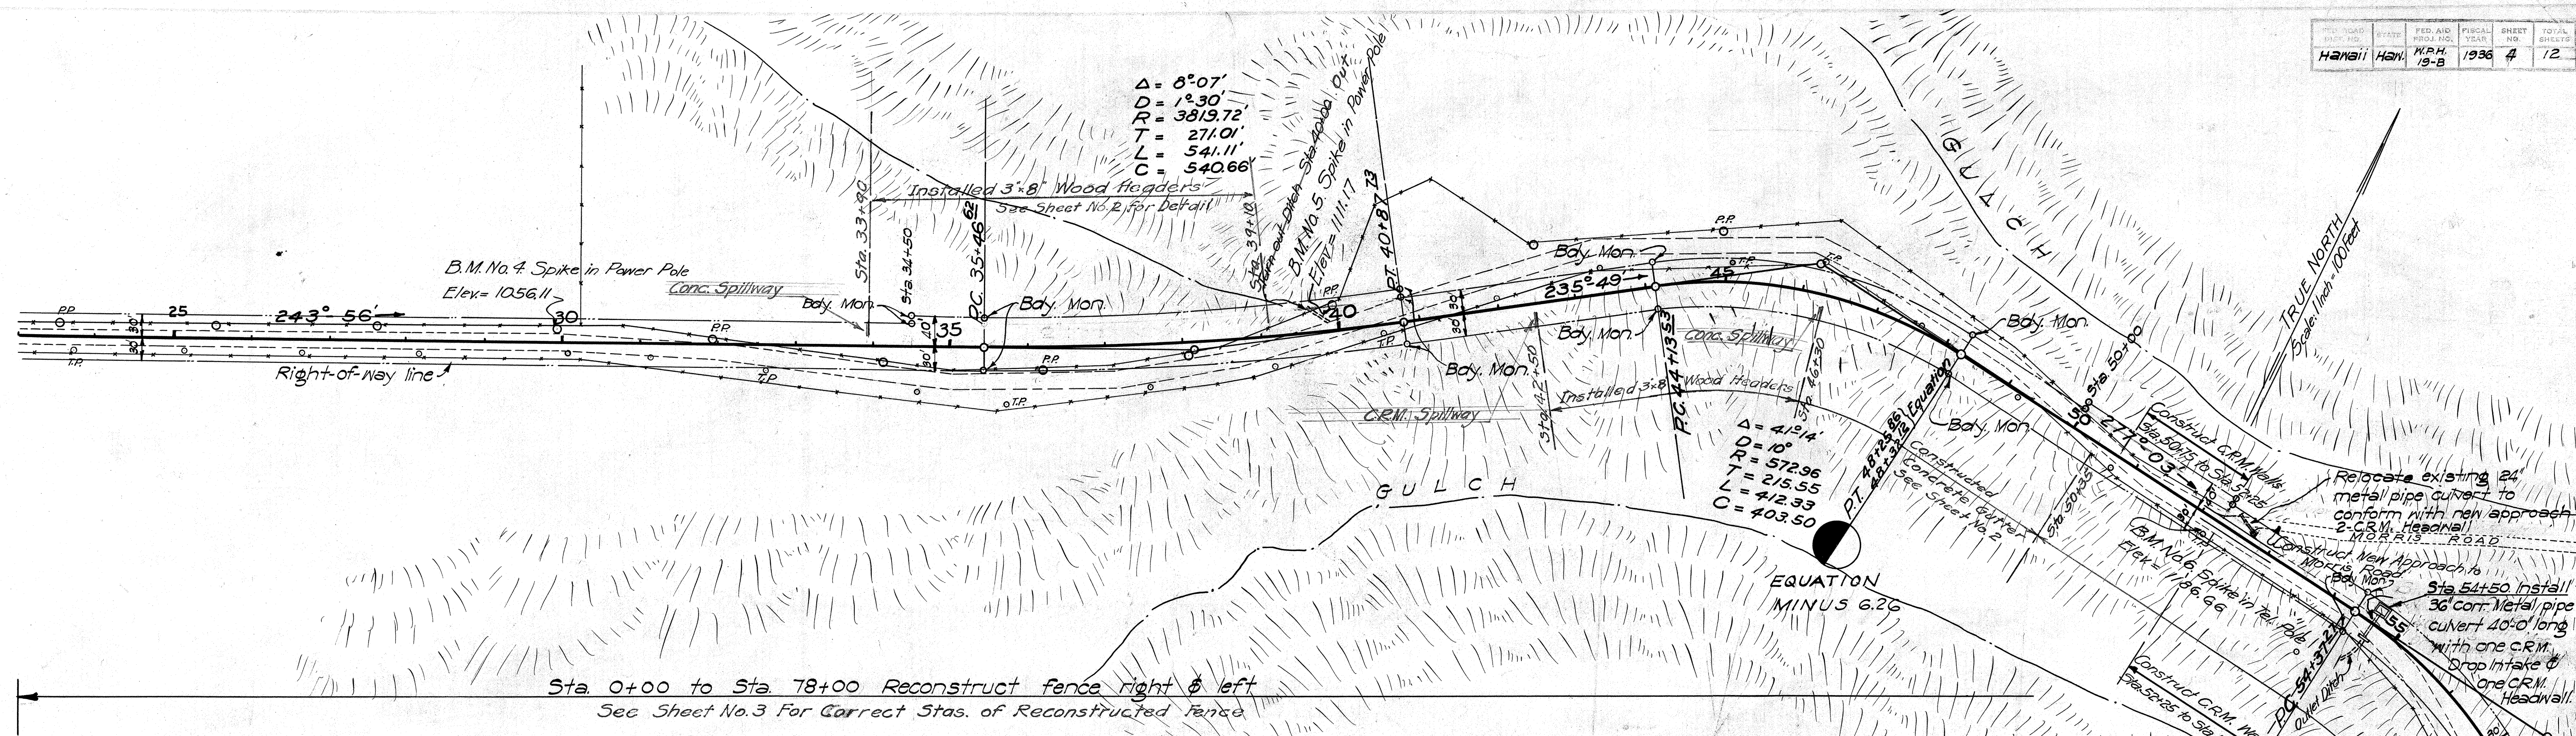

Sta 0+00 to Sta 78+00 Reconstruct fence right & left
See Sheet No. 3 For Correct Stas. of Reconstructed Fence


Exc. = 1,558.4 cu. yds. Emb. = 0	Exc. = 2,283.5 cu. yds. Emb. = 1,576.0 cu. yds.	Exc. = 722 cu. yds. Emb. = 3,298.3 cu. yds.	Exc. = 111.1 cu. yds. Emb. = 2,196.3 cu. yds.	Exc. = 2,077.2 cu. yds. Emb. = 1,529.0 cu. yds.	Exc. = 0 Emb. = 3,674.9 cu. yds.
-------------------------------------	--	--	--	--	-------------------------------------

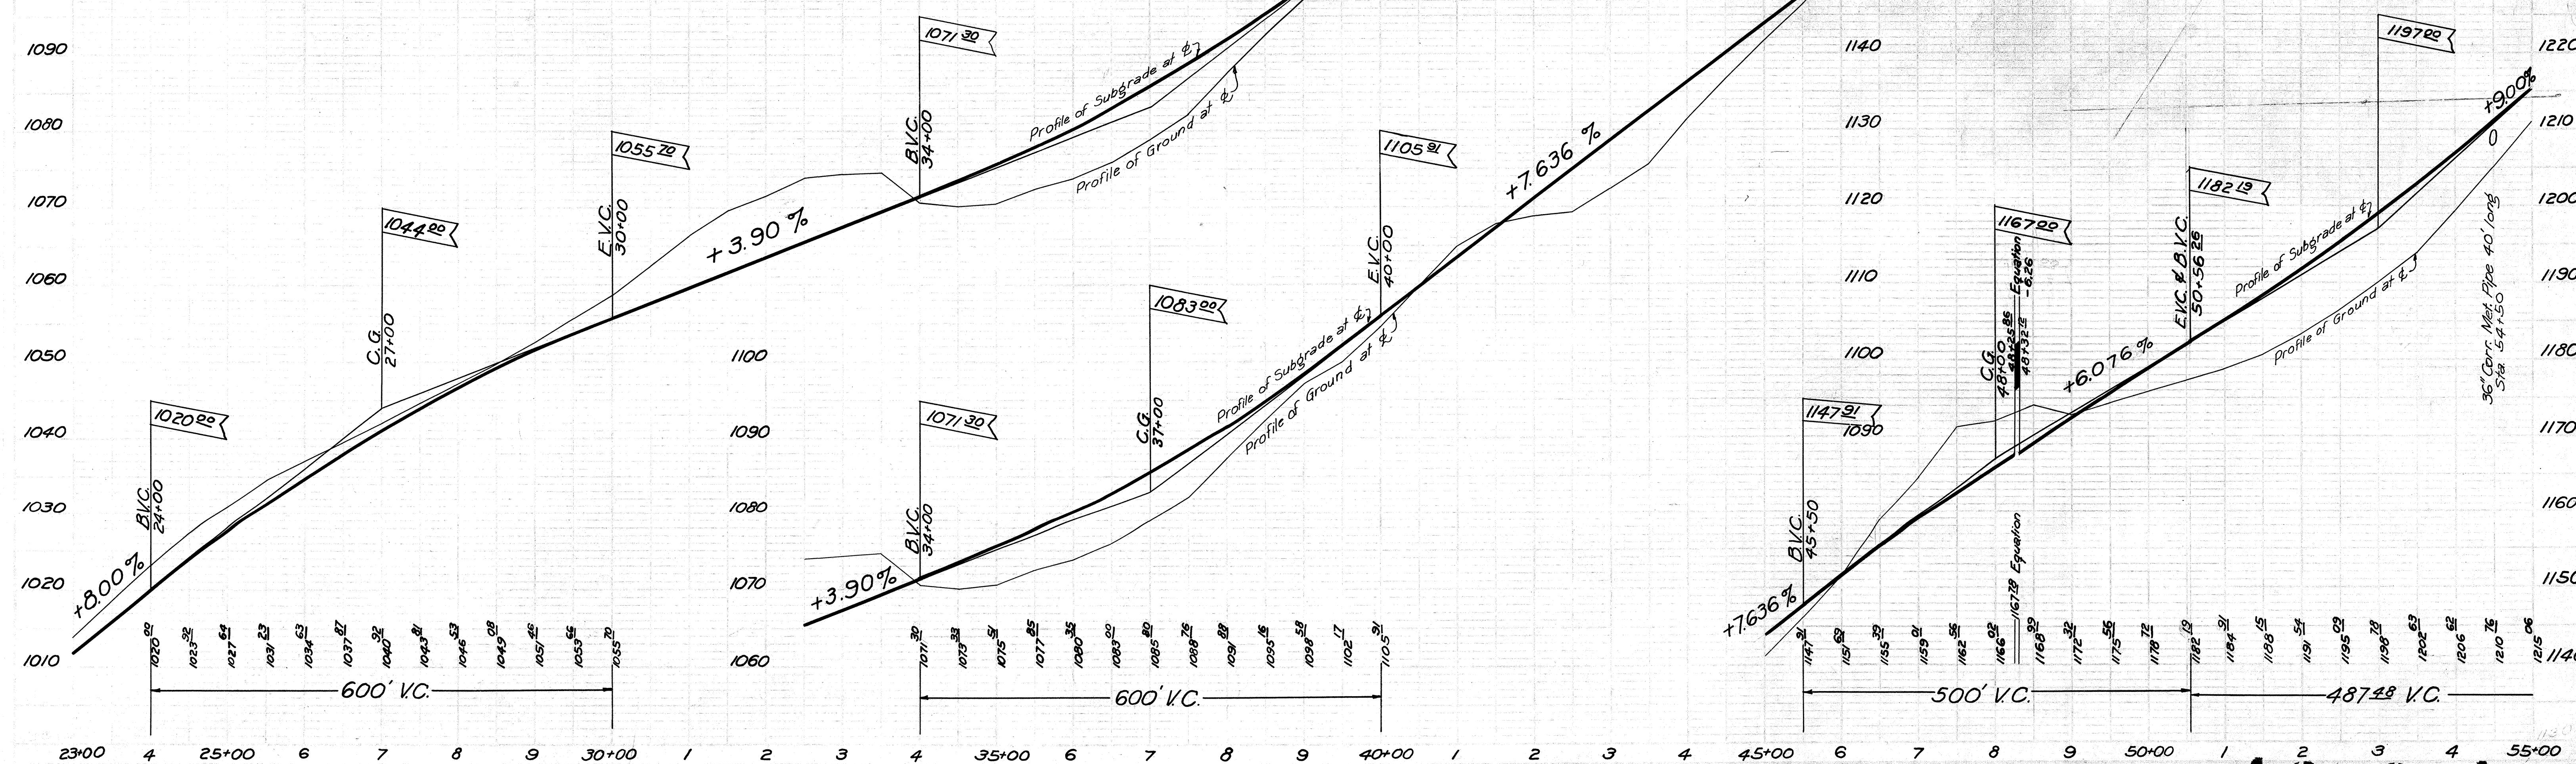

4378.4

NOTE:
2900 cu. yds. was used to construct a suitable approach to Morris Road. Fill varied from 6.0 ft. to 12.0 ft. within a distance of 500 lin. ft.

Sta. 0+00 to Sta. 78+00 Reconstruct fence right & left
See Sheet No. 3 For Correct Stas. at Reconstructed Fence.

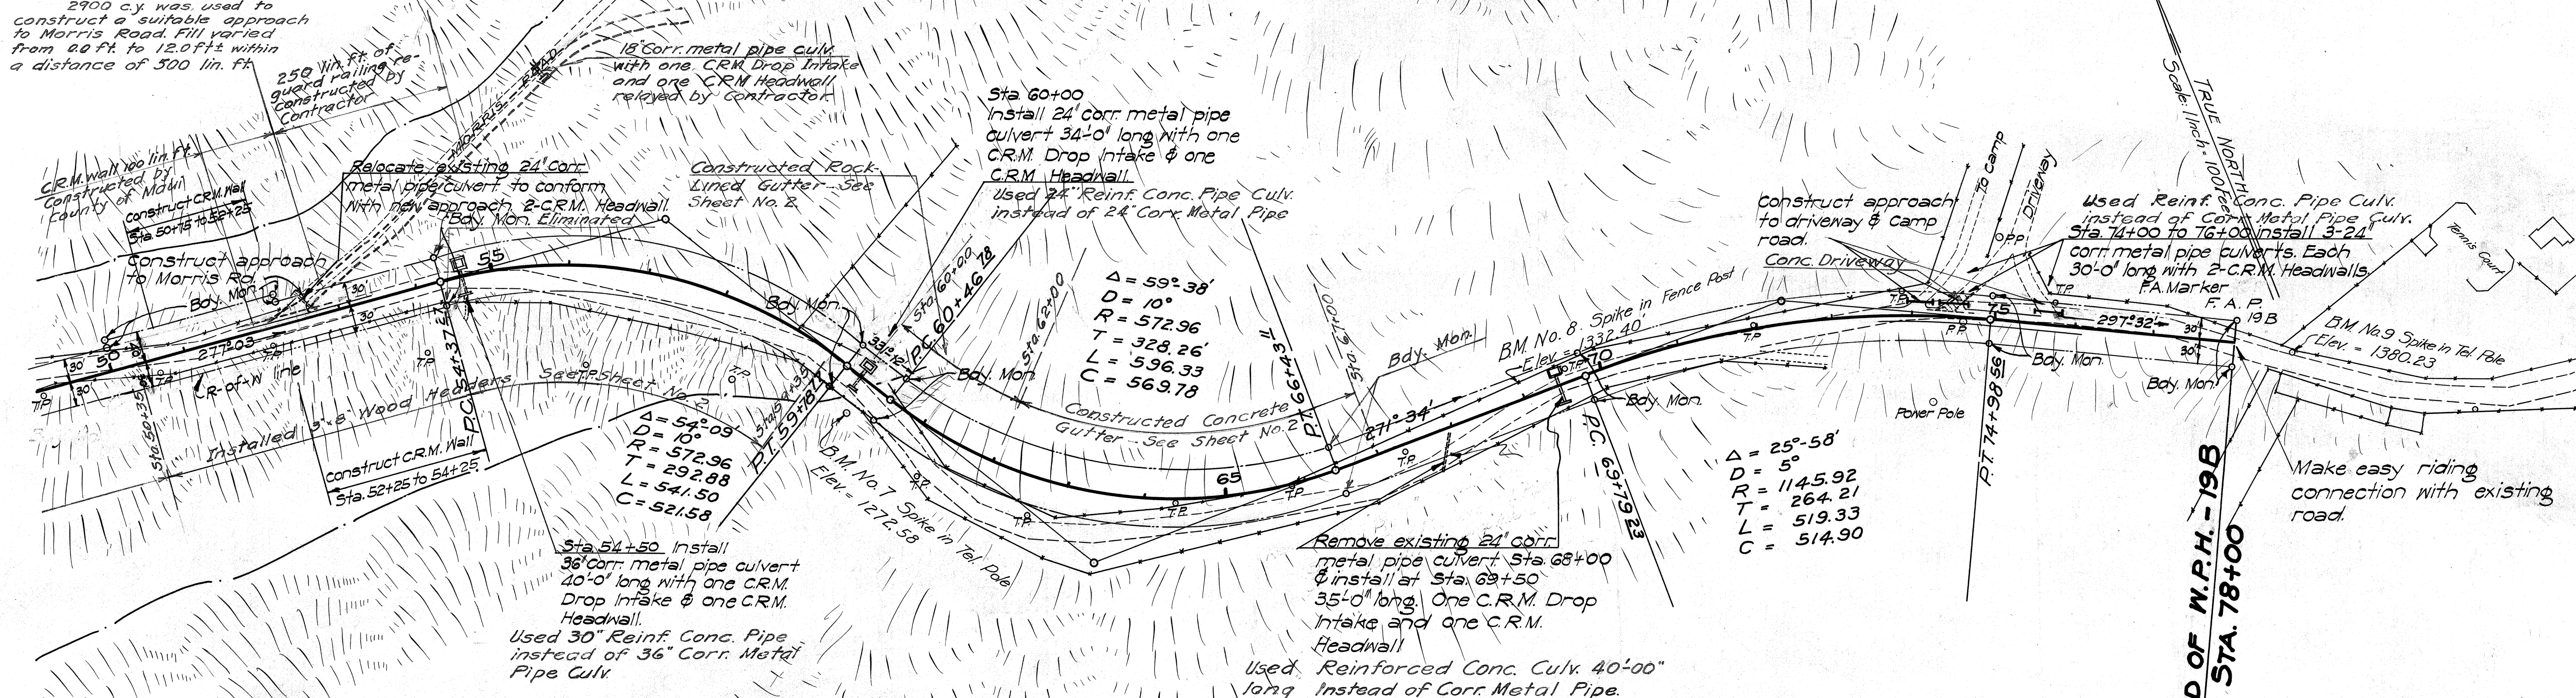

Exc. = 2012.2 Cu. Yds. Emb. = 1,674.9 Cu. Yds.	Exc. = 5,320.3 Cu. Yds. Emb. = 91.7 Cu. Yds.	Exc. = 4,361.0 Cu. Yds. Emb. = 0	Exc. = 1,250.0 Cu. Yds. Emb. = 771.4 Cu. Yds.	Exc. = 917.7 Cu. Yds. Emb. = 240.8 Cu. Yds.
---	---	-------------------------------------	--	--

