
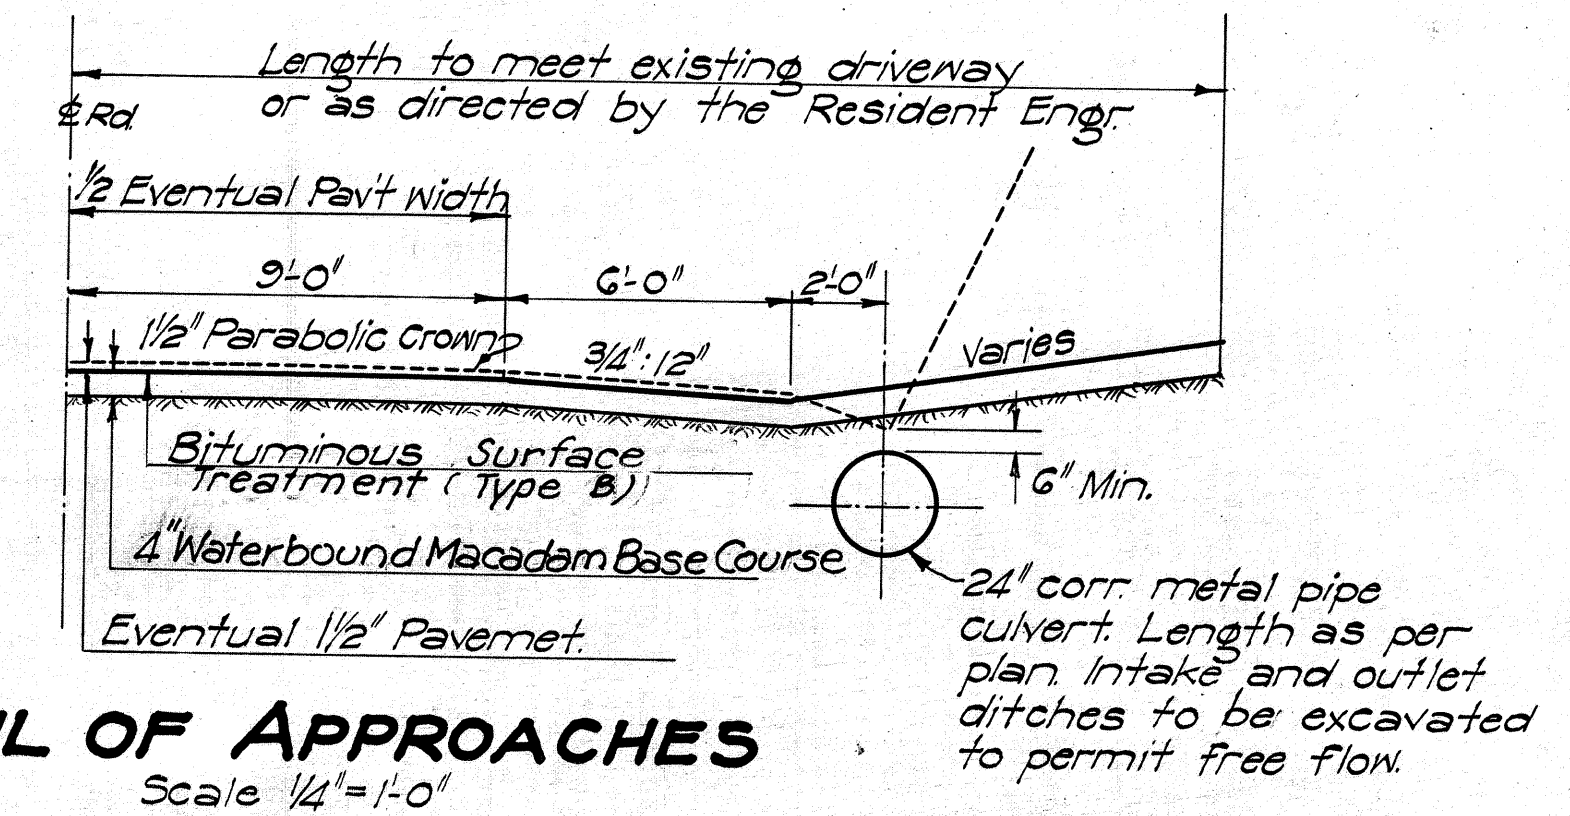



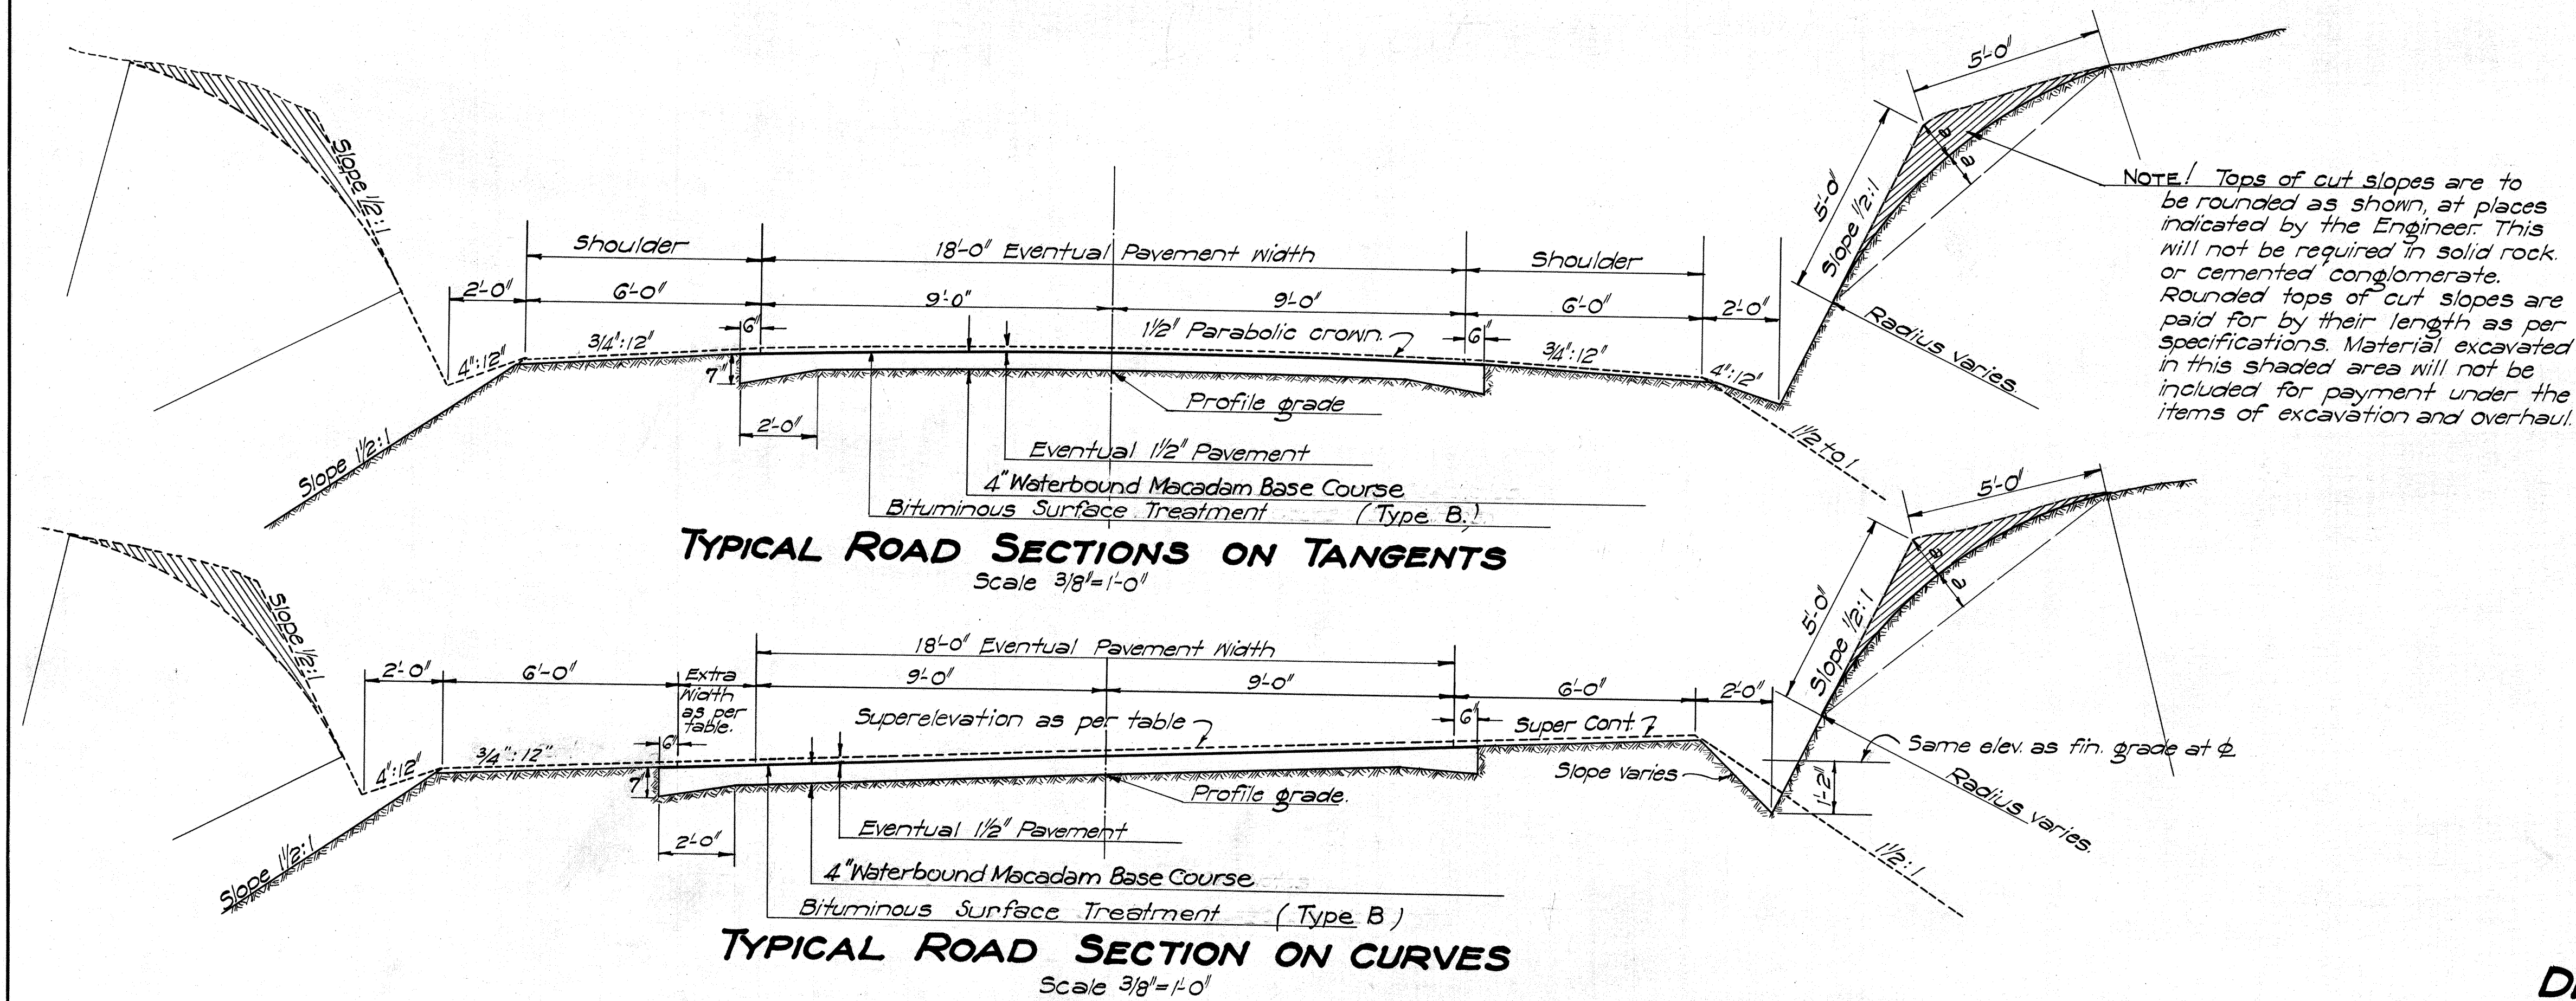


NOTES ON BASE COURSE

BASE COURSE: Total compacted thickness of 4" to 7" as shown by the typical sections above, of Waterbound Macadam Base Course.

BITUMINOUS SURFACE TREATMENT: Type B

GENERAL NOTES: Special reference is made to the specifications and special provisions covering all these items of work.

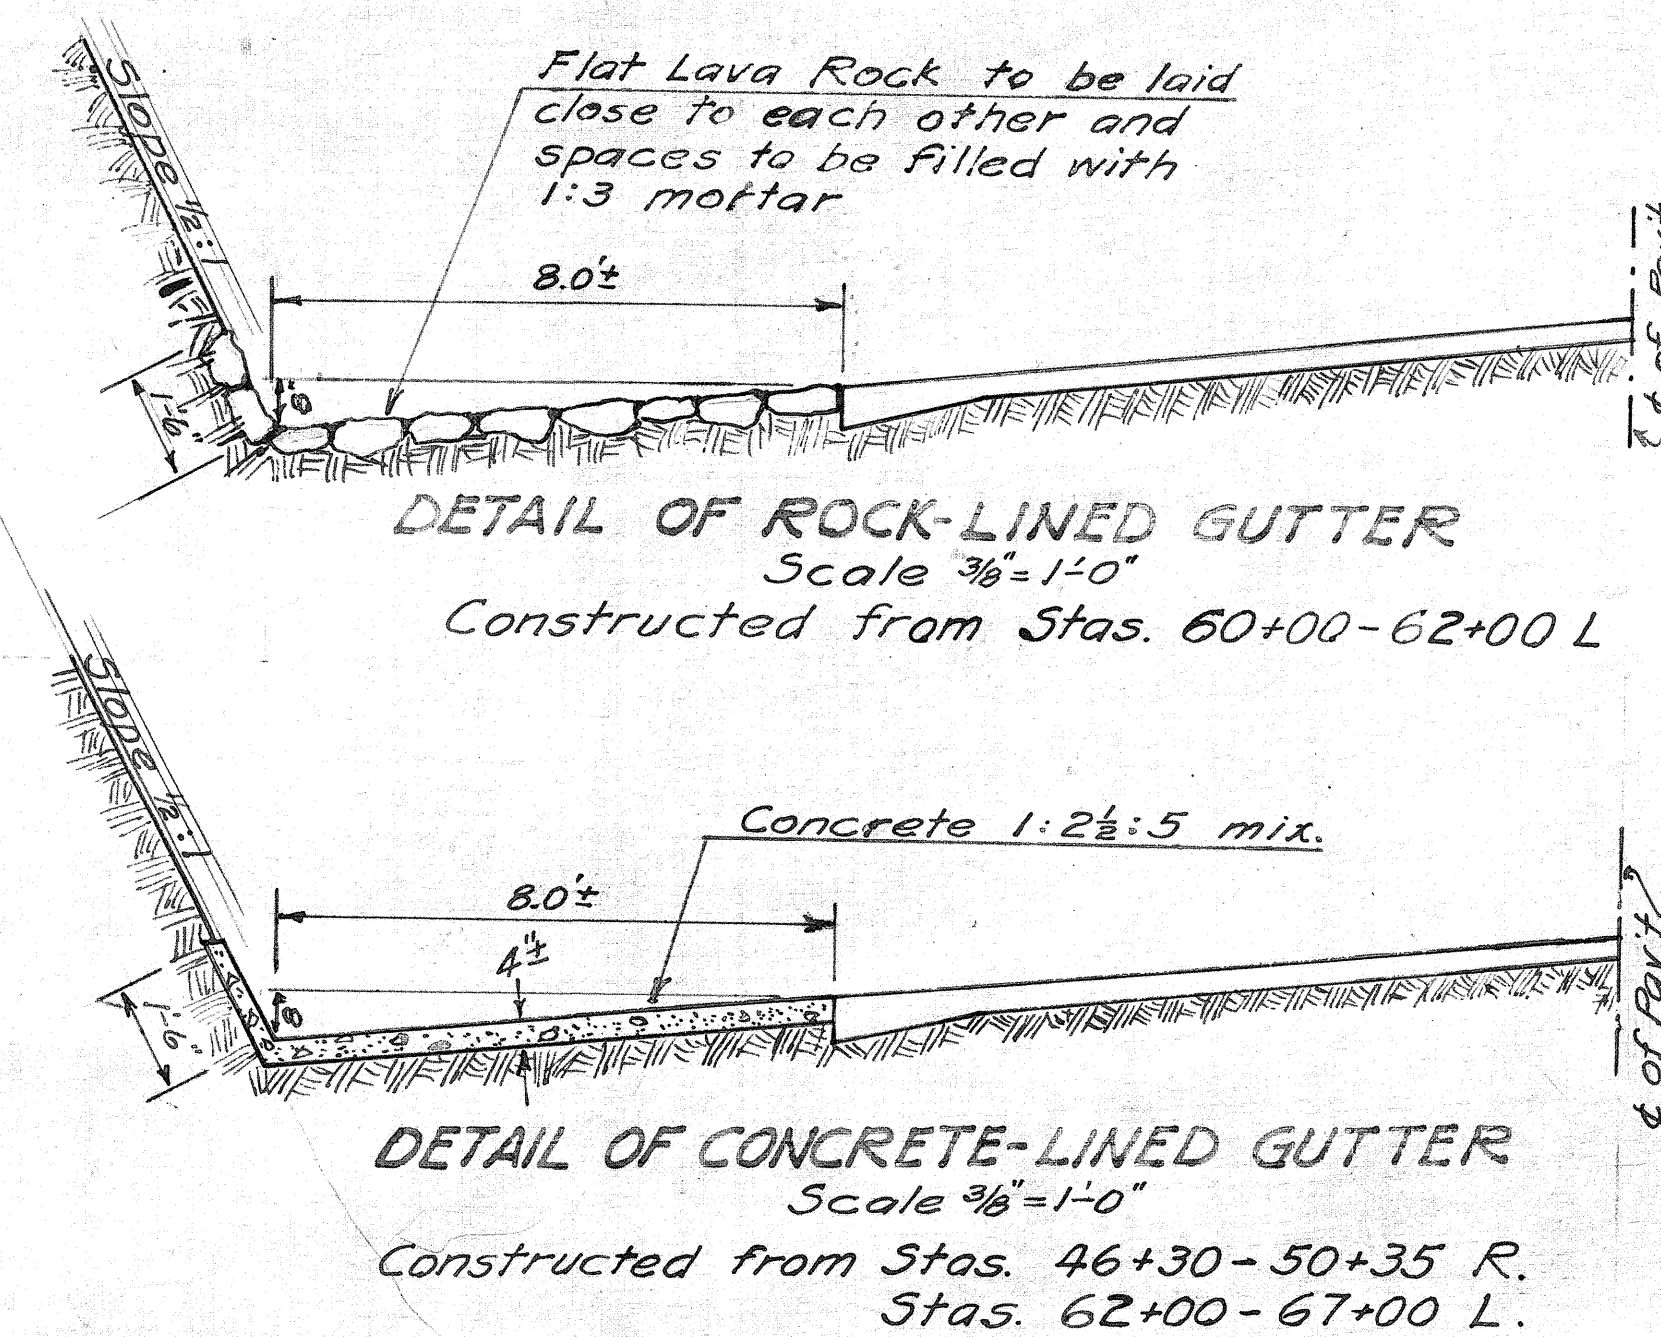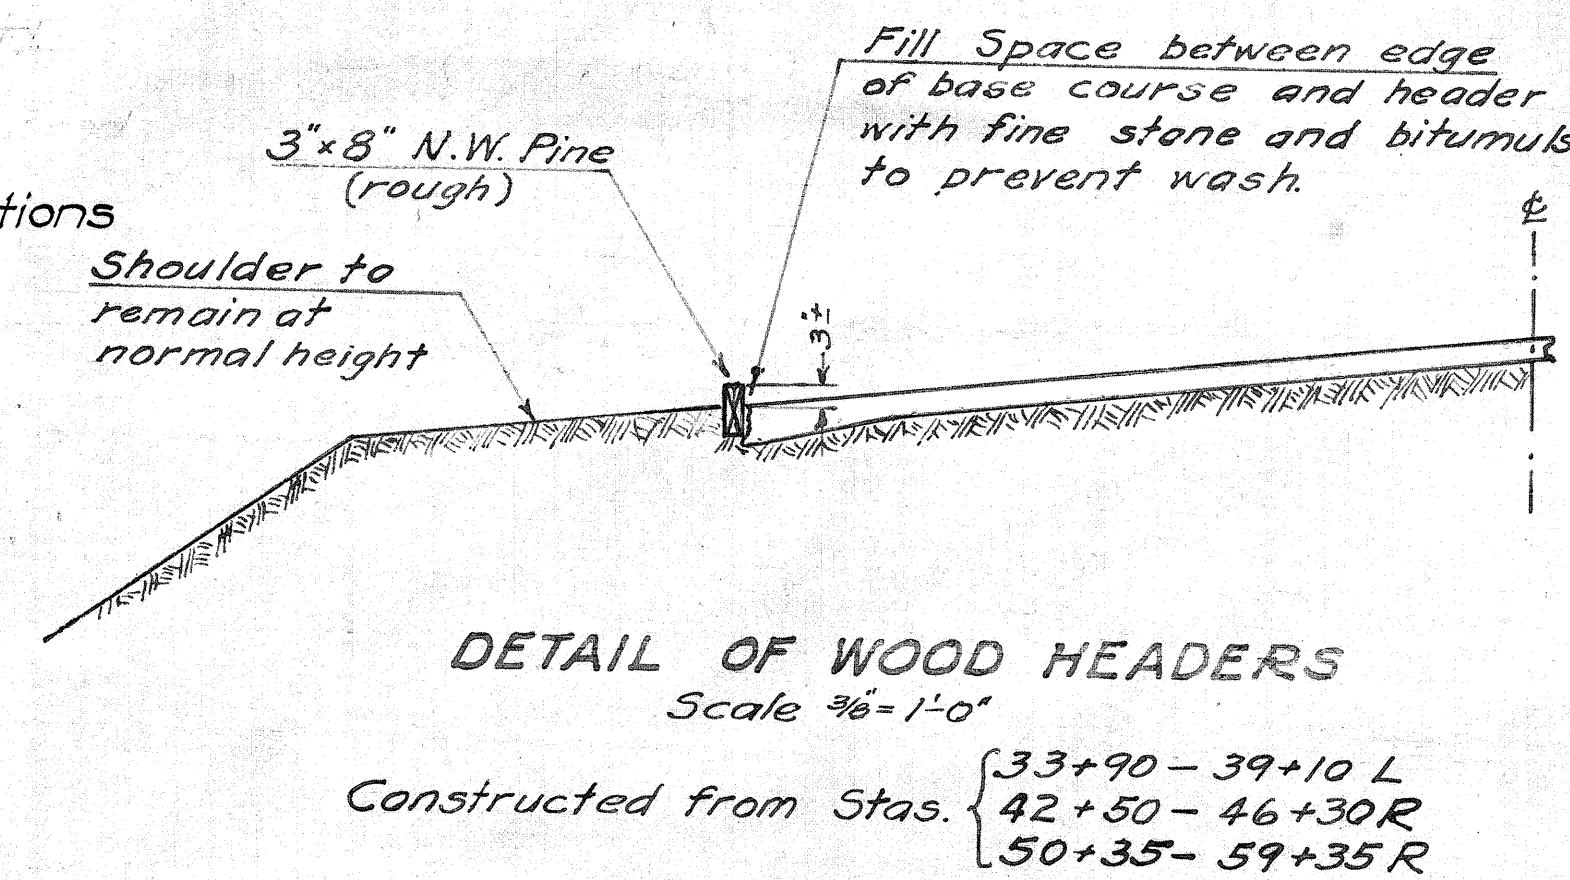

DATE: July 31, 1936
DESIGNED BY: B. M. G. W. L. L. L.
DRAWN BY: B. M. G. W. L. L. L.
CHECKED BY: B. M. G. W. L. L. L.