


INDEX TO DRAWINGS	
SHEET NO.	DESCRIPTION
1	TITLE SHEET
2	TYPICAL SECTION
3-6	PLAN & PROFILE
7	BORROW PIT SITE
8	DETAILS
9-19	CROSS SECTION

CONVENTIONAL SIGNS USED	
Boundary Lines	
Bridge	
Centerline	 3.5
Centerline Monument	 2 Mon.
Circular Pipe Culvert	
Electric Pole	 0.00
Existing Road	
Fences	
Telephone Pole	 0.00
Warning & Regulatory Signs	 + W-1 + R-1 (Type)

TERRITORY OF HAWAII
TERRITORIAL HIGHWAY DEPARTMENT
HONOLULU, T.H.
AS BUILT
PLANS OF
KAUNAKAKAI - KUALAPUU ROAD
FEDERAL AID PROJECT NO. F-047-I(1)

DISTRICT OF MOLOKAI
COUNTY OF MAUI
ISLAND OF MOLOKAI

SCALES	
PLAN	1 IN. = 100 FT.
PROFILE	HOR. 1 IN. = 100 FT. VER. 1 IN. = 10 FT.
CROSS SECTION	HOR. 1 IN. = 10 FT. VER. 1 IN. = 10 FT.

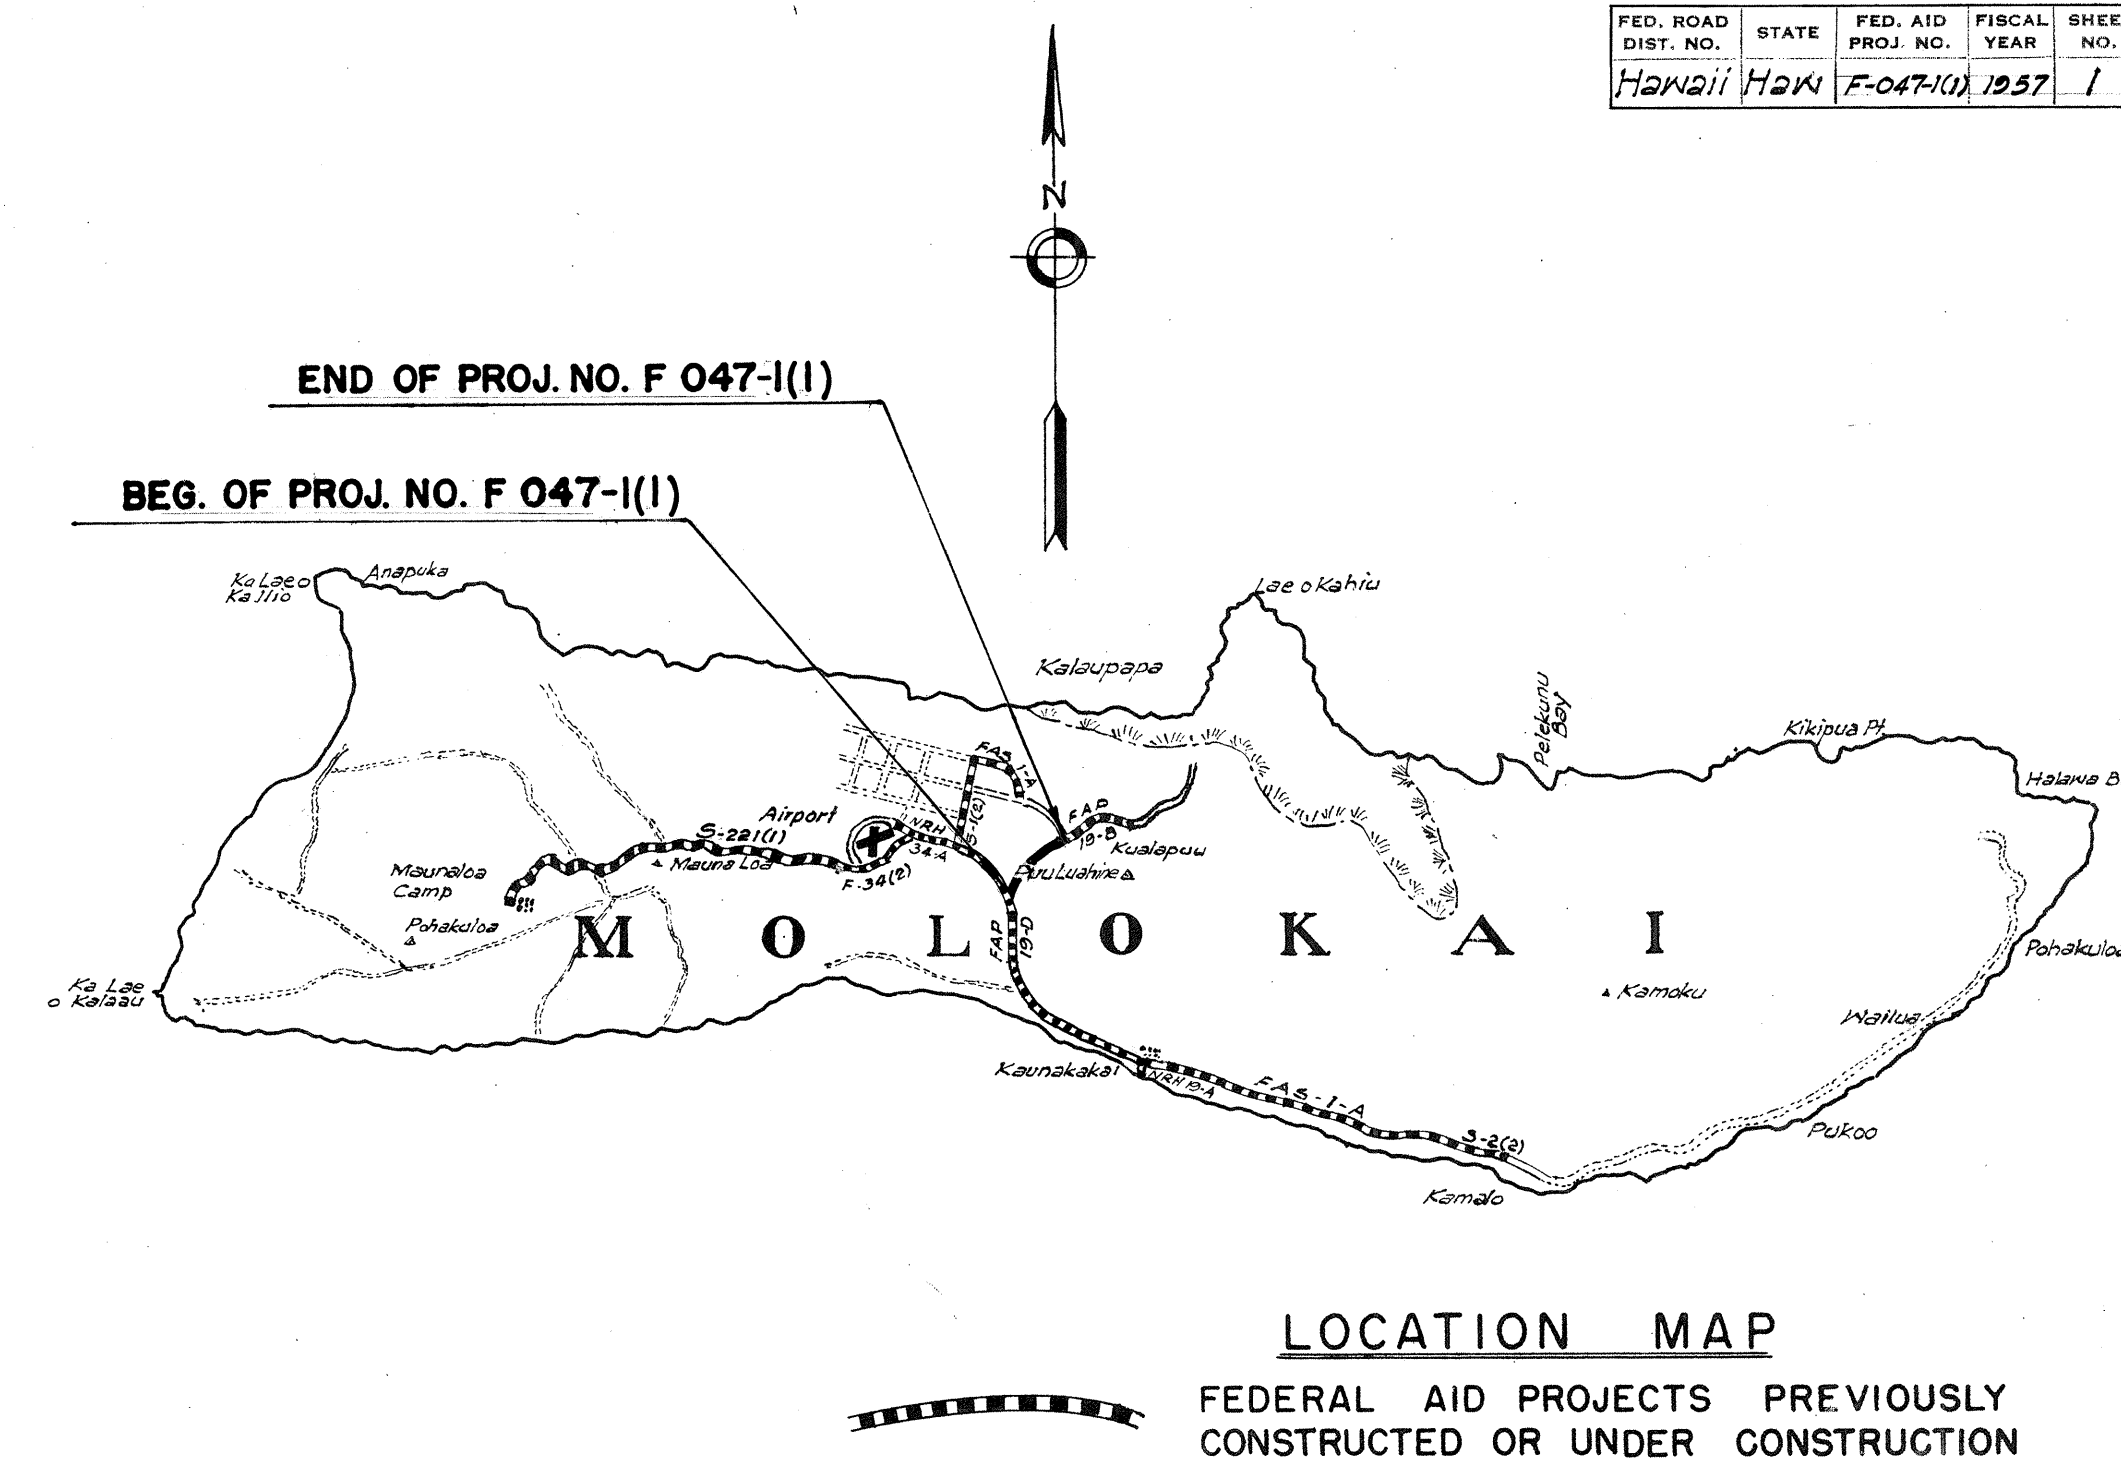

NOTE:
ALL CHANGES MADE DURING CONSTRUCTION
HAVE BEEN NOTED IN RED ON THESE
TRACINGS AND CHECKED BY:

Benjamin Kaimaulani
PROJECT ENGINEER

10/26/58
DATE

APPROVED: DATE 8/26/57
Wm. Wachtel
TERRITORIAL HIGHWAY ENGINEER

DEPARTMENT OF COMMERCE
BUREAU OF PUBLIC ROADS
APPROVED:

DIVISION ENGINEER DATE

LAYOUT OF PROJECT
SCALE: 1" = 2640'
GROSS LENGTH OF PROJECT 1.740 MILE
BRIDGES 0.0
NET LENGTH OF PROJECT 1.740 MILE

5913.1