

FED. ROAD DIST. NO.	STATE	FED. AID PROJ. NO.	FISCAL YEAR	SHEET NO.	TOTAL SHEETS
HAWAII	HAW.	5-0470(1) 5-0470(2)	1970	6	80

DATE	BY

DATE	BY

DATE	BY

DATE	BY

NOTE:
All Vertical Curves 100'
Unless noted otherwise.


CURVE 1

CURVE 2

Sheet no. 1 of 2 Sheets

SUPERELEVATION DIAGRAM

3+00 4+00 5+00 6+00 14+00 15+00 16+00 27+00 28+00 29+00 30+00 31+00 37+00 38+00 39+00 40+00

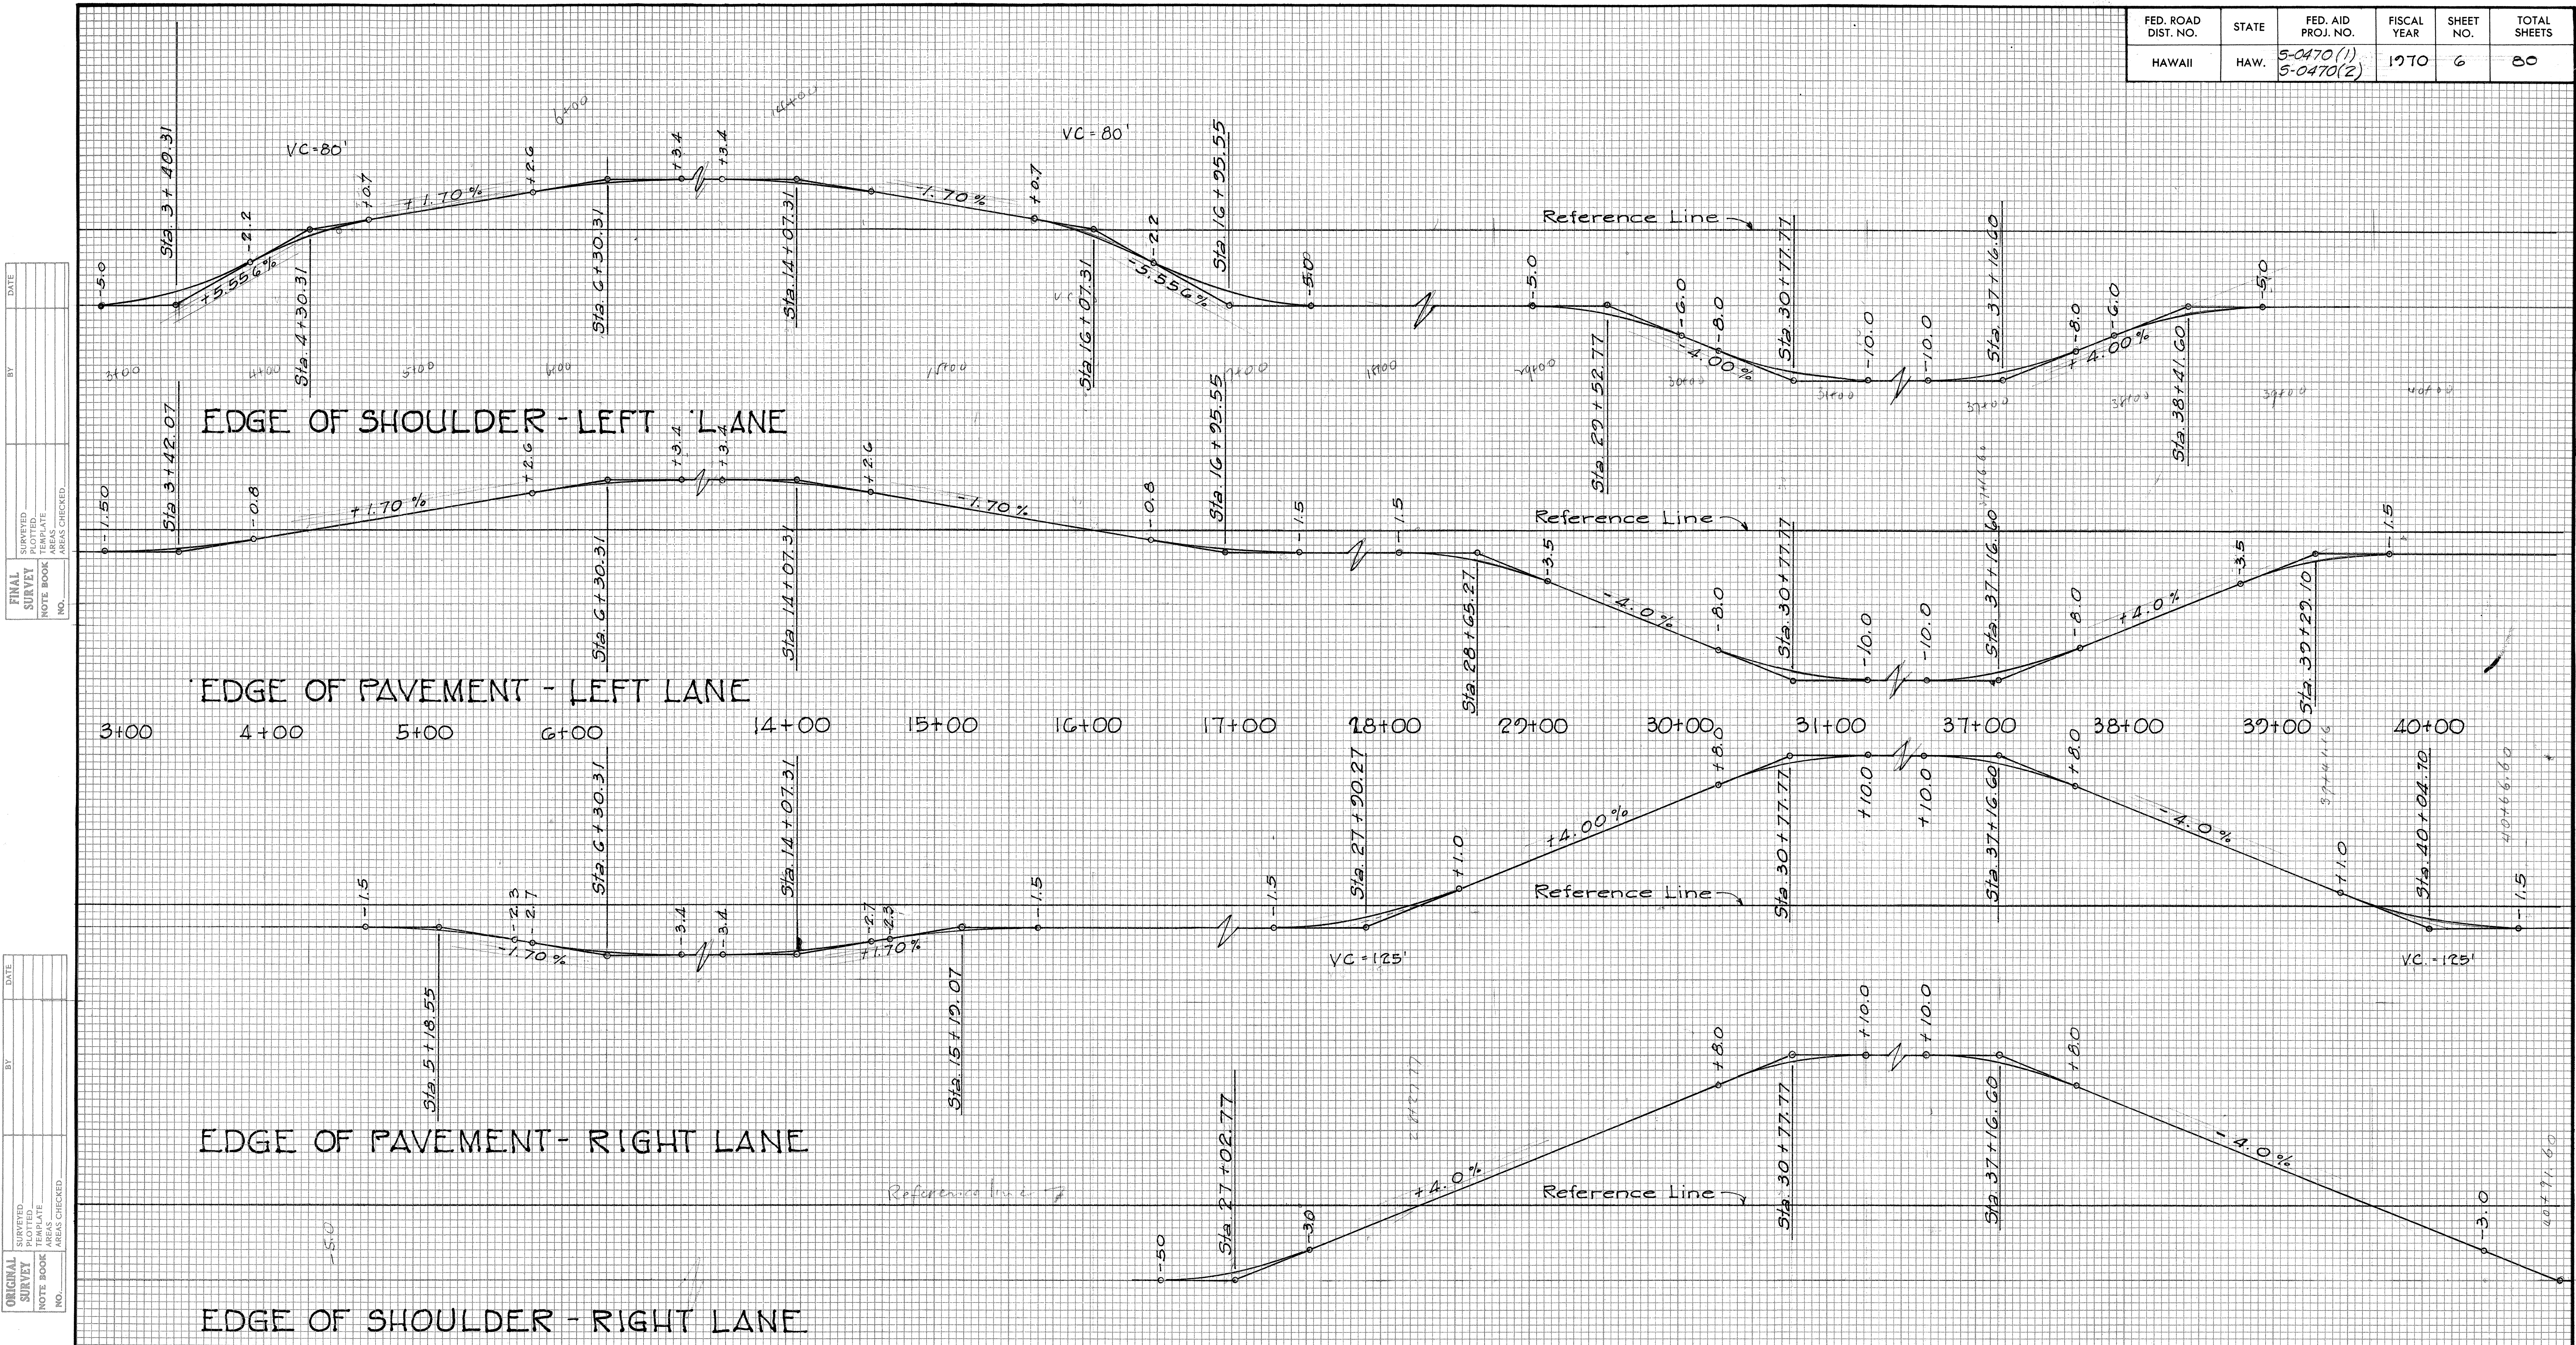

FED. ROAD DIST. NO.	STATE	FED. AID PROJ. NO.	FISCAL YEAR	SHEET NO.	TOTAL SHEETS
HAWAII	HAW.	5-0470(1) 5-0470(2)	1970	7	80

FINAL SURVEY	BY	DATE
SURVEYED		
PLOTTED		
NOTE BOOK		
NO.		

ORIGINAL SURVEY	BY	DATE
SURVEYED		
PLOTTED		
NOTE BOOK		
NO.		

