


INDEX TO DRAWINGS	
SHEET NO.	DESCRIPTION
1	TITLE SHEET
2	TYPICAL SECTIONS
3-5	PLAN & PROFILE
6-7	SUPER ELEV DIAGRAM
8-16	MISCELLANEOUS DETAIL
17	TRAFFIC SIGN & MARKERS
18-26	DRAINAGE
** 27-29	UTILITIES
* 32-36	R/W ADJUSTMENTS
37-41	FIELD OFFICE & LAB.
42-64	STANDARD DETAILS
64A, 65-68	
69-82	CROSS SECTIONS
** 27 S-I	UTILITIES

* SHEET NOS. 30 & 31 HAVE BEEN DELETED FROM THESE PLANS.

CONVENTIONAL SIGNS

Centerline	5
Electric Power Pole	Exist. O.E.P. New E.P.
Telephone Pole	O.T.P. T.P.
Guy Pole	O.G.P. G.P.
Fences (Named)	
Trees (Named)	Mango Coconut
Existing Roads	
Existing Culverts	
Water Meter	W.M.
Existing Pipeline	W-3/4

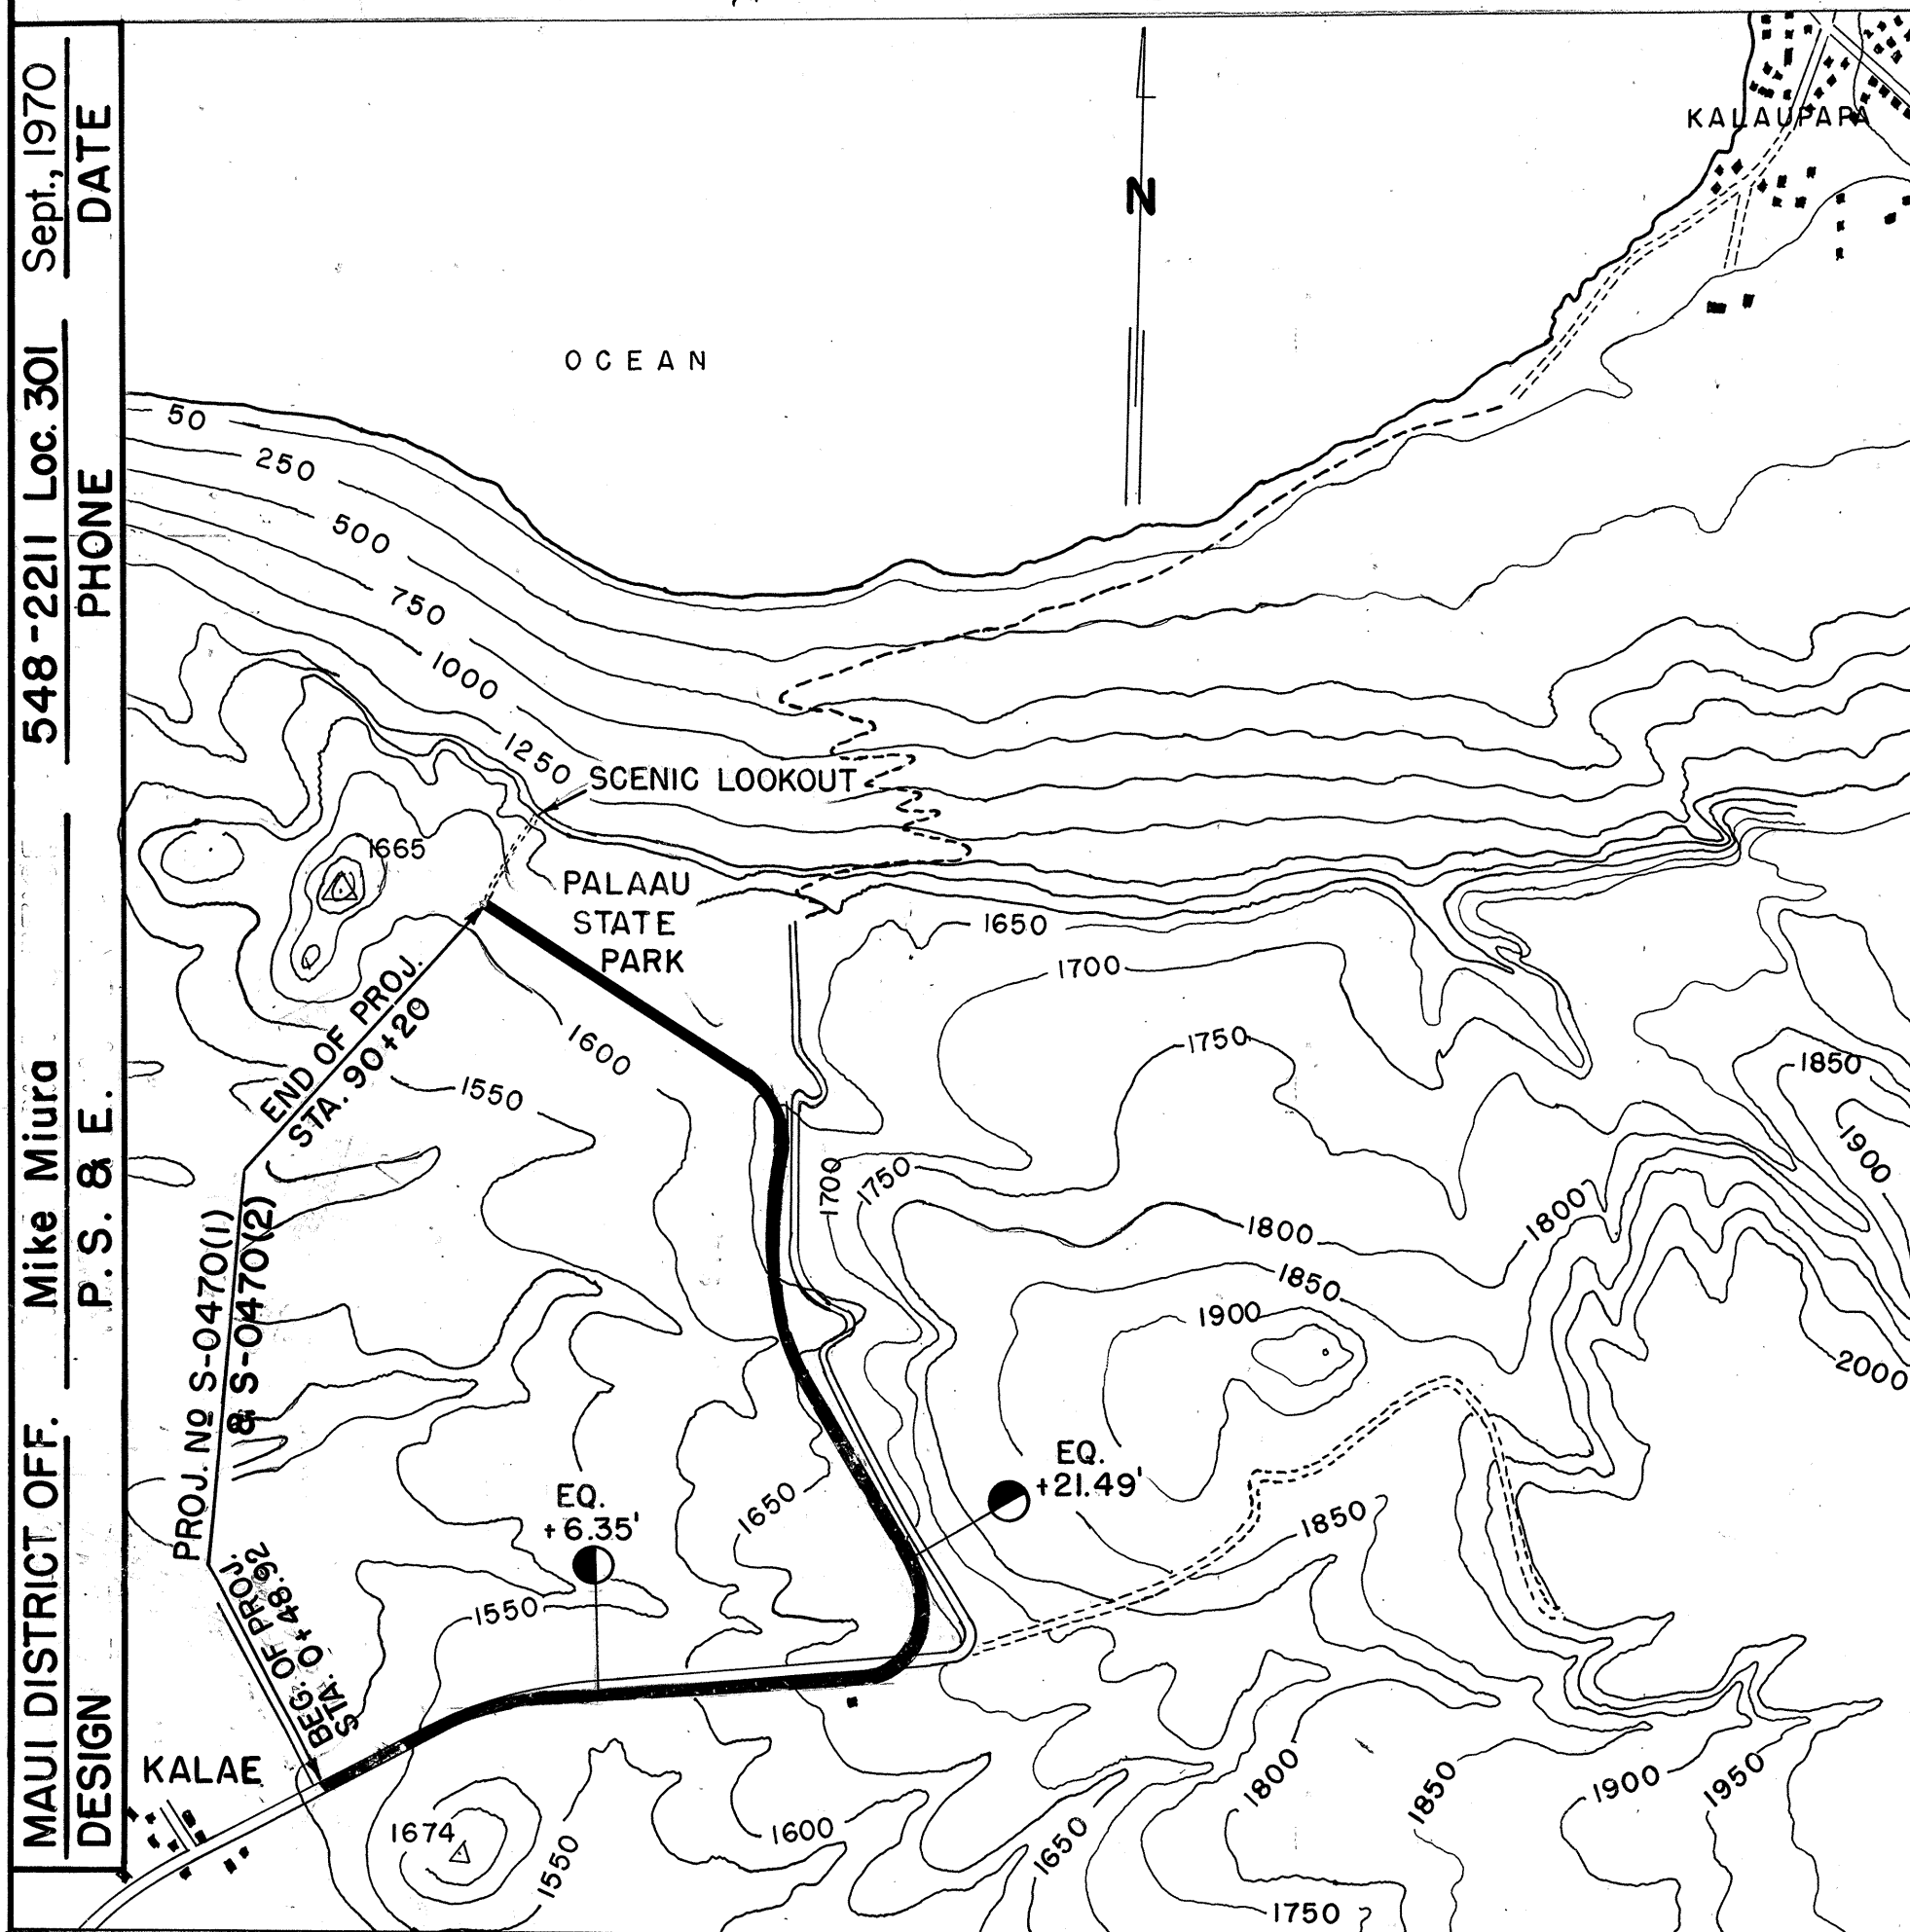

LAYOUT OF PROJECT
SCALE: 1" = 1000'

STATE OF HAWAII
DEPARTMENT OF TRANSPORTATION
HIGHWAYS DIVISION

"AS BUILT"
PLANS OF

KALAUPAPA LOOKOUT RD.
(KALAE TO PALI LOOKOUT)

FEDERAL AID SECONDARY PROJECT Nos. S-0470 (1) & S-0470 (2)

DISTRICT OF MOLOKAI
COUNTY OF MAUI
ISLAND OF MOLOKAI

SCALES

PLAN	1 IN. = 100 FT.
PROFILE	HOR. 1 IN. = 100 FT. VER. 1 IN. = 10 FT.
X-SECTIONS	HOR. 1 IN. = 10 FT. VER. 1 IN. = 10 FT. (EXCEPT WHERE NOTED)

DESIGN CLASSIFICATION

ADT (1971)	190
ADT (1991)	300
DHV	4%
D	50/50
T	2%
T24	4%
V	40 MPH

NOTE:

All changes made during construction have been incorporated on these plans except change in the original theoretical quantities.

Ketsumi Nakamoto 9/25/70
Resident Engineer Date


DEPARTMENT OF TRANSPORTATION FEDERAL HIGHWAY ADMINISTRATION
APPROVED:
DIVISION ENGINEER DATE

DEPARTMENT OF TRANSPORTATION STATE OF HAWAII
APPROVED:
<i>E. Alvey Wright</i> 9/25/70 DIR. OF TRANSPORTATION DATE

GROSS LENGTH OF PROJECT 1.704 MILES

FED. ROAD DIST. NO.	STATE	FED. AID PROJ. NO.	FISCAL YEAR	SHEET NO.	TOTAL SHEETS
HAWAII	HAW.	S-0470(1) S-0470(2)	1970	1	81

REVISED: OCT. 12, 1970

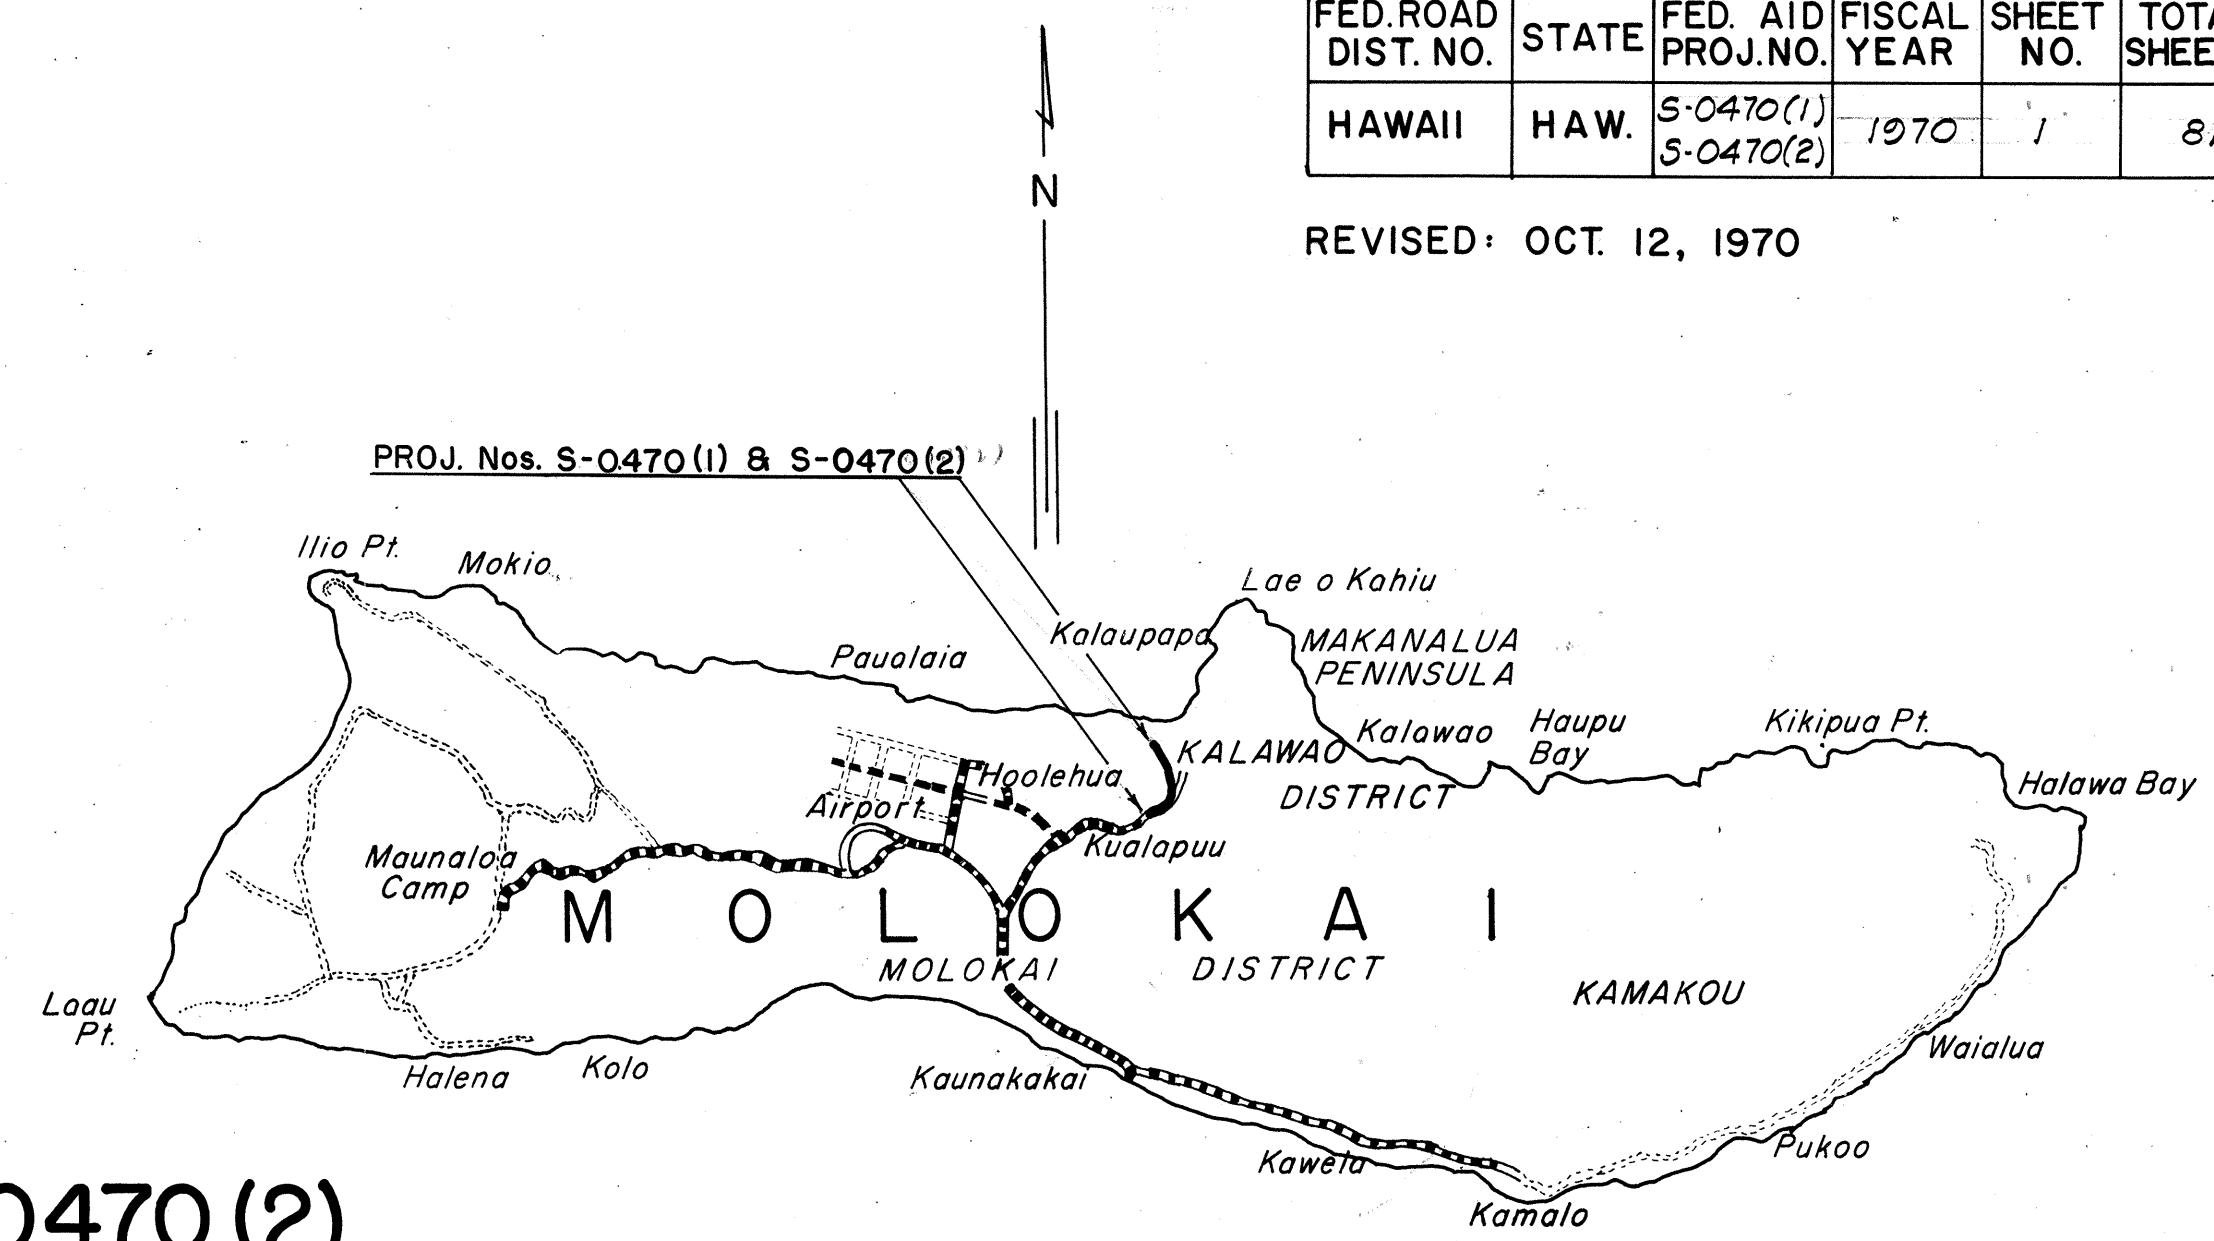

FEDERAL AID PROJECTS PREVIOUSLY CONSTRUCTED OR UNDER CONSTRUCTION

DESIGNED BY

MAUI DISTRICT OFF. Mike Miura
P.S. & E.
548-2211 Loc. 301
DATE Sept. 1970
PHONE