
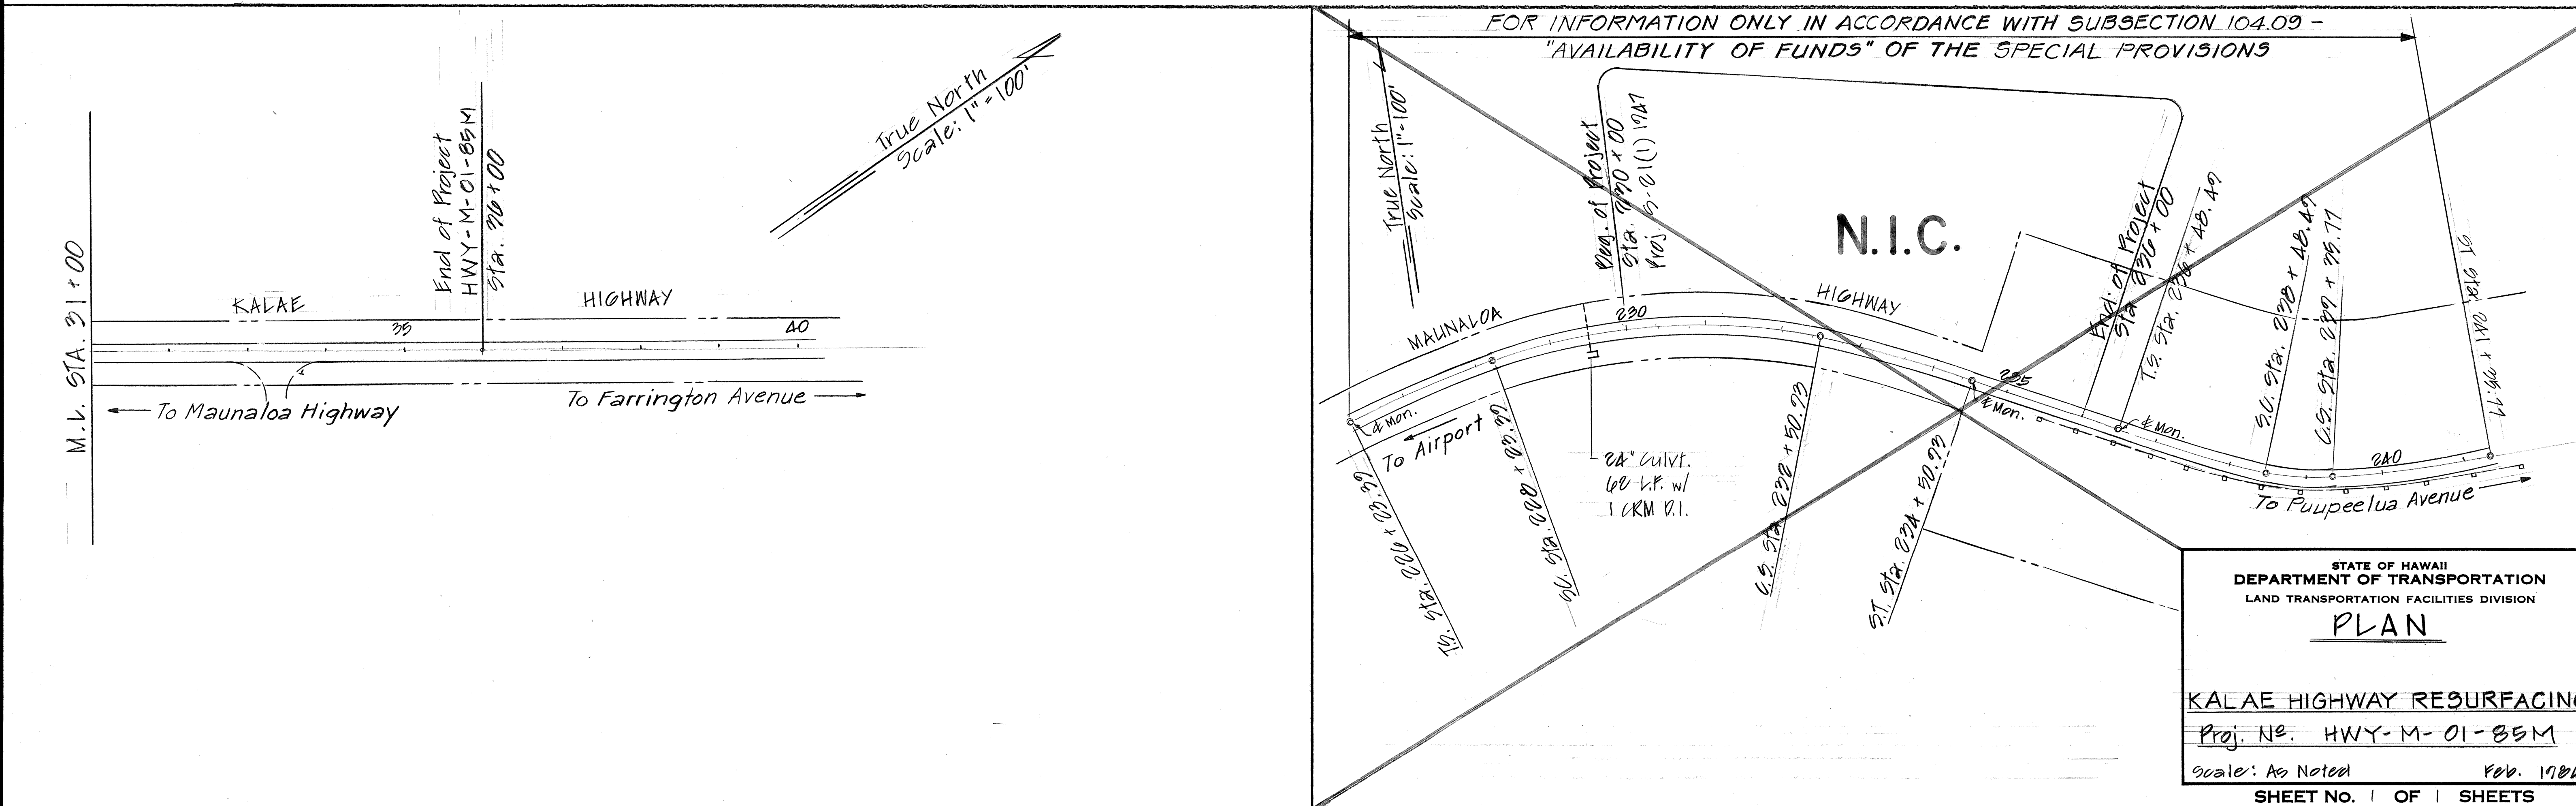


FED. ROAD DIST. NO.	STATE	PROJ. NO.	FISCAL YEAR	SHEET NO.	TOTAL SHEETS
HAWAII	HAW.	HWY-M-01-85M	1985	3	3

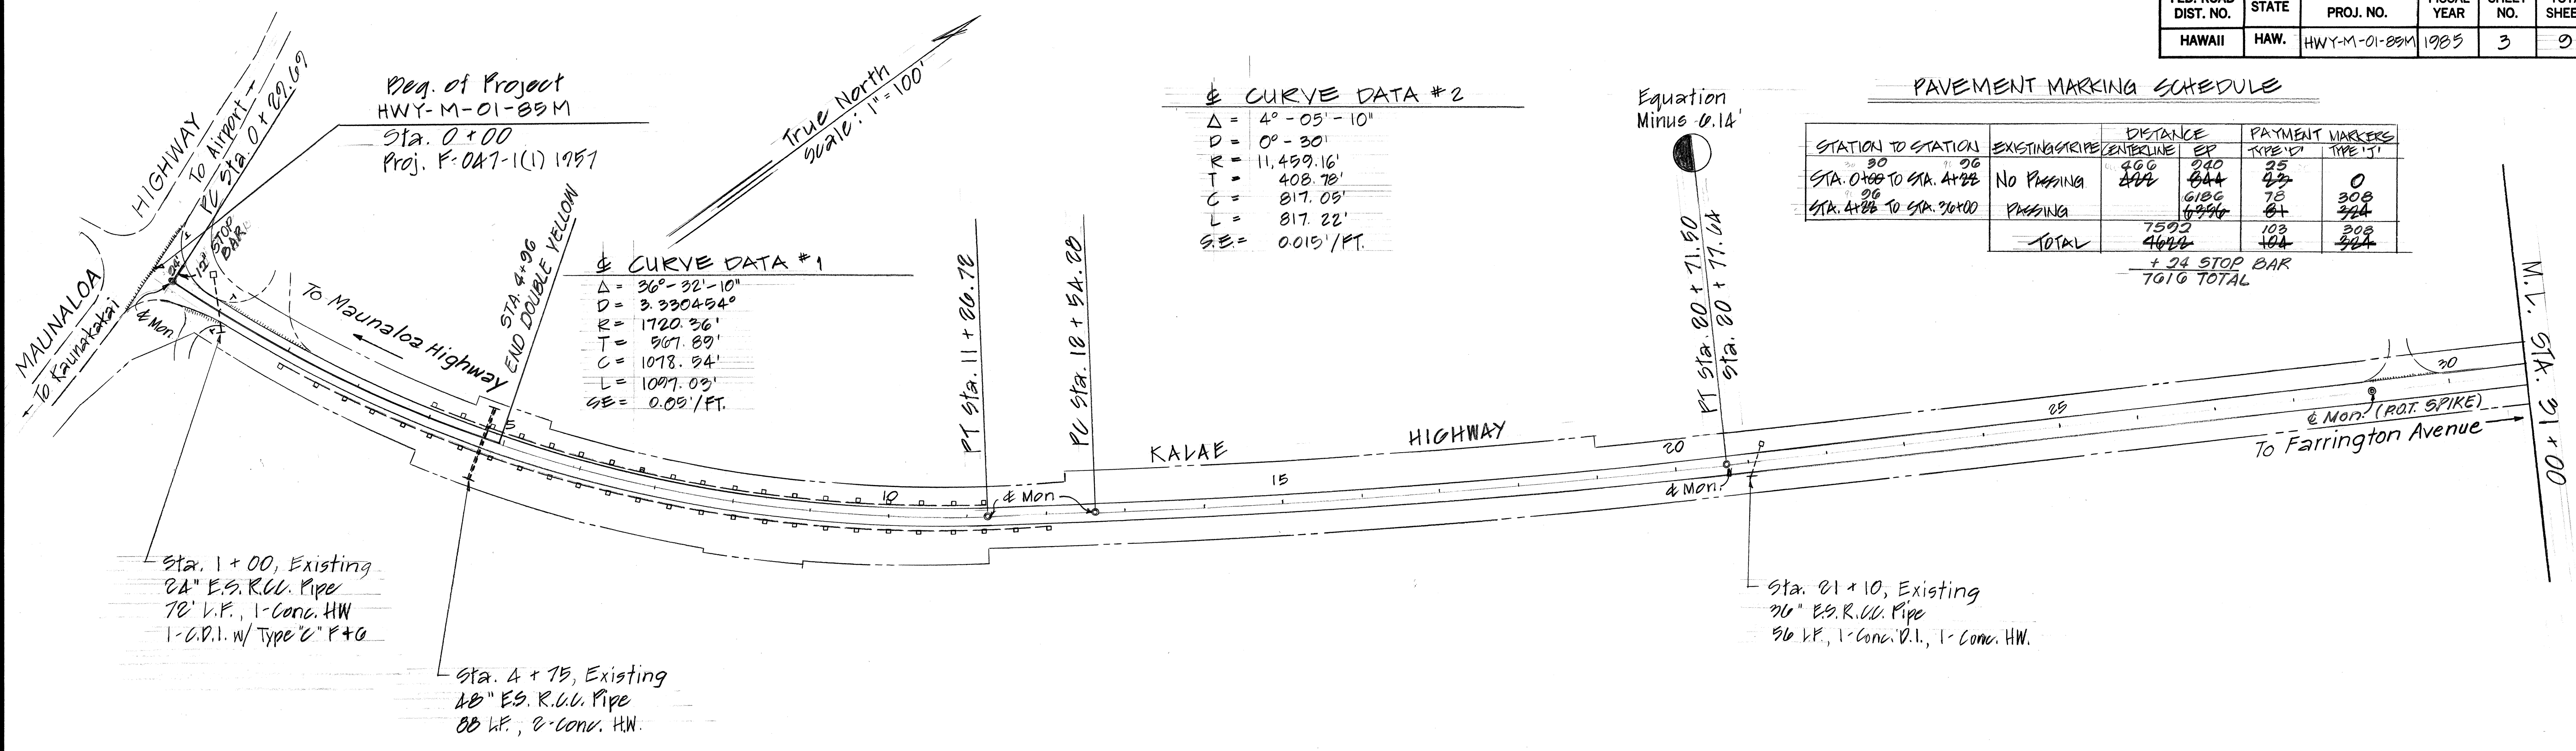

STATE OF HAWAII

DEPARTMENT OF TRANSPORTATION

LAND TRANSPORTATION FACILITIES DIVISION

PLAN

KALAE HIGHWAY RESURFACING

Proj. No. HWY-M-01-85M

Scale: As Noted

Feb. 1984

SHEET NO. 1 OF 1 SHEETS

3

SURVEY PLOTTED BY	DATE
DRAWN BY	2/21/84
DESIGNED BY	
QUANTITIES BY	
CHECKED BY	
ORIGINAL PLAN	
NOTE BOOK	
No.	