	INDEX TO DRAWINGS
SHEET NO.	DESCRIPTION
:	TITLE SHEET
2	TYPICAL SECTIONS, DETAILS,
	GENERAL NOTES
3	PLAN
4-9	STANDARD DETAILS
, ,	
1	
*********	
,	

NISHIMURA
P. S. & E. BY



STATE OF HAWAII

## DEPARTMENT OF TRANSPORTATION

HIGHWAYS DIVISION


HONOLULU, HAWAII "AS-BUILT"


PLANS FOR



DIST. NO. PROJ. NO. HAW. | HWY-M-01-85M 1985 |



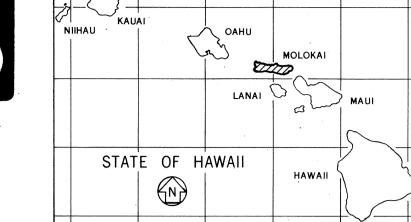

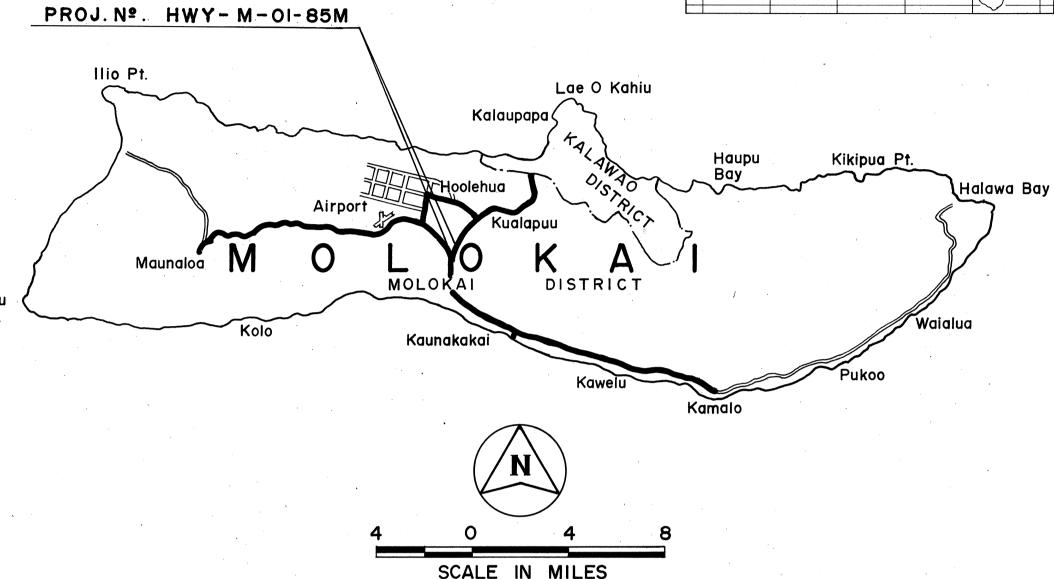

OR UNDER CONSTRUCTION

CHANGES MADE DURING CONSTRUCTION HAVE BEEN NOTED ON THESE PLANS AND CHECKED BY:


RESIDENT ENGINEER

13 Feb. 85

DATE

## KALAE HIGHWAY RESURFACING MAUNALOA HIGHWAY TOWARDS FARRINGTON AVENUE Light PROJECT Nº. HWY-M-01-85M

DISTRICT OF MOLOKAI ISLAND OF MOLOKAI

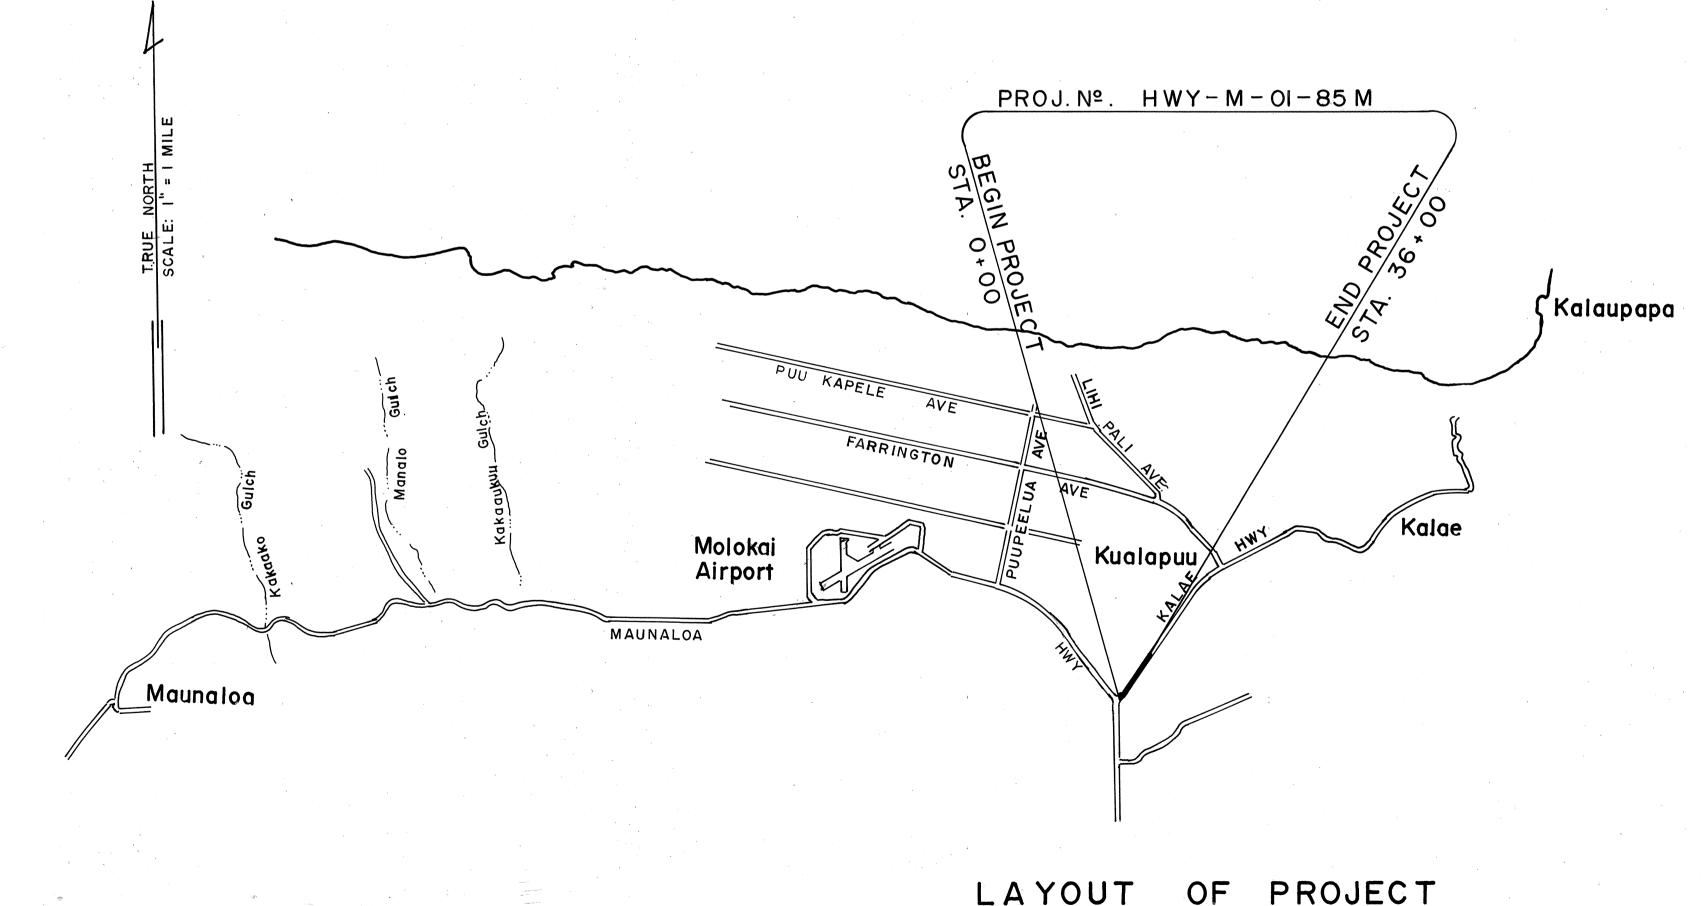

OF PROJECT LAYOUT LENGTH OF PROJECT 0.681 Mi.

DEPARTMENT OF TRANSPORTATION STATE OF HAWAII APPROVED:

Cheery D. Son 918/84 DIR. OF TRANSPORTATION

1-2-7