Ý	INDEX TO DRAWINGS
SHEET NO.	DESCRIPTION
1	TITLE SHEET
2	TYPICAL SECTIONS AND
•	GENERAL NOTES
3-14	PLAN
15	A.C. DETAILS, GUARDRAIL
	SCHEDULES AND NOTES
16	PAVEMENT MARKER, STRIPING
	AND MONUMENT SUMMARY -
	SIGNING, STRIPING AND
	MARKER NOTES
y 17	DRAINAGE DETAILS
18-28	STANDARD DETAILS
	·
, , , , , , , , , , , , , , , , , , , ,	
. (

STATE OF HAWAII

DEPARTMENT OF TRANSPORTATION

HIGHWAYS DIVISION HONOLULU, HAWAII


PLANS FOR

"AS-BUILT"


MAUNALOA HIGHWAY AND KALAE HIGHWAY RESURFACING

PROJECT NO. RS-0900(24)


DISTRICT OF MOLOKAI

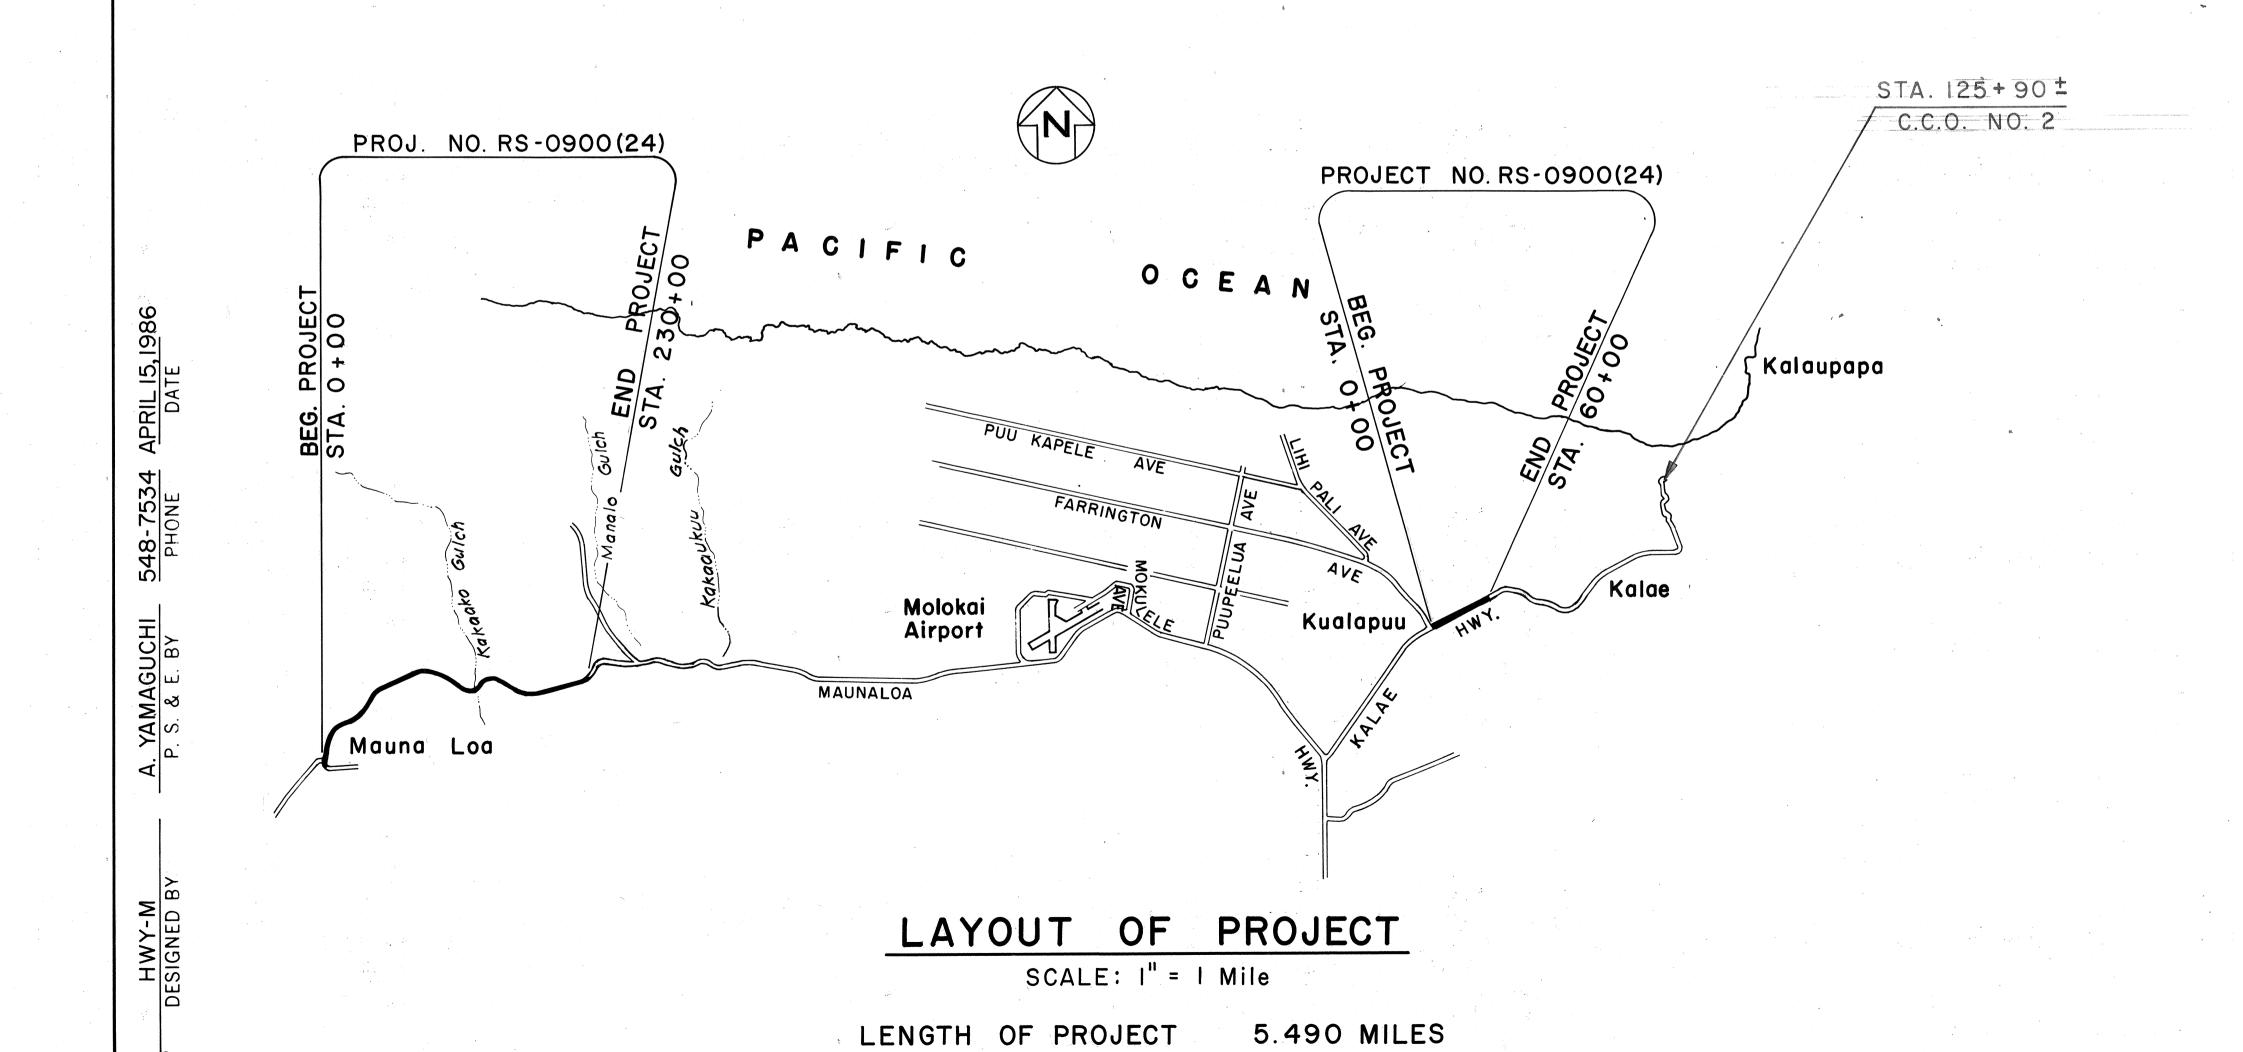



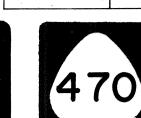

FED. ROAD DIST. NO.

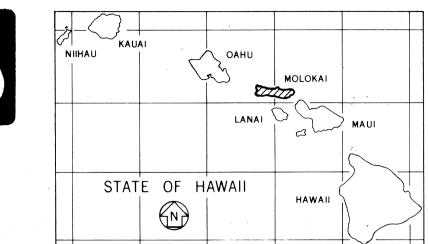


FISCAL SHEET YEAR NO.

SHEETS

FED. AID PROJ. NO.

HAW RS-0900(24) 1985

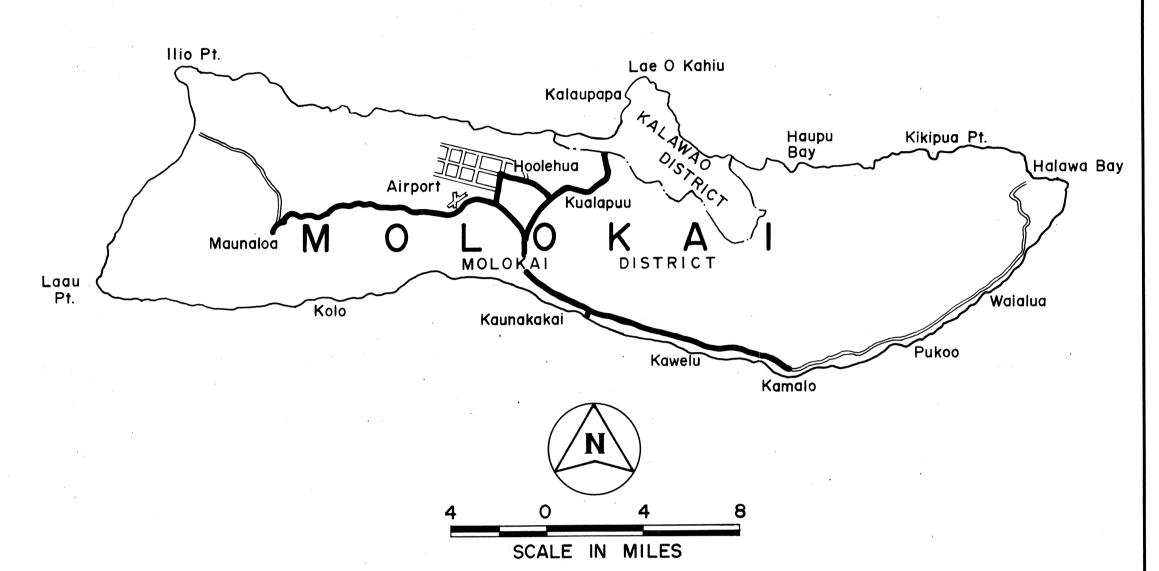

FEDERAL AID PROJECTS PREVIOUSLY CONSTRUCTED
OR UNDER CONSTRUCTION

DESIGN DESIGNATION	MAUNALOA HIGHWAY	KALAE HIGHWAY
CURRENT ADT (1985)	675	800
DESIGN ADT (1995)	725	1025
DHV	75	100
T 2 4	14%	9%

CHANGES MADE DURING CONSTRUCTION HAVE
BEEN INCORPORATED ON THESE PLANS EXCEPT
CHANGES IN THE ORIGINAL THEORETICAL
QUANTITIES. FOR ACTUAL QUANTITIES, REFER TO
PROJECT LEDGER AND/OR COMPUTATION BOOK.

FESIDENT ENGINEER

9-22-88 DATE

DEPARTMENT OF TRANSPORTATION
STATE OF HAWAII

APPROVED:

Classification

Date

DEPARTMENT OF TRANSPORTATION

STATE OF TRANSPORTATION

DATE